



Attachment 17


MRTMC Floor Plan

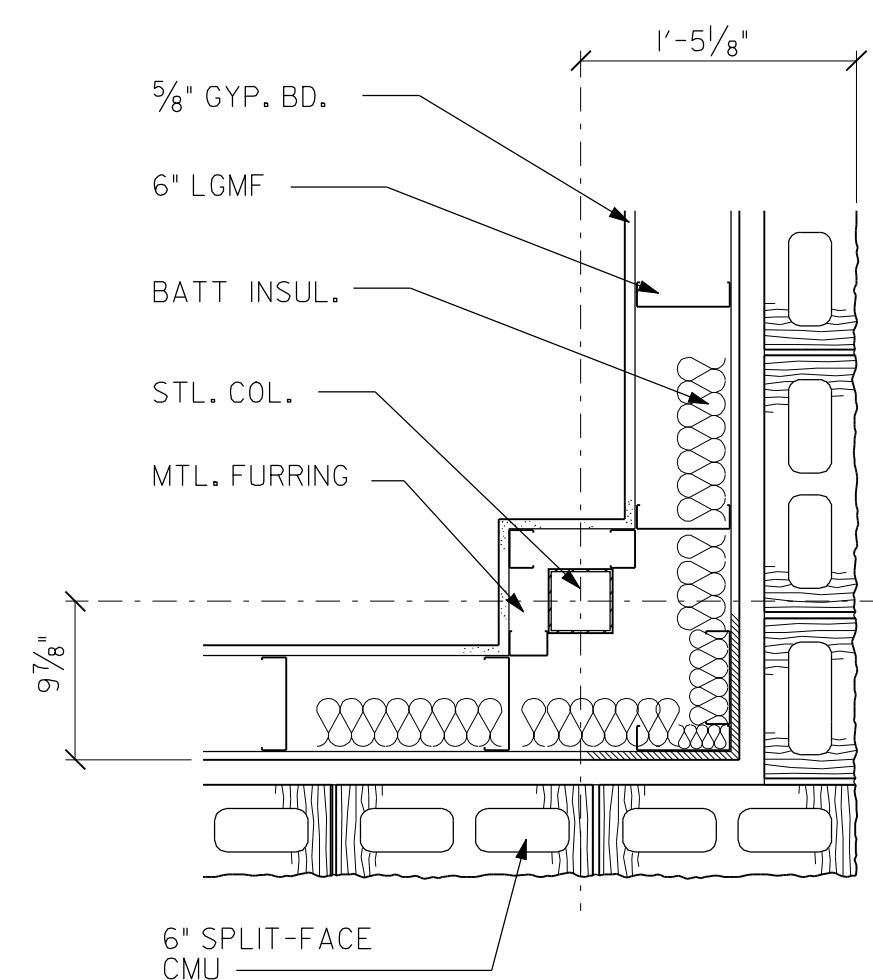


2 DETAIL
SCALE: 1/8"=1'-0"

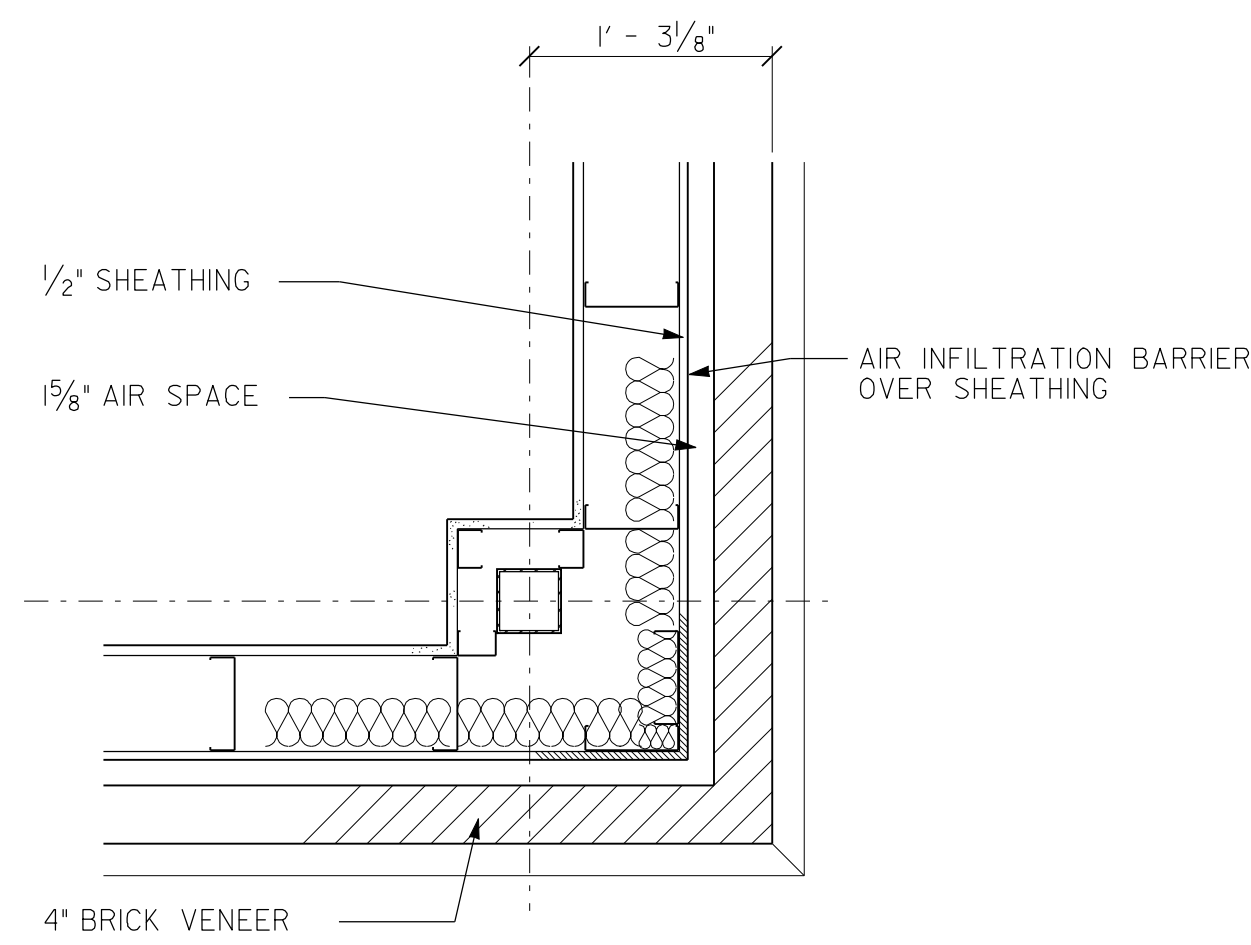

3 DETAIL
SCALE: 1/8"=1'-0"

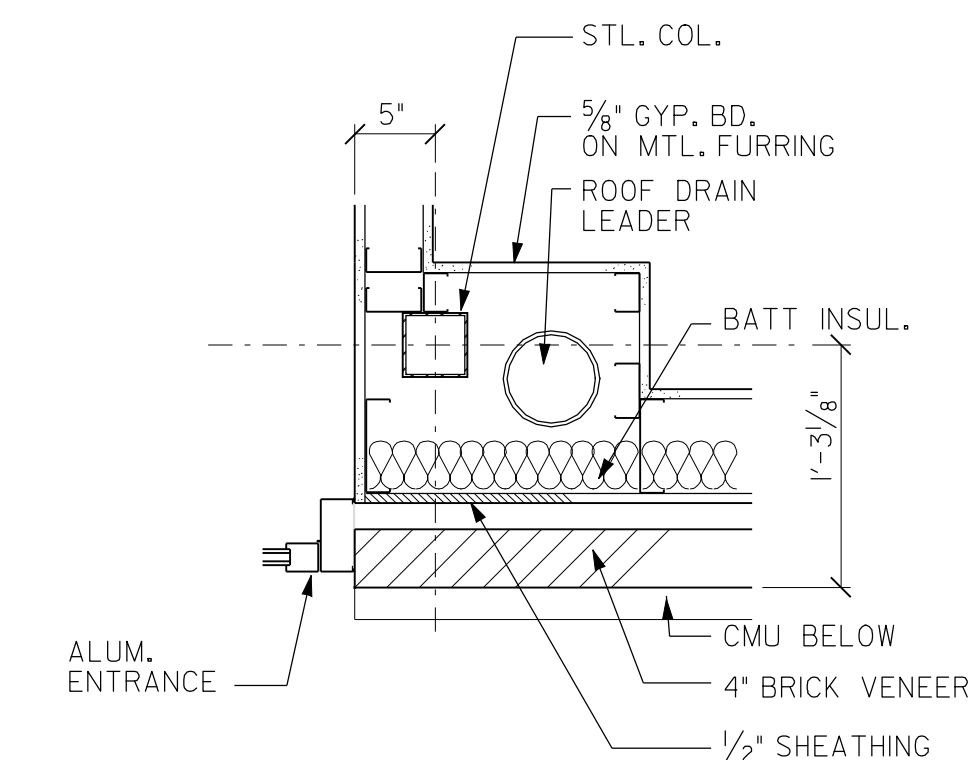


4 DETAIL
SCALE: 1/8"=1'-0"

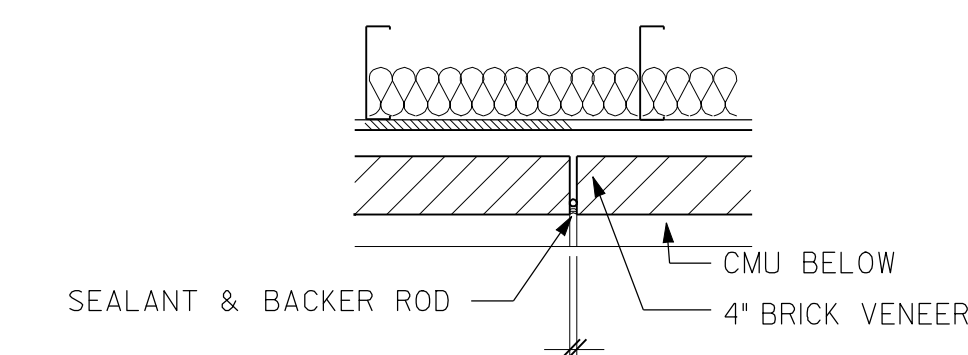

5 DETAIL
SCALE: 1/8"=1'-0"

- FE-1 10lb WALL MTD. CARBON DIOXIDE FIRE EXTINGUISHER (ON HOOK)
- FE-2 2 1/2 gal. WALL MTD. WATER FIRE EXTINGUISHER (ON HOOK)
- FE-3 10ABC FIRE EXTINGUISHER (ON HOOK)
- FE-4 10lb WALL MTD. CARBON DIOXIDE FIRE EXTINGUISHER IN WALL MTD. CABINET
- FE-5 2 1/2 gal. WALL MTD. WATER FIRE EXTINGUISHER IN WALL MTD. CABINET
- FE-6 10ABC FIRE EXTINGUISHER IN WALL MTD. CABINET

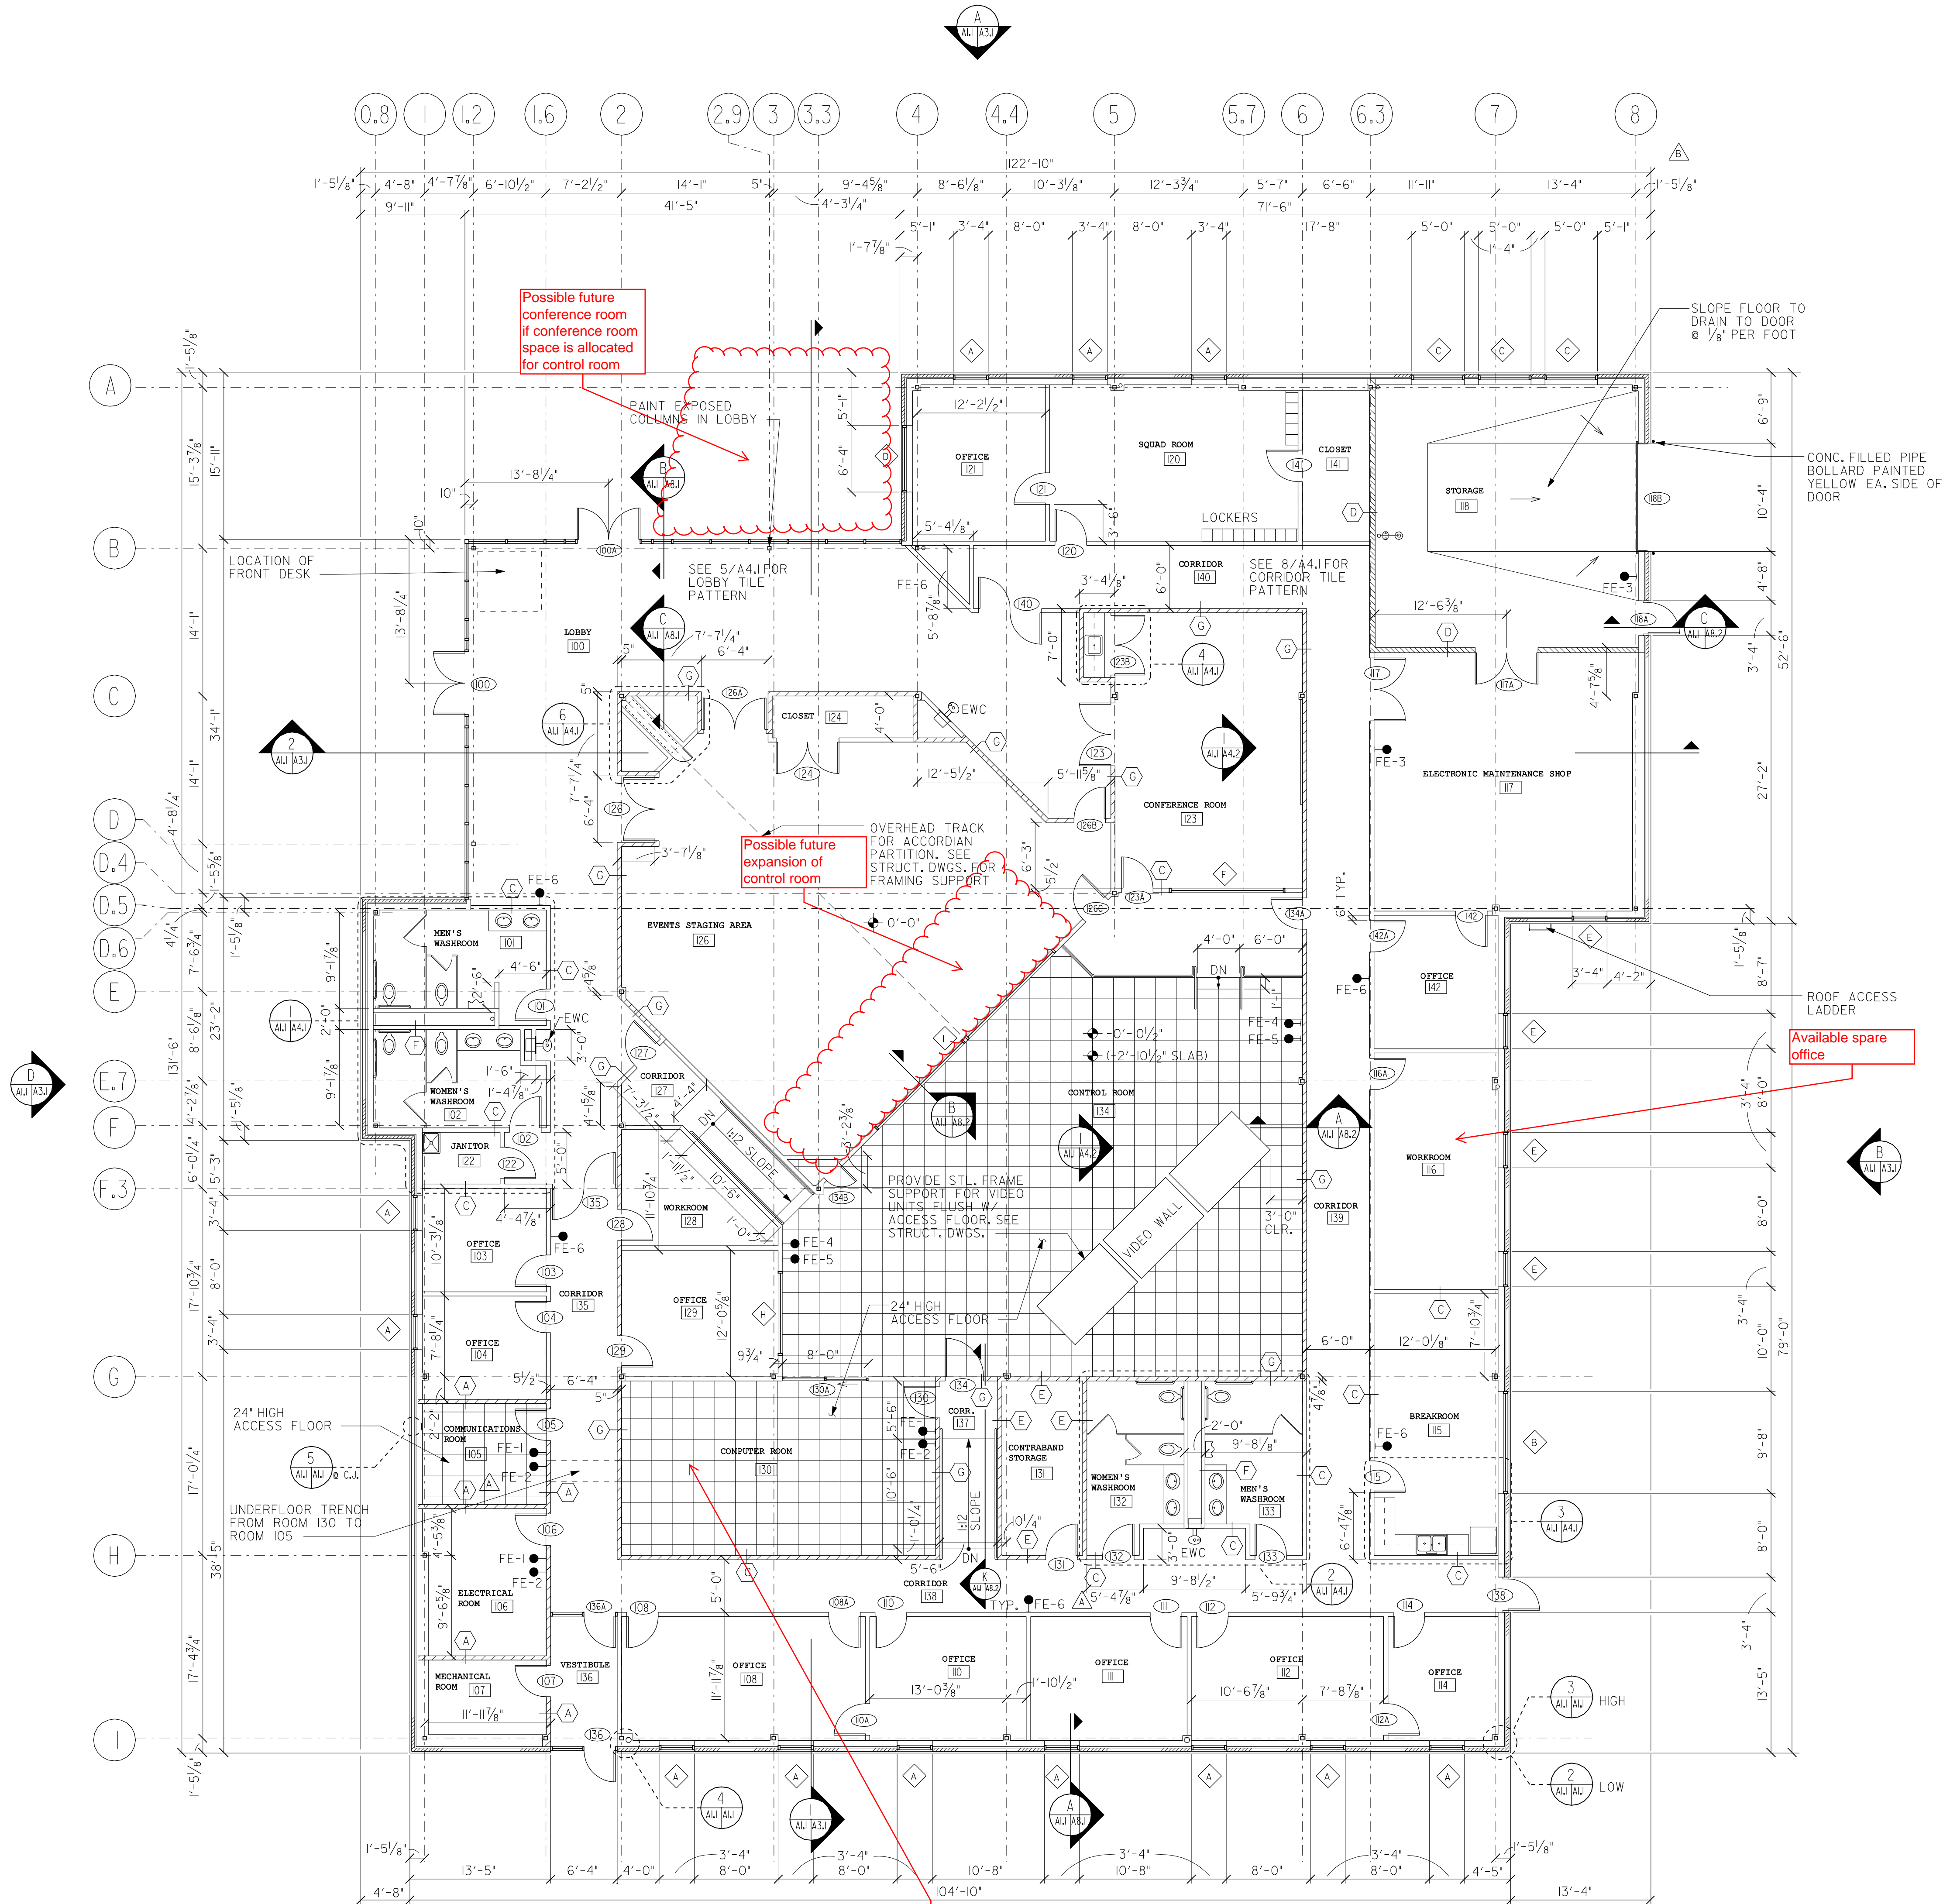

1 FLOOR PLAN
SCALE: 1/8"=1'-0"
ALL INTERIOR PARTITIONS TYPE (B) U.N.O.

- NOTES
1. PROVIDE THE FOLLOWING SIGNAGE FOR ALL ROOMS:
TOILET ROOMS - MALE/FEMALE FIGURE W/ WORDS
ALL OTHER ROOMS - WORDS
ALL SIGNAGE TO HAVE BRAILLE CHARACTERS.
SIGNAGE SHALL COMPLY WITH ADA/ANSI A117.1
 2. ALL RATED WALLS SHALL HAVE THE FOLLOWING WORDING APPLIED AS PER NCSBC 704.2.1.5:
FIRE AND SMOKE BARRIER PROTECT ALL OPENINGS
 3. ALL OPENINGS IN RATED WALLS SHALL BE PROTECTED AS PER NCSBC 705.

As an instrument of service, this Drawing is the property of the Architect and may be used only for this Project. Modifications to this Drawing may be made only by the Architect.

Drawing Issue & Revision Status

Mark	Date	Issued by	Description
-	10-15-96	BWS	OWNER REVIEW
-	11-12-96	BWS	60% OWNER REVIEW
-	12-5-96	BWS	90% OWNER REVIEW
1	12-13-96	BWS	ISSUE FOR BIDS
2	1-10-97	BWS	ADDENDUM #1
2	1-15-97	BWS	PERMIT & CONSTRUCTION
3	3-12-97	BWS	REVISION #1
3	3-19-97	BWS	REVISION #2
3	5-28-97	BWS	REVISION #3
3	7-30-97	BWS	REVISION #4
3	9-19-97	BWS	REVISION #5
3	5-18-98	BWS	REVISION #6
3	12/13/99	BWS	RECORD DRAWINGS



CARLSON PROFESSIONAL SERVICES, INC.
ARCHITECT & ENGINEERS
6520 POWERS FERRY ROAD
SUITE 175
ATLANTA, GEORGIA 30339
TEL. 770.951.1155 / FAX 770.953.2555

CARAT
TRAFFIC OPERATIONS CENTER
NORTH CAROLINA
DEPARTMENT
OF
TRANSPORTATION
TIPTON DRIVE
CHARLOTTE, NORTH CAROLINA

FLOOR PLAN
96502 | A1.1

