



STATE OF NORTH CAROLINA  
DEPARTMENT OF TRANSPORTATION

ROY COOPER  
GOVERNOR

J.R. "JOEY" HOPKINS  
SECRETARY

April 03, 2024

**Addendum No. 1**

RE: Contract # C204410

WBS # 38454.3.1

FEDERAL-AID NO. 0070245

**Wake County (B-4654)**

BRIDGE #69 OVER US-70 ON NC-50 (BENSON RD)

**April 16, 2024 Letting**

To Whom It May Concern:

Reference is made to the plans furnished to you on this project.

The following revision has been made to the Utility Construction plans.

Sheet No.	Revision
UC-3	New note added

Please void the above listed Sheet in your plans and staple the revised Sheet thereto.


The following revision has been made to the Wall (Structure) plans.

Sheet No.	Revision
W-1	Wall bend stations revised

Please void the above listed Sheet in your plans and staple the revised Sheet thereto.

The contract will be prepared accordingly.

Sincerely,

DocuSigned by:  
  
52C46046381F443...

Ronald E. Davenport, Jr., PE  
State Contract Officer

RED/jjr

Mailing Address:  
NC DEPARTMENT OF TRANSPORTATION  
CONTRACT STANDARDS AND DEVELOPMENT  
1591 MAIL SERVICE CENTER  
RALEIGH, NC 27699-1591

Telephone: (919) 707-6900  
Fax: (919) 250-4127  
Customer Service: 1-877-368-4968

Location:  
1020 BIRCH RIDGE DR.  
RALEIGH, NC 27610

Website: [www.ncdot.gov](http://www.ncdot.gov)

Attachments

cc: Mr. Boyd Tharrington, PE  
Mr. Brandon H. Jones, PE  
Mr. Ken Kennedy, PE  
Mr. Malcolm Bell

Mr. Forrest Dungan, PE  
Ms. Jaci Kincaid  
Mr. Jon Weathersbee, PE  
Project File (2)

# UTILITY CONSTRUCTION

## GENERAL NOTES:

1. THE PROPOSED UTILITY CONSTRUCTION SHALL MEET THE APPLICABLE REQUIREMENTS OF THE NC DEPARTMENT OF TRANSPORTATION'S "STANDARD SPECIFICATIONS FOR ROADS AND STRUCTURES" DATED JANUARY 2024.
2. THE EXISTING WATER AND SEWER UTILITIES BELONG TO THE CITY OF RALEIGH PUBLIC UTILITIES DEPARTMENT (CORPUD).
3. ALL WATER LINES TO BE INSTALLED WITHIN COMPLIANCE OF THE RULES AND REGULATIONS OF THE NORTH CAROLINA DEPARTMENT OF ENVIRONMENTAL QUALITY, DIVISION OF WATER RESOURCES, PUBLIC WATER SUPPLY SECTION. ALL SEWER LINES TO BE INSTALLED WITHIN COMPLIANCE OF THE RULES AND REGULATIONS OF THE NORTH CAROLINA DEPARTMENT OF ENVIRONMENT QUALITY, DIVISION OF WATER RESOURCES, WATER QUALITY SECTION. PERFORM ALL WORK IN ACCORDANCE WITH THE APPLICABLE PLUMBING CODES.
4. THE UTILITY OWNER OWNS THE EXISTING UTILITY FACILITIES AND WILL OWN THE NEW UTILITY FACILITIES AFTER ACCEPTANCE BY THE DEPARTMENT. THE DEPARTMENT OWNS THE CONSTRUCTION CONTRACT AND HAS ADMINISTRATIVE AUTHORITY. COMMUNICATIONS AND DECISIONS BETWEEN THE CONTRACTOR AND UTILITY OWNER ARE NOT BINDING UPON THE DEPARTMENT OR THIS CONTRACT UNLESS AUTHORIZED BY THE ENGINEER. AGREEMENTS BETWEEN THE UTILITY OWNER AND CONTRACTOR FOR THE WORK THAT IS NOT PART OF THIS CONTRACT OR IS SECONDARY TO THIS CONTRACT ARE ALLOWED, BUT ARE NOT BINDING UPON THE DEPARTMENT.
5. PROVIDE ACCESS FOR THE DEPARTMENT PERSONNEL AND THE OWNER'S REPRESENTATIVES TO ALL PHASES OF CONSTRUCTION. NOTIFY DEPARTMENT PERSONNEL AND THE UTILITY OWNER TWO WEEKS PRIOR TO COMMENCEMENT OF ANY WORK AND ONE WEEK PRIOR TO SERVICE INTERRUPTION. KEEP UTILITY OWNERS' REPRESENTATIVES INFORMED OF WORK PROGRESS AND PROVIDE OPPORTUNITY FOR INSPECTION OF CONSTRUCTION AND TESTING.

6. THE PLANS DEPICT THE BEST AVAILABLE INFORMATION FOR THE LOCATION, SIZE, AND TYPE OF MATERIAL FOR ALL EXISTING UTILITIES. MAKE INVESTIGATIONS FOR DETERMINING THE EXACT LOCATION, SIZE, AND TYPE MATERIAL OF THE EXISTING FACILITIES AS NECESSARY FOR THE CONSTRUCTION OF THE PROPOSED UTILITIES AND FOR AVOIDING DAMAGE TO EXISTING FACILITIES. REPAIR ANY DAMAGE INCURRED TO EXISTING FACILITIES TO THE ORIGINAL OR BETTER CONDITION AT NO ADDITIONAL COST TO THE DEPARTMENT.
7. MAKE FINAL CONNECTIONS OF THE NEW WORK TO THE EXISTING SYSTEM WHERE INDICATED ON THE PLANS, AS REQUIRED TO FIT THE ACTUAL CONDITIONS, OR AS DIRECTED.
8. MAKE CONNECTIONS BETWEEN EXISTING AND PROPOSED UTILITIES AT TIMES MOST CONVENIENT TO THE PUBLIC, WITHOUT ENDANGERING THE UTILITY SERVICE, AND IN ACCORDANCE WITH THE UTILITY OWNER'S REQUIREMENTS. MAKE CONNECTIONS ON WEEKENDS, AT NIGHT, AND ON HOLIDAYS IF NECESSARY.
9. ALL UTILITY MATERIALS SHALL BE APPROVED PRIOR TO DELIVERY TO THE PROJECT. SEE 1500-7, " SUBMITTALS AND RECORDS" IN SECTION 1500 OF THE STANDARD SPECIFICATIONS.

## PROJECT SPECIFIC NOTES:

1

1. THE CONTRACTOR SHALL REPLACE ANY DAMAGED SEWER LATERAL AND/OR CLEANOUTS AS DIRECTED BY THE ENGINEER. THE NECESSARY QUANTITIES HAVE BEEN ADDED TO THE CONTRACT TO FACILITATE THIS PROCEDURE.

Prepared in the Office of:



AECOM TECHNICAL SERVICES OF NORTH CAROLINA, INC.  
5438 WADE PARK BLVD, SUITE 200, RALEIGH, NC 27607  
919-461-1100  
F - 0342

DOCUMENT NOT CONSIDERED FINAL  
UNLESS ALL SIGNATURES COMPLETED


PROJECT REFERENCE NO. <b>B-4654</b>	SHEET NO. <b>UC-3</b>
DESIGNED BY:	
DRAWN BY:	
CHECKED BY:	
APPROVED BY:	
REVISED:	
NORTH CAROLINA DEPARTMENT OF TRANSPORTATION UTILITIES ENGINEERING SECTION PHONE: (919) 707-6690 FAX: (919) 250-4151	

## UTILITY CONSTRUCTION

DATE: 4/2/2024  
TIME: 3:48 PM  
DGN: L:\Laptops\Pro\Per\6043695-B-4654\900\_Work\930\_LC\NVO\_KICDOT\_T\IP\Utilities\Engineer\ng\UC\Pro\B4654\_Luc\_p403.rgn

1 "Per Addendum: Added Note No. 1 to the Project Specific notes. April 2, 2024"

GEOTECHNICAL ENGINEER







SEAL  
032171  
ENGINEER  
JUNYOUNG PARK

ENGINEER

---

DocuSigned by: *J. Park* 04/02/2024


**DOCUMENT NOT CONSIDERED FINAL  
UNLESS ALL SIGNATURES COMPLETED**

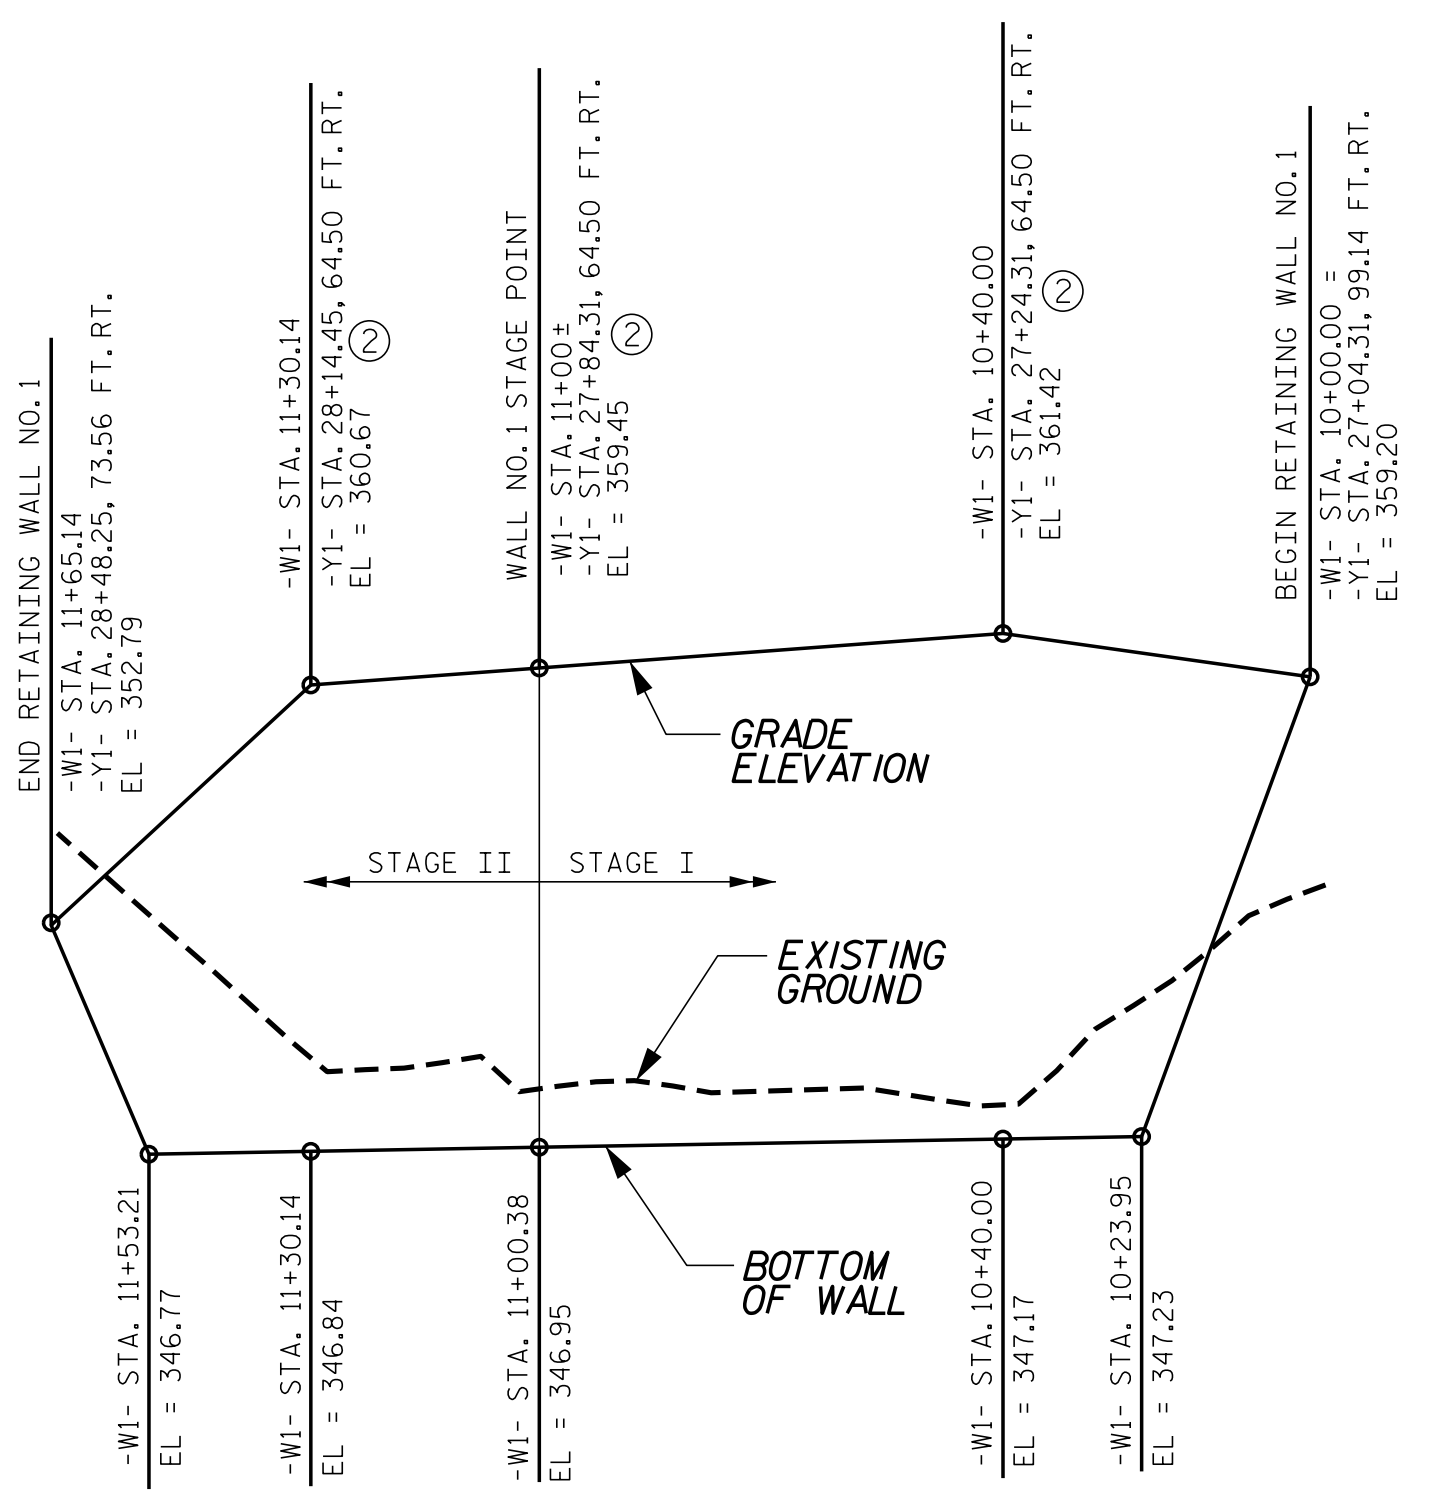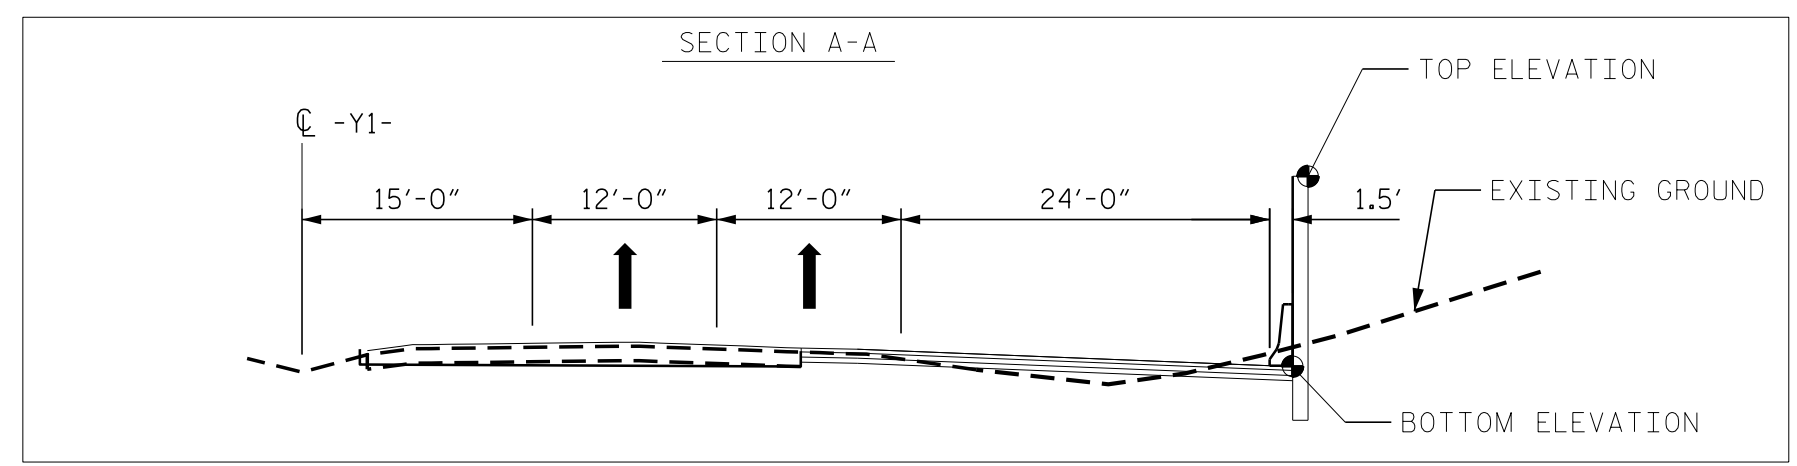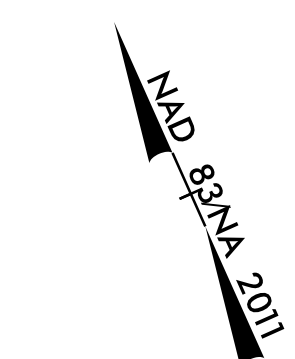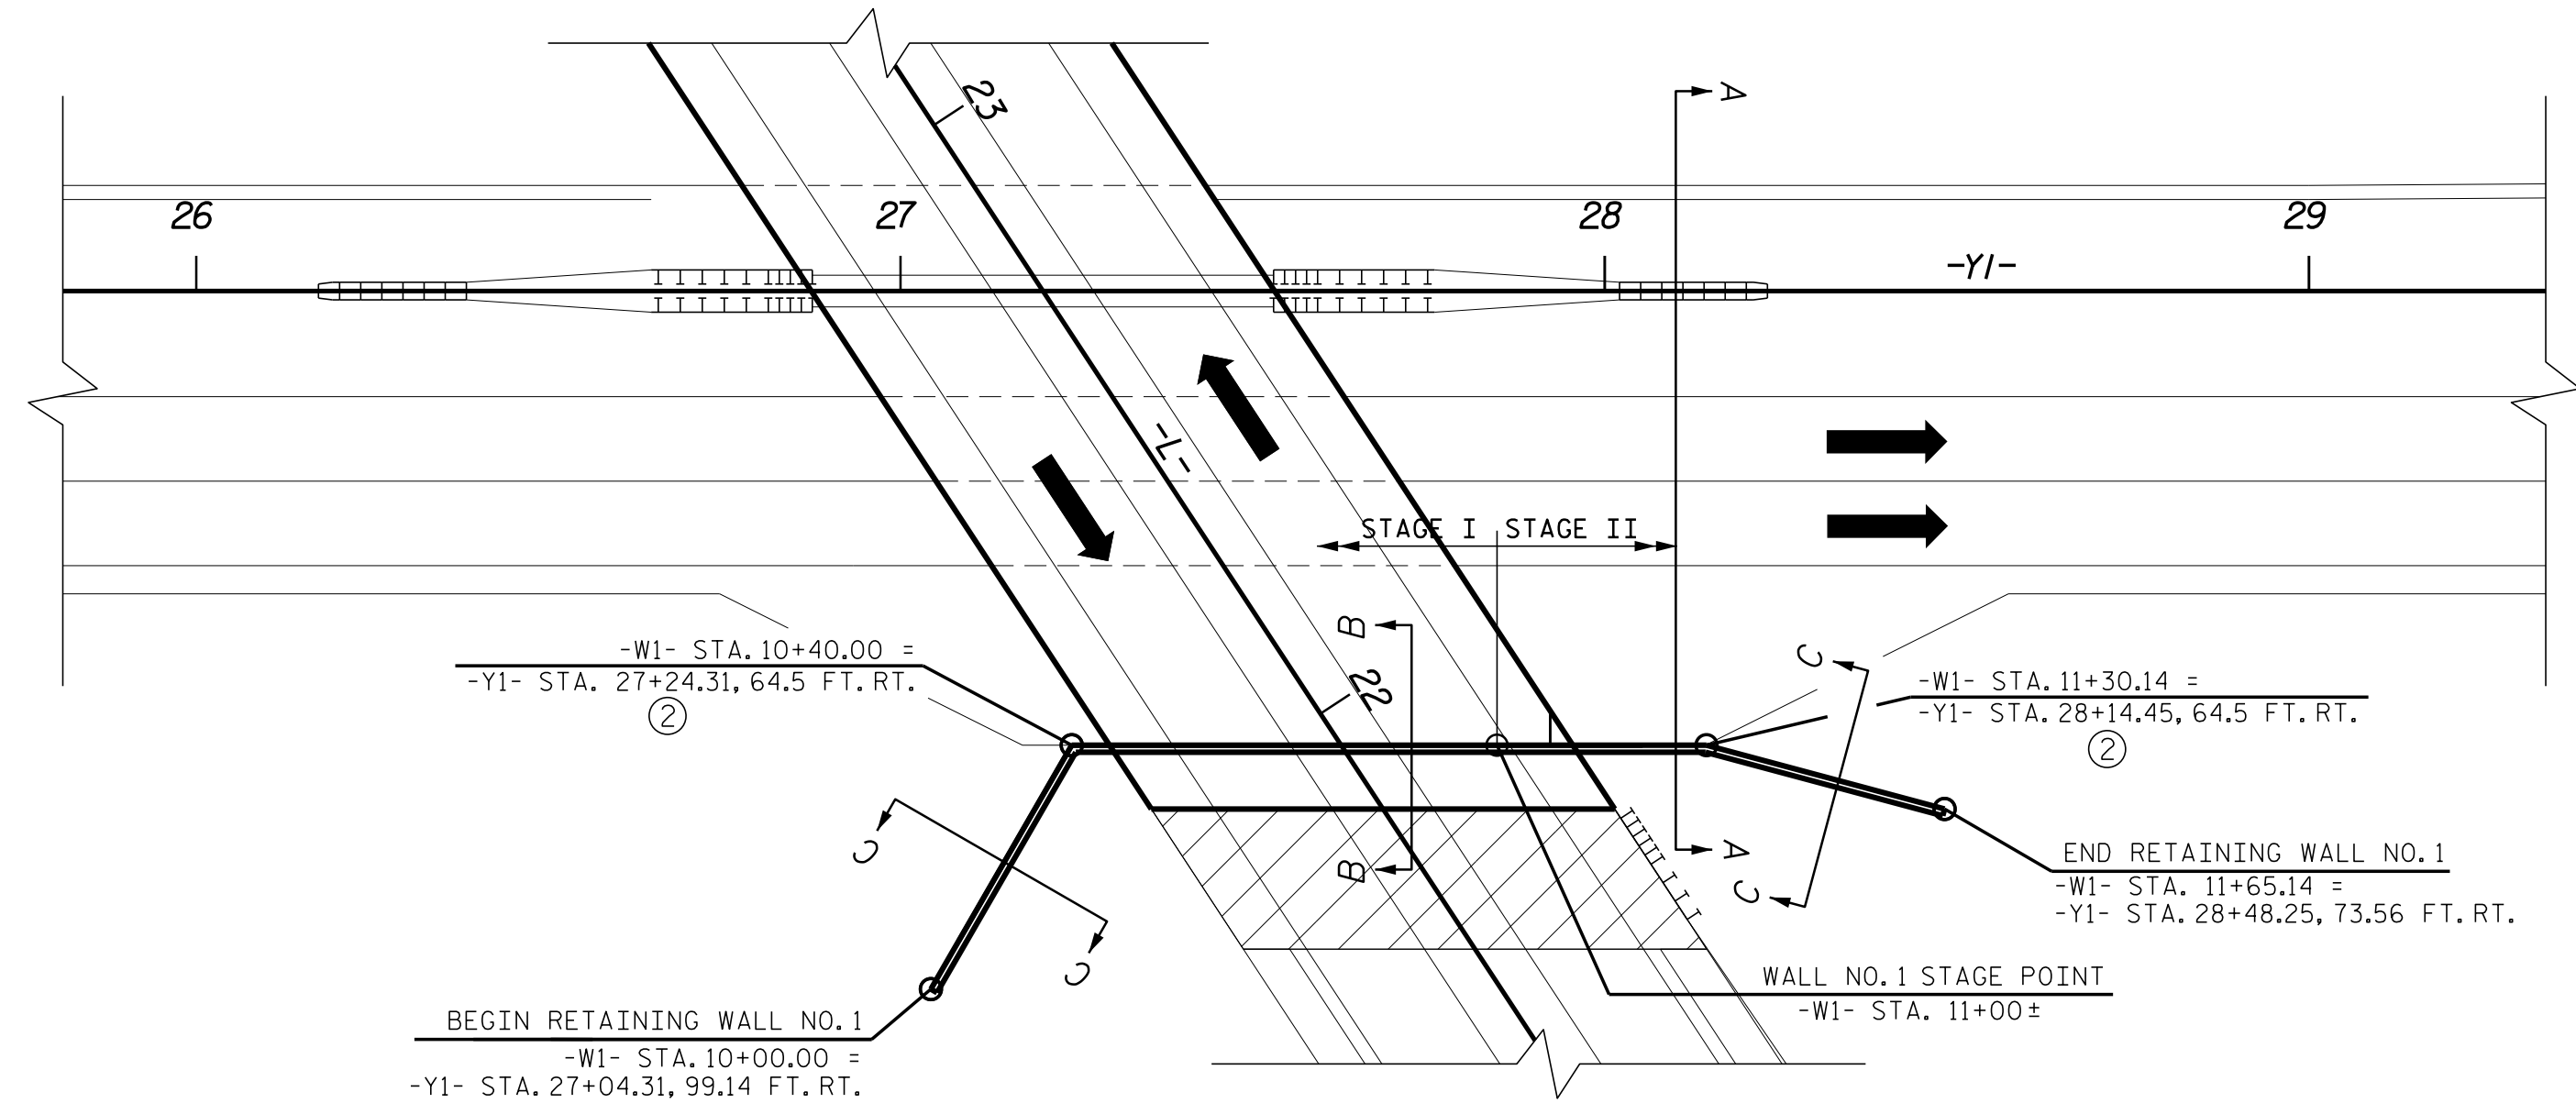

ESTIMATED MSE WALL NO. 1 QUANTITIES	
MSE RETAINING WALL NO. 1*	2,300 SF
ARCHITECTURAL CONCRETE SURFACE TREATMENT**	1,750 SF

\* QUANTITY INCLUDES EMBEDMENT AND EXTENSION  
\*\* QUANTITY BASED ON EXPOSED AREA

PROJECT NO.: 38454.1.1 (B-4654)  
WAKE COUNTY  
STATION: -L- 21+80.00  
SHEET 1 OF 5

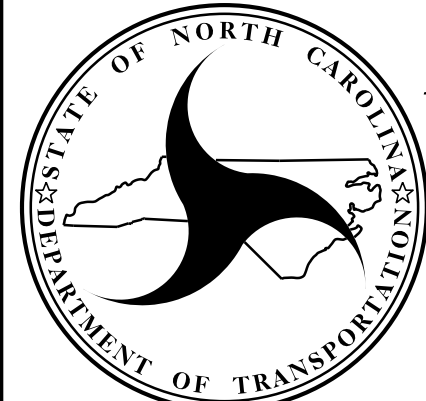

**NORTH CAROLINA  
DEPARTMENT OF TRANSPORTATION  
DIVISION OF HIGHWAYS**

**GEOTECHNICAL  
ENGINEERING UNIT**

REVISIONS					
NO.	BY	DATE	NO.	BY	DATE
1	J. PARK	5/16/19	3		
2	J. PARK	4/2/24	4		

**RETAINING WALL NO. 1  
PLAN VIEW AND  
WALL ENVELOPE**

PREPARED BY: J. PARK	DATE: 02 / 2019
REVIEWED BY: J. BATTS	DATE: 02 / 2019

SHEET NO.  
W-1