

# STATE OF NORTH CAROLINA DEPARTMENT OF TRANSPORTATION

ROY COOPER
GOVERNOR

J.R. "JOEY" HOPKINS
SECRETARY

October 26, 2023

#### Addendum No. 1

Contract No.: DA00576

WBS Element: 2024CPT.01.12.20082, ETC.

Microsurfacing & Pavement Markings on Various Sections of Secondary Routes in Bertie, Camden, Hyde, Tyrrell, & Washington Counties

To Whom It May Concern:

Reference is made to the proposal and plans previously furnished for this project.

The following revisions have been made to the proposal and plans:

Pages 40A – 40B "Hot Spray Thermoplastic Pavement Marking Lines" have been included. Please insert Pages 40A – 40B "Hot Spray Thermoplastic Pavement Marking Lines" in the appropriate location.

Pages 75 - 76 "Bid Form" have been revised. Please note that the quantity for Line Item #10 "Pavement Marking Lines (4") has been increased, the quantity for Line Item #14 "Removal of Pavement Marking Lines (4") has been increased and Line Item #18 "Generic Pavement Marking Item – Hot Spray Thermoplastic Pavement Marking Lines, (4",55 MILS), has been included. Please replace the original Pages 75 - 76 "Bid Form" with the attached revised Pages 75 - 76 "Bid Form".

Plan Sheet No. 1 "Title Sheet #1" has been revised to remove the reference to "Asphalt Surface Treatment". Please replace the original Plan Sheet No. 1 "Title Sheet #1" with the attached revised Plan Sheet No. 1 "Title Sheet #1".

Plan Sheet No. 9 "Summary of Quantities" has been revised. Please note that the quantity for "Pavement Marking Lines (4") has been increased, the quantity for "Removal of Pavement Marking Lines (4") has been increased and "Generic Pavement Marking Item – Hot Spray Thermoplastic Pavement Marking Lines, (4",55 MILS), has been included. Please replace the original Plan Sheet No. 9 "Summary of Quantities" with the attached revised Plan Sheet No. 9 "Summary of Quantities".

## Sincerely,



## C. E. Slachta Division Planning Engineer

Cc: C. W. Bridgers, Jr., PE

R. K. Sawyer, PE

R. W. Midgett, PE

M. B Gill, PE

B. N. Braswell, PE

D. B. Otts, PE

M. R. Hill, PE

C. A. Spear, PE

E. S. Sedlacek

A. L. Mulder

J. W. Hoadley

M. Proctor

DA00576 REVISED 10/26/2023 ADDENDUM #1 PAGE 40A



#### HOT SPRAY THERMOPLASTIC PAVEMENT MARKING LINES:

(12-01-20) Rev. 04/05/22

#### **Description**

This special provision covers machine applied "hot spray" thermoplastic pavement marking material with both incorporated reflective media.

General, Color, Packing for Shipment, Storage, Materials, Construction Methods, Maintenance, Method of Measurement, and Basis of Payment shall be as described in Section 1087 and Section 1205 of the *Standard Specifications*, with the exceptions as shown below:

Revise the 2018 Standard Specifications as follows:

Page 10-182, Subarticle 1087-4(C) Gradation & Roundness, lines 15-17, replace this subarticle with the following:

The reflective media used in all pavement marking shall be used according to the manufacturer's recommendations in order to meet the retroreflectivity requirements as stated in Subarticles 1205-4(C) and 1205-4(D) as measured by any Department approved 30-meter geometry retroreflectivity device.

The reflective media shall be capable of flowing freely through dispensing equipment in any weather suitable for marking the pavement.

#### Page 12-1, Subarticle 1205-2(B) Material Qualification, line 9, add the following:

All "hot spray" thermoplastic manufacturers must be prequalified. In order to be prequalified, all "hot spray" Thermoplastic Pavement Marking manufacturers must have their material installed on the NTPEP test deck.

**Page 12-6, Subarticle 1205-4(A) Application Equipment,** delete lines 28-30, add the following:

Handliners shall not be allowed.

Use application equipment that provides multiple width settings ranging from 4" to 12" and multiple thickness settings to achieve a minimum 50 mil thickness in one pass.

DA00576 REVISED 10/26/2023 ADDENDUN #1 PAGE 40 B

**Page 12-7, Subarticle 1205-4(C) Application,** lines 2-5, delete the first paragraph and replace with the following:

All thermoplastic markings shall be of the hot, machine applied type. Application shall be accomplished by spraying methods only.

**Page 12-7, Subarticle 1205-4(C) Application,** lines 30-31, delete the last paragraph and replace with the following:

Produce a cross-sectional thickness of hot spray thermoplastic markings for long line markings only with a minimum thickness of 50 mils without reflective media or a minimum thickness of 55 mils with reflective media.

Extruded type thermoplastic shall not be sprayed.

Payment will be made under:

The cross-sectional thickness of all "hot sprayed" thermoplastic markings above the surface of the existing pavement shall be no more than 60 mils.

The manufacturer of that material shall certify that the Contractor is trained to place the material. At least one member of each crew working on this project shall have completed this training. The Contractor shall furnish the Engineer written confirmation of this training from the material manufacturer prior to beginning the work.

If the hot sprayed thermoplastic is to be placed over milled-in rumble strips, the Contractor shall ensure that all debris is removed after milling and the surface is thoroughly cleaned to ensure optimum adhesion between the surface and the hot sprayed thermoplastic.

Page 12-12, Article 1205-10 Measurement and Payment, replace this article with the following:

Hot Spray Thermoplastic Pavement Marking Line, \_\_(width), \_\_(thickness) will be measured and paid as the actual number of linear feet of pavement marking lines satisfactorily placed and accepted by the Engineer. The quantity of solid lines will be the summation of the linear feet of solid line measured end-to-end of the line. The quantity of skip or broken lines will be the summation of the linear feet derived by multiplying the nominal length of a line by the number of marking lines satisfactorily placed. Such prices and payment will be full compensation for all work covered by this section including, but not limited to, furnishing, surface preparation, reapplication of molten pavement marking crossed by a vehicle, and removal of all pavement marking materials spilled on the roadway surface.

Pay Item	<b>Pay Unit</b>
Hot Spray Thermoplastic Pavement Marking Lines,,	Linear Foot

REVISED 10/26/2023

Page 1 of 2

ITEMIZED PROPOSAL FOR CONTRACT NO. DA00576

Oct 26, 2023 8:48 AM

County:

BERTIE, CAMDEN, HYDE, TYRRELL, WASHINGTON

Line **Unit Cost Amount** Item Number Sec Description Quantity # # **ROADWAY ITEMS** 0001 0000100000-N 800 **MOBILIZATION** L.S. Lump Sum 0002 SP GENERIC PAVING ITEM 1891000000-E 126,966 LATEX MODIFIED MICROSURFACING SY TYPE II (18-22 LBS.) 0003 283000000-N 858 ADJUSTMENT OF MANHOLES EΑ 0004 2845000000-N 858 ADJUSTMENT OF METER BOXES OR 3 EΑ VALVE BOXES SP 0005 WORK ZONE ADVANCE/GENERAL 4413000000-E 3,860 WARNING SIGNING SF 0006 4457000000-N SP TEMPORARY TRAFFIC CONTROL Lump Sum L.S. 0007 4704000000-E 1205 THERMOPLASTIC PAVEMENT 40 MARKING LINES (16", 90 MILS) LF 8000 4709000000-E 1205 THERMOPLASTIC PAVEMENT 30 MARKING LINES (24", 90 MILS) LF 0009 1205 THERMOPLASTIC PAVEMENT 2 4720000000-E MARKING CHARACTER (90 MILS) EΑ 0010 4810000000-E 1205 230,242 PAINT PAVEMENT MARKING LINES (4") LF 1205 PAINT PAVEMENT MARKING LINES 40 0011 4830000000-E (16")LF 0012 4835000000-E 1205 PAINT PAVEMENT MARKING LINES 30 LF (24")0013 484000000-N 1205 PAINT PAVEMENT MARKING 2 CHARACTER EΑ 4850000000-E 1205 REMOVAL OF PAVEMENT MARKING 109,032 0014 LINES (4") ΙF 0015 4870000000-E 1205 REMOVAL OF PAVEMENT MARKING 30 LINES (24") LF 0016 4875000000-N 1205 REMOVAL OF PAVEMENT MARKING 2 SYMBOLS & CHARACTERS EΑ 4891000000-E 1205 GENERIC PAVEMENT MARKING ITEM 40 0017 REMOVAL OF PAVEMENT MARKING LF LINES (16")

Oct 26, 2023 8:48 AM

ITEMIZED PROPOSAL FOR CONTRACT NO. DA00576

REVISED 10/26/2023

Page 2 of 2

County: BERTIE, CAMDEN, HYDE, TYRRELL, WASHINGTON

Line #	Item Number	Sec #	Description	Quantity	Unit Cost	Amount
0018	4890000000-E	SP	GENERIC PAVEMENT MARKING ITEM HOT SPRAY THERMOPLASTIC PAVEMENT MARKING LINES, (4", 55 MILS)	109,032 LF		

0848/Oct26/Q579354/D74260100000/E18

Total Amount Of Bid For Entire Project :

# STATE OF NORTH CAROLINA DIVISION OF HIGHWAYS

# **BERTIE**

REVISED 10/26/2023

STATE PROJECT REFERENCE NUMBER 2024CPT.01.12.20082, ETC


P.E., CONST. P.E., CONST.


P.E., CONST.

STATE PROJECT NUMBER 2024CPT.01.12.20082, ETC

# TYPE OF WORK: MICROSURFAC & PAVEMENT MARKINGS

MAP R	ROUTE	FROM	то
01 S	SR 1301 (Pine Ridge Rd.)	SR 1001 (Wakelon Road)	SR 1346 (Bethany Church Rd)

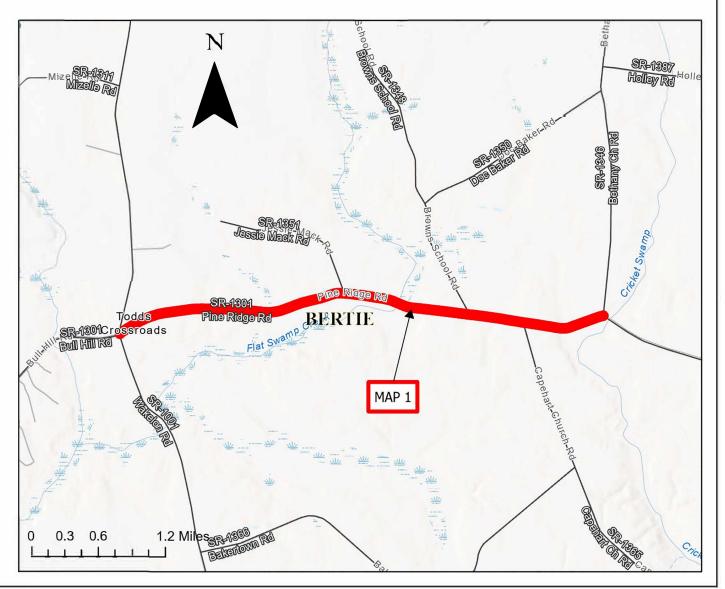

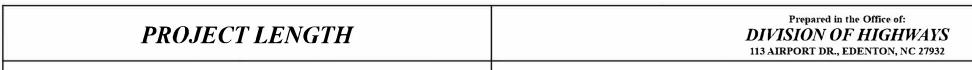

 MAP
 MILES

 01
 3.60

B. N. BRASWELL, PE DIV. PROJ. DEVELOPMENT ENGINEER

C. E. SLACHTA

DIVISION CONTRACT ENGINEER

J. S. ABEL, JR.

DIVISION PROJECT TEAM LEAD

D. H. STALLINGS

DIVISION DESIGN ENGINEER



## REVISED 10/26/2023

PROJECT NO.	SHEET NO.	TOTAL NO.
2024CPT.01.12.20082, ETC.	9	

## THERMOPLASTIC AND PAINT QUANTITIES

									4413000000-F	4457000000-N	4704000000-E		4720000000-F		00000-E	4830000000-F	4835000000-F	4840000000-N	4850000000-F	4870000000-E	4875000000-N	489000	0000-E	4891000000-E
PROJECT NO	COUNTY	MAP NO	ROUTE	DESCRIPTION	TYP NO	LANES LANE	LENGTH	WIDTH		TEMPORARY	470400000 E	THERMO	4720000000	PAINT	PAINT	PAINT	PAINT	PAINT	REMOVAL OF		REMOVAL OF	GEN	GEN	GEN PVMT
						ТҮРЕ			ADVANCE/GE	TRAFFIC	THERMOPLAS	PAVEMENT	THERMOPLAS	PAVEMENT	PAVEMENT	PAVEMENT	PAVEMENT	PAVEMENT	PAVEMENT	PAVEMENT	PAVEMENT	PAVEMENT	PAVEMENT	MKG ITEM
									NERAL	CONTROL (SP)	TIC	MARKING	TIC	MARKING	MARKING	MARKING	MARKING	MARKING	MARKING	MARKING	MARKING	MARKING	MARKING	REMOVAL OF
									WARNING		PAVEMENT	LINES (24" 90	PAVEMENT	LINES (4")	LINES (4")	LINES (16")	LINES (24")	CHARACTER	LINES (4")	LINES (24")	SYMBOLS &	ITEM,	ITEM,	PAVEMENT
									SIGNING		MARKING	MILS)	MARKING	WHITE	YELLOW			(MSG RXR)			CHARACTERS	THERMO HOT	THERMO HOT	MARKING LINES
											LINES (16")		CHARACTER									SPRAY LINES	SPRAY LINES	(16")
													(90 MILS), RXR									(4" 55 MILS)	(4" 55 MILS)	
																ļ						WHITE	YELLOW	<del></del>
2024CPT.01.12.20082	Bertie	1	SR-1301 / PINE RIDGE RD	SR 1001 WAKELON ROAD TO SR 1346 BETHANY CHURCH ROAD	1	2 2WU	MI 2.61	<b>FT</b> 21	<b>SF</b> 456	LS 1	LF	LF	EA	<b>LF</b> 76,454	<b>LF</b> 57,340	LF	LF	EA	<b>LF</b> 66.897	LF	EA	LF 38.227	<b>LFT</b> 28,670	LF
2024CF1.01.12.20082	bertie	1	SK-1301 / FINE KIDGE KD	SK 1001 WAKELON KOAD TO SK 1540 BETTIANT CHOKET KOAD	1	2 2000	3.01	21	430	1				70,434	37,340				00,837			36,227	28,070	<del>                                     </del>
							3.61		456	*				76,454	57,340				66,897			38,227	28,670	
10	TAL FOR PRO	J NO. 2024C	PT.01.12.20082											13	3,794							66,	897	
2024CPT.01.12.20152	Camden	2	SR-1145 / BELCROSS RD	FROM RXR TRACKS @ US 158 TO SR 1136 (IVEY NECK ROAD)	1	2 2WU	2.28	20	248	*	40	30	2	48,154	36,116	40	30	2	42,135	30	2	24,077	18,058	40
						ļ				*			ļ											
то	TAL FOR PRO	J NO. 2024C	PT.01.12.20152		1	-	2.28		248	•	40	30	2	48,154	36,116 1,270	40	30	2	42,135	30	2	24,077	18,058 135	40
				<u> </u>	1		1		l	I	l		1	. 84	,,,,,,,,,,,,,,,,,,,,,,,,,,,,,,,,,,,,,,,		I		1	l .		42,	133	1
2024CPT.01.12.20482	Hyde	3	SR-1123 / ARCH RD	DEAD END TO SR 1121 JUNIPER BAY ROAD	1	2 2WU	0.41	18	108	*														
2024CPT.01.12.20482	Hyde	4	SR-1130 / ACADEMY ST	NC 45 TO NC 94	1	2 2WU		16	216	*														
		4			1	1 1 1 1 1 1				*														
2024CPT.01.12.20482	Hyde	5	SR-1131 / CHURCH ST	SR 1133 THIRD ST TO NC 94	1	2 2WU	0.15	16	264	*														<del>                                     </del>
2024CPT.01.12.20482	Hyde	6	SR-1131 / CHURCH ST	NC 45 TO NC 94	1	2 2WU	0.18	16	216	*														<u> </u>
2024CPT.01.12.20482	Hyde	7	SR-1132 / SECOND ST	NC 45 TO SR 1131 CHURCH STREET	1	2 2WU	0.12	18	240	*														<u> </u>
2024CPT.01.12.20482	Hyde	8	SR-1132 / SECOND ST	SR 1136 LANDING ROAD TO NC 45	1	2 2WU	0.09	18	216	*				200										
2024CPT.01.12.20482	Hyde	9	SR-1133 / THIRD ST	NC 45 TO SR 1131 CHURCH STREET	1	2 2WU	0.14	18	216	*														
2024CPT.01.12.20482	Hyde	10	SR-1134 / PEARL ST	SR 1132 SECOND STREET TO NC 94	1	2 2WU	0.08	16	216	*														
2024CPT.01.12.20482	Hyde	11	SR-1162 / RANSOME GREEN RD	SR 1124 QUARTER ROAD TO DEAD END	1	2 2WU	0.12	18	108	*														
то	TAL FOR PRO	J NO. 2024C	PT.01.12.20482				1.62		1,800	*				200	200									<del></del>
					1		<u> </u>			<u>l</u>			1		200	1	<u>l</u>		1					1
2024CPT.01.12.20892	Tyrrell	12	SR-1203 / COLONIAL BEACH RD	SR 1200 ALBEMARLE CHURCH ROAD TO EOM	1	2 2WU	0.69	20	132	*				7,424	4,554									
2024CPT.01.12.20892	Tyrrell	13	SR-1243 / SHILOH RD	SR 1221 NEWFOUNDLAND ROAD TO CDS	1		0.14	18	108	*														
2024CPT.01.12.20892	Tyrrell	14	SR-1244 / VA-LEE BEACH RD	SR 1245 RHODES DRIVE TO SR 1209 SOUND SIDE ROAD	1	2 2WU		18	252	*														
2024CPT.01.12.20892	Tyrrell	15	SR-1245 / RHODES DR	EOP TO SR 1244 VA-LEE BEACH ROAD	1	2 2WU		18	108	*														<b></b>
2024CPT.01.12.20892	Tyrrell	16	SR-1247 / OLD BEACH HOUSE RD	SR 1203 COLONIAL BEACH ROAD TO EOM	1	2 2WU	0.16	18	108	*														<b></b>
					-	<u> </u>	1.61		708	*				7,424	4,554									<del></del>
то	TAL FOR PRO	J NO. 2024C	PT.01.12.20892				1.61		708	-					4,554 1,978				1					<del>                                     </del>
				L		ı	1 1		l .	I	l .		I		.,	1	I		ı	1				
2024CPT.01.12.20942	Washington	17	SR-1144 / FURLOUGH RD	DEAD END TO SR 1143 MOUNT TABOR ROAD	1	2 2WU	0.3	18	108	*														
2024CPT.01.12.20942	Washington	18	SR-1152 / WHITE RD	SR 1149 AMBROSE ROAD TO DEAD END	1	2 2WU	0.41	18	108	*														
	Washington		SR-1154 / TARKINGTON RD	DEAD END TO SR 1148 AMBROSE ROAD	1	2 2WU		18	108	*														
2024CPT.01.12.20942			SR-1157 / BURRIS RD	SR 1142 SPRUILL BRIDGE ROAD TO DEAD END	1	2 2WU		18	108	*														<del></del>
2024CPT.01.12.20942			SR-1185 / PUDDING RD	CDS TO SR 1155 CHERRY ROAD	1	2 2WU		18	108	*					1									-
2024CPT.01.12.20942	Washington	22	SR-1305 / LITCHFIELD RD	DEAD END TO SR 1303 DAVENPORT FORKS ROAD	1	2 2WU	0.4	18	108	*														
то	TAL FOR PRO	J NO. 2024C	PT.01.12.20942				1.67		648	*														
-					1				<u> </u>		<u> </u>								<u> </u>					
	6	RAND TOTA	1				10.79		3,860	1	40	30	2	132,232	98,010	40	30	2	109,032	30	2	62,304	46,728	40
	G	NAND IUIA	-											23	0,242							109	,032	