


## VERTICAL GRADE DATA -L-




 UNCLASSIFIED  
STRUCTURE EXCAVATION

PI STA. 14+52.18  
 $\Delta = 58^{\circ} 22' 37.0''$  (RT)  
 $D = 31^{\circ} 49' 51.6''$   
 $L = 183.40'$   
 $T = 100.55'$   
 $R = 180.00'$

## HORIZONTAL CURVE DATA -L-

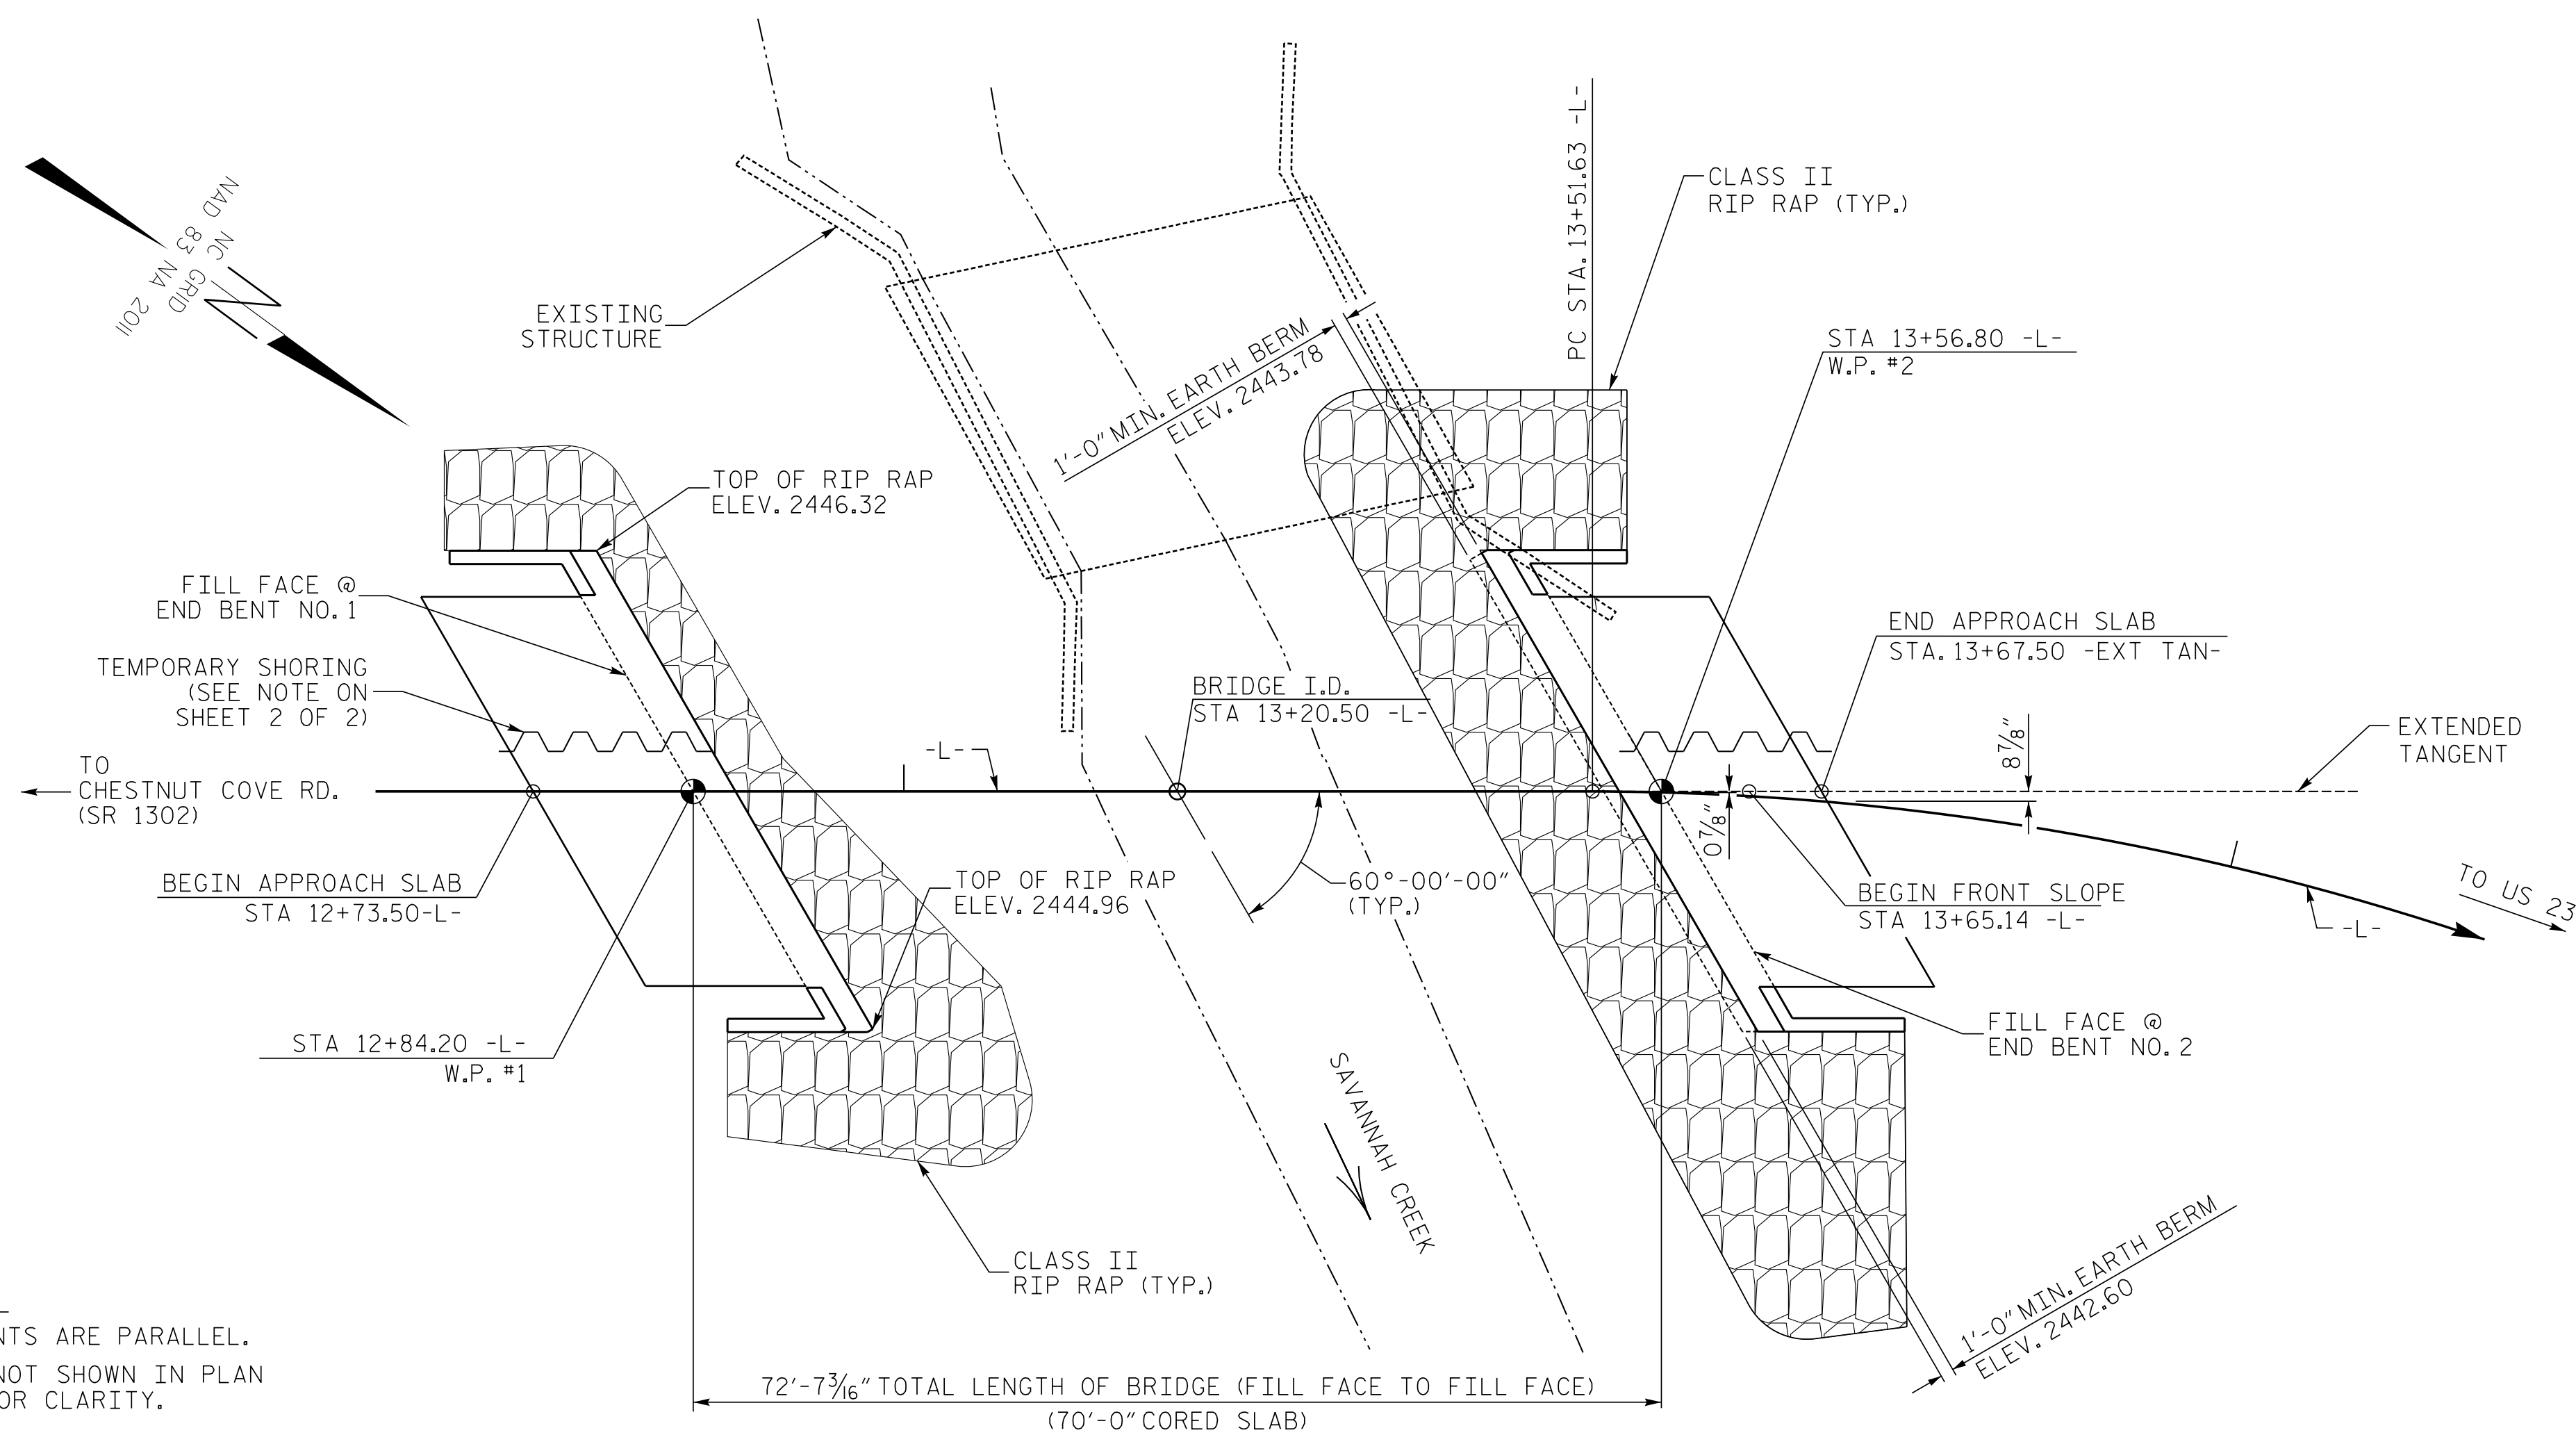

I HEREBY CERTIFY  
THAT THESE PLANS  
ARE THE AS-BUILT  
PLANS.

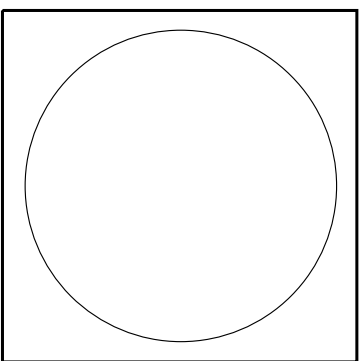

PROJECT NO. B-6034  
JACKSON COUNTY  
 STATION: 13+20.50 -L-

SHEET 1 OF 3      REPLACES BRIDGE NO. 490065

1/6/2026 | 6:49:00 AM PST



DocuSigned by:  
HARDY WILLIS

STATE OF NORTH CAROLINA  
DEPARTMENT OF TRANSPORTATION  
RALEIGH

GENERAL DRAWING  
FOR BRIDGE OVER  
SAVANNAH CREEK ON SR 1330  
(PUMPKINTOWN RD.) BETWEEN  
CHESTNUT COVE RD. (1302)  
AND US 23

REVISIONS						SHEET NO. S-1
NO.	BY:	DATE:	NO.	BY:	DATE:	
1			3			TOTAL SHEETS 20
2			4			

NOTES:             
END BENTS ARE PARALLEL.  
PILES NOT SHOWN IN PLAN  
VIEW FOR CLARITY.

DWN. BY: WDC	DATE: 5/2025
CHKD. BY: HLW	DATE: 5/2025
DES. EGR. OF RECORD: ACO	DATE: 1/2016

PLAN ALONG  $\mathbb{C}$  SURVEY -L-

**DOCUMENT NOT CONSIDERED FINAL  
UNLESS ALL SIGNATURES COMPLETED**



**Johnson, Mirmiran, & Thompson Inc.**  
4700 Falls of Neuse Rd, Suite 100,  
Raleigh, NC, 27609  
License No: C-3097