

-0.3157% +1.0076%


PI = 12+10.00 -L-
EL = 2080.36
VC = 80'

GRADE DATA -L-



+1.0076% +2.3376%

PI = 14+30.00 -L-
EL = 2082.58
VC = 80'

GRADE DATA -L-

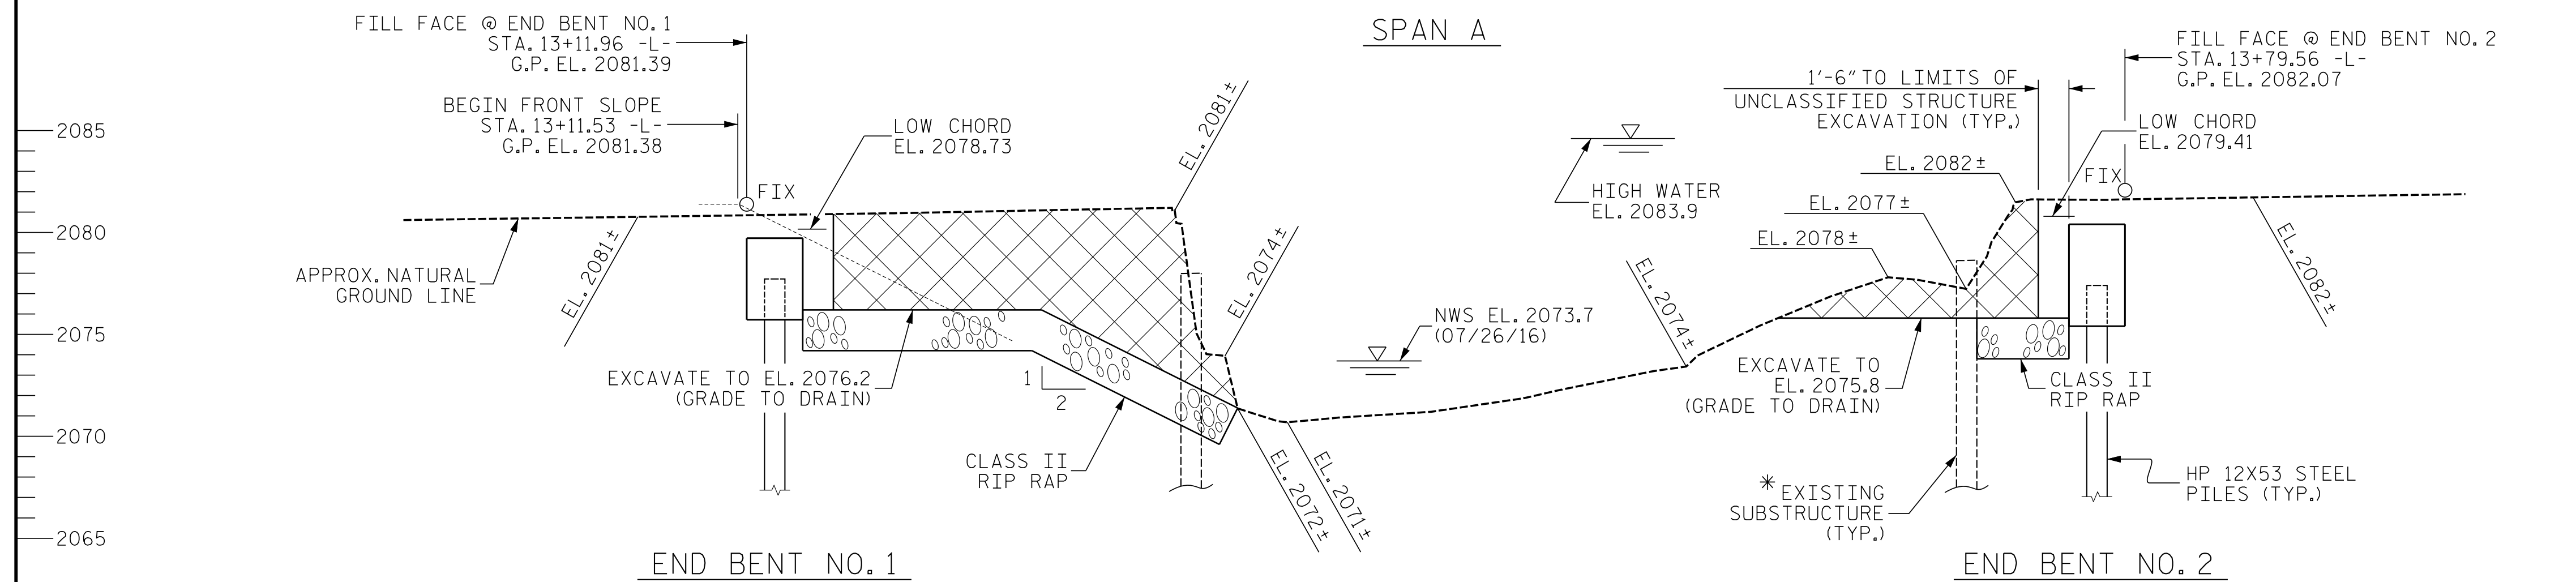

* NOTE: CONTRACTOR SHALL REMOVE EXISTING ABUTMENT AT BEGIN BRIDGE, AND SHALL CUT OFF EXISTING ABUTMENT AT END BRIDGE TO EL. 2075.8.

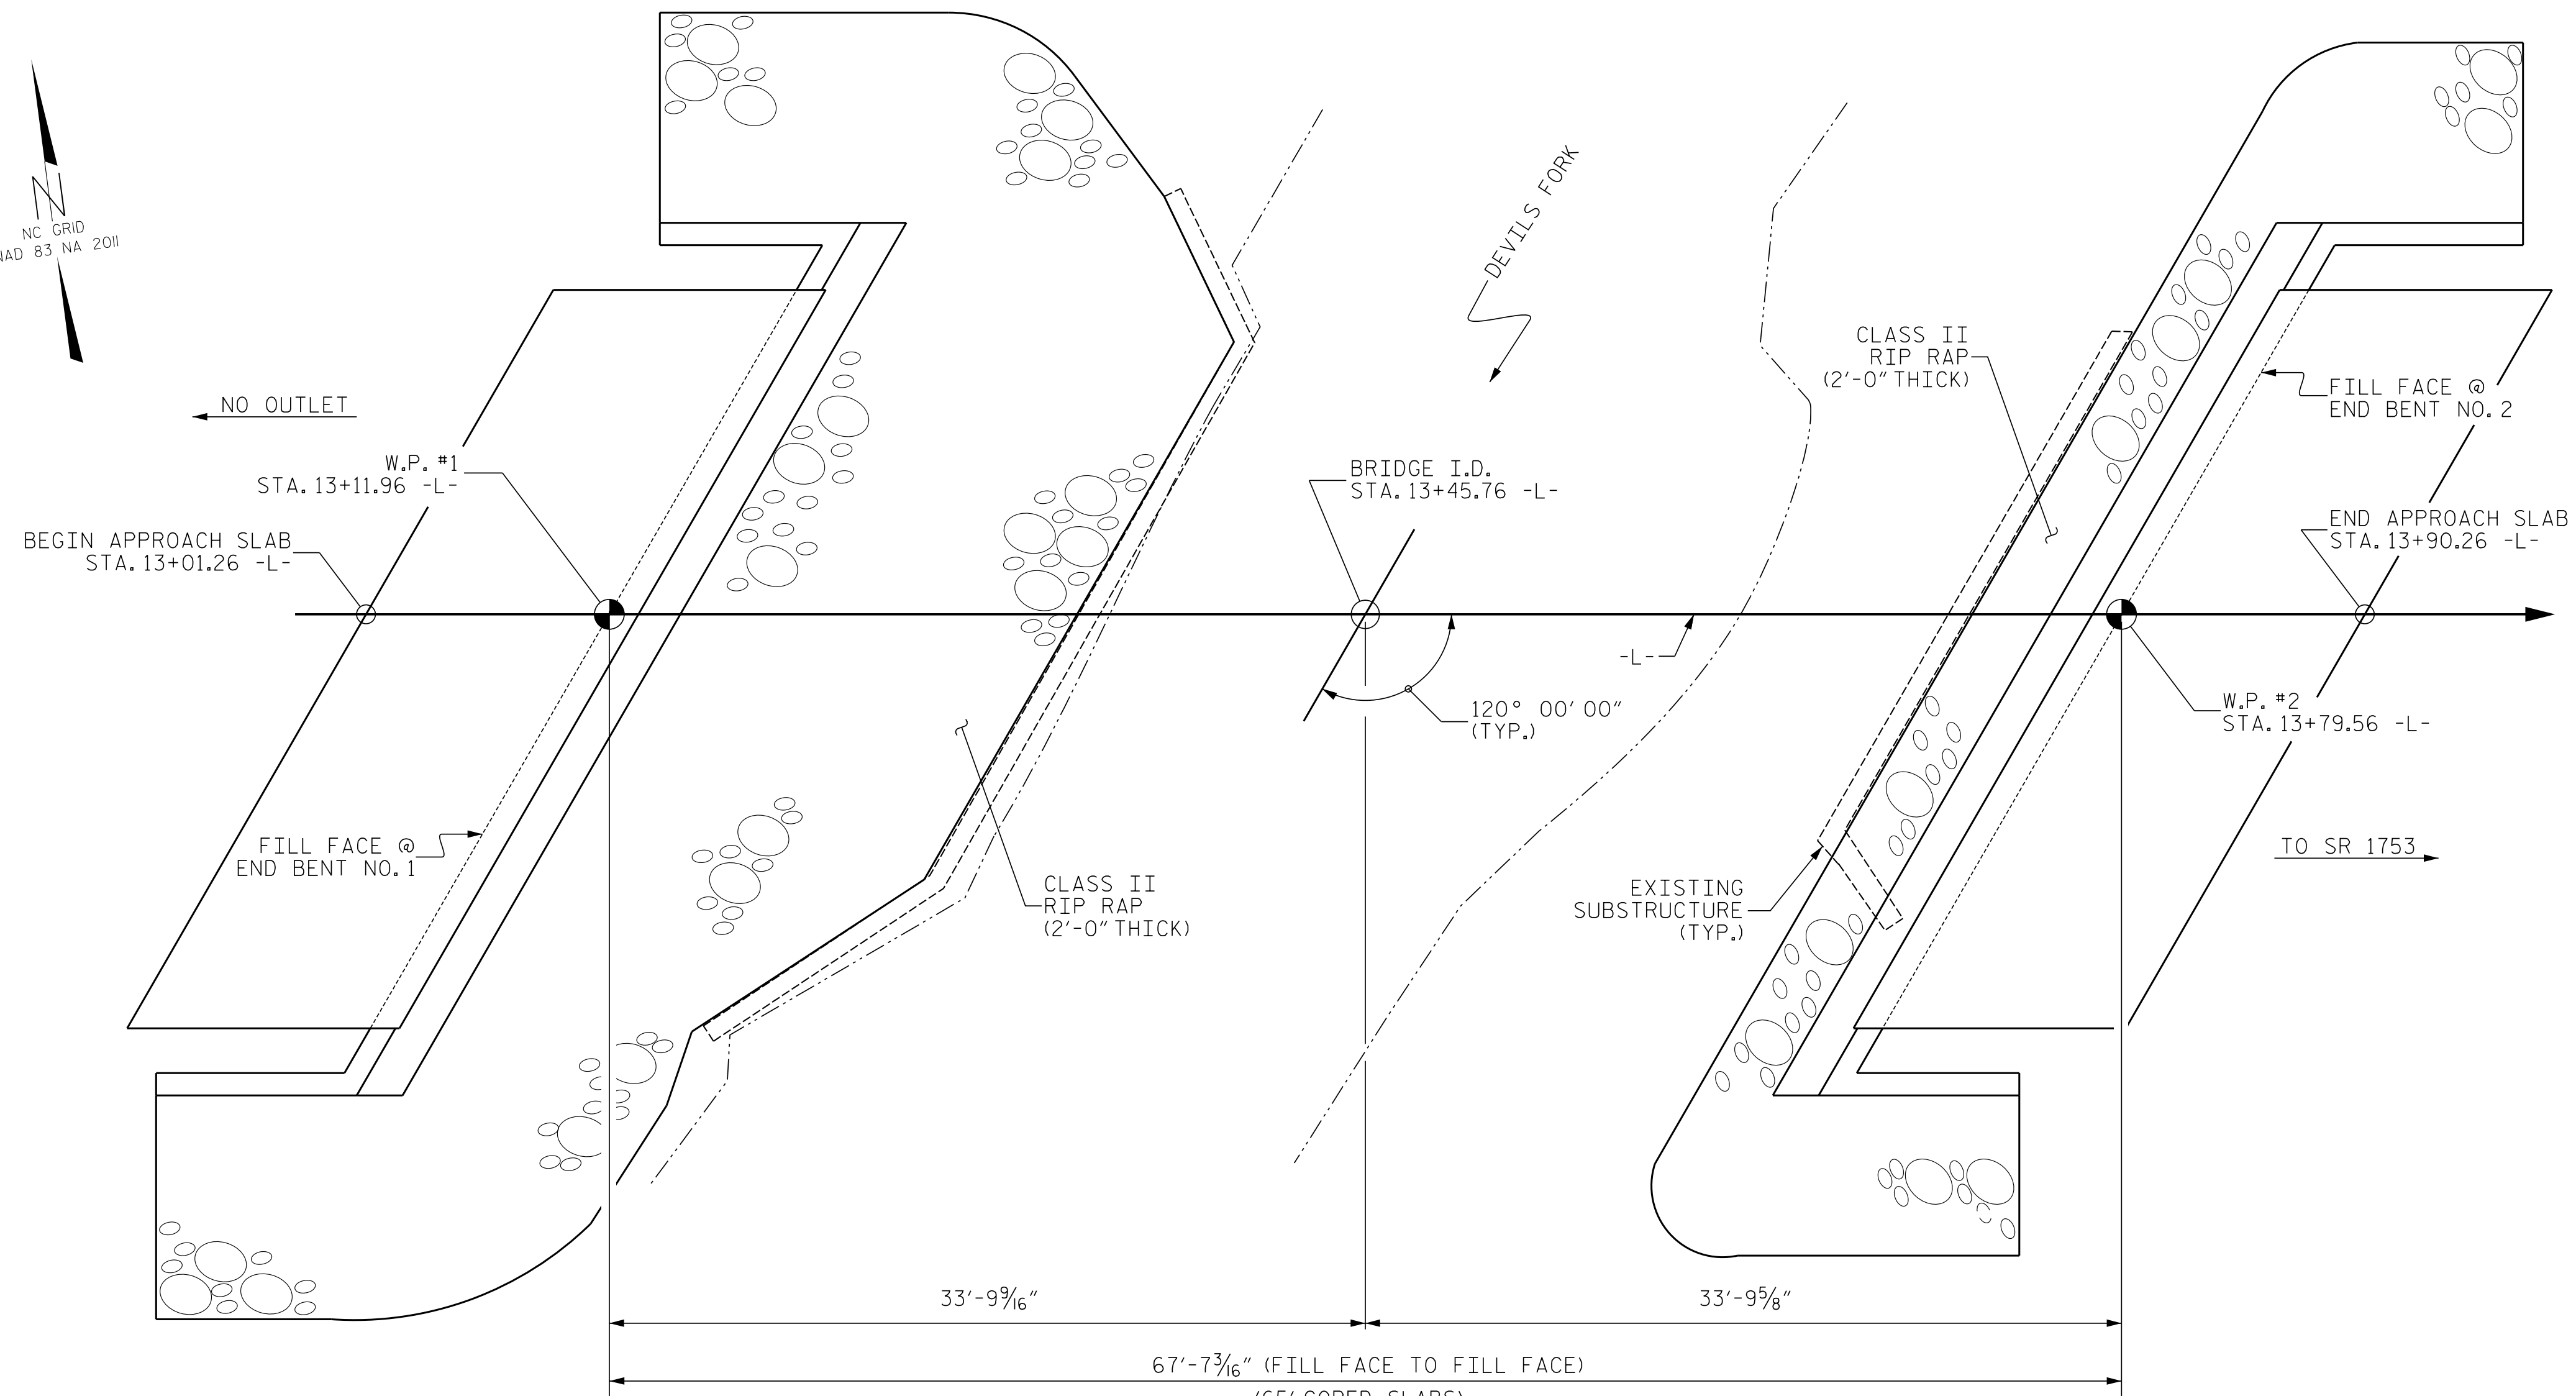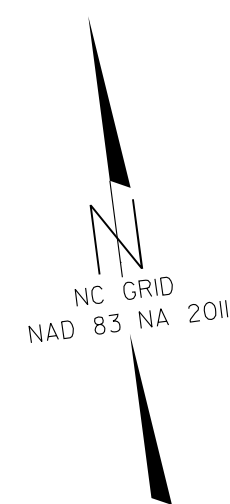

NOTES:
END BENTS ARE PARALLEL.
CORED SLABS ARE PARALLEL TO -L-.

I HEREBY CERTIFY
THAT THESE PLANS
ARE THE
AS-BUILT PLANS.

PROJECT NO. B-5929

HENDERSON COUNTY


STATION: 13+45.76 -L-

SHEET 1 OF 2 REPLACES BRIDGE #350

STATE OF NORTH CAROLINA
DEPARTMENT OF TRANSPORTATION
RALEIGH

GENERAL DRAWING

FOR BRIDGE OVER DEVILS FORK
ON TRACY GROVE RD. BETWEEN
US HWY 64 & SR 1753

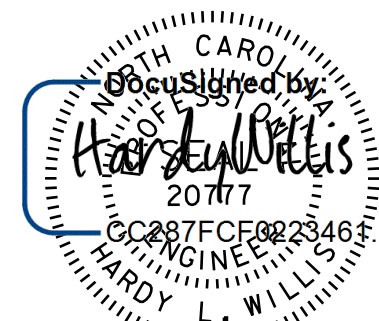

DOCUMENT NOT CONSIDERED
FINAL UNLESS ALL
SIGNATURES COMPLETED

JMT Johnson, Mirmiran, & Thompson Inc.
1318 Patton Ave Suite F,
Asheville, NC 28806
License No: C-3097

DWN. BY: WC DATE: 06/17
CHKD. BY: HLW DATE: 06/17
DSG. ENG. OF RECORD.: RTS DATE: 06/17

REVISIONS						SHEET NO.
NO.	BY:	DATE:	NO.	BY:	DATE:	
1			3			S-1
2			4			
TOTAL SHEETS						25