
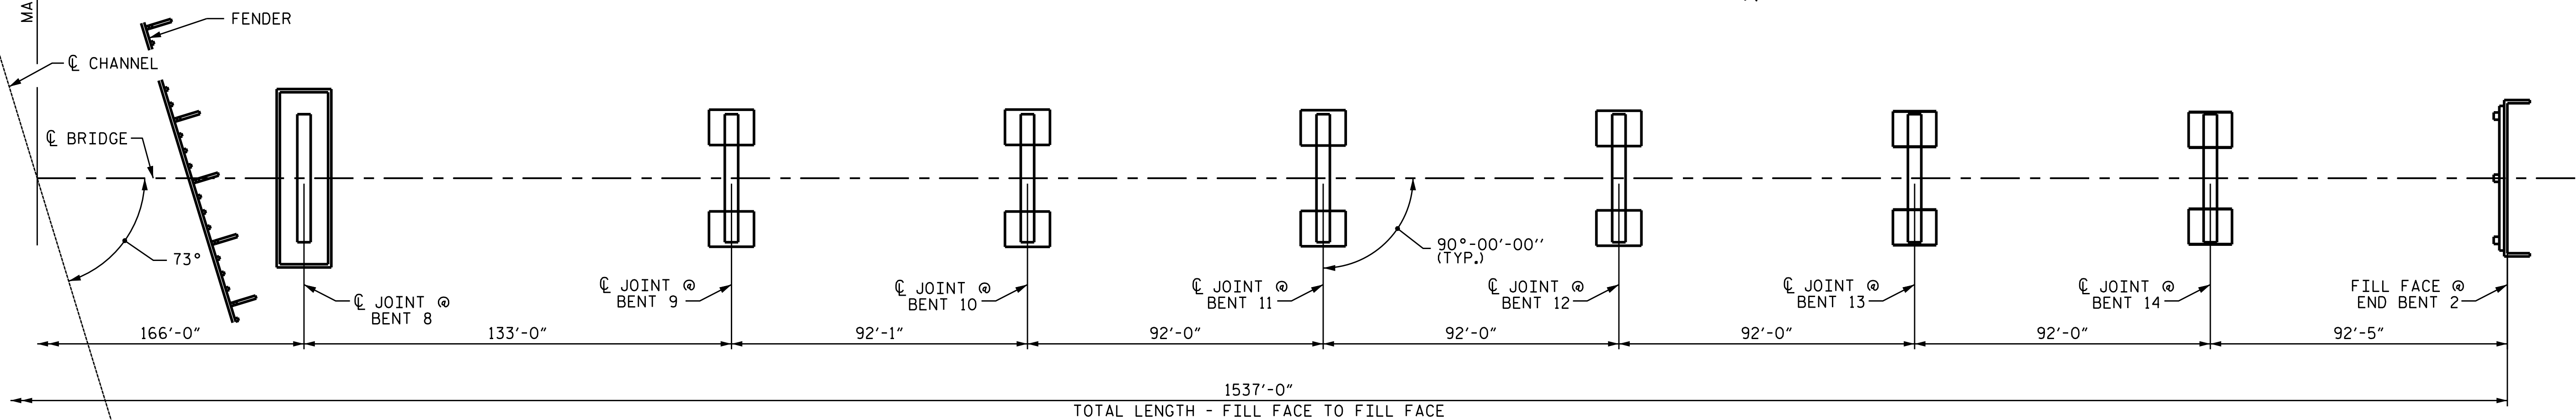


NOTE:
APPROXIMATE NATURAL GROUND AND WATER
SURFACE ELEVATION ARE FROM THE 9/9/15
ROUTINE INSPECTION REPORT.

PARTIAL SECTION ALONG BRIDGE

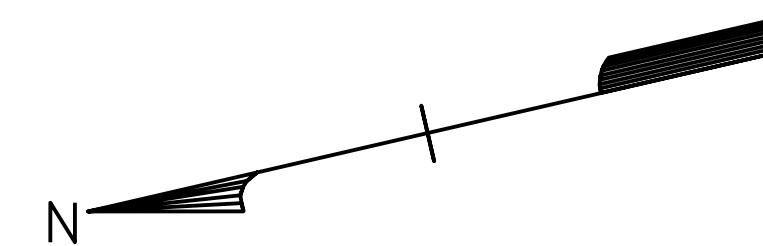

PARTIAL PLAN

(PILES NOT SHOWN FOR CLARITY)

PROJECT No. B-5942


HYDE COUNTY

BRIDGE No. 20

SHEET 2 OF 3

I HEREBY CERTIFY THESE PLANS
ARE THE AS-BUILT PLANS

DocuSigned by:
Brandon L. Green

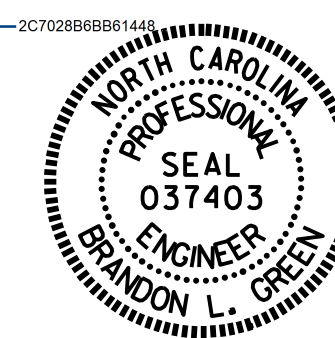

3/7/2017

STATE OF NORTH CAROLINA
DEPARTMENT OF TRANSPORTATION
RALEIGH
GENERAL DRAWING FOR
BRIDGE ON U.S. 264
OVER INTRACOASTAL
WATERWAY

DRAWN BY : R.W. WRIGHT DATE : 10/15
CHECKED BY : P.C. BREWER DATE : 10/15
DESIGN ENGINEER OF RECORD: - DATE : -

02-MAR-2017 10:08
R:\Structures\Plans\B5942.SMU. FinalPlans.dgn
bgreen

DOCUMENT NOT CONSIDERED
FINAL UNLESS ALL
SIGNATURES COMPLETED

REVISIONS						SHEET .
	BY:	DATE:		BY:	DATE:	
1			3			S-2
2			4			TOTAL SHEETS 30