


Scale 1"=800' 1 centimeter = 96 meters Scale Ratio 1:9600

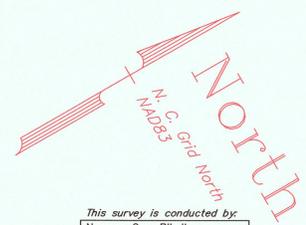


This survey is conducted by
 Norman Grey Ribelin
 dba/
 Ribelin Land Surveying, Inc.
 C-1693
 333 Surveyors Drive
 Salisbury, N. C. 28146-1538
 Ph. (704) 633-2995

I, NORMAN GREY RIBELIN, CERTIFY TO THE BEST OF MY BELIEF AND KNOWLEDGE THAT THESE MEASUREMENTS WERE CONDUCTED BY MYSELF IN MARCH OF 1990 AND REVISED IN 1991, 1993, AND 1995 AND THAT THE CITY BOUNDARY IS REPRESENTED AS THAT OF LATE 2015.

Norman Grey Ribelin 7-1-15
 N. C. LICENSE # L-2674 Date
 NORMAN GREY RIBELIN



Electronically transmitted drawings. Drawings that are transmitted electronically to a client or a governmental agency shall have the computer-generated seal removed from the original file. The electronic media shall have the following inserted in lieu of the signature and date: This document originally issued and sealed by (NORMAN GREY RIBELIN), (L-2674), on (July 01, 2012). This media shall not be considered a certified document.

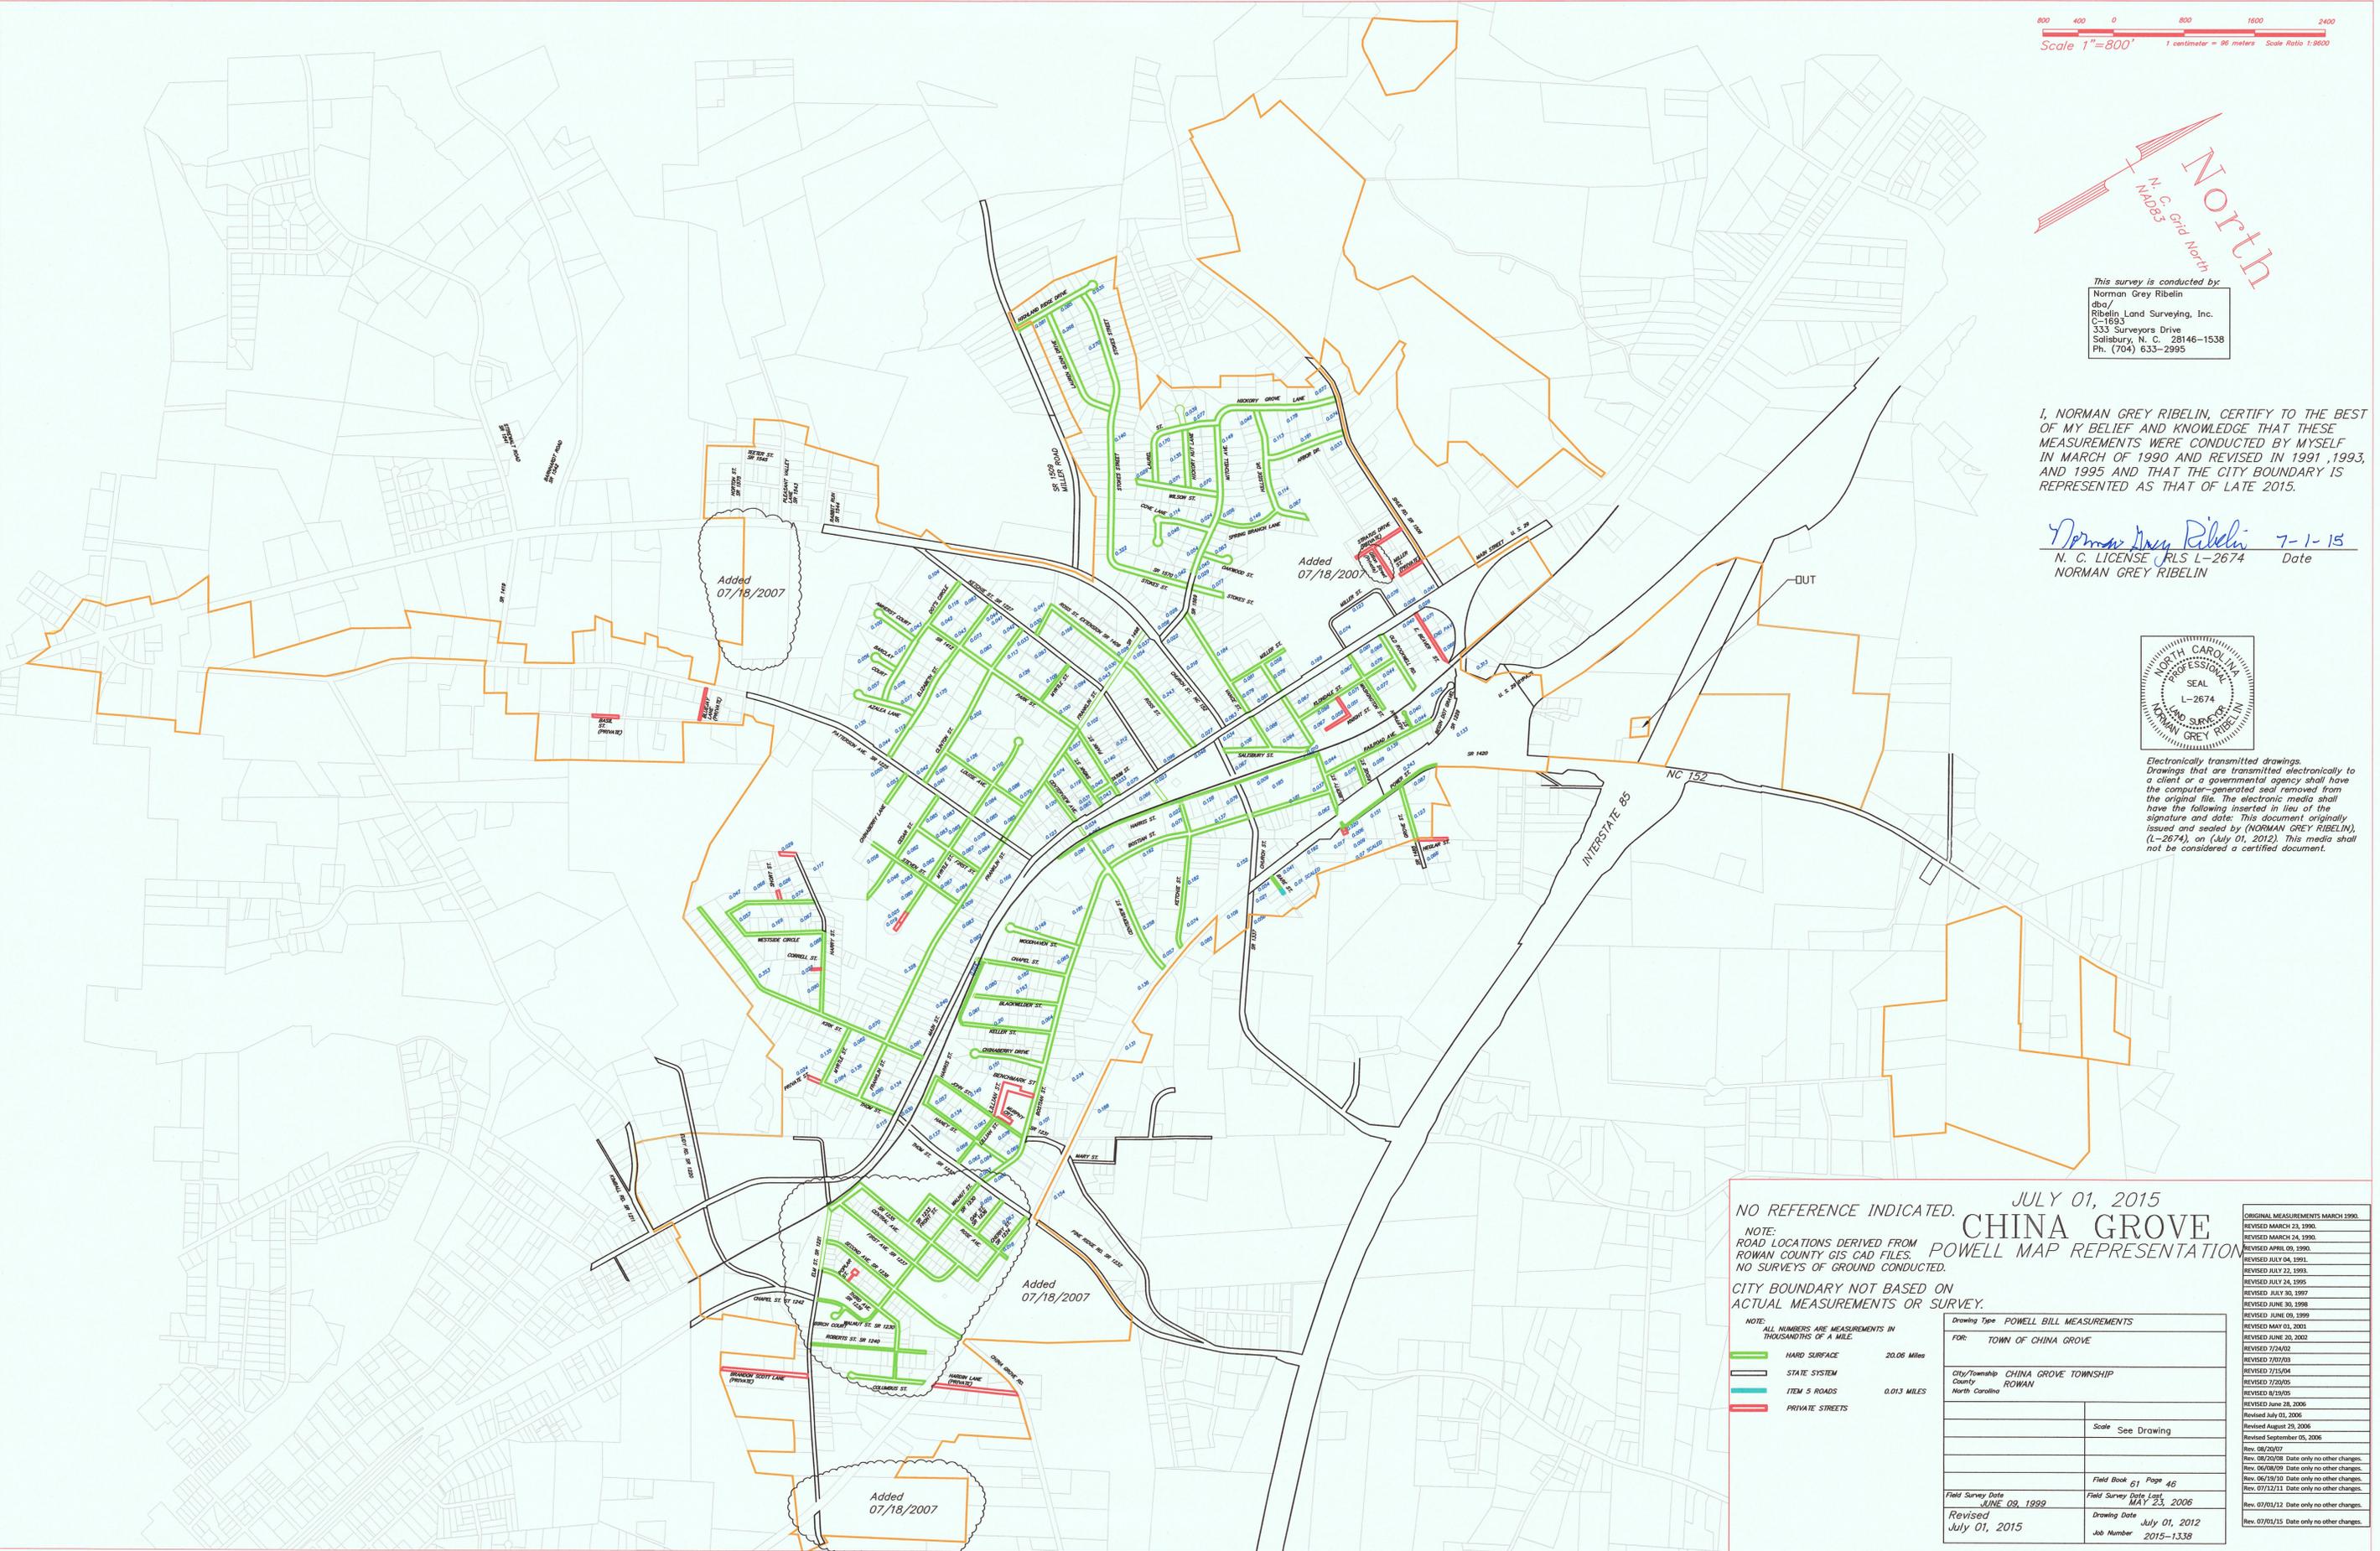

NO REFERENCE INDICATED. JULY 01, 2015
CHINA GROVE
 NOTE: ROAD LOCATIONS DERIVED FROM ROWAN COUNTY GIS CAD FILES. POWELL MAP REPRESENTATION
 NO SURVEYS OF GROUND CONDUCTED.

CITY BOUNDARY NOT BASED ON ACTUAL MEASUREMENTS OR SURVEY.

NOTE: ALL NUMBERS ARE MEASUREMENTS IN THOUSANDTHS OF A MILE.
 20.06 Miles
 0.013 Miles

Legend:
 [Green line] HARD SURFACE
 [Blue line] STATE SYSTEM
 [Orange line] ITEM 5 ROADS
 [Red line] PRIVATE STREETS

Drawing Type	POWELL BILL MEASUREMENTS
FOR:	TOWN OF CHINA GROVE
City/Township	CHINA GROVE TOWNSHIP
County	ROWAN
Scale	See Drawing
Field Book	61 Page 46
Field Survey Date	JUNE 09, 1999
Field Survey Date List	MAY 23, 2006
Revised	July 01, 2015
Drawing Date	July 01, 2012
Job Number	2015-1338

ORIGINAL MEASUREMENTS	MARCH 1990
REVISED	MARCH 23, 1990
REVISED	MARCH 24, 1990
REVISED	APRIL 09, 1995
REVISED	JULY 04, 1991
REVISED	JULY 22, 1993
REVISED	JULY 24, 1995
REVISED	JULY 30, 1997
REVISED	JUNE 30, 1998
REVISED	JUNE 09, 1999
REVISED	MAY 01, 2001
REVISED	JUNE 20, 2002
REVISED	7/24/02
REVISED	7/07/03
REVISED	7/15/04
REVISED	7/20/05
REVISED	8/15/05
REVISED	June 28, 2006
REVISED	July 01, 2006
REVISED	August 29, 2006
REVISED	September 05, 2006
Rev.	08/20/07
Rev.	08/20/08 Date only no other changes.
Rev.	06/08/09 Date only no other changes.
Rev.	06/19/10 Date only no other changes.
Rev.	07/12/11 Date only no other changes.
Rev.	07/01/12 Date only no other changes.
Rev.	07/01/15 Date only no other changes.