


BRIDGE AS-BUILT EXAMPLE

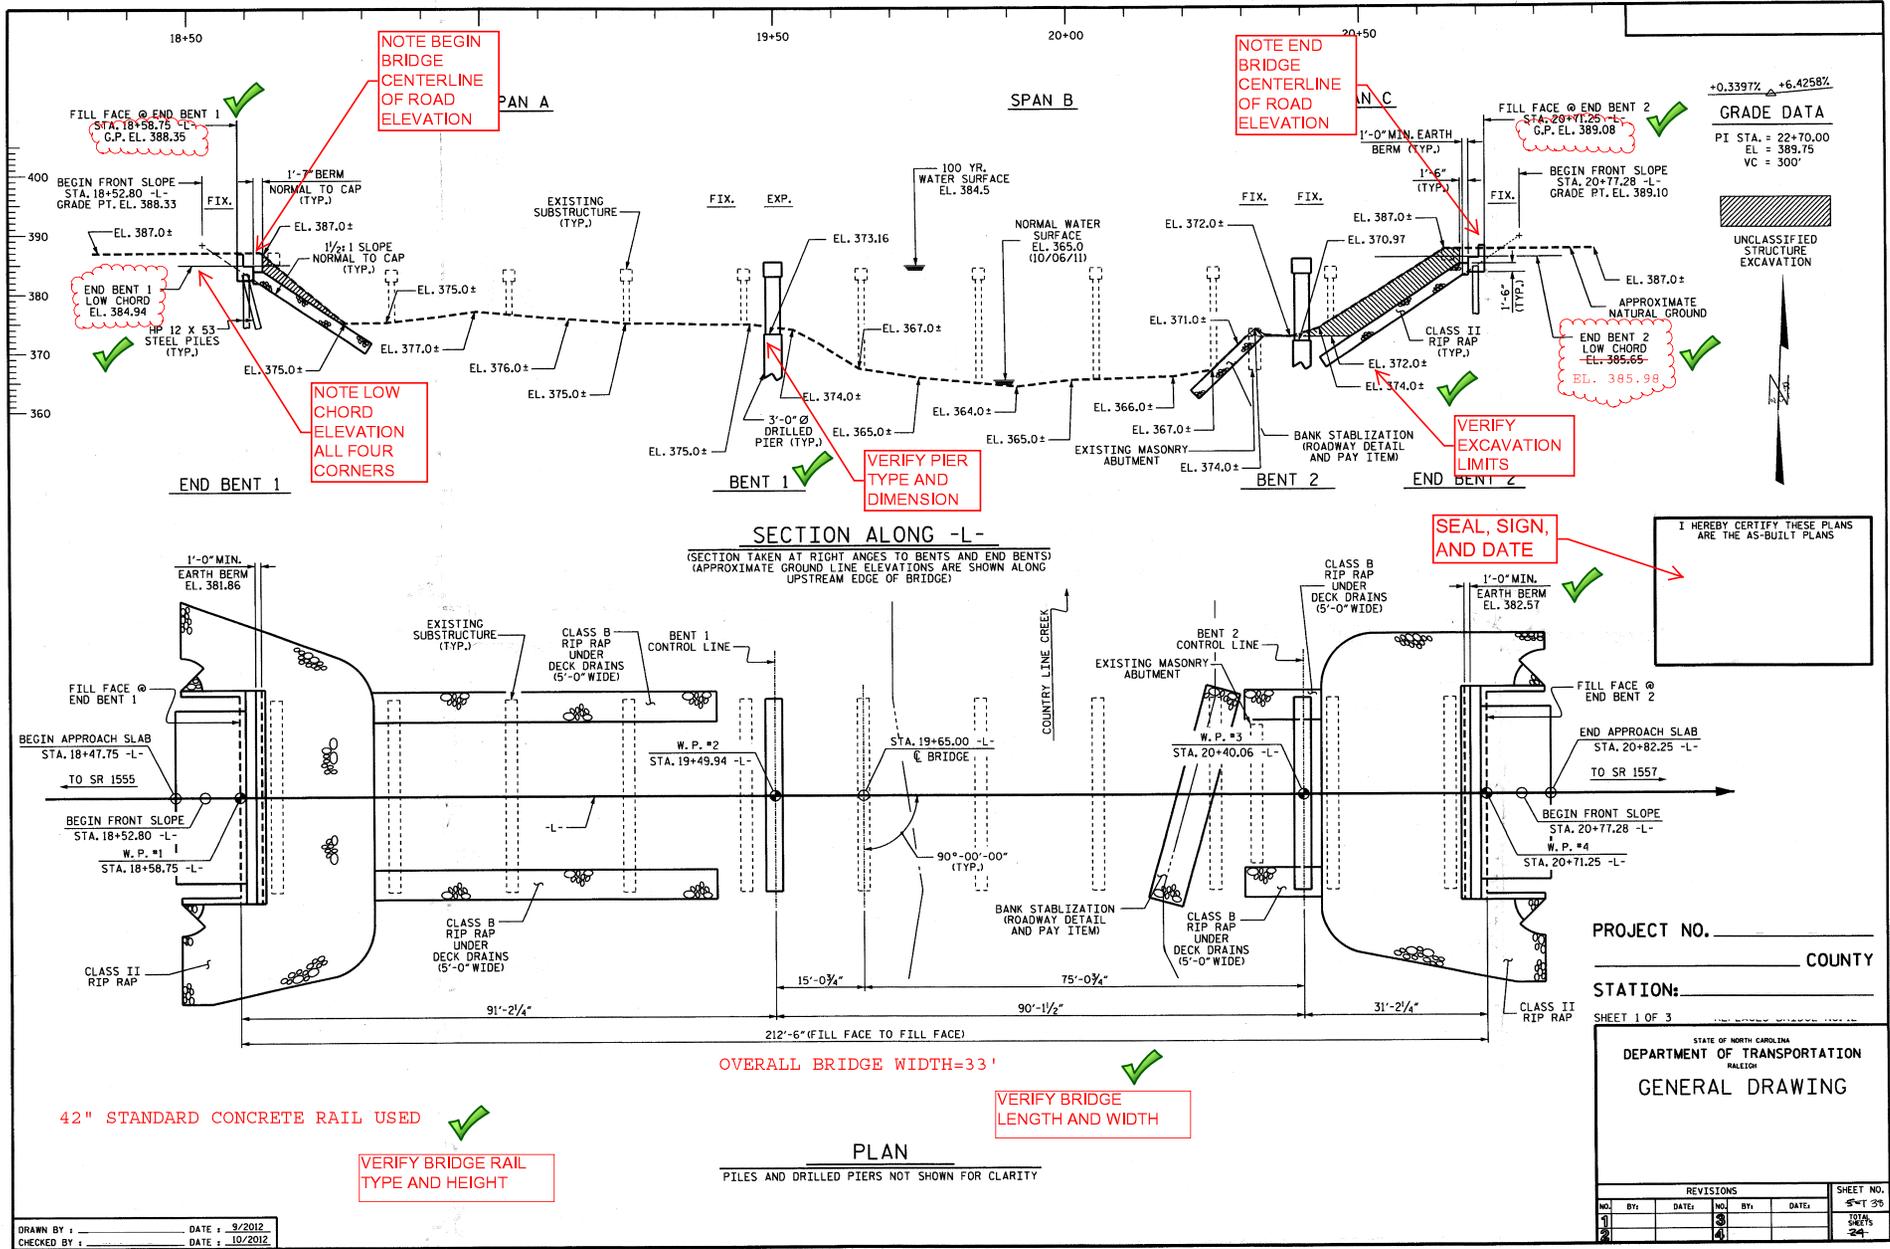

DRAWN BY: _____ DATE: 9/2012
 CHECKED BY: _____ DATE: 10/2012

PROJECT NO. _____ COUNTY _____
 STATION: _____
 SHEET 1 OF 3

REVISIONS					SHEET NO.
NO.	BY	DATE	NO.	DATE	5-T 38
1			3		2012
2			4		24

PLAN
 PILES AND DRILLED PIERS NOT SHOWN FOR CLARITY