
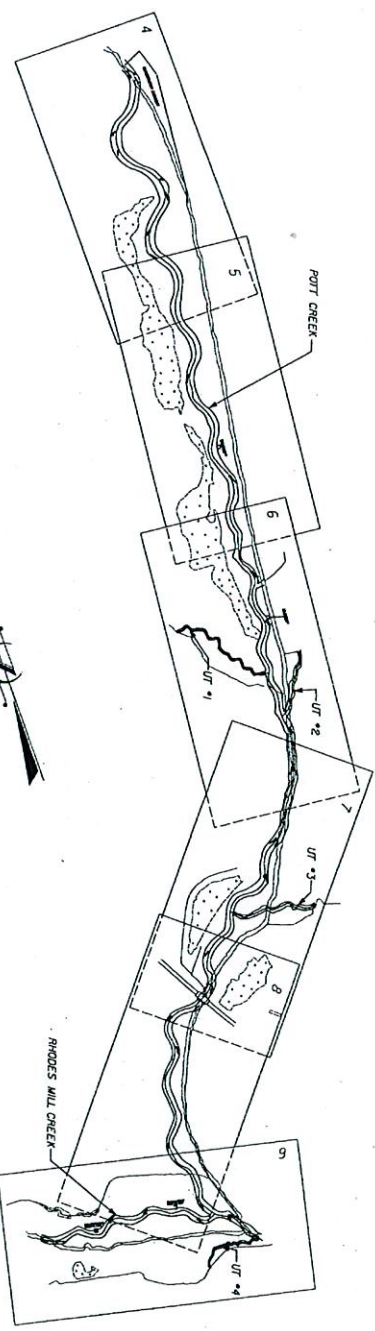


CATAWBA COUNTY

POTT CREEK II STREAM RESTORATION PROJECT

LOCATION: POTT CREEK II RESTORATION SITE NORTH & SOUTH OF SR 2023 (PAINT SHOP ROAD) WEST OF WADEEN, NORTH CAROLINA

AS BUILT PLANS

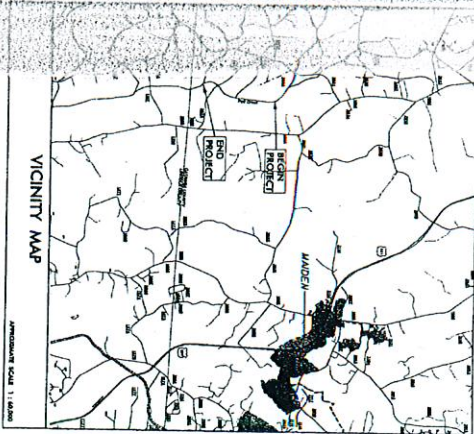

SHEET NUMBER	SHEET	TITLE SHEET	PLAN SHEETS
1	1		4 - 9

REVISIONS		SCALE AS SHOWN	DATE	BY	PROJECT ENGINEER	PROJECT MANAGER	PLANS PREPARED FOR	TITLE SHEET	SHEET OF
						RICHARD K. MOGENSEN, P.E.	EarthMark companies EARTHMARK COMPANIES 530 AVIATION BOULEVARD SUITE 100 CONCORD, NC 28027 (704) 782-4033	Roostertan Environmental Engineering	7

ROCK C

J HOOK




MATCH TO SHEET 5



PROJECT ENGINEER

PROJECT REFERENCE NO.	SHEET NO.
POTT CREEK II STREAM RESTORATION	4

PLAN & PROFILE
EarthMark
companies

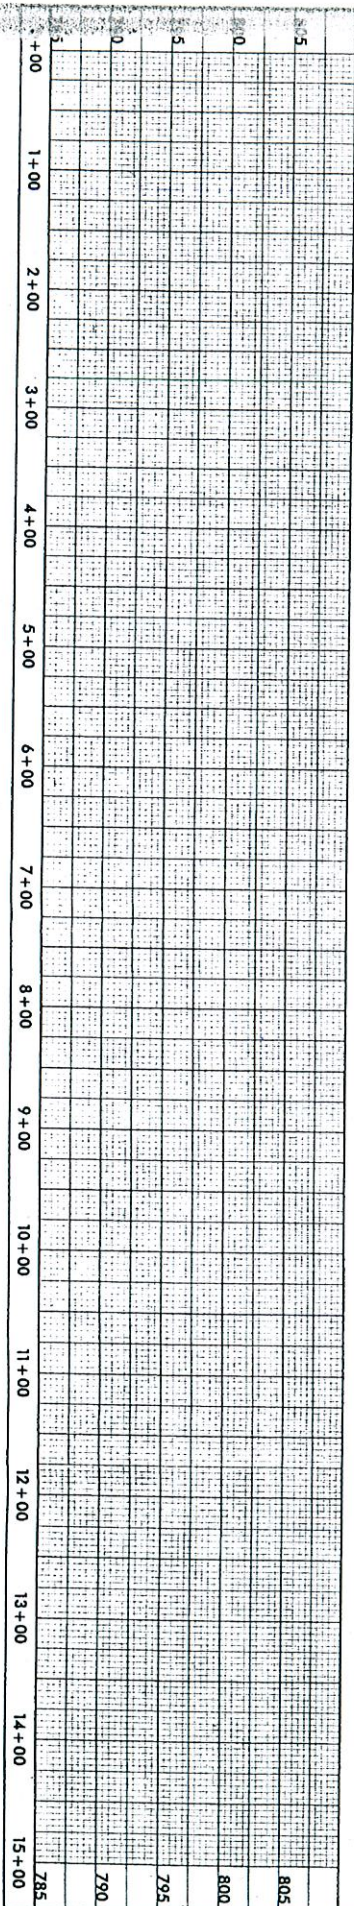

J HOOK



PROJECT NUMBER



PROJECT REFERENCE NO. SHEET NO.
POTT CREEK II STREAM RESTORATION 5

PLAN & PROFILE

EarthMark
companies

MATCH TO SHEET 4

MATCH TO SHEET 6

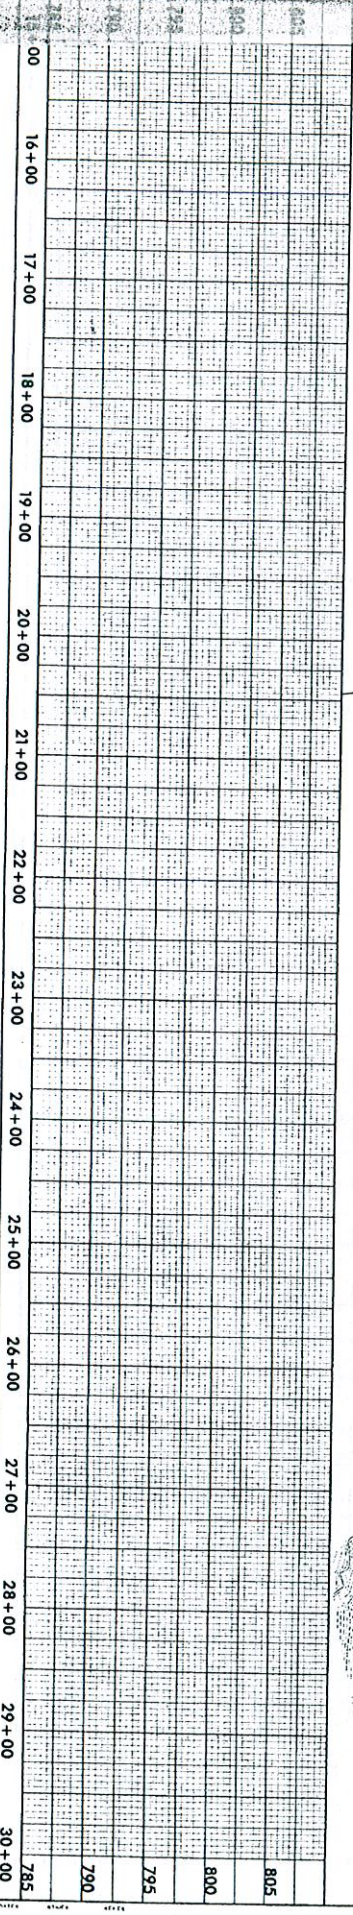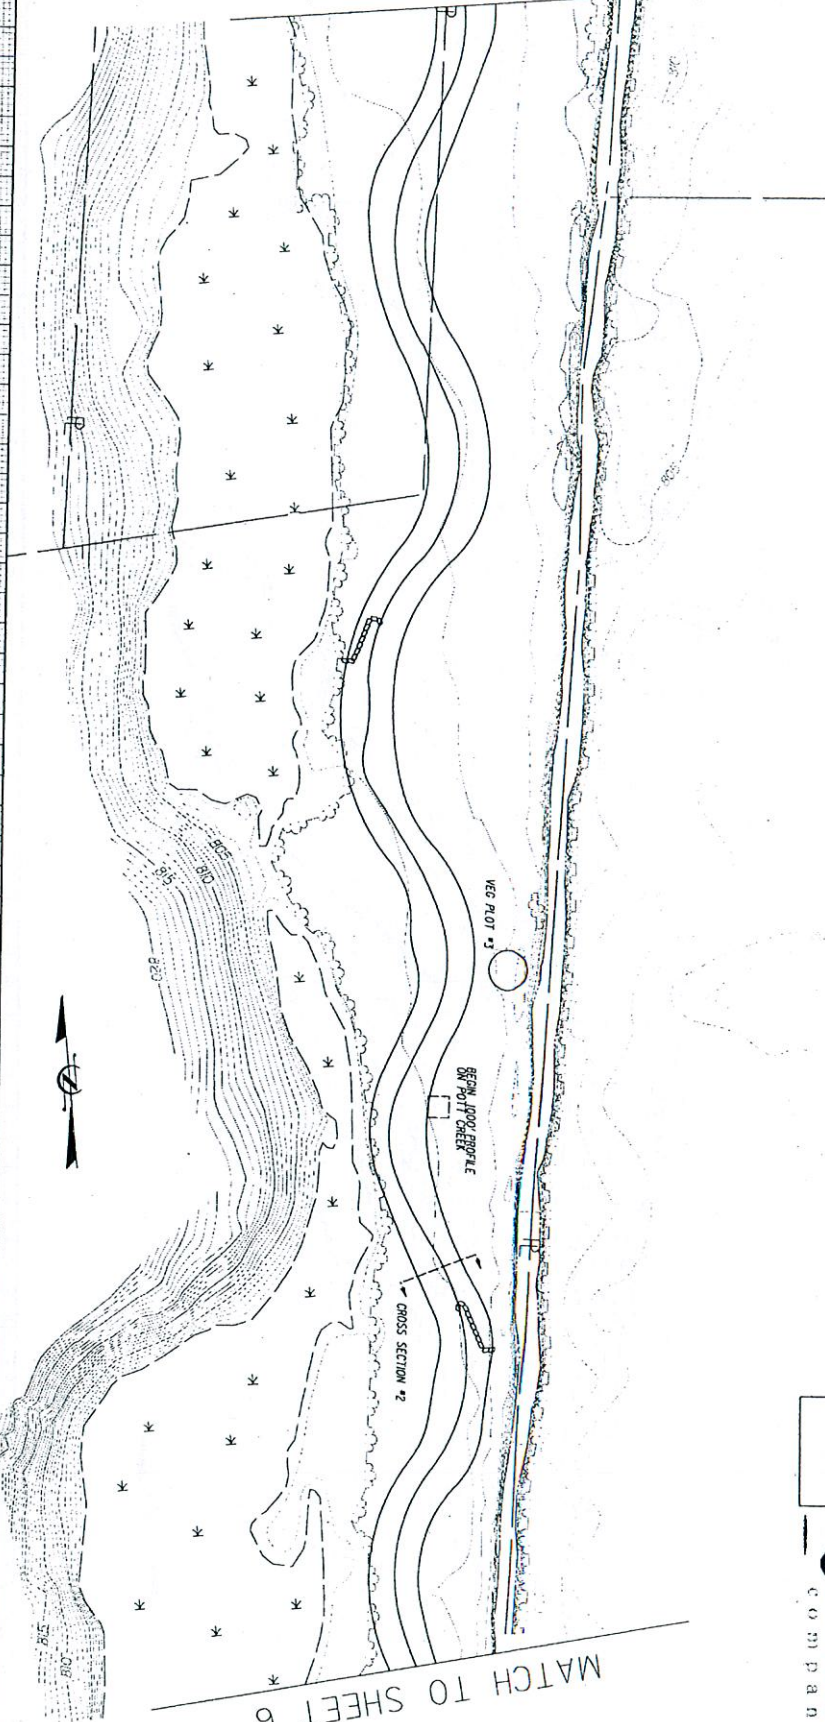

J HOOK — ROCK VANE





PROJECT REFERENCE NO. SHEET NO. 8

POTT GREEN II STREAM RESTORATION

PLAN & PROFILE


EarthMark
companies

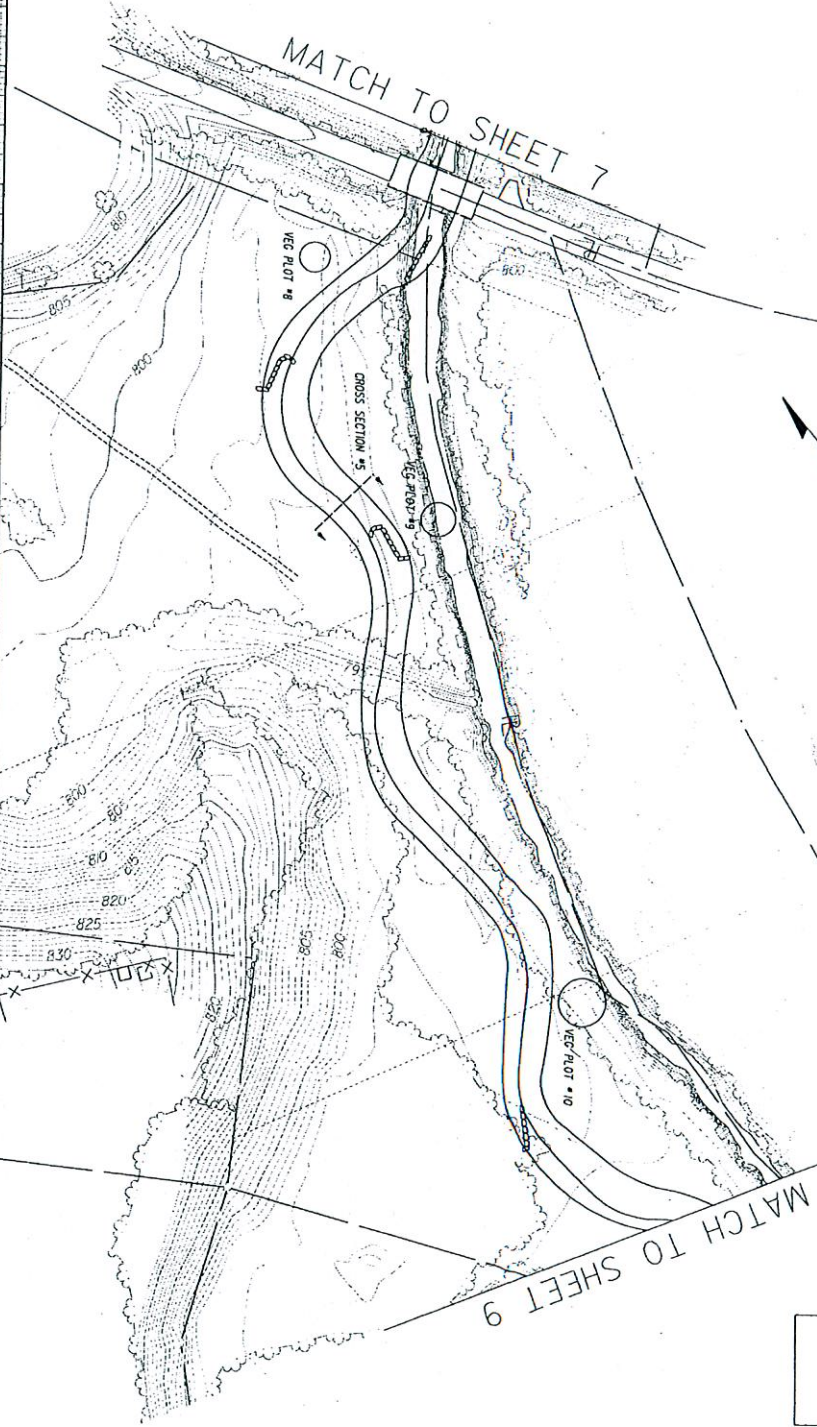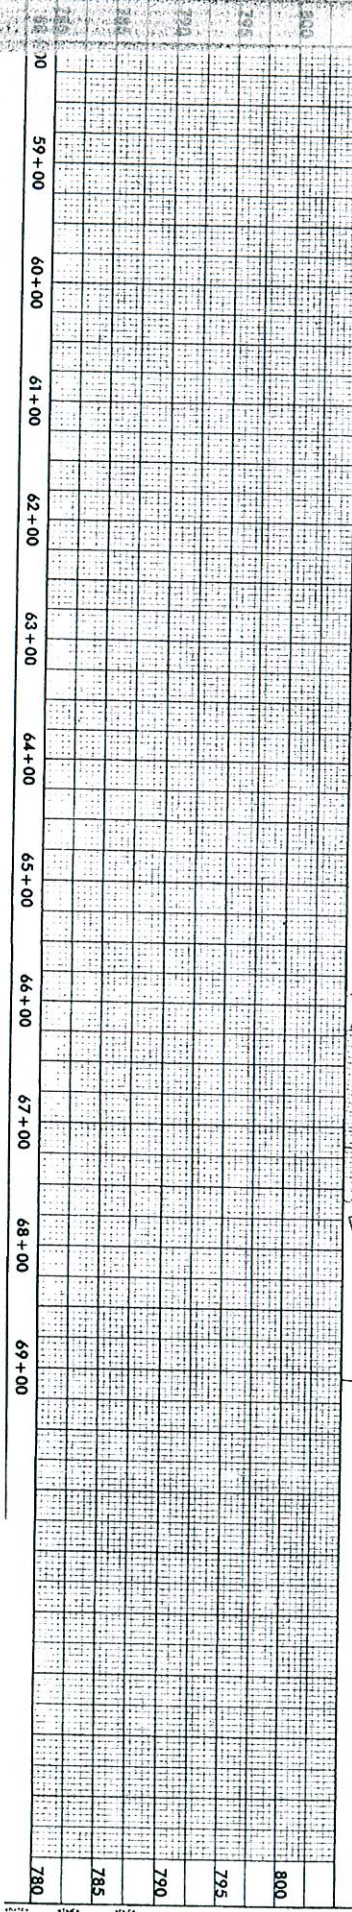

MATCH TO SHEET 8



PROJECT REFERENCE NO.	SHEET NO.
POIT CREEK II STREAM RESTORATION	5
PLAN & PROFILE 	

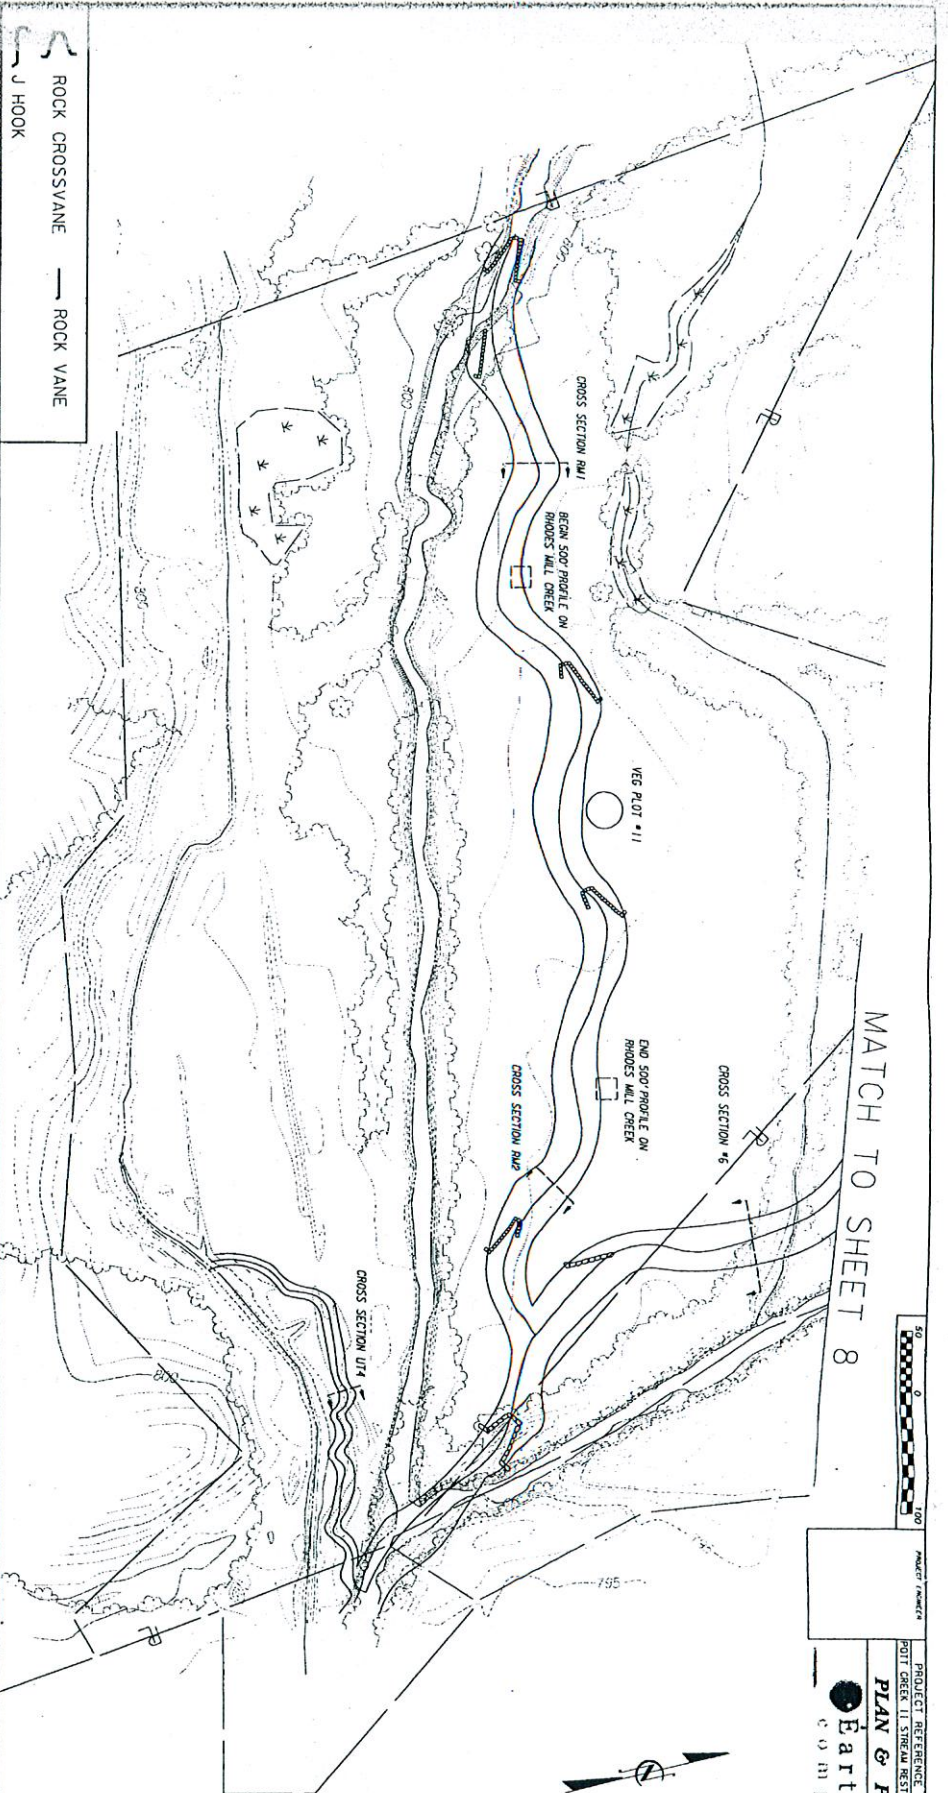

ROCK CROSSVANE
 ROCK VANE
 J HOOK

