



FIGURE 9 - 5

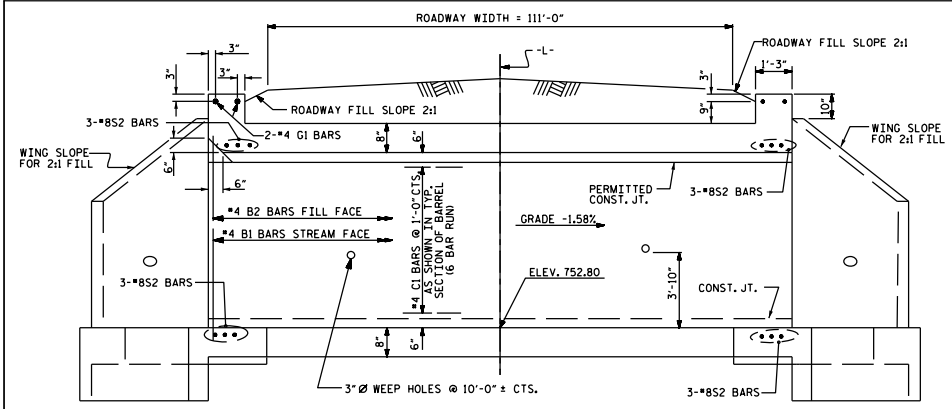

CULVERT SECTION NORMAL TO ROADWAY

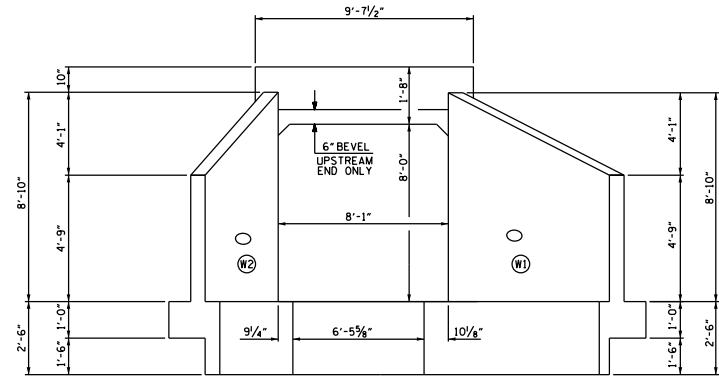


END ELEVATION NORMAL TO SKEW

I HEREBY CERTIFY THESE PLANS ARE THE AS-BUILT PLANS

PROJECT NO. EXAMPLE
 COUNTY _____
 STATION: _____


STATE OF NORTH CAROLINA
 DEPARTMENT OF TRANSPORTATION
 RALEIGH
 SINGLE 7 FT. X 8 FT.
 CONCRETE BOX CULVERT
 60° SKEW

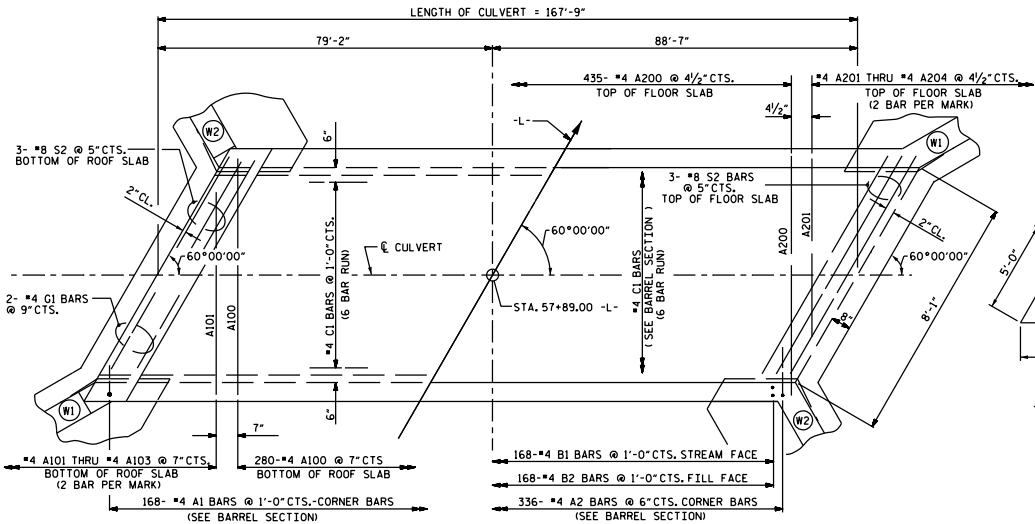

PART PLAN - ROOF SLAB

PART PLAN - FLOOR SLAB

SKEW TRIANGLE

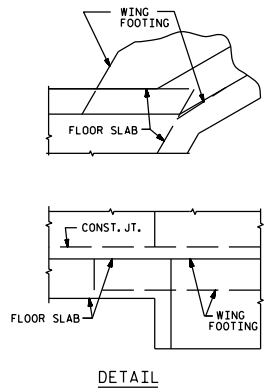

CONNECTION OF WING FOOTING AND FLOOR SLAB WHEN SLAB IS THICKER THAN FOOTING

DRAWN BY: _____ DATE: _____
 CHECKED BY: _____ DATE: _____
 DESIGN ENGINEER OF RECORD: _____ DATE: _____

| | | | | | | | |
|---|-----------|----|------|-----|----|------|---------------------------|
| DOCUMENT NOT CONSIDERED FINAL UNLESS ALL SIGNATURES COMPLETED | REVISIONS | | | | | | SHEET NO. TOTAL SHEETS |
| | NO. | BY | DATE | NO. | BY | DATE | |
| | 1 | | | 2 | | | |