
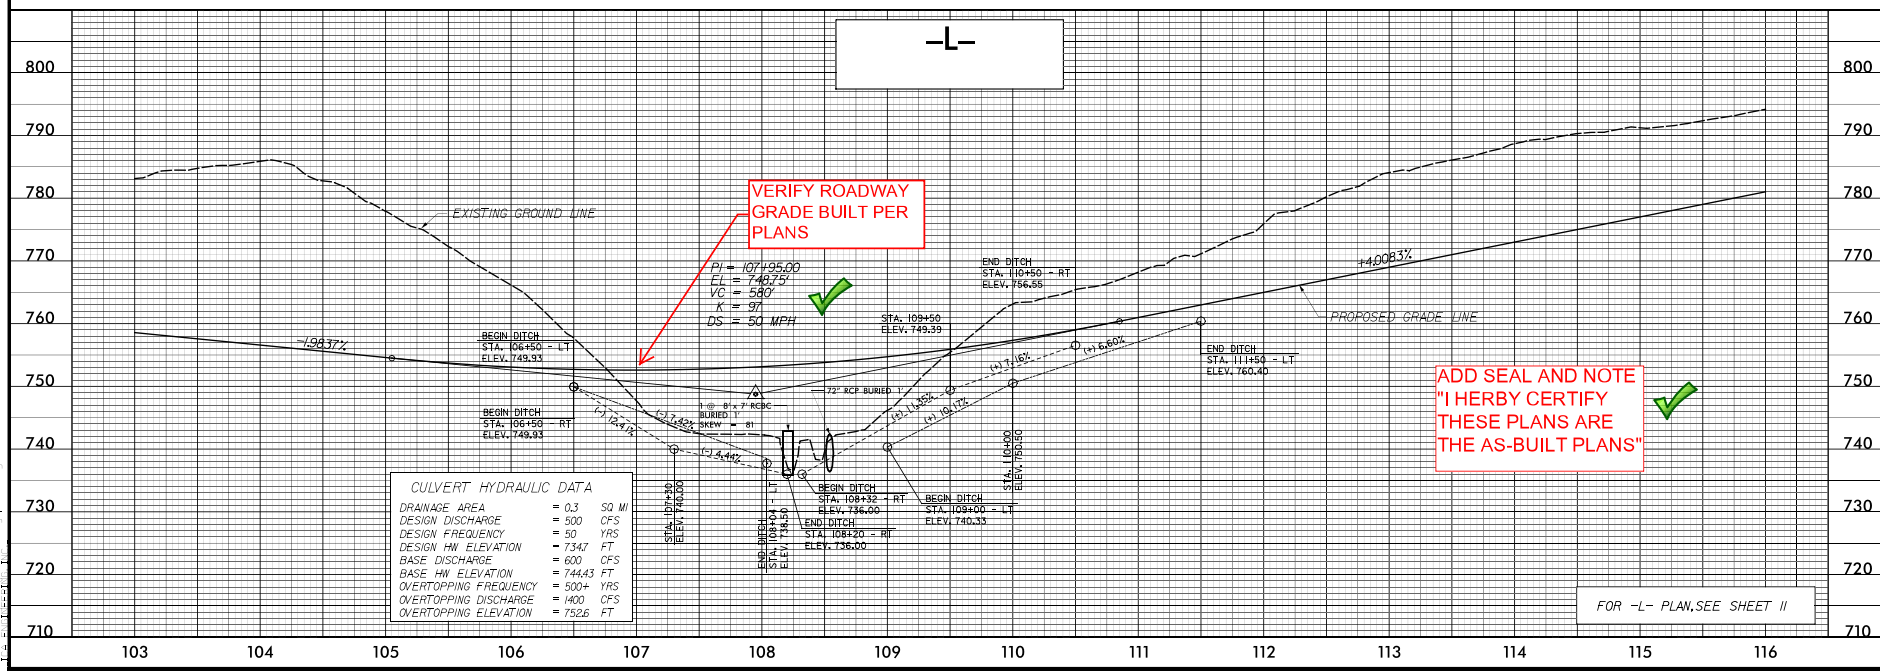


CULVERT AS-BUILT ROADWAY PROFILE VIEW EXAMPLE

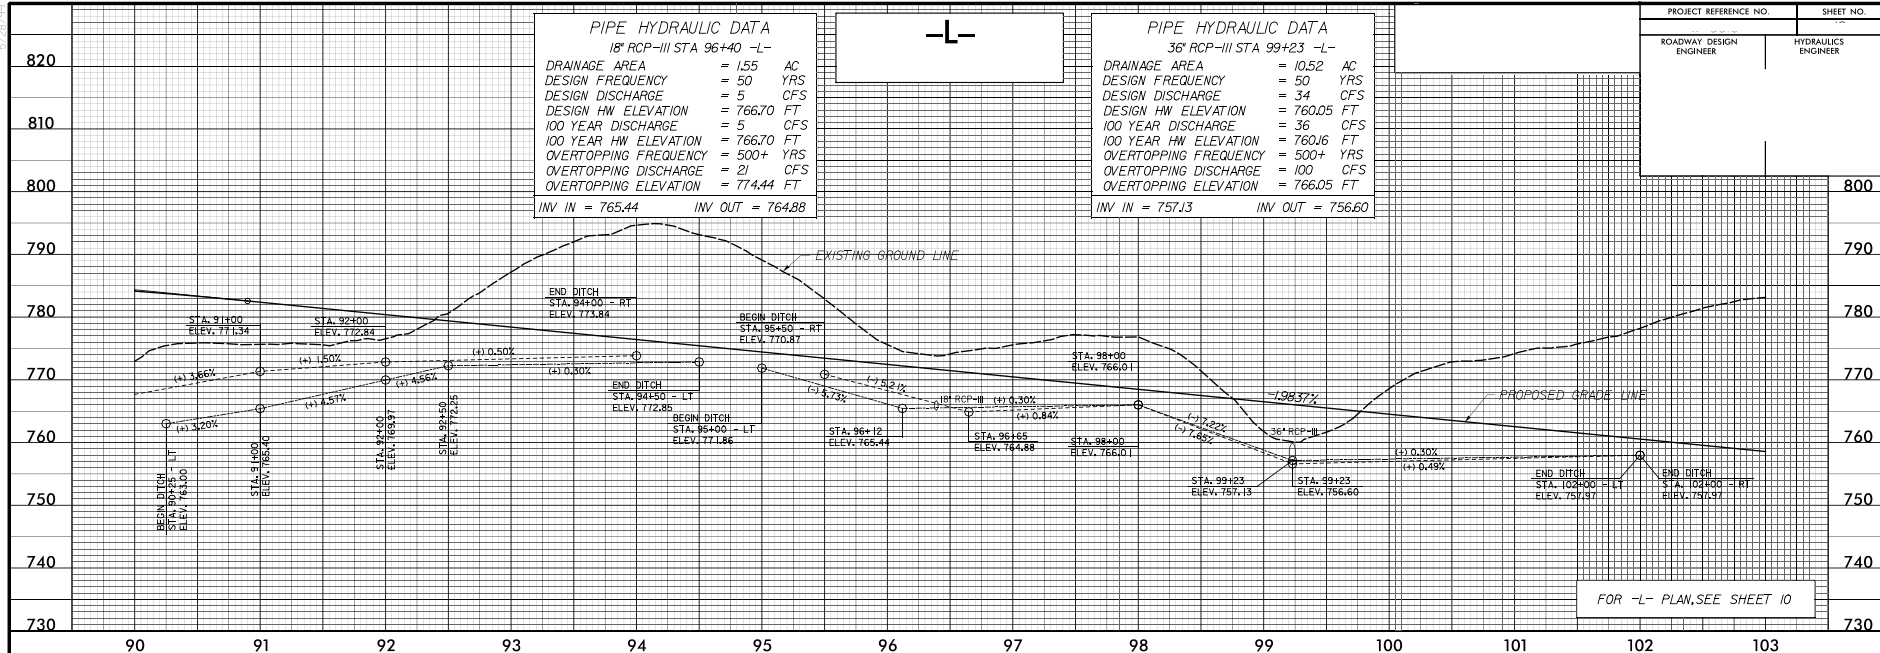

PROJECT REFERENCE NO.	SHEET NO.
ROADWAY DESIGN ENGINEER	HYDRAULICS ENGINEER

5/23/2019

5/23/2019