




STATE OF NORTH CAROLINA
DEPARTMENT OF TRANSPORTATION

ROY COOPER
GOVERNOR

J. ERIC BOYETTE
SECRETARY

February 1, 2022

ADDENDUM # 1

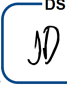To: Plan Holders
From: Josh Deyton, P.E. 
Project Team Lead

RE: **Pay Item Addition, SP Addition, Roadway Plan Revision,
Structure Plan Revision**
Contract ID: DN00132
County: Macon
Letting Date: February 8, 2022

The above contract has experienced the following revisions:

1. Pay Item Addition

On page T-4 of the proposal, after item 0061 REFORESTATION, add the following pay item:

| | | | | |
|------|--------------|----|--|-----------|
| 0079 | 3563000000-E | SP | TEMP *** WOVEN WIRE FENCE, COMPLETE W/POSTS (60) | 270 LF |
|------|--------------|----|--|-----------|

See attached page T-4 showing this revision.

2. SP Addition

On page G-49 of the proposal, add the following special provision:

SP8 R85 – TEMPORARY WOVEN WIRE FENCE

See attached page G-49 showing this SP addition.

3. Roadway Plan Revision

Sheet 4 of the roadway plans has been revised to show the addition of the Temporary Woven Wire fence item.

See attached sheet 4 showing this revision.

4. Structure Plan Revision

The structure plans have been revised to show the exterior cored slabs bolted down instead of connected to the cap with a dowel.

See attached structure sheets showing these revisions.

Please access ebs addenda files on Bid Express®.

Thank you for your attention to this matter.

County : Macon

| Line # | Item Number | Sec # | Description | Quantity | Unit Cost | Amount |
|--------|--------------|-------|--|----------|-----------|--------|
| 0057 | 6111000000-E | SP | IMPERVIOUS DIKE | 50 | | |
| | | | | | LF | |
| 0058 | 6114500000-N | 1667 | SPECIALIZED HAND MOWING | 10 | | |
| | | | | | MHR | |
| 0059 | 6117000000-N | SP | RESPONSE FOR EROSION CONTROL | 25 | | |
| | | | | | EA | |
| 0060 | 6117500000-N | SP | CONCRETE WASHOUT STRUCTURE | 2 | | |
| | | | | | EA | |
| 0061 | 6123000000-E | 1670 | REFORESTATION | 0.1 | | |
| | | | | | ACR | |
| 0079 | 3563000000-E | SP | TEMP *** WOVEN WIRE FENCE, COMPLETE W/POSTS (60) | 270 | | |
| | | | | | LF | |

STRUCTURE ITEMS

| | | | | | | |
|------|--------------|-----|---|----------|------|--|
| 0062 | 8035000000-N | 402 | REMOVAL OF EXISTING STRUCTURE AT STATION ***** (13+25.00 -L-) | Lump Sum | L.S. | |
| 0063 | 8065000000-N | SP | ASBESTOS ASSESSMENT | Lump Sum | L.S. | |
| 0064 | 8096000000-E | 450 | PILE EXCAVATION IN SOIL | 35 | | |
| | | | | | LF | |
| 0065 | 8097000000-E | 450 | PILE EXCAVATION NOT IN SOIL | 45 | | |
| | | | | | LF | |
| 0066 | 8112730000-N | 450 | PDA TESTING | 1 | | |
| | | | | | EA | |
| 0067 | 8121000000-N | 412 | UNCLASSIFIED STRUCTURE EXCAVA- TION AT STATION ***** (13+25.00 -L-) | Lump Sum | L.S. | |
| 0068 | 8182000000-E | 420 | CLASS A CONCRETE (BRIDGE) | 48.6 | | |
| | | | | | CY | |
| 0069 | 8210000000-N | 422 | BRIDGE APPROACH SLABS, STATION ***** (12+83.02 -L-) | Lump Sum | L.S. | |
| 0070 | 8217000000-E | 425 | REINFORCING STEEL (BRIDGE) | 5,846 | | |
| | | | | | LB | |
| 0071 | 8328200000-E | 450 | PILE DRIVING EQUIPMENT SETUP FOR *** STEEL PILES (12X53) | 14 | | |
| | | | | | EA | |

the highway right of way shall be certified as a qualified flagger in accordance with Article 1150-3 of the *Standard Specifications*, even if flagging is not being performed as part of the traffic control.

Provide the name and contact information of all qualified work zone installers to the Engineer prior to or at the preconstruction conference. Additionally, provide a qualification statement that all other individuals participating in the setup, installation, and removal of temporary traffic control are qualified flaggers that have been properly trained through an NCDOT approved training agency.

TEMPORARY WOVEN WIRE FENCE:

(7-1-95) (Rev. 1-19-16)

866

SP8 R85

Description

Construct a temporary woven wire fence, posts, gates, and barbed wire at locations shown on the plans.

Materials

Use only fabric and posts that have been approved by the Engineer. Materials shall meet the requirements of Article 866-2 of the *2018 Standard Specifications*.

Construction Methods

Construct the fence in accordance with Subarticle 866-3(C) and the *Roadway Standard Drawing* 866.02. The fence shall be maintained with fabric taut and securely fastened to the posts at all times. Barbed wire shall be installed along the top of the posts and at any ditch locations as determined by the Engineer.

After the fence has served its purpose and is no longer needed, as determined by the Engineer, it will become the property of the Contractor and shall be removed and disposed of by him.

Measurement and Payment

Temporary ___" Woven Wire Fence, Complete with Posts will be measured and paid as the actual number of linear feet of fence constructed and accepted, measured in place from center of end post to center of end post. Such price and payment will be full compensation for all materials, labor, fence maintenance, and incidentals including fence, posts, gates, and barbed wire necessary to satisfactorily complete the work.

Payment will be made under:



Pay Item

Temporary ___" Woven Wire Fence, Complete with Posts

Pay Unit

Linear Foot

| | | |
|--|--|---|
| PROJECT REFERENCE NO. 14SP.205611 | | SHEET NO. 4 |
| DOCUMENT NOT CONSIDERED FINAL UNLESS ALL SIGNATURES COMPLETED | | |

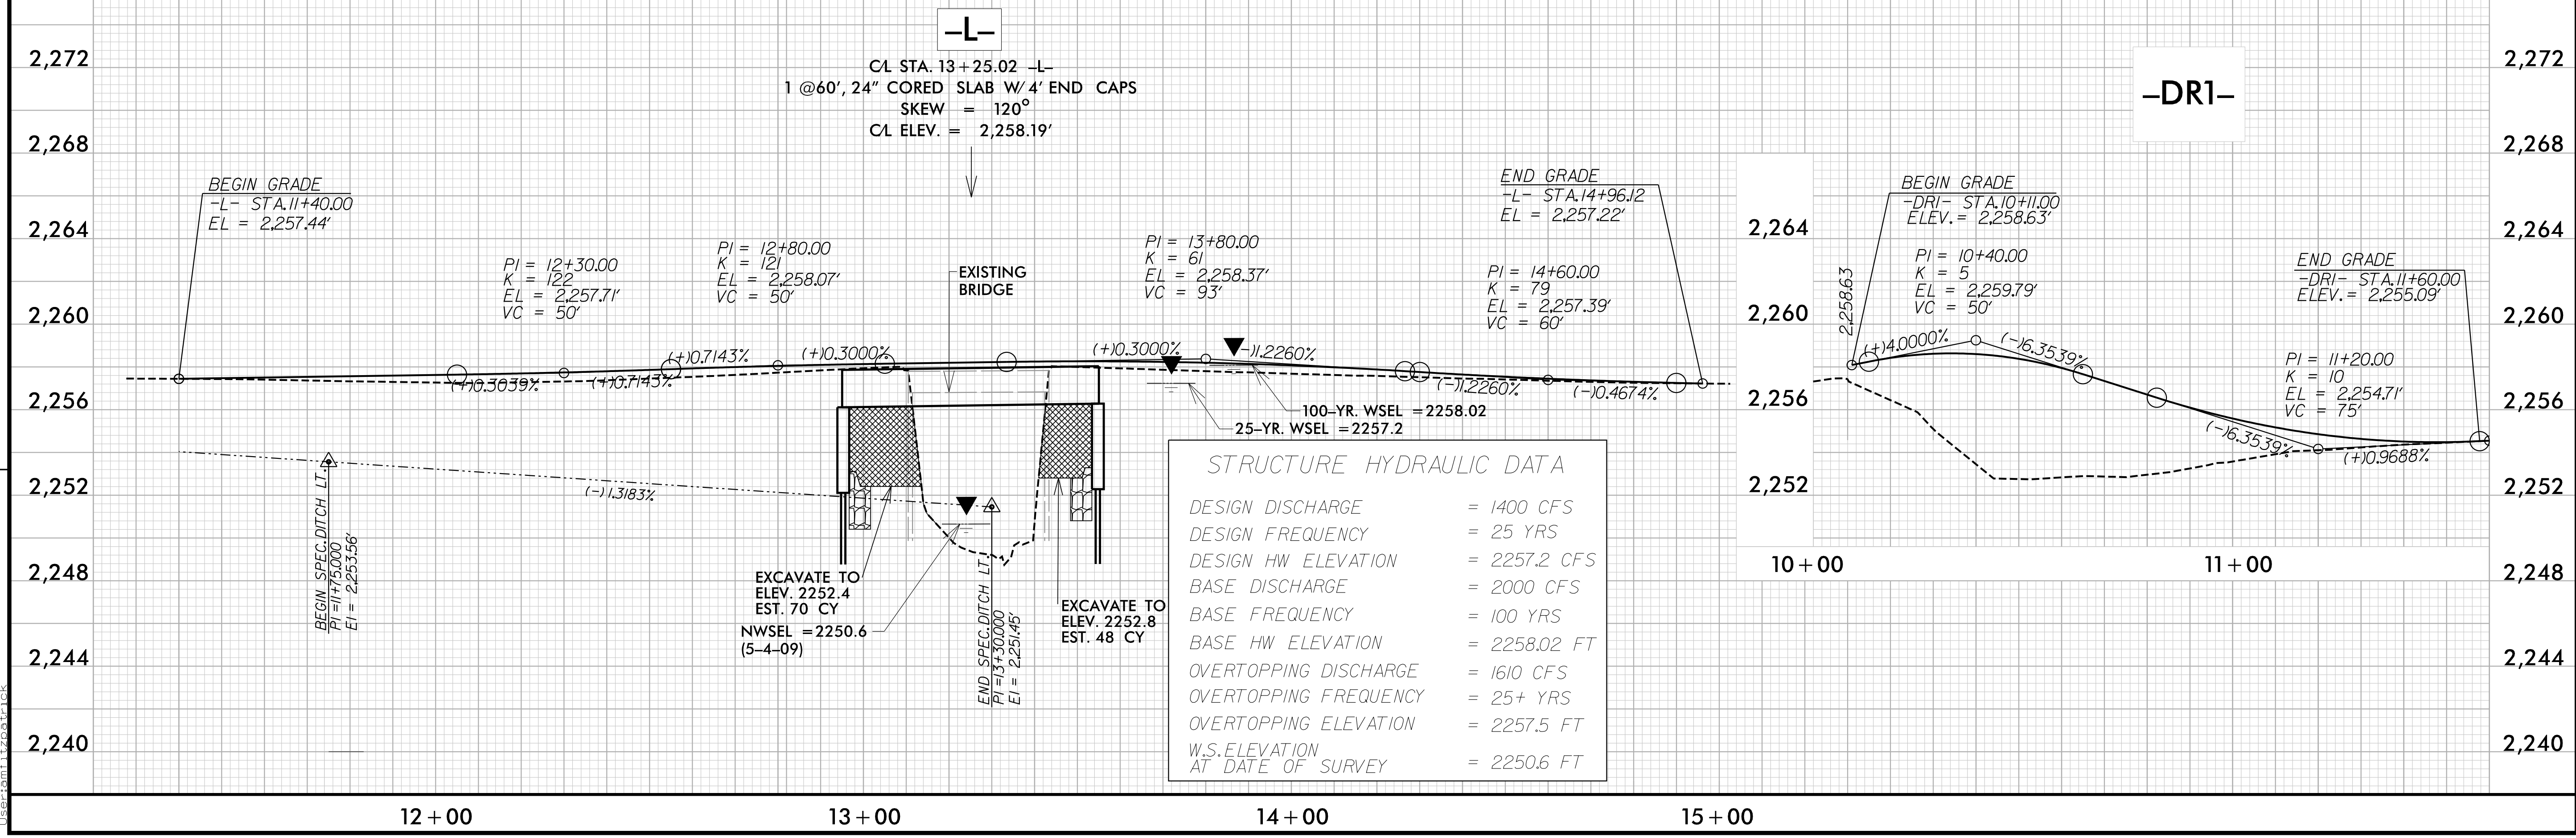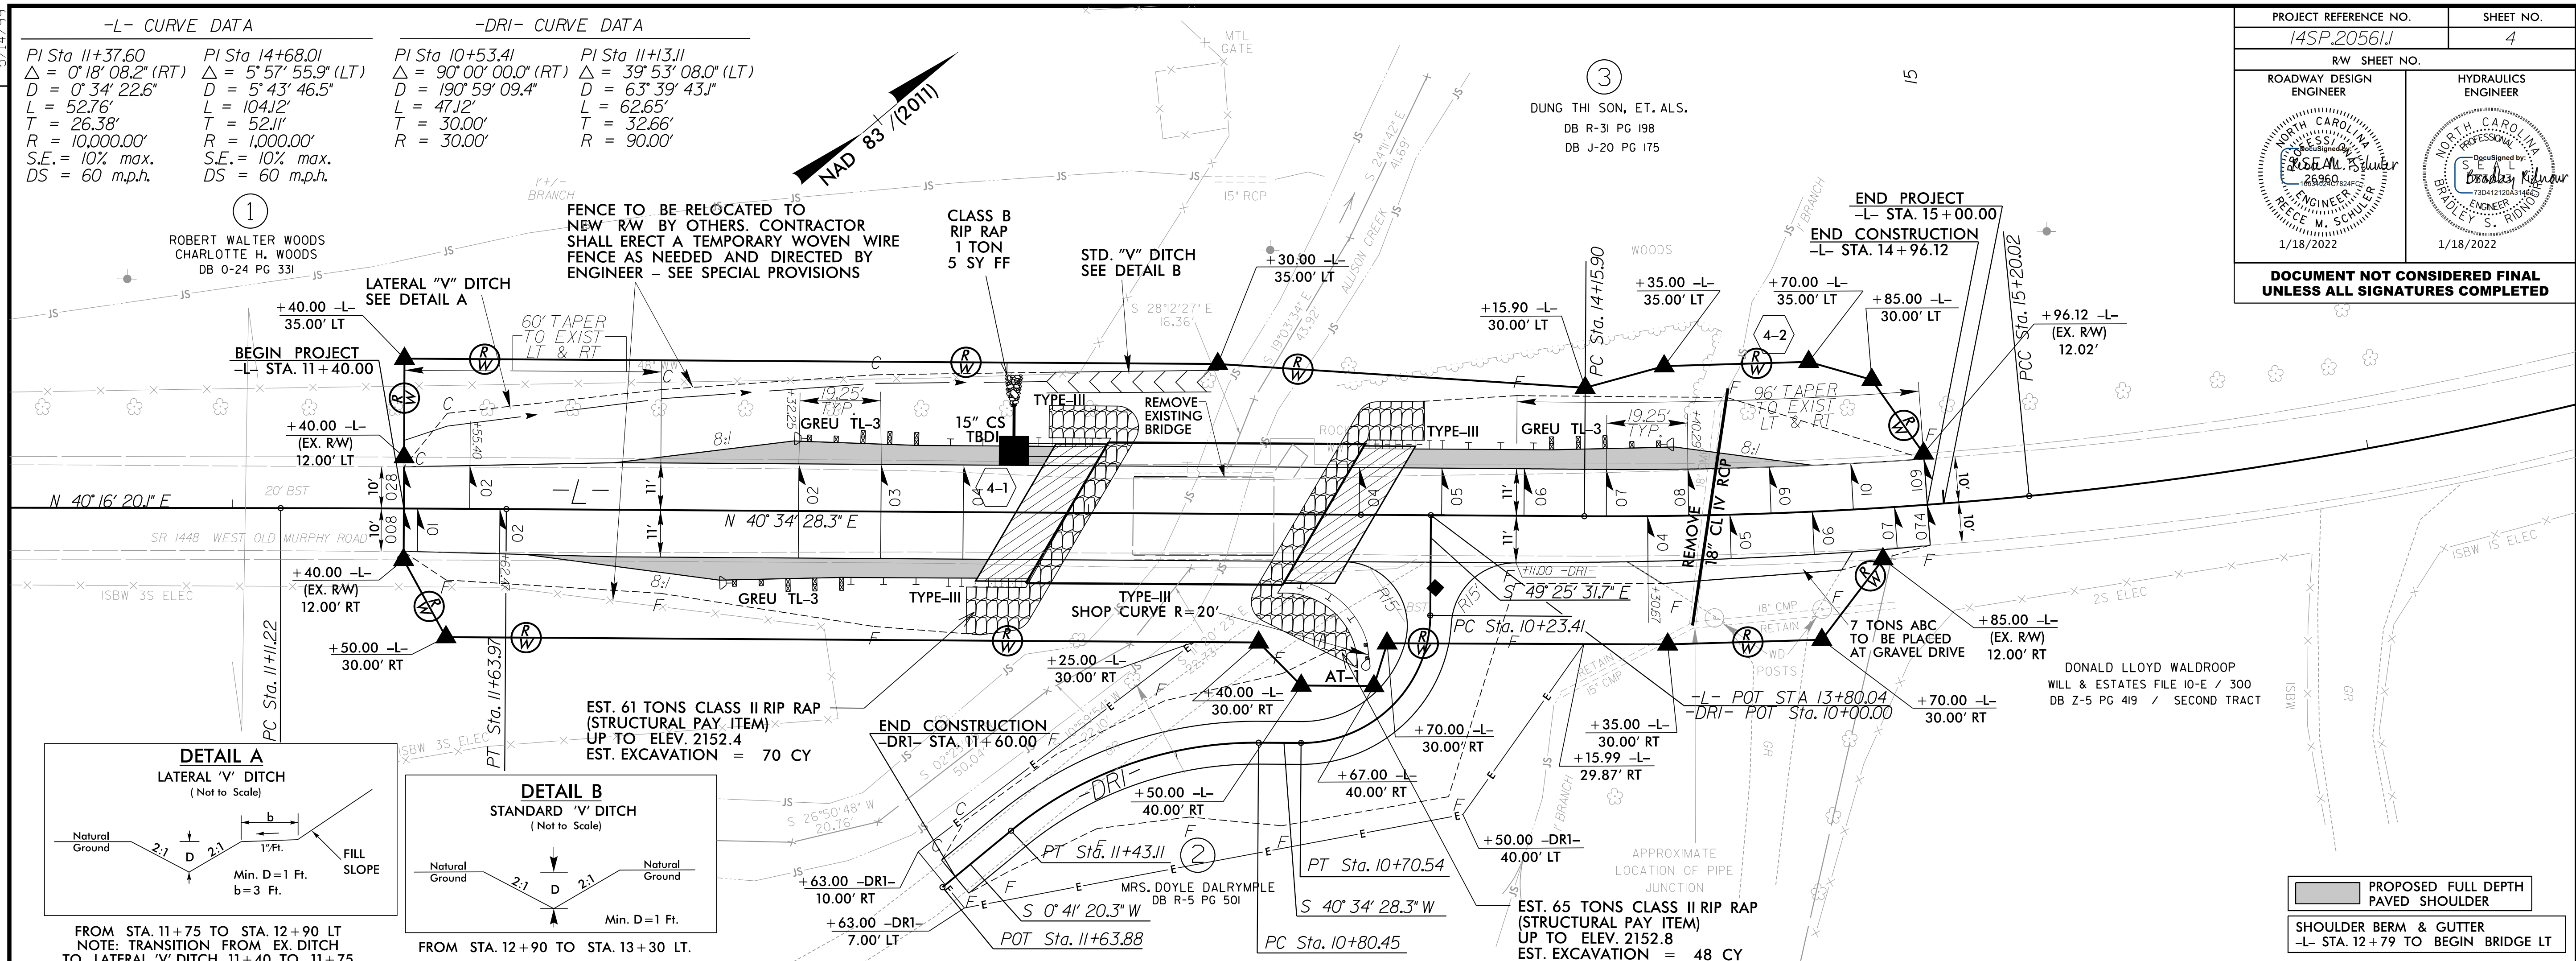

REVISIONS



1/18/2022, 2:41:27 PM
S:\p\co\k\50143_psh04_pah.dgn
User: smit\trapatrick

CONTRACT: DN00132 **TIP NO: 14SP.20561.1**

| STATE | STATE PROJECT REFERENCE NO. | SHEET NO. | TOTAL SHEETS |
|-----------------|-----------------------------|-------------|--------------|
| N.C. | 14SP.20561.1 | | |
| STATE PROJ. NO. | F. A. PROJ. NO. | DESCRIPTION | |
| 14SP.20561.1 | N/A | PE | |
| 14SP.20561.1 | N/A | R/W | |
| 14SP.20561.1 | N/A | CONST. | |
| | | | |
| | | | |


STATE OF NORTH CAROLINA
 DIVISION OF HIGHWAYS
MACON COUNTY

**LOCATION: BRIDGE NO. 343 OVER ALLISON CREEK
 ON SR 1448 (WEST OLD MURPHY ROAD)**

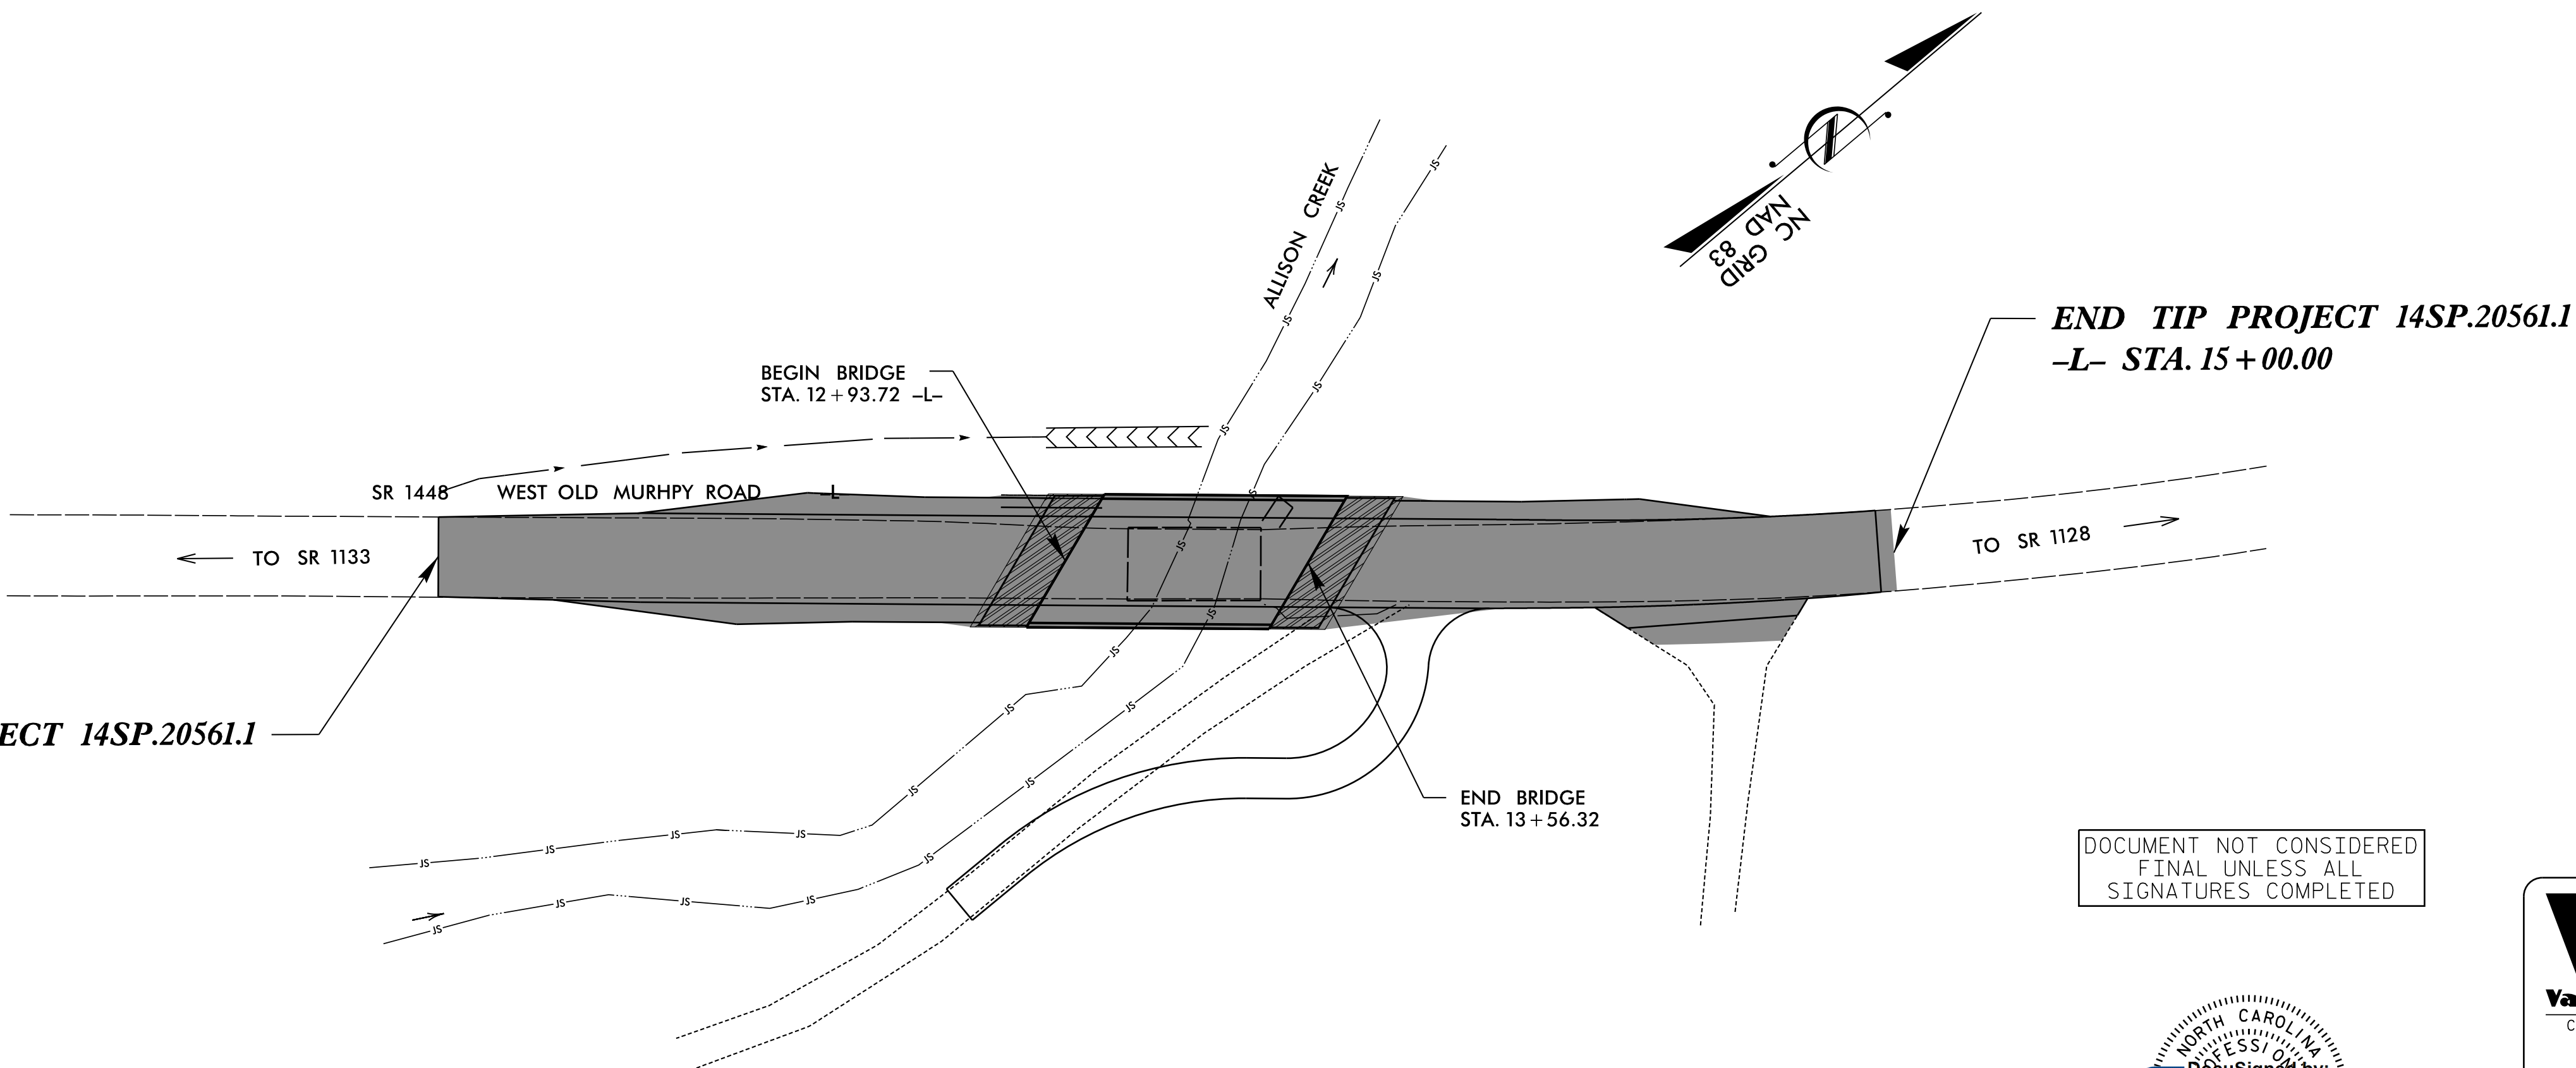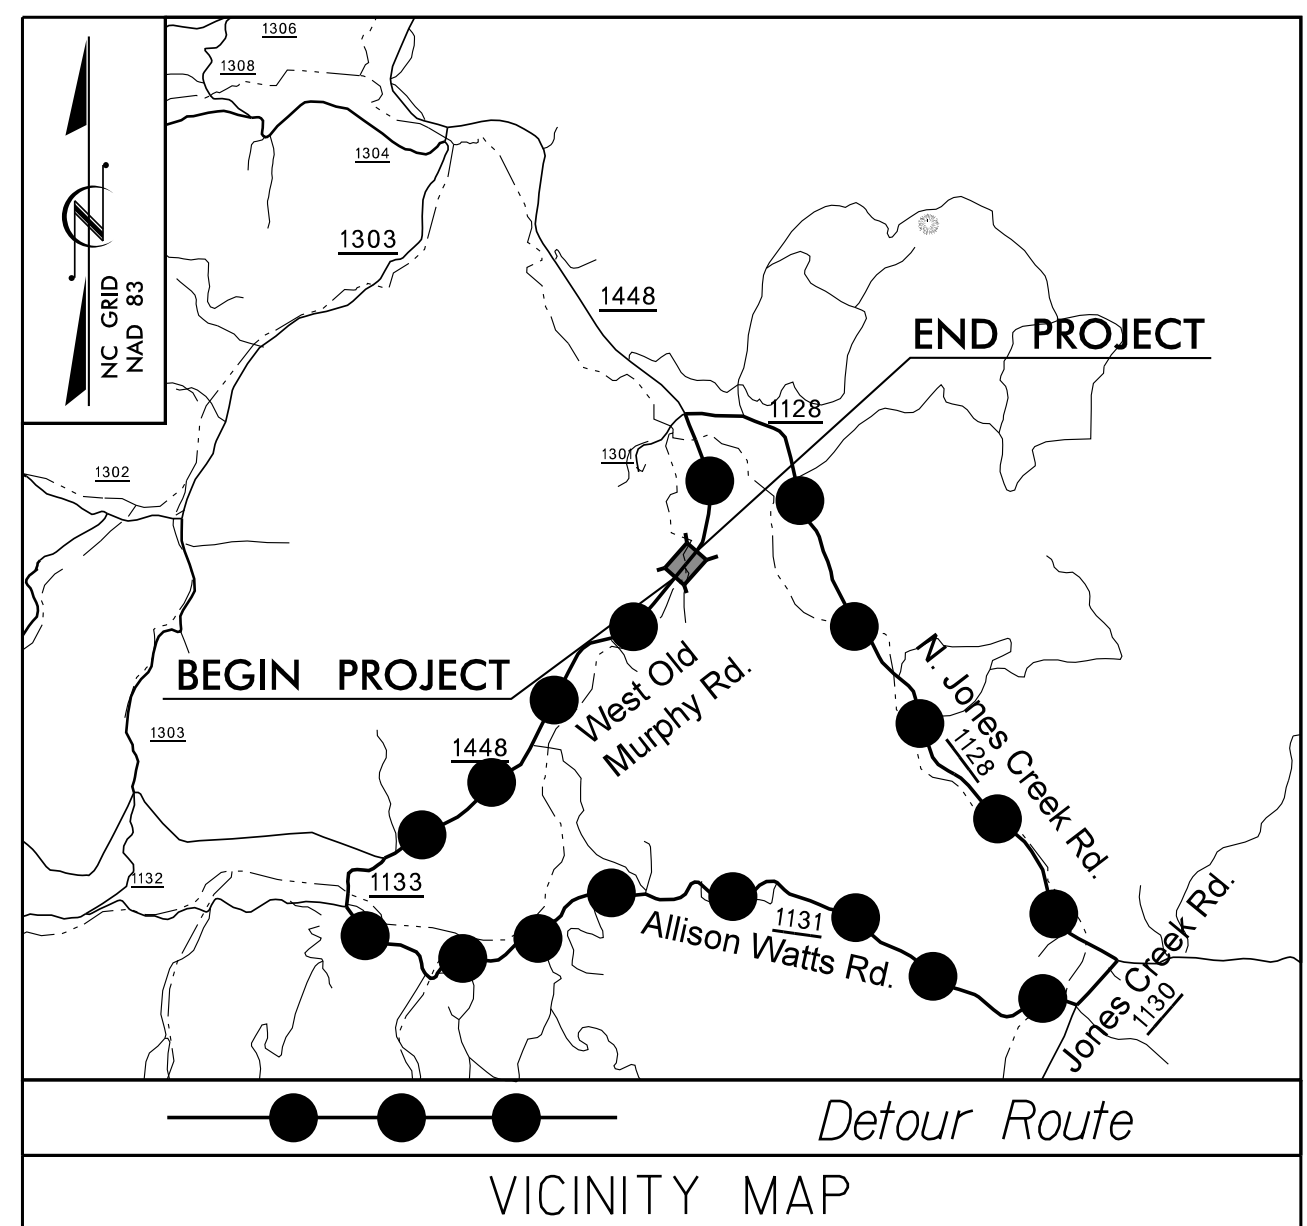

STRUCTURE

DOCUMENT NOT CONSIDERED FINAL UNLESS ALL SIGNATURES COMPLETED

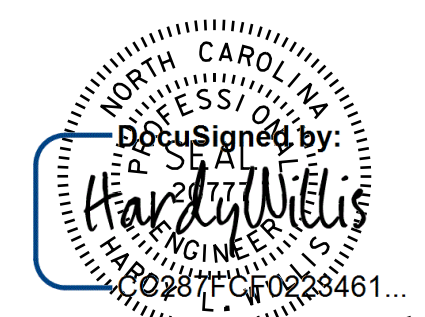


V&M
Vaughn & Melton
 Consulting Engineers

Asheville, North Carolina
 828-253-2796

- Boone, NC 828-355-9933
- Tri-Cities, TN 423-467-8401
- Knoxville, TN 865-546-5800
- Spartanburg, SC 864-574-4775
- Charleston, SC 843-974-5650
- Middlesboro, KY 606-248-6600
- Raleigh, NC 919-977-9455
- Charlotte, NC 704-357-0488
- Atlanta, GA 770-627-3509

Copyright © 2006 Vaughn & Melton, Inc. All Rights Reserved

1/26/2022

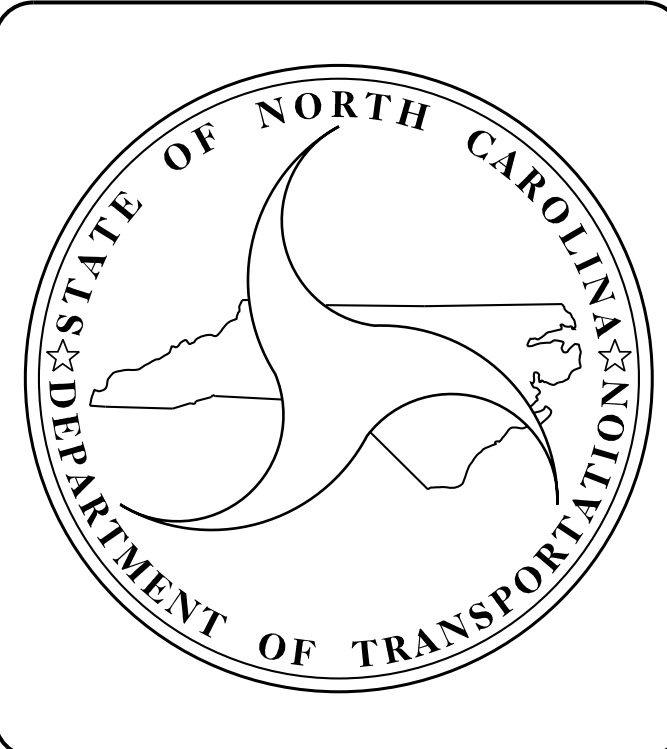

DESIGN DATA

ADT 2011 = 590
 ADT 2031 = 880
 T = 7%
 V = 55 MPH
 FUNC CLASS = MINOR
 LOCAL COLLECTOR
 SUBREGIONAL TIER

PROJECT LENGTH

LENGTH ROADWAY TIP PROJECT 14SP.20561.1 = 0.056 MI
 LENGTH STRUCTURE TIP PROJECT 14SP.20561.1 = 0.012 MI
 TOTAL LENGTH OF TIP PROJECT 14SP.20561.1 = 0.068 MI

Prepared in the Office of:
VAUGHN & MELTON
 1318-F PATTON AVE.
 ASHEVILLE, NC, 28806
 FOR THE NORTH CAROLINA DIVISION OF HIGHWAYS

2018 STANDARD SPECIFICATIONS



LETTING DATE :
 FEBRUARY 8, 2022

HARDY L. WILLIS, PE
 PROJECT ENGINEER



JASON E. BARTLEY, EI
 PROJECT DESIGN ENGINEER

STRUCTURES MANAGEMENT UNIT
 1000 BIRCH RIDGE DR.
 RALEIGH, N.C. 27610


DIVISION OF HIGHWAYS
STATE OF NORTH CAROLINA

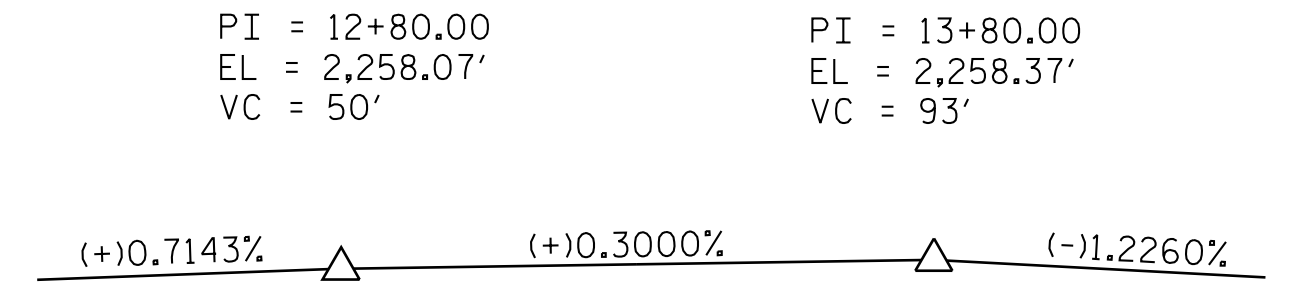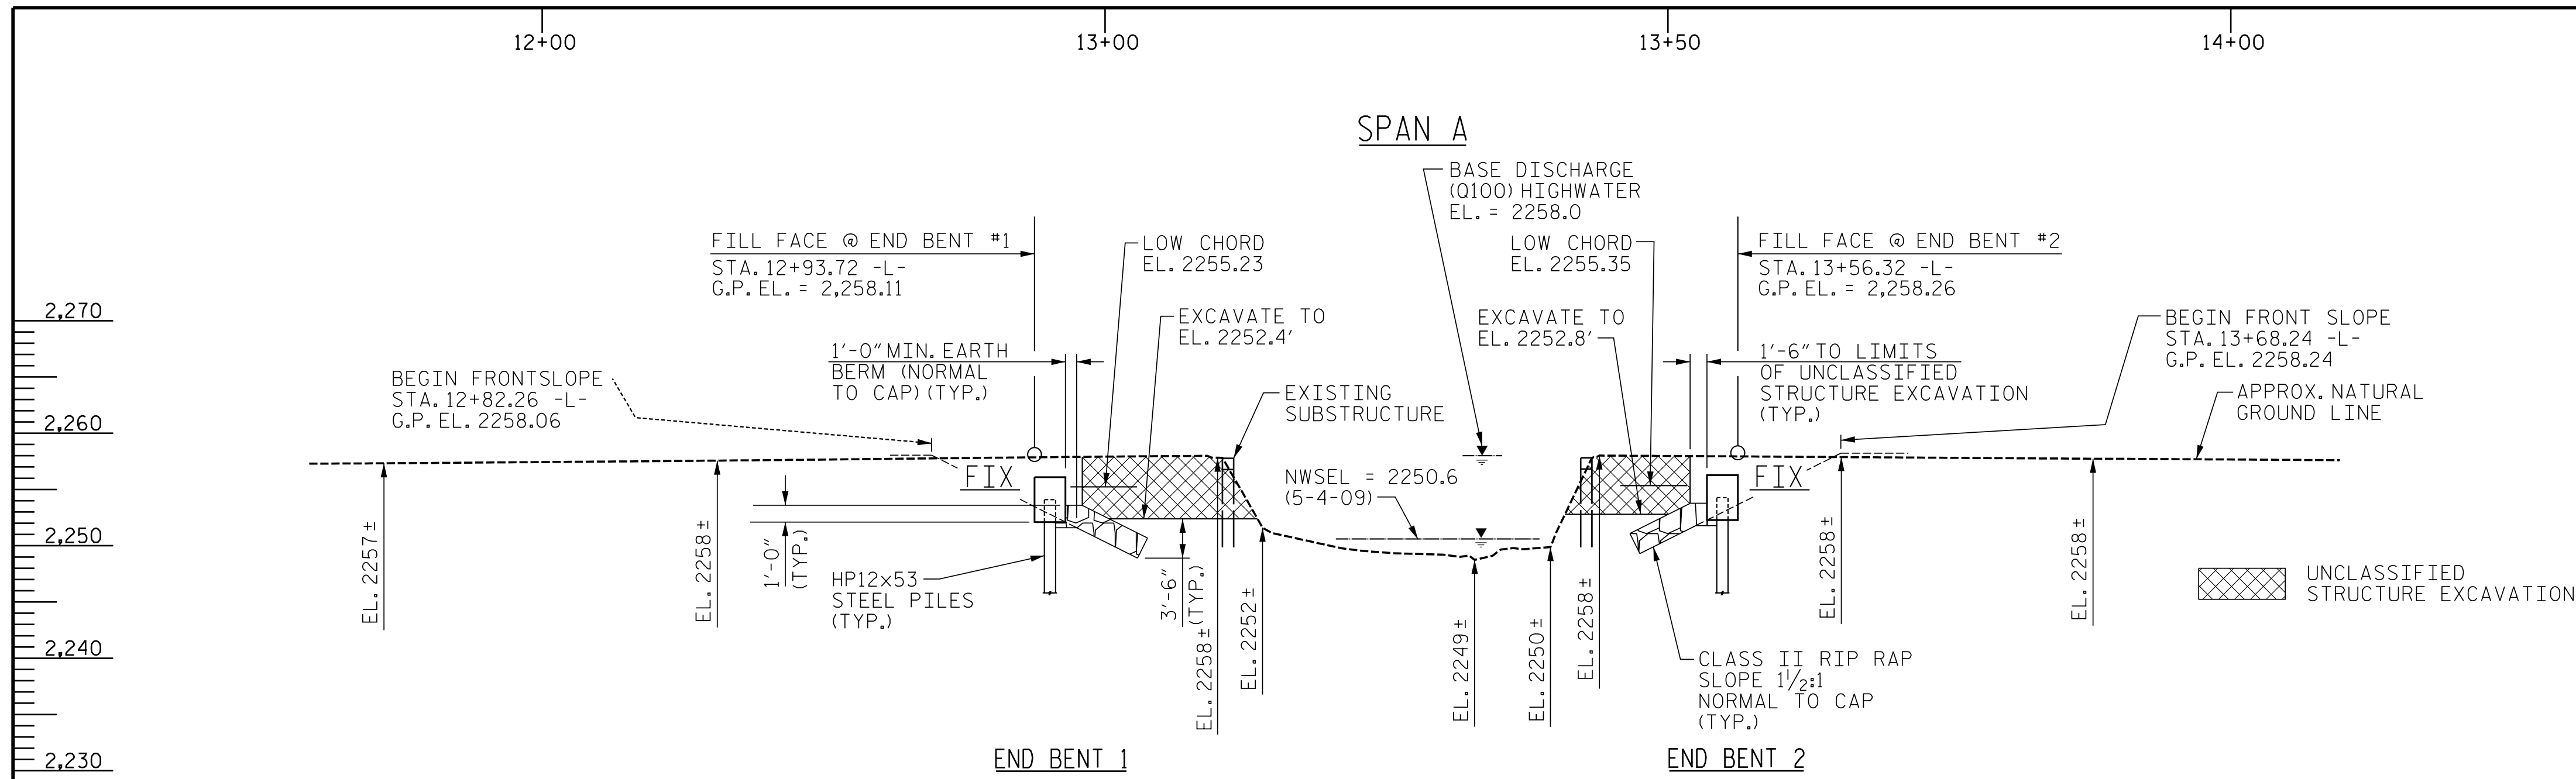

SECTION ALONG C/L SURVEY -L-
SECTIONS AT END BENTS ARE AT RIGHT ANGLES.

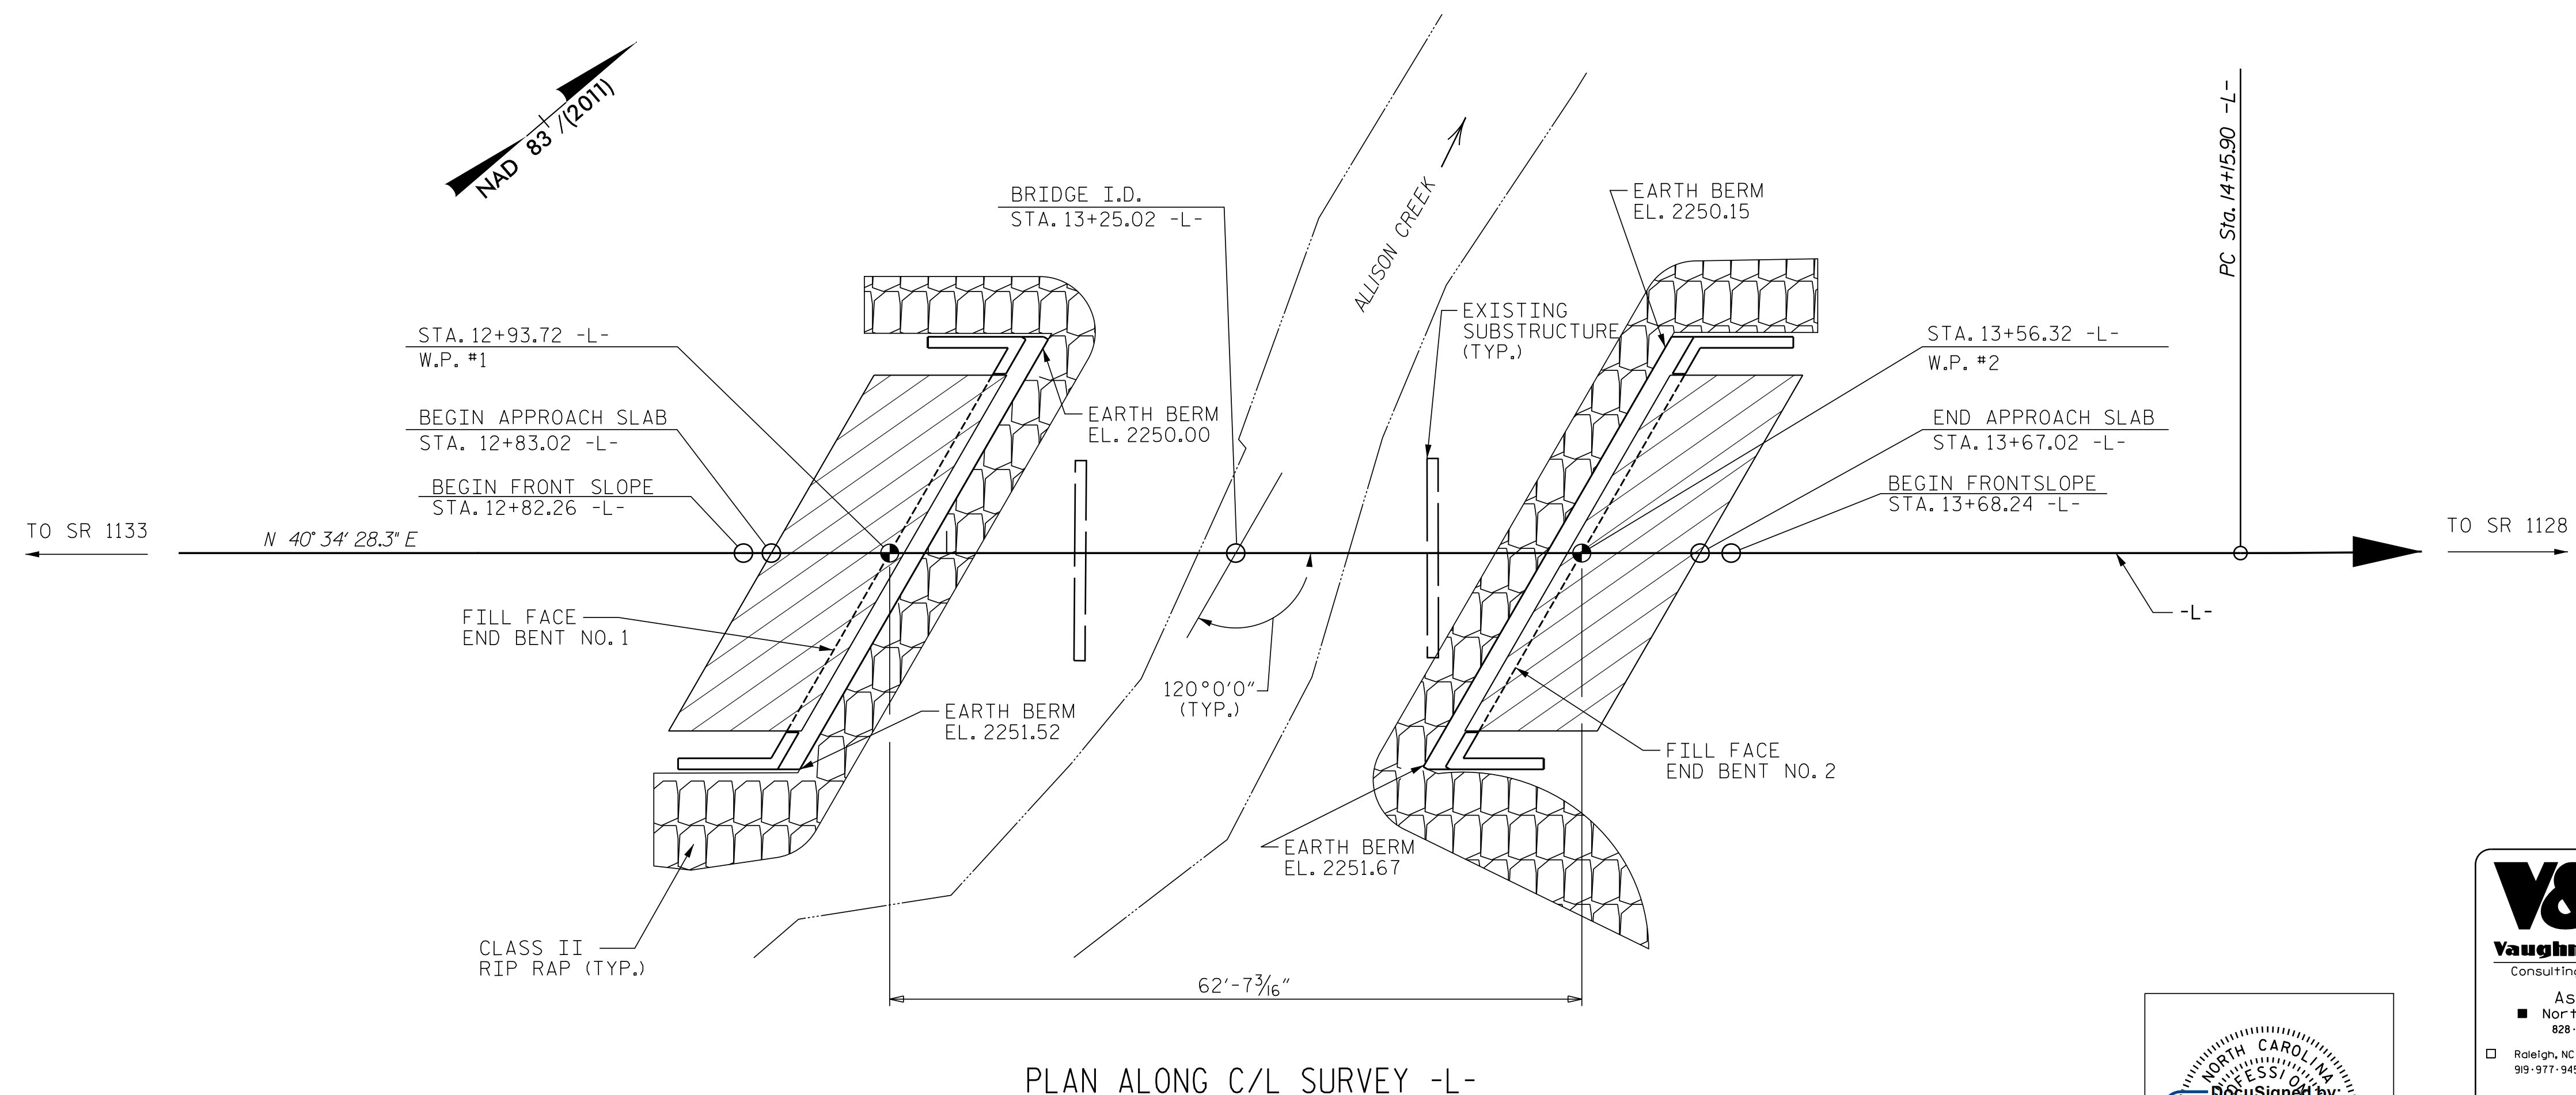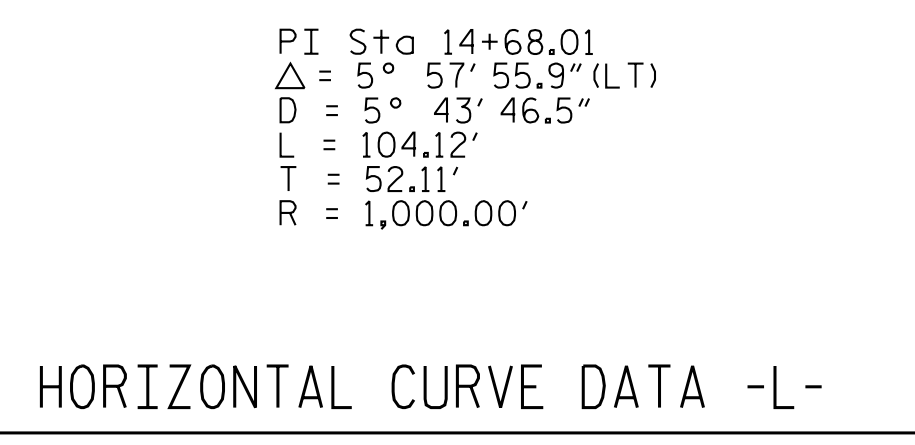

I HEREBY CERTIFY THAT THESE PLANS ARE THE AS-BUILT PLANS.

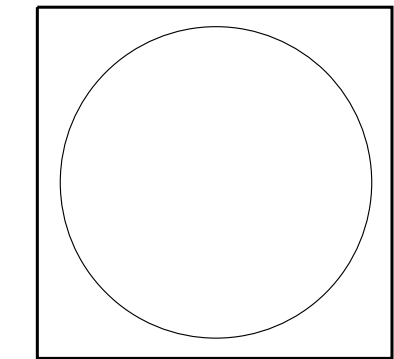

PROJECT NO. 14SP.20561.1
MACON COUNTY
STATION: 13+25.02 -L-
SHEET 1 OF 2 REPLACES BRIDGE NO. 343

V&M
Vaughn & Melton
Consulting Engineers
Asheville, North Carolina
828-253-2796

- Boone, NC 828-355-9933
- Tri-Cities, TN 423-467-8401
- Knoxville, TN 865-546-5800
- Spartanburg, SC 864-574-4775
- Charleston, SC 843-974-5650
- Middleboro, KY 606-248-6600
- Raleigh, NC 919-977-9455
- Charlotte, NC 704-357-0468
- Atlanta, GA 770-627-3509


Copyright © 2006 Vaughn & Melton, Inc. All Rights Reserved

STATE OF NORTH CAROLINA
DEPARTMENT OF TRANSPORTATION
RALEIGH

GENERAL DRAWING
FOR BRIDGE OVER ALLISON CREEK
ON SR 1448 BETWEEN
SR 1133 AND SR 1128

NOTES:
END BENTS ARE PARALLEL.
PILES NOT SHOWN IN PLAN VIEW FOR CLARITY.
CORED SLABS PARALLEL TO C SURVEY -L-.


DOCUMENT NOT CONSIDERED FINAL UNLESS ALL SIGNATURES COMPLETED

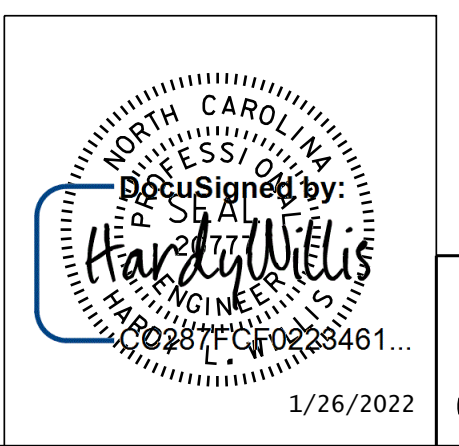

DSG. ENG. OF RECORD.: JEB DATE: 7/16
DWN. BY: MAF DATE: 7/16
CHKD. BY: HLW DATE: 7/16

| REVISIONS | | | | | | SHEET NO. |
|-----------|-----|-------|-----|-----|-------|--------------|
| NO. | BY: | DATE: | NO. | BY: | DATE: | S-1 |
| 1 | | | 3 | | | TOTAL SHEETS |
| 2 | | | 4 | | | 13 |

BM-1 N 527433.17 E 662544.42 -L- STA.9+92.11 23.55' LT ELEV=2258.12 8" SPIKE IN BASE OF 15" PINE

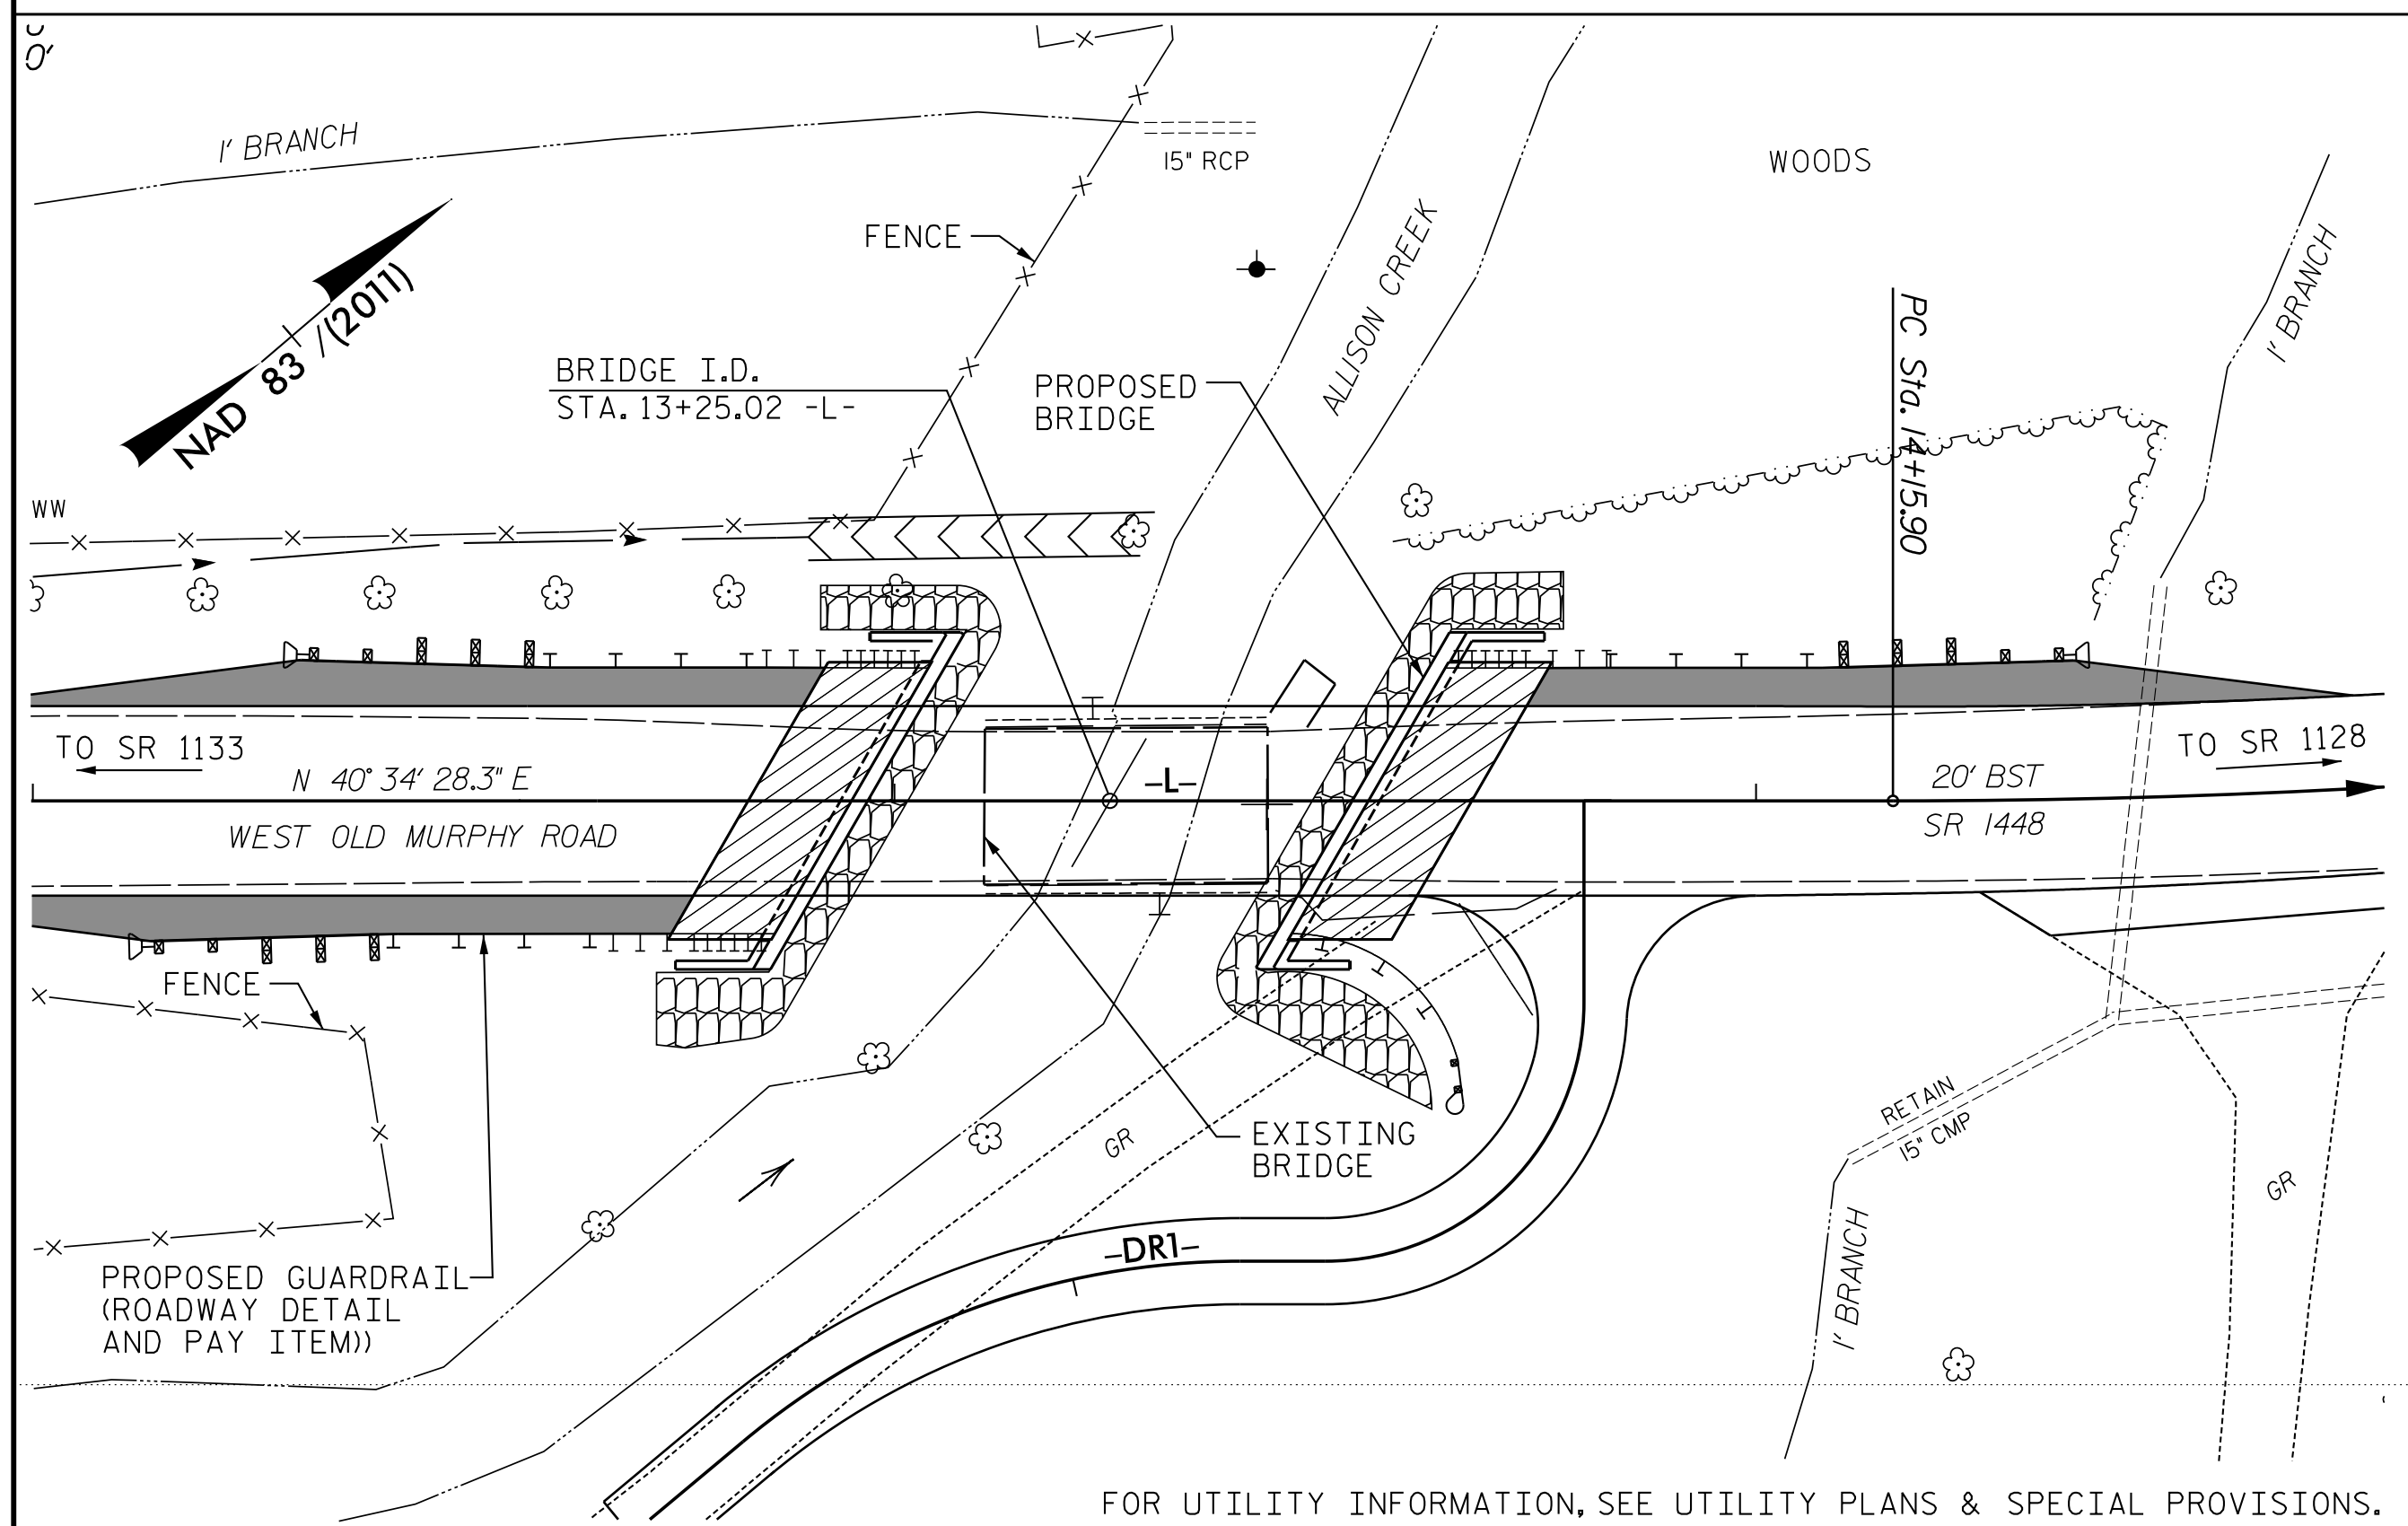

LOCATION SKETCH

FOR UTILITY INFORMATION, SEE UTILITY PLANS & SPECIAL PROVISIONS.

GENERAL NOTES:

ASSUMED LIVE LOAD = HL-93 OR ALTERNATE LOADING.
 THIS BRIDGE HAS BEEN DESIGNED IN ACCORDANCE WITH THE REQUIREMENTS OF THE AASHTO LRFD BRIDGE DESIGN SPECIFICATIONS.
 THIS BRIDGE IS LOCATED IN SEISMIC ZONE 1.
 FOR OTHER DESIGN DATA AND GENERAL NOTES, SEE SHEET SN.
 FOR EROSION CONTROL MEASURES, SEE EROSION CONTROL PLANS.

THE EXISTING STRUCTURE, CONSISTING OF A SINGLE SPAN, 32'-0" LONG REINFORCED CONCRETE DECK ON STEEL I-BEAMS, 21'-1" WIDE, ON REINFORCED CONCRETE ABUTMENTS, AND LOCATED AT THE PROPOSED STRUCTURE, SHALL BE REMOVED. THE EXISTING BRIDGE IS PRESENTLY POSTED BELOW THE LEGAL LOAD LIMIT.

REMOVAL OF THE EXISTING BRIDGE SHALL BE PERFORMED SO AS NOT TO ALLOW DEBRIS TO FALL INTO THE WATER. THE CONTRACTOR SHALL REMOVE THE BRIDGE AND SUBMIT PLANS FOR DEMOLITION IN ACCORDANCE WITH ARTICLE 402-2 OF THE STANDARD SPECIFICATIONS.

THE SUBSTRUCTURE OF THE EXISTING BRIDGE INDICATED ON THE PLANS IS FROM THE BEST INFORMATION AVAILABLE. SINCE THIS INFORMATION IS SHOWN FOR THE CONVENIENCE OF THE CONTRACTOR, THE CONTRACTOR SHALL HAVE NO CLAIM WHATSOEVER AGAINST THE DEPARTMENT OF TRANSPORTATION FOR ANY DELAYS OR ADDITIONAL COST INCURRED BASED ON DIFFERENCES BETWEEN THE EXISTING BRIDGE SUBSTRUCTURE SHOWN ON THE PLANS AND THE ACTUAL CONDITIONS AT THE PROJECT SITE.

THIS STRUCTURE HAS BEEN DESIGNED IN ACCORDANCE WITH "HEC 18- EVALUATING SCOUR AT BRIDGES."

FOR SUBMITTAL OF WORKING DRAWINGS, SEE SPECIAL PROVISIONS.

FOR FALSEWORK AND FORMWORK, SEE SPECIAL PROVISIONS.

FOR CRANE SAFETY, SEE SPECIAL PROVISIONS.

FOR GROUT FOR STRUCTURES, SEE SPECIAL PROVISIONS.

THE MATERIAL SHOWN IN THE CROSS-HATCHED AREA SHALL BE EXCAVATED FOR A DISTANCE OF 25 FT. EACH SIDE OF CENTERLINE ROADWAY AS DIRECTED BY THE ENGINEER. THIS WORK WILL BE PAID FOR AT THE CONTRACT LUMP SUM PRICE FOR UNCLASSIFIED STRUCTURE EXCAVATION. SEE SECTION 412 OF THE STANDARD SPECIFICATIONS.

ASPHALT WEARING SURFACE IS INCLUDED IN ROADWAY QUANTITY ON ROADWAY PLANS.

AT THE CONTRACTOR'S OPTION, PRESTRESSED CONCRETE END BENT AND BENT CAPS MAY BE SUBSTITUTED IN PLACE OF CAST-IN-PLACE. THE CONTRACTOR SHALL COORDINATE WITH THE RESIDENT ENGINEER TO RECEIVE REVISED PLANS AND DETAILS FROM THE STRUCTURES MANAGEMENT UNIT. THE REDESIGN AND ANY ADDITIONAL MATERIALS NEEDED WILL BE AT NO ADDITIONAL COST TO THE CONTRACTOR.

INASMUCH AS THE PAINT SYSTEM ON THE EXISTING STRUCTURAL STEEL CONTAINS LEAD, THE CONTRACTOR'S ATTENTION IS DIRECTED TO ARTICLE 107-1 OF THE STANDARD SPECIFICATIONS. ANY COSTS RESULTING FROM COMPLIANCE WITH APPLICABLE STATE OR FEDERAL REGULATIONS PERTAINING TO HANDLING OF MATERIALS CONTAINING LEAD BASED PAINT SHALL BE INCLUDED IN THE BID PRICE FOR "REMOVAL OF EXISTING STRUCTURE AT STATION 13+25.02."

FOR ASBESTOS ASSESSMENT FOR BRIDGE DEMOLITION AND RENOVATION ACTIVITIES, SEE SPECIAL PROVISIONS.

FOUNDATION NOTES:

FOR PILES, SEE SECTION 450 OF THE STANDARD SPECIFICATIONS.

PILES AT END BENT NO.1 & END BENT 2 ARE DESIGNED FOR A FACTORED RESISTANCE OF 80 TONS PER PILE.

DRIVE PILES AT END BENT NO.1 & END BENT NO.2 TO A REQUIRED DRIVING RESISTANCE OF 135 TONS PER PILE.

STEEL H-PILE POINTS ARE REQUIRED FOR STEEL H-PILES AT END BENT NO.1 & END BENT NO.2. FOR STEEL PILE POINTS, SEE SECTION 450 OF THE STANDARD SPECIFICATIONS.

DRILLED IN PILES ARE REQUIRED FOR END BENT NO.1 (RT). EXCAVATE HOLES AT PILE LOCATIONS TO A MINIMUM ELEVATION OF 2236.5 FT. FOR PILE EXCAVATIONS, SEE SECTION 450 OF THE STANDARD SPECIFICATIONS.

CONCRETE OR GROUT IS REQUIRED TO FILL HOLES FOR PILE EXCAVATIONS AT END BENT NO.1.

TESTING PILES WITH THE PDA DURING DRIVING, RESTRIKING OR REDRIVING MAY BE REQUIRED. THE ENGINEER WILL DETERMINE THE NEED FOR PDA TESTING. FOR PDA TESTING, SEE SECTION 450 OF THE STANDARD SPECIFICATIONS.

HYDRAULIC DATA

| | |
|---------------------|--------------|
| DESIGN DISCHARGE | = 1400 CFS |
| DESIGN FREQUENCY | = 25 YRS |
| DESIGN HW ELEVATION | = 2257.2 FT |
| BASE DISCHARGE | = 2000 CFS |
| BASE FREQUENCY | = 100 YRS |
| BASE HW ELEVATION | = 2258.02 FT |

OVERTOPPING FLOOD DATA

| | |
|-----------------------|-------------|
| OVERTOPPING DISCHARGE | = 1610 CFS |
| OVERTOPPING FREQUENCY | = 25 + YRS |
| OVERTOPPING ELEVATION | = 2257.5 FT |

DRAINAGE AREA = 5.9 SQ. MI.

W.S. ELEVATION = 2250.6'
 @ DATE OF SURVEY = 5/4/09

TOTAL BILL OF MATERIAL

| | REMOVAL OF EXISTING STRUCTURE | ASBESTOS ASSESSMENT | PILE EXCAVATION IN SOIL | PILE EXCAVATION NOT IN SOIL | PDA TESTING | UNCLASSIFIED STRUCTURE EXCAVATION | CLASS A CONCRETE | BRIDGE APPROACH SLABS | REINFORCING STEEL | PILE DRIVING EQUIPMENT SETUP FOR HP 12 X 53 STEEL PILES | HP 12 X 53 STEEL PILES | STEEL PILE POINTS | VERTICAL CONCRETE BARRIER RAIL | RIP RAP CLASS II (2'-0" THICK) | GEOTEXTILE FOR DRAINAGE | ELASTOMERIC BEARINGS | 3'-0" x 2'-0" PRESTRESSED CONCRETE CORED SLAB UNIT |
|----------------|-------------------------------|---------------------|-------------------------|-----------------------------|-------------|-----------------------------------|------------------|-----------------------|-------------------|---|------------------------|-------------------|--------------------------------|--------------------------------|-------------------------|----------------------|--|
| | LUMP SUM | LUMP SUM | LIN. FT. | LIN. FT. | EA. | LUMP SUM | CU. YARDS | LUMP SUM | LBS. | EACH | NO., LIN. FT. | EACH | LIN. FT. | TONS | SQ. YARDS | LUMP SUM | NO., LIN. FT. |
| SUPERSTRUCTURE | | | | | | | | LUMP SUM | | | | | 120.29 | | | LUMP SUM | 11, 660.00 |
| END BENT 1 | | | 35.0 | 45.0 | | LUMP SUM | 24.3 | | 2914 | 7 | 7, 154 | 7 | | 61.0 | 46.0 | | |
| END BENT 2 | | | | | | LUMP SUM | 24.3 | | 2914 | 7 | 7, 154 | 7 | | 65.0 | 53.0 | | |
| TOTAL | LUMP SUM | LUMP SUM | 35.0 | 45.0 | 1 | LUMP SUM | 48.6 | LUMP SUM | 5828 | 14 | 14, 308 | 14 | 120.29 | 126.0 | 99.0 | LUMP SUM | 11, 660.0 |

PROJECT NO. 14SP.20561.1

MACON COUNTY

STATION: 13+25.02 -L-


SHEET 2 OF 2

STATE OF NORTH CAROLINA
 DEPARTMENT OF TRANSPORTATION
 RALEIGH

GENERAL DRAWING

FOR BRIDGE OVER ALLISON CREEK
 ON SR 1448 BETWEEN
 SR 1133 AND SR 1128

DOCUMENT NOT CONSIDERED FINAL UNLESS ALL SIGNATURES COMPLETED

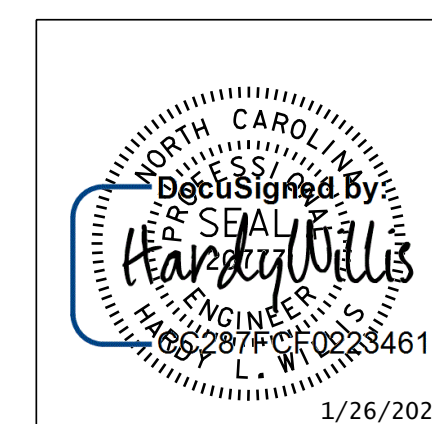

DSG. ENG. OF RECORD.: JEB DATE: 7/16
 DWN. BY: MAF DATE: 7/16
 CHKD. BY: HLW DATE: 7/16

| REVISIONS | | | | | | SHEET NO. |
|-----------|-----|-------|-----|-----|-------|-----------------|
| NO. | BY: | DATE: | NO. | BY: | DATE: | S-2 |
| 1 | | | 3 | | | TOTAL SHEETS 13 |
| 2 | | | 4 | | | |

LOAD AND RESISTANCE FACTOR RATING (LRFD) SUMMARY FOR PRESTRESSED CONCRETE GIRDERS

| LEVEL | VEHICLE | WEIGHT (W) (TONS) | CONTROLLING LOAD RATING | MINIMUM RATING FACTORS (RF) | TONS = W X RF | STRENGTH I LIMIT STATE | | | | | | | | | | SERVICE III LIMIT STATE | | | | | COMMENT NUMBER | | | |
|--------------------------|------------|----------------------|----------------------------|-----------------------------------|---------------|------------------------|------------------------------|---------------|------|-----------------|---|------------------------------|---------------|------|-----------------|---|---------------------|------------------------------|---------------|------|----------------|-----------------|---|--|
| | | | | | | MOMENT | | | | | SHEAR | | | | | MOMENT | | | | | | | | |
| | | | | | | LIVELOAD FACTORS | DISTRIBUTION FACTORS (DF) | RATING FACTOR | SPAN | GIRDER LOCATION | DISTANCE FROM LEFT END OF SPAN (ft) | DISTRIBUTION FACTORS (DF) | RATING FACTOR | SPAN | GIRDER LOCATION | DISTANCE FROM LEFT END OF SPAN (ft) | LIVELOAD FACTORS | DISTRIBUTION FACTORS (DF) | RATING FACTOR | SPAN | | GIRDER LOCATION | DISTANCE FROM LEFT END OF SPAN (ft) | |
| DESIGN LOAD RATING | HL-93(InV) | N/A | 1 | 1.47 | -- | 1.75 | 0.204 | 1.60 | 60' | EL | 29.5 | 0.651 | 1.47 | 60' | EL | 1.77 | 0.80 | 0.204 | 2.52 | 60' | EL | 29.5 | | |
| | HL-93(OPr) | N/A | -- | 1.91 | -- | 1.35 | 0.204 | 2.08 | 60' | EL | 29.5 | 0.651 | 1.91 | 60' | EL | 1.77 | 0.80 | 0.204 | -- | 60' | EL | 29.5 | | |
| | HS-20(InV) | 36.00 | 2 | 1.81 | 65.048 | 1.75 | 0.204 | 2.03 | 60' | EL | 29.5 | 0.651 | 1.81 | 60' | EL | 1.77 | 0.80 | 0.204 | 3.19 | 60' | EL | 29.5 | | |
| | HS-20(OPr) | 36.00 | -- | 2.34 | 84.321 | 1.35 | 0.204 | 2.63 | 60' | EL | 29.5 | 0.651 | 2.34 | 60' | EL | 1.77 | 0.80 | 0.204 | -- | 60' | EL | 29.5 | | |
| LEGAL LOAD RATING | SV | SNSH | 13.50 | -- | 5.27 | 71.099 | 1.40 | 0.204 | 5.44 | 60' | EL | 29.5 | 0.651 | 5.27 | 60' | EL | 1.77 | 0.80 | 0.204 | 6.86 | 60' | EL | 29.5 | |
| | | SNGARBS2 | 20.00 | -- | 3.78 | 75.688 | 1.40 | 0.204 | 4.17 | 60' | EL | 29.5 | 0.651 | 3.78 | 60' | EL | 1.77 | 0.80 | 0.204 | 5.25 | 60' | EL | 29.5 | |
| | | SNAGRIS2 | 22.00 | -- | 3.53 | 77.601 | 1.40 | 0.204 | 4.02 | 60' | EL | 29.5 | 0.651 | 3.53 | 60' | EL | 1.77 | 0.80 | 0.204 | 5.04 | 60' | EL | 29.5 | |
| | | SNCOTTS3 | 27.25 | -- | 2.64 | 71.923 | 1.40 | 0.204 | 2.72 | 60' | EL | 29.5 | 0.651 | 2.64 | 60' | EL | 1.77 | 0.80 | 0.204 | 3.42 | 60' | EL | 29.5 | |
| | | SNAGGRS4 | 34.93 | -- | 2.21 | 77.204 | 1.40 | 0.204 | 2.31 | 60' | EL | 29.5 | 0.651 | 2.21 | 60' | EL | 1.77 | 0.80 | 0.204 | 2.91 | 60' | EL | 29.5 | |
| | | SNS5A | 35.55 | -- | 2.25 | 79.978 | 1.40 | 0.204 | 2.26 | 60' | EL | 29.5 | 0.651 | 2.25 | 60' | EL | 1.77 | 0.80 | 0.204 | 2.84 | 60' | EL | 29.5 | |
| | | SNS6A | 39.95 | -- | 2.08 | 83.013 | 1.40 | 0.204 | 2.10 | 60' | EL | 29.5 | 0.651 | 2.08 | 60' | EL | 1.77 | 0.80 | 0.204 | 2.65 | 60' | EL | 29.5 | |
| | TTST | TNAGRIT3 | 33.00 | -- | 2.45 | 80.759 | 1.40 | 0.204 | 2.55 | 60' | EL | 29.5 | 0.651 | 2.45 | 60' | EL | 1.77 | 0.80 | 0.204 | 3.21 | 60' | EL | 29.5 | |
| | | TNT4A | 33.08 | -- | 2.38 | 78.586 | 1.40 | 0.204 | 2.58 | 60' | EL | 29.5 | 0.651 | 2.38 | 60' | EL | 1.77 | 0.80 | 0.204 | 3.24 | 60' | EL | 29.5 | |
| | | TNT6A | 41.60 | -- | 2.12 | 88.195 | 1.40 | 0.204 | 2.12 | 60' | EL | 29.5 | 0.651 | 2.19 | 60' | EL | 1.77 | 0.80 | 0.204 | 2.67 | 60' | EL | 29.5 | |
| | | TNT7A | 42.00 | -- | 2.11 | 88.725 | 1.40 | 0.204 | 2.15 | 60' | EL | 29.5 | 0.651 | 2.11 | 60' | EL | 1.77 | 0.80 | 0.204 | 2.70 | 60' | EL | 29.5 | |
| | | TNT7B | 42.00 | -- | 1.98 | 83.189 | 1.40 | 0.204 | 2.23 | 60' | EL | 29.5 | 0.651 | 1.98 | 60' | EL | 1.77 | 0.80 | 0.204 | 2.81 | 60' | EL | 29.5 | |
| | | TNAGRIT4 | 43.00 | -- | 1.91 | 82.316 | 1.40 | 0.204 | 2.11 | 60' | EL | 29.5 | 0.651 | 1.91 | 60' | EL | 1.77 | 0.80 | 0.204 | 2.66 | 60' | EL | 29.5 | |
| | | TNAGT5A | 45.00 | -- | 1.91 | 86.145 | 1.40 | 0.204 | 1.99 | 60' | EL | 29.5 | 0.651 | 1.91 | 60' | EL | 1.77 | 0.80 | 0.204 | 2.49 | 60' | EL | 29.5 | |
| TNAGT5B | 45.00 | 3 | 1.82 | 81.762 | 1.40 | 0.204 | 1.95 | 60' | EL | 29.5 | 0.651 | 1.82 | 60' | EL | 1.77 | 0.80 | 0.204 | 2.46 | 60' | EL | 29.5 | | | |

LOAD FACTORS:

| DESIGN LOAD RATING FACTORS | LIMIT STATE | γ_{DC} | γ_{DW} |
|-------------------------------------|-------------|---------------|---------------|
| | STRENGTH I | 1.25 | 1.50 |
| | SERVICE III | 1.00 | 1.00 |

NOTES:

MINIMUM RATING FACTORS ARE BASED ON THE STRENGTH I AND SERVICE III LIMIT STATES.
ALLOWABLE STRESSES FOR SERVICE III LIMIT STATE ARE AS REQUIRED FOR DESIGN.

COMMENTS:

- 1.
- 2.
- 3.
- 4.

| | |
|--|----------------------------|
| # | CONTROLLING LOAD RATING |
| 1 | DESIGN LOAD RATING (HL-93) |
| 2 | DESIGN LOAD RATING (HS-20) |
| 3 | LEGAL LOAD RATING ** |
| ** SEE CHART FOR VEHICLE TYPE | |
| GIRDER LOCATION | |
| I - INTERIOR GIRDER EL - EXTERIOR LEFT GIRDER ER - EXTERIOR RIGHT GIRDER | |



LRFR SUMMARY
FOR SPAN 'A'

V&M
Vaughn & Melton
Consulting Engineers

Asheville, North Carolina
828-253-2796

Boone, NC 828-355-9933
Tri-Cities, TN 423-467-8401
Knoxville, TN 865-546-5800
Spartanburg, SC 864-574-4775
Charleston, SC 843-974-5650
Middlesboro, KY 606-248-6600
Raleigh, NC 919-977-9455
Charlotte, NC 704-357-0488
Atlanta, GA 770-627-3509

Copyright © 2006 Vaughn & Melton, Inc. All Rights Reserved

PROJECT NO. 14SP.20561.1
MACON COUNTY
STATION: 13+25.02 -L-

STATE OF NORTH CAROLINA
DEPARTMENT OF TRANSPORTATION
RALEIGH

LRFR SUMMARY FOR
60' CORED SLAB UNIT
120° SKEW
(NON-INTERSTATE TRAFFIC)


ENGINEER OF RECORD: JEB
ASSEMBLED BY: MAF
CHECKED BY: HLW
DATE: 7/16
DATE: 7/16

DRAWN BY: CVC 6/10
CHECKED BY: DNS 6/10

DOCUMENT NOT CONSIDERED
FINAL UNLESS ALL
SIGNATURES COMPLETED


North Carolina Professional Engineer Seal
L. W. Williams
1/26/2022

| REVISIONS | | | | | | SHEET NO. |
|-----------|-----|-------|-----|-----|-------|--------------|
| NO. | BY: | DATE: | NO. | BY: | DATE: | S-3 |
| 1 | | | 3 | | | TOTAL SHEETS |
| 2 | | | 4 | | | 13 |

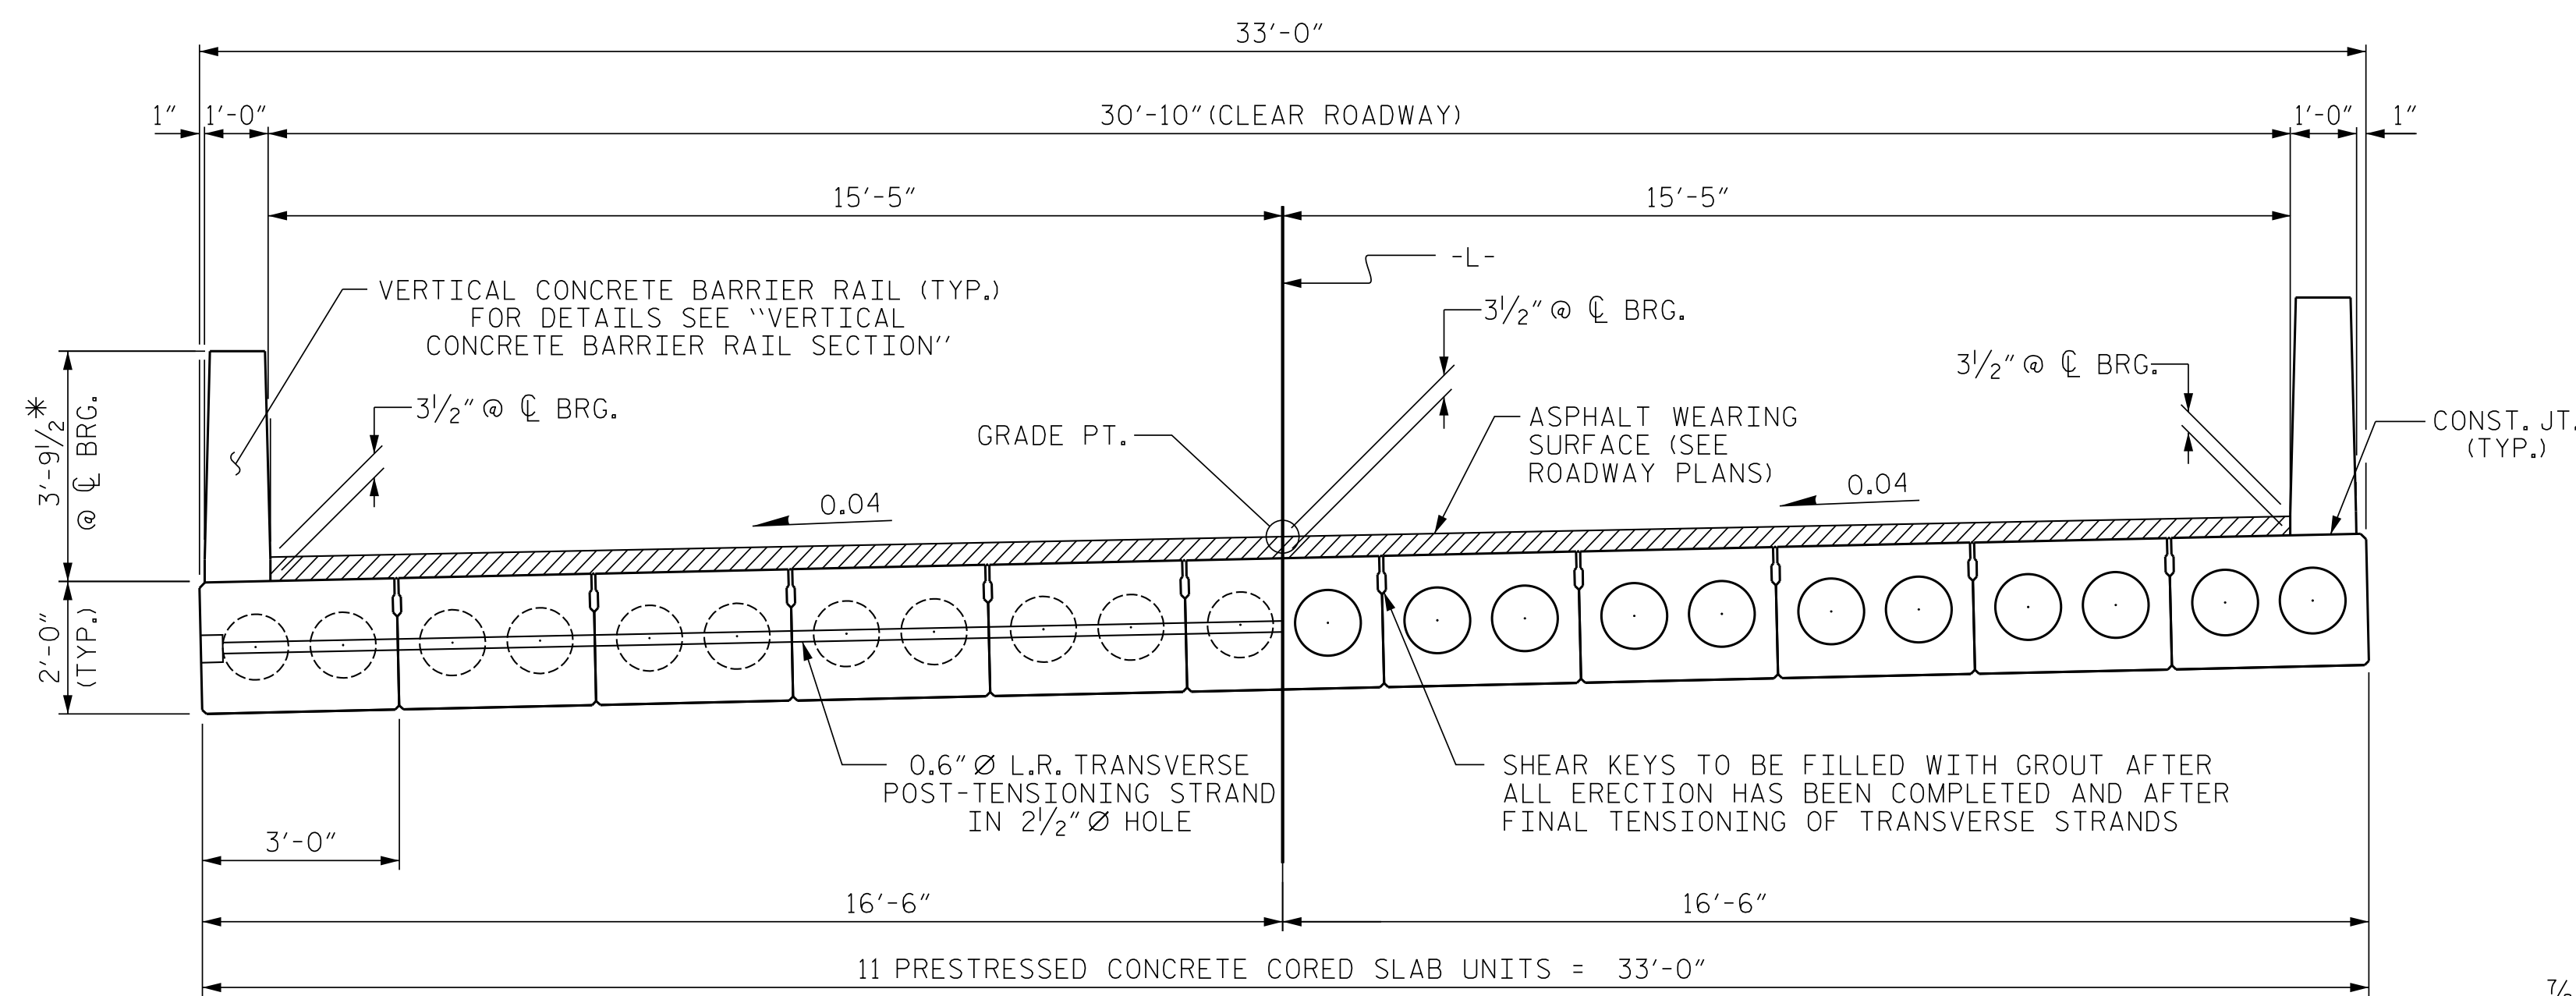


HALF SECTION AT INTERMEDIATE DIAPHRAGMS
TYPICAL SECTION
 HALF SECTION THROUGH VOIDS

* - THE MAXIMUM BARRIER RAIL HEIGHT AND ASPHALT THICKNESS IS SHOWN. THE HEIGHT OF THE BARRIER RAIL AND ASPHALT THICKNESS VARIES WHILE THE TOP OF THE BARRIER RAIL FOLLOWS THE PROFILE OF THE GUTTERLINE. FOR RAIL HEIGHT DETAILS AND ASPHALT THICKNESS, SEE THE "VERTICAL CONCRETE BARRIER RAIL SECTION" DETAIL.

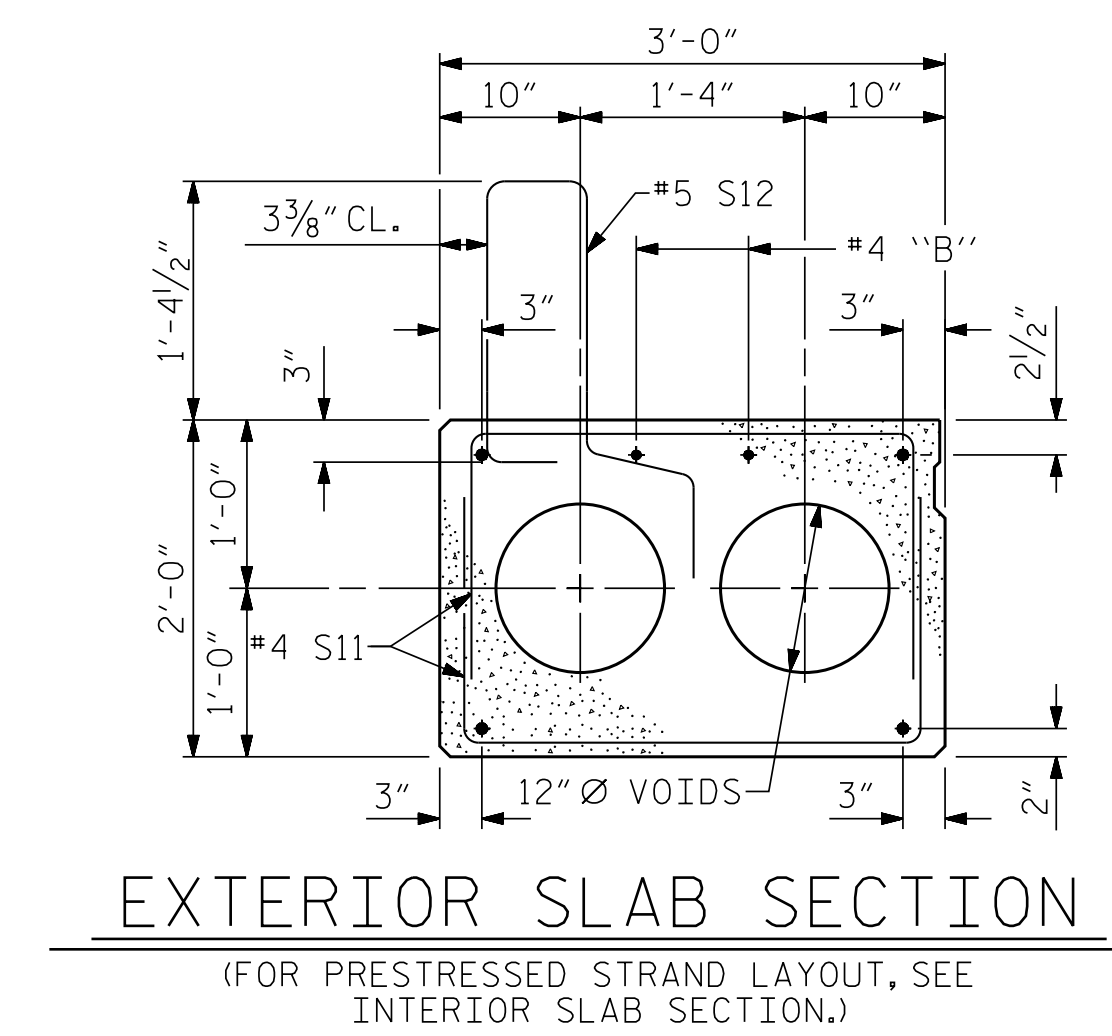

EXTERIOR SLAB SECTION
 (FOR PRESTRESSED STRAND LAYOUT, SEE INTERIOR SLAB SECTION.)

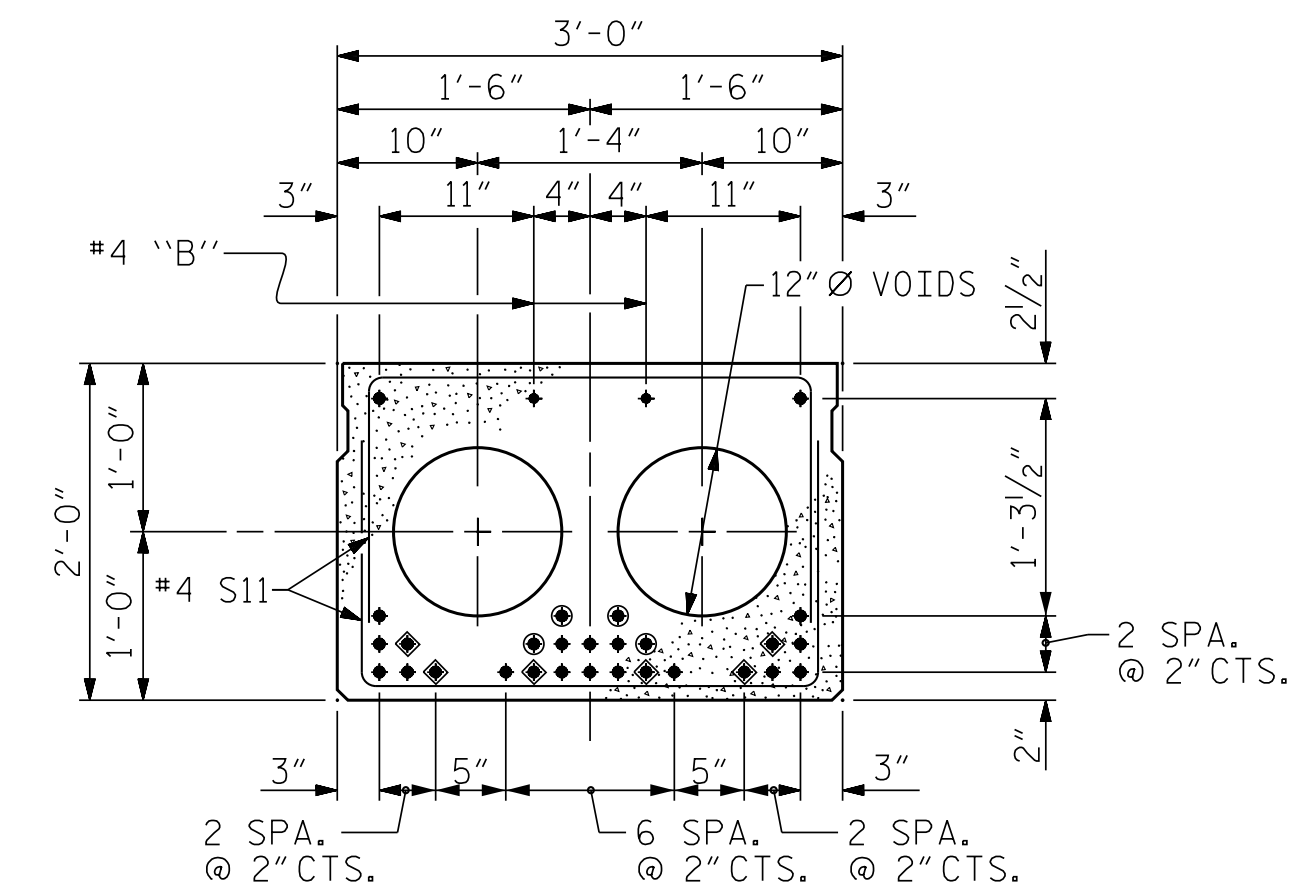


INTERIOR SLAB SECTION (60' UNIT)
 (24 STRANDS REQUIRED)

0.6" Ø LOW RELAXATION STRAND LAYOUT

- ◆ BOND SHALL BE BROKEN ON THESE STRANDS FOR A DISTANCE OF 16'-0" FROM END OF CORED SLAB UNIT. SEE STANDARD SPECIFICATIONS, ARTICLE 1078-7.
- OPTIONAL FULL LENGTH DEBONDED STRANDS. THESE STRANDS ARE NOT REQUIRED. IF THE FABRICATOR CHOOSES TO INCLUDE THESE STRANDS IN THE CORED SLAB UNIT, THE STRANDS SHALL BE DEBONDED FOR THE FULL LENGTH OF THE UNIT AT NO ADDITIONAL COST. SEE STANDARD SPECIFICATIONS, ARTICLE 1078-7.

DEBONDING LEGEND

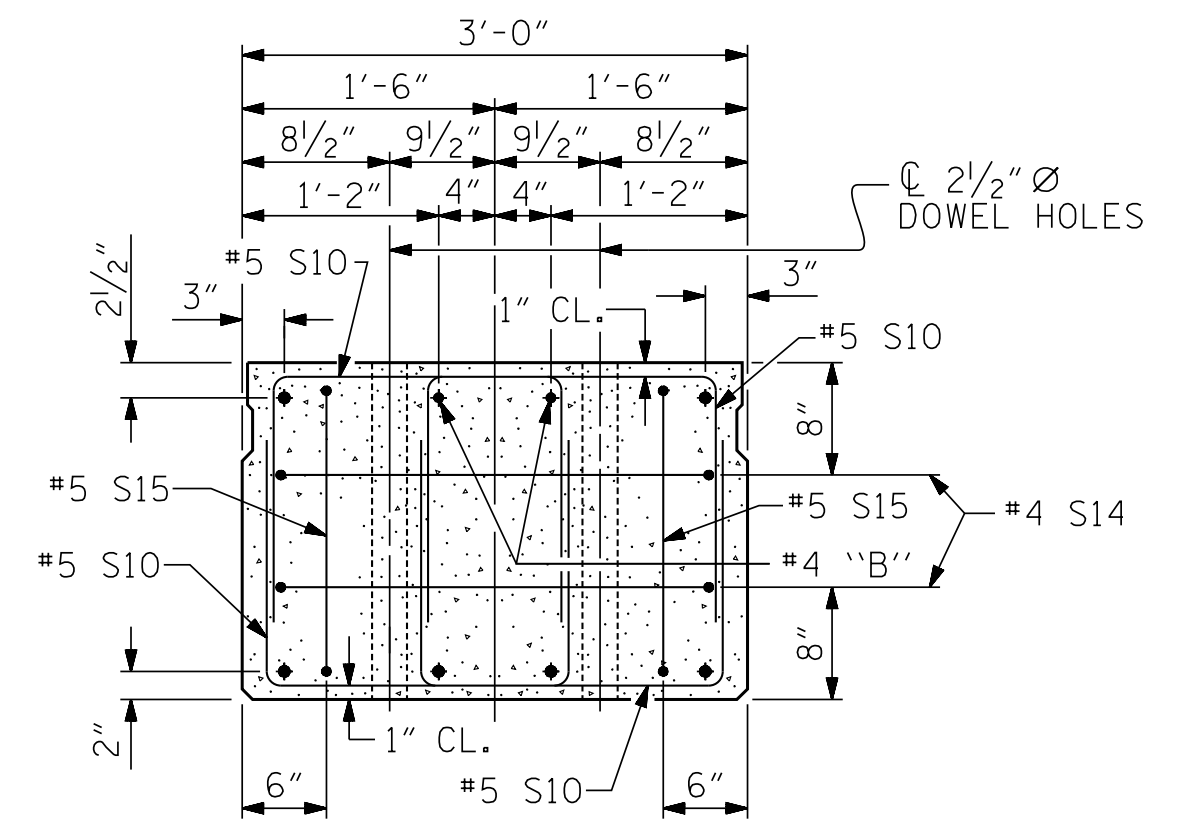

END ELEVATION

SHOWING PLACEMENT OF DOUBLE STIRRUPS AND LOCATION OF DOWEL HOLES. (STRAND LAYOUT NOT SHOWN.) INTERIOR SLAB UNIT SHOWN-EXTERIOR SLAB UNIT SIMILAR EXCEPT SHEAR KEY LOCATION.


PROJECT NO. 14SP.20561.1
 MACON COUNTY
 STATION: 13+25.02 -L-

SHEET 1 OF 3


STATE OF NORTH CAROLINA
 DEPARTMENT OF TRANSPORTATION
 RALEIGH
 STANDARD
 3'-0" X 2'-0"
 PRESTRESSED CONCRETE
 CORED SLAB UNIT

| REVISIONS | | | | | | SHEET NO. |
|-----------|-----|-------|-----|-----|-------|--------------|
| NO. | BY: | DATE: | NO. | BY: | DATE: | S-4 |
| 1 | | | 3 | | | TOTAL SHEETS |
| 2 | | | 4 | | | 13 |


STD. NO. 24PCS4.33.120S

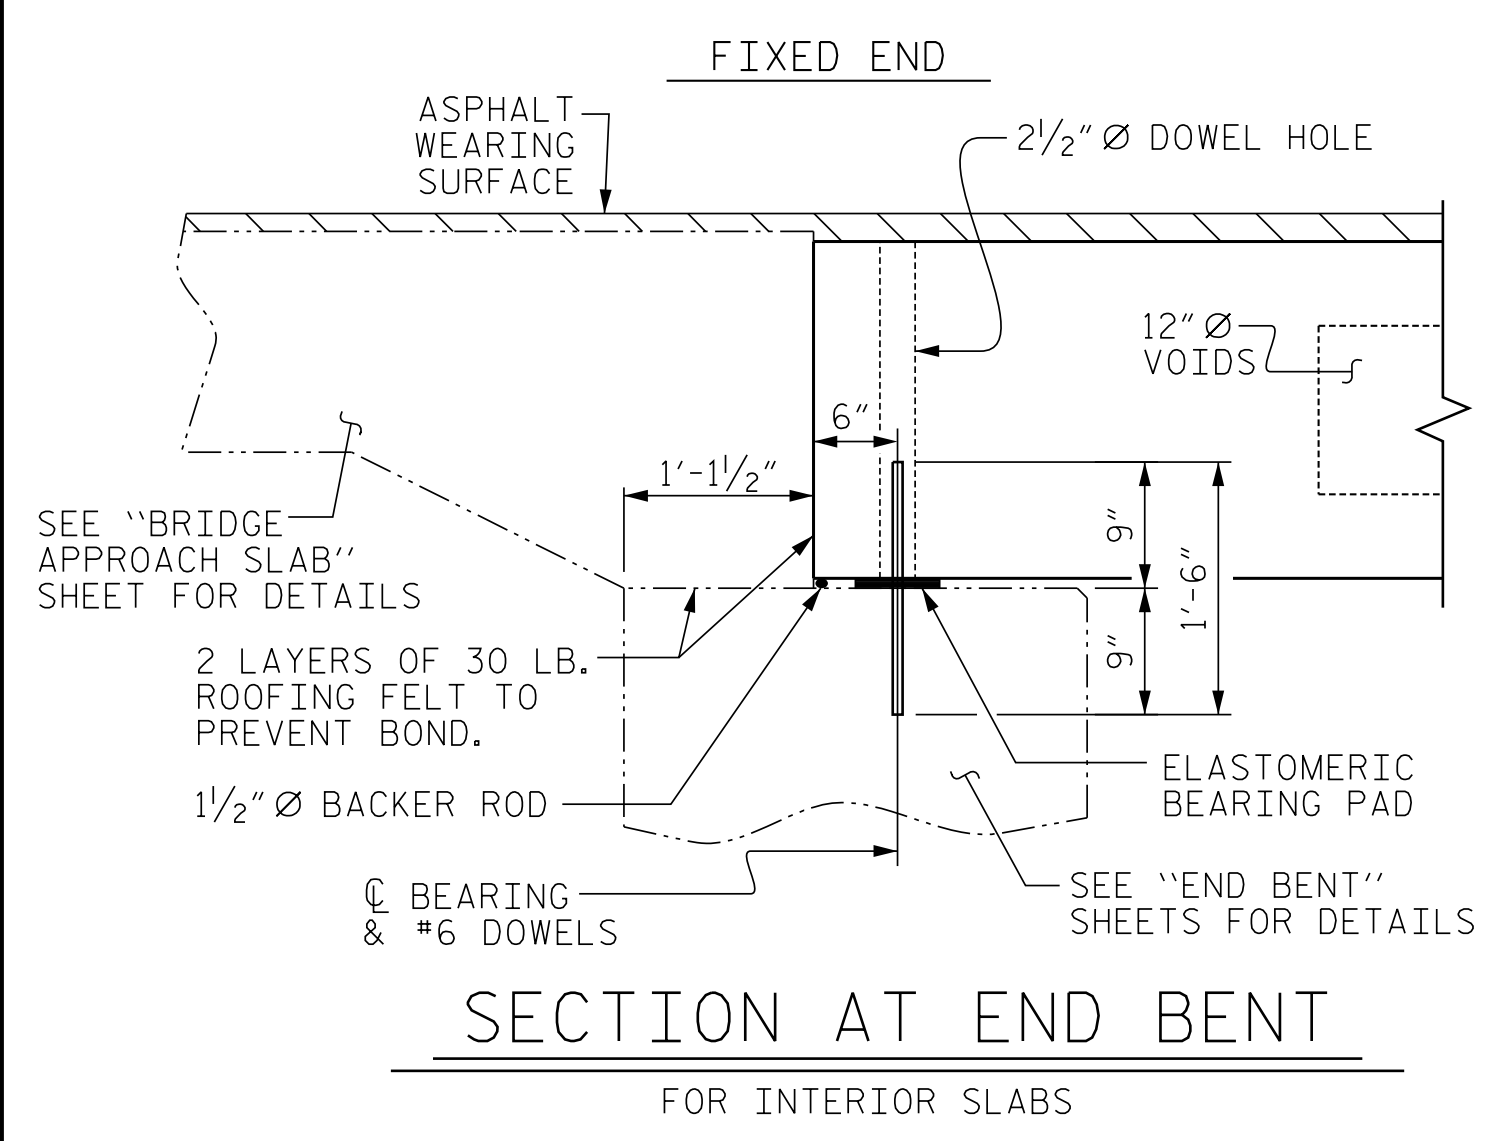


SECTION AT END BENT
 FOR INTERIOR SLABS

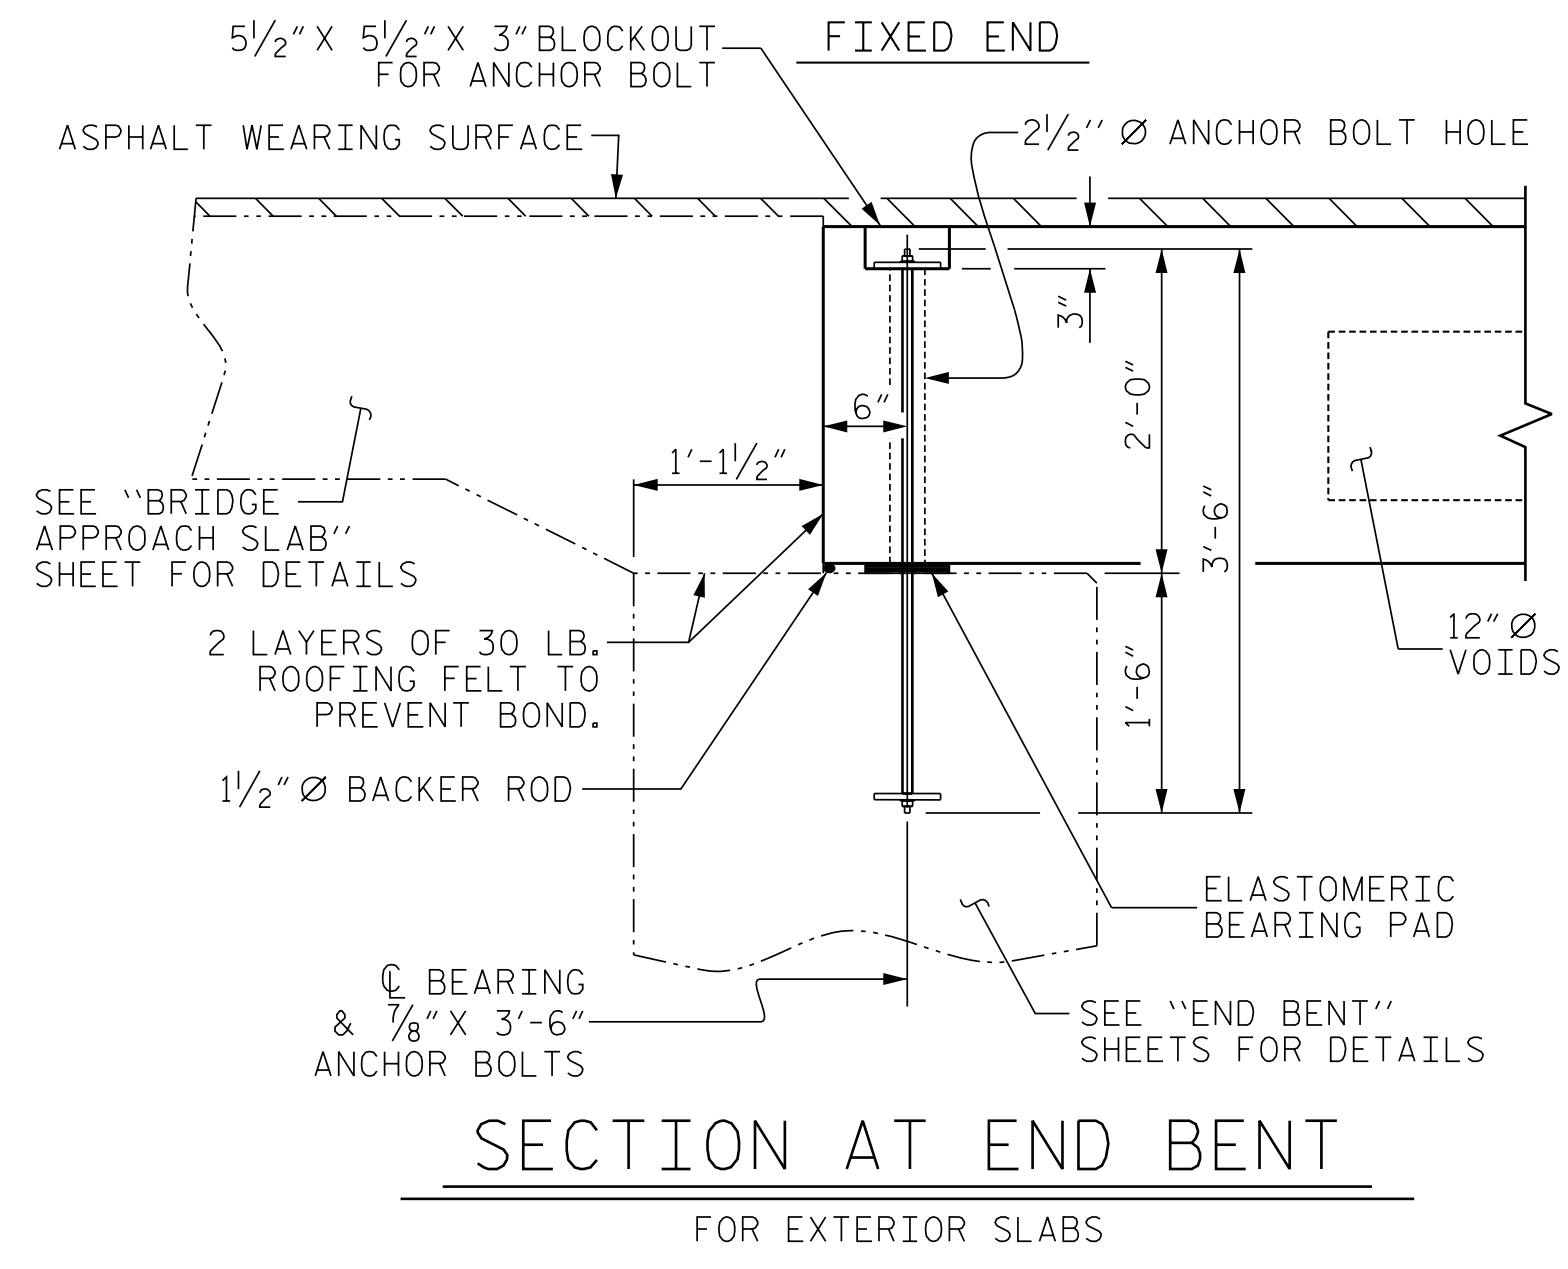

SECTION AT END BENT
 FOR EXTERIOR SLABS

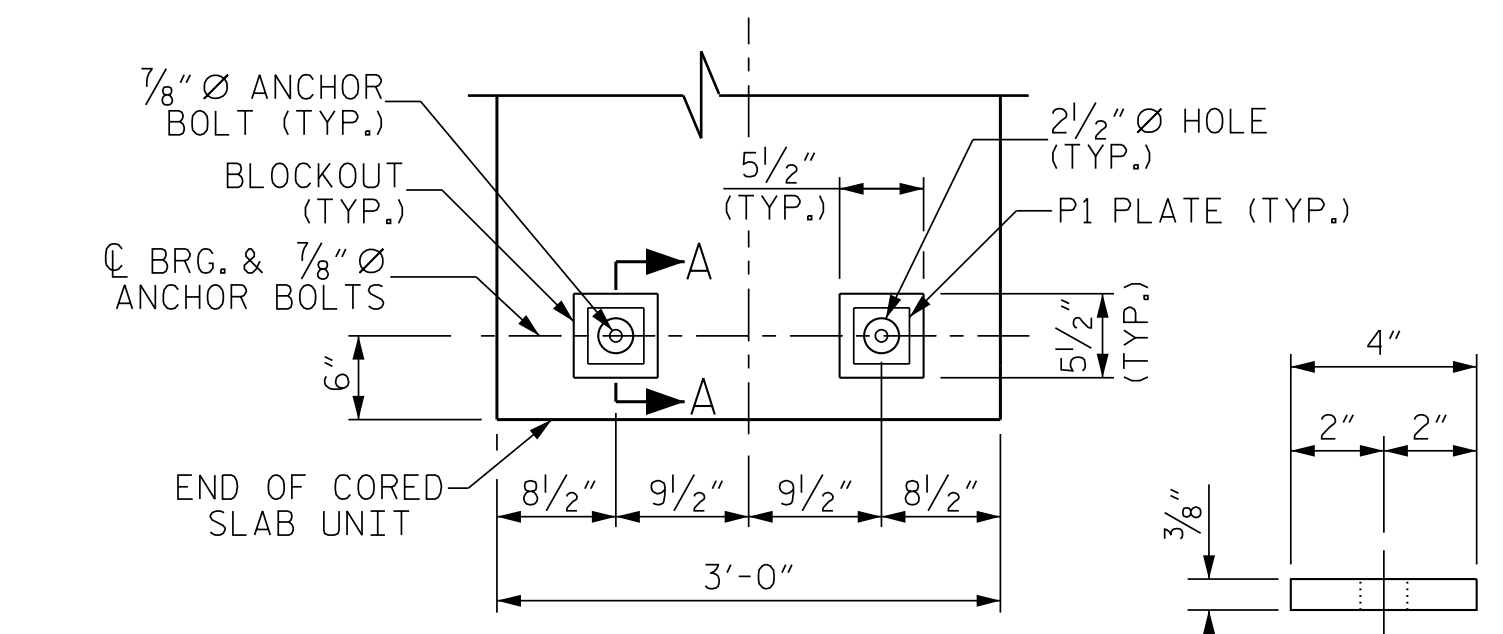


TYPICAL PLAN
 TYP. EACH END

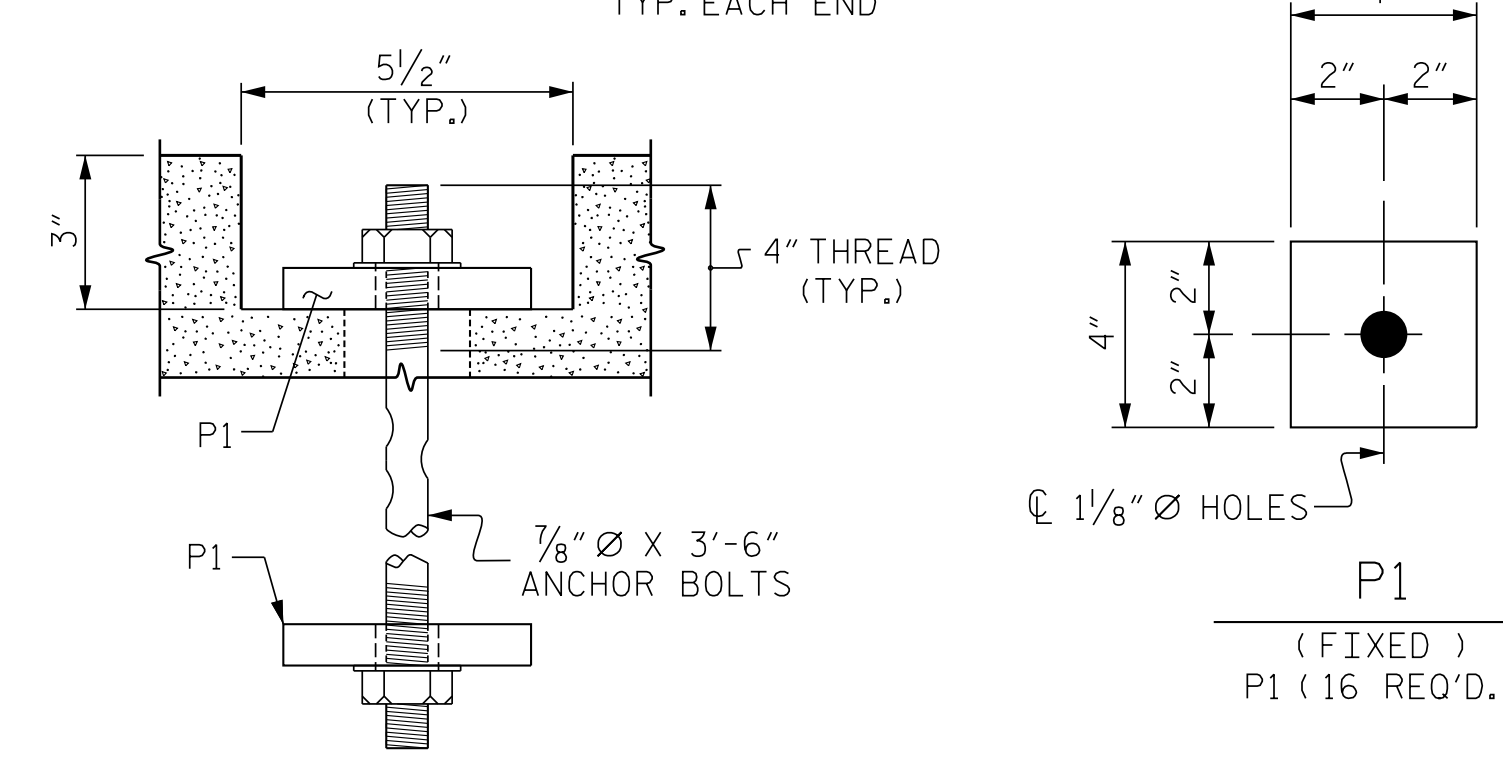


SECTION A-A
 (FIXED)

PLATE DETAILS


BLOCKOUT DETAIL FOR ANCHOR BOLTS

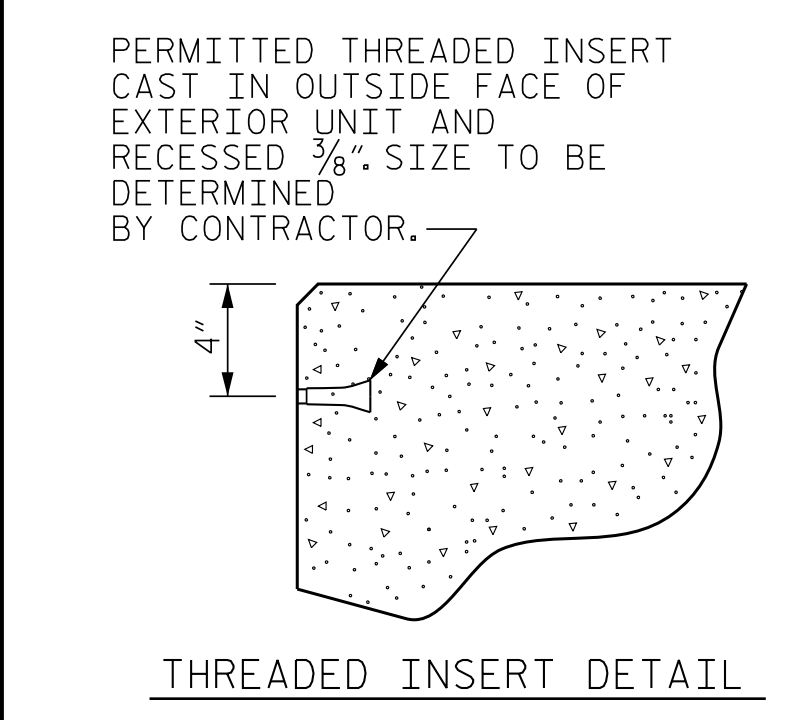

THREADED INSERT DETAIL

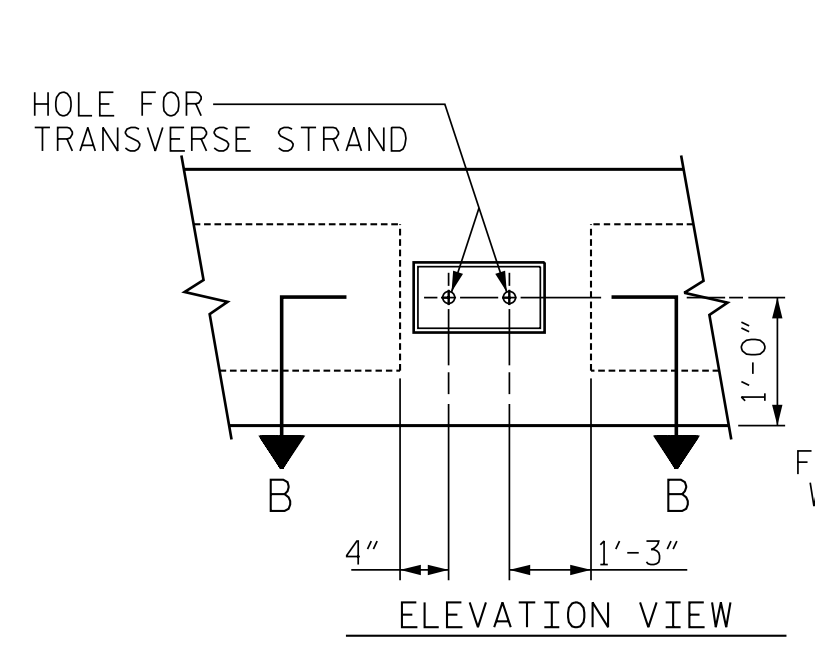


ELEVATION VIEW

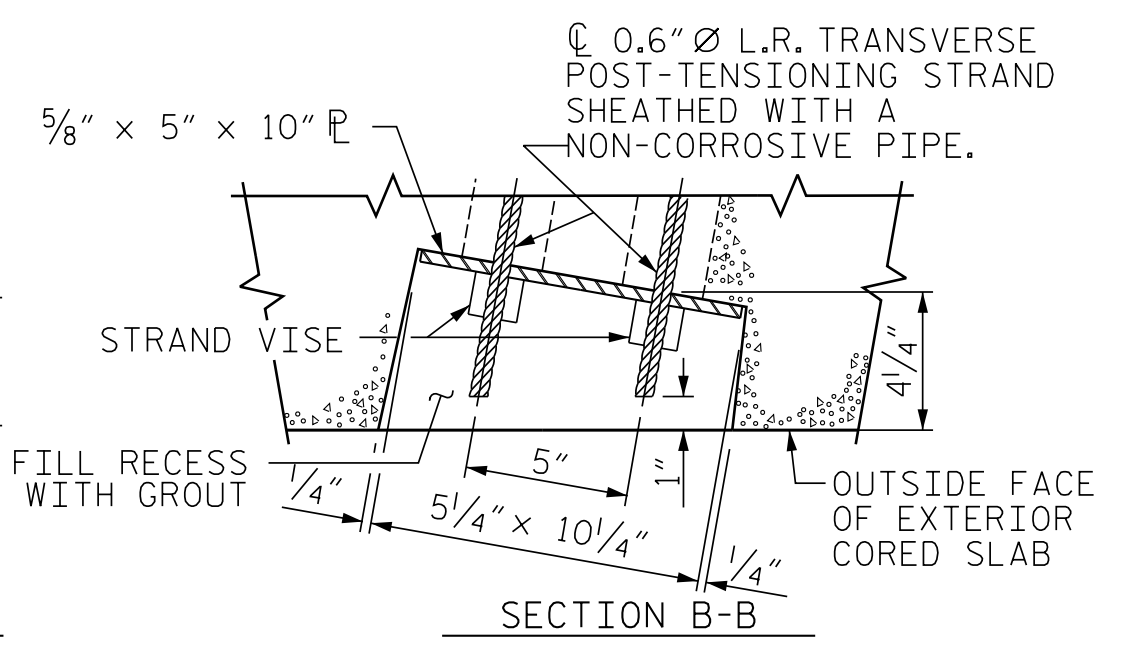

SECTION B-B


GROUTED RECESS AT END OF POST-TENSIONED STRAND CORED SLABS

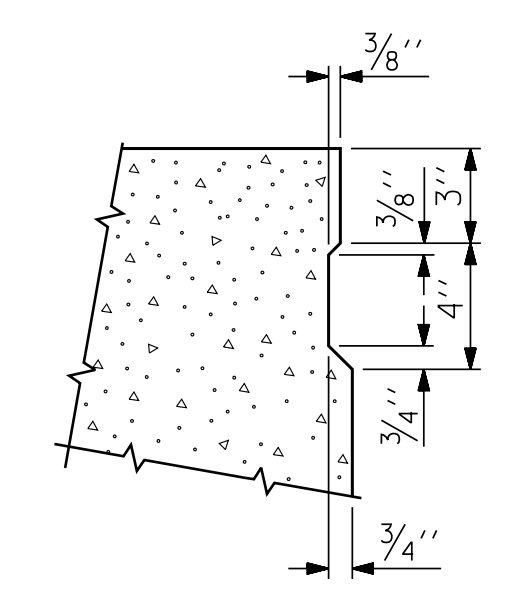


SHEAR KEY DETAIL

NOTE: OMIT SHEAR KEY ON OUTSIDE FACE OF EXTERIOR CORED SLABS.


DOCUMENT NOT CONSIDERED FINAL UNLESS ALL SIGNATURES COMPLETED

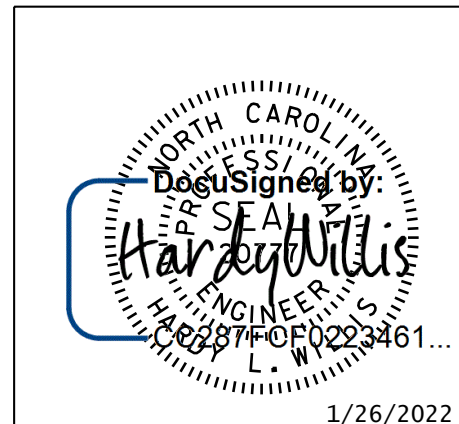

| | |
|-------------------------|------------|
| ENGINEER OF RECORD: JEB | DATE: 7/16 |
| ASSEMBLED BY: MAF | DATE: 7/16 |
| CHECKED BY: HLW | |
| DRAWN BY: MAA 6/10 | REV. 9/14 |
| CHECKED BY: MKT 7/10 | MAA/TMG |

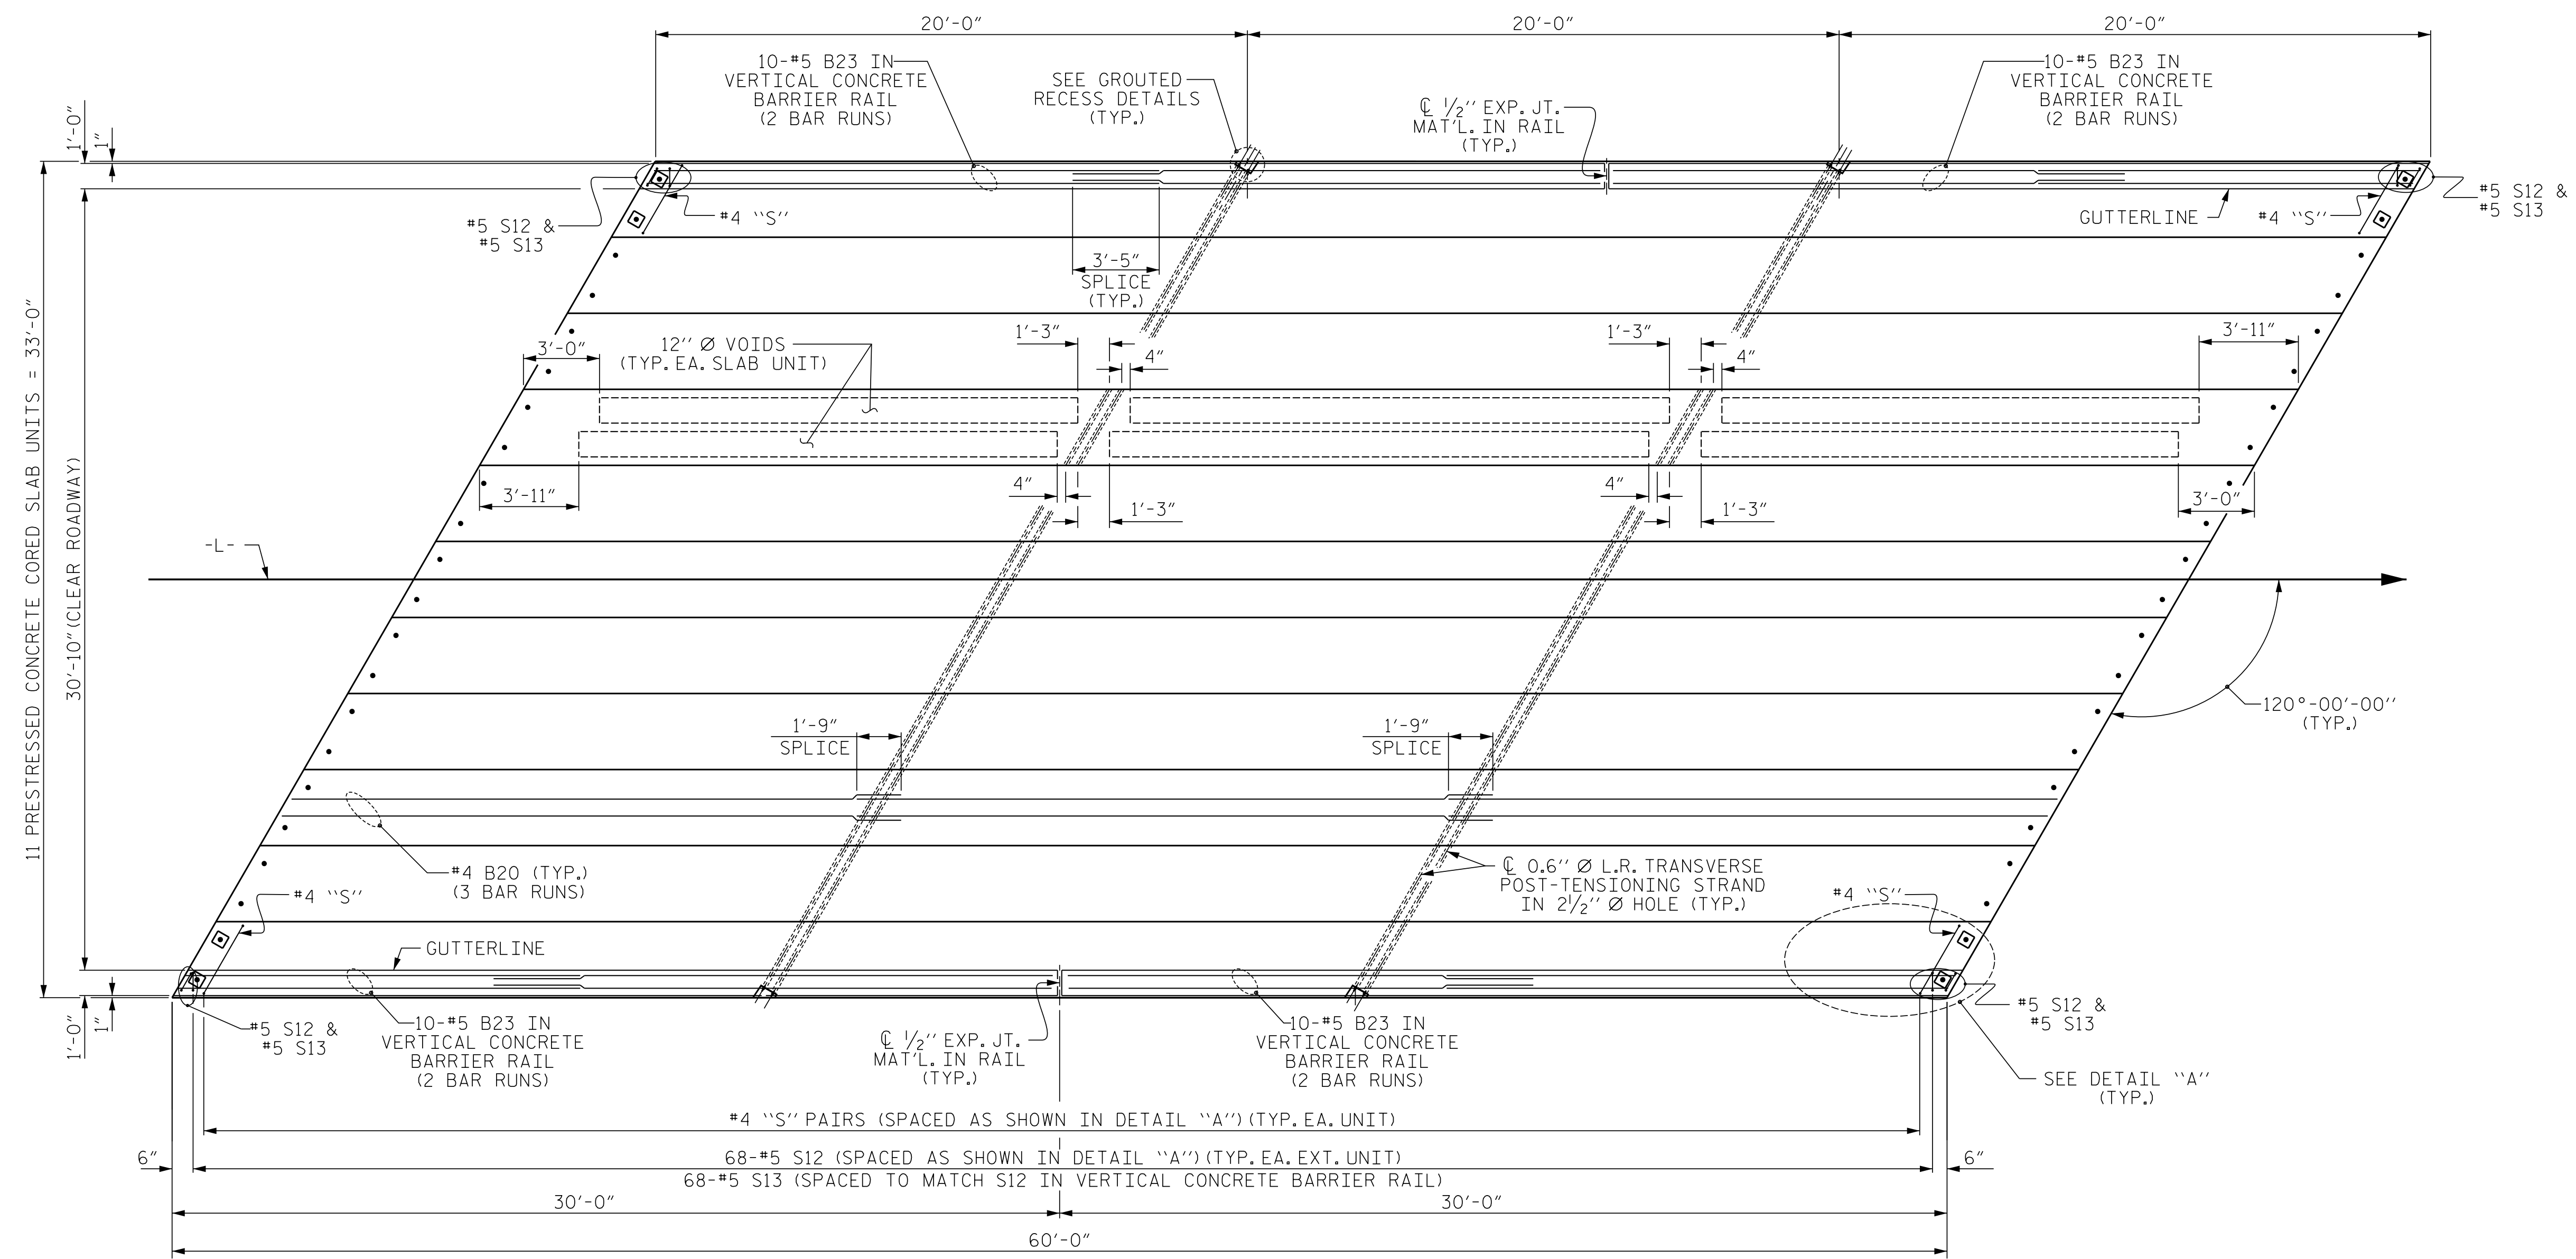


PLAN OF UNIT

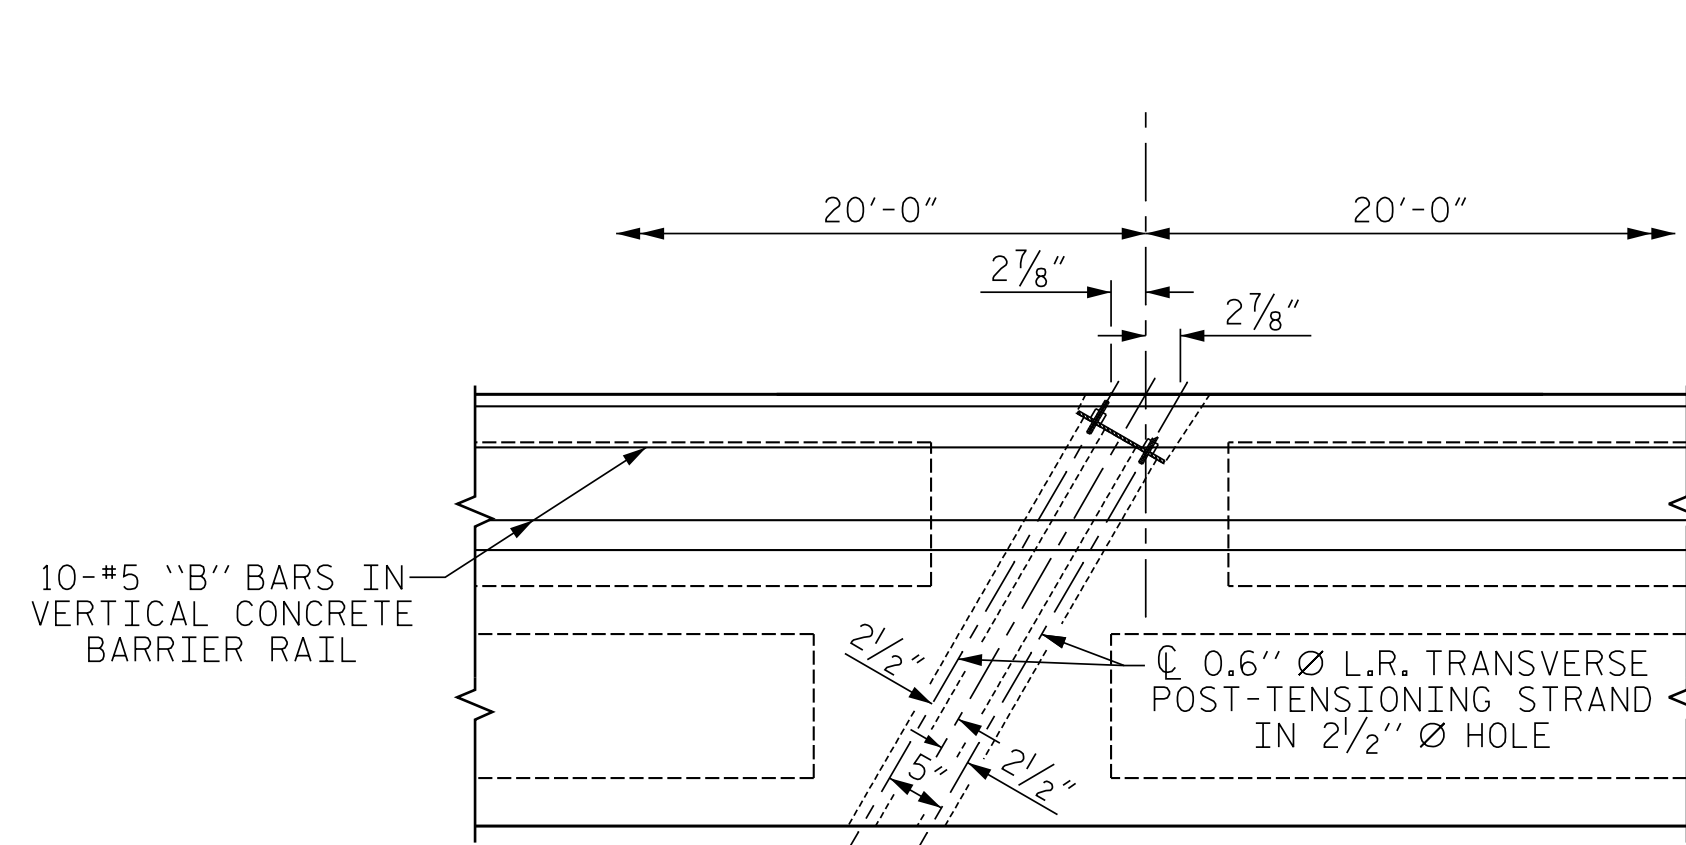

DETAIL "B"

#4 S11 BARS MAY BE SHIFTED AS NECESSARY TO MAINTAIN 1" CLEAR TO GROUDED RECESS AND 2 1/2" Ø TRANSVERSE POST-TENSIONING STRAND HOLES

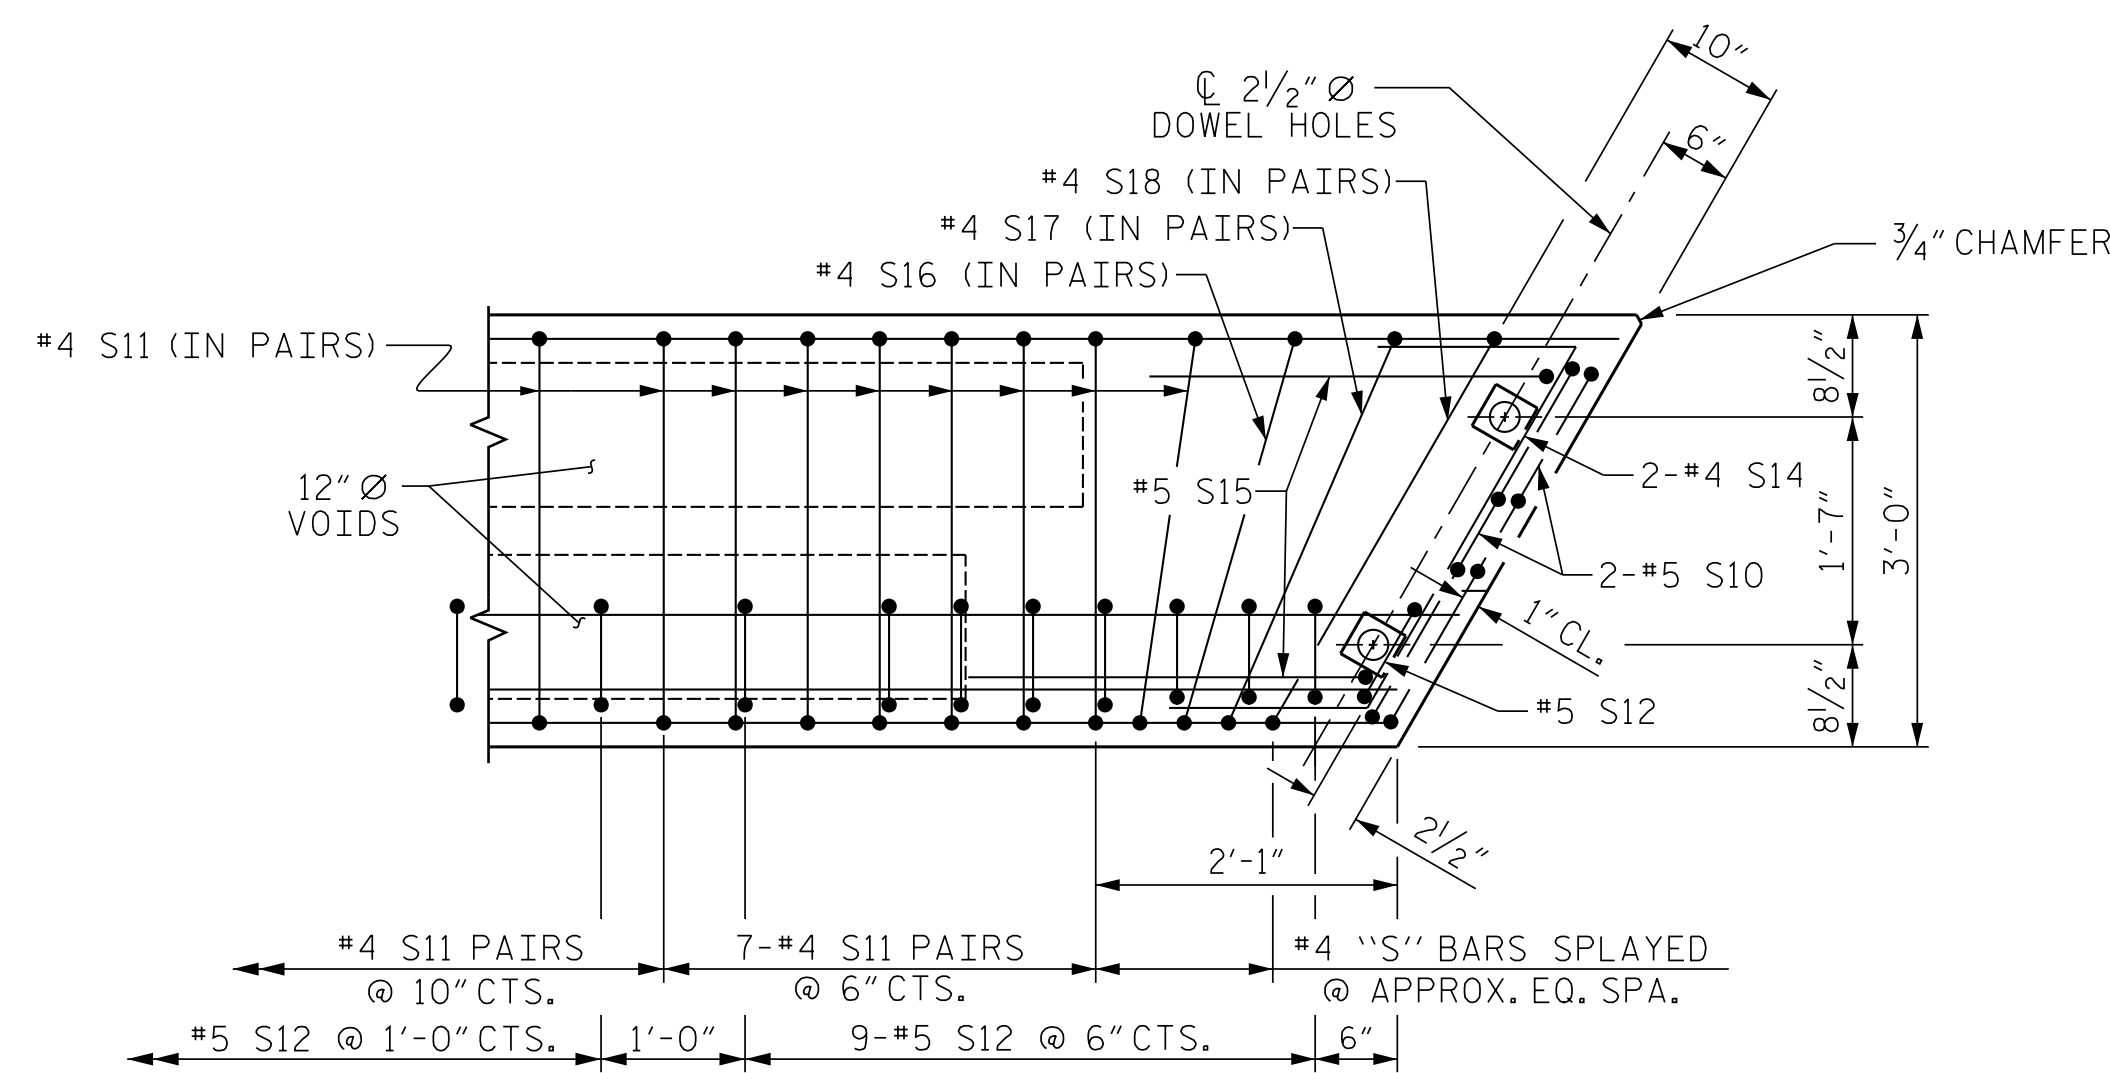


DETAIL "A"

(SIMILAR EACH END OF UNIT)
NOTE: EXTERIOR UNIT SHOWN - INTERIOR UNIT SIMILAR EXCEPT OMIT #5 S12 BARS.

| | | | |
|---------------------|-----|-------|--------------|
| ENGINEER OF RECORD: | JEB | DATE: | 7/16 |
| ASSEMBLED BY: | MAF | DATE: | 7/16 |
| CHECKED BY: | HLW | | |
| DRAWN BY: | MAA | 6/10 | REV. 12/5/11 |
| CHECKED BY: | MKT | 7/10 | REV. 8/14 |
| | | | MAA/TMC |
| | | | MAA/TMG |

DOCUMENT NOT CONSIDERED FINAL UNLESS ALL SIGNATURES COMPLETED

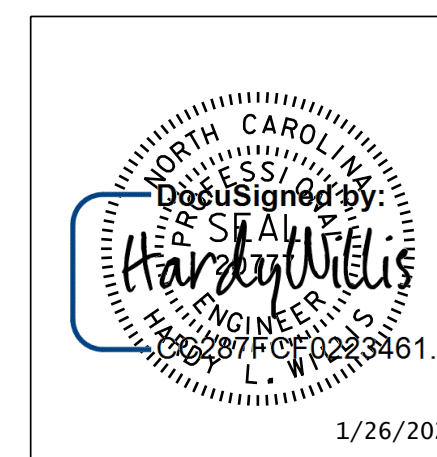

PROJECT NO. 14SP.20561.1
MACON COUNTY
STATION: 13+25.02 -L-


SHEET 2 OF 3

STATE OF NORTH CAROLINA
DEPARTMENT OF TRANSPORTATION
RALEIGH

PLAN OF 60' UNIT
30'-10" CLEAR ROADWAY

120° SKEW

| REVISIONS | | | | | | SHEET NO. |
|-----------|-----|-------|-----|-----|-------|--------------|
| NO. | BY: | DATE: | NO. | BY: | DATE: | S-5 |
| 1 | | | 3 | | | TOTAL SHEETS |
| 2 | | | 4 | | | 13 |

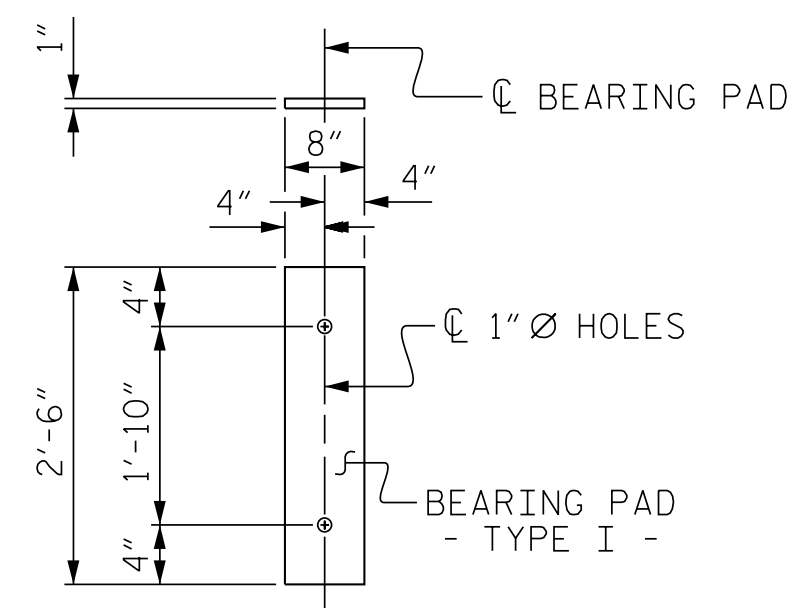

FIXED END
(TYPE I - 22 REQ'D)

ELASTOMERIC BEARING DETAILS


ELASTOMER IN ALL BEARINGS SHALL BE 60 DUROMETER HARDNESS.

| CORED SLABS REQUIRED | | | |
|----------------------|--------|--------|--------------|
| | NUMBER | LENGTH | TOTAL LENGTH |
| 60' UNIT | | | |
| EXTERIOR C.S. | 2 | 60'-0" | 120 |
| INTERIOR C.S. | 9 | 60'-0" | 540 |
| TOTAL | 11 | | 660 |

| BILL OF MATERIAL FOR ONE 60' CORED SLAB UNIT | | | | | | | |
|--|--------|------|----------|----------------------|----------------------|----------------------|----------------------|
| BAR | NUMBER | SIZE | TYPE | EXTERIOR UNIT LENGTH | EXTERIOR UNIT WEIGHT | INTERIOR UNIT LENGTH | INTERIOR UNIT WEIGHT |
| B20 | 6 | #4 | STR | 21'-2" | 85 | 21'-2" | 85 |
| S10 | 8 | #5 | 3 | 5'-0" | 42 | 5'-0" | 42 |
| S11 | 146 | #4 | 3 | 5'-10" | 569 | 5'-10" | 569 |
| *S12 | 70 | #5 | 1 | 5'-7" | 408 | | |
| S14 | 4 | #4 | 4 | 5'-11" | 16 | 5'-11" | 16 |
| S15 | 4 | #5 | 3 | 7'-1" | 30 | 7'-1" | 30 |
| S16 | 4 | #4 | 3 | 5'-11" | 16 | 5'-11" | 16 |
| S17 | 4 | #4 | 3 | 6'-1" | 16 | 6'-1" | 16 |
| S18 | 4 | #4 | 3 | 6'-3" | 17 | 6'-3" | 17 |
| REINFORCING STEEL | | | LBS. | | 791 | | 791 |
| *EPOXY COATED REINFORCING STEEL | | | LBS. | | 408 | | |
| 6000 P.S.I. CONCRETE | | | CU. YDS. | | 10.4 | | 10.4 |
| 0.6" Ø L.R. STRANDS | | | No. | | 24 | | 24 |

| DEAD LOAD DEFLECTION AND CAMBER | |
|--|----------------------------------|
| 60' CORED SLAB UNIT | 3'-0" x 2'-0" 0.6" Ø L.R. STRAND |
| CAMBER (SLAB ALONE IN PLACE) | 1 7/8" ↑ |
| DEFLECTION DUE TO SUPERIMPOSED DEAD LOAD** | 1/2" ↓ |
| FINAL CAMBER | 1 3/8" ↑ |

** INCLUDES FUTURE WEARING SURFACE

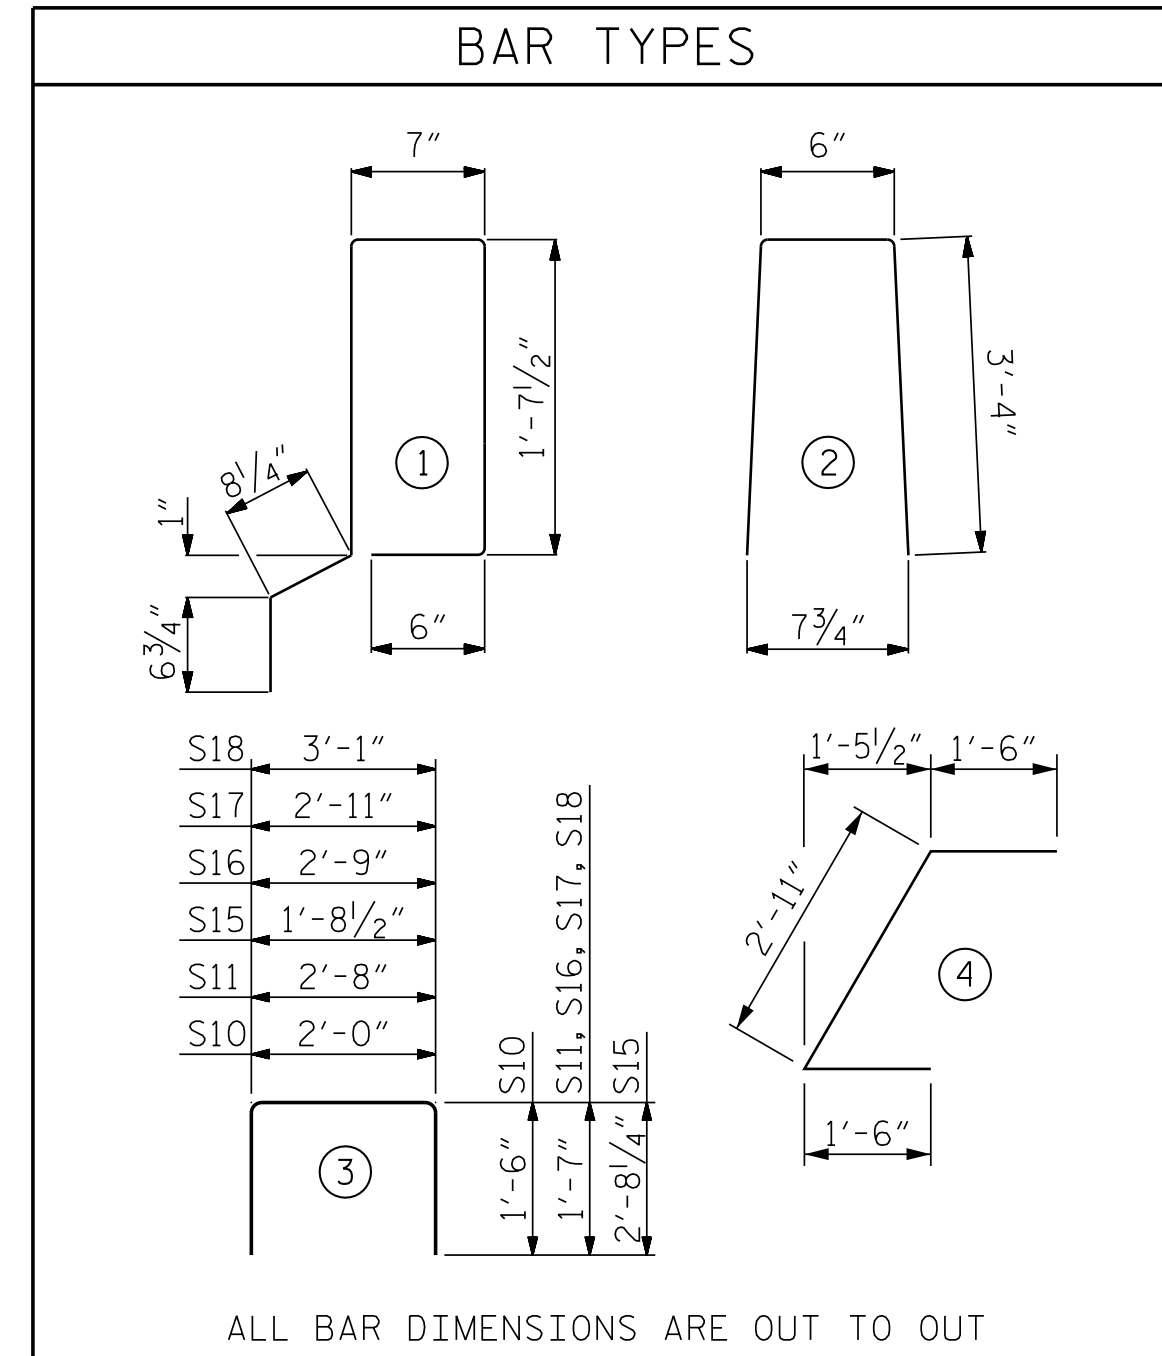

NOTES

ALL PRESTRESSING STRANDS SHALL BE 7-WIRE LOW RELAXATION GRADE 270 STRANDS AND SHALL CONFORM TO AASHTO M203 EXCEPT FOR SAMPLING REQUIREMENTS WHICH SHALL BE IN ACCORDANCE WITH THE STANDARD SPECIFICATIONS.

ALL REINFORCING STEEL CAST WITH THE CORED SLAB SECTIONS SHALL BE GRADE 60 AND SHALL BE INCLUDED IN THE UNIT PRICE BID FOR PRESTRESSED CONCRETE CORED SLABS.

RECESSES FOR TRANSVERSE STRANDS SHALL BE GROUTED AFTER THE TENSIONING OF THE STRANDS.

THE 2 1/2" Ø DOWEL HOLES AT FIXED ENDS OF SLAB SECTIONS SHALL BE FILLED WITH NON-SHRINK GROUT.

THE BACKER RODS SHALL CONFORM TO THE REQUIREMENTS OF TYPE M BOND BREAKER. SEE SECTION 1028 OF THE STANDARD SPECIFICATIONS.

WHEN CORED SLABS ARE CAST, AN INTERNAL HOLD-DOWN SYSTEM SHALL BE EMPLOYED TO PREVENT VOIDS FROM RISING OR MOVING SIDEWAYS. AT LEAST SIX WEEKS PRIOR TO CASTING CORED SLABS, THE CONTRACTOR SHALL SUBMIT TO THE ENGINEER FOR REVIEW AND COMMENT, DETAILED DRAWINGS OF THE PROPOSED HOLD-DOWN SYSTEM. IN ADDITION TO STRUCTURAL DETAILS, LOCATION AND SPACING OF THE HOLD-DOWNS SHALL BE INDICATED.

THE TRANSFER OF LOAD FROM THE ANCHORAGES TO THE CORED SLAB UNIT SHALL BE DONE WHEN THE CONCRETE HAS REACHED A COMPRESSIVE STRENGTH OF NOT LESS THAN THE REQUIRED STRENGTH SHOWN IN THE "CONCRETE RELEASE STRENGTH" TABLE.




ALL REINFORCING STEEL IN VERTICAL CONCRETE BARRIER RAILS SHALL BE EPOXY COATED.

PRESTRESSING STRANDS SHALL BE CUT FLUSH WITH THE CORED SLAB UNIT ENDS.

APPLY EPOXY PROTECTIVE COATING TO CORED SLAB UNIT ENDS.

| BILL OF MATERIAL FOR VERTICAL CONCRETE BARRIER RAIL | | | | | | |
|---|---------------------------------|-----------|------|------|----------|--------|
| BAR | BARS PER PAIR OF EXTERIOR UNITS | TOTAL NO. | SIZE | TYPE | LENGTH | WEIGHT |
| | | | | | | |
| | | | | | | |
| *B23 | 80 | 80 | #5 | STR | 16'-11" | 1412 |
| *S13 | 140 | 140 | #5 | 2 | 7'-2" | 1046 |
| *EPOXY COATED REINFORCING STEEL | | | | | LBS. | 2458 |
| CLASS AA CONCRETE | | | | | CU. YDS. | 15.5 |
| TOTAL VERTICAL CONCRETE BARRIER RAIL | | | | | LN. FT. | 120.29 |


| GUTTERLINE ASPHALT THICKNESS & RAIL HEIGHT | | |
|--|--------------------------------------|------------------------|
| | ASPHALT OVERLAY THICKNESS @ MID-SPAN | RAIL HEIGHT @ MID-SPAN |
| 60' UNITS | 2 1/8" | 3'-8 1/8" |

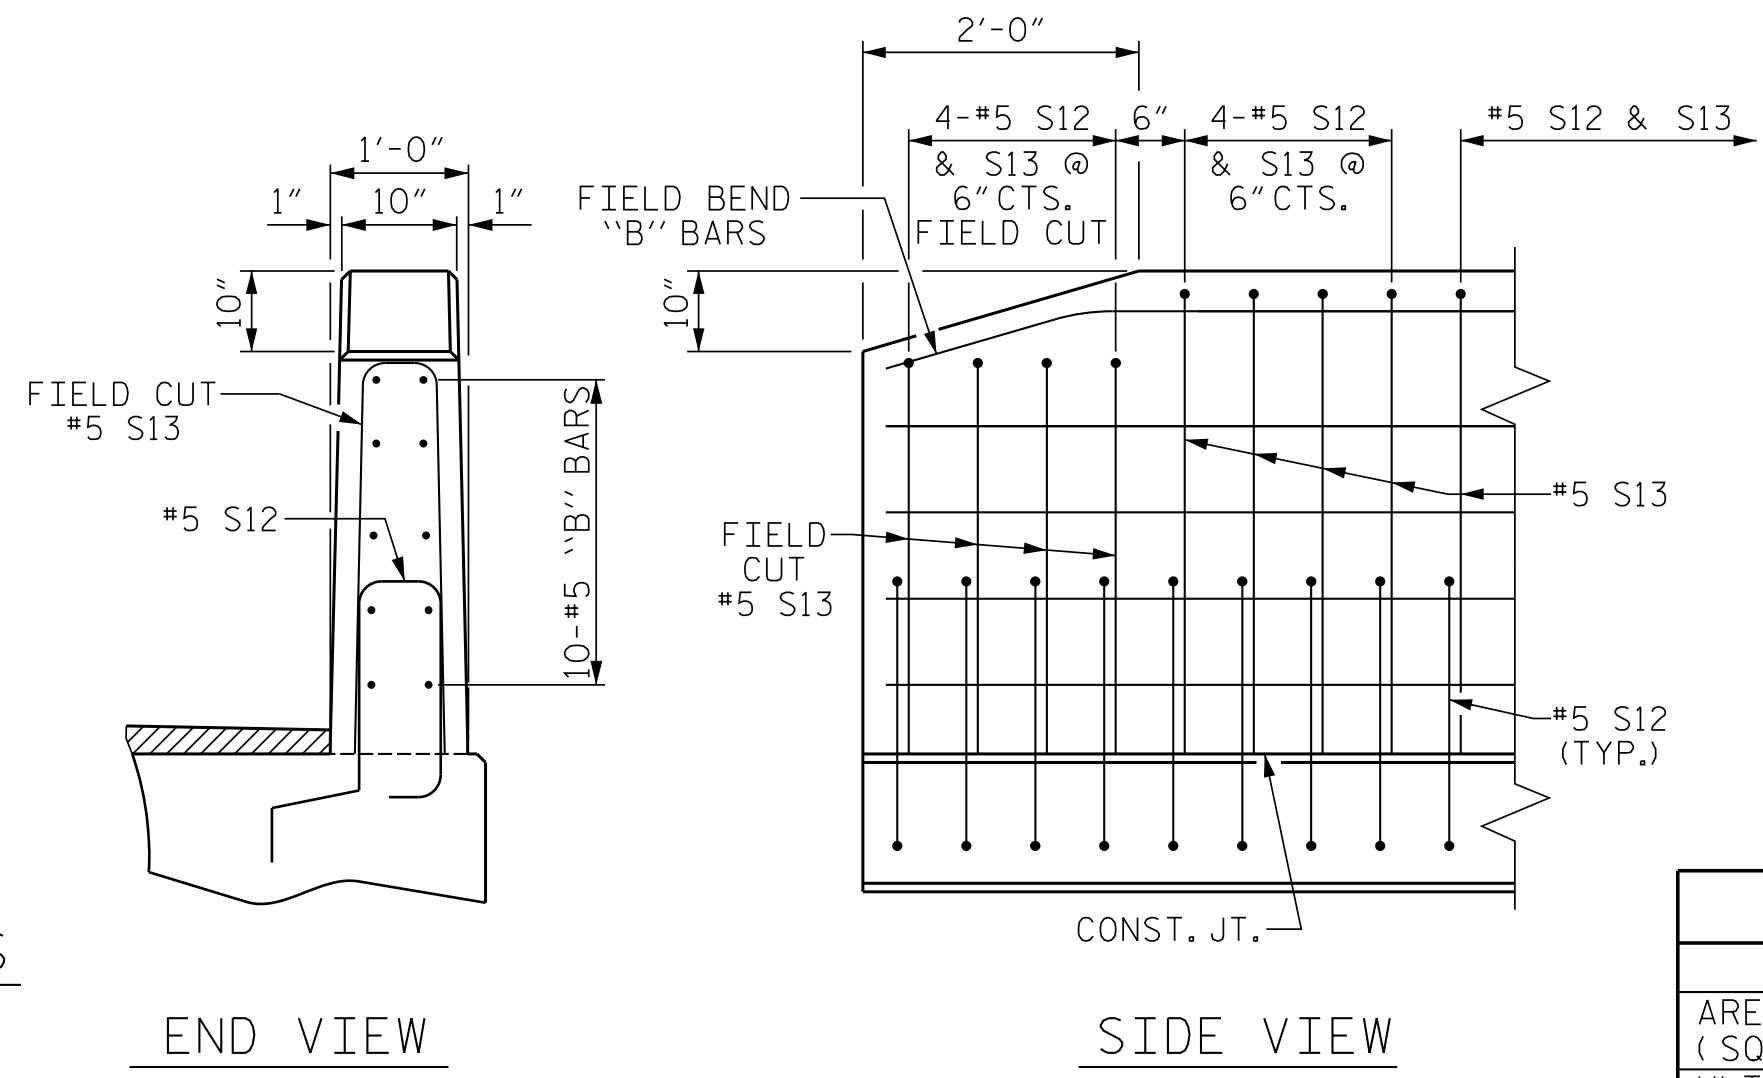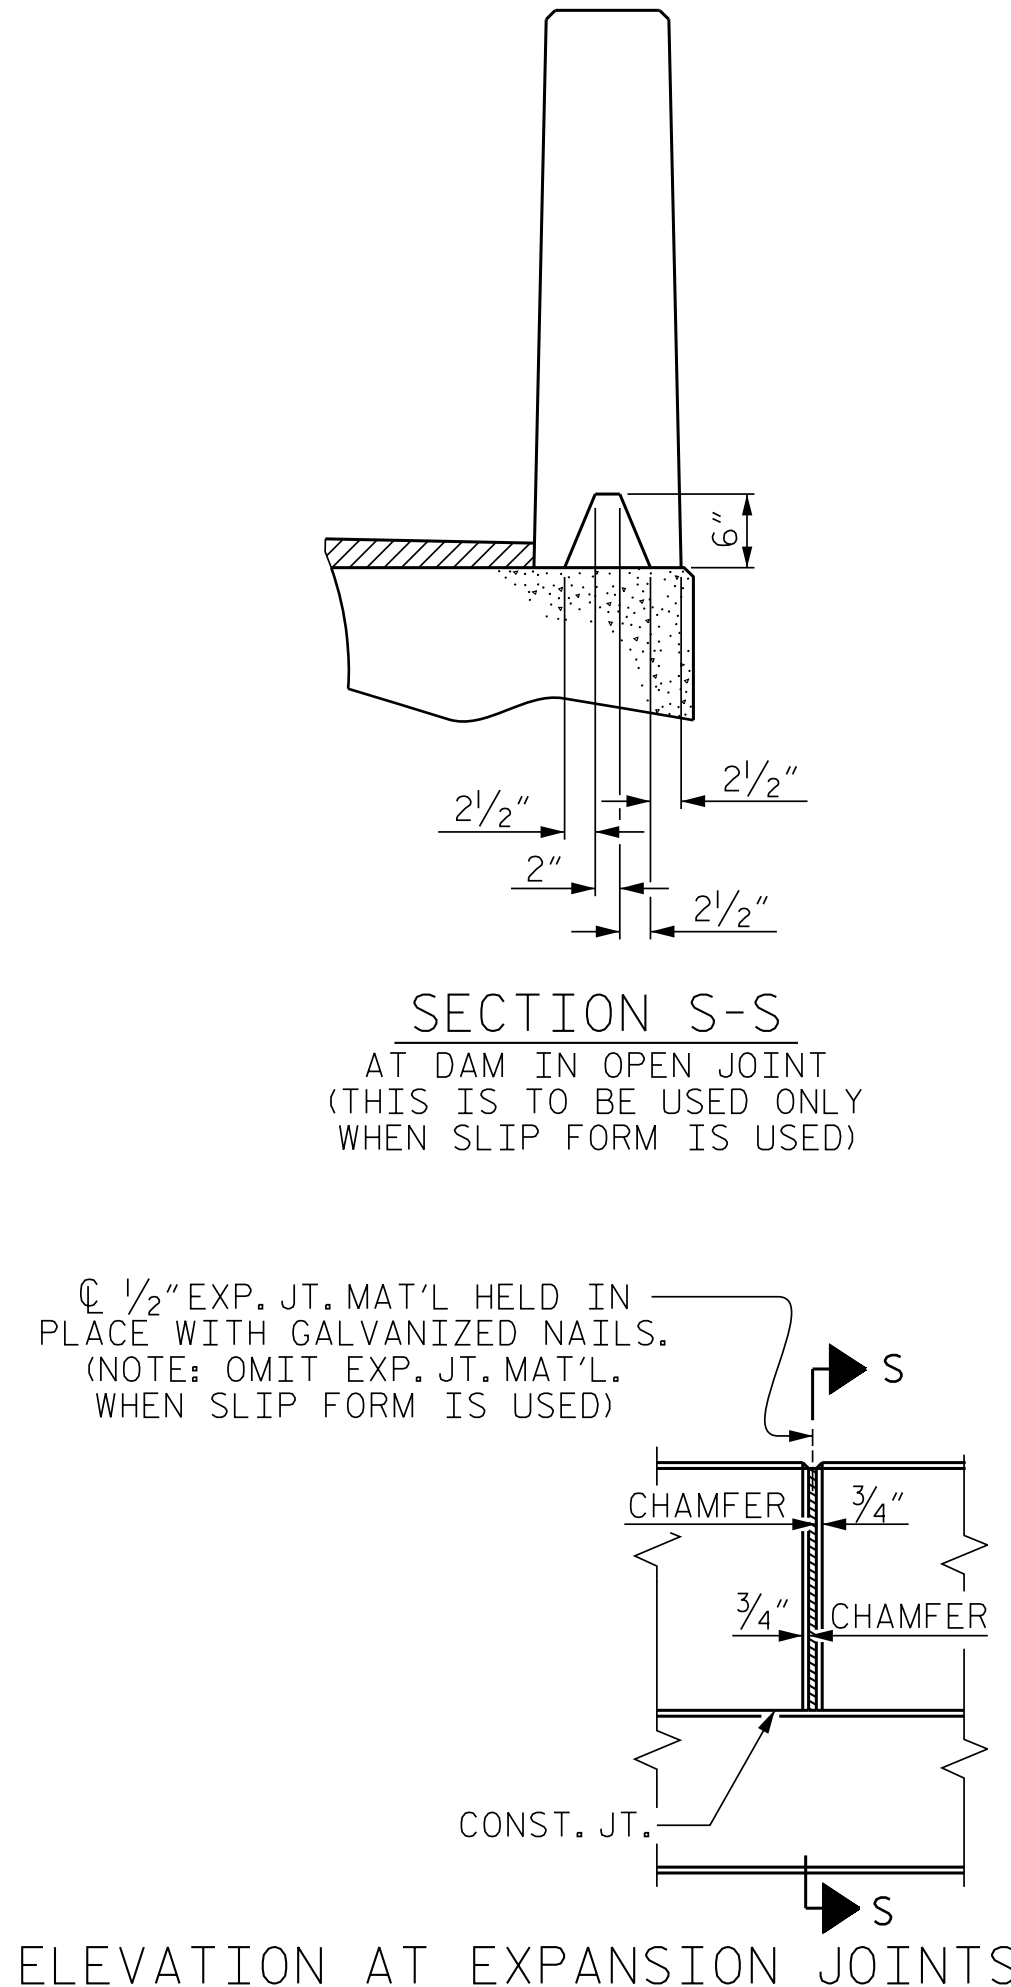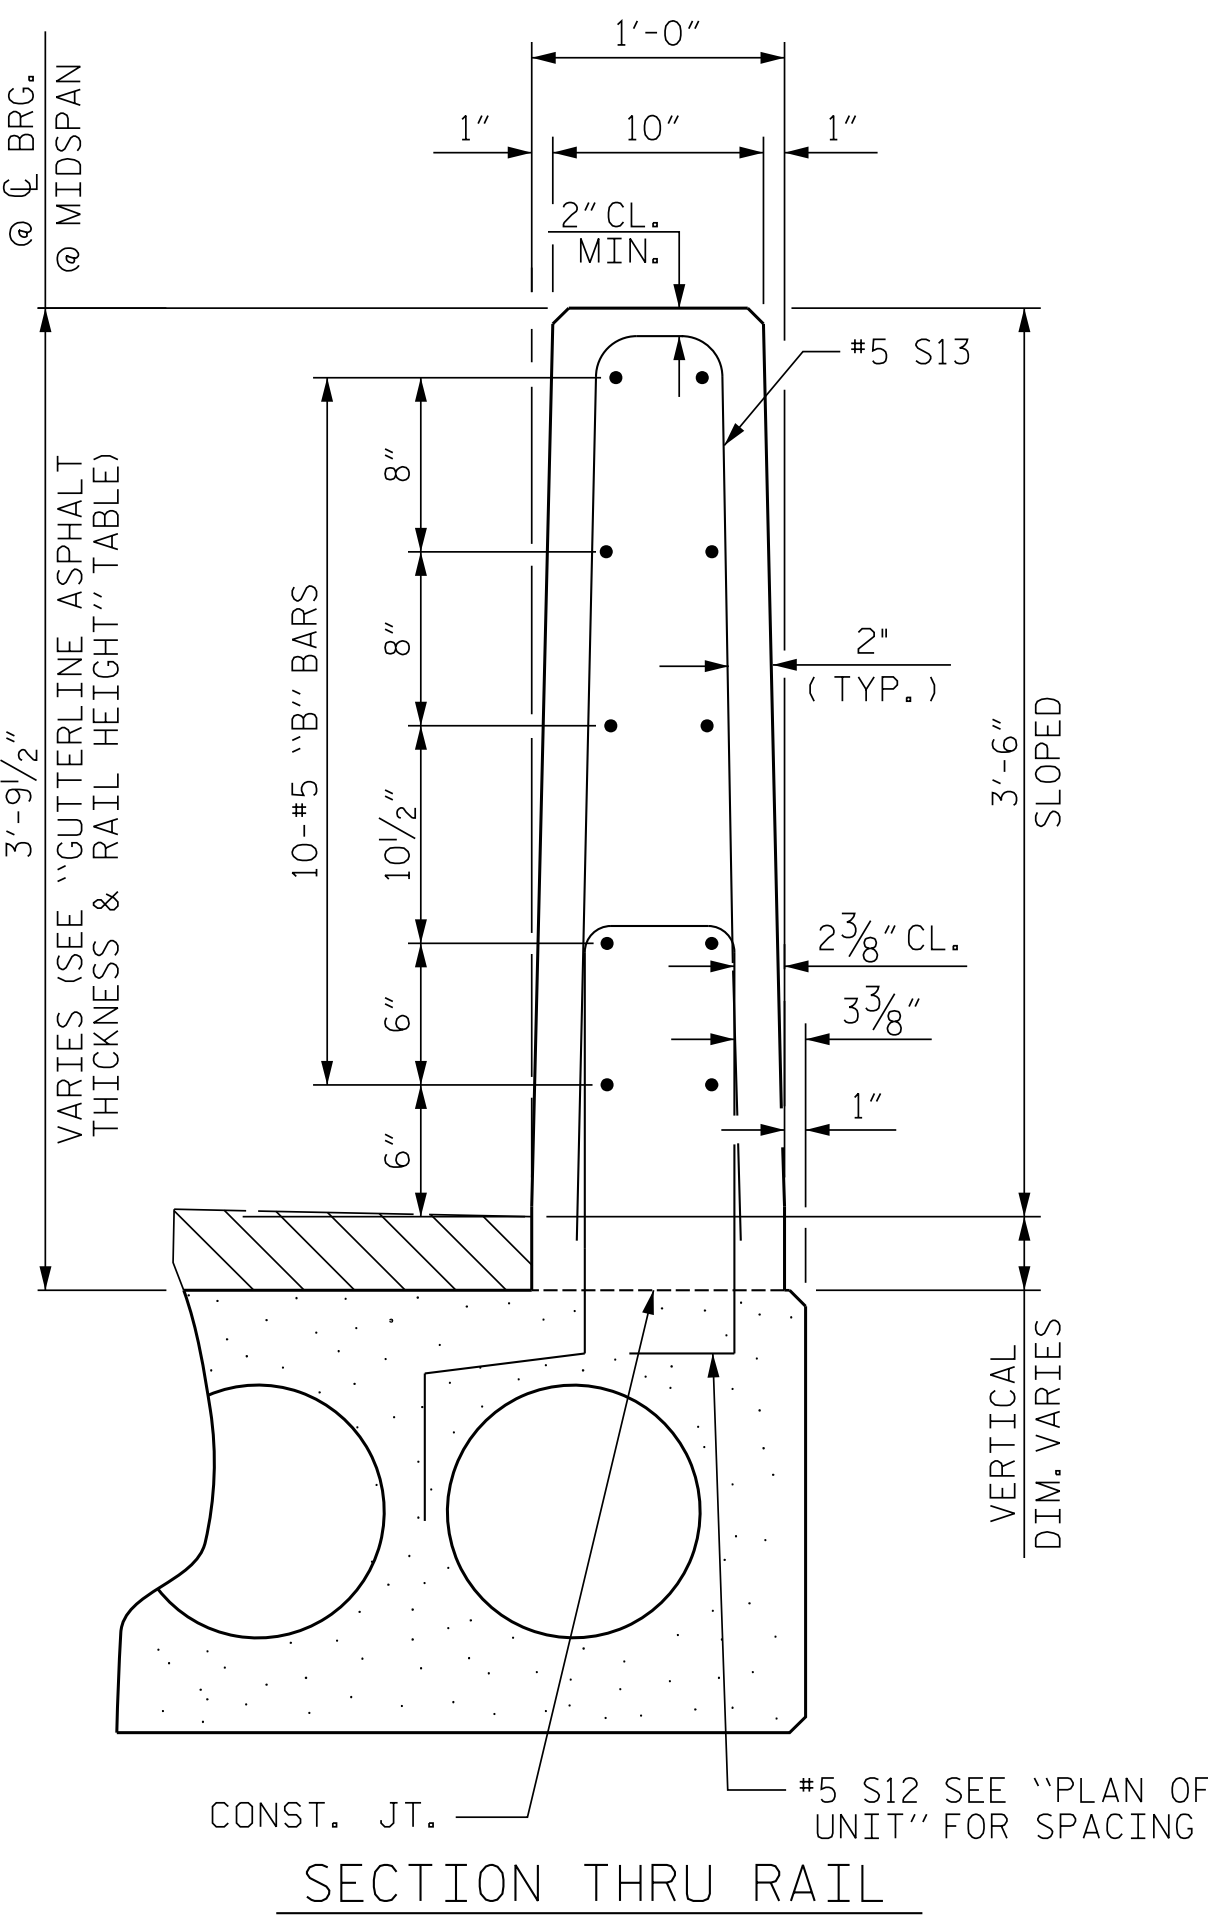

| CONCRETE RELEASE STRENGTH | |
|---------------------------|------|
| UNIT | PSI |
| 60' UNITS | 4800 |

| GRADE 270 STRANDS | |
|---------------------------------------|-------------|
| | 0.6" Ø L.R. |
| AREA (SQUARE INCHES) | 0.217 |
| ULTIMATE STRENGTH (LBS. PER STRAND) | 58,600 |
| APPLIED PRESTRESS (LBS. PER STRAND) | 43,950 |

DOCUMENT NOT CONSIDERED FINAL UNLESS ALL SIGNATURES COMPLETED

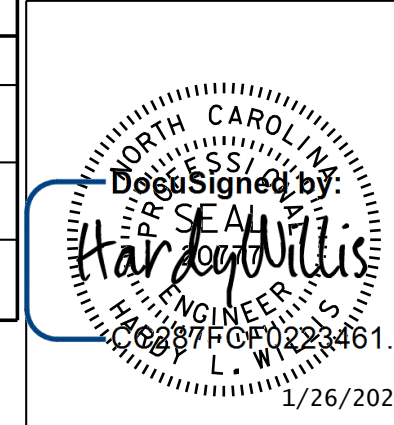

PROJECT NO. 14SP.20561.1
MACON COUNTY
STATION: 13+25.02 -L-

SHEET 3 OF 3
STATE OF NORTH CAROLINA
DEPARTMENT OF TRANSPORTATION
RALEIGH
STANDARD
3'-0" X 2'-0"
PRESTRESSED CONCRETE
CORED SLAB UNIT

| REVISIONS | | | | | | SHEET NO. |
|-----------|-----|-------|-----|-----|-------|-----------------|
| NO. | BY: | DATE: | NO. | BY: | DATE: | S-6 |
| 1 | | | 3 | | | TOTAL SHEETS 13 |
| 2 | | | 4 | | | |

| | |
|-------------------------|-------------------|
| ENGINEER OF RECORD: JEB | DATE: 7/16 |
| ASSEMBLED BY: MAF | DATE: 7/16 |
| CHECKED BY: HLW | |
| DRAWN BY: MAA 6/10 | REV. 5/18 MAA/THC |
| CHECKED BY: MKT 7/10 | |

NOTES

THE GUARDRAIL ANCHOR ASSEMBLY SHALL CONSIST OF A 1/4" HOLD DOWN PLATE AND 7 - 7/8" Ø BOLTS WITH NUTS AND WASHERS.

THE HOLD-DOWN PLATE SHALL CONFORM TO AASHTO M270 GRADE 36. AFTER FABRICATION, THE HOLD-DOWN PLATE SHALL BE HOT-DIP GALVANIZED IN ACCORDANCE WITH AASHTO M111.

BOLTS SHALL CONFORM TO THE REQUIREMENTS OF ASTM A307 AND NUTS SHALL CONFORM TO THE REQUIREMENTS OF AASHTO M291. BOLTS, NUTS AND WASHERS SHALL BE GALVANIZED. (AT THE CONTRACTOR'S OPTION, STAINLESS STEEL BOLTS, NUTS AND WASHERS MAY BE USED AS AN ALTERNATE FOR THE 7/8" Ø GALVANIZED BOLTS, NUTS AND WASHERS. THEY SHALL CONFORM TO OR EXCEED THE MECHANICAL REQUIREMENTS OF ASTM A307. THE USE OF THIS ALTERNATE SHALL BE APPROVED BY THE ENGINEER.)


THE GUARDRAIL ANCHOR ASSEMBLY IS REQUIRED AT ALL POINTS WHERE APPROACH GUARDRAIL IS TO BE ATTACHED TO THE END OF BARRIER RAIL. FOR POINTS OF ATTACHMENT, SEE SKETCH.

AFTER INSTALLATION, THE EXPOSED THREAD OF THE BOLT SHALL BE BURRED WITH A SHARP POINTED TOOL.




THE COST OF THE GUARDRAIL ANCHOR ASSEMBLY SHALL BE INCLUDED IN THE UNIT CONTRACT PRICE BID FOR VERTICAL CONCRETE BARRIER RAIL.

THE VERTICAL REINFORCING BARS MAY BE SHIFTED SLIGHTLY IN THE VERTICAL CONCRETE BARRIER RAIL TO CLEAR ASSEMBLY BOLTS.

THE 1 1/4" Ø HOLES SHALL BE FORMED OR DRILLED WITH A CORE BIT. IMPACT TOOLS WILL NOT BE PERMITTED. ANY CONCRETE DAMAGED BY THIS WORK SHALL BE REPAIRED TO THE SATISFACTION OF THE ENGINEER.

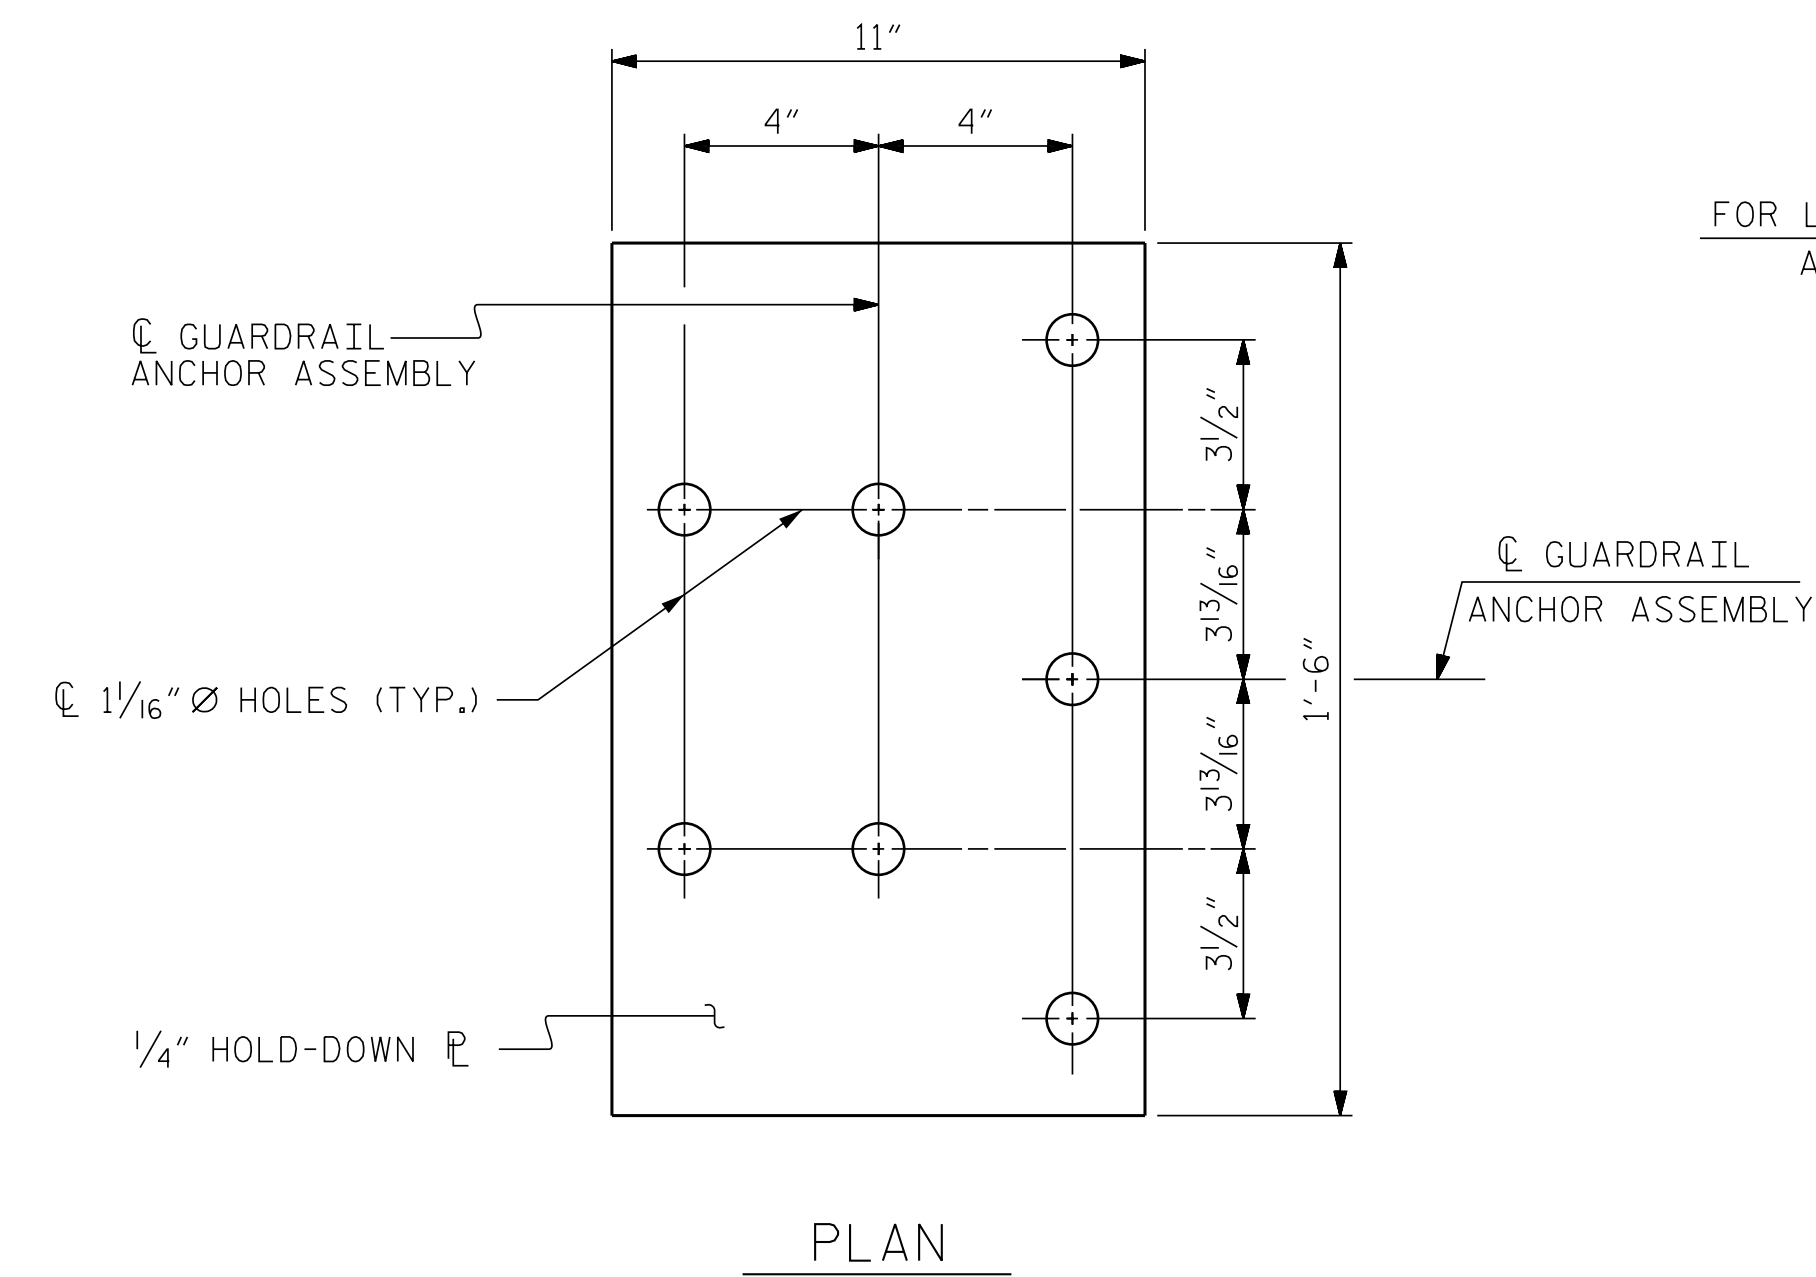


FOR LOCATION OF GUARDRAIL ANCHOR ASSEMBLY, SEE "PLAN" BELOW

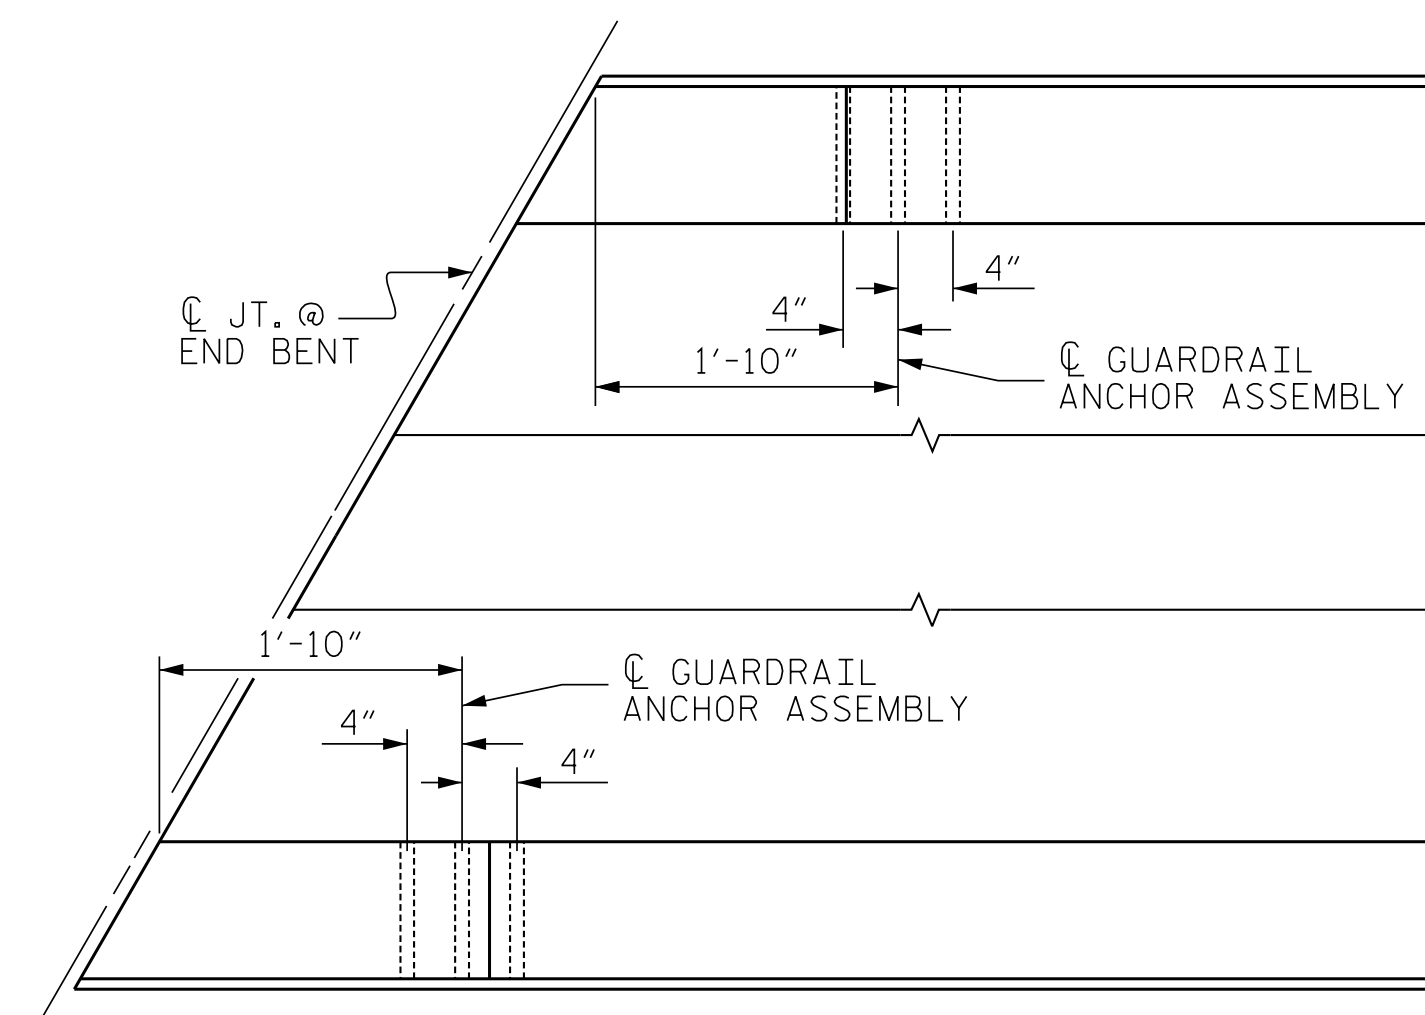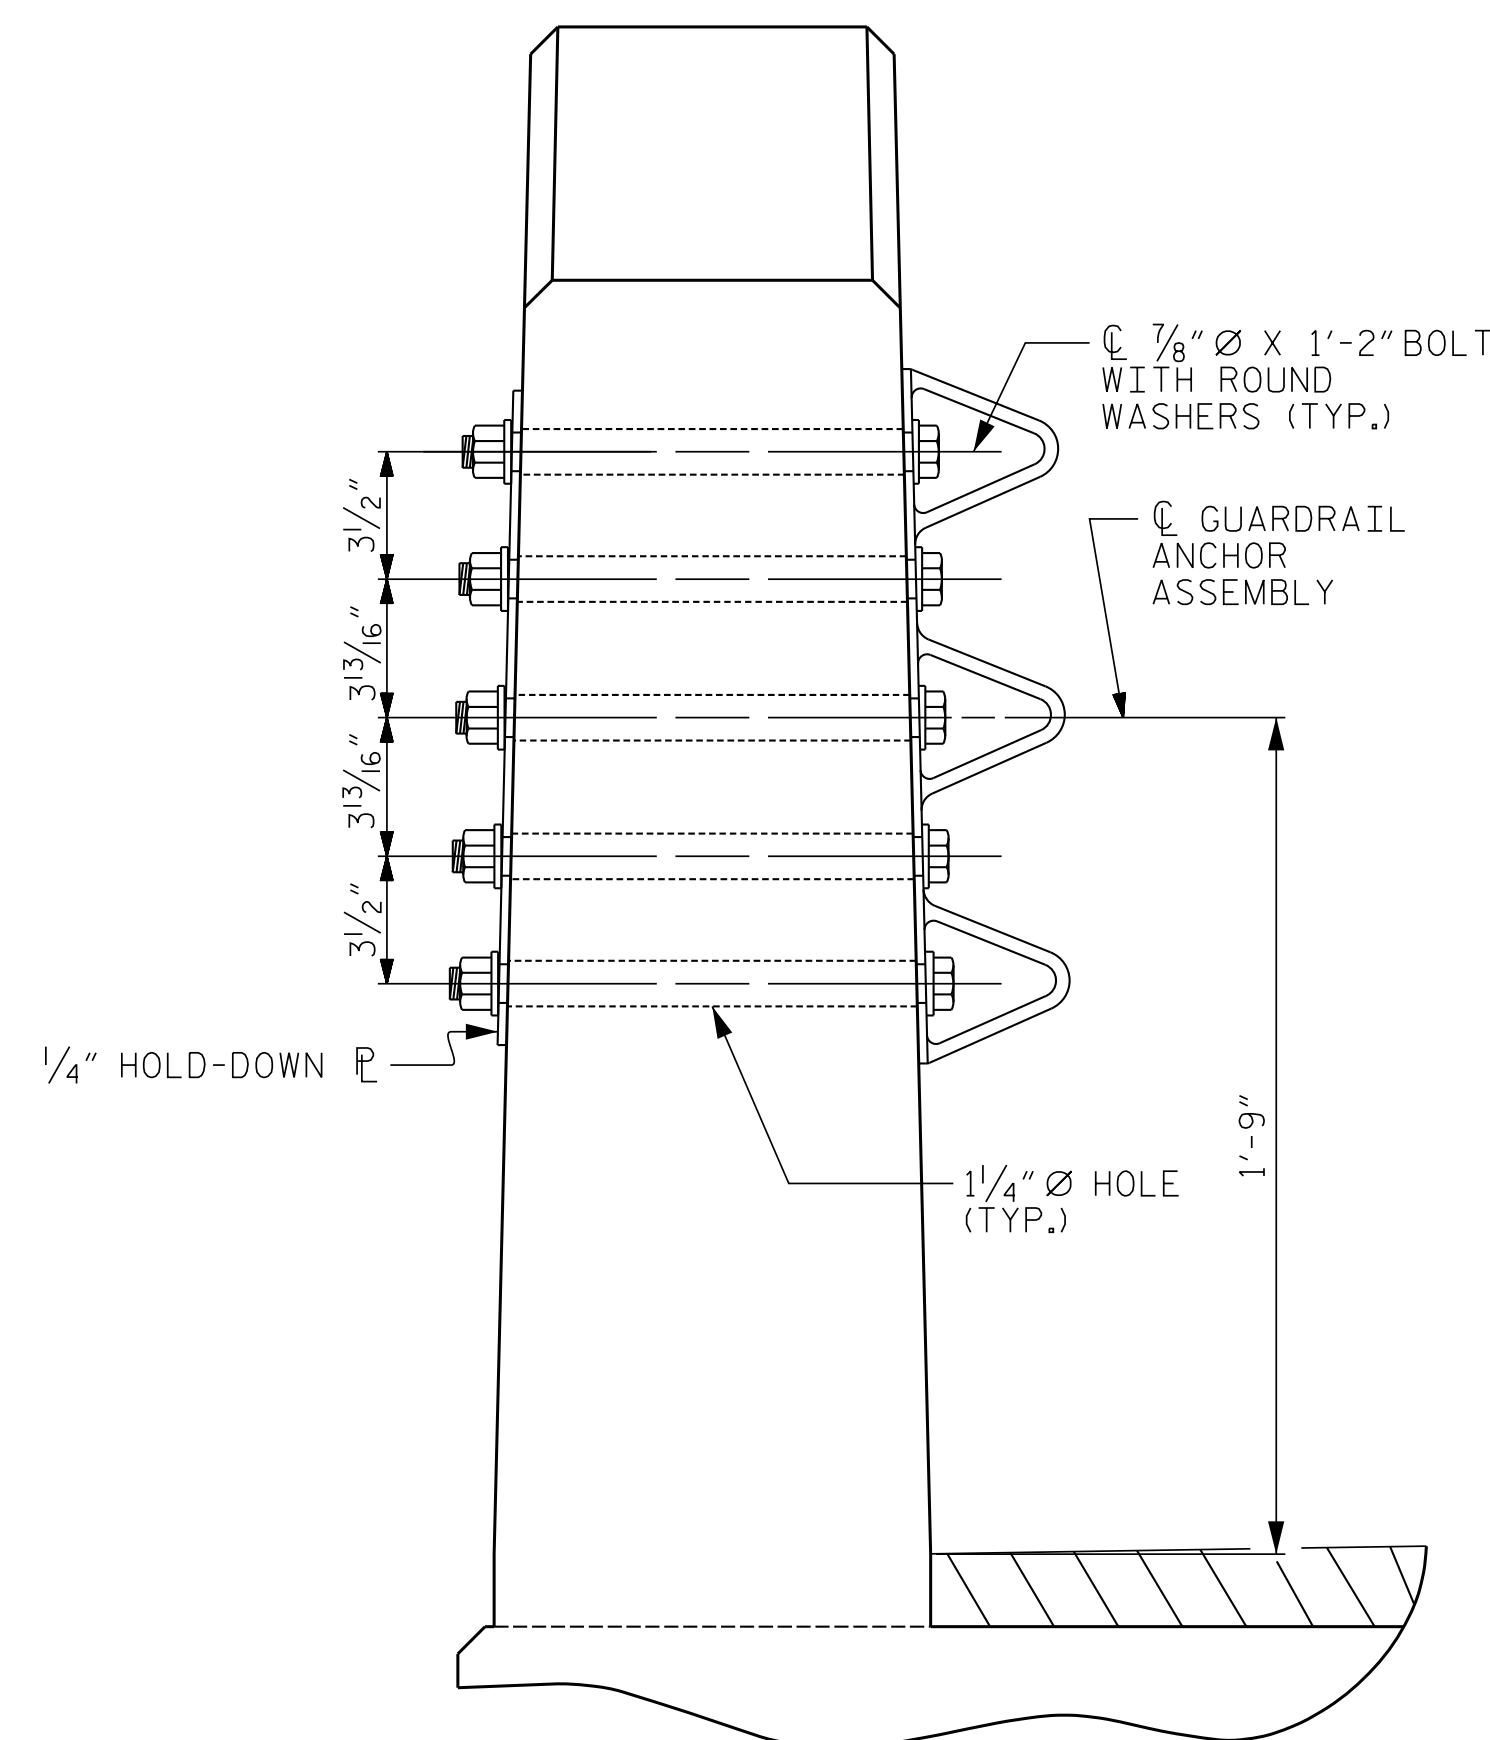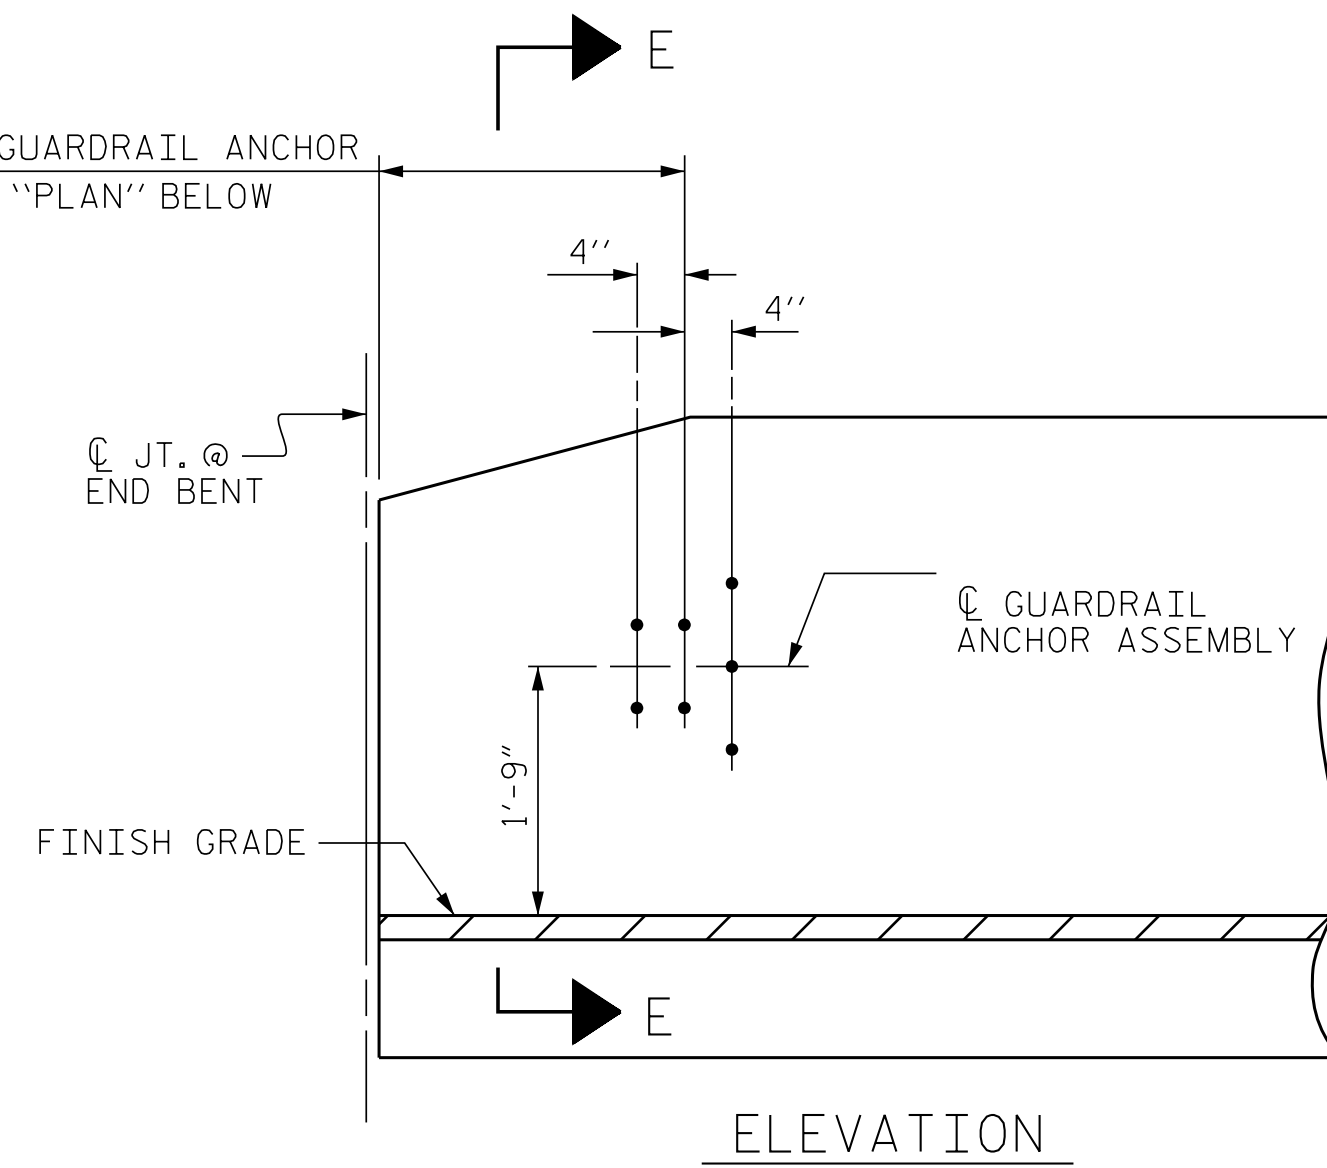


LOCATION OF ANCHORS FOR GUARDRAIL

END BENT #1 SHOWN, END BENT #2 SIMILAR.

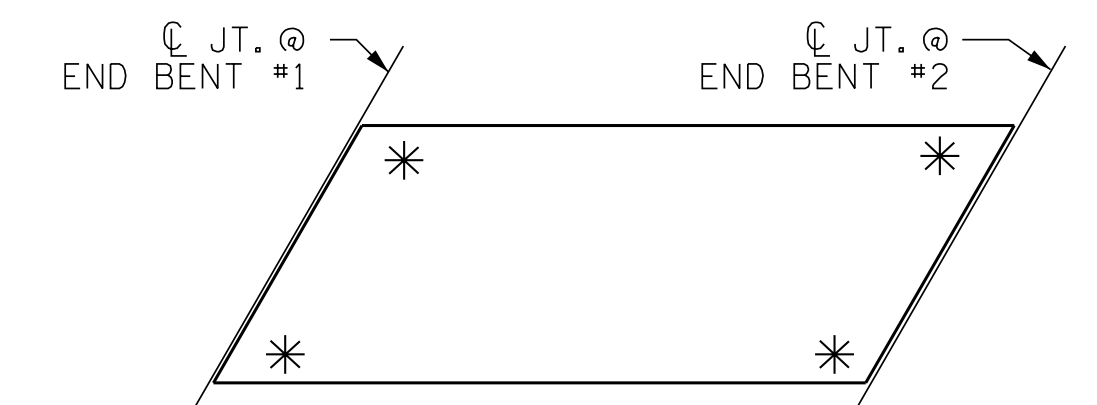

* DENOTES GUARDRAIL ANCHOR ASSEMBLY

PROJECT NO. 14SP.20561.1
MACON COUNTY
STATION: 13+25.02 -L-

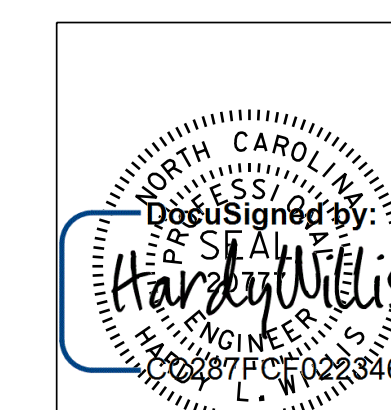

STATE OF NORTH CAROLINA
DEPARTMENT OF TRANSPORTATION
RALEIGH
STANDARD
GUARDRAIL ANCHORAGE
DETAILS
FOR VERTICAL CONCRETE
BARRIER RAIL

| | |
|--------------------------|--------------------|
| ENGINEER OF RECORD : JEB | DATE : 7/16 |
| ASSEMBLED BY : MAF | DATE : 7/16 |
| CHECKED BY : HLW | |
| DRAWN BY : MAA 5/10 | REV. 1/15 MAA/TMG |
| CHECKED BY : GM 5/10 | REV. 12/17 MAA/THC |
| | REV. 5/18 MAA/THC |

DOCUMENT NOT CONSIDERED FINAL UNLESS ALL SIGNATURES COMPLETED

| REVISIONS | | | | | | SHEET NO. |
|-----------|-----|-------|-----|-----|-------|--------------|
| NO. | BY: | DATE: | NO. | BY: | DATE: | S-7 |
| 1 | | | 3 | | | TOTAL SHEETS |
| 2 | | | 4 | | | 13 |


NOTES

STIRRUPS IN CAP MAY BE SHIFTED AS NECESSARY TO CLEAR DOWELS.


THE CONCRETE IN THE SHADED AREA OF THE WING SHALL BE POURED AFTER THE VERTICAL CONCRETE BARRIER RAIL IS CAST IF SLIP FORMING IS USED.

FOR PILE SPLICE DETAILS, SEE SHEET 4 OF 4.

FOR WING DETAILS, SEE SHEET 3 OF 4.

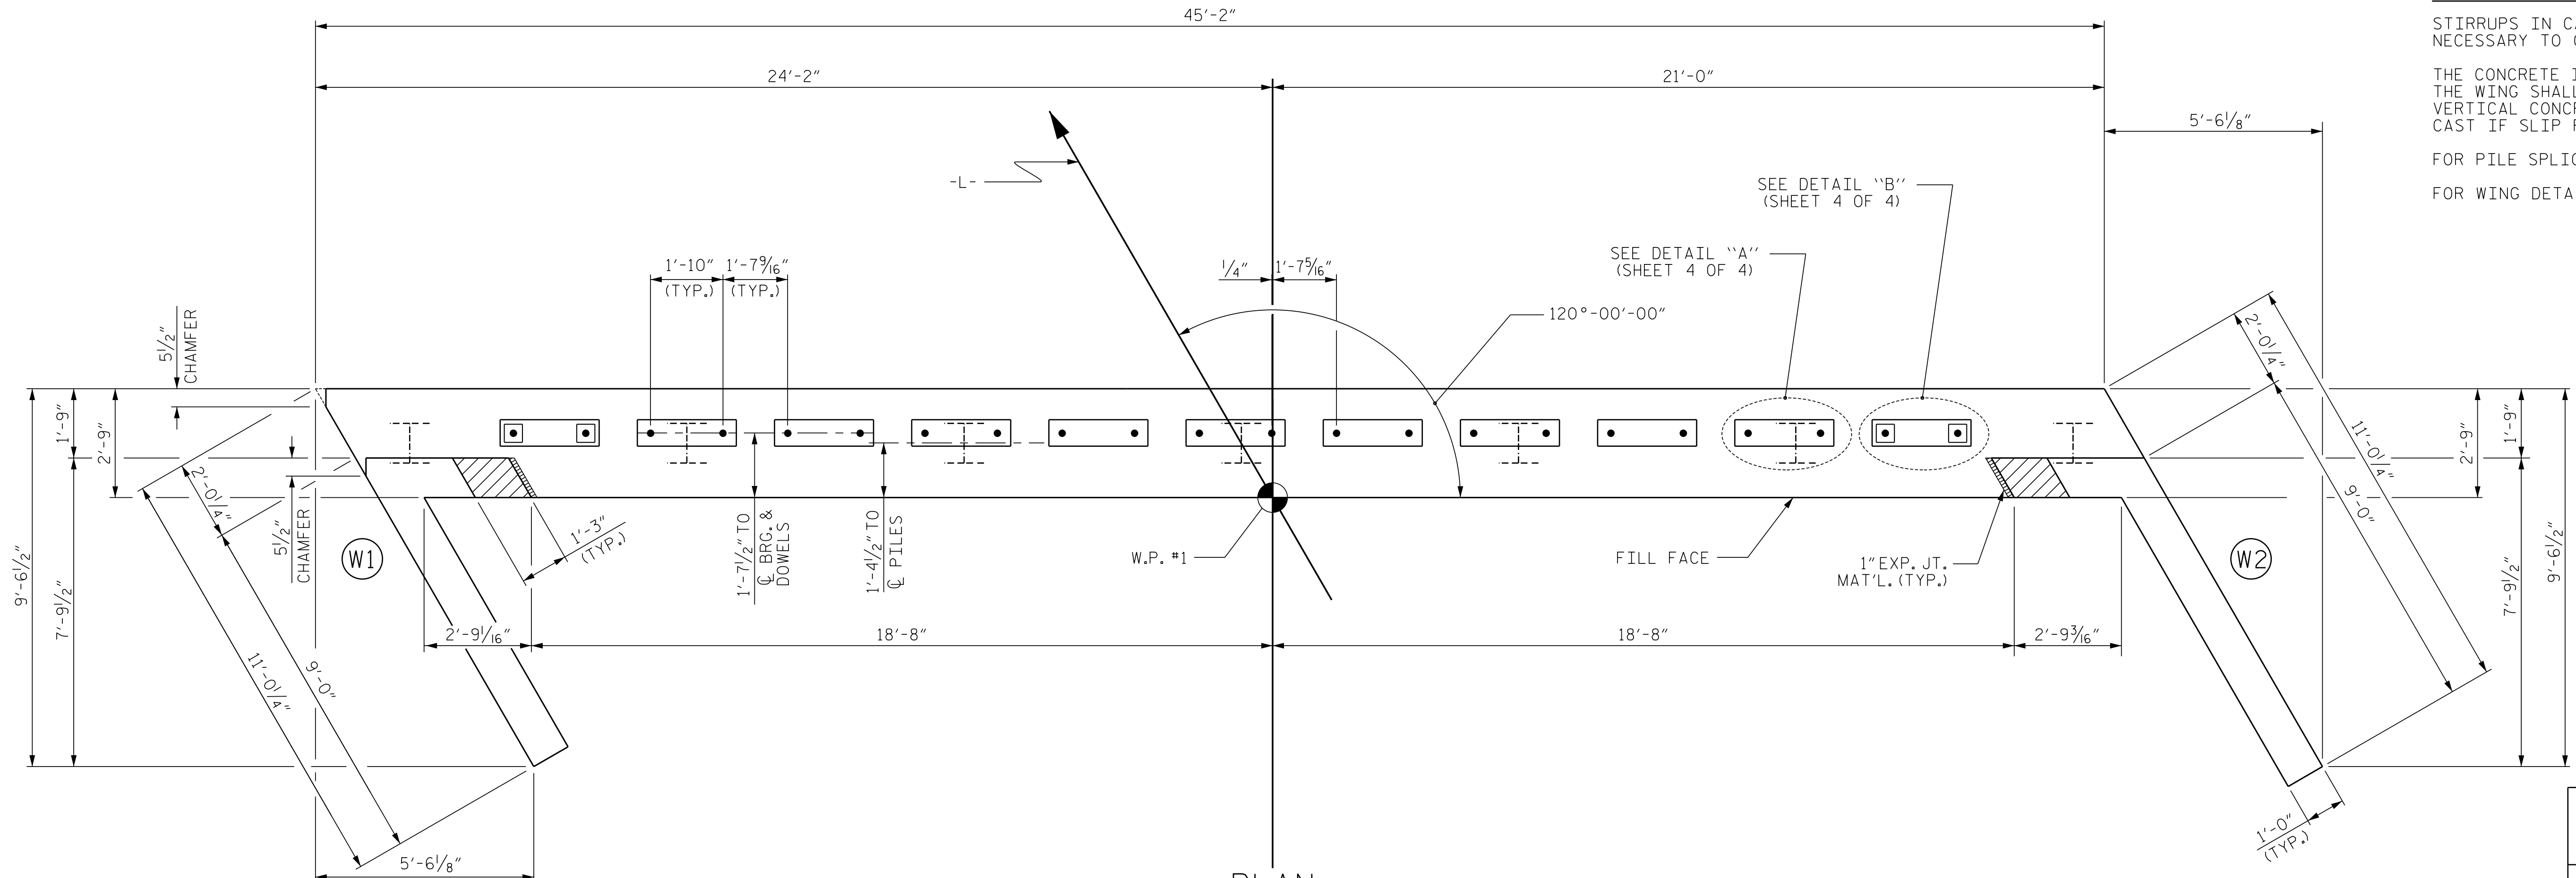

PLAN

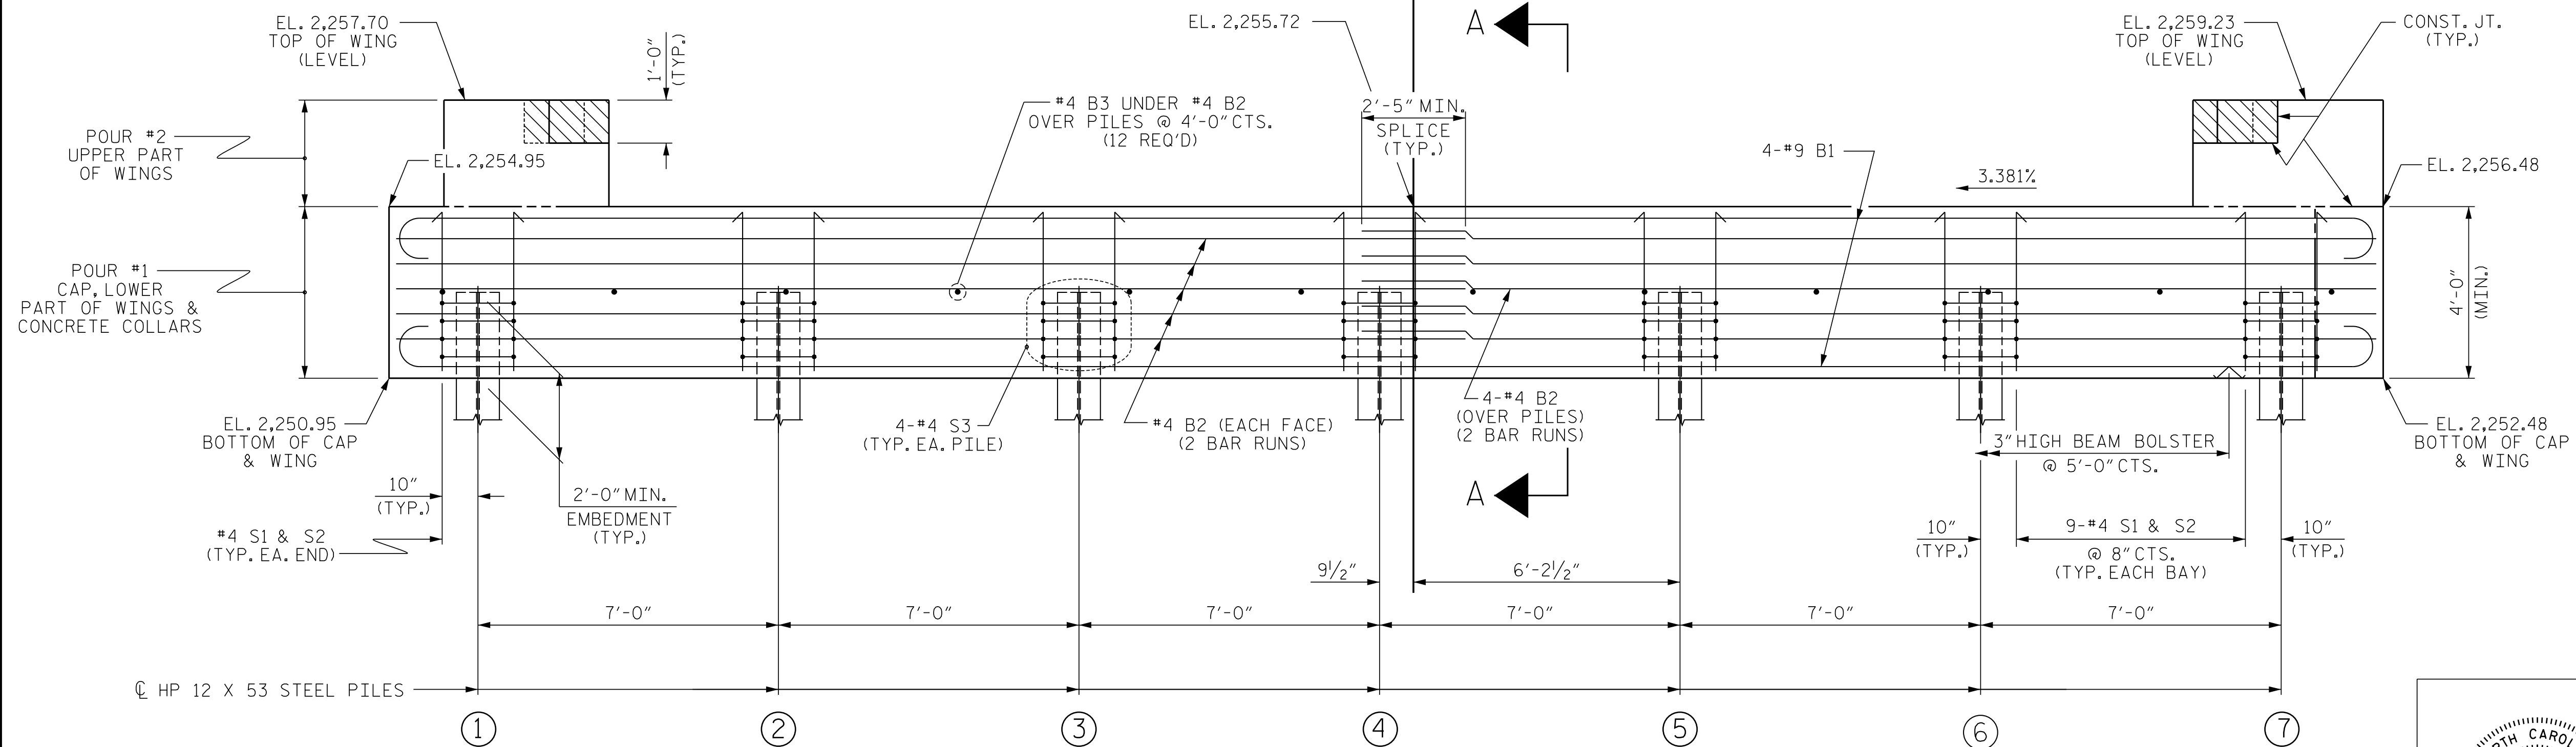

ELEVATION

| TOP OF PILE ELEVATIONS | |
|------------------------|---------|
| ① | 2253.01 |
| ② | 2253.25 |
| ③ | 2253.49 |
| ④ | 2253.73 |
| ⑤ | 2253.97 |
| ⑥ | 2254.21 |
| ⑦ | 2254.45 |

PROJECT NO. 14SP.20561.1
 MACON COUNTY
 STATION: 13+25.02 -L-

SHEET 1 OF 4

STATE OF NORTH CAROLINA
 DEPARTMENT OF TRANSPORTATION
 RALEIGH

SUBSTRUCTURE
 END BENT No. 1


| REVISIONS | | | | | | SHEET NO. |
|-----------|-----|-------|-----|-----|-------|--------------|
| NO. | BY: | DATE: | NO. | BY: | DATE: | S-8 |
| 1 | | | 3 | | | TOTAL SHEETS |
| 2 | | | 4 | | | 13 |

ENGINEER OF RECORD : JEB
 ASSEMBLED BY : MAF DATE : 7/16
 CHECKED BY : HLW DATE : 7/16

DRAWN BY : WJH 12/11 REV. 4/15 MAA/TMG
 CHECKED BY : AAC 12/11

WINGS NOT SHOWN FOR CLARITY.
 FOR SECTION A-A, SEE SHEET 4 OF 4.
 CONCRETE COLLARS FOR STEEL PILES NOT SHOWN IN PLAN AND ELEVATION VIEWS FOR CLARITY.
 SEE "CORROSION PROTECTION FOR STEEL PILES DETAIL", SHEET 4 OF 4.

DOCUMENT NOT CONSIDERED
 FINAL UNLESS ALL
 SIGNATURES COMPLETED

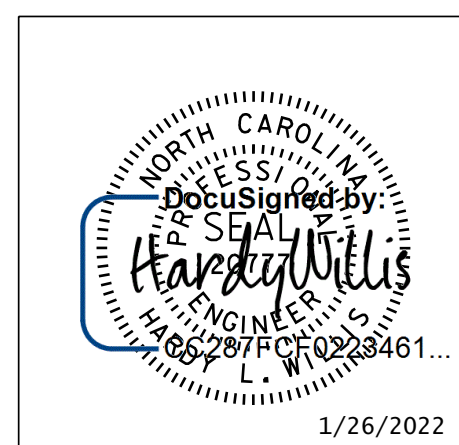


NOTES

STIRRUPS IN CAP MAY BE SHIFTED AS NECESSARY TO CLEAR DOWELS.

THE CONCRETE IN THE SHADED AREA OF THE WING SHALL BE POURED AFTER THE VERTICAL CONCRETE BARRIER RAIL IS CAST IF SLIP FORMING IS USED.


FOR PILE SPLICE DETAILS, SEE SHEET 4 OF 4.

FOR WING DETAILS, SEE SHEET 3 OF 4.

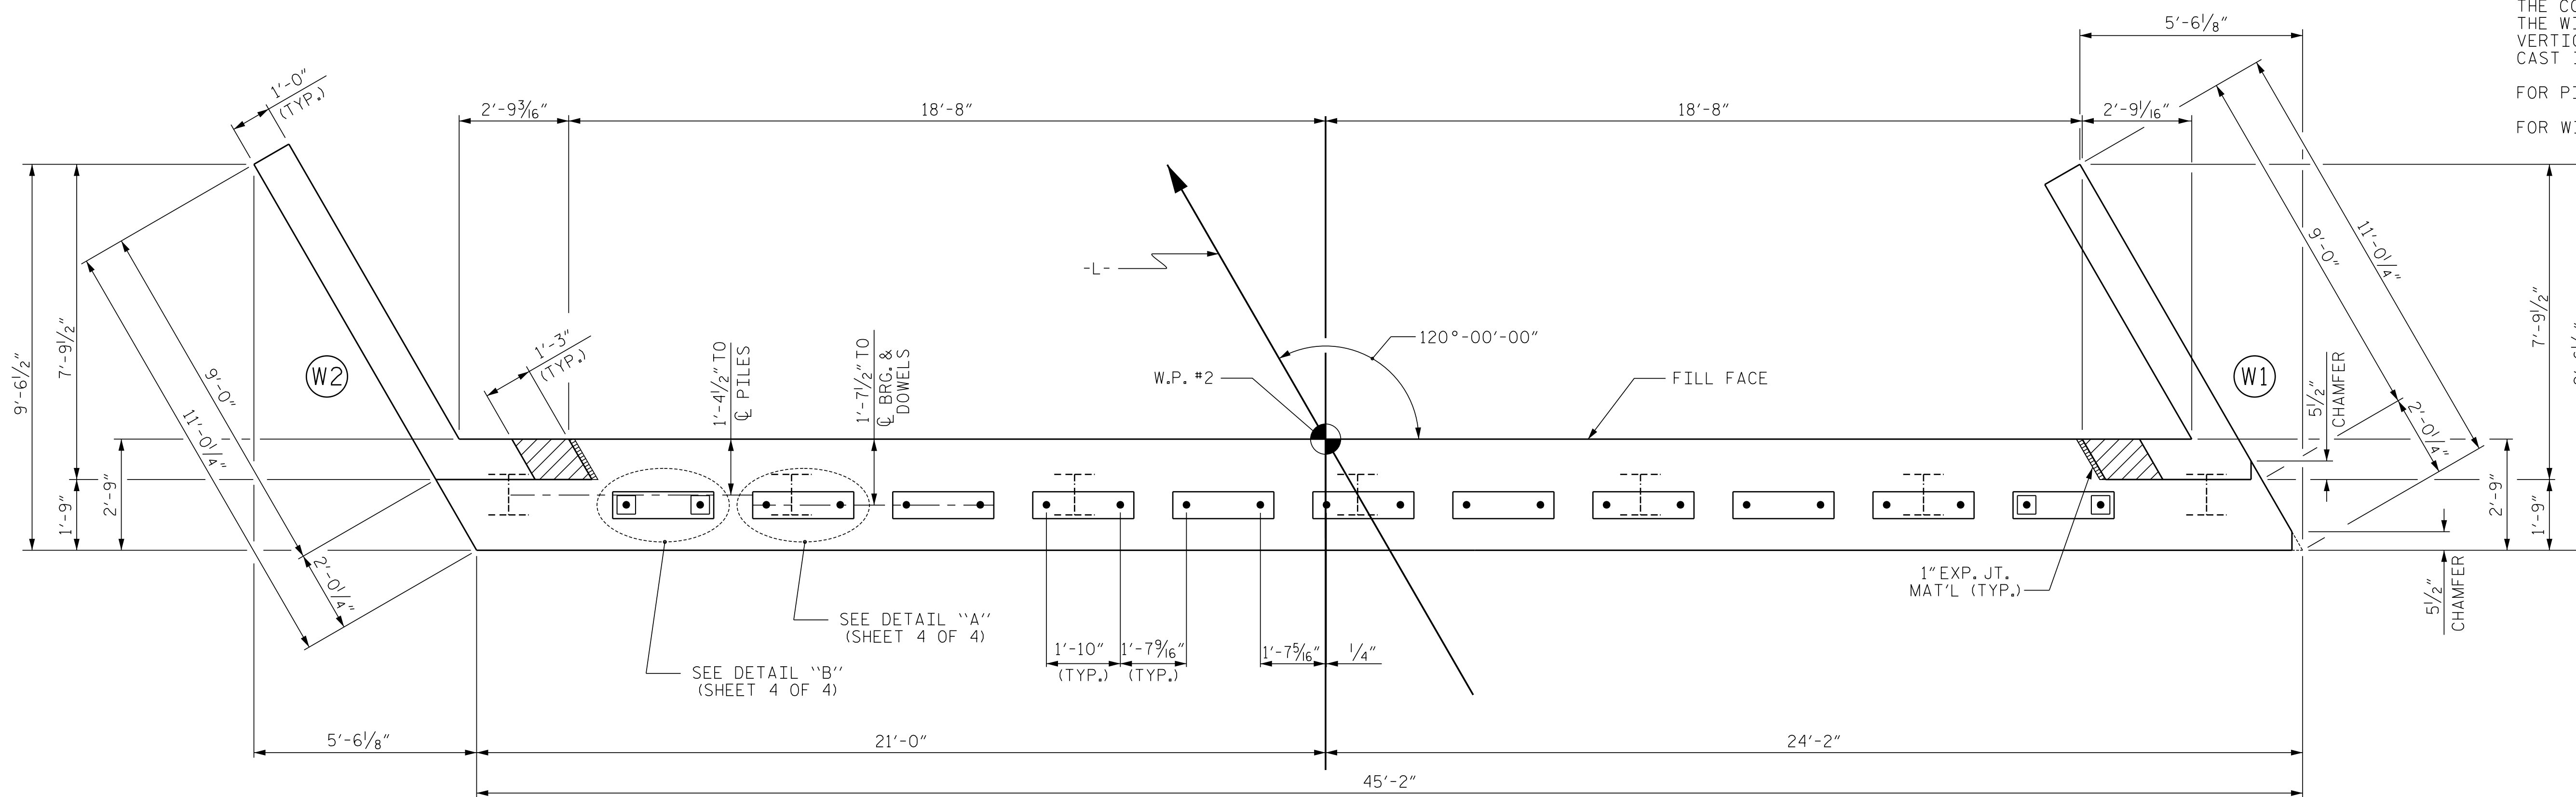

PLAN

| TOP OF PILE ELEVATIONS | |
|------------------------|----------|
| ① | 2,253.15 |
| ② | 2,253.39 |
| ③ | 2,253.63 |
| ④ | 2,253.87 |
| ⑤ | 2,254.11 |
| ⑥ | 2,254.35 |
| ⑦ | 2,254.59 |

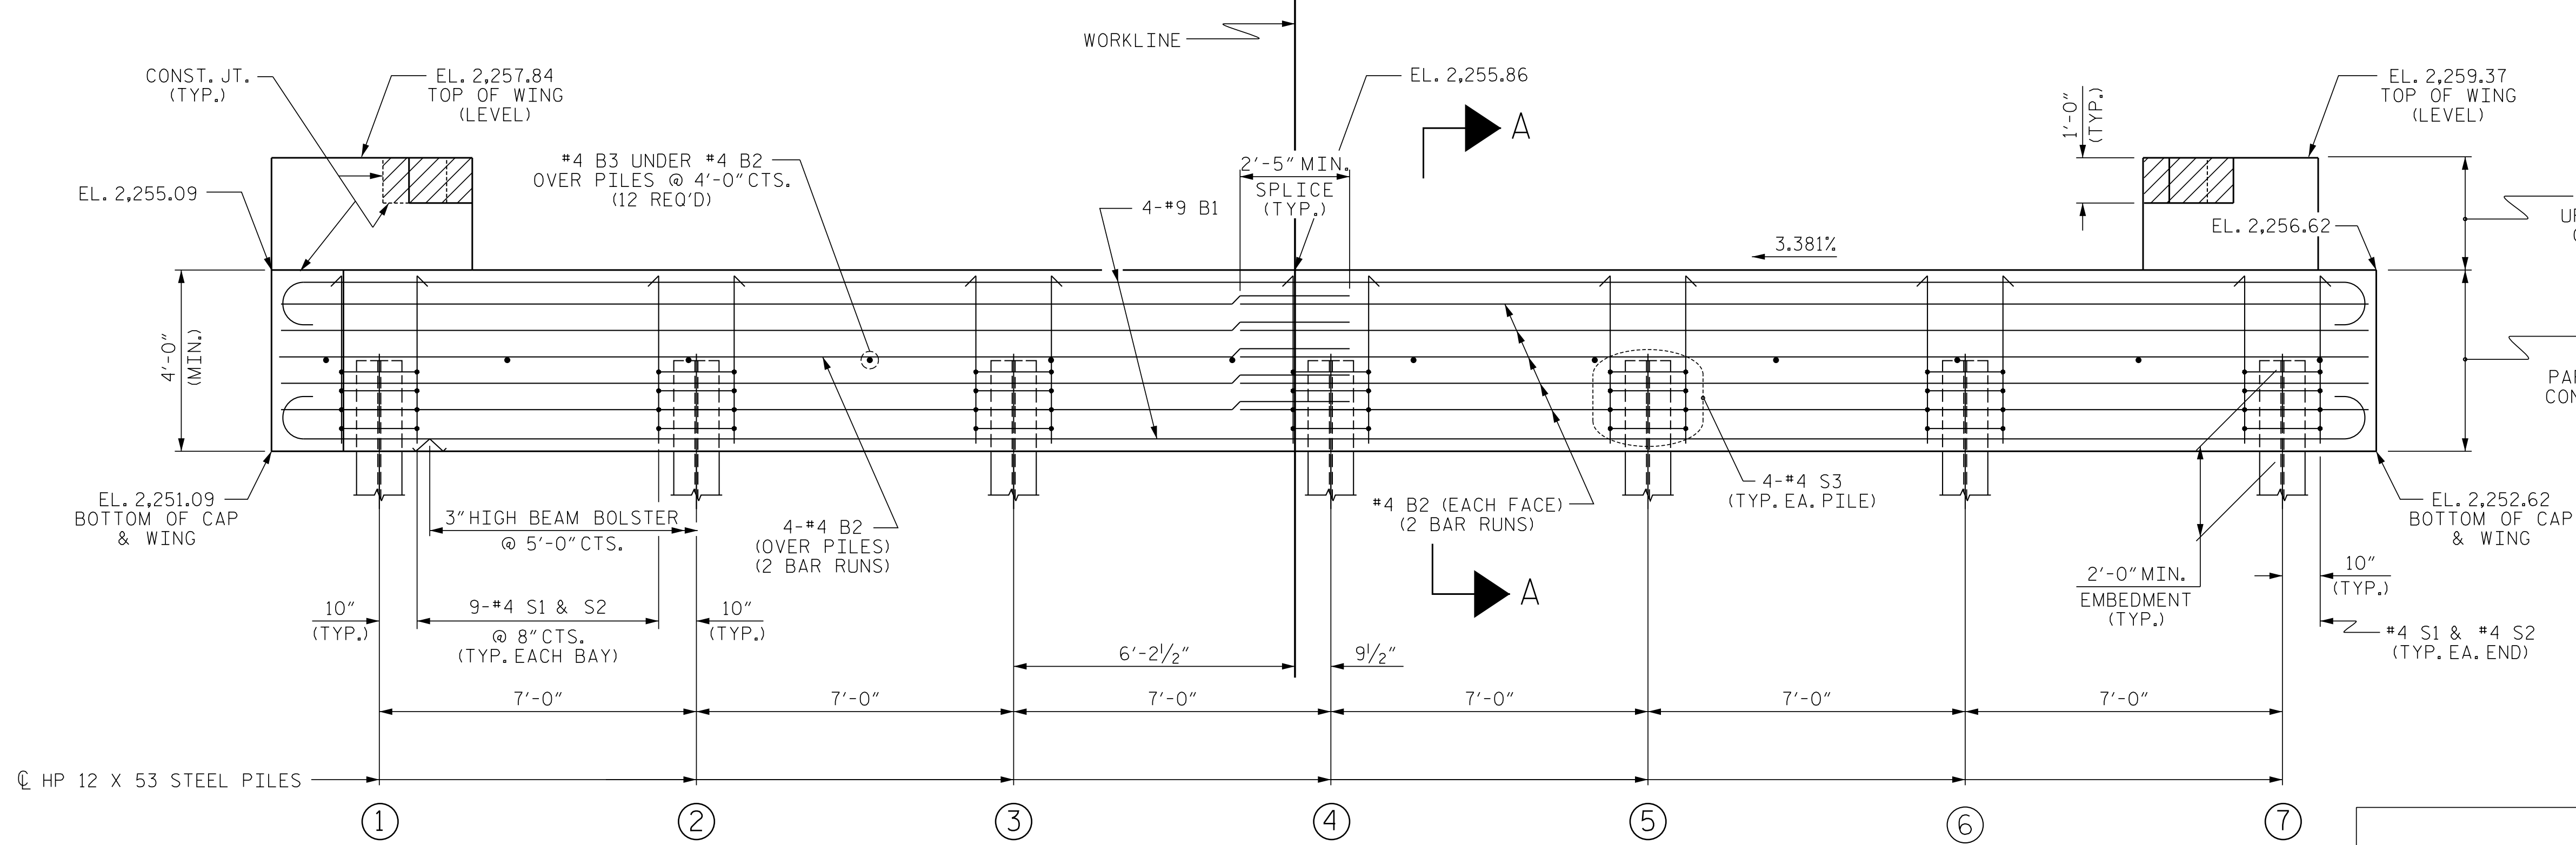

ELEVATION

PROJECT NO. 14SP.20561.1
 MACON COUNTY
 STATION: 13+25.02 -L-

SHEET 2 OF 4


STATE OF NORTH CAROLINA
 DEPARTMENT OF TRANSPORTATION
 RALEIGH

SUBSTRUCTURE
 END BENT No. 2


ENGINEER OF RECORD : JEB
 ASSEMBLED BY : MAF DATE : 7/16
 CHECKED BY : HLW DATE : 7/16
 DRAWN BY : WJH 12/11 REV. 4/15 MAA/TMG
 CHECKED BY : AAC 12/11

WINGS NOT SHOWN FOR CLARITY.
 FOR SECTION A-A, SEE SHEET 4 OF 4.
 CONCRETE COLLARS FOR STEEL PILES NOT SHOWN IN PLAN AND ELEVATION VIEWS FOR CLARITY.
 SEE "CORROSION PROTECTION FOR STEEL PILES DETAIL", SHEET 4 OF 4.

DOCUMENT NOT CONSIDERED
 FINAL UNLESS ALL
 SIGNATURES COMPLETED

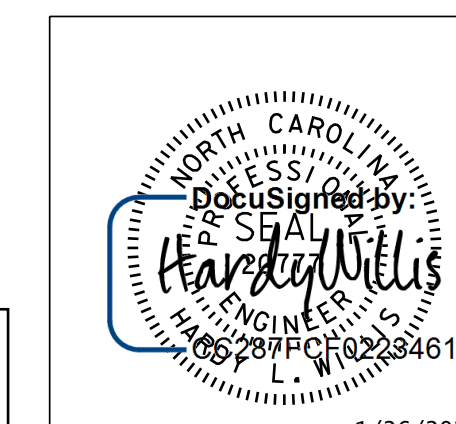

| REVISIONS | | | | | | SHEET NO. |
|-----------|-----|-------|-----|-----|-------|--------------|
| NO. | BY: | DATE: | NO. | BY: | DATE: | S-9 |
| 1 | | | 3 | | | TOTAL SHEETS |
| 2 | | | 4 | | | 13 |

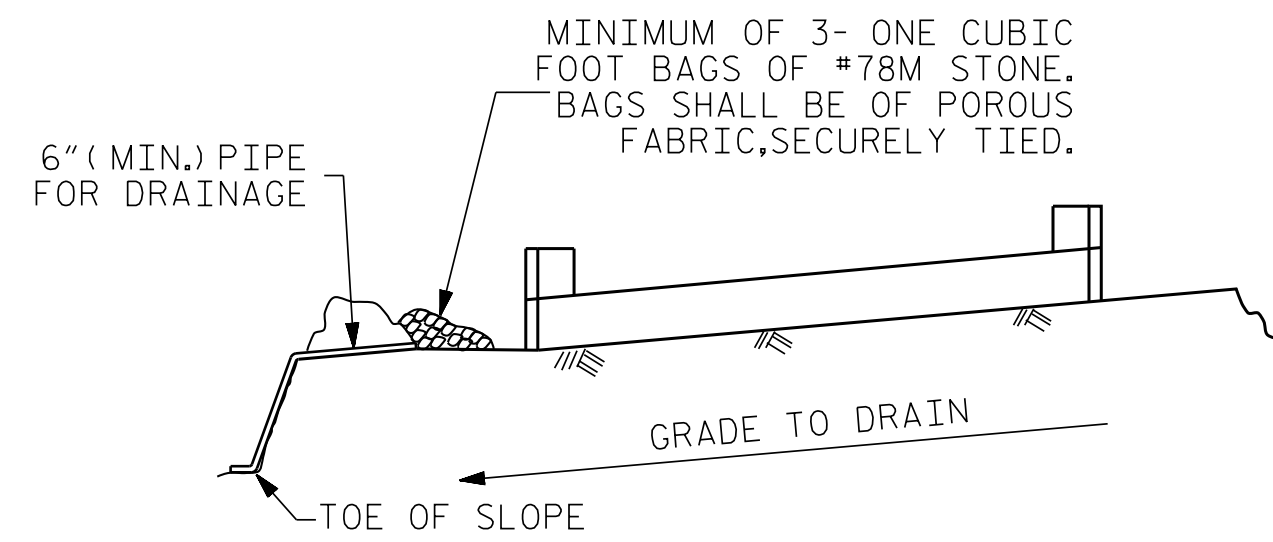


BAGGED STONE AND PIPE SHALL BE PLACED IMMEDIATELY AFTER COMPLETION OF END BENT EXCAVATION. PIPE MAY BE EITHER CONCRETE, CORRUGATED STEEL, CORRUGATED ALUMINUM ALLOY, OR CORRUGATED PLASTIC. PERFORATED PIPE WILL NOT BE ALLOWED.

BAGGED STONE SHALL REMAIN IN PLACE UNTIL THE ENGINEER DIRECTS THAT IT BE REMOVED. THE CONTRACTOR SHALL REMOVE AND DISPOSE OF SILT ACCUMULATIONS AT BAGGED STONE WHEN SO DIRECTED BY THE ENGINEER. BAGS SHALL BE REMOVED AND REPLACED WHENEVER THE ENGINEER DETERMINES THAT THEY HAVE DETEIORATED AND LOST THEIR EFFECTIVENESS.


NO SEPARATE PAYMENT WILL BE MADE FOR THIS WORK AND THE ENTIRE COST OF THIS WORK SHALL BE INCLUDED IN THE UNIT CONTRACT PRICE BID FOR THE SEVERAL PAY ITEMS.

TEMPORARY DRAINAGE AT END BENT

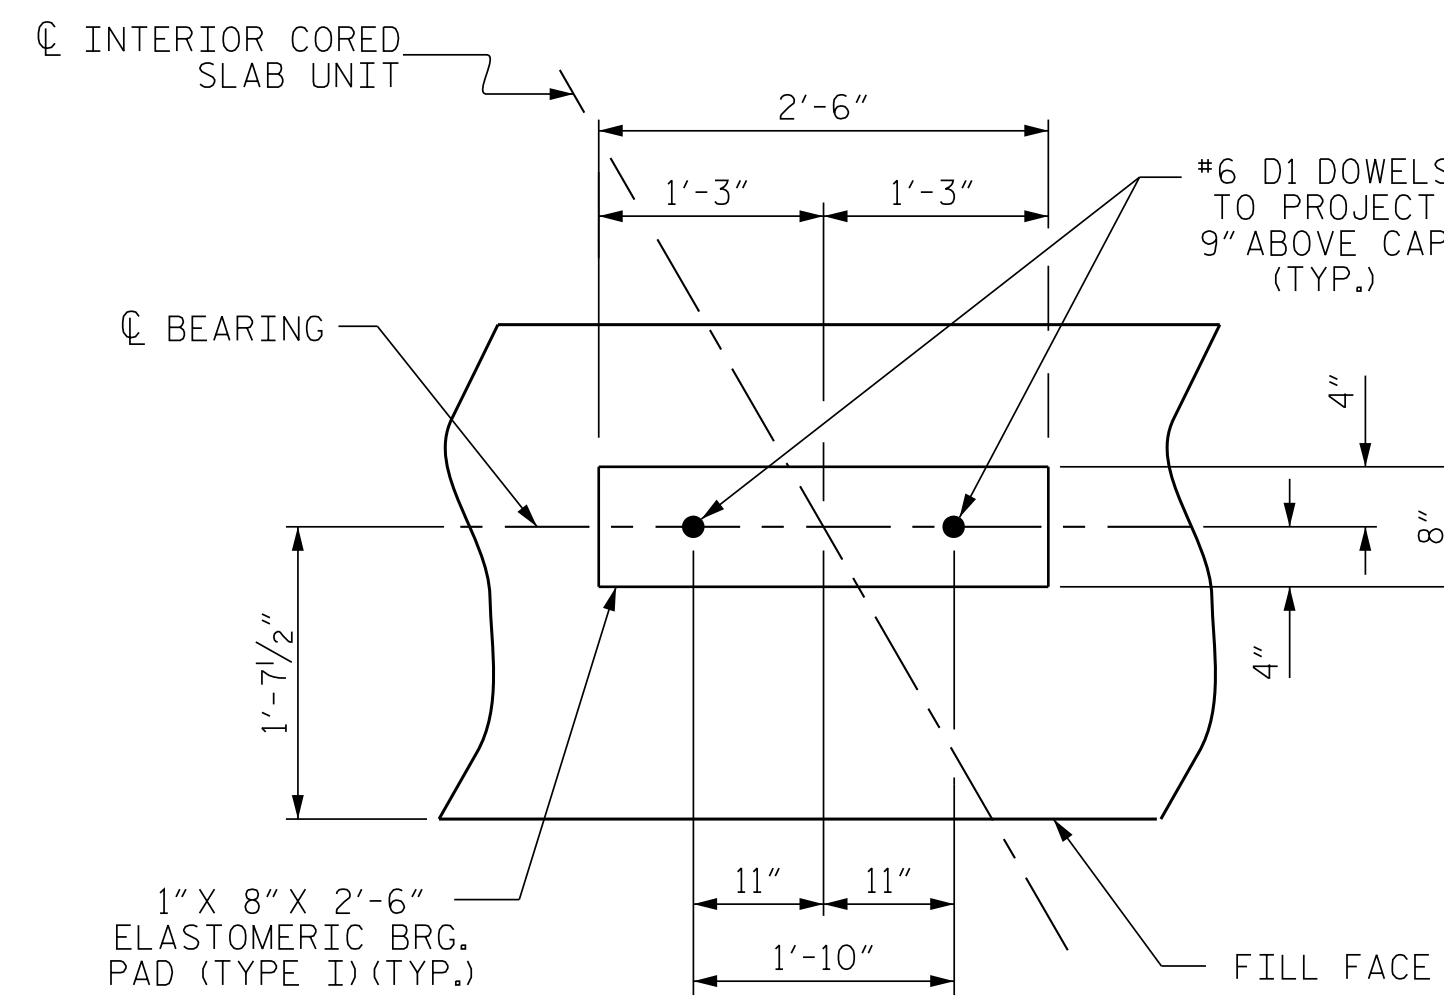


DETAIL "A"

(END BENT No. 1 SHOWN, END BENT No. 2 SIMILAR BY ROTATION)

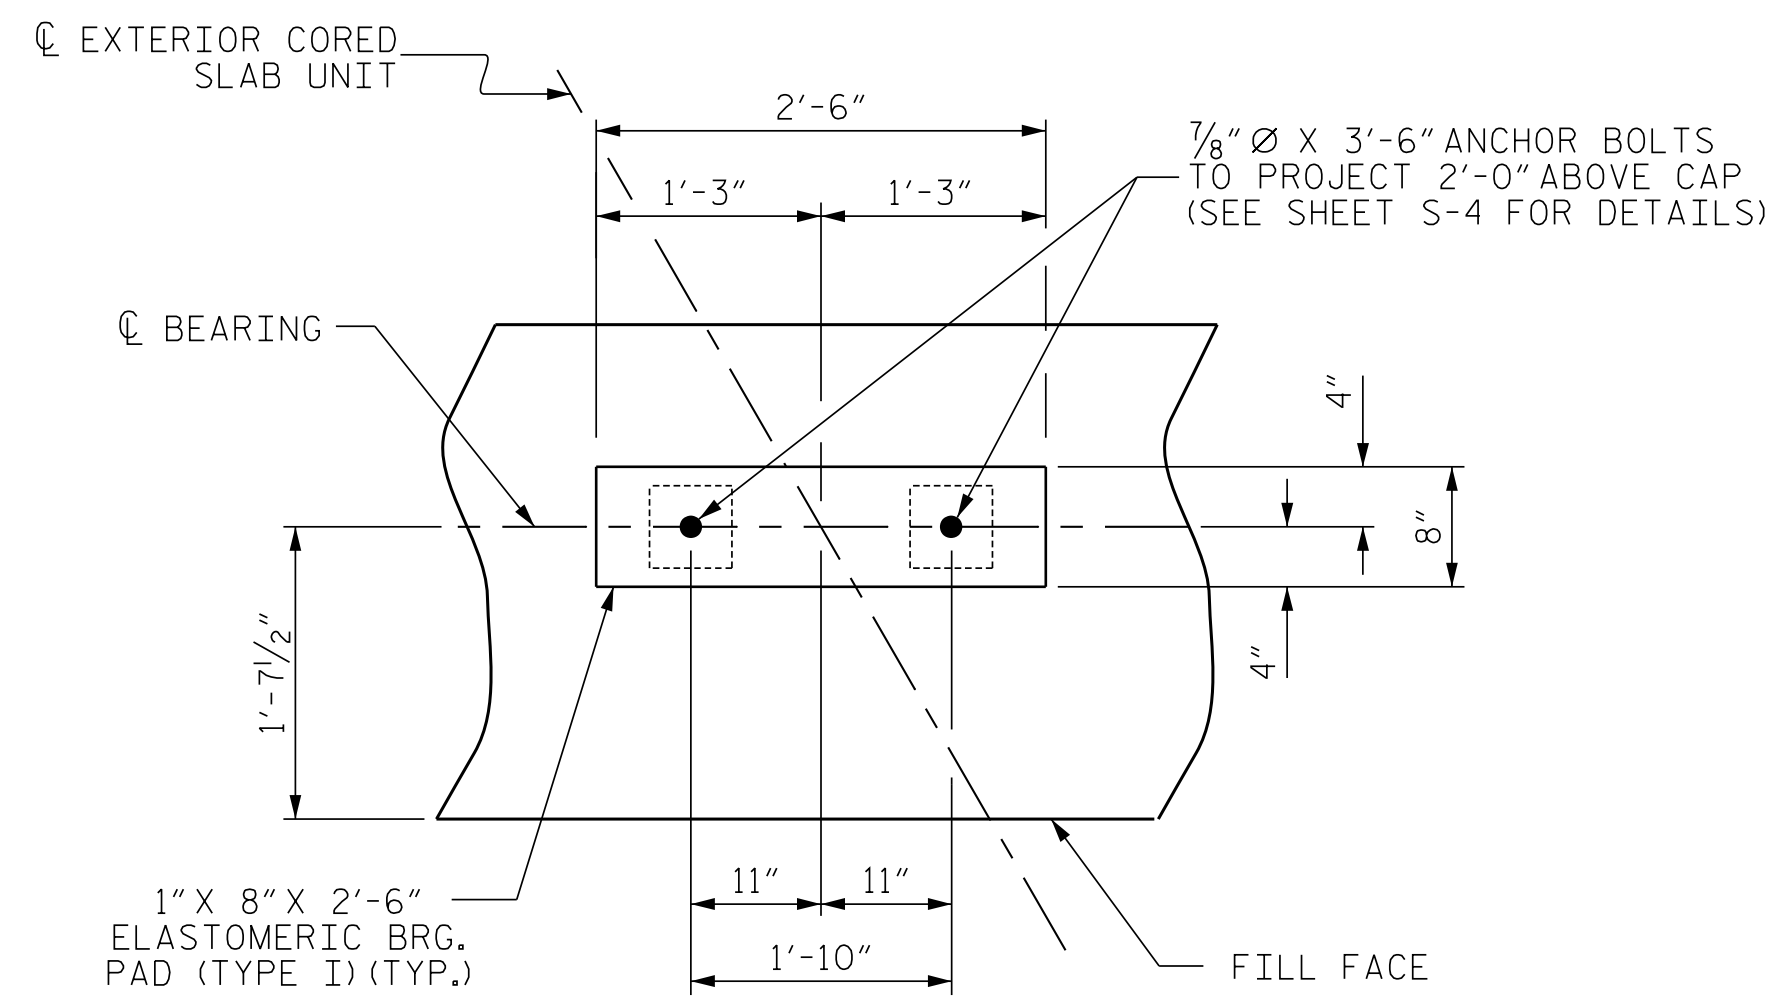



DETAIL "B"

(END BENT No. 1 SHOWN, END BENT No. 2 SIMILAR BY ROTATION)

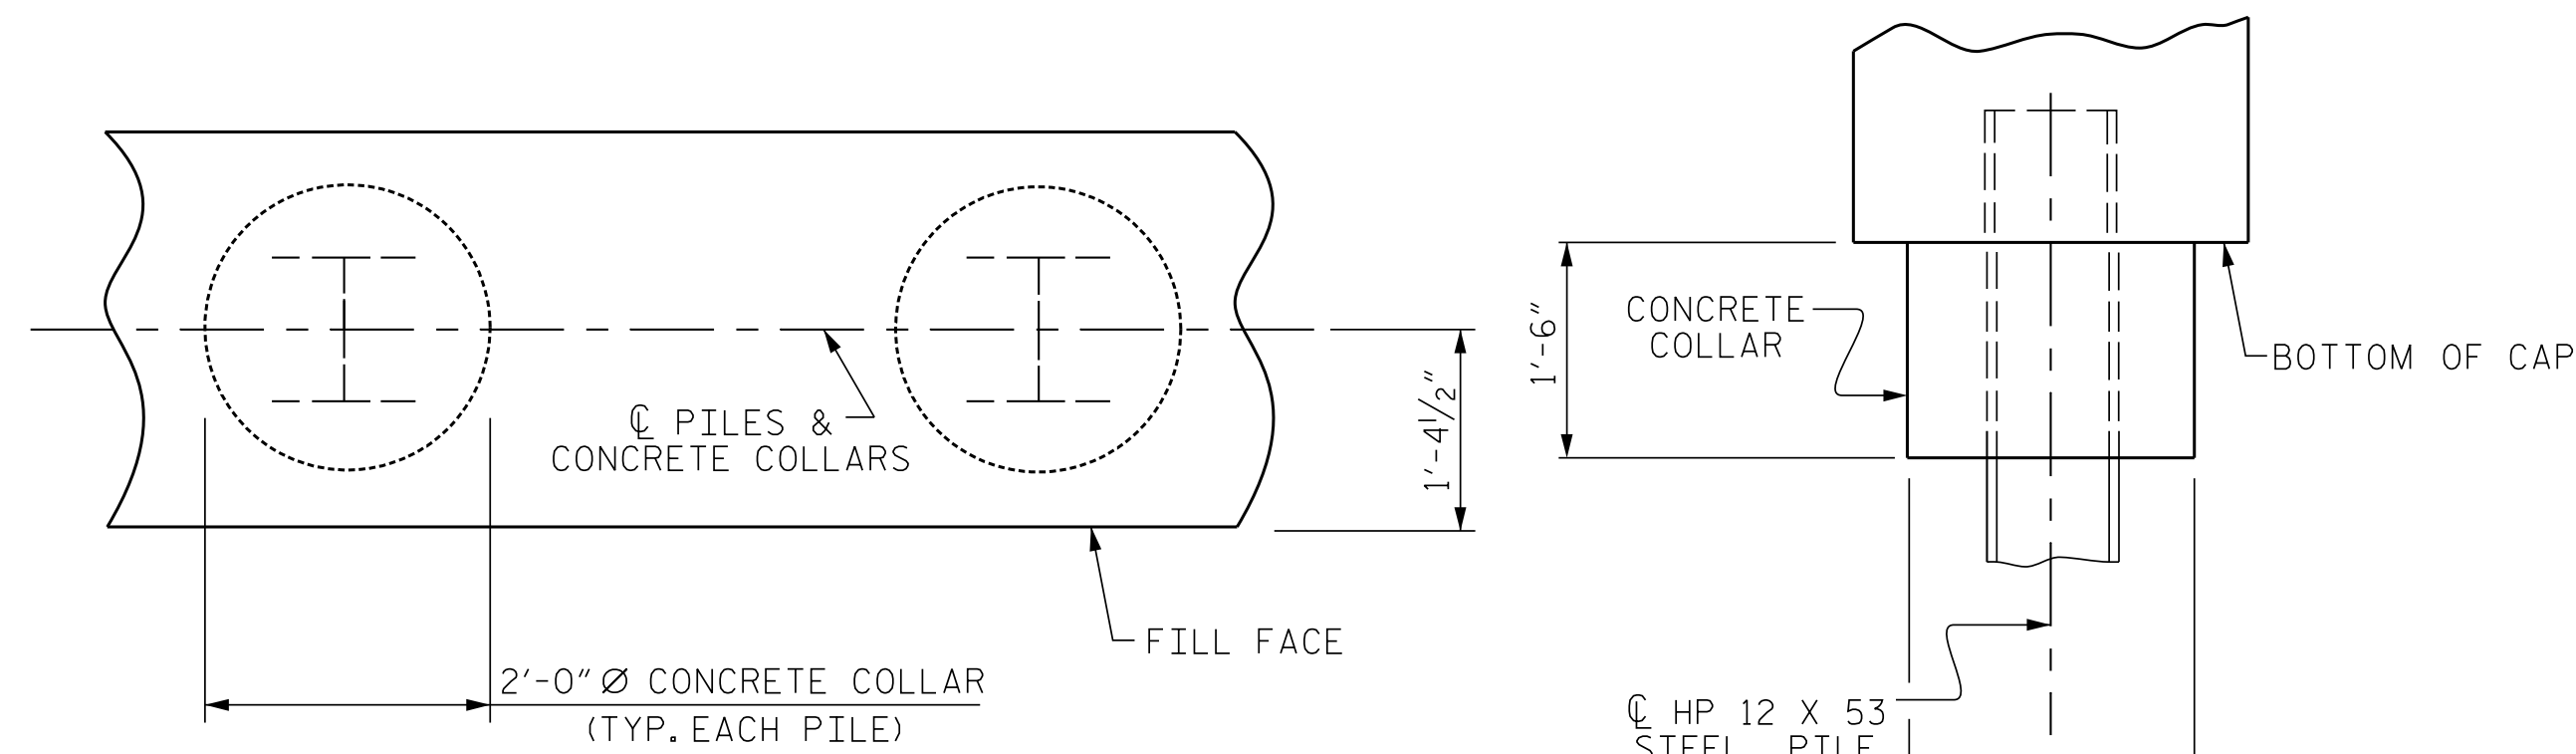


CORROSION PROTECTION FOR STEEL PILES DETAIL

(END BENT No. 1 SHOWN, END BENT No. 2 SIMILAR BY ROTATION)

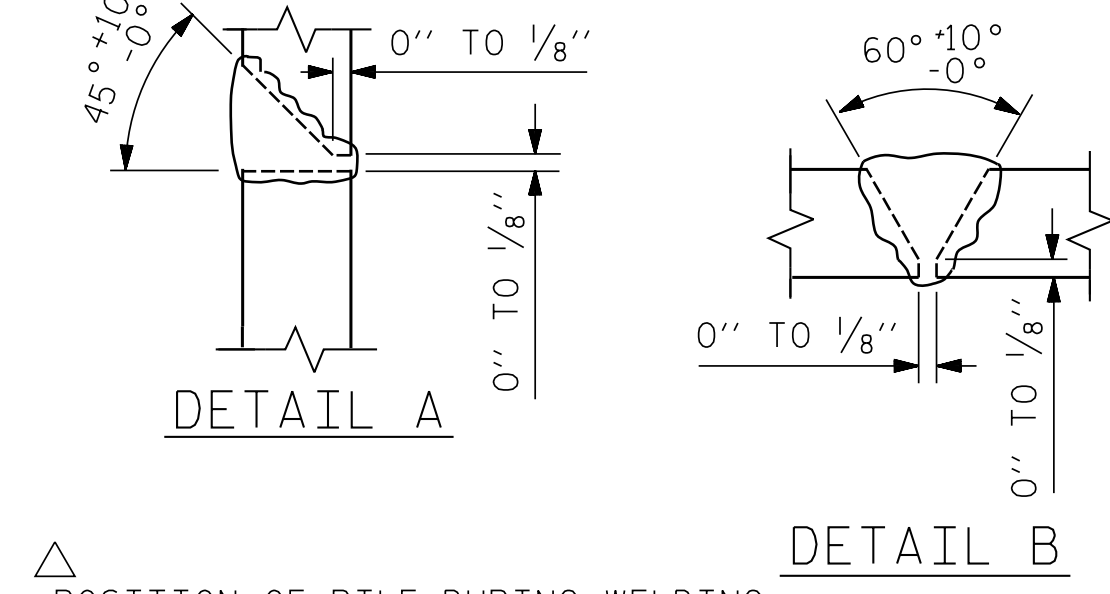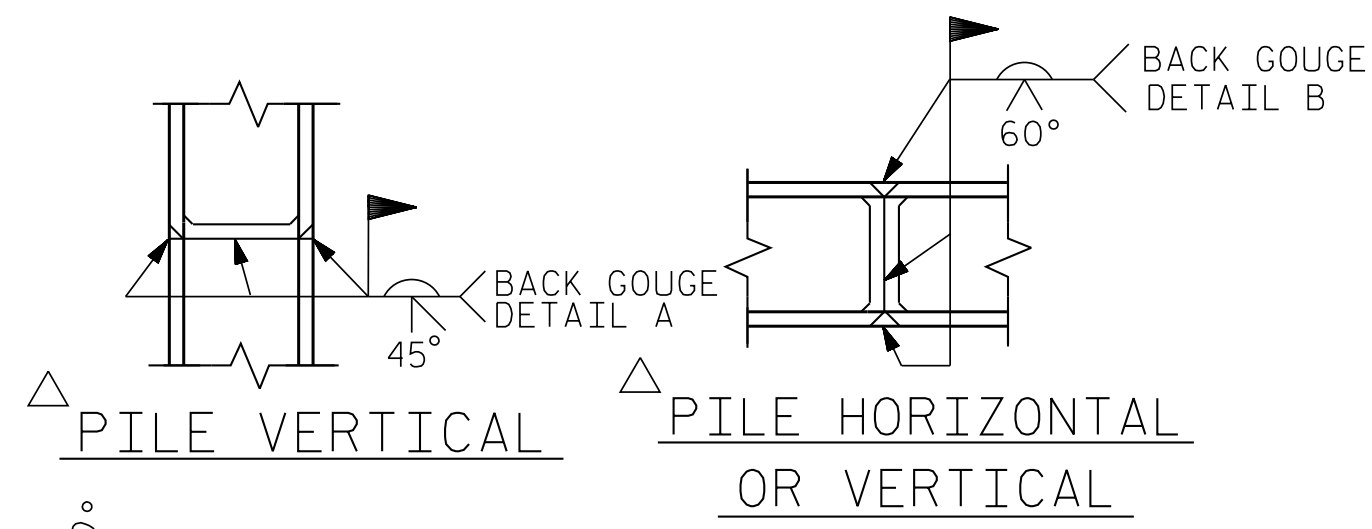

PILE SPLICE DETAILS


| BILL OF MATERIAL FOR ONE END BENT | | | | | |
|---|-----|------|---|-----------|-----------|
| BAR | NO. | SIZE | TYPE | LENGTH | WEIGHT |
| B1 | 8 | #9 | | 47'-2" | 1283 |
| B2 | 28 | #4 | STR | 23'-8" | 443 |
| B3 | 12 | #4 | STR | 2'-5" | 19 |
| D1 | 18 | #6 | STR | 1'-6" | 41 |
| H1 | 10 | #4 | | 9'-9" | 65 |
| H2 | 10 | #4 | | 9'-4" | 62 |
| H3 | 20 | #4 | | 8'-10" | 118 |
| K1 | 16 | #4 | STR | 3'-3" | 35 |
| S1 | 56 | #4 | | 10'-5" | 390 |
| S2 | 56 | #4 | | 3'-2" | 118 |
| S3 | 28 | #4 | | 6'-6" | 122 |
| V1 | 53 | #4 | STR | 6'-2" | 218 |
| REINFORCING STEEL (FOR ONE END BENT) | | | | | 2914 LBS. |
| CLASS A CONCRETE BREAKDOWN (FOR ONE END BENT) | | | | | |
| POUR #1 CAP, LOWER PART OF WINGS & COLLARS | | | | 21.9 C.Y. | |
| POUR #2 UPPER PART OF WINGS | | | | 2.4 C.Y. | |
| TOTAL CLASS A CONCRETE | | | | 24.3 C.Y. | |
| ALL BAR DIMENSIONS ARE OUT TO OUT. | | | | | |
| END BENT No. 1 | | | END BENT No. 2 | | |
| PILE DRIVING EQUIPMENT SETUP FOR HP 12 X 53 STEEL PILES | | | PILE DRIVING EQUIPMENT SETUP FOR HP 12 X 53 STEEL PILES | | |
| NO: 7 | | | NO: 7 | | |
| HP 12 X 53 STEEL PILES | | | HP 12 X 53 STEEL PILES | | |
| NO: 7 LIN. FT. = 154 | | | NO: 7 LIN. FT. = 154 | | |
| STEEL PILE POINTS | | | STEEL PILE POINTS | | |
| NO: 7 | | | NO: 7 | | |
| PILE EXCAVATION IN SOIL | | | PILE EXCAVATION IN SOIL | | |
| 35 LIN. FT. | | | 45 LIN. FT. | | |
| NOT IN SOIL | | | NOT IN SOIL | | |
| 45 LIN. FT. | | | 45 LIN. FT. | | |

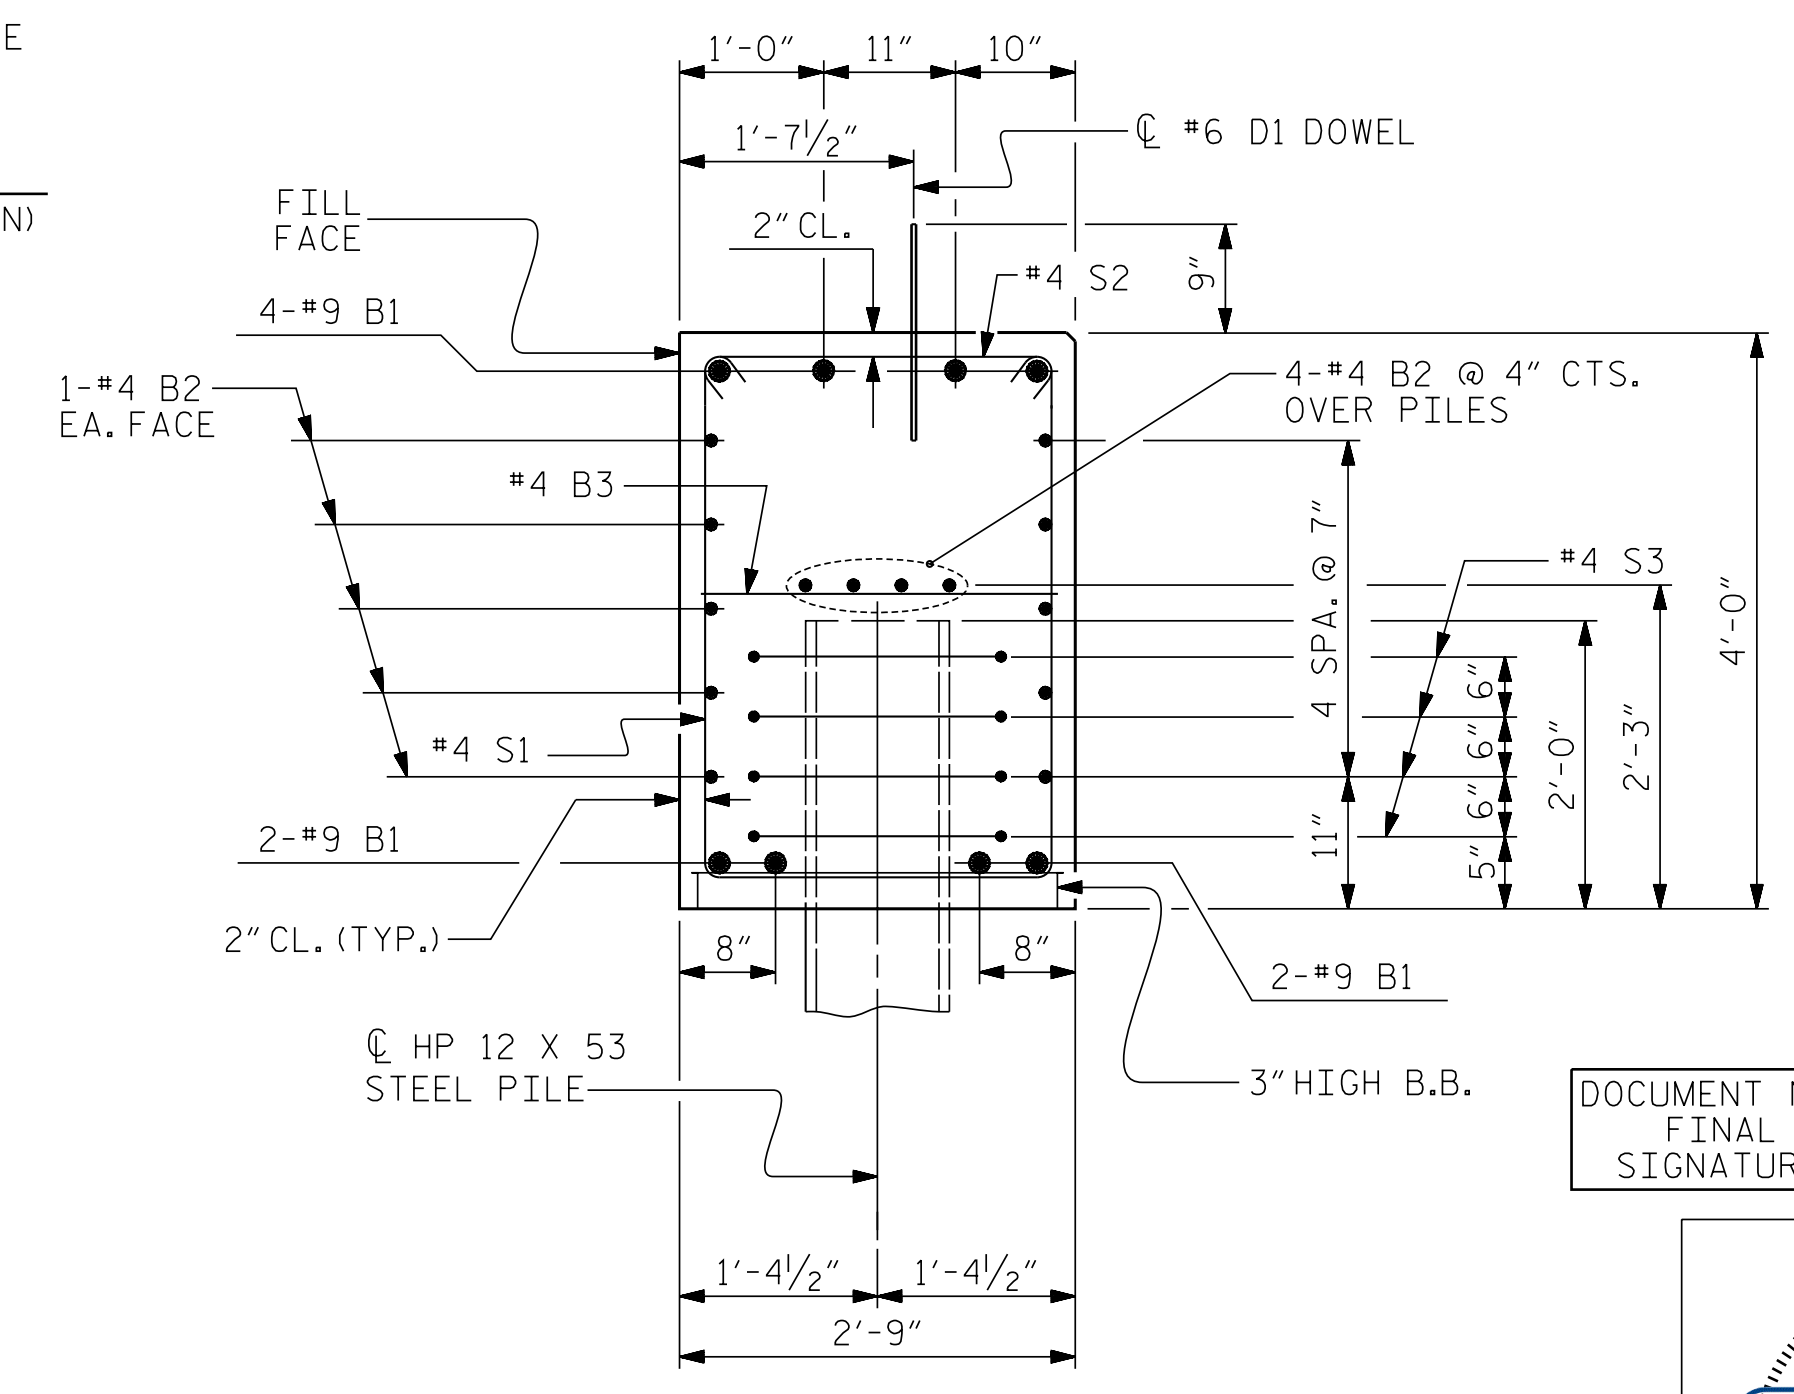

SECTION A-A

(CONCRETE COLLAR NOT SHOWN FOR CLARITY. SEE "CORROSION PROTECTION FOR STEEL PILES DETAIL.")

DOCUMENT NOT CONSIDERED FINAL UNLESS ALL SIGNATURES COMPLETED

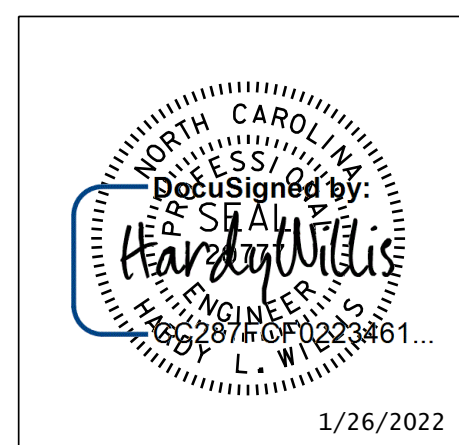

PROJECT NO. 14SP.20561.1
 MACON COUNTY
 STATION: 13+25.02 -L-

SHEET 4 OF 4


STATE OF NORTH CAROLINA
 DEPARTMENT OF TRANSPORTATION
 RALEIGH

SUBSTRUCTURE
 END BENT No. 1 & 2
 DETAILS

| REVISIONS | | | | | | SHEET NO. | |
|-----------|-----|-------|-----|-----|-------|-----------------|--|
| NO. | BY: | DATE: | NO. | BY: | DATE: | S-11 | |
| 1 | | | 3 | | | TOTAL SHEETS 13 | |
| 2 | | | 4 | | | | |

| | | | |
|----------------------|-----------|-----------|---------|
| ENGINEER OF RECORD : | JEB | DATE : | 7/16 |
| ASSEMBLED BY : | MAF | DATE : | 7/16 |
| CHECKED BY : | HLW | | |
| DRAWN BY : | WJH 12/11 | REV. 4/17 | MAA/THC |
| CHECKED BY : | AAC 12/11 | | |

NOTES :
FOR BERM WIDTH DIMENSIONS, SEE GENERAL DRAWING.

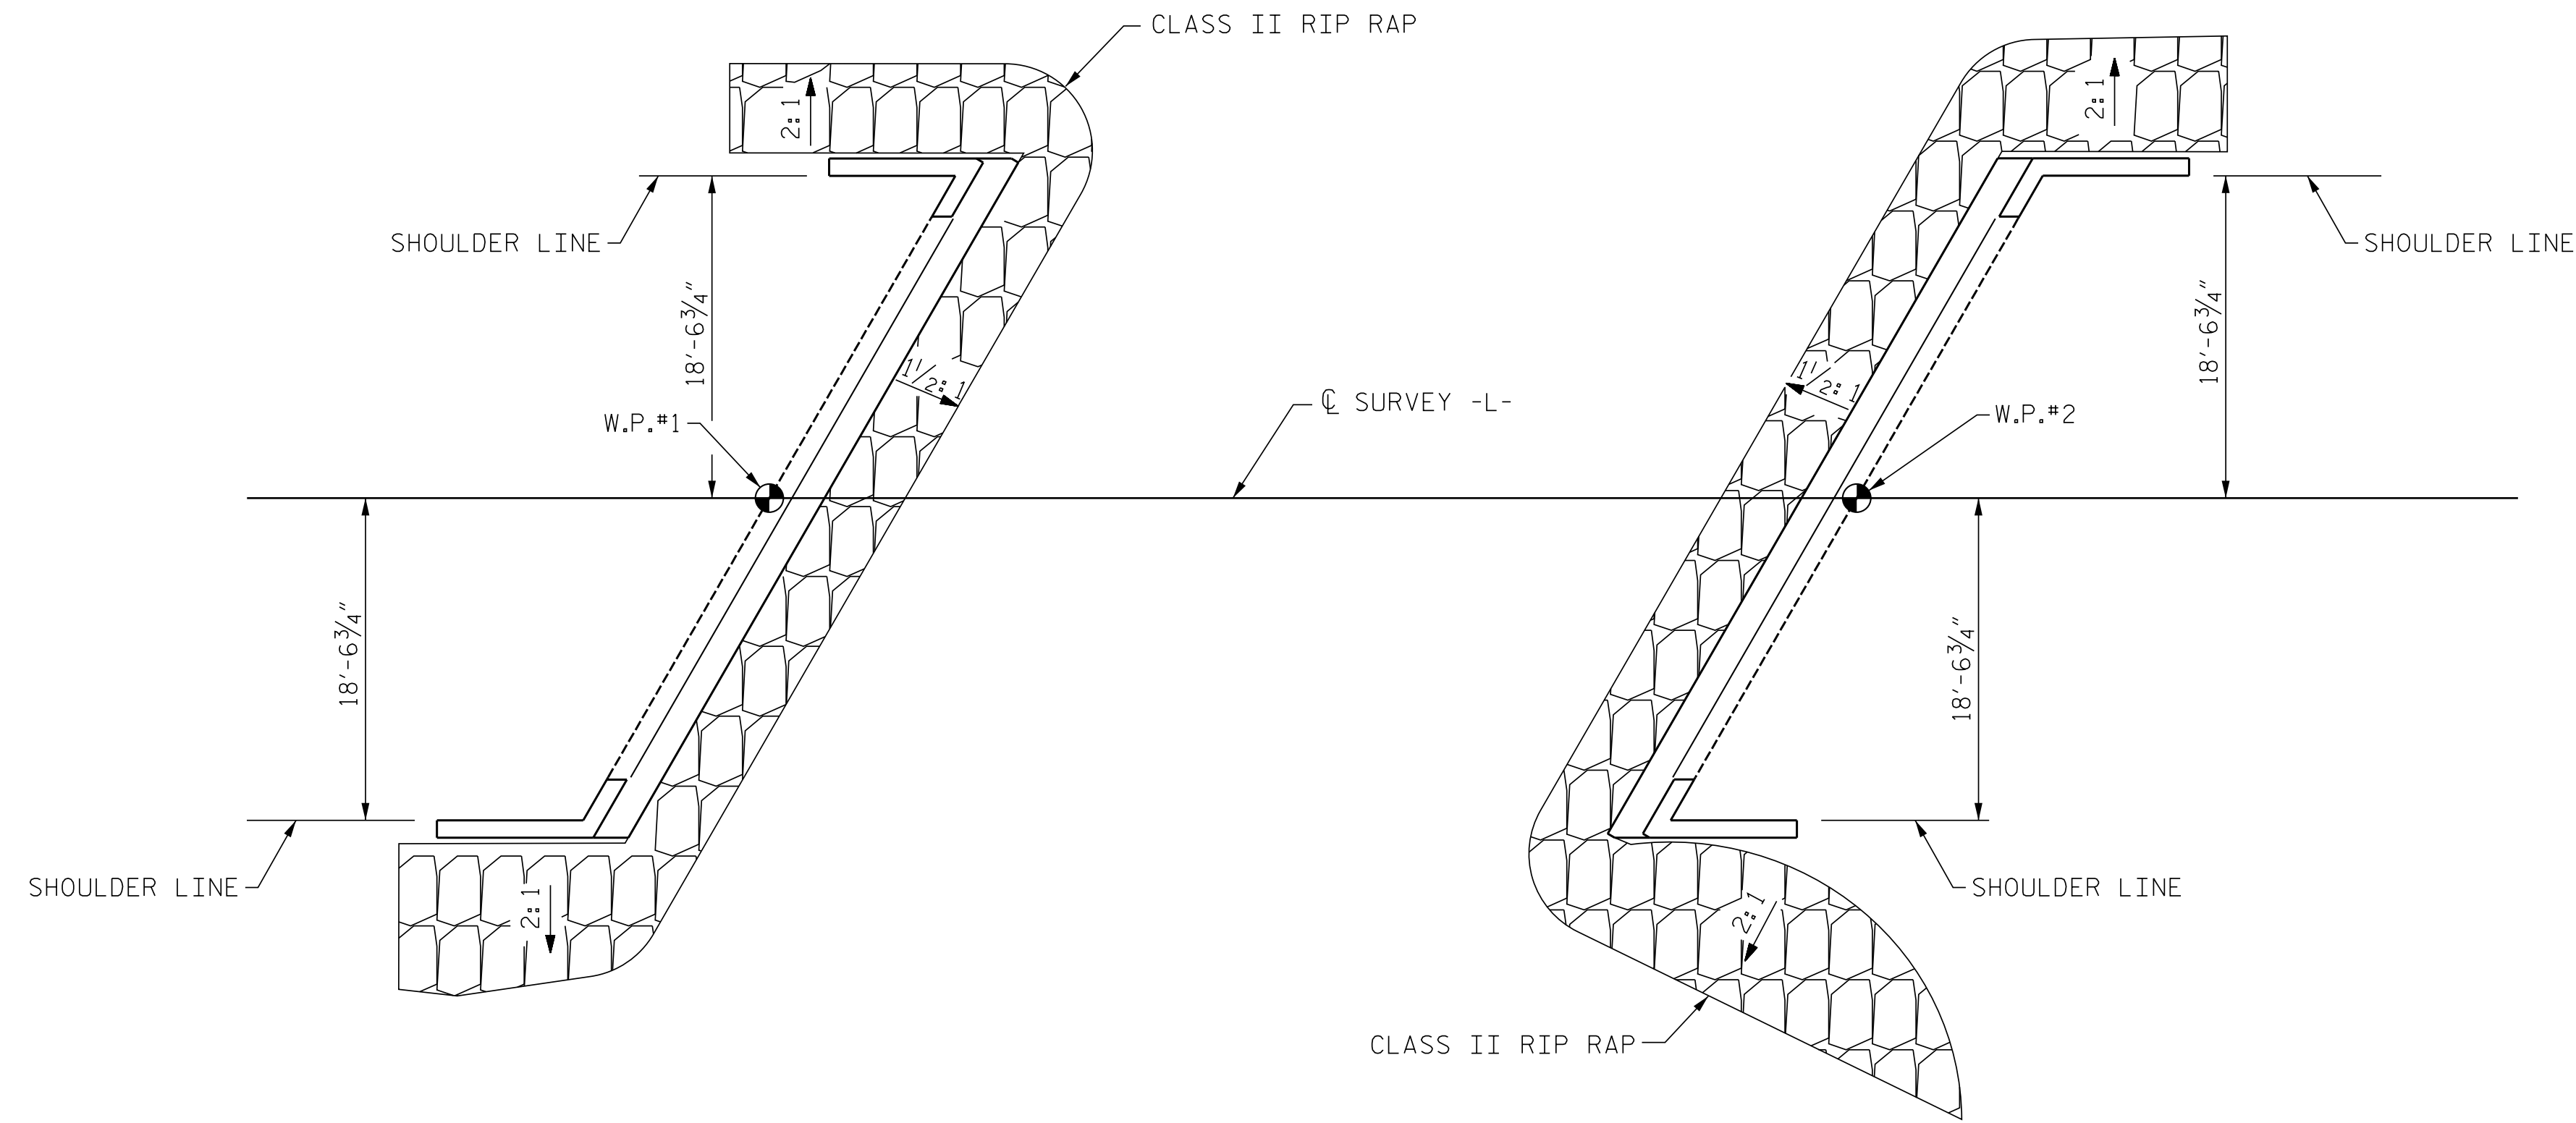


END BENT #1


END BENT #2

PLAN

| ESTIMATED QUANTITIES | | |
|-------------------------------|--------------------------------------|----------------------------|
| BRIDGE @ STA. 13+25.02 -L- | RIP RAP CLASS II (2'-0" THICK) | GEOTEXTILE FOR DRAINAGE |
| | TONS | SQUARE YARDS |
| END BENT 1 | 61 | 46 |
| END BENT 2 | 65 | 53 |

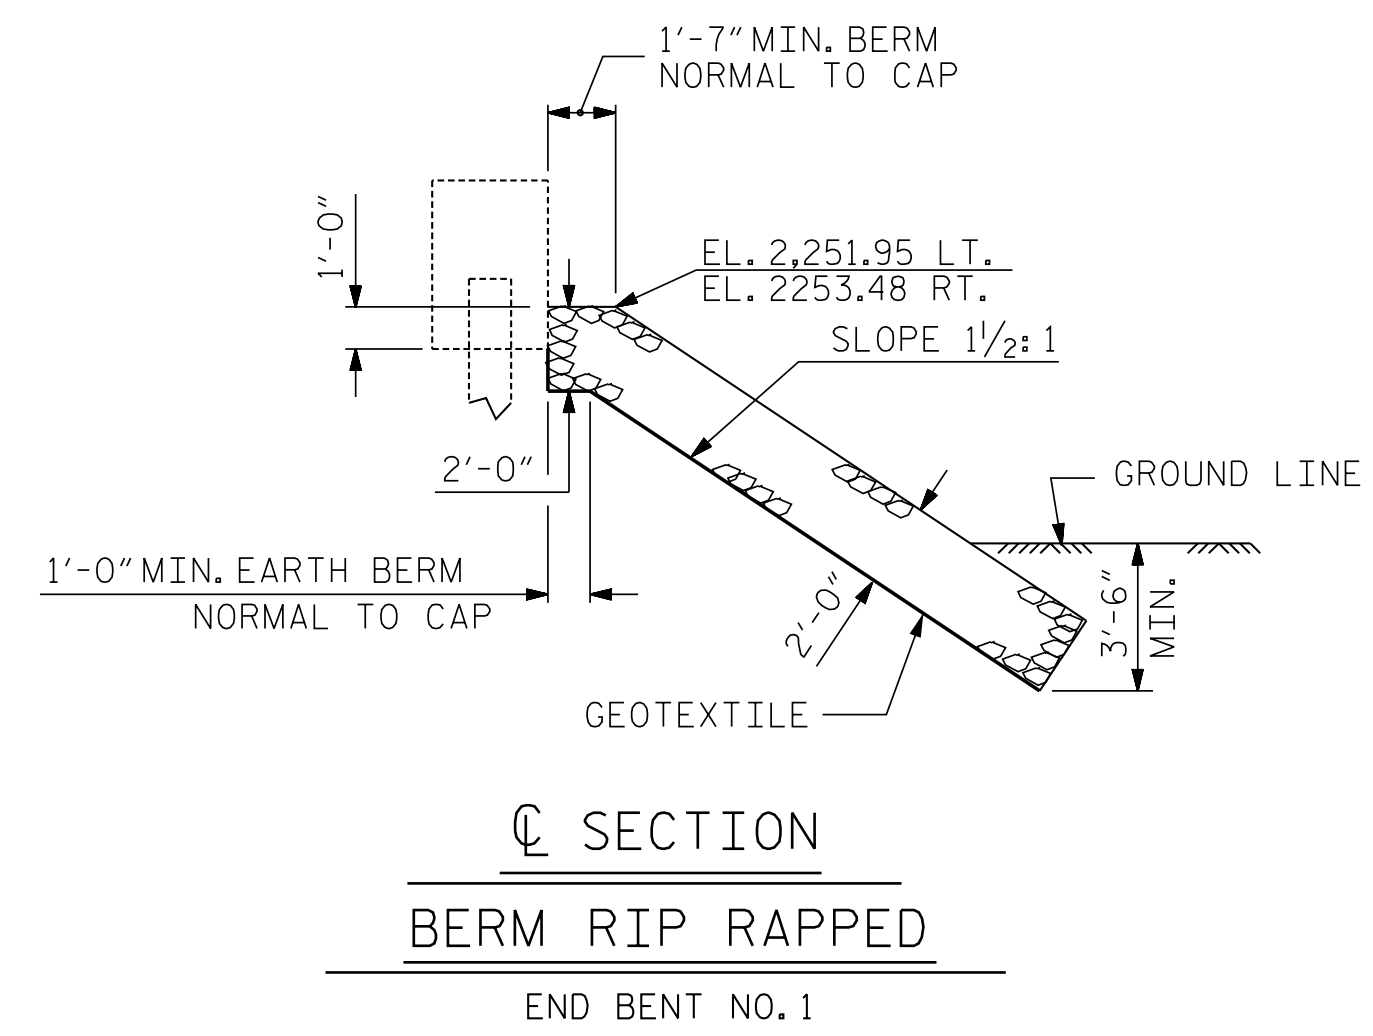

SECTION
BERM RIP RAPPED
END BENT NO. 1

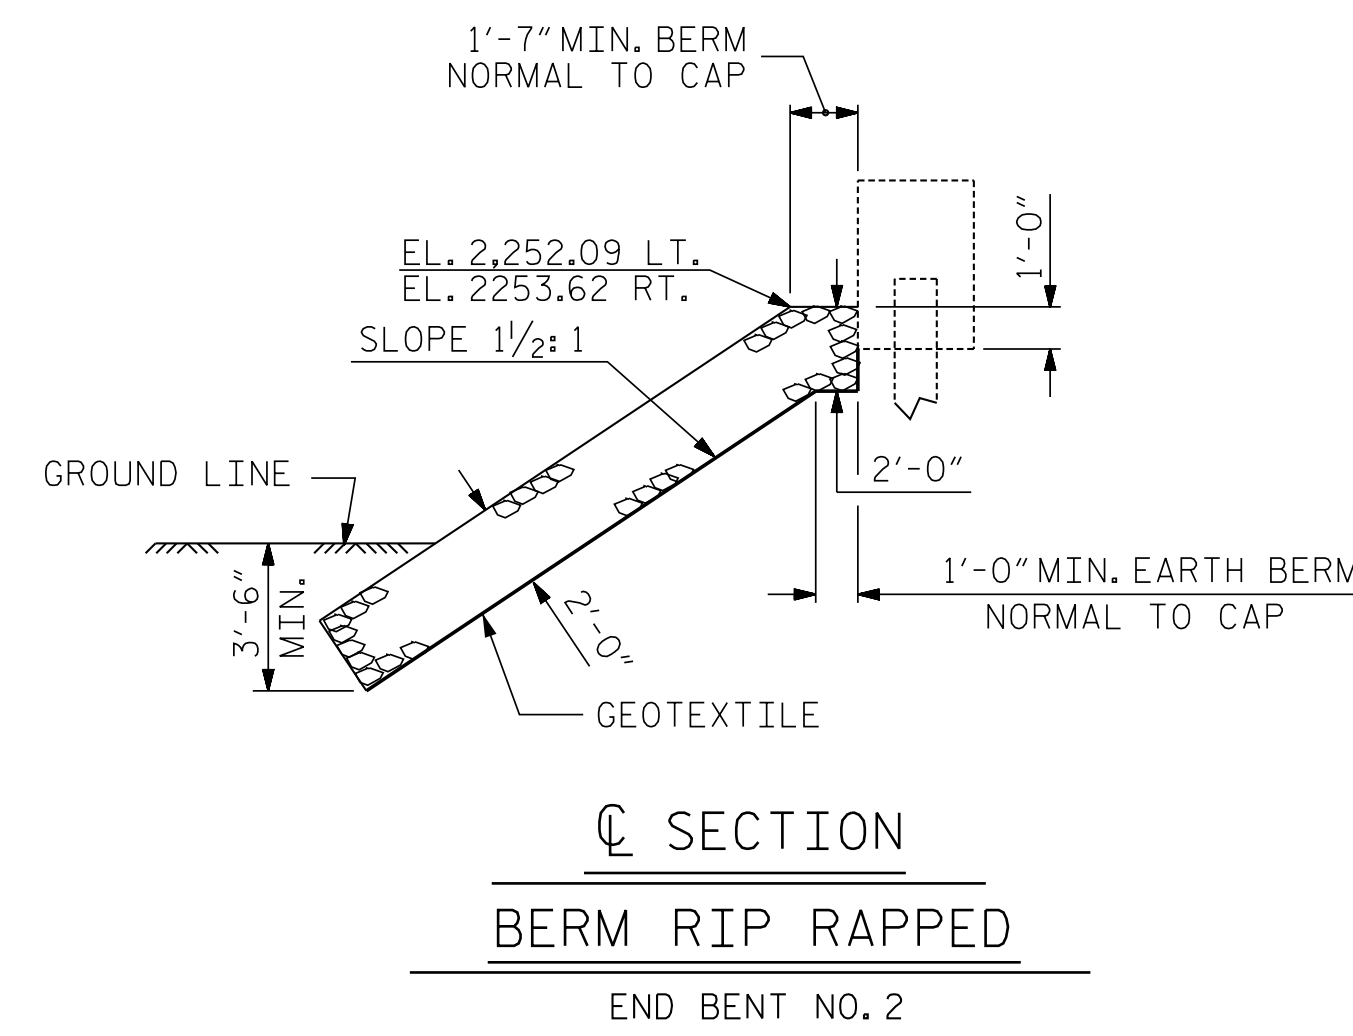

SECTION
BERM RIP RAPPED
END BENT NO. 2

V&M
Vaughn & Melton
Consulting Engineers
Asheville, North Carolina
828-253-2796

Boone, NC 828-355-9933
 Tri-Cities, TN 423-467-8401
 Knoxville, TN 865-546-5800
 Spartanburg, SC 864-574-4775
 Charleston, SC 843-974-5650
 Middlesboro, KY 606-248-6600
 Atlanta, GA 770-627-3509
 Raleigh, NC 919-977-9455
 Charlotte, NC 704-357-0488

Copyright © 2006 Vaughn & Melton, Inc. All Rights Reserved

PROJECT NO. 14SP.20561.1
MACON COUNTY
STATION: 13+25.02 -L-




STATE OF NORTH CAROLINA
DEPARTMENT OF TRANSPORTATION
RALEIGH
STANDARD
RIP RAP DETAILS


| | | |
|--------------------------|---------------|---------|
| ENGINEER OF RECORD : JEB | DATE : 7/16 | MAA/GM |
| ASSEMBLED BY : MAF | DATE : 7/16 | MAA/GM |
| CHECKED BY : HLW | | MAA/THC |
| DRAWN BY : REK 1/84 | REV. 10/1/11 | |
| CHECKED BY : RDU 1/84 | REV. 12/21/11 | |
| | REV. 12/17 | |

DOCUMENT NOT CONSIDERED
FINAL UNLESS ALL
SIGNATURES COMPLETED



| REVISIONS | | | | | | SHEET NO. |
|-----------|-----|-------|-----|-----|-------|--------------|
| NO. | BY: | DATE: | NO. | BY: | DATE: | S-12 |
| 1 | | | 3 | | | TOTAL SHEETS |
| 2 | | | 4 | | | 13 |

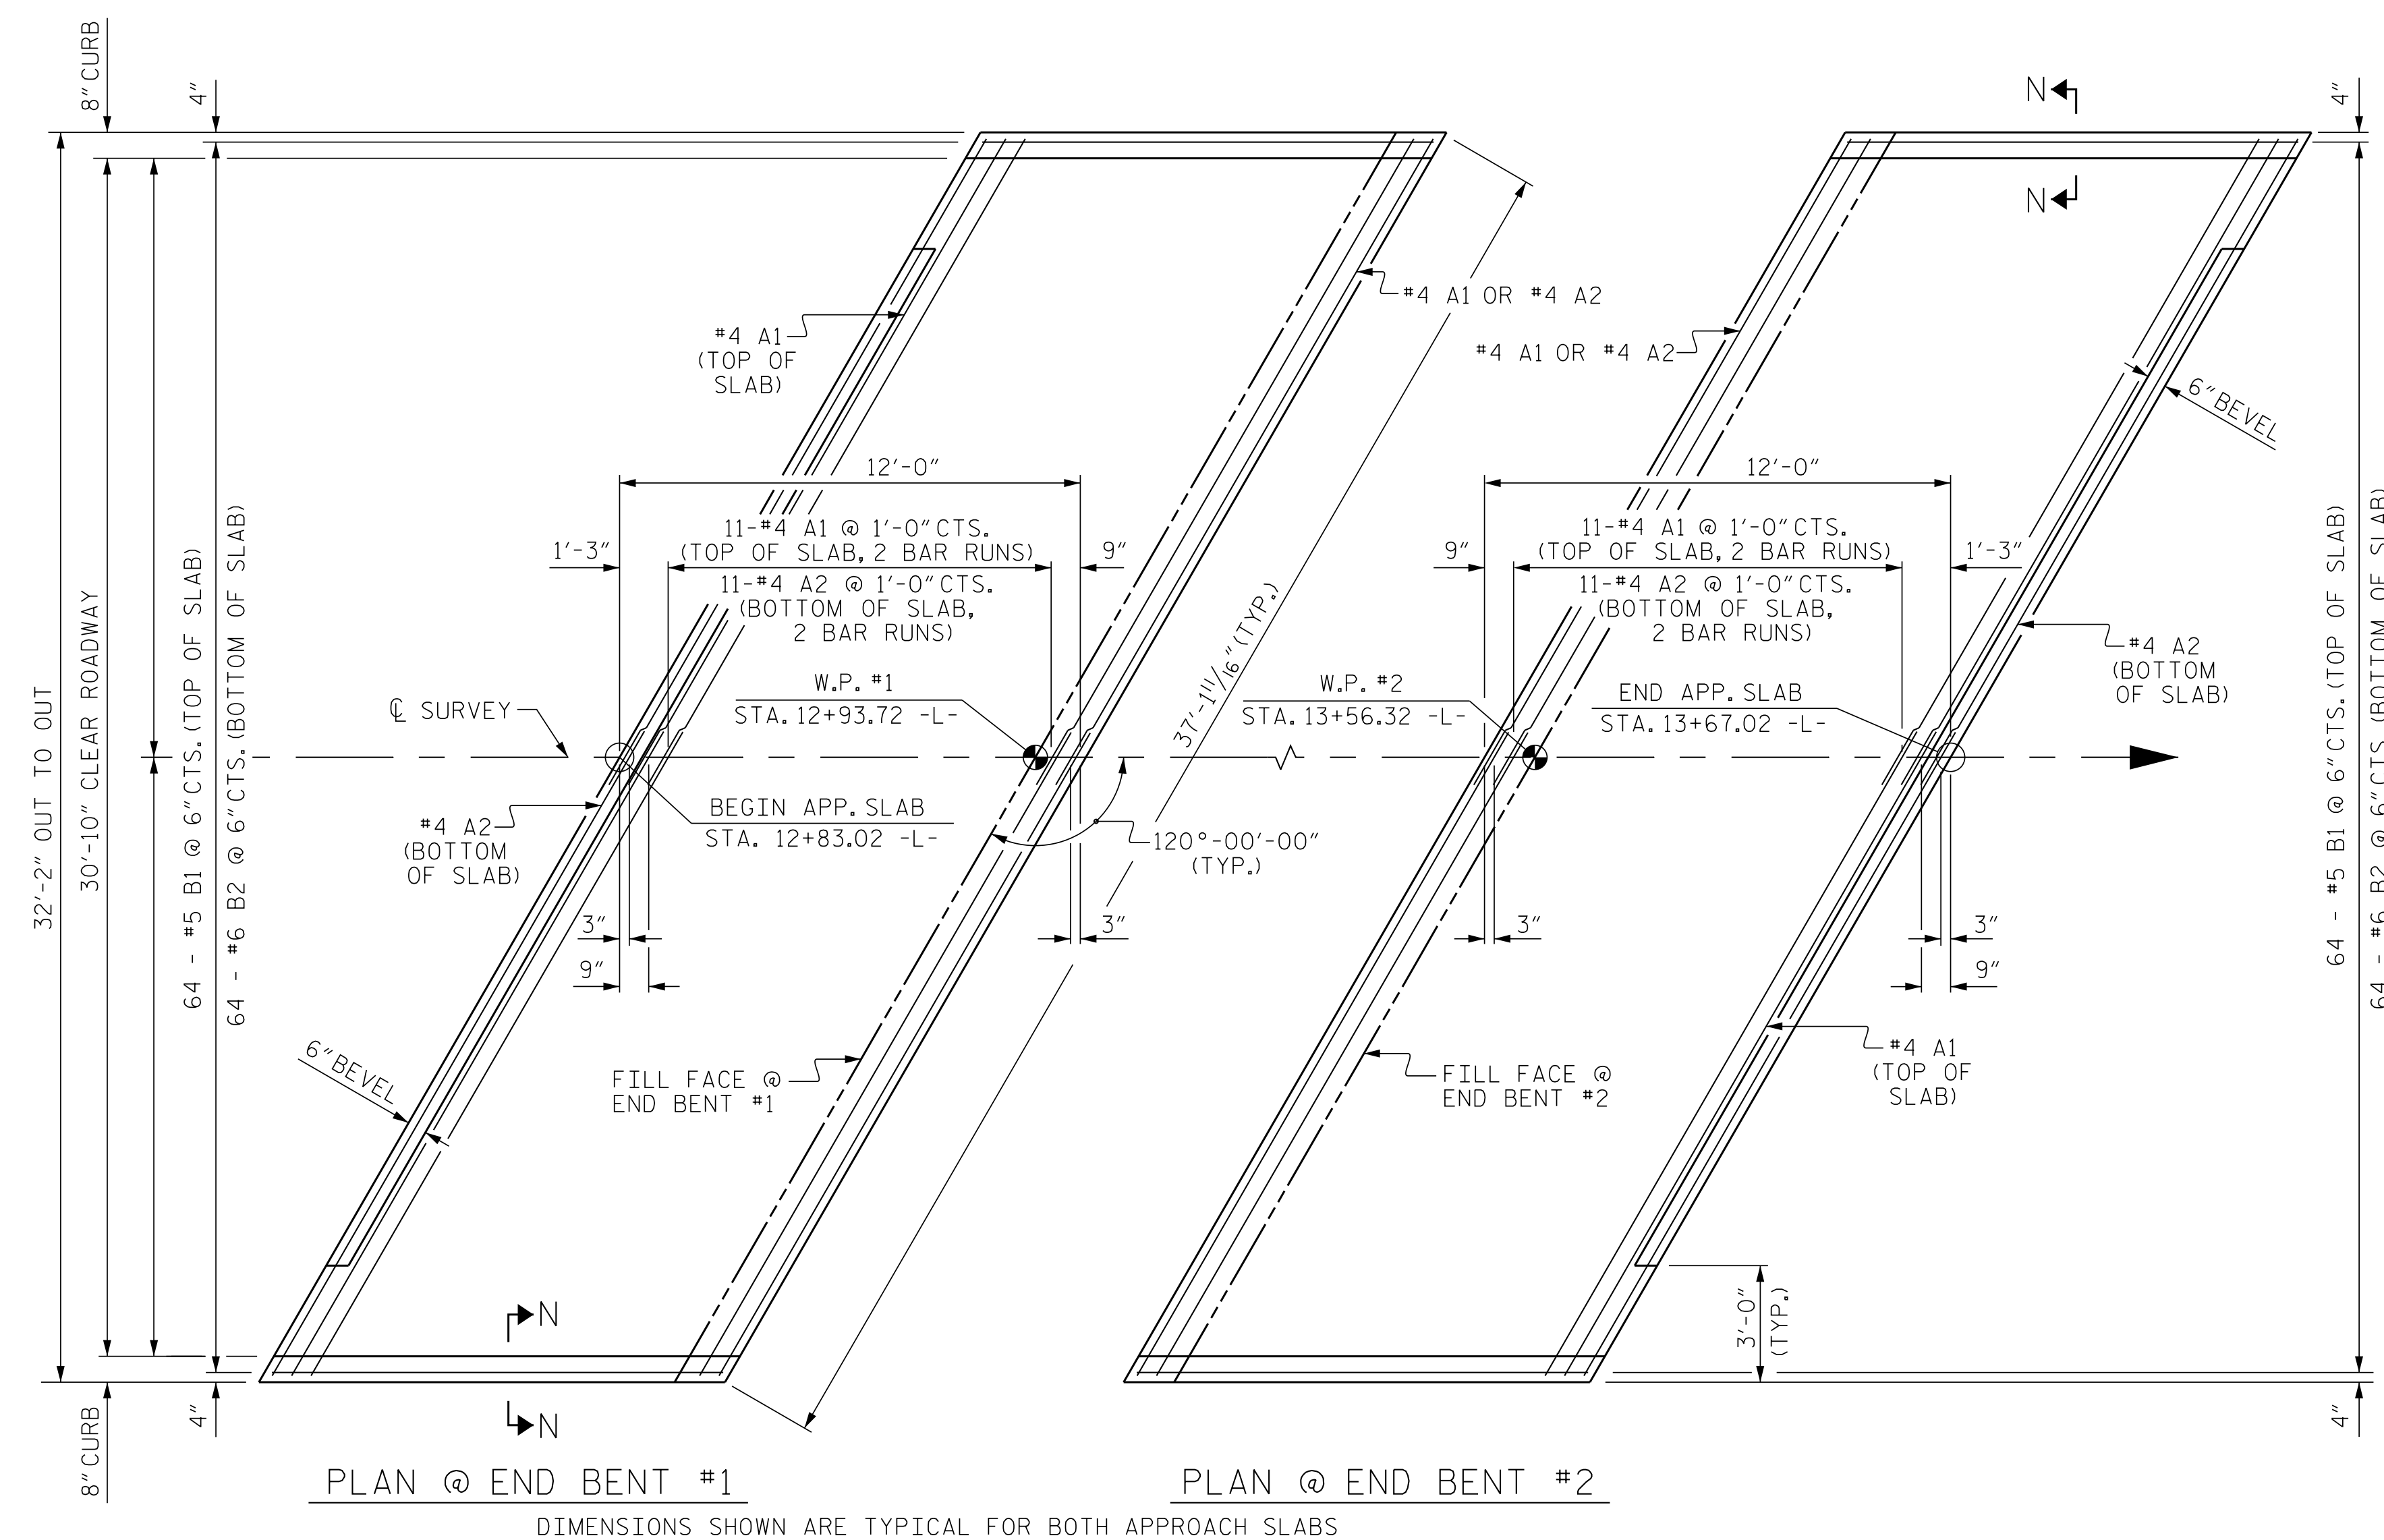

PLAN @ END BENT #1
 PLAN @ END BENT #2
 DIMENSIONS SHOWN ARE TYPICAL FOR BOTH APPROACH SLABS

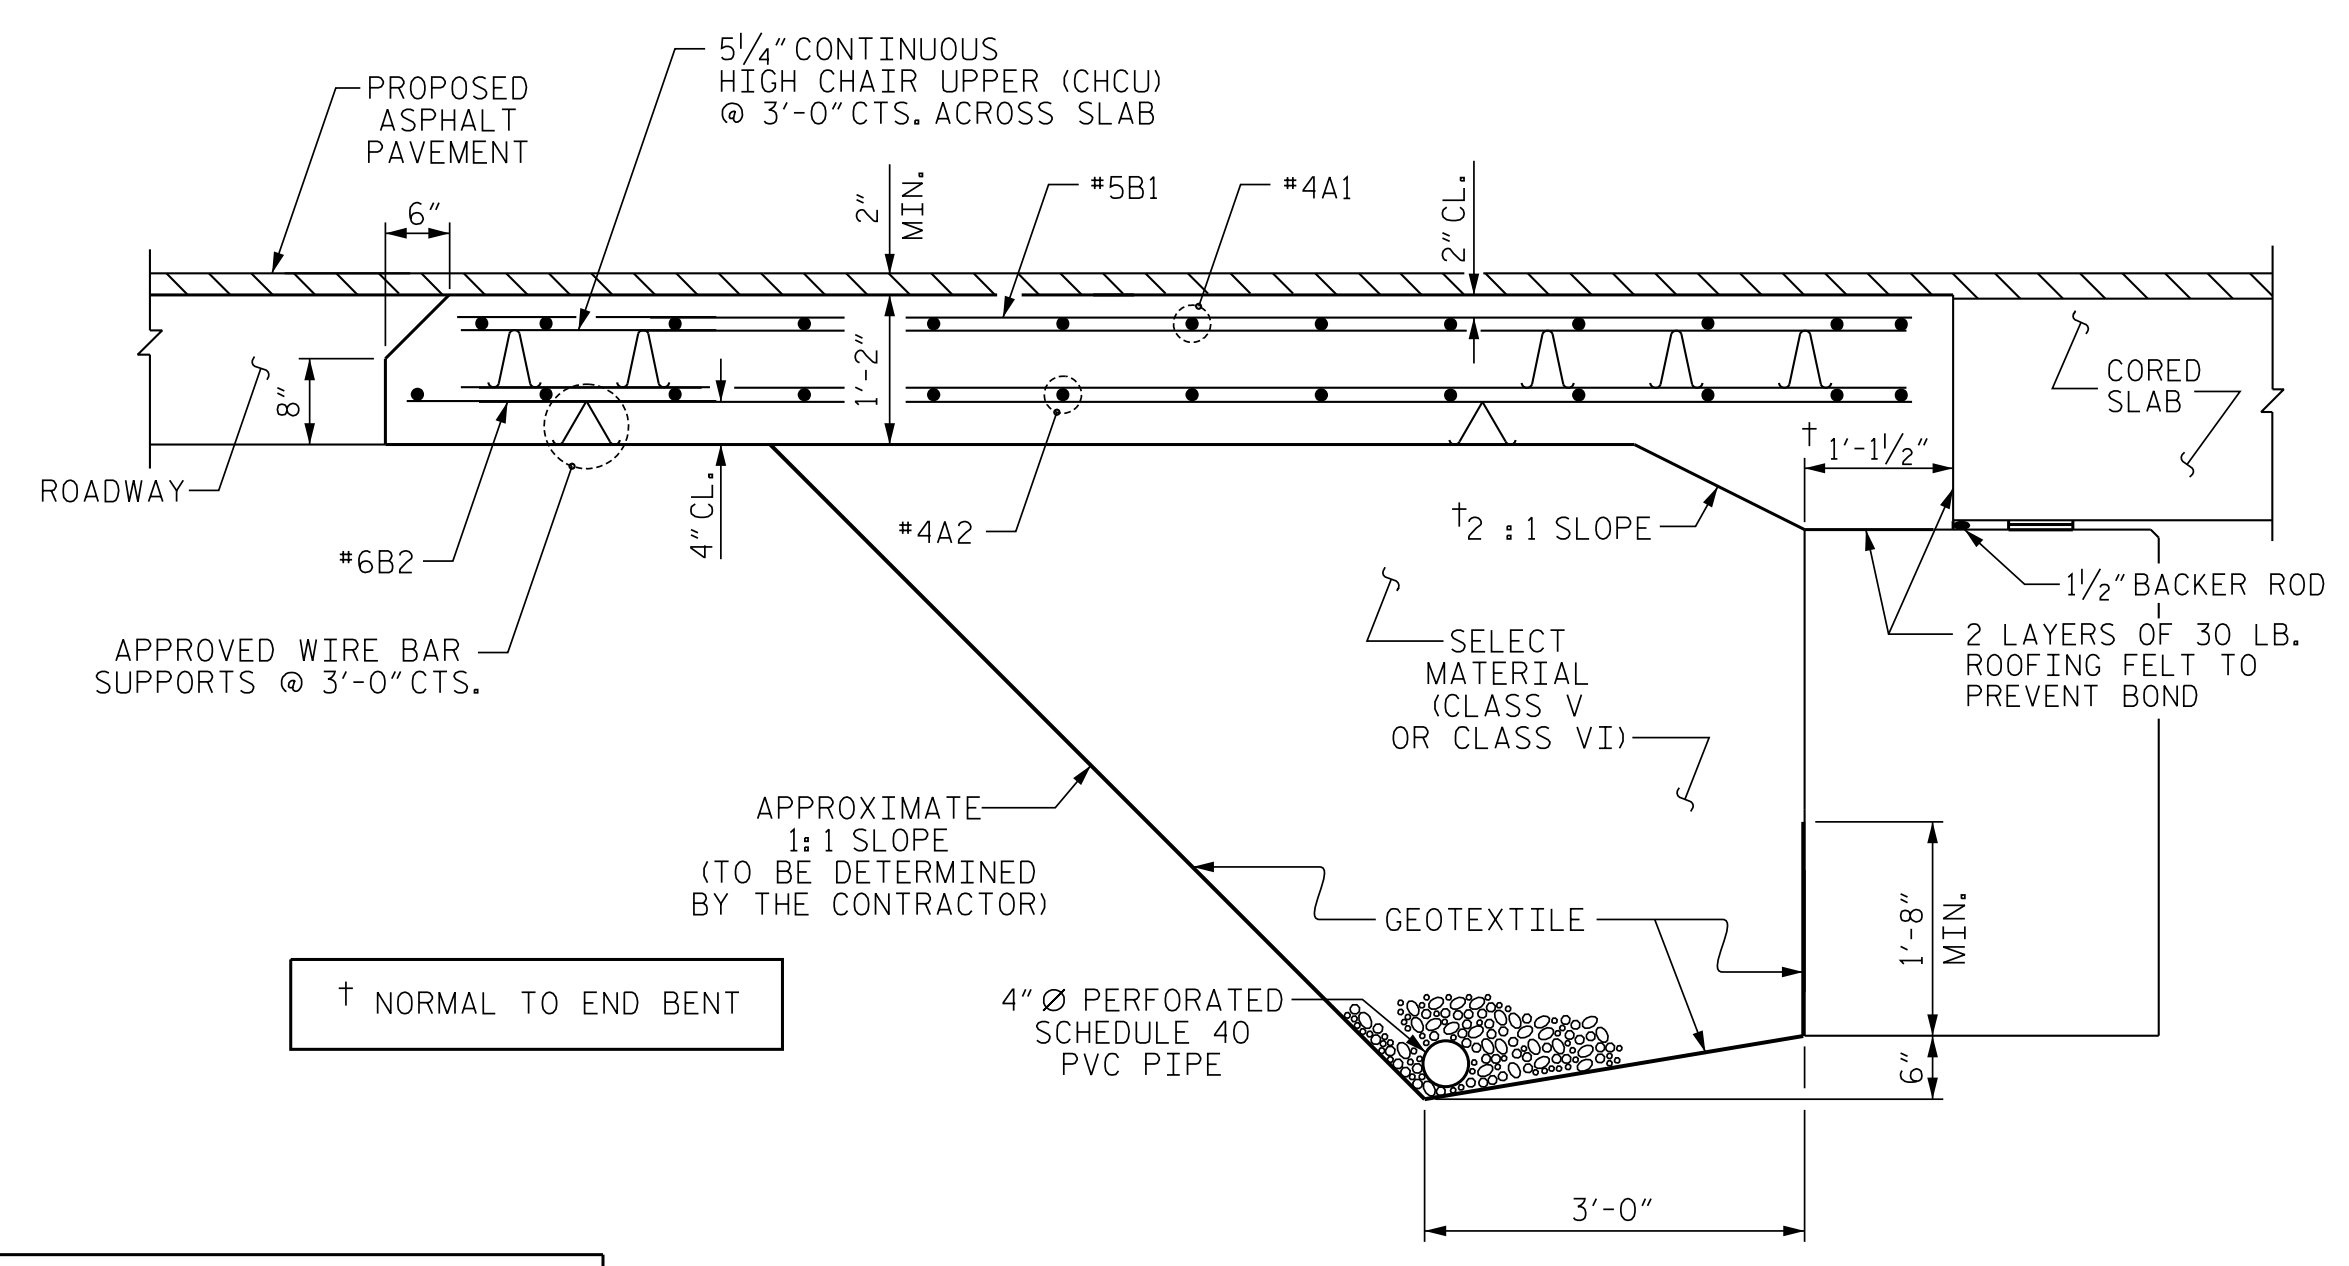

SECTION THRU SLAB
 (TYPE II - MODIFIED APPROACH FILL)

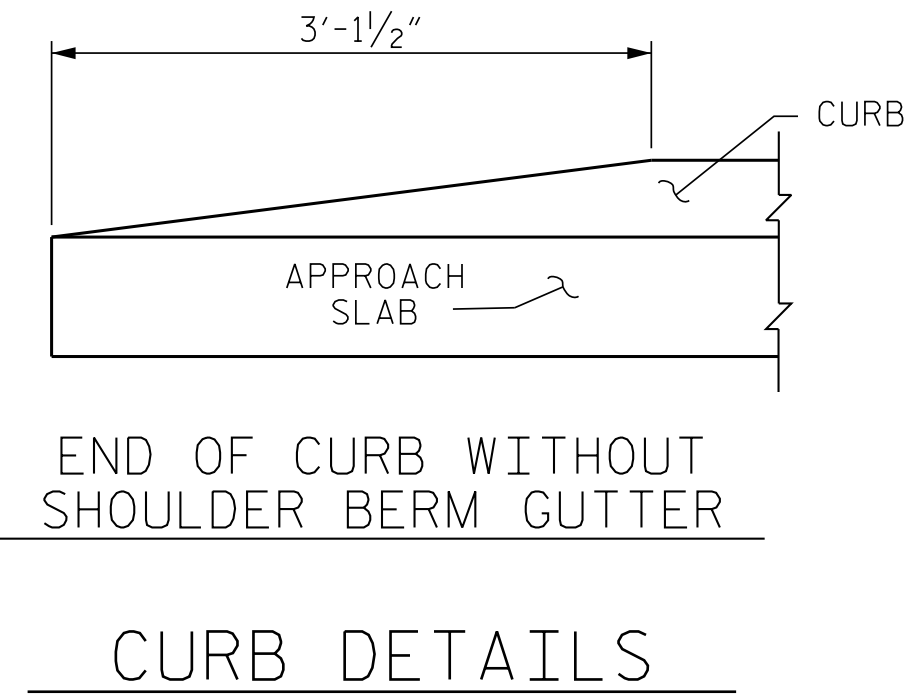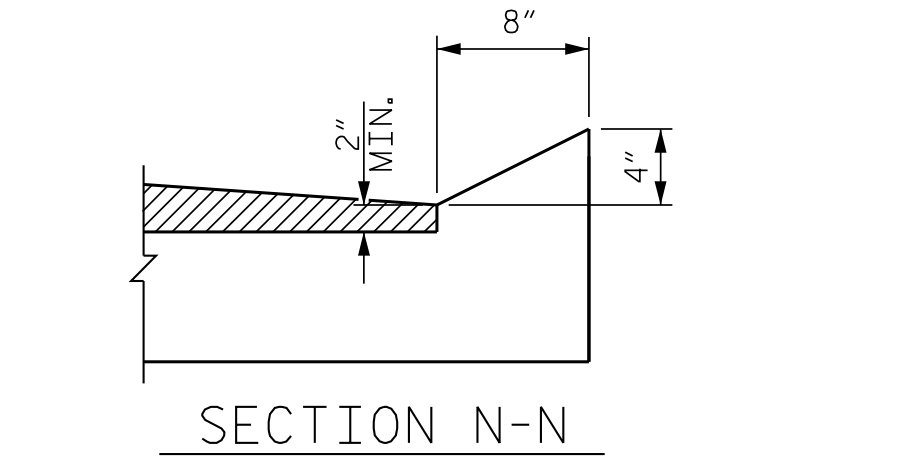

NOTES

FOR BRIDGE APPROACH FILL INCLUDING GEOTEXTILE, 4" Ø DRAINAGE PIPE, AND SELECT MATERIAL BACKFILL, SEE ROADWAY PLANS.

GEOTEXTILE SHALL BE TYPE 1 IN ACCORDANCE WITH THE STANDARD SPECIFICATIONS SECTION 1056.


SELECT MATERIAL BACKFILL (CLASS V OR CLASS VI) SHALL BE IN ACCORDANCE WITH STANDARD SPECIFICATIONS SECTION 1016.

SELECT MATERIAL BACKFILL IS TO BE CONTINUOUS ALONG FILL FACE OF BACKWALL FROM OUTSIDE EDGE TO OUTSIDE EDGE OF APPROACH SLAB.


FOR THE 4" Ø DRAINAGE PIPE OUTLET(S), SEE ROADWAY STANDARD DRAWINGS.

AREA BETWEEN THE WINGWALL AND APPROACH SLAB SHALL BE GRADED TO DRAIN THE WATER AWAY FROM THE FILL FACE OF THE BRIDGE AND SHALL BE PAVED. SEE ROADWAY PLANS.

APPROACH SLAB GROOVING IS NOT REQUIRED.

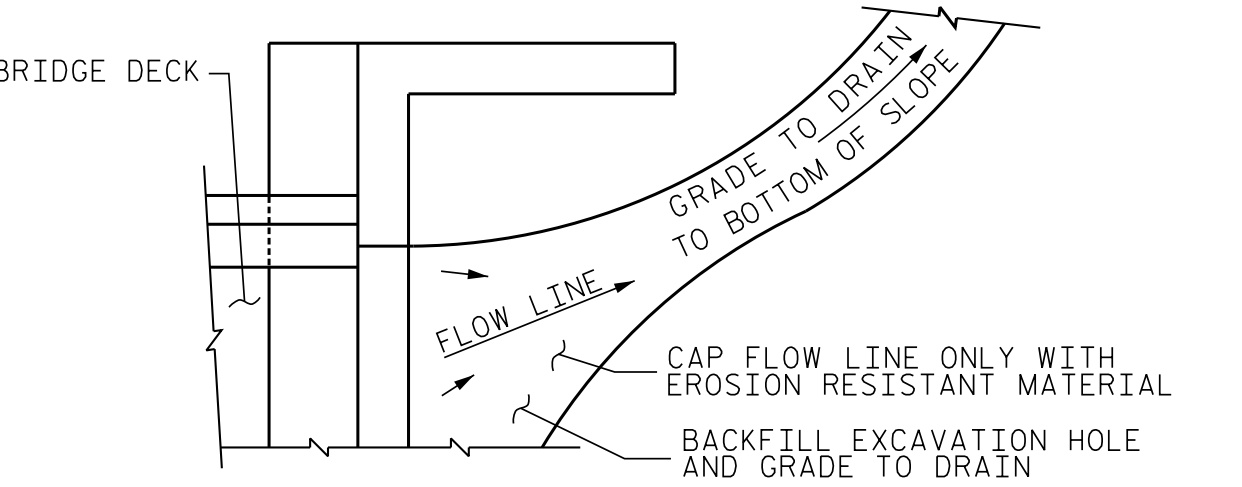


NOTE: IF THE APPROACH SLAB IS NOT CONSTRUCTED IMMEDIATELY AFTER THE BACKFILLING OF THE END BENT EXCAVATION, GRADE TO DRAIN TO THE BOTTOM OF THE SLOPE AND PROVIDE EROSION RESISTANT MATERIAL, SUCH AS FIBERGLASS ROVING OR AS DIRECTED BY THE ENGINEER TO PREVENT SOIL EROSION AND TO PROTECT THE AREA ADJACENT TO THE STRUCTURE. THE CONTRACTOR WILL BE REQUIRED TO REMOVE THESE MATERIALS PRIOR TO CONSTRUCTION OF THE APPROACH SLAB.

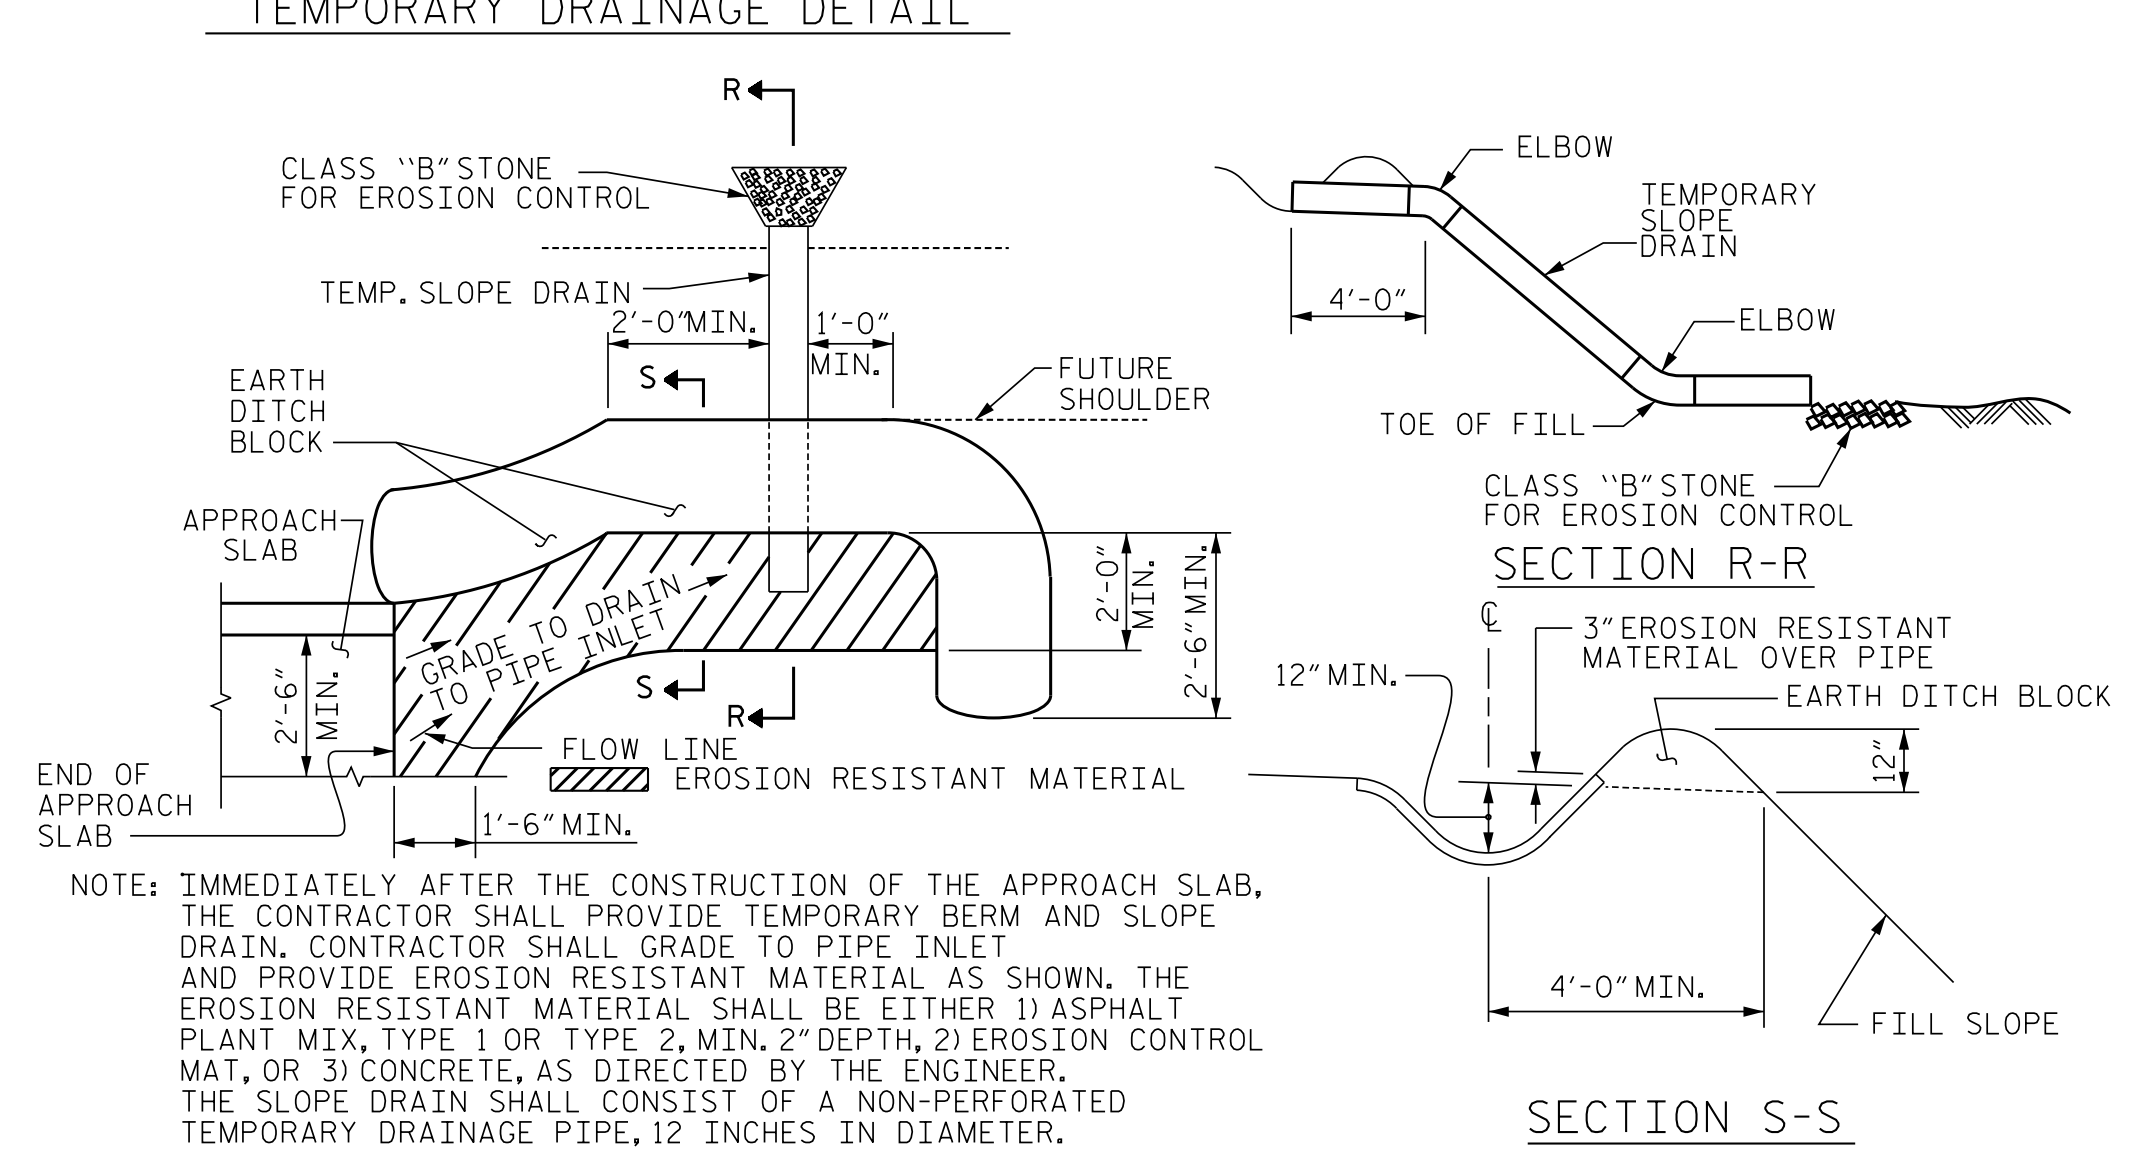

TEMPORARY BERM AND SLOPE DRAIN DETAILS
 (TO BE USED WHEN SHOULDER BERM GUTTER IS REQUIRED)

| BILL OF MATERIAL | | | | | |
|---------------------------------|-----|------|------|--------|--------|
| APPROACH SLAB AT EB #1 | | | | | |
| BAR | NO. | SIZE | TYPE | LENGTH | WEIGHT |
| *A1 | 26 | #4 | STR | 19'-5" | 337 |
| A2 | 26 | #4 | STR | 19'-4" | 336 |
| *B1 | 64 | #5 | STR | 11'-1" | 740 |
| B2 | 64 | #6 | STR | 11'-7" | 1,113 |
| REINFORCING STEEL | | | | LBS. | 1,449 |
| *EPOXY COATED REINFORCING STEEL | | | | LBS. | 1,077 |
| CLASS AA CONCRETE | | | | C. Y. | 19.8 |
| APPROACH SLAB AT EB #2 | | | | | |
| BAR | NO. | SIZE | TYPE | LENGTH | WEIGHT |
| *A1 | 26 | #4 | STR | 19'-5" | 337 |
| A2 | 26 | #4 | STR | 19'-4" | 336 |
| *B1 | 64 | #5 | STR | 11'-1" | 740 |
| B2 | 64 | #6 | STR | 11'-7" | 1,113 |
| REINFORCING STEEL | | | | LBS. | 1,449 |
| *EPOXY COATED REINFORCING STEEL | | | | LBS. | 1,077 |
| CLASS AA CONCRETE | | | | C. Y. | 19.8 |

| SPlice LENGTHS | | |
|----------------|--------------|----------|
| BAR SIZE | EPOXY COATED | UNCOATED |
| #4 | 2'-0" | 1'-9" |
| #5 | 2'-6" | 2'-2" |
| #6 | 3'-10" | 2'-7" |

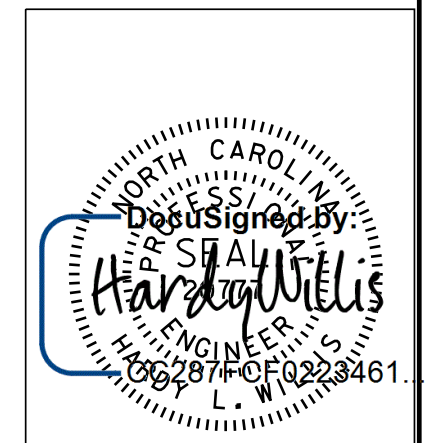

PROJECT NO. 14SP.20561.1
 MACON COUNTY
 STATION: 13+25.02 -L-

STATE OF NORTH CAROLINA
 DEPARTMENT OF TRANSPORTATION
 RALEIGH
 STANDARD
 BRIDGE APPROACH SLAB
 FOR PRESTRESSED CONCRETE
 CORED SLAB UNIT
 (SUB-REGIONAL TIER)

ENGINEER OF RECORD: JEB
 ASSEMBLED BY: MAF
 CHECKED BY: HLW
 DATE: 7/16
 DATE: 7/16

DRAWN BY: SHS/MAA 5-09
 CHECKED BY: BCH 5-09

REV. 12-17
 REV. 08-19

MAA/THC
 BNB/THC

| REVISIONS | | | | | | SHEET NO. |
|-----------|-----|-------|-----|-----|-------|--------------|
| NO. | BY: | DATE: | NO. | BY: | DATE: | S-13 |
| 1 | | | 3 | | | TOTAL SHEETS |
| 2 | | | 4 | | | 13 |

DOCUMENT NOT CONSIDERED FINAL UNLESS ALL SIGNATURES COMPLETED

STANDARD NOTES

DESIGN DATA:

| | | |
|---|-------|----------------------------------|
| SPECIFICATIONS | ----- | A.A.S.H.T.O. (CURRENT) |
| LIVE LOAD | ----- | SEE PLANS |
| IMPACT ALLOWANCE | ----- | SEE A.A.S.H.T.O. |
| STRESS IN EXTREME FIBER OF STRUCTURAL STEEL - AASHTO M270 GRADE 36 | -- | 20,000 LBS. PER SQ. IN. |
| | -- | 27,000 LBS. PER SQ. IN. |
| | -- | 27,000 LBS. PER SQ. IN. |
| REINFORCING STEEL IN TENSION - GRADE 60 | ---- | 24,000 LBS. PER SQ. IN. |
| CONCRETE IN COMPRESSION | ----- | 1,200 LBS. PER SQ. IN. |
| CONCRETE IN SHEAR | ----- | SEE A.A.S.H.T.O. |
| STRUCTURAL TIMBER - TREATED OR UNTREATED EXTREME FIBER STRESS | ---- | 1,800 LBS. PER SQ. IN. |
| COMPRESSION PERPENDICULAR TO GRAIN OF TIMBER | ----- | 375 LBS. PER SQ. IN. |
| EQUIVALENT FLUID PRESSURE OF EARTH | ----- | 30 LBS. PER CU. FT. (MINIMUM) |

MATERIAL AND WORKMANSHIP:

EXCEPT AS MAY OTHERWISE BE SPECIFIED ON PLANS OR IN THE SPECIAL PROVISIONS, ALL MATERIAL AND WORKMANSHIP SHALL BE IN ACCORDANCE WITH THE 2018 "STANDARD SPECIFICATIONS FOR ROADS AND STRUCTURES" OF THE N.C. DEPARTMENT OF TRANSPORTATION.

STEEL SHEET PILING FOR PERMANENT OR TEMPORARY APPLICATIONS SHALL BE HOT ROLLED.

CONCRETE:

UNLESS OTHERWISE REQUIRED ON PLANS, CLASS A CONCRETE SHALL BE USED FOR ALL PORTIONS OF ALL STRUCTURES WITH THE EXCEPTION THAT: CLASS AA CONCRETE SHALL BE USED IN BRIDGE SUPERSTRUCTURES, ABUTMENT BACKWALLS, AND APPROACH SLABS; AND CLASS B CONCRETE SHALL BE USED FOR SLOPE PROTECTION AND RIP RAP.

CONCRETE CHAMFERS:

UNLESS OTHERWISE NOTED ON THE PLANS, ALL EXPOSED CORNERS ON STRUCTURES SHALL BE CHAMFERED $\frac{3}{4}$ " WITH THE FOLLOWING EXCEPTIONS: TOP CORNERS OF CURBS MAY BE ROUNDED TO $1\frac{1}{2}$ " RADIUS WHICH IS BUILT INTO CURB FORMS; CORNERS OF TRANSVERSE FLOOR EXPANSION JOINTS SHALL BE ROUNDED WITH A $\frac{1}{4}$ " FINISHING TOOL UNLESS OTHERWISE REQUIRED ON PLANS; AND CORNERS OF EXPANSION JOINTS IN THE ROADWAY FACES AND TOPS OF CURBS AND SIDEWALKS SHALL BE ROUNDED TO A $\frac{1}{4}$ " RADIUS WITH A FINISHING STONE OR TOOL UNLESS OTHERWISE REQUIRED ON PLANS.

DOWELS:

DOWELS WHEN INDICATED ON PLANS AS FOR CULVERT EXTENSIONS, SHALL BE EMBEDDED AT LEAST 12" INTO THE OLD CONCRETE AND GROUTED INTO PLACE WITH 1:2 CEMENT MORTAR.

ALLOWANCE FOR DEAD LOAD DEFLECTION, SETTLEMENT, ETC. IN CASTING SUPERSTRUCTURES:

BRIDGES SHALL BE BUILT ON THE GRADE OR VERTICAL CURVE SHOWN ON PLANS. SLABS, CURBS AND PARAPETS SHALL CONFORM TO THE GRADE OR CURVE.

ALL DIMENSIONS WHICH ARE GIVEN IN SECTION AND ARE AFFECTED BY DEAD LOAD DEFLECTIONS ARE DIMENSIONS AT CENTER LINE OF BEARING UNLESS OTHERWISE NOTED ON PLANS. IN SETTING FORMS FOR STEEL BEAM BRIDGES AND PRESTRESSED CONCRETE GIRDER BRIDGES, ADJUSTMENTS SHALL BE MADE DUE TO THE DEAD LOAD DEFLECTIONS FOR THE ELEVATIONS SHOWN. WHERE BLOCKS ARE SHOWN OVER BEAMS FOR BUILDING UP TO THE SLAB, THE VERTICAL DIMENSIONS OF THE BLOCKS SHALL BE ADJUSTED BETWEEN BEARINGS TO COMPENSATE FOR DEAD LOAD DEFLECTIONS, VERTICAL CURVE ORDINATE, AND ACTUAL BEAM CAMBER. WHERE BOTTOM OF SLAB IS IN LINE WITH BOTTOM OF TOP FLANGES, DEPTH OF SLAB BETWEEN BEARINGS SHALL BE ADJUSTED TO COMPENSATE FOR DEAD LOAD DEFLECTION, VERTICAL CURVE ORDINATE, AND ACTUAL BEAM CAMBER.

IN SETTING FALSEWORK AND FORMS FOR REINFORCED CONCRETE SPANS, AN ALLOWANCE SHALL BE MADE FOR DEAD LOAD DEFLECTIONS, SETTLEMENT OF FALSEWORK, AND PERMANENT CAMBER WHICH SHALL BE PROVIDED FOR IN ADDITION TO THE ELEVATIONS SHOWN. AFTER REMOVAL OF THE FALSEWORK, THE FINISHED STRUCTURES SHALL CONFORM TO THE PROFILE AND ELEVATIONS SHOWN ON THE PLANS AND CONSTRUCTION ELEVATIONS FURNISHED BY THE ENGINEER.

DETAILED DRAWINGS FOR FALSEWORK OR FORMS FOR BRIDGE SUPERSTRUCTURE AND ANY STRUCTURE OR PARTS OF A STRUCTURE AS NOTED ON THE PLANS SHALL BE SUBMITTED TO THE ENGINEER FOR APPROVAL BEFORE CONSTRUCTION OF THE FALSEWORK OR FORMS IS STARTED.

REINFORCING STEEL:

ALL REINFORCING STEEL SHALL BE DEFORMED. DIMENSIONS RELATIVE TO PLACEMENT OF REINFORCING ARE TO CENTERS OF BARS UNLESS OTHERWISE INDICATED IN THE PLANS. DIMENSIONS ON BAR DETAILS ARE TO CENTERS OF BARS OR ARE OUT TO OUT AS INDICATED ON PLANS.

WIRE BAR SUPPORTS SHALL BE PROVIDED FOR REINFORCING STEEL WHERE INDICATED ON THE PLANS. WHEN BAR SUPPORT PIECES ARE PLACED IN CONTINUOUS LINES, THEY SHALL BE SO PLACED THAT THE ENDS OF THE SUPPORTING WIRES SHALL BE LAPPED TO LOCK LEGS ON ADJOINING PIECES.

STRUCTURAL STEEL:

AT THE CONTRACTOR'S OPTION, HE MAY SUBSTITUTE $\frac{7}{8}$ " \emptyset SHEAR STUDS FOR THE $\frac{3}{4}$ " \emptyset STUDS SPECIFIED ON THE PLANS. THIS SUBSTITUTION SHALL BE MADE AT THE RATE OF 3 - $\frac{7}{8}$ " \emptyset STUDS FOR 4 - $\frac{3}{4}$ " \emptyset STUDS, AND STUD SPACING CHANGES SHALL BE MADE AS NECESSARY TO PROVIDE THE SAME EQUIVALENT NUMBER OF $\frac{7}{8}$ " \emptyset STUDS ALONG THE BEAM AS SHOWN FOR $\frac{3}{4}$ " \emptyset STUDS BASED ON THE RATIO OF 3 - $\frac{7}{8}$ " \emptyset STUDS FOR 4 - $\frac{3}{4}$ " \emptyset STUDS. STUDS OF THE LENGTH SPECIFIED ON THE PLANS MUST BE PROVIDED. THE MAXIMUM SPACING SHALL BE 2'-0".

EXCEPT AT THE INTERIOR SUPPORTS OF CONTINUOUS BEAMS WHERE THE COVER PLATE IS IN CONTACT WITH BEARING PLATE, THE CONTRACTOR MAY, AT HIS OPTION, SUBSTITUTE FOR THE COVER PLATES DESIGNATED ON THE PLANS COVER PLATES OF THE EQUIVALENT AREA PROVIDED THESE PLATES ARE AT LEAST $\frac{3}{16}$ " IN THICKNESS AND DO NOT EXCEED A WIDTH EQUAL TO THE FLANGE WIDTH LESS 2" OR A THICKNESS EQUAL TO 2 TIMES THE FLANGE THICKNESS. THE SIZE OF FILLET WELDS SHALL CONFORM TO THE REQUIREMENTS OF THE CURRENT ANSI/AASHTO/AWS "BRIDGE WELDING CODE". ELECTROSLAG WELDING WILL NOT BE PERMITTED.

WITH THE SOLE EXCEPTION OF EDGES AT SURFACES WHICH BEAR ON OTHER SURFACES, ALL SHARP EDGES AND ENDS OF SHAPES AND PLATES SHALL BE SLIGHTLY ROUNDED BY SUITABLE MEANS TO A RADIUS OF APPROXIMATELY $\frac{1}{16}$ " INCH OR EQUIVALENT FLAT SURFACE AT A SUITABLE ANGLE PRIOR TO PAINTING, GALVANIZING, OR METALLIZING.

HANDRAILS AND POSTS:

METAL STANDARDS AND FACES OF THE CONCRETE END POSTS FOR THE METAL RAIL SHALL BE SET NORMAL TO THE GRADE OF THE CURB, UNLESS OTHERWISE SHOWN ON PLANS. THE METAL RAIL AND TOPS OF CONCRETE POSTS USED WITH THE ALUMINUM RAIL SHALL BE BUILT PARALLEL TO THE GRADE OF THE CURB.

METAL HANDRAILS SHALL BE IN ACCORDANCE WITH THE PLANS. RAILS SHALL BE AS MANUFACTURED FOR BRIDGE RAILING. CASTINGS SHALL BE OF A UNIFORM APPEARANCE. FINIS AND OTHER DEFORMATIONS RESULTING FROM CASTING OR OTHERWISE SHALL BE REMOVED IN A MANNER SO THAT A UNIFORM COLORING OF THE COMPLETED CASTING SHALL BE OBTAINED. CASTINGS WITH DISCOLORATIONS OR OF NON-UNIFORM COLORING WILL NOT BE ACCEPTED. CERTIFIED MILL REPORTS ARE REQUIRED FOR METAL RAILS AND POSTS.

SPECIAL NOTES:

GENERALLY, IN CASE OF DISCREPANCY, THIS STANDARD SHEET OF NOTES SHALL GOVERN OVER THE SPECIFICATIONS, BUT THE REMAINDER OF THE PLANS SHALL GOVERN OVER NOTES HEREON, AND SPECIAL PROVISIONS SHALL GOVERN OVER ALL. SEE SPECIFICATIONS ARTICLE 105-4.

ENGLISH

JANUARY, 1990

STD. NO. SN