


CONTRACT: DB00162 TIP PROJECT: BD-5102U&17BP.2.R.51

See Sheet 1-A For Index of Sheets

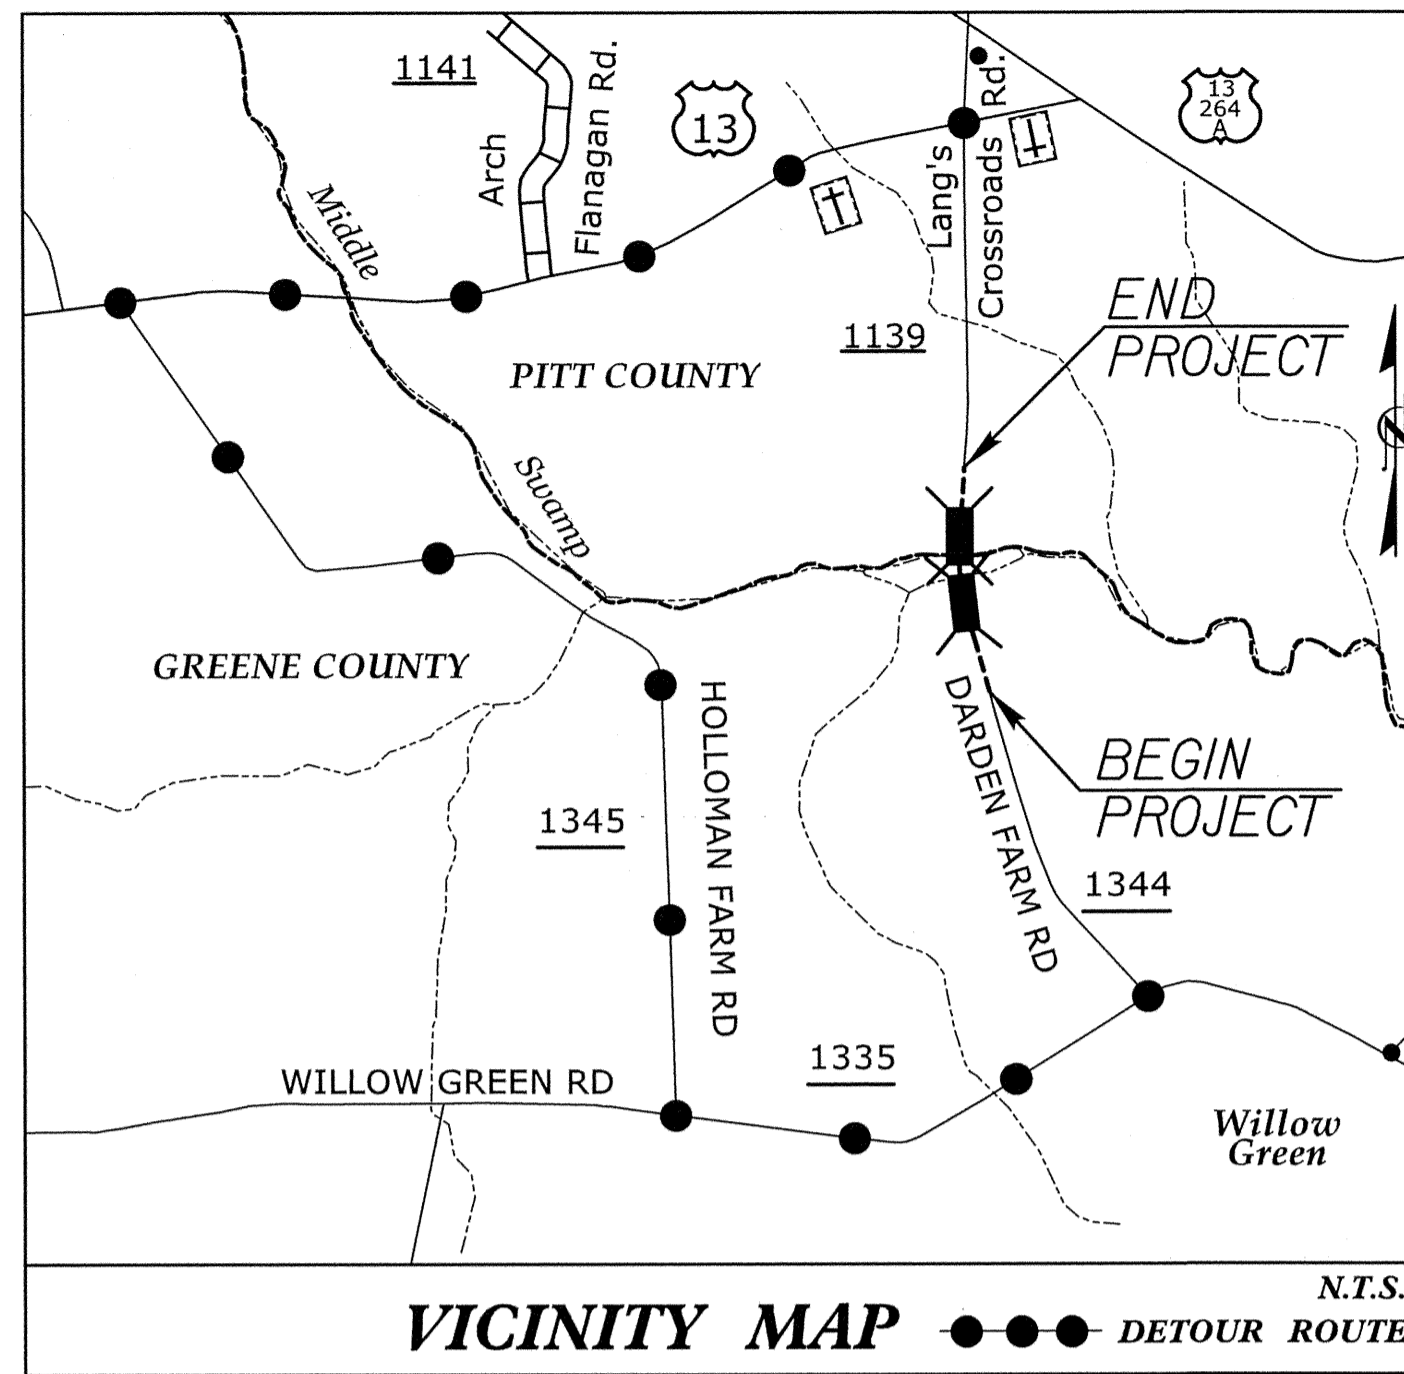


STATE OF NORTH CAROLINA  
DIVISION OF HIGHWAYS

# PITT & GREENE COUNTY

**LOCATION:** BRIDGE NO. 069 OVER MIDDLE SWAMP  
ON SR 1139 (MOYE-TURNAGE RD.) - PITT CO.  
&  
BRIDGE NO. 034 OVER MIDDLE SWAMP(OVERFLOW)  
ON SR 1139 (DARDEN FARM RD.) - GREENE CO.

**TYPE OF WORK:** GRADING, PAVING, RESURFACING, GUARDRAIL,  
DRAINAGE & STRUCTURES

| STATE           | PROJECT REFERENCE NO.  | SHEET NO.   | TOTAL SHEETS |
|-----------------|------------------------|-------------|--------------|
| NC              | BD-5102U & 17BP.2.R.51 | 1           | X            |
| STATE PROJ. NO. | F.A. PROJ. NO.         | DESCRIPTION |              |
| 45348.1.21      | BRZ-1139(5)            | CONST       |              |
| 17BP.2.R.51     |                        |             |              |
|                 |                        |             |              |
|                 |                        |             |              |
|                 |                        |             |              |
|                 |                        |             |              |

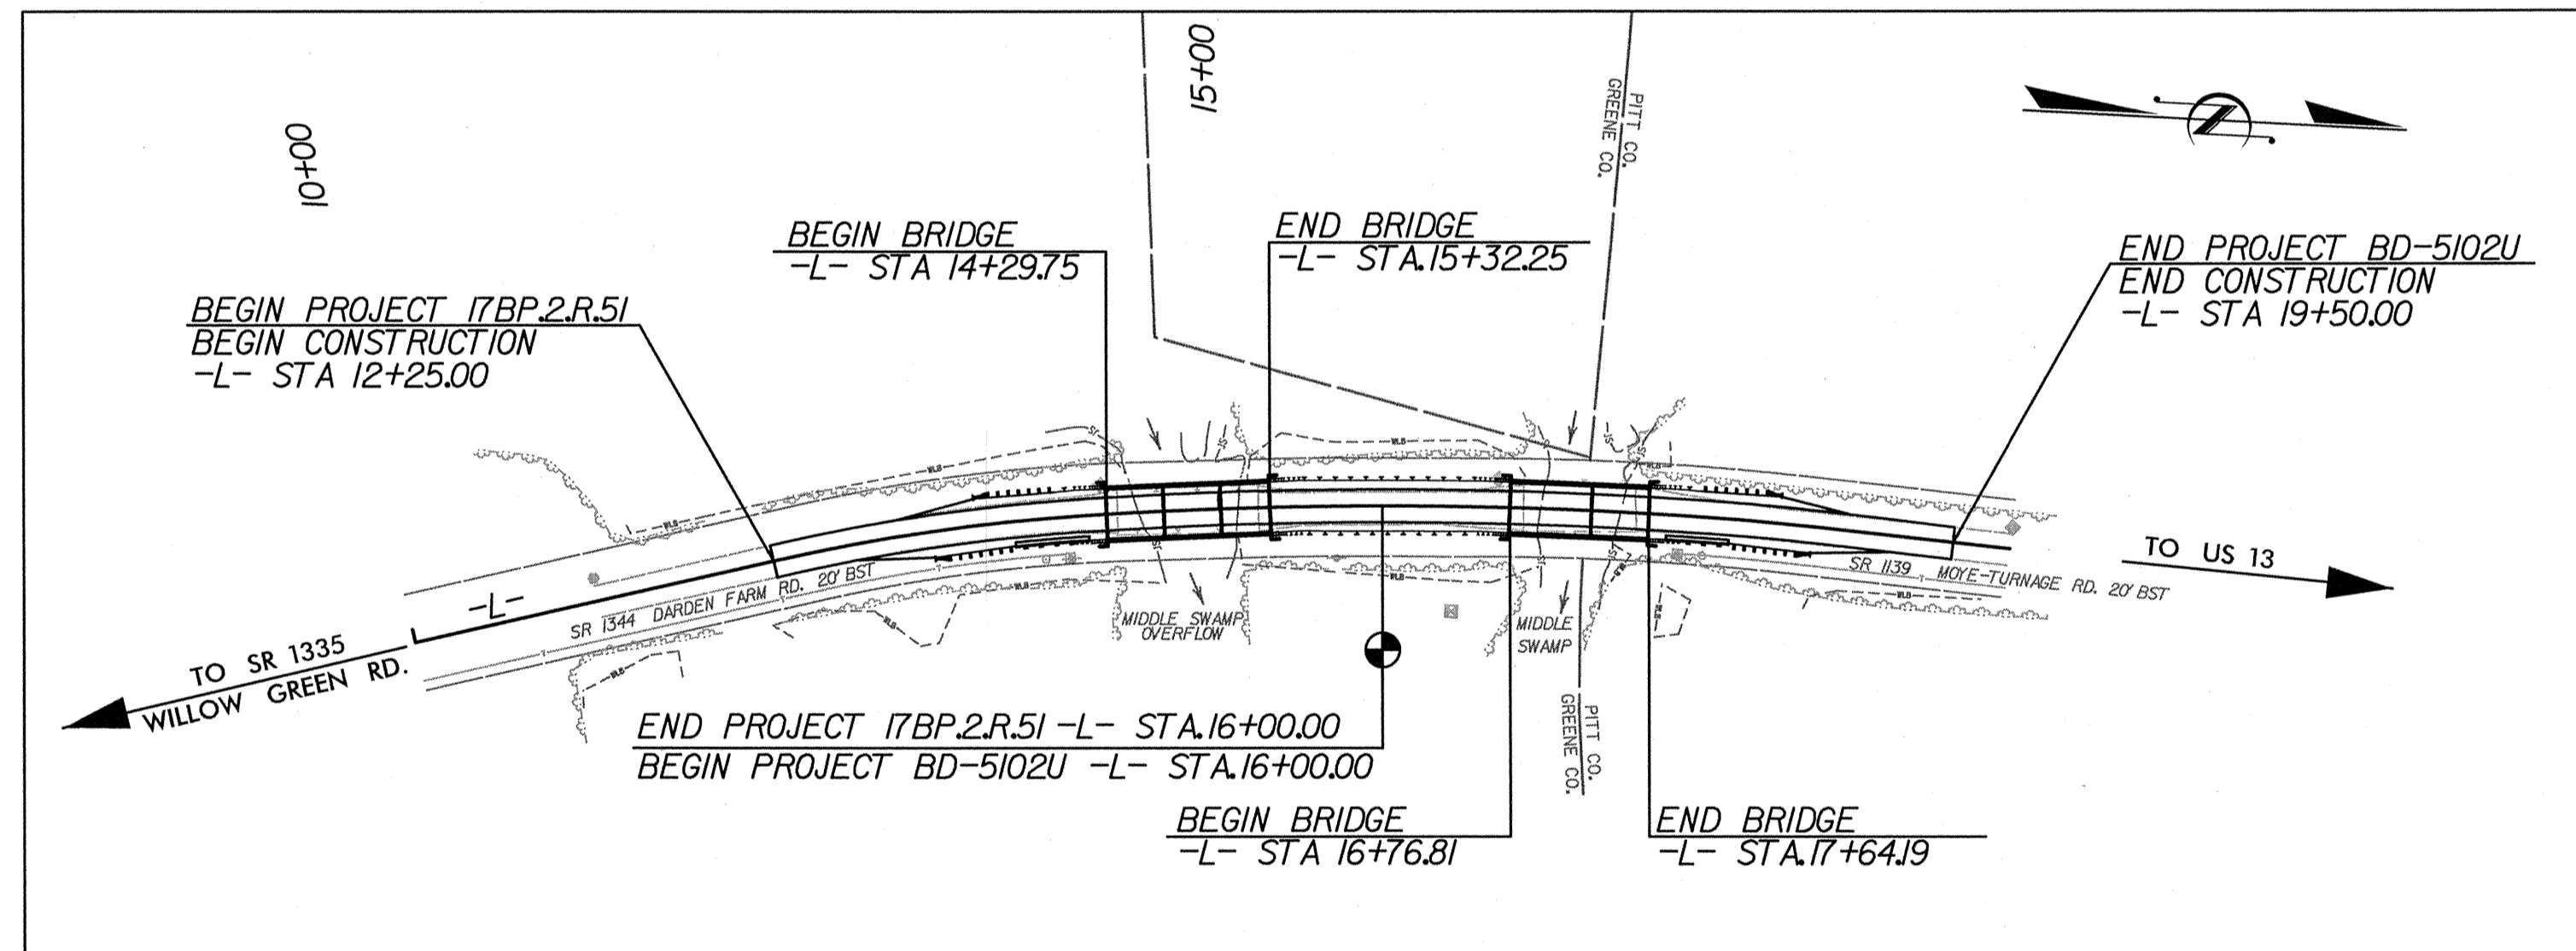

CLEARING ON THIS PROJECT SHALL BE PERFORMED TO THE LIMITS ESTABLISHED BY METHOD II.

|  |   |  |   |   |   |
|--|---|--|---|---|---|
| <p><b>GRAPHIC SCALES</b></p> <p>50 25 0 50 100<br/>PLANS</p> <p>50 25 0 50 100<br/>PROFILE (HORIZONTAL)</p> <p>10 5 0 10 20<br/>PROFILE (VERTICAL)</p> | <p><b>DESIGN DATA</b></p> <p>ADT 2008 = 840<br/>ADT 2035 = 1680<br/>DHV = 10%<br/>D = 60%<br/>T = 6% *<br/>STATUTORY = 55 MPH<br/>ADVISORY = 50 MPH<br/>* TTST 2% DUAL 4%<br/>SUB REGIONAL TIER</p> | <p><b>PROJECT LENGTH</b></p> <p>LENGTH OF ROADWAY TIP PROJECT BD-5102U = 0.101 MI.<br/>LENGTH OF STRUCTURE TIP PROJECT BD-5102U = 0.036 MI.<br/>TOTAL LENGTH OF TIP PROJECT BD-5102U = 0.137 MI.</p> | <p>Prepared In the Office of:</p> <p><b>HNTB</b> HNTB NORTH CAROLINA, P.C.<br/>343 E. Six Forks Road, Suite 200<br/>Raleigh, North Carolina 27609<br/>NC License No: C-1554</p> <p>2012 STANDARD SPECIFICATIONS</p> <p><b>RIGHT OF WAY DATE:</b><br/>JULY 22, 2013</p> <p><b>LETTING DATE:</b><br/>MARCH 12, 2014</p> <p><b>ENRICO A. ROQUE, P.E.</b><br/>PROJECT ENGINEER</p> <p><b>ANTHONY THOMPSON, P.E.</b><br/>PROJECT DESIGNER</p> <p><b>MARIA ROGERSON, P.E.</b><br/>NCDOT CONTACT</p> | <p><b>HYDRAULICS ENGINEER</b></p> <p><i>James A. Byrd</i><br/>SIGNATURE: 12/9/13</p> <p><b>ROADWAY DESIGN ENGINEER</b></p> <p><i>Enrico A. Roque</i><br/>SIGNATURE: 12/9/13</p> | <p><b>DIVISION OF HIGHWAYS<br/>STATE OF NORTH CAROLINA</b></p> <p>STATE HIGHWAY DESIGN ENGINEER</p> |
|--|---|--|---|---|---|

12/9/2013 9:38:53 AM ...\\Proj\BD5102U\rdy\_tsh.dgn

**INDEX OF SHEETS**

| SHEET NUMBER     | SHEET  |
|------------------|--|
| 1                | TITLE SHEET  |
| 1-A              | INDEX OF SHEETS, GENERAL NOTES, LIST OF STANDARDS<br>CENTERLINE COORDINATE LIST, AND DATUM DESCRIPTION |
| 1-B              | SYMBOLOLOGY SHEET  |
| 2                | TYPICAL SECTION SHEET  |
| 3                | EARTHWORK, PAVEMENT REMOVAL, GUARDRAIL SUMMARY,<br>ROW SUMMARY, & DRAINAGE SUMMARY SHEET               |
| 4                | PLAN & PROFILE SHEET   |
| TMP-1 THRU TMP-2 | TRAFFIC CONTROL PLANS  |
| EC-1 THRU EC-6   | EROSION CONTROL PLANS  |
| RF-1             | REFORESTATION PLAN   |
| P-1              | PERMIT DRAWING   |
| X-1 THRU X-7     | -L- CROSS SECTION SHEETS   |
| S-1 THRU S-17    | BRIDGE PLANS - PITT 069  |
| S-18 THRU S-35   | BRIDGE PLANS - GREENE 034  |

**GENERAL NOTES:**

2012 SPECIFICATIONS  
 EFFECTIVE: 01-17-2012  
 REVISED: 07-30-2012

EFF. 01-17-2012  
 REV. 10-30-2012

**GRADE LINE:  
 GRADING AND SURFACING:**

THE GRADE LINES SHOWN DENOTE THE FINISHED ELEVATION OF THE PROPOSED SURFACING AT GRADE POINTS SHOWN ON THE TYPICAL SECTIONS. GRADE LINES MAY BE ADJUSTED AT THEIR BEGINNING AND ENDING AND AT STRUCTURES AS DIRECTED BY THE ENGINEER IN ORDER TO SECURE A PROPER TIE-IN.

**CLEARING:**

CLEARING ON THIS PROJECT SHALL BE PERFORMED TO THE LIMITS ESTABLISHED BY METHOD II.

**SUPERELEVATION:**

ALL CURVES ON THIS PROJECT SHALL BE SUPERELEVATED IN ACCORDANCE WITH STD. NO. 225.04 SUPERELEVATION IS TO BE REVOLVED ABOUT THE GRADE POINTS SHOWN ON THE TYPICAL SECTIONS.

**SHOULDER CONSTRUCTION:**

ASPHALT, EARTH, AND CONCRETE SHOULDER CONSTRUCTION ON THE HIGH SIDE OF SUPERELEVATED CURVES SHALL BE IN ACCORDANCE WITH

**GUARDRAIL:**

THE GUARDRAIL LOCATIONS SHOWN ON THE PLANS MAY BE ADJUSTED DURING CONSTRUCTION AS DIRECTED BY THE ENGINEER. THE CONTRACTOR SHOULD CONSULT WITH THE ENGINEER PRIOR TO ORDERING GUARDRAIL MATERIAL.

**SUBSURFACE PLANS:**

NO SUBSURFACE PLANS ARE AVAILABLE ON THIS PROJECT. THE CONTRACTOR SHOULD MAKE HIS OWN INVESTIGATION AS TO THE SUBSURFACE CONDITIONS.

**UTILITIES:**

NO UTILITY RELOCATIONS ARE REQUIRED FOR THIS PROJECT.

**RIGHT-OF-WAY MARKERS:**

ALL RIGHT-OF-WAY MARKERS ON THIS PROJECT SHALL BE PLACED BY OTHERS.

2012 ROADWAY ENGLISH STANDARD DRAWINGS

The following Roadway Standards as appear in "Roadway Standard Drawings" Highway Design Branch - N. C. Department of Transportation - Raleigh, N. C., Dated January, 2012 are applicable to this project and by reference hereby are considered a part of these plans:

| STD.NO.                                    | TITLE   |
|--|---|
| DIVISION 2 - EARTHWORK                     |   |
| 200.02                                     | Method of Clearing - Method II  |
| 225.02                                     | Guide for Grading Subgrade - Secondary and Local                              |
| 225.04                                     | Method of Obtaining Superelevation - Two Lane Pavement                        |
| DIVISION 3 - PIPE CULVERTS                 |   |
| 300.01                                     | Method of Pipe Installation   |
| DIVISION 4 - MAJOR STRUCTURES              |   |
| 422.10                                     | Reinforced Bridge Approach Fills  |
| DIVISION 5 - SUBGRADE, BASES AND SHOULDERS |   |
| 560.01                                     | Method of Shoulder Construction - High Side of Superelevated Curve - Method I |
| DIVISION 8 - INCIDENTALS                   |   |
| 840.29                                     | Frames and Narrow Slot Flat Grates  |
| 840.35                                     | Traffic Bearing Grated Drop Inlet - for Cast Iron Double Frame and Grates     |
| 846.01                                     | Concrete Curb, Gutter and Curb & Gutter                                       |
| 848.02                                     | Driveway Turnout - Radius Type  |
| 862.01                                     | Guardrail Placement   |
| 862.02                                     | Guardrail Installation  |
| 876.01                                     | Rip Rap in Channels   |
| 876.02                                     | Guide for Rip Rap at Pipe Outlets   |

**CENTERLINE COORDINATE LIST**

| POINT | STATION  | NORTHING    | EASTING      |
|-------|----------|-------------|--------------|
| POT   | 10+00.00 | 651385.4430 | 2432874.8770 |
| BEG   | 12+25.00 | 651601.8710 | 2432813.3634 |
| PC    | 12+26.95 | 651603.7459 | 2432812.8305 |
| PCC   | 14+17.01 | 651789.9297 | 2432775.6583 |
| PCC   | 18+03.48 | 652175.6390 | 2432756.6801 |
| PT    | 18+67.75 | 652239.8478 | 2432759.1829 |
| END   | 19+50.00 | 652321.9591 | 2432764.0365 |
| POT   | 19+84.83 | 652356.7330 | 2432766.0920 |

**DATUM DESCRIPTION**

THE LOCALIZED COORDINATE SYSTEM DEVELOPED FOR THIS PROJECT IS BASED ON THE STATE PLANE COORDINATES ESTABLISHED BY NCDOT FOR MONUMENT "GPS-1" WITH NAD 83/2011 STATE PLANE GRID COORDINATES OF NORTHING: 651492.247(ft) EASTING: 2432829.997(ft) ELEVATION: 41.706(ft) THE AVERAGE COMBINED GRID FACTOR USED ON THIS PROJECT (GROUND TO GRID) IS: 0.99988806 THE N.C. LAMBERT GRID BEARING AND LOCALIZED HORIZONTAL GROUND DISTANCE FROM "GPS-1" TO -L- STATION 10+00.00 IS S 22° 47' 33.3" E 115.8504' ALL LINEAR DIMENSIONS ARE LOCALIZED HORIZONTAL DISTANCES VERTICAL DATUM USED IS NAVD 88

REVISIONS

DATE TIME BY

Note: Not to Scale

\*S.U.E. = Subsurface Utility Engineering

STATE OF NORTH CAROLINA  
DIVISION OF HIGHWAYS

# CONVENTIONAL PLAN SHEET SYMBOLS

### BOUNDARIES AND PROPERTY:

|                                     |           |
|-------------------------------------|-----------|
| State Line                          | _____     |
| County Line                         | _____     |
| Township Line                       | _____     |
| City Line                           | _____     |
| Reservation Line                    | _____     |
| Property Line                       | _____     |
| Existing Iron Pin                   | ○ EP      |
| Property Corner                     | _____ X   |
| Property Monument                   | □ EDM     |
| Parcel/Sequence Number              | ②③        |
| Existing Fence Line                 | —X—X—X—   |
| Proposed Woven Wire Fence           | ○         |
| Proposed Chain Link Fence           | □         |
| Proposed Barbed Wire Fence          | ◇         |
| Existing Wetland Boundary           | ---WLB--- |
| Proposed Wetland Boundary           | ---WLB--- |
| Existing Endangered Animal Boundary | ---EAB--- |
| Existing Endangered Plant Boundary  | ---EPB--- |

### BUILDINGS AND OTHER CULTURE:

|                               |       |
|-------------------------------|-------|
| Gas Pump Vent or U/G Tank Cap | ○     |
| Sign                          | ○ S   |
| Well                          | ○ W   |
| Small Mine                    | ⋈     |
| Foundation                    | □     |
| Area Outline                  | □     |
| Cemetery                      | □ †   |
| Building                      | □     |
| School                        | □     |
| Church                        | □     |
| Dam                           | _____ |

### HYDROLOGY:

|                                    |            |
|------------------------------------|------------|
| Stream or Body of Water            | _____      |
| Hydro, Pool or Reservoir           | □          |
| Jurisdictional Stream              | ---JS---   |
| Buffer Zone 1                      | ---BZ 1--- |
| Buffer Zone 2                      | ---BZ 2--- |
| Flow Arrow                         | ←          |
| Disappearing Stream                | _____      |
| Spring                             | ○          |
| Wetland                            | _____      |
| Proposed Lateral, Tail, Head Ditch | _____      |
| False Sump                         | _____      |

### RAILROADS:

|                    |               |
|--------------------|---------------|
| Standard Gauge     | _____         |
| RR Signal Milepost | ○ MILEPOST 35 |
| Switch             | □ SWITCH      |
| RR Abandoned       | _____         |
| RR Dismantled      | _____         |

### RIGHT OF WAY:

|  |         |
|--|---------|
| Baseline Control Point                                     | ◆       |
| Existing Right of Way Marker                               | △       |
| Existing Right of Way Line                                 | _____   |
| Proposed Right of Way Line                                 | ○ R/W   |
| Proposed Right of Way Line with Iron Pin and Cap Marker    | ○ R/W ▲ |
| Proposed Right of Way Line with Concrete or Granite Marker | ○ R/W ▲ |
| Existing Control of Access                                 | ○ CA    |
| Proposed Control of Access                                 | ○ CA    |
| Existing Easement Line                                     | —E—     |
| Proposed Temporary Construction Easement                   | —E—     |
| Proposed Temporary Drainage Easement                       | —TDE—   |
| Proposed Permanent Drainage Easement                       | —PDE—   |
| Proposed Permanent Utility Easement                        | —PUE—   |

### ROADS AND RELATED FEATURES:

|                                      |         |
|--------------------------------------|---------|
| Existing Edge of Pavement            | _____   |
| Existing Curb                        | _____   |
| Proposed Slope Stakes Cut            | ---C--- |
| Proposed Slope Stakes Fill           | ---F--- |
| Proposed Wheel Chair Ramp            | □ WCR   |
| Proposed Wheel Chair Ramp Curb Cut   | □ WCC   |
| Curb Cut for Future Wheel Chair Ramp | □ CCFR  |
| Existing Metal Guardrail             | _____   |
| Proposed Guardrail                   | _____   |
| Existing Cable Guiderail             | _____   |
| Proposed Cable Guiderail             | _____   |
| Equality Symbol                      | ⊕       |
| Pavement Removal                     | □       |

### VEGETATION:

|              |            |
|--------------|------------|
| Single Tree  | ○          |
| Single Shrub | ○          |
| Hedge        | _____      |
| Woods Line   | _____      |
| Orchard      | □          |
| Vineyard     | □ Vineyard |

### EXISTING STRUCTURES:

|  |               |
|--|---------------|
| MAJOR:                                   |               |
| Bridge, Tunnel or Box Culvert            | _____ CONC    |
| Bridge Wing Wall, Head Wall and End Wall | _____ CONC WW |
| MINOR:                                   |               |
| Head and End Wall                        | _____ CONC HW |
| Pipe Culvert                             | _____         |
| Footbridge                               | _____         |
| Drainage Box: Catch Basin, DI or JB      | □ CB          |
| Paved Ditch Gutter                       | _____         |
| Storm Sewer Manhole                      | ○ S           |
| Storm Sewer                              | —S—           |

### UTILITIES:

|                                     |         |
|-------------------------------------|---------|
| POWER:                              |         |
| Existing Power Pole                 | ●       |
| Proposed Power Pole                 | ○       |
| Existing Joint Use Pole             | ●       |
| Proposed Joint Use Pole             | ○       |
| Power Manhole                       | ⊕       |
| Power Line Tower                    | □       |
| Power Transformer                   | □       |
| U/G Power Cable Hand Hole           | □ HH    |
| H-Frame Pole                        | ●       |
| Recorded U/G Power Line             | —P—     |
| Designated U/G Power Line (S.U.E.*) | ---P--- |

### TELEPHONE:

|   |            |
|---|------------|
| Existing Telephone Pole                     | ●          |
| Proposed Telephone Pole                     | ○          |
| Telephone Manhole                           | ⊕          |
| Telephone Booth                             | □          |
| Telephone Pedestal                          | □          |
| Telephone Cell Tower                        | ⋈          |
| U/G Telephone Cable Hand Hole               | □ HH       |
| Recorded U/G Telephone Cable                | —T—        |
| Designated U/G Telephone Cable (S.U.E.*)    | ---T---    |
| Recorded U/G Telephone Conduit              | ---TC---   |
| Designated U/G Telephone Conduit (S.U.E.*)  | ---TC---   |
| Recorded U/G Fiber Optics Cable             | ---T FO--- |
| Designated U/G Fiber Optics Cable (S.U.E.*) | ---T FO--- |

### WATER:

|                                     |       |           |
|-------------------------------------|-------|-----------|
| Water Manhole                       | _____ | ⊕         |
| Water Meter                         | _____ | ○         |
| Water Valve                         | _____ | ⊗         |
| Water Hydrant                       | _____ | ⊕         |
| Recorded U/G Water Line             | _____ | —W—       |
| Designated U/G Water Line (S.U.E.*) | _____ | ---W---   |
| Above Ground Water Line             | _____ | A/G Water |

### TV:

|  |       |             |
|--|-------|-------------|
| TV Satellite Dish                          | _____ | ⋈           |
| TV Pedestal                                | _____ | □           |
| TV Tower                                   | _____ | ⊗           |
| U/G TV Cable Hand Hole                     | _____ | □ HH        |
| Recorded U/G TV Cable                      | _____ | —TV—        |
| Designated U/G TV Cable (S.U.E.*)          | _____ | ---TV---    |
| Recorded U/G Fiber Optic Cable             | _____ | ---TV FO--- |
| Designated U/G Fiber Optic Cable (S.U.E.*) | _____ | ---TV FO--- |

### GAS:

|                                   |       |         |
|-----------------------------------|-------|---------|
| Gas Valve                         | _____ | ◇       |
| Gas Meter                         | _____ | ⊕       |
| Recorded U/G Gas Line             | _____ | —G—     |
| Designated U/G Gas Line (S.U.E.*) | _____ | ---G--- |
| Above Ground Gas Line             | _____ | A/G Gas |

### SANITARY SEWER:


|  |       |                    |
|--|-------|--------------------|
| Sanitary Sewer Manhole                   | _____ | ⊕                  |
| Sanitary Sewer Cleanout                  | _____ | ⊕                  |
| U/G Sanitary Sewer Line                  | _____ | —SS—               |
| Above Ground Sanitary Sewer              | _____ | A/G Sanitary Sewer |
| Recorded SS Forced Main Line             | _____ | ---FSS---          |
| Designated SS Forced Main Line (S.U.E.*) | _____ | ---FSS---          |

### MISCELLANEOUS:

|  |       |            |
|--|-------|------------|
| Utility Pole                           | _____ | ●          |
| Utility Pole with Base                 | _____ | □          |
| Utility Located Object                 | _____ | ○          |
| Utility Traffic Signal Box             | _____ | □          |
| Utility Unknown U/G Line               | _____ | ---TUTL--- |
| U/G Tank; Water, Gas, Oil              | _____ | □          |
| A/G Tank; Water, Gas, Oil              | _____ | □          |
| U/G Test Hole (S.U.E.*)                | _____ | ⊕          |
| Abandoned According to Utility Records | _____ | AATUR      |
| End of Information                     | _____ | E.O.I.     |


| PAVEMENT SCHEDULE |  |
|-------------------|--|
| C1                | PROP. APPROX. 3.0" ASPHALT CONCRETE SURFACE COURSE, TYPE SF9.5A, AT AN AVERAGE RATE OF 165 LBS. PER SQ. YARD IN EACH OF TWO LAYERS.  |
| D                 | PROP. APPROX. 2.5" ASPHALT CONCRETE INTERMEDIATE COURSE, TYPE I19.0B, AT AN AVERAGE RATE OF 285 LBS. PER SQ. YD.   |
| D1                | PROP. VAR. DEPTH ASPHALT CONCRETE INTERMEDIATE COURSE, TYPE I19.0B, AT AN AVERAGE RATE OF 114 LBS. PER SQ. YD. PER 1" DEPTH, TO BE PLACED IN LAYERS NOT LESS THAN 2 1/2" IN DEPTH OR GREATER THAN 4" IN DEPTH. |
| E                 | PROP. APPROX. 4" ASPHALT CONCRETE BASE COURSE, TYPE B25.0B, AT AN AVERAGE RATE OF 456 LBS. PER SQ. YARD.   |
| E1                | PROP. VARIABLE DEPTH ASPHALT CONCRETE BASE COURSE, TYPE B25.0B AT AN AVERAGE RATE OF 114 LBS. PER SQ. YARD PER INCH DEPTH, TO BE PLACED IN LAYERS NOT LESS THAN 3" IN DEPTH OR GREATER THAN 5.5" IN DEPTH.     |
| T                 | EARTH MATERIAL   |
| U                 | EXISTING PAVEMENT  |
| W                 | WEDGING (SEE DETAIL)   |

ALL PAVEMENT EDGE SLOPES ARE 1:1 UNLESS SHOWN OTHERWISE

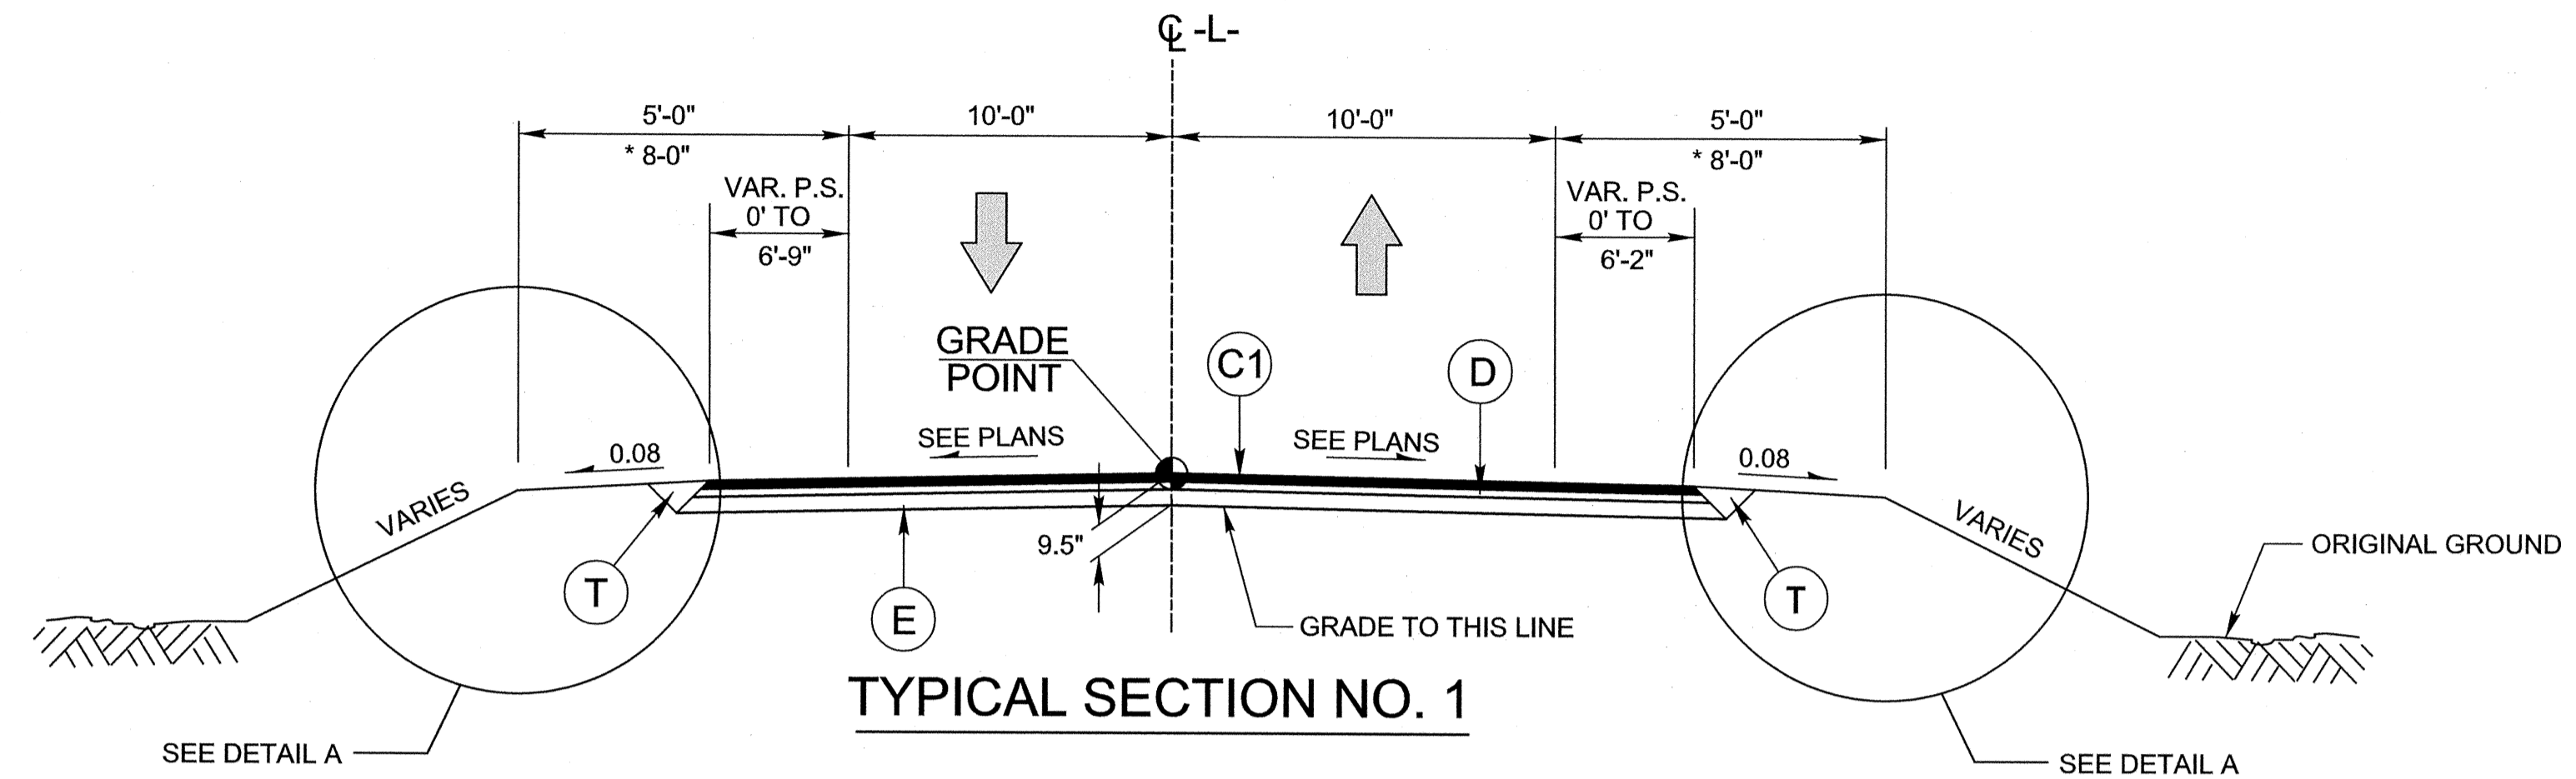


USE TYPICAL SECTION NO. 1 FROM:

- L- STA. 12+25.00 TO -L- STA. 14+29.75 (BEGIN BRIDGE)
- L- STA. 15+32.25(END BRIDGE) TO -L- STA. 16+00.00 (END PROJECT 17BP.2.R.51)
- L- STA. 16+00.00 (BEGIN PROJECT BD-5102U) TO -L- STA. 16+76.81 (BEGIN BRIDGE)
- L- STA. 17+64.19 (END BRIDGE) TO -L- STA. 19+50.00

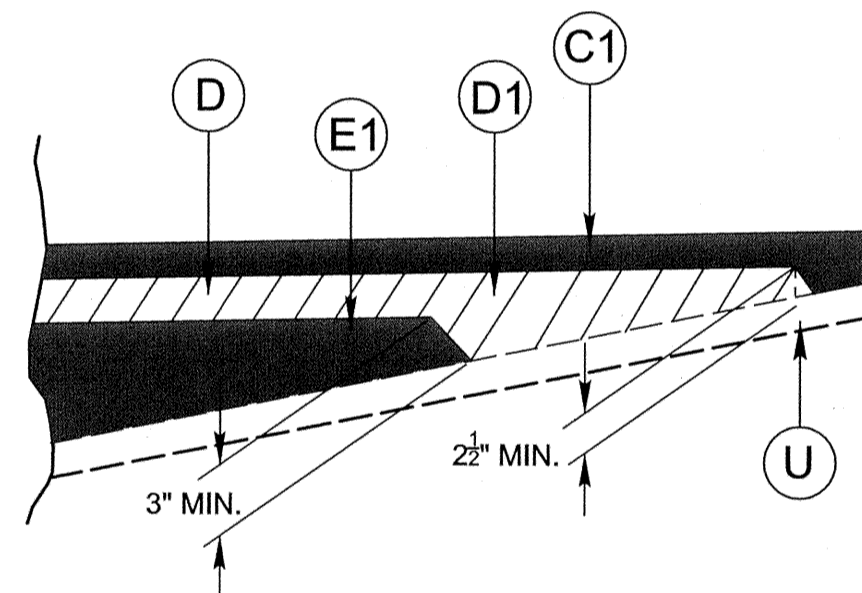


**DETAIL SHOWING METHOD OF WEDGING**  
SEE TYPICAL SECTIONS

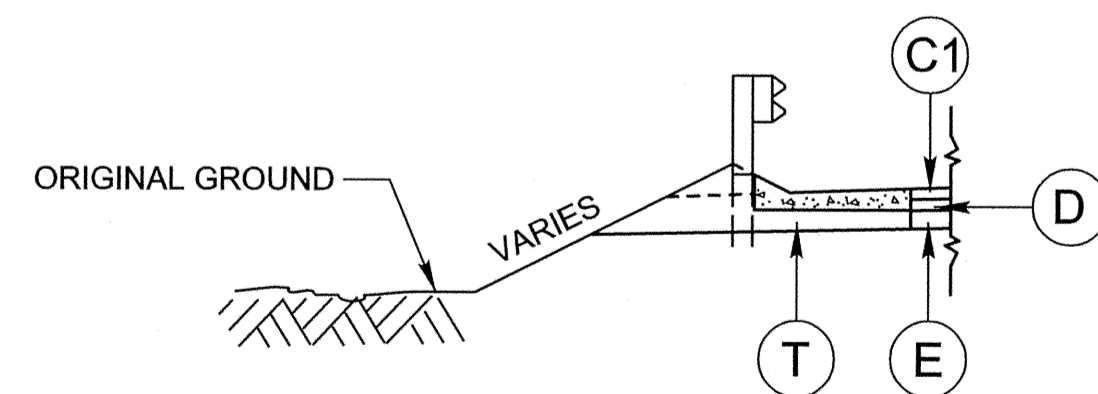

**DETAIL A**

SHOULDER BERM GUTTER LOCATIONS

- L- STA. 13+74.0 TO -L- STA. 14+18.4 RT
- L- STA. 17+75.5 TO -L- STA. 18+13.0 RT

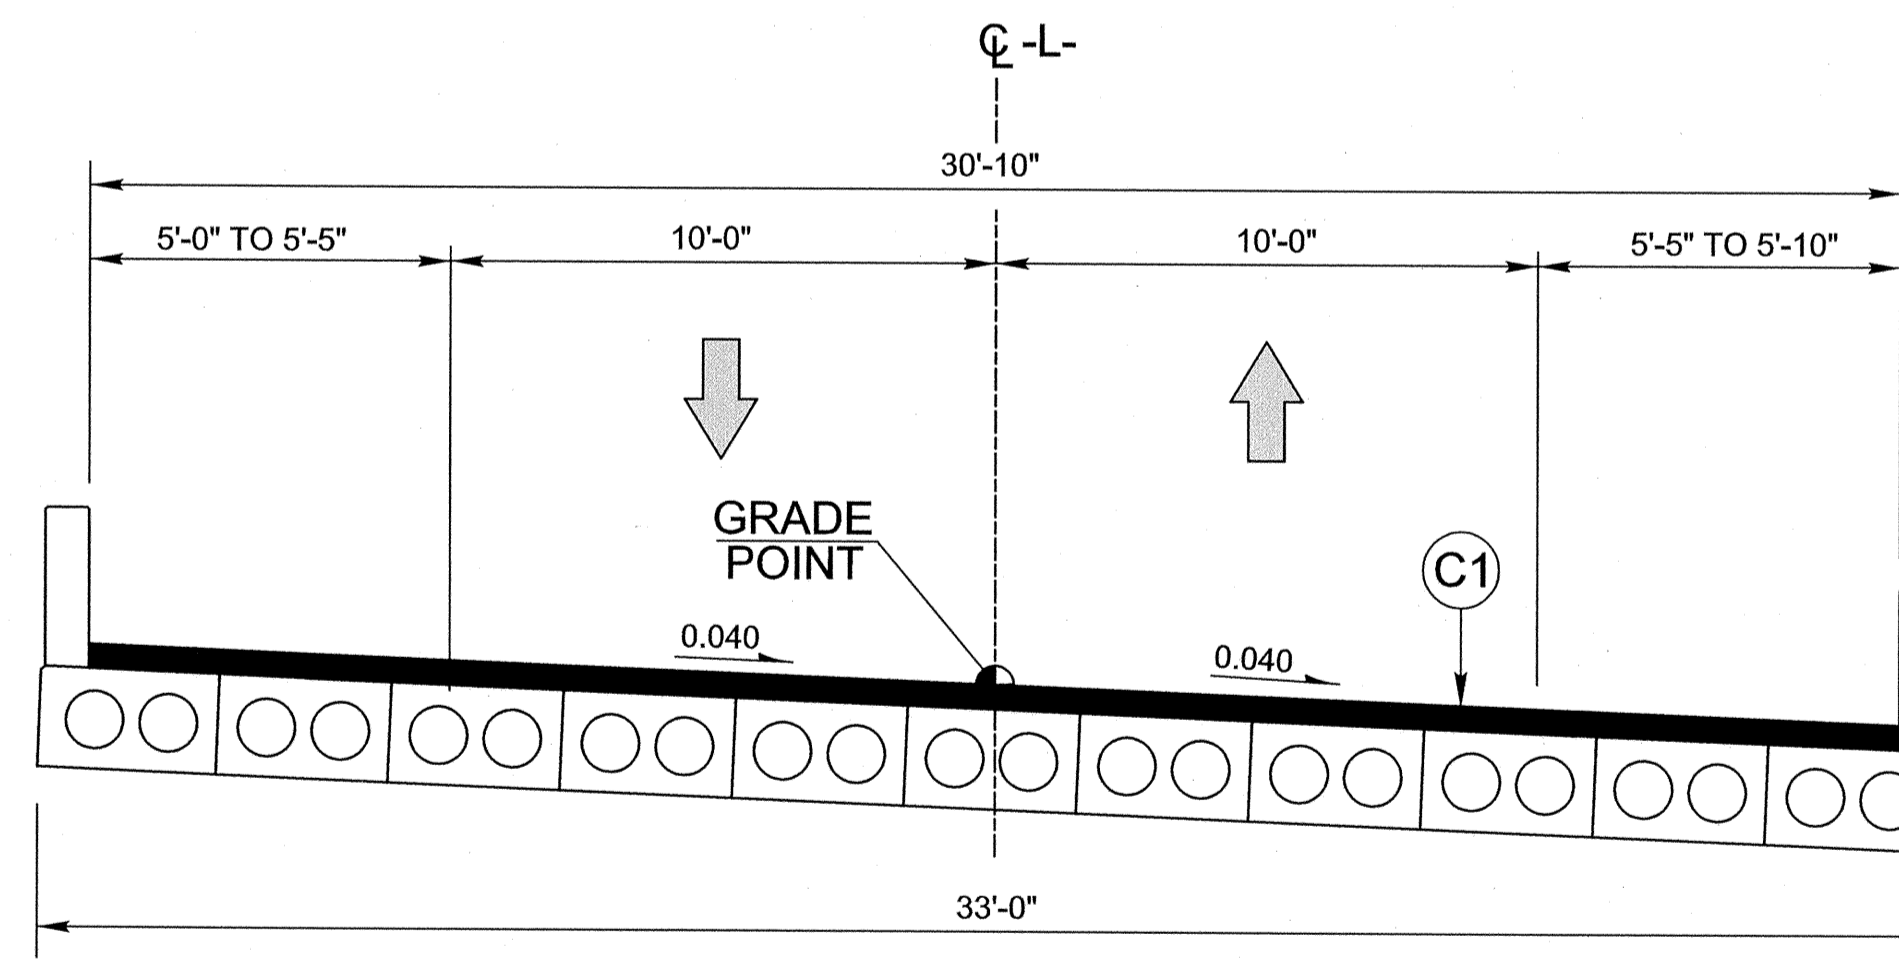

**TYPICAL SECTION NO. 2**  
CORED SLAB BRIDGE OVERLAY

USE TYPICAL SECTION NO. 2 FROM:

- L- STA. 14+29.75 TO -L- STA. 15+32.25
- L- STA. 16+76.81 TO -L- STA. 17+64.19

NOTES: \* SHOULDER WIDTH INCREASED 3' WITH THE USE OF GUARDRAIL

REVISIONS

**ROW AREA DATA SUMMARY**

Table with columns: PARCEL NO., PROPERTY OWNERS NAMES, TOTAL ACREAGE, AREA TAKEN (SQFT), AREA REMAINING RT., AREA REMAINING LT., CONST. EASE. (ACRES), PERM. DRAIN. EASE., TEMP. DRAIN. EASE.

PROJECT REFERENCE NO. BD-5102U SHEET NO. 3 R/W SHEET NO. ROADWAY DESIGN ENGINEER HYDRAULICS ENGINEER

**PAVEMENT REMOVAL SUMMARY IN SQUARE YARDS**

Table with columns: LOCATION, REMOVAL OF ASPHALT PAVEMENT, BREAKING OF ASPHALT PAVEMENT

**DRAINAGE SUMMARY**

Large table for drainage summary with columns: STATION, SIZE, THICKNESS OR GAUGE, LOCATION, STRUCTURE NO., TOP ELEVATION, INVERT ELEVATION, SLOPE CRITICAL, CLASS IV R.C. PIPE, QUANTITIES FOR DRAINAGE STRUCTURES, SIDE DRAIN PIPE, ABBREVIATIONS, REMARKS

**SUMMARY OF EARTHWORK IN CUBIC YARDS**

Table with columns: STATION, UNCLASSIFIED EXCAVATION, EMBANK. +% BORROW, WASTE


**GUARDRAIL SUMMARY**

Table with columns: SURVEY LINE, BEG. STA., END STA., LOCATION, LENGTH, WARRANT POINT, FLARE LENGTH, W, ANCHORS, IMPACT ATTENUATOR, SINGLE FACED GUARDRAIL, REMOVE EXISTING GUARDRAIL, REMOVE AND STOCKPILE EXISTING GUARDRAIL, REMARKS

REVISIONS



11/26/2013 11:31:52 AM BD5102U.Fcy\_sum.dgn

**PLAN**

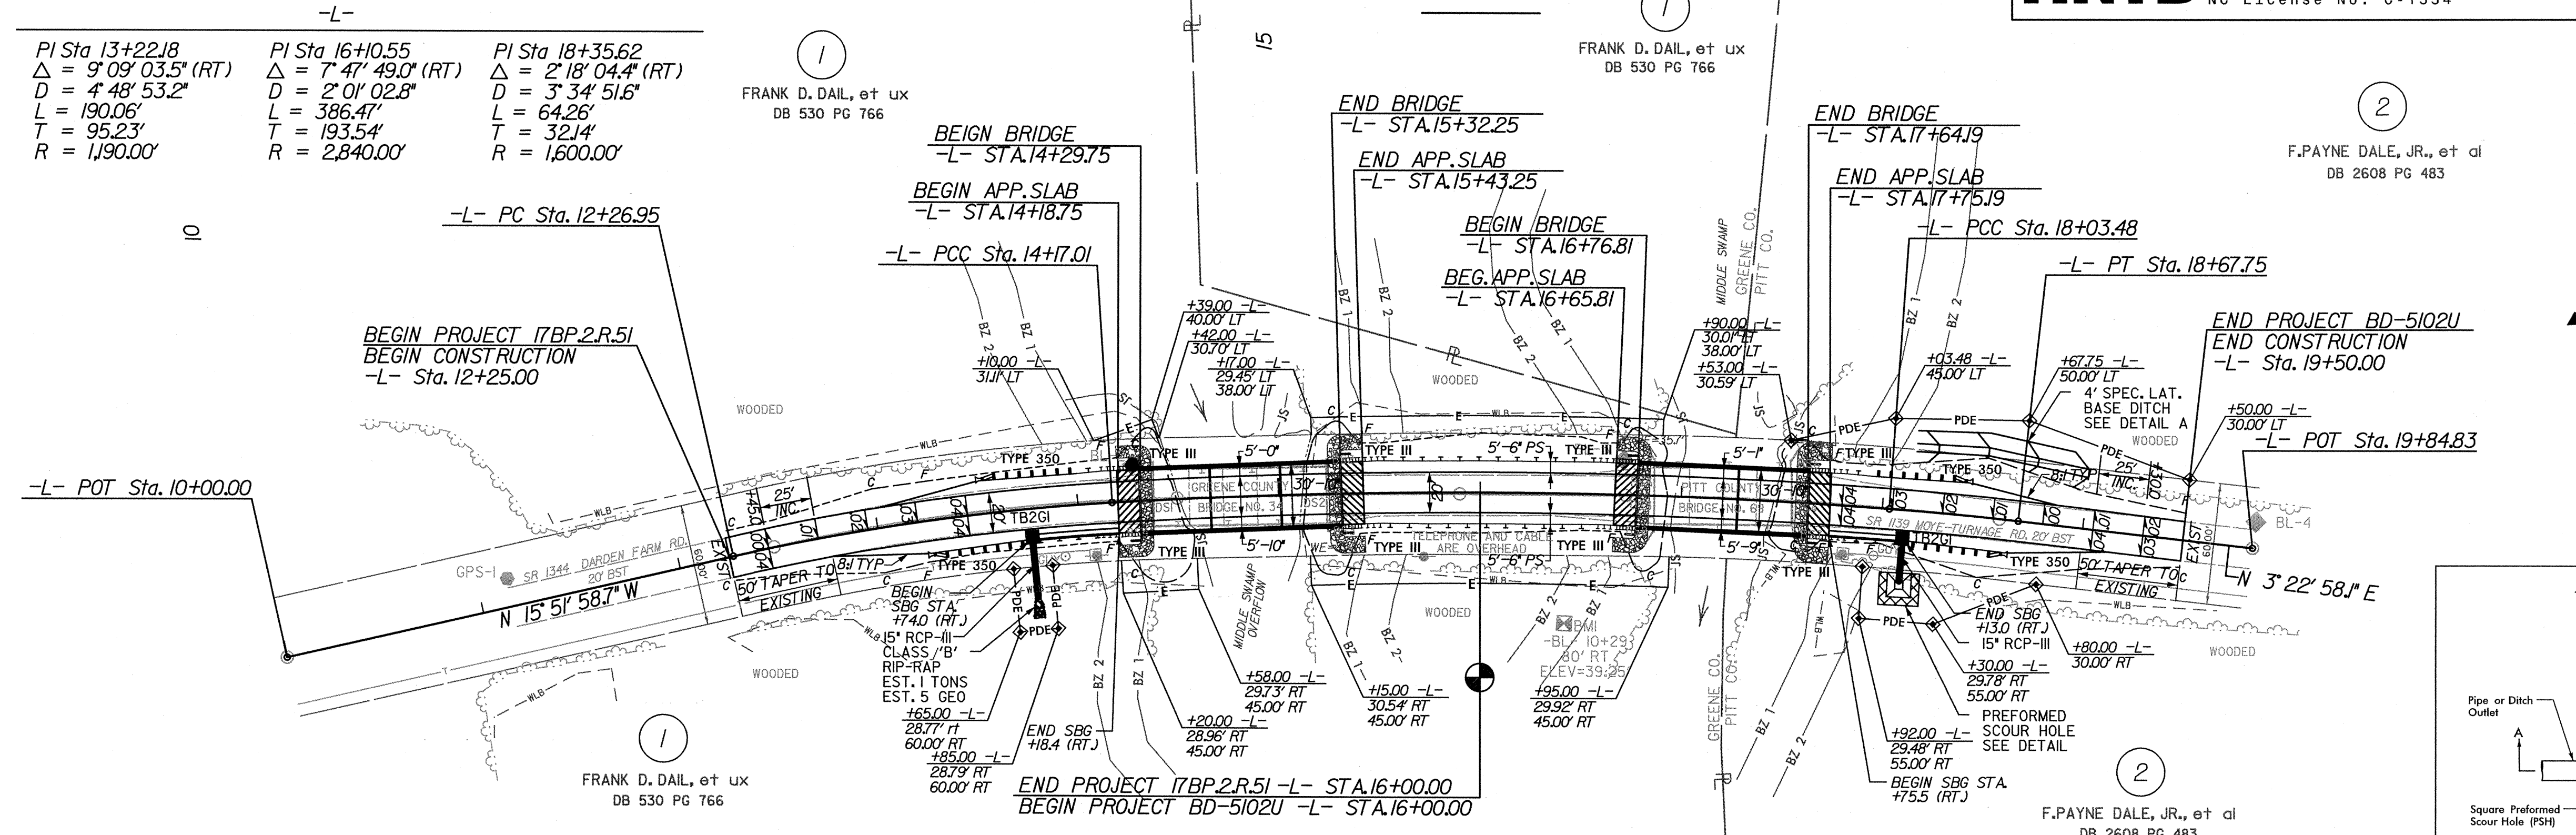


| Point | North      | East        | Elevation | Description        |
|-------|------------|-------------|-----------|--------------------|
| BS1   | 651809.892 | 2432757.159 | 40.33     | BRIDGE SEAT 1      |
| BS2   | 651894.668 | 2432750.888 | 40.31     | BRIDGE SEAT 2      |
| BS3   | 651896.944 | 2432780.750 | 40.36     | BRIDGE SEAT 3      |
| BS4   | 651812.192 | 2432786.943 | 40.33     | BRIDGE SEAT 4      |
| BS5   | 652058.660 | 2432741.890 | 40.93     | BRIDGE SEAT 5      |
| BS6   | 652125.030 | 2432738.747 | 40.95     | BRIDGE SEAT 6      |
| BS7   | 652127.463 | 2432768.554 | 40.92     | BRIDGE SEAT 7      |
| BS8   | 652060.052 | 2432771.732 | 40.94     | BRIDGE SEAT 8      |
| DS1   | 652125.810 | 2432755.646 | 42.51     | CL SHOT @ DECK END |
| DS2   | 652059.853 | 2432756.885 | 42.50     | CL SHOT @ DECK END |
| DS3   | 651895.170 | 2432765.846 | 41.87     | CL SHOT @ DECK END |
| DS4   | 651811.828 | 2432772.170 | 41.89     | CL SHOT @ DECK END |

| Point | North      | East        | Elevation | Description                          |
|-------|------------|-------------|-----------|--------------------------------------|
| 1     | 651492.247 | 2432829.997 | 41.71     | GPS-1                                |
| 2     | 651798.937 | 2432756.446 | 41.27     | BL-2                                 |
| 3     | 652042.715 | 2432740.220 | 41.62     | BL-3                                 |
| 4     | 652357.740 | 2432752.950 | 39.90     | BL-4                                 |
| BM1   | 652017.446 | 2432822.390 | 39.25     | RR SPIKE SET IN BASE OF 24" OAK TREE |

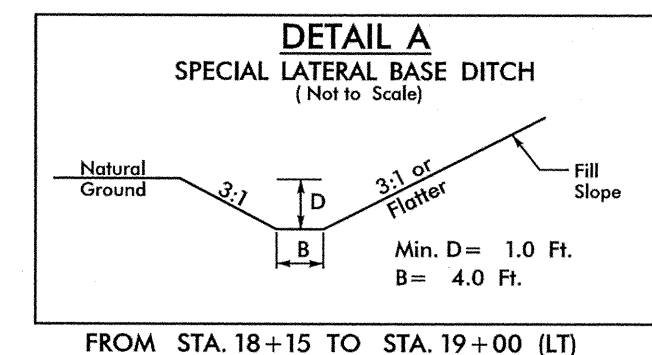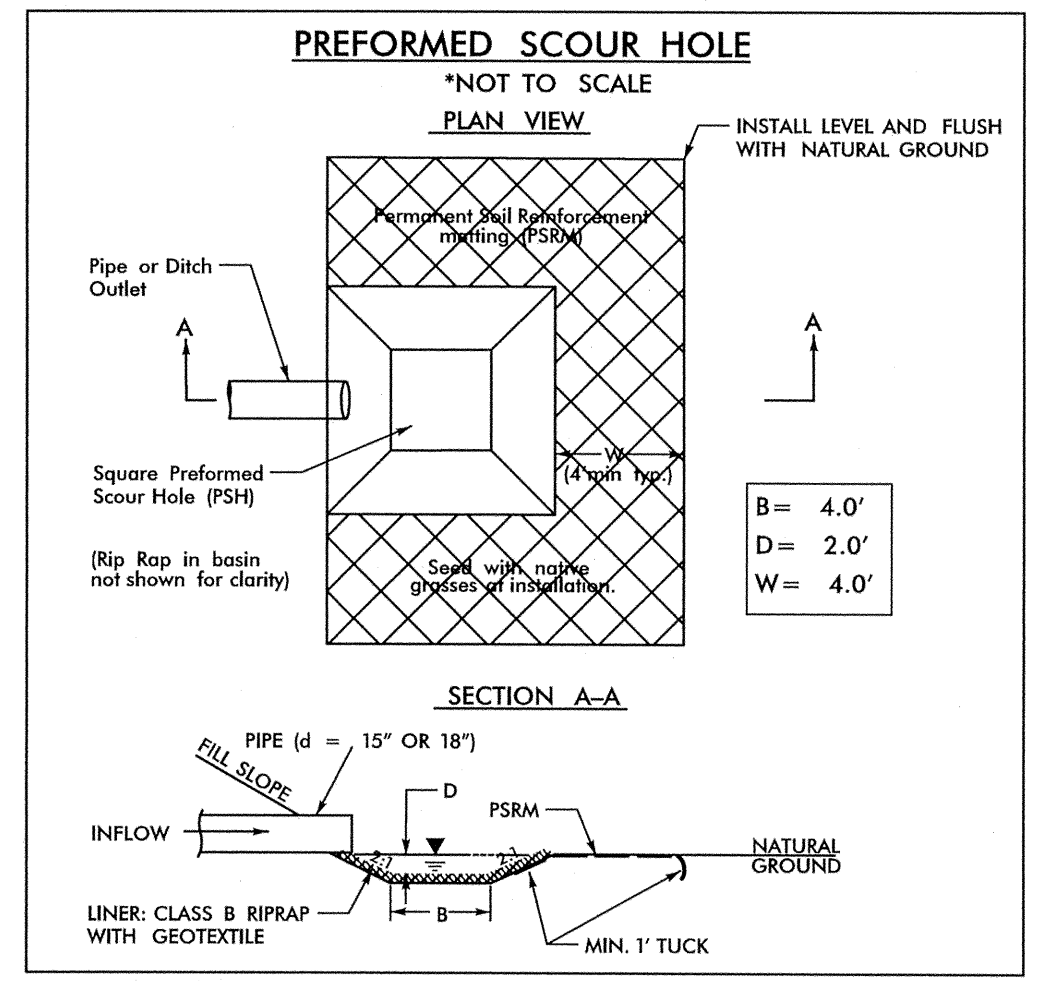

**PROFILE**

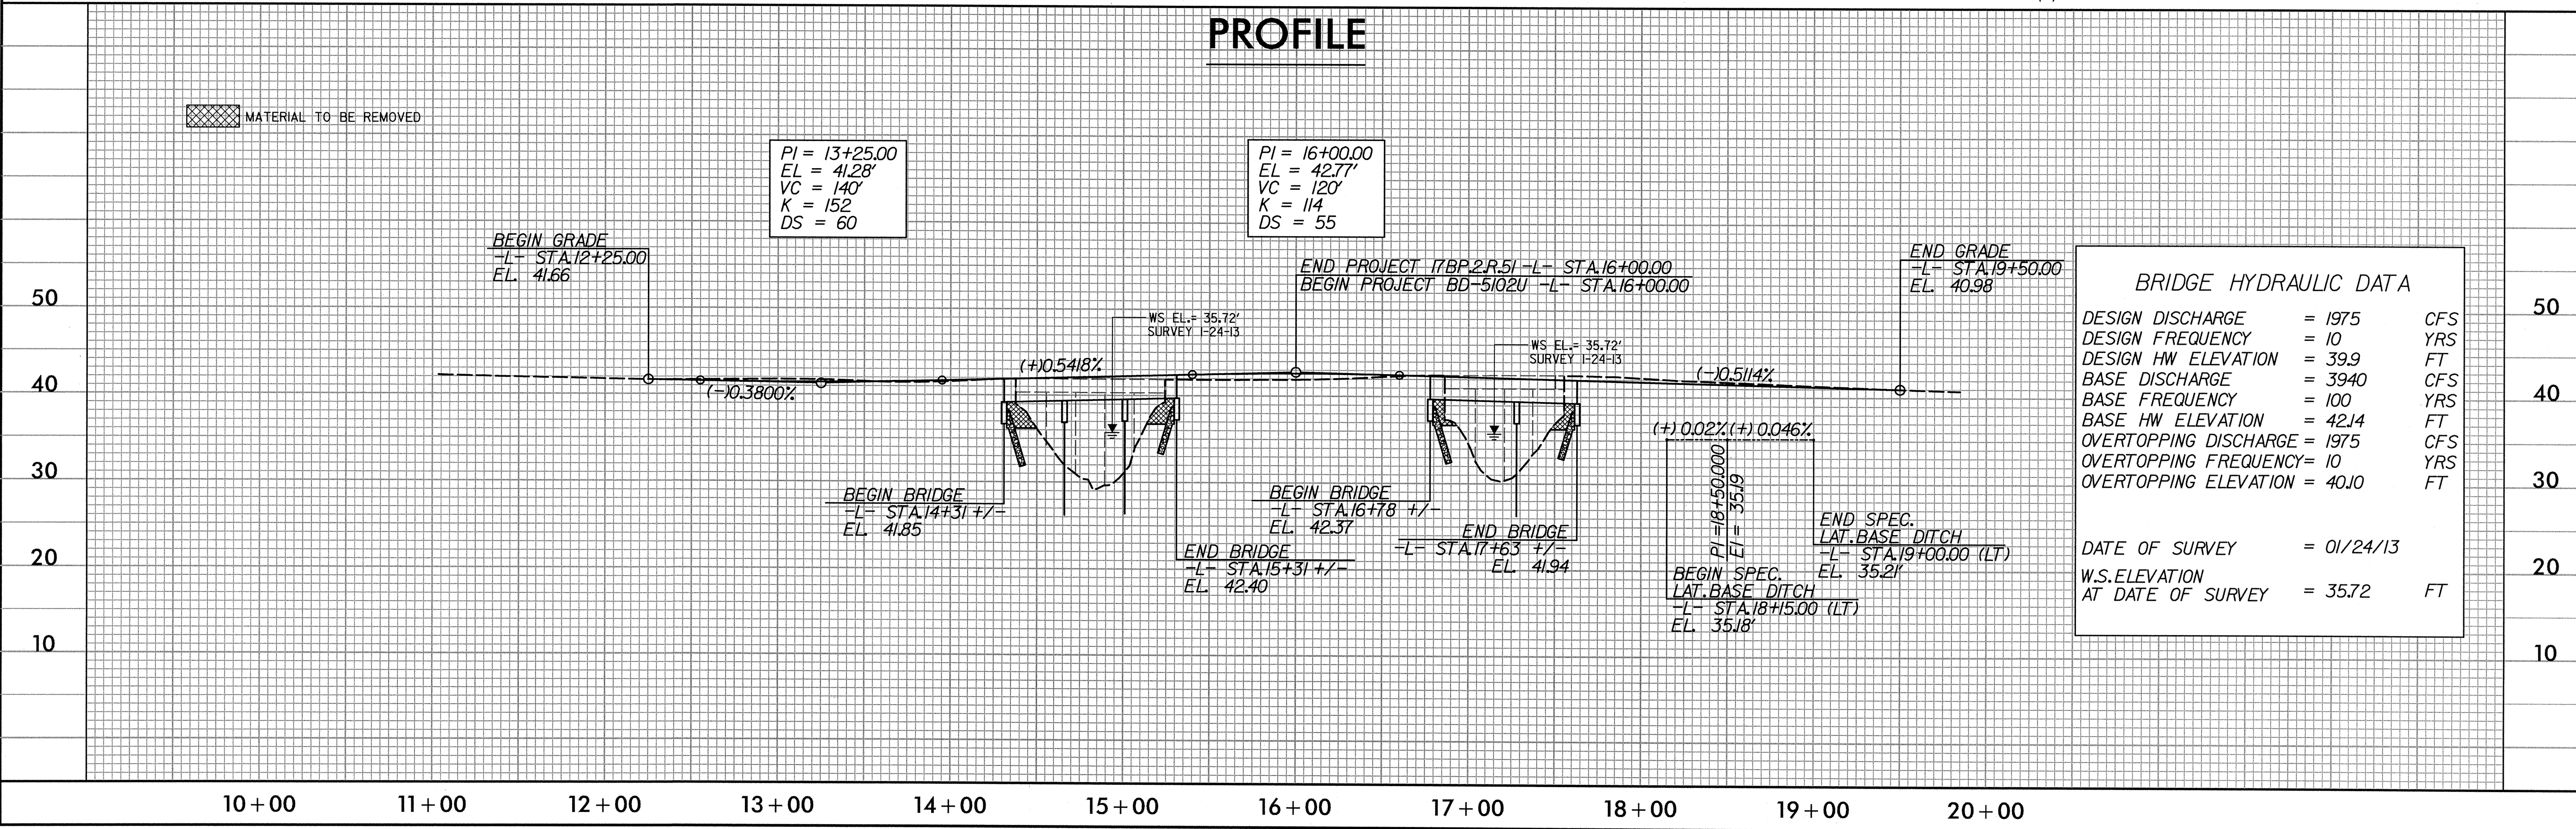

| BRIDGE HYDRAULIC DATA            |            |
|----------------------------------|------------|
| DESIGN DISCHARGE                 | = 1975 CFS |
| DESIGN FREQUENCY                 | = 10 YRS   |
| DESIGN HW ELEVATION              | = 39.9 FT  |
| BASE DISCHARGE                   | = 3940 CFS |
| BASE FREQUENCY                   | = 100 YRS  |
| BASE HW ELEVATION                | = 42.14 FT |
| OVERTOPPING DISCHARGE            | = 1975 CFS |
| OVERTOPPING FREQUENCY            | = 10 YRS   |
| OVERTOPPING ELEVATION            | = 40.10 FT |
| DATE OF SURVEY                   | = 01/24/13 |
| W.S. ELEVATION AT DATE OF SURVEY | = 35.72 FT |


REVISIONS

11/26/2013 11:31:45 AM ... \Pco\A\BD5102U\rdy\_dsh\_s04.dgn

STATE OF NORTH CAROLINA  
DIVISION OF HIGHWAYS

**TRANSPORTATION MANAGEMENT PLAN**

**PITT COUNTY**

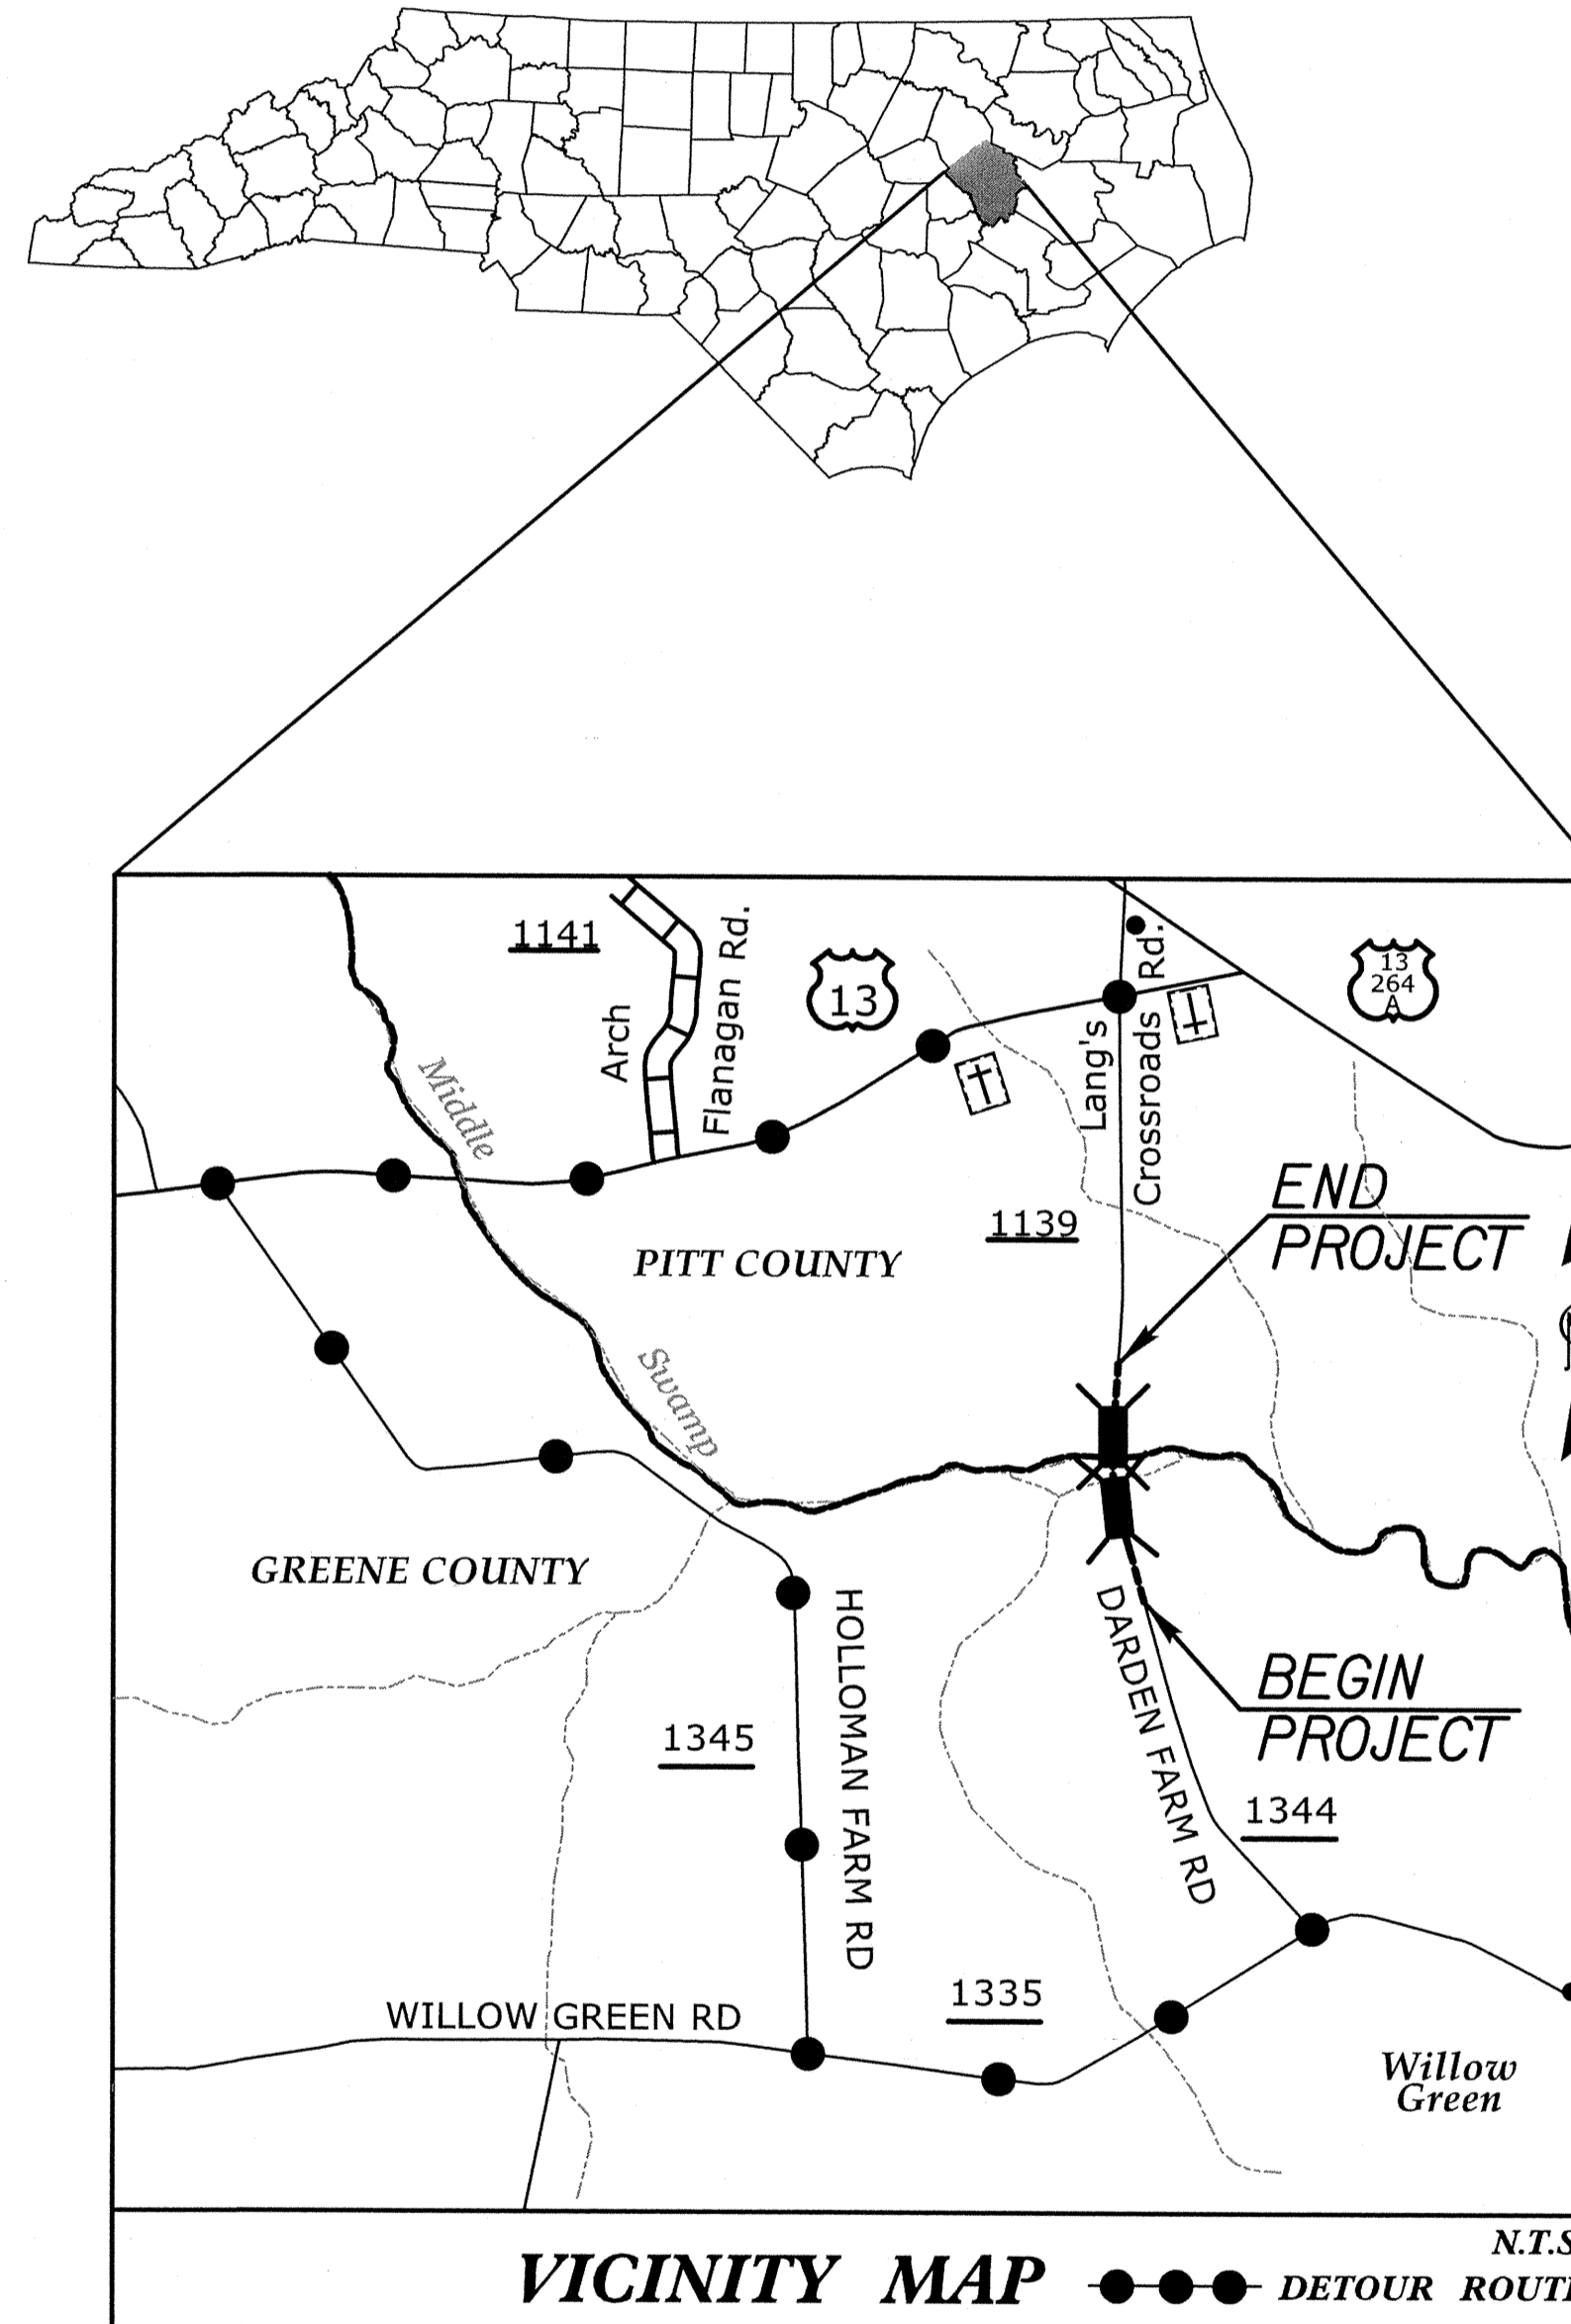

SHEET NO.  
TMP-1

**INDEX OF SHEETS**

| SHEET NO. | TITLE  |
|-----------|--|
| TMP-1     | TITLE SHEET WITH VICINITY MAP, INDEX OF SHEETS, LIST OF APPLICABLE ROADWAY STANDARD DRAWINGS, AND LEGEND |
| TMP-2     | GENERAL NOTES, DETOUR AND PLAN.  |

**ROADWAY STANDARD DRAWINGS**

THE FOLLOWING ROADWAY STANDARDS AS SHOWN IN "ROADWAY STANDARD DRAWINGS" PROJECT SERVICES UNIT - N.C. DEPARTMENT OF TRANSPORTATION - RALEIGH, N.C. DATED JAN 2012 ARE APPLICABLE TO THIS PROJECT AND BY REFERENCE HEREBY ARE CONSIDERED A PART OF THESE PLANS:

| TITLE   |                               |
|---------|-------------------------------|
| 1101.11 | TRAFFIC CONTROL DESIGN TABLES |
| 1110.01 | STATIONARY WORK ZONE SIGNS    |
| 1145.01 | BARRICADES                    |

**LEGEND**

**GENERAL**

- DIRECTION OF TRAFFIC FLOW
- DIRECTION OF PEDESTRIAN TRAFFIC FLOW
- EXIST. PVMT.
- NORTH ARROW
- PROPOSED PVMT.
- WORK AREA

**TRAFFIC CONTROL DEVICES**

- BARRICADE (TYPE III)

**HNTB** HNTB NORTH CAROLINA, P.C.  
343 E. Six Forks Road, Suite 200  
Raleigh, North Carolina 27609  
NC License No: C-1554

R. B. EARLY, PE                      **TRAFFIC CONTROL PROJECT ENGINEER**  
J. A. PHILLIPS                      **TRAFFIC CONTROL DESIGN ENGINEER**

APPROVED:   
DATE: 11.22.15

SEAL


**BD-5102U**

**TIP PROJECT:**

**WORK ZONE SAFETY & MOBILITY**  
"from the MOUNTAINS to the COAST"

**N.C.D.O.T. WORK ZONE TRAFFIC CONTROL**  
1561 MAIL SERVICE CENTER (MSC) RALEIGH, NC 27699-1561  
750 N. GREENFIELD PARKWAY, GARNER, NC 27529 (DELIVERY)  
PHONE: (919) 773-2800 FAX: (919) 771-2745

STEVEN J. HAMILTON, PE **DIVISION TRAFFIC ENGINEER**

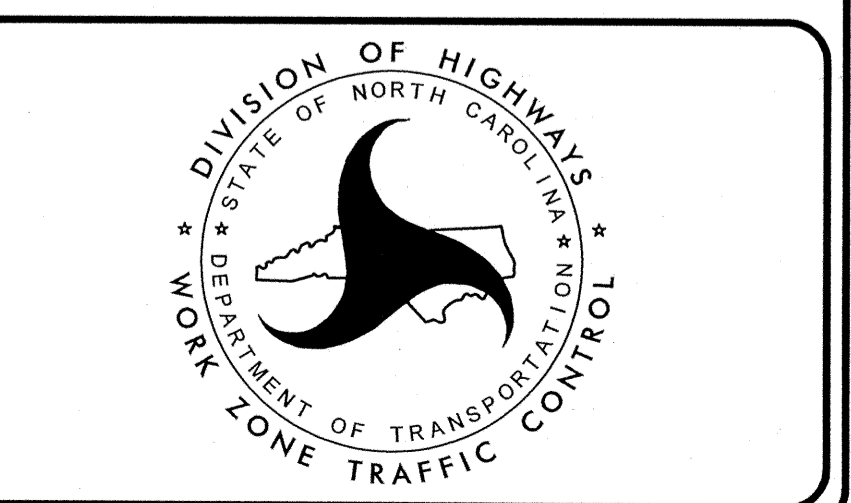



1:08:39 PM I:\B-5102U\_Tc-TCP\_01\_Tile.dgn \$\$\$USERNAME\$\$\$

# GENERAL NOTES

IMPLEMENT TRAFFIC CONTROL IN ACCORDANCE WITH THE ROADWAY STANDARD DRAWINGS LISTED ON TMP-1.




CHANGES MAY BE REQUIRED WHEN PHYSICAL DIMENSIONS IN THE DETAIL DRAWINGS, STANDARD DETAILS AND ROADWAY DETAILS ARE NOT ATTAINABLE TO MEET FIELD CONDITIONS, OR RESULT IN DUPLICATE, OR UNDESIRED OVERLAPPING, OF DEVICES. MODIFICATIONS MAY INCLUDE: MOVING, SUPPLEMENTING, COVERING OR REMOVAL OF DEVICES, AS DIRECTED BY THE ENGINEER.

STATE FORCES WILL INSTALL AND MAINTAIN THE PROJECT DETOUR AND THE TYPE III BARRICADES AT THE PROJECT LIMITS.  
STATE FORCES WILL INSTALL MARKINGS AND MARKERS ON THE FINISHED PROJECT.  
CALL JIM EVANS AT 252-830-3493 FOR COORDINATION.

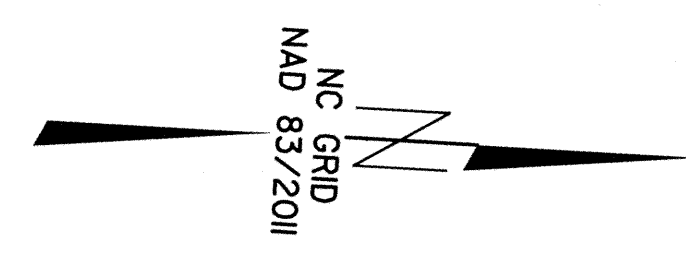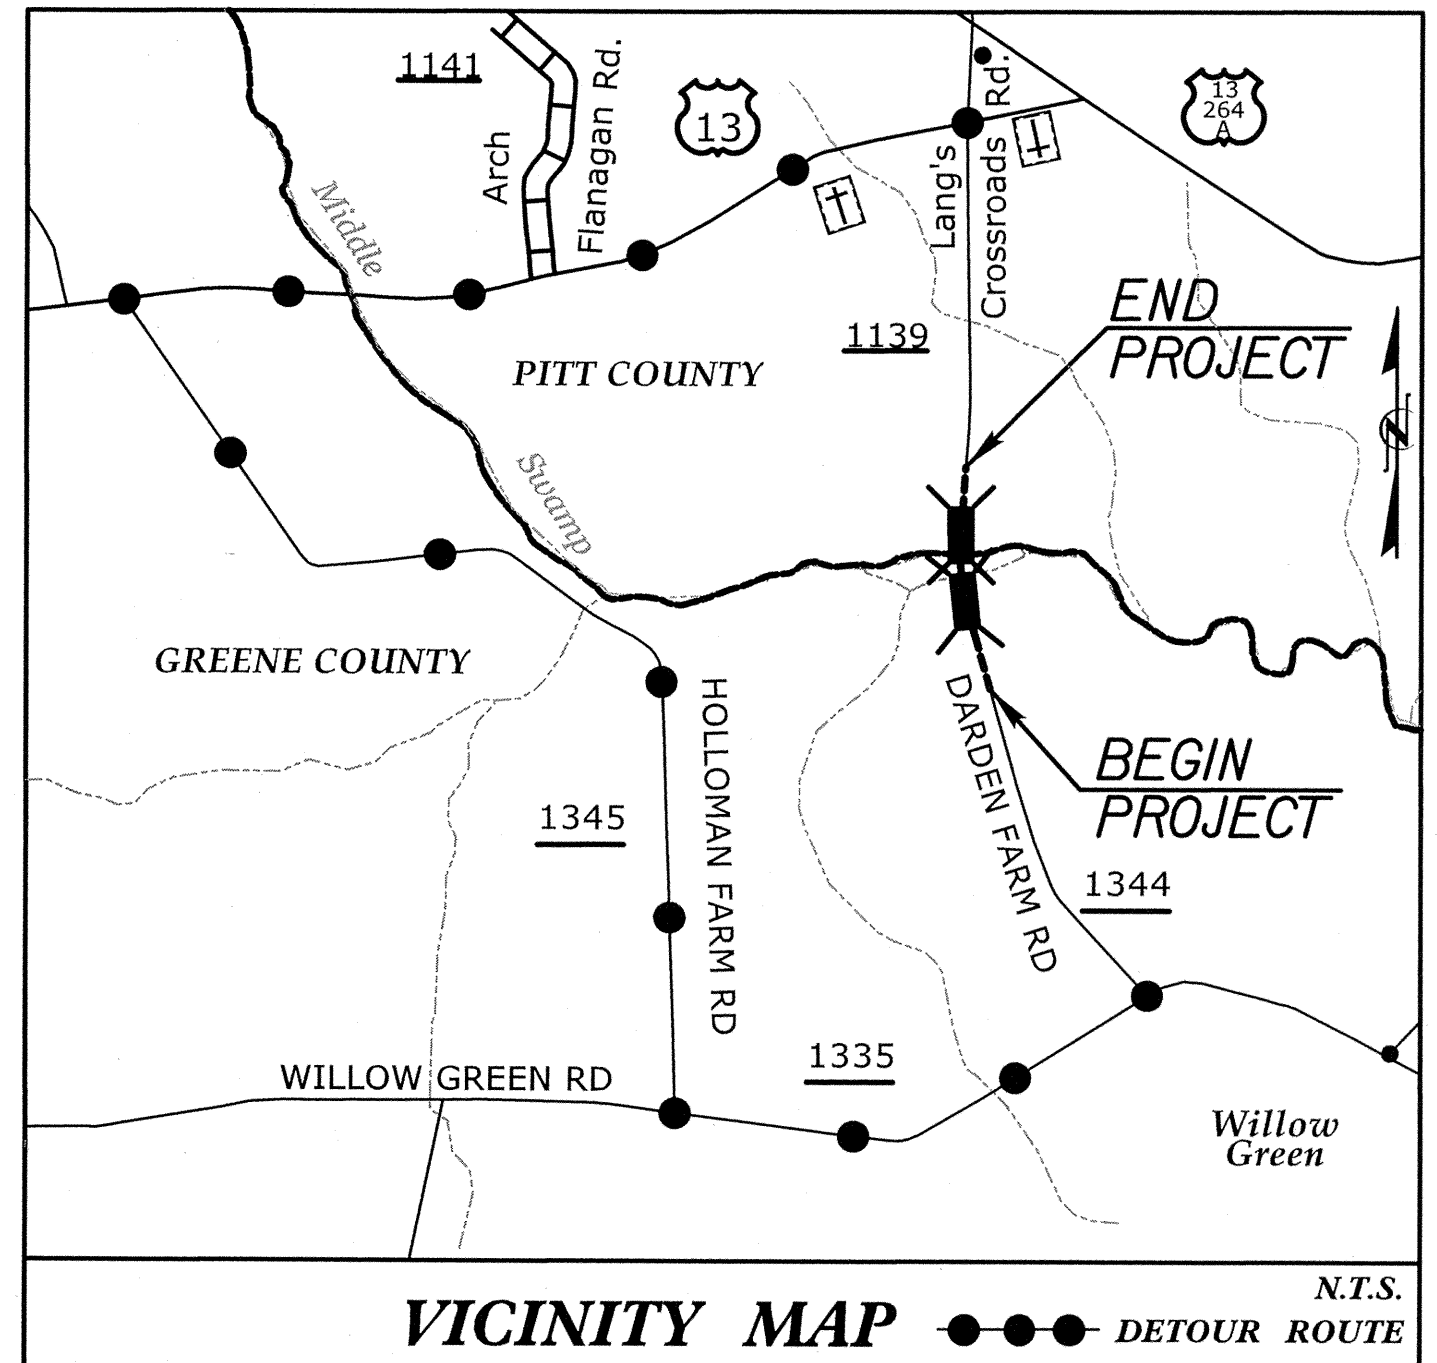


10

15

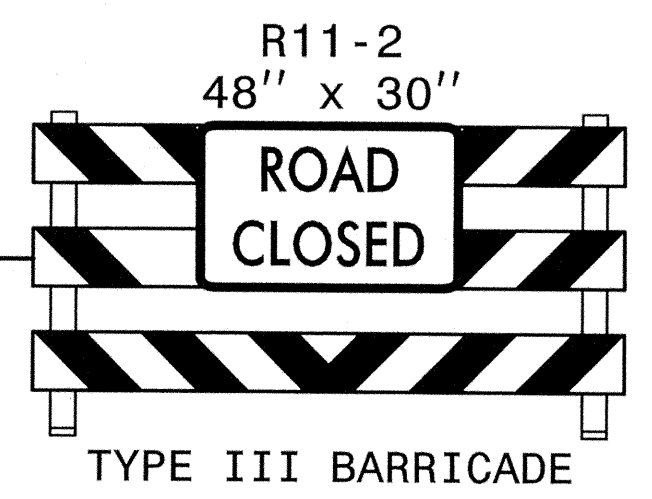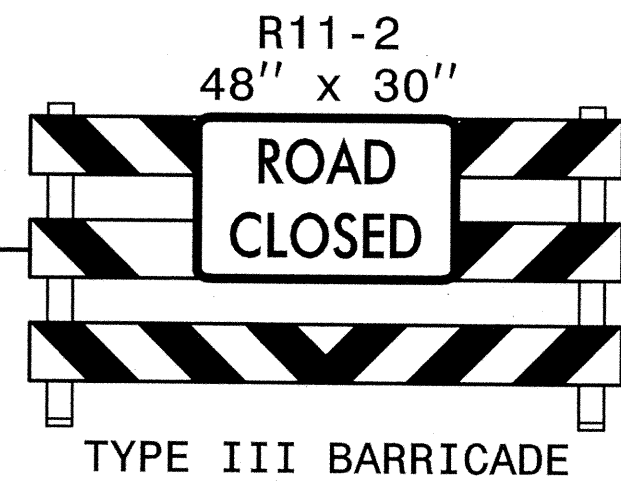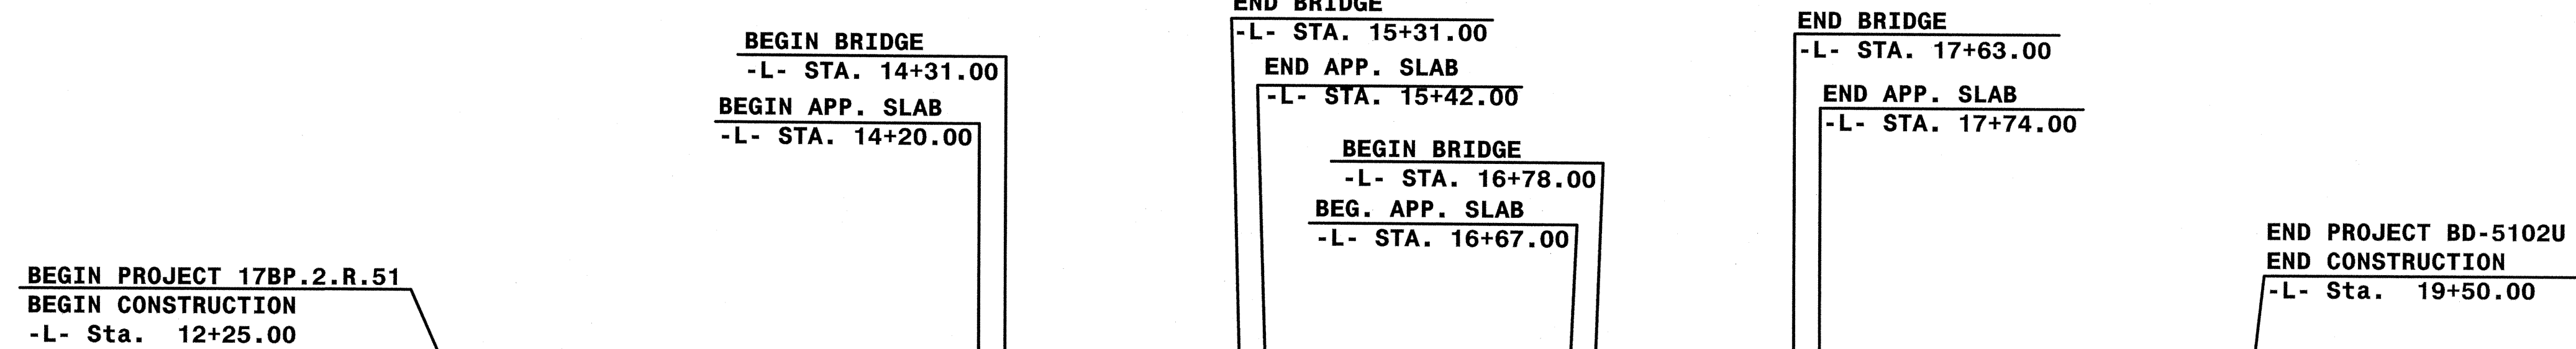

H:\024 PM 10-17-10\10-17-10 TCP 02 detour.dgn  
 \$\$\$USER\$\$\$  
 QA/QC STAGE: \_\_\_\_\_  
 REVIEW: \_\_\_\_\_  
 CONCUR: \_\_\_\_\_  
 REVISE: \_\_\_\_\_  
 VERIFY: \_\_\_\_\_

APPROVED: *[Signature]* DATE: 11-22-13

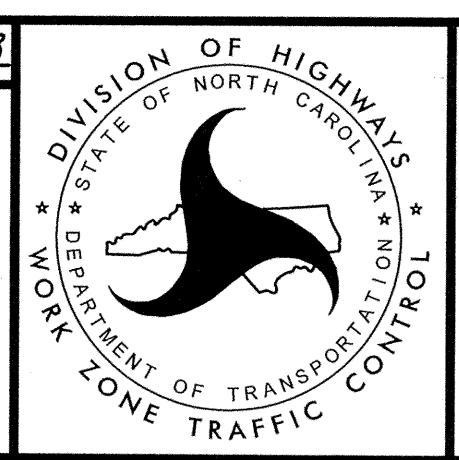

TRANSPORTATION  
MANAGEMENT PLAN  
GENERAL NOTES,  
DETOUR  
AND PLAN

**HNTB**  
 HNTB NORTH CAROLINA, P.C.  
 343 E. Six Forks Road, Suite 200  
 Raleigh, North Carolina 27609  
 NC License No: C-1554




**TIP PROJECT:BD-5102U & 17BP.2.R.51**

STATE OF NORTH CAROLINA  
DIVISION OF HIGHWAYS  
**PLAN FOR PROPOSED  
HIGHWAY EROSION CONTROL**

**LOCATION: BRIDGE NO. 069 OVER MIDDLE SWAMP  
ON SR 1139 (MOYE-TURNAGE RD.)  
BRIDGE NO. 034 OVER MIDDLE SWAMP (OVERFLOW)  
ON SR 1344 (DARDEN FARM RD.)**

**TYPE OF WORK: GRADING, PAVING, RESURFACING, GUARDRAIL,  
DRAINAGE & STRUCTURE**

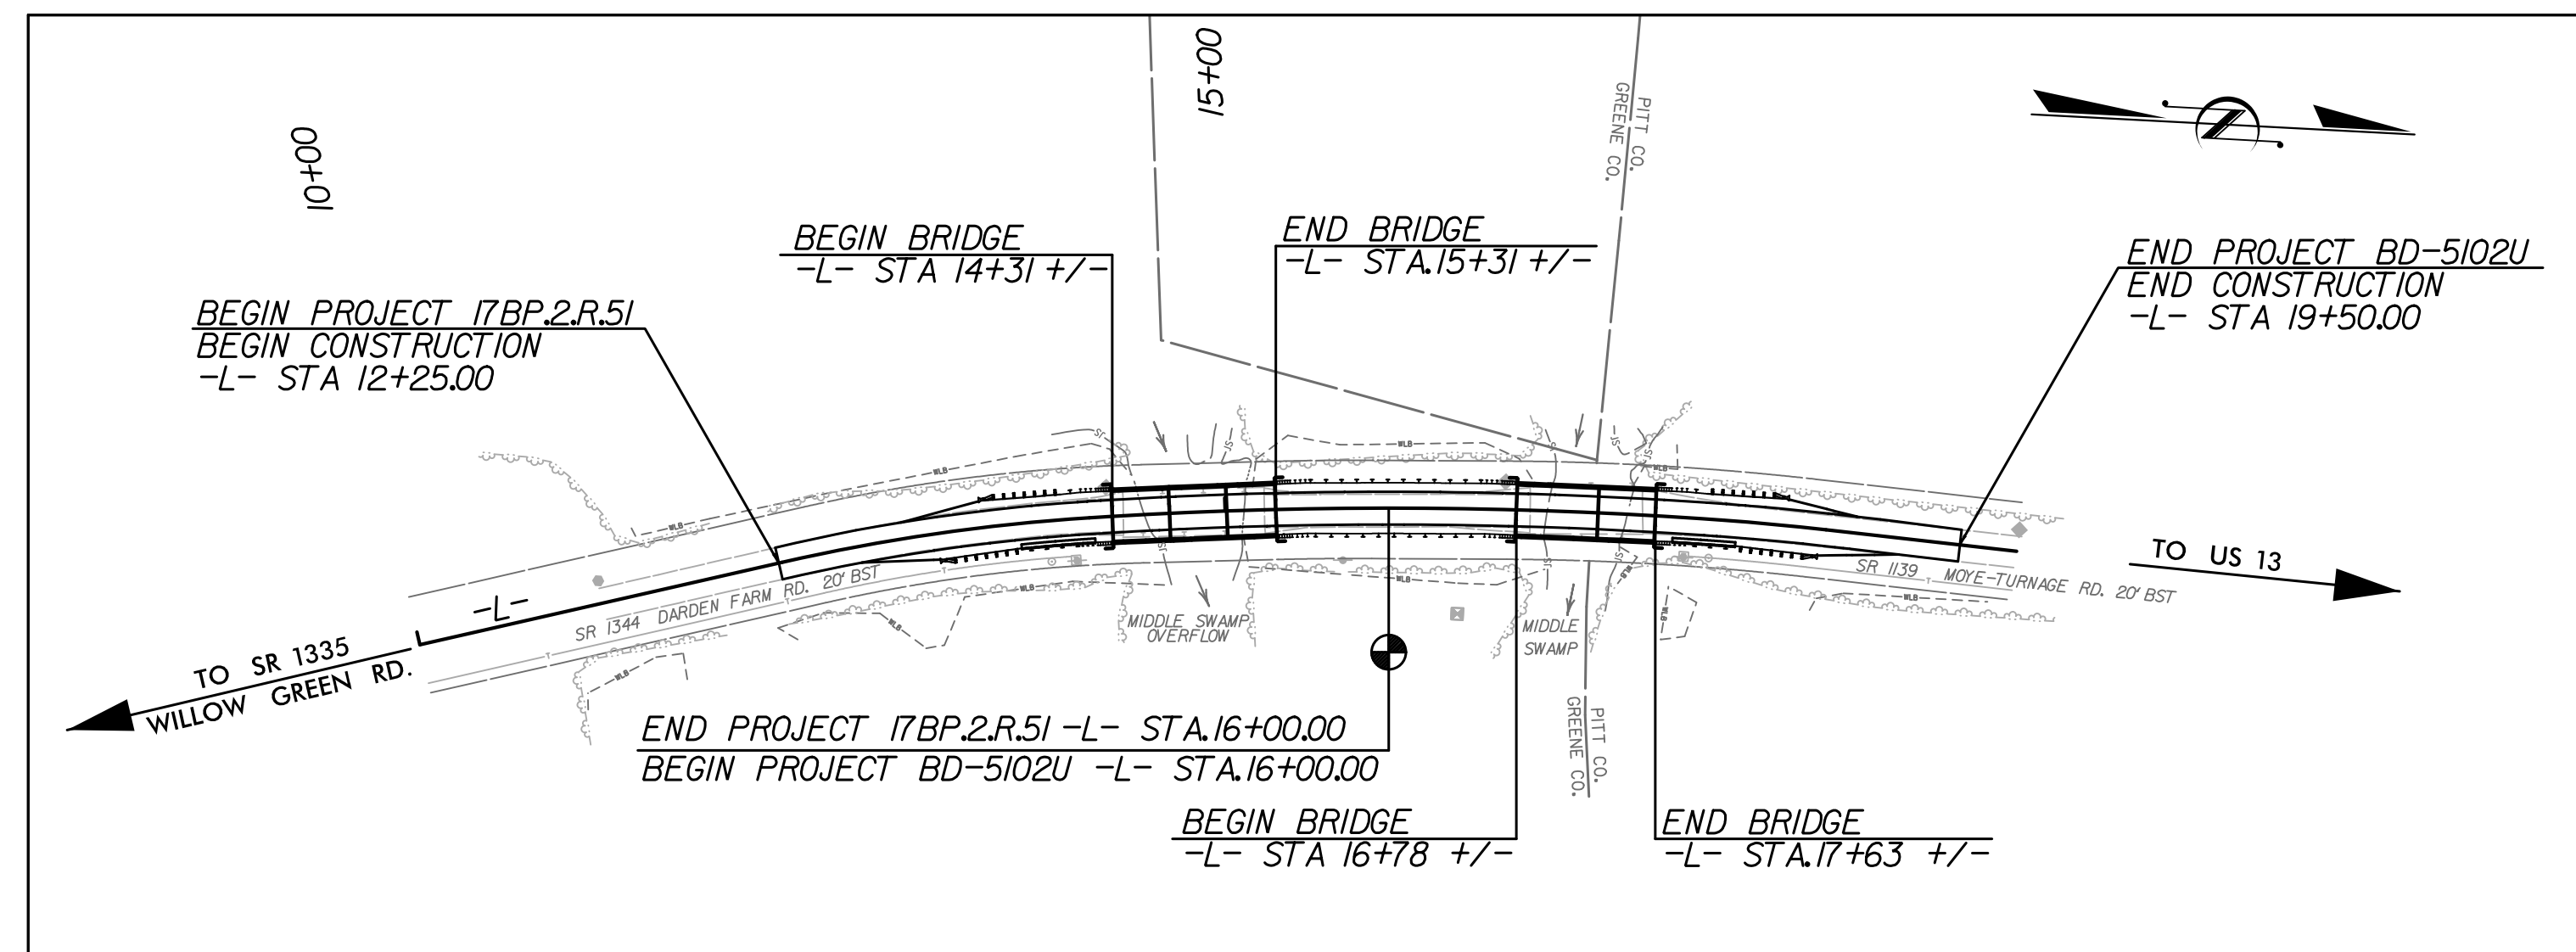

|                 |                             |             |              |
|-----------------|-----------------------------|-------------|--------------|
| STATE           | STATE PROJECT REFERENCE NO. | SHEET NO.   | TOTAL SHEETS |
| N.C.            | 45348.1.21 & 17BP.2.R.51    | EC-1        | 7            |
| STATE PROJ. NO. | F.A. PROJ. NO.              | DESCRIPTION |              |
| 45348.1.21      | BRZ-1139(5)                 | CONST       |              |
| 17BP.2.R.51     |                             |             |              |


**EROSION AND SEDIMENT CONTROL MEASURES**

| Std. #  | Description  | Symbol |
|---------|--|--------|
| 1630.03 | Temporary Silt Ditch   | TD     |
| 1630.05 | Temporary Diversion  | TD     |
| 1605.01 | Temporary Silt Fence   |        |
| 1606.01 | Special Sediment Control Fence   | △△△    |
| 1622.01 | Temporary Berms and Slope Drains                                       | →      |
|         | Silt Basin Type B  | ▨      |
| 1633.01 | Temporary Rock Silt Check Type-A                                       | ▨      |
|         | Temporary Rock Silt Check Type-A with Matting and Polyacrylamide (PAM) | ▨      |
|         | Temporary Rock Silt Check Type-B                                       | ▨      |
|         | Wattle/Coir Fiber Wattle   | →      |
|         | Wattle/Coir Fiber Wattle with Polyacrylamide (PAM)                     | →      |
| 1634.01 | Temporary Rock Sediment Dam Type-A                                     | ▨      |
| 1634.02 | Temporary Rock Sediment Dam Type-B                                     | ▨      |
| 1635.01 | Rock Pipe Inlet Sediment Trap Type-A                                   | ⊓      |
| 1635.02 | Rock Pipe Inlet Sediment Trap Type-B                                   | ⊓      |
| 1630.04 | Stilling Basin   | ▭      |
| 1630.06 | Special Stilling Basin   | ▭      |
|         | Rock Inlet Sediment Trap:  |        |
| 1632.01 | Type A   | A      |
| 1632.02 | Type B   | B      |
| 1632.03 | Type C   | C      |
|         | Skimmer Basin  | ▭      |
|         | Tiered Skimmer Basin   | ▭      |
|         | Infiltration Basin   | ▭      |

**THIS PROJECT HAS  
BEEN DESIGNED TO  
SENSITIVE WATERSHED  
STANDARDS.**

**ENVIRONMENTALLY  
SENSITIVE AREA(S) EXIST  
ON THIS PROJECT**  
*Refer To E. C. Special Provisions  
for Special Considerations.*

**GRAPHIC SCALE**

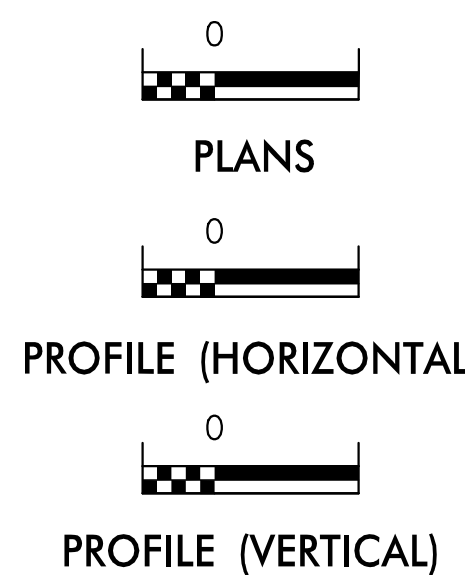

ROADSIDE ENVIRONMENTAL UNIT  
DIVISION OF HIGHWAYS  
STATE OF NORTH CAROLINA

THESE EROSION AND SEDIMENT CONTROL PLANS COMPLY WITH THE REGULATIONS SET FORTH BY THE NCG-010000 GENERAL CONSTRUCTION PERMIT EFFECTIVE AUGUST 3, 2011 ISSUED BY THE NORTH CAROLINA DEPARTMENT OF ENVIRONMENT AND NATURAL RESOURCES DIVISION OF WATER QUALITY.

Prepared in the Office of:

**HNTB** HNTB NORTH CAROLINA, P.C.  
343 E. Six Forks Road, Suite 200  
Raleigh, North Carolina 27609  
NC License No: C-1554

**2012 STANDARD SPECIFICATIONS**

BENTON R. CARROLL  
EROSION CONTROL  
LEVEL III-A  
CERTIFICATION #3180

**Roadway Standard Drawings**






The following roadway english standards as appear in "Roadway Standard Drawings"- Roadway Design Unit - N. C. Department of Transportation - Raleigh, N. C., dated January 2012 and the latest revision thereto are applicable to this project and by reference hereby are considered a part of these plans.

|  |  |
|--|--|
| 1604.01 Railroad Erosion Control Detail  | 1632.01 Rock Inlet Sediment Trap Type A      |
| 1605.01 Temporary Silt Fence             | 1632.02 Rock Inlet Sediment Trap Type B      |
| 1606.01 Special Sediment Control Fence   | 1632.03 Rock Inlet Sediment Trap Type C      |
| 1607.01 Gravel Construction Entrance     | 1633.01 Temporary Rock Silt Check Type A     |
| 1622.01 Temporary Berms and Slope Drains | 1633.02 Temporary Rock Silt Check Type B     |
| 1630.01 Riser Basin                      | 1634.01 Temporary Rock Sediment Dam Type A   |
| 1630.02 Silt Basin Type B                | 1634.02 Temporary Rock Sediment Dam Type B   |
| 1630.03 Temporary Silt Ditch             | 1635.01 Rock Pipe Inlet Sediment Trap Type A |
| 1630.04 Stilling Basin                   | 1635.02 Rock Pipe Inlet Sediment Trap Type B |
| 1630.05 Temporary Diversion              | 1640.01 Coir Fiber Baffle                    |
| 1630.06 Special Stilling Basin           | 1645.01 Temporary Stream Crossing            |
| 1631.01 Matting Installation             |  |

# COIR FIBER WATTLE WITH POLYACRYLAMIDE (PAM) DETAIL

**NOTES:**



- USE MINIMUM 12 IN. DIAMETER COIR FIBER (COCONUT FIBER) WATTLE.
- USE 2 FT. WOODEN STAKES WITH A 2 IN. BY 2 IN. NOMINAL CROSS SECTION.
- ONLY INSTALL WATTLE(S) TO A HEIGHT IN DITCH SO FLOW WILL NOT WASH AROUND WATTLE AND SCOUR DITCH SLOPES AND AS DIRECTED.
- INSTALL A MINIMUM OF 2 UPSLOPE STAKES AND 4 DOWNSLOPE STAKES AT AN ANGLE TO WEDGE WATTLE TO BOTTOM OF DITCH.
- PROVIDE STAPLES MADE OF 0.125 IN. DIAMETER STEEL WIRE FORMED INTO A U SHAPE NOT LESS THAN 12" IN LENGTH.
- INSTALL STAPLES APPROXIMATELY EVERY 1 LINEAR FOOT ON BOTH SIDES OF WATTLE AND AT EACH END TO SECURE IT TO THE SOIL.
- INSTALL MATTING IN ACCORDANCE WITH SECTION 1631 OF THE STANDARD SPECIFICATIONS.
- PRIOR TO POLYACRYLAMIDE (PAM) APPLICATION, OBTAIN A SOIL SAMPLE FROM PROJECT LOCATION, AND FROM OFFSITE MATERIAL, AND ANALYZE FOR APPROPRIATE PAM FLOCCULANT TO BE APPLIED TO EACH WATTLE.
- INITIALLY APPLY 2 OUNCES OF ANIONIC OR NEUTRALLY CHARGED PAM OVER WATTLE WHERE WATER WILL FLOW AND 1 OUNCE OF PAM ON EACH SIDE OF WATTLE. REAPPLY PAM AFTER EVERY RAINFALL EVENT THAT IS EQUAL TO OR EXCEEDS 0.50 IN.

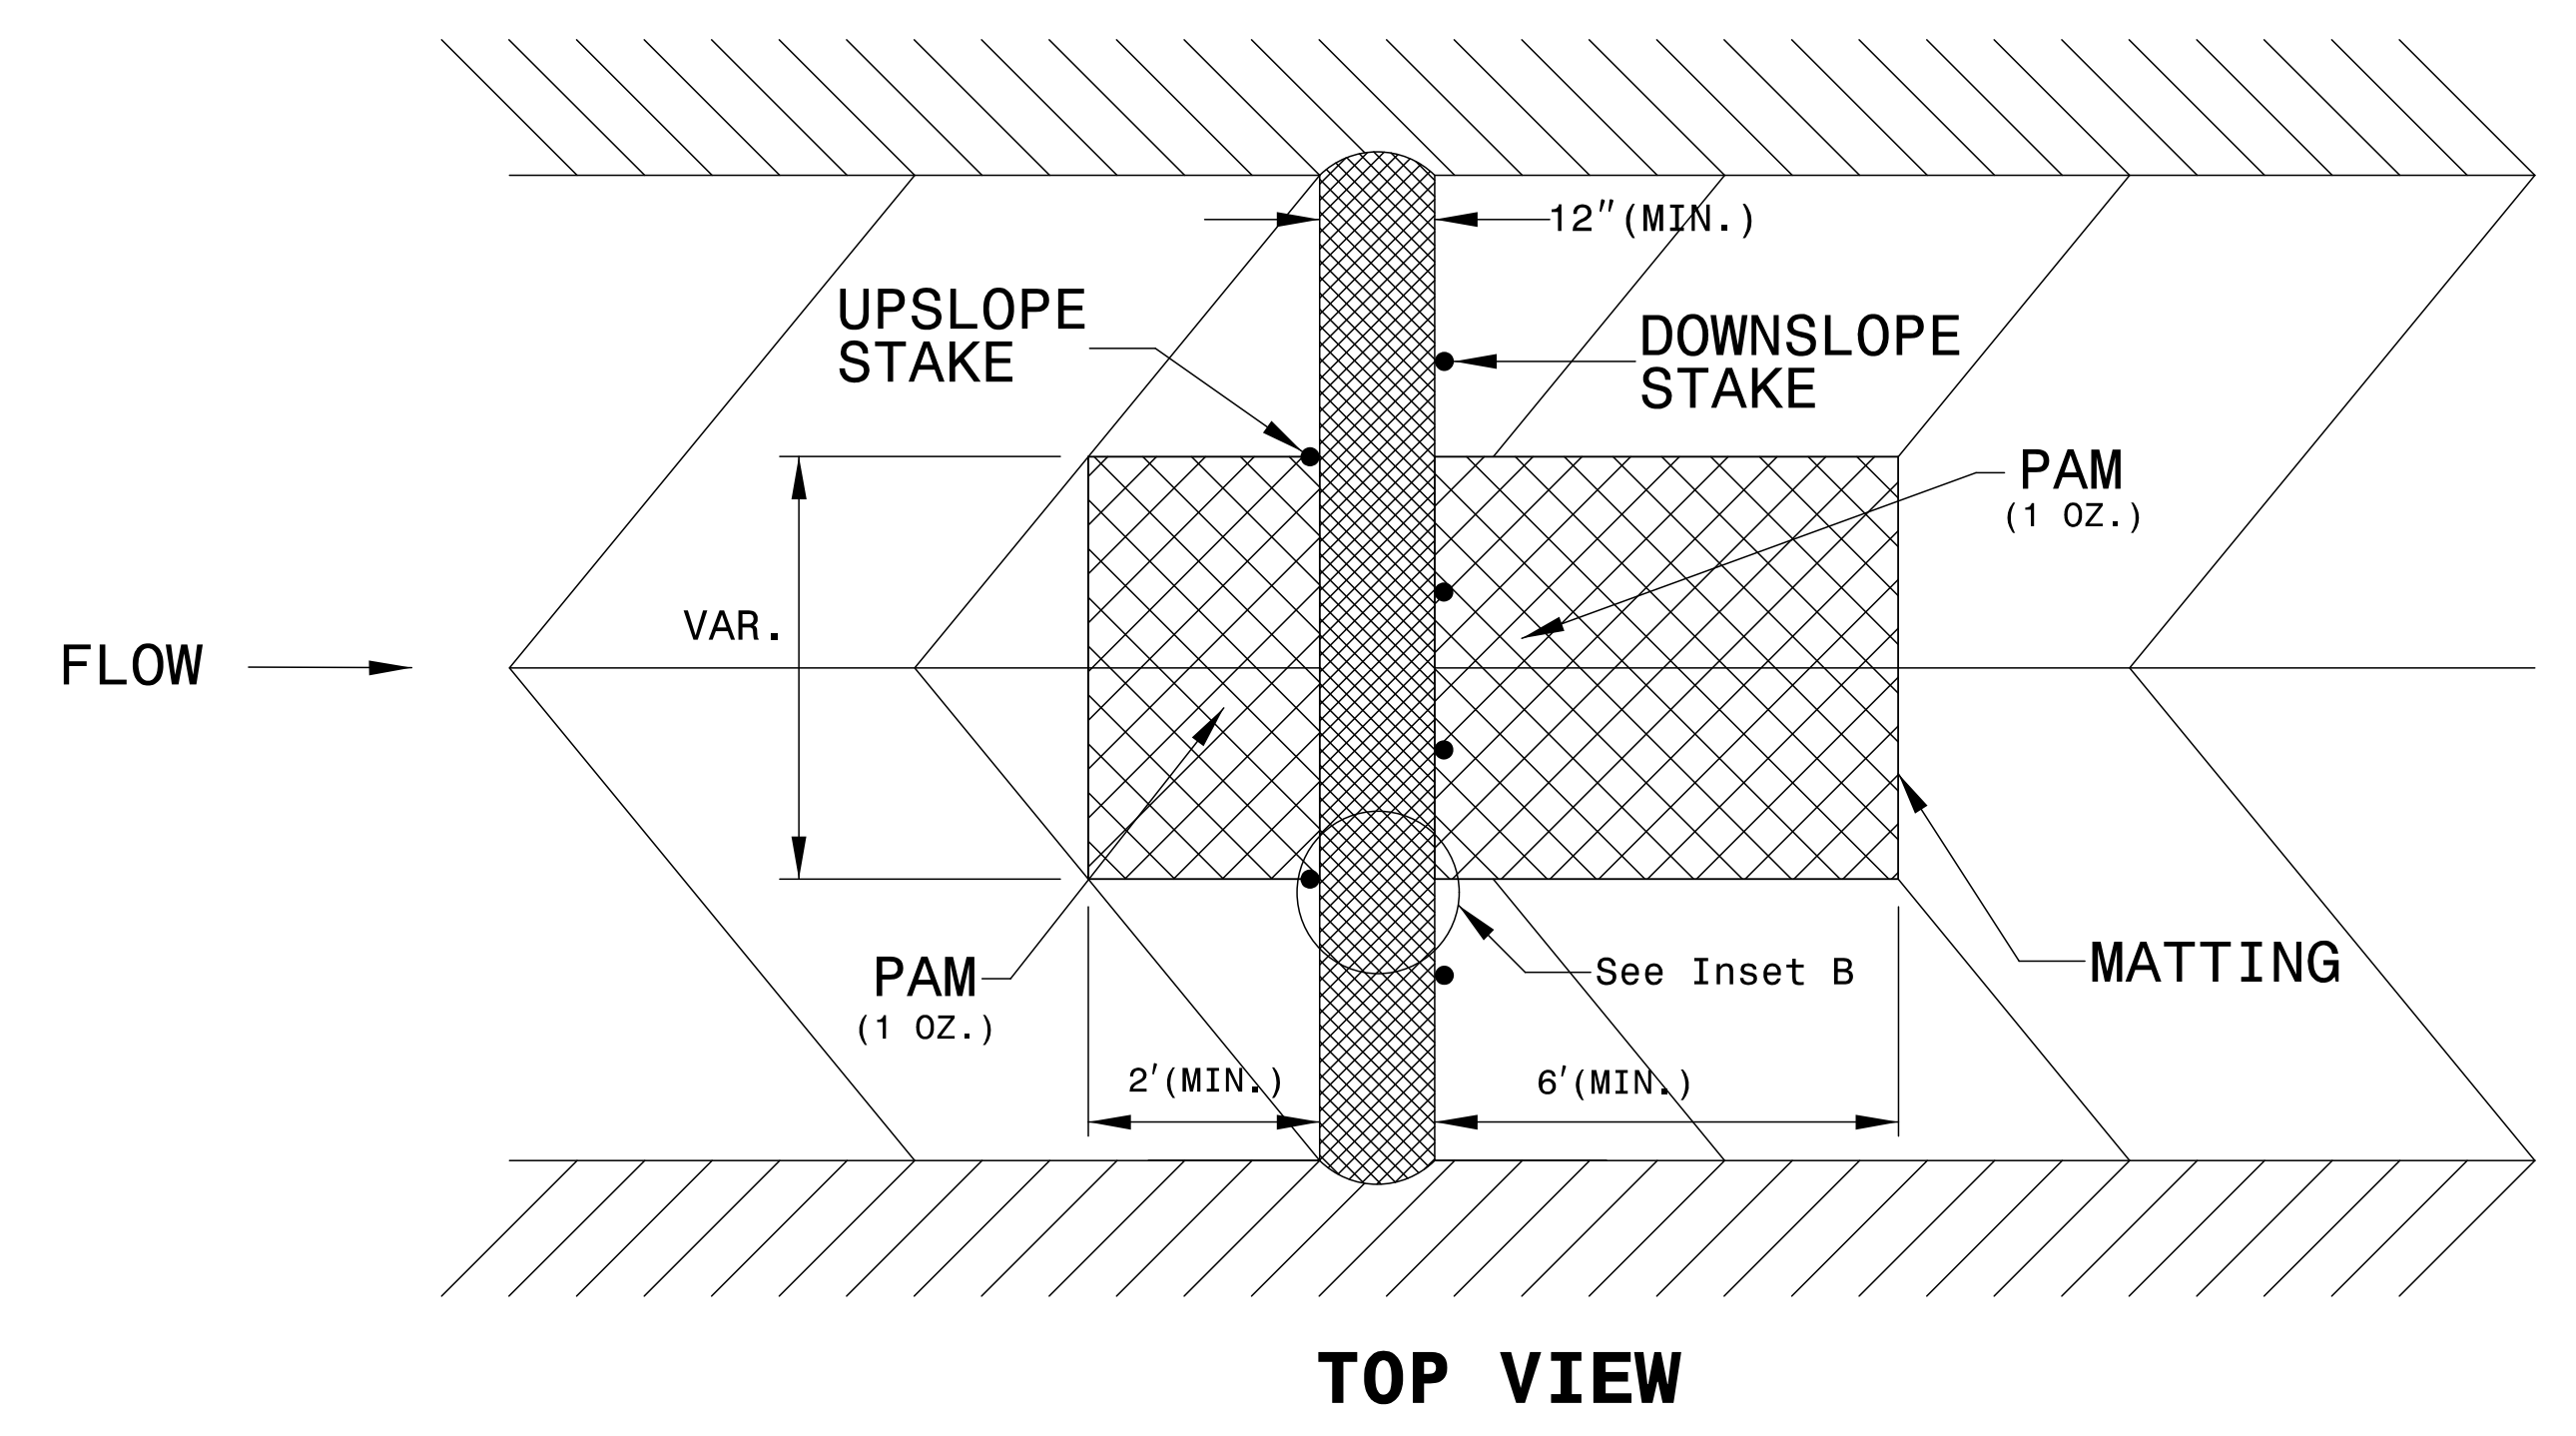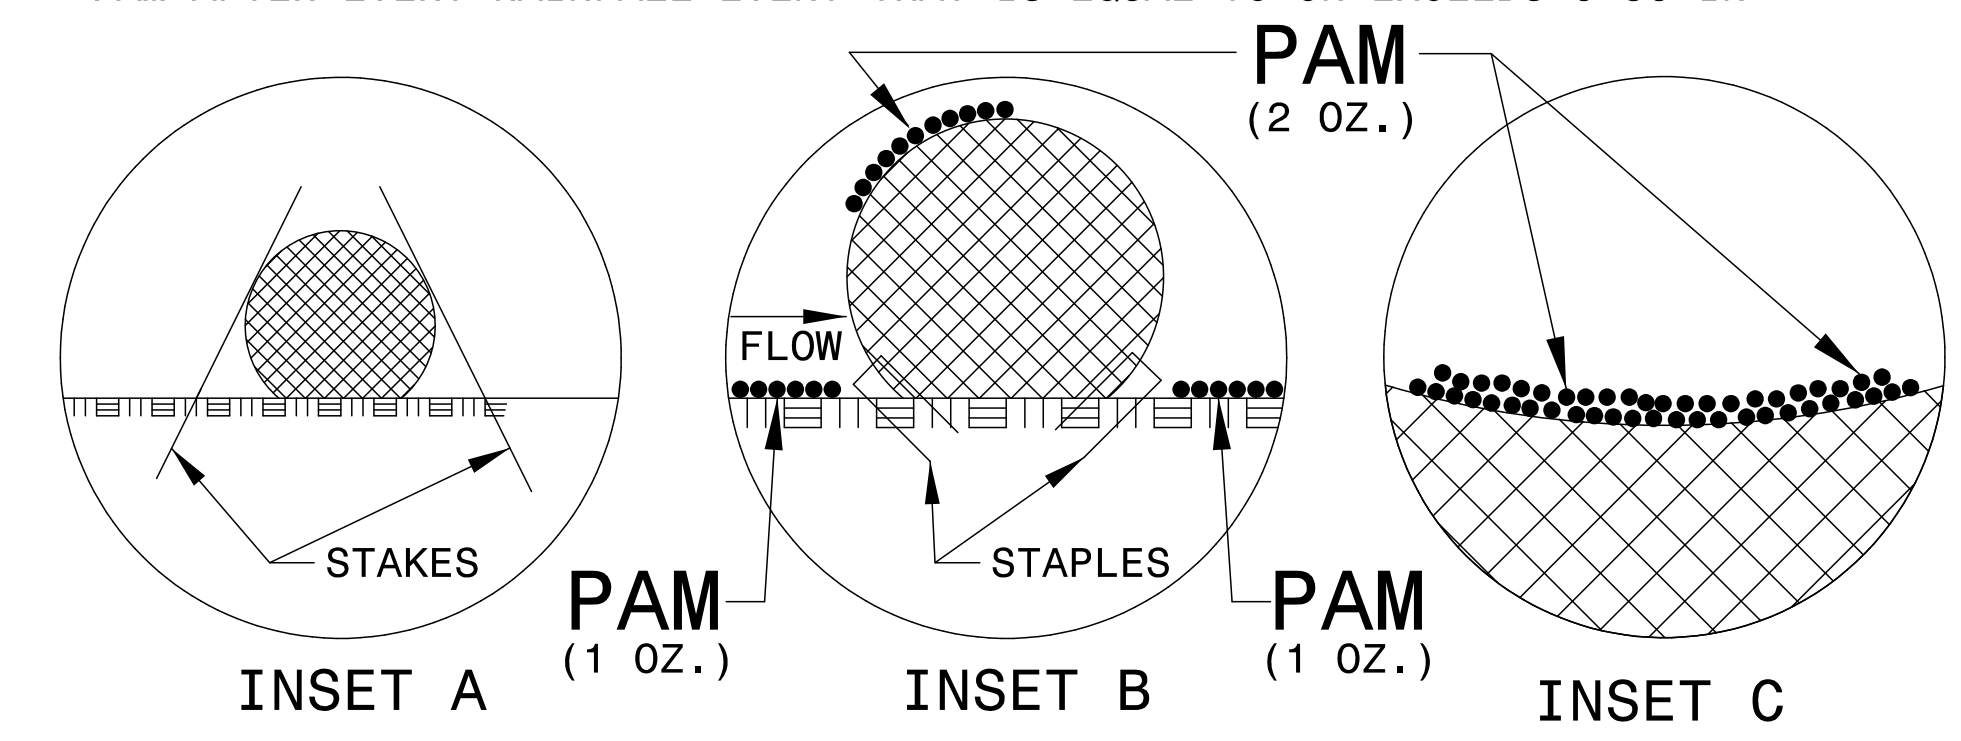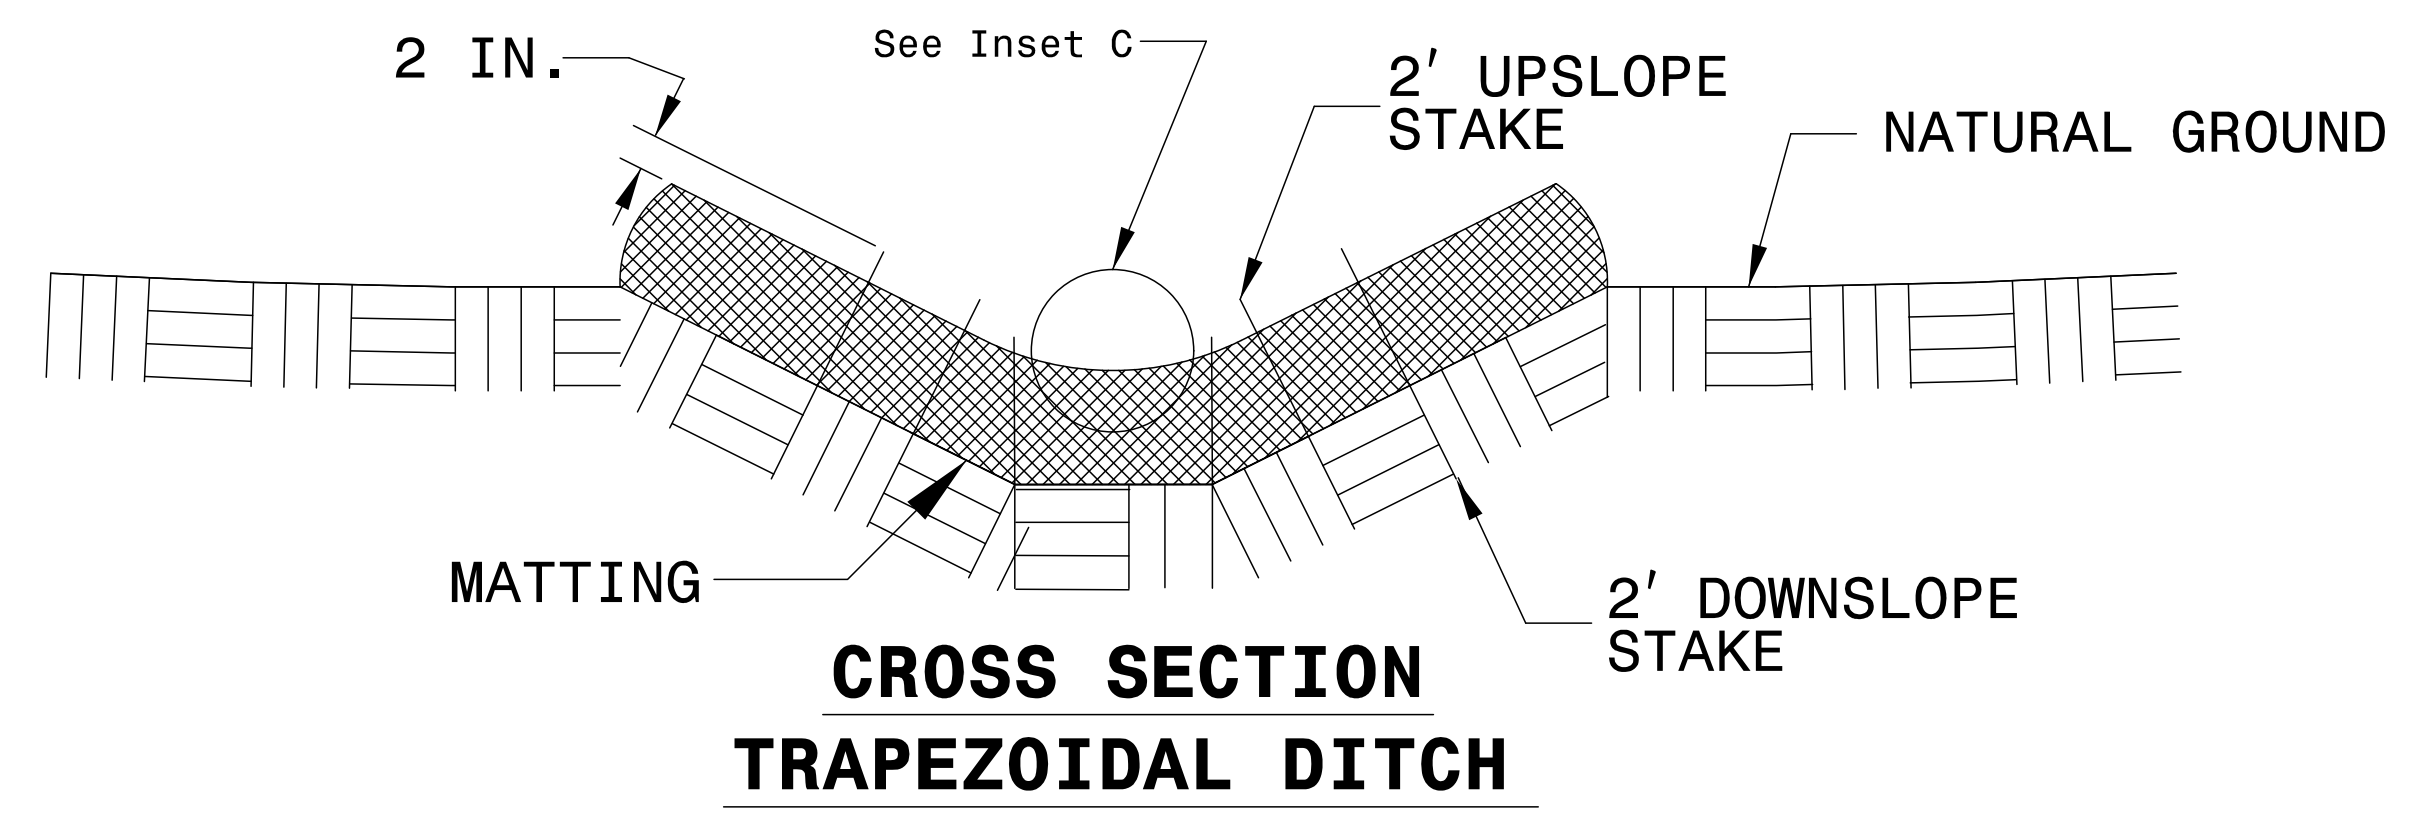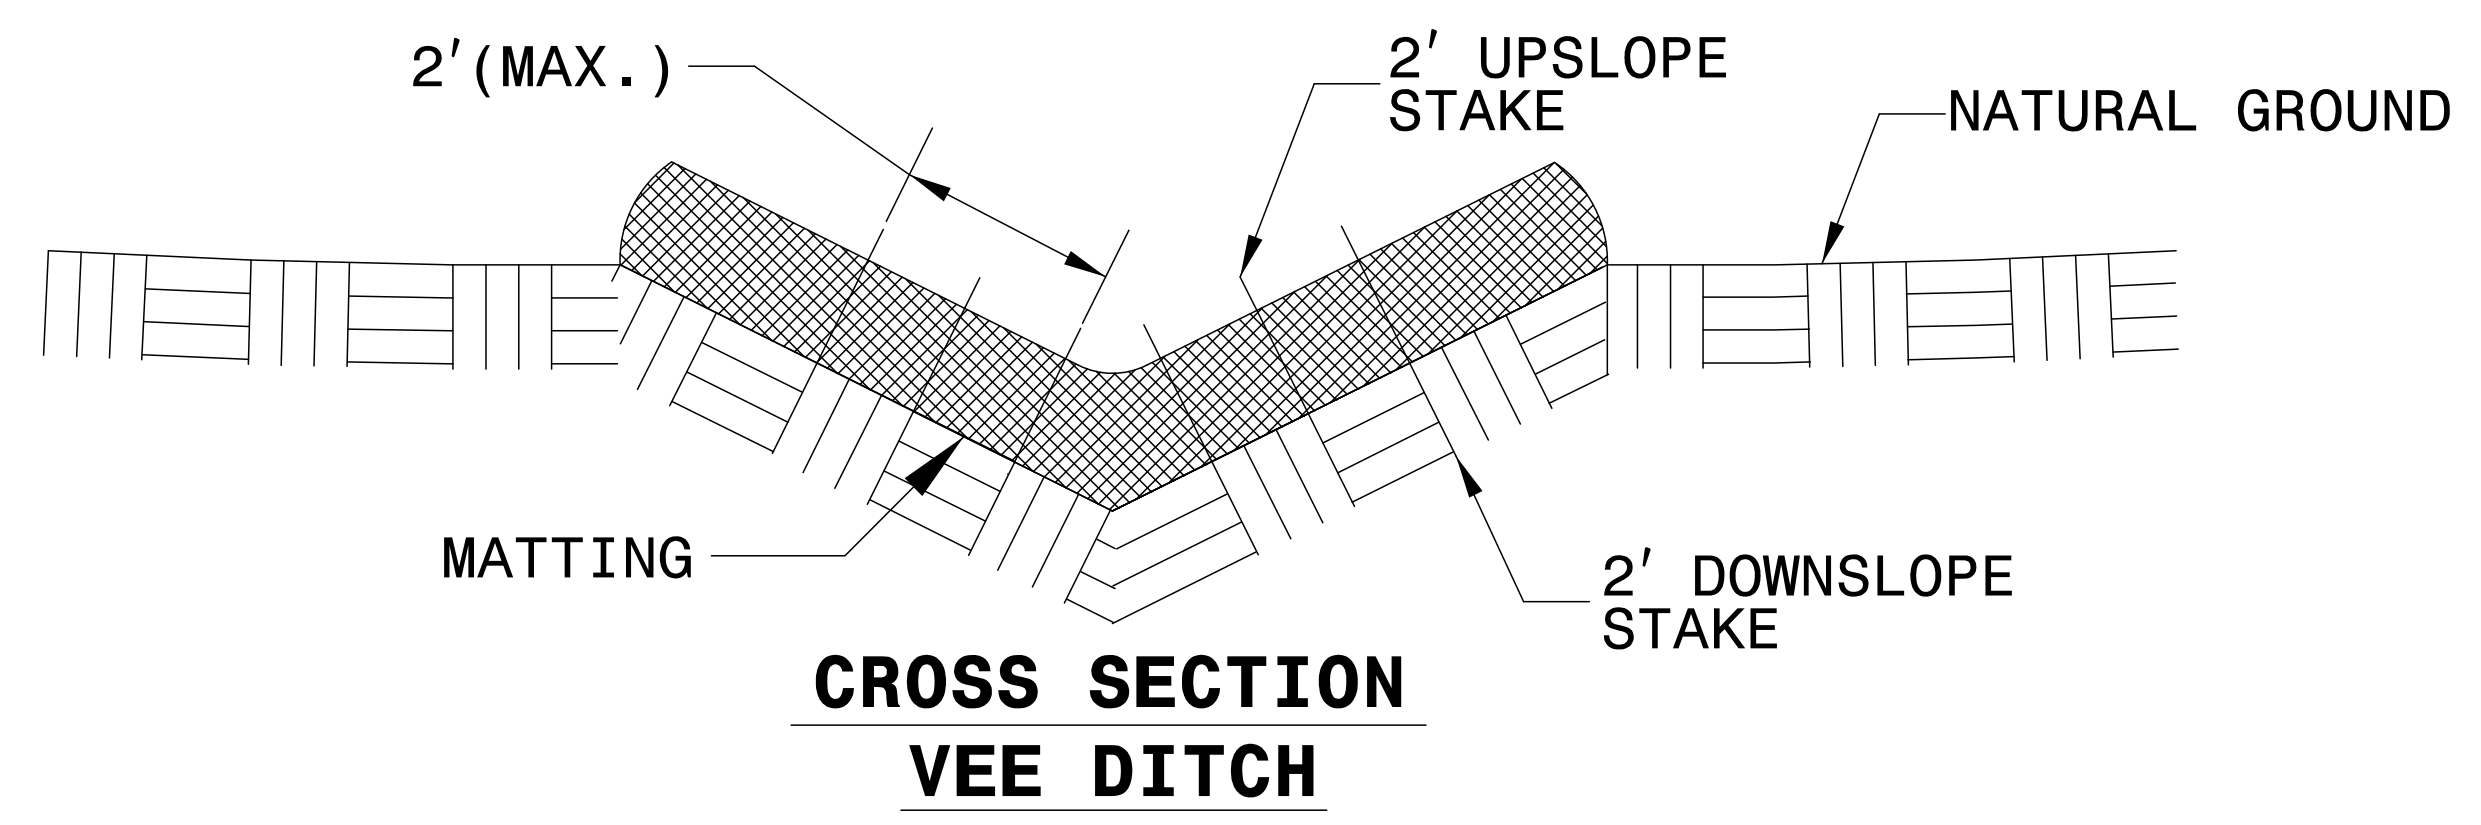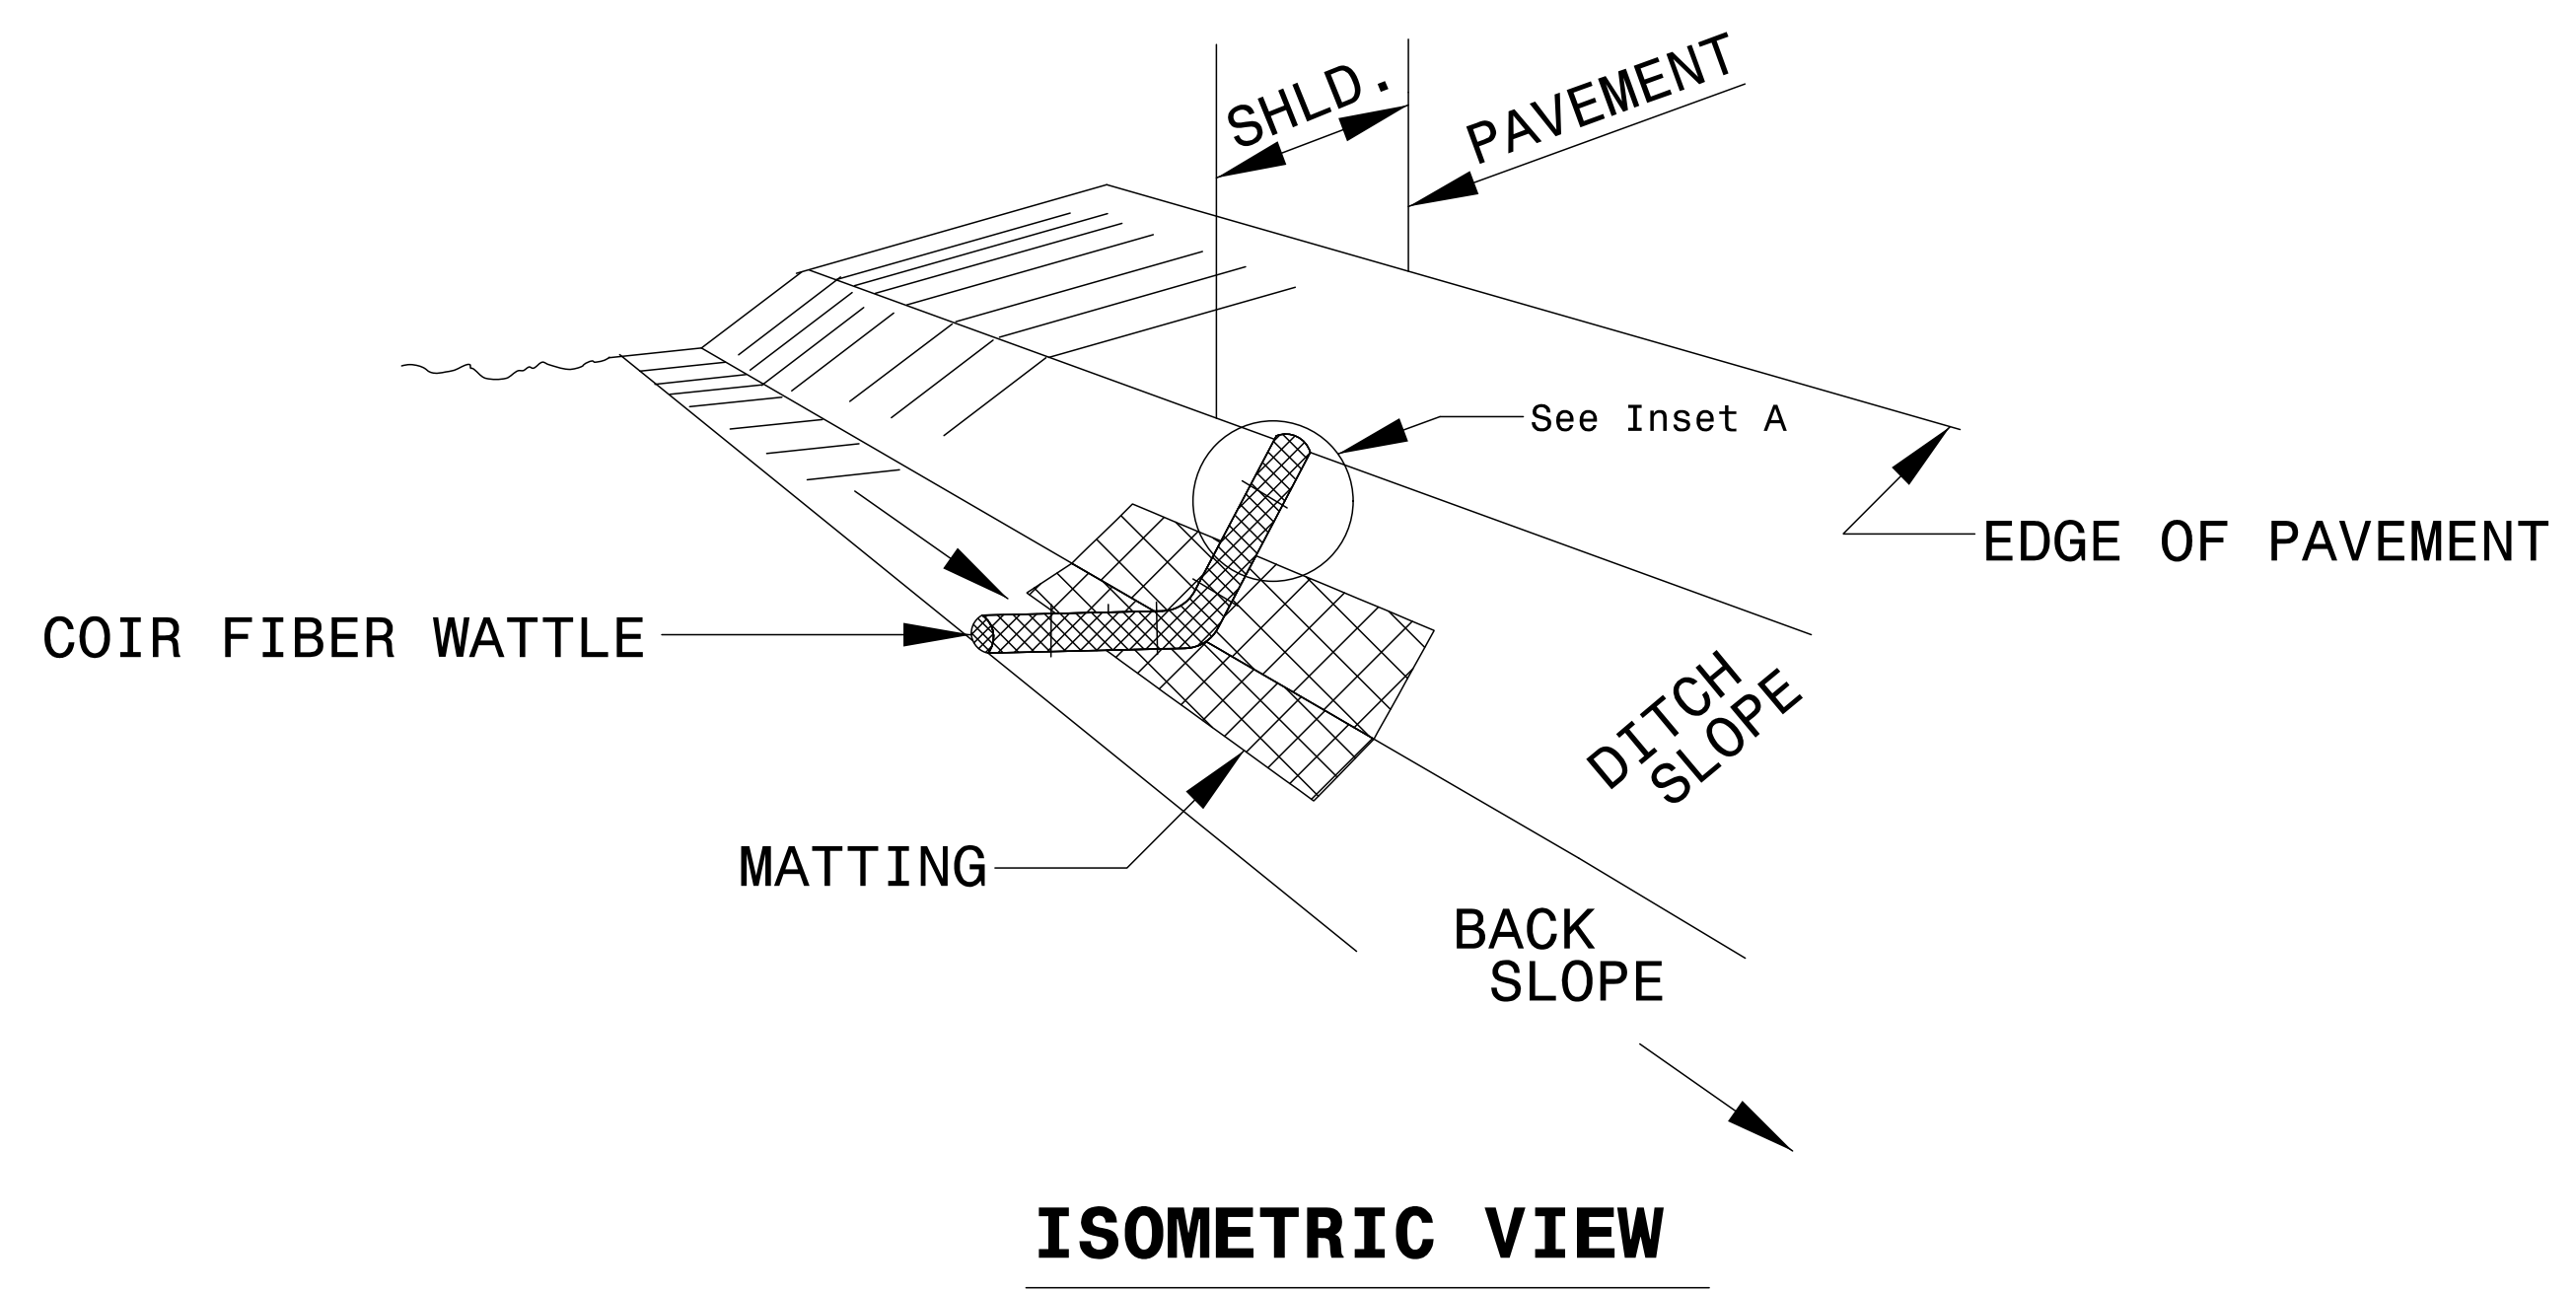

6/2/99

5:29:12 PM  
C:\Bentley\Bentley\ec\_detail.dgn  
USER:NAME

# SILT FENCE COIR FIBER WATTLE BREAK DETAIL

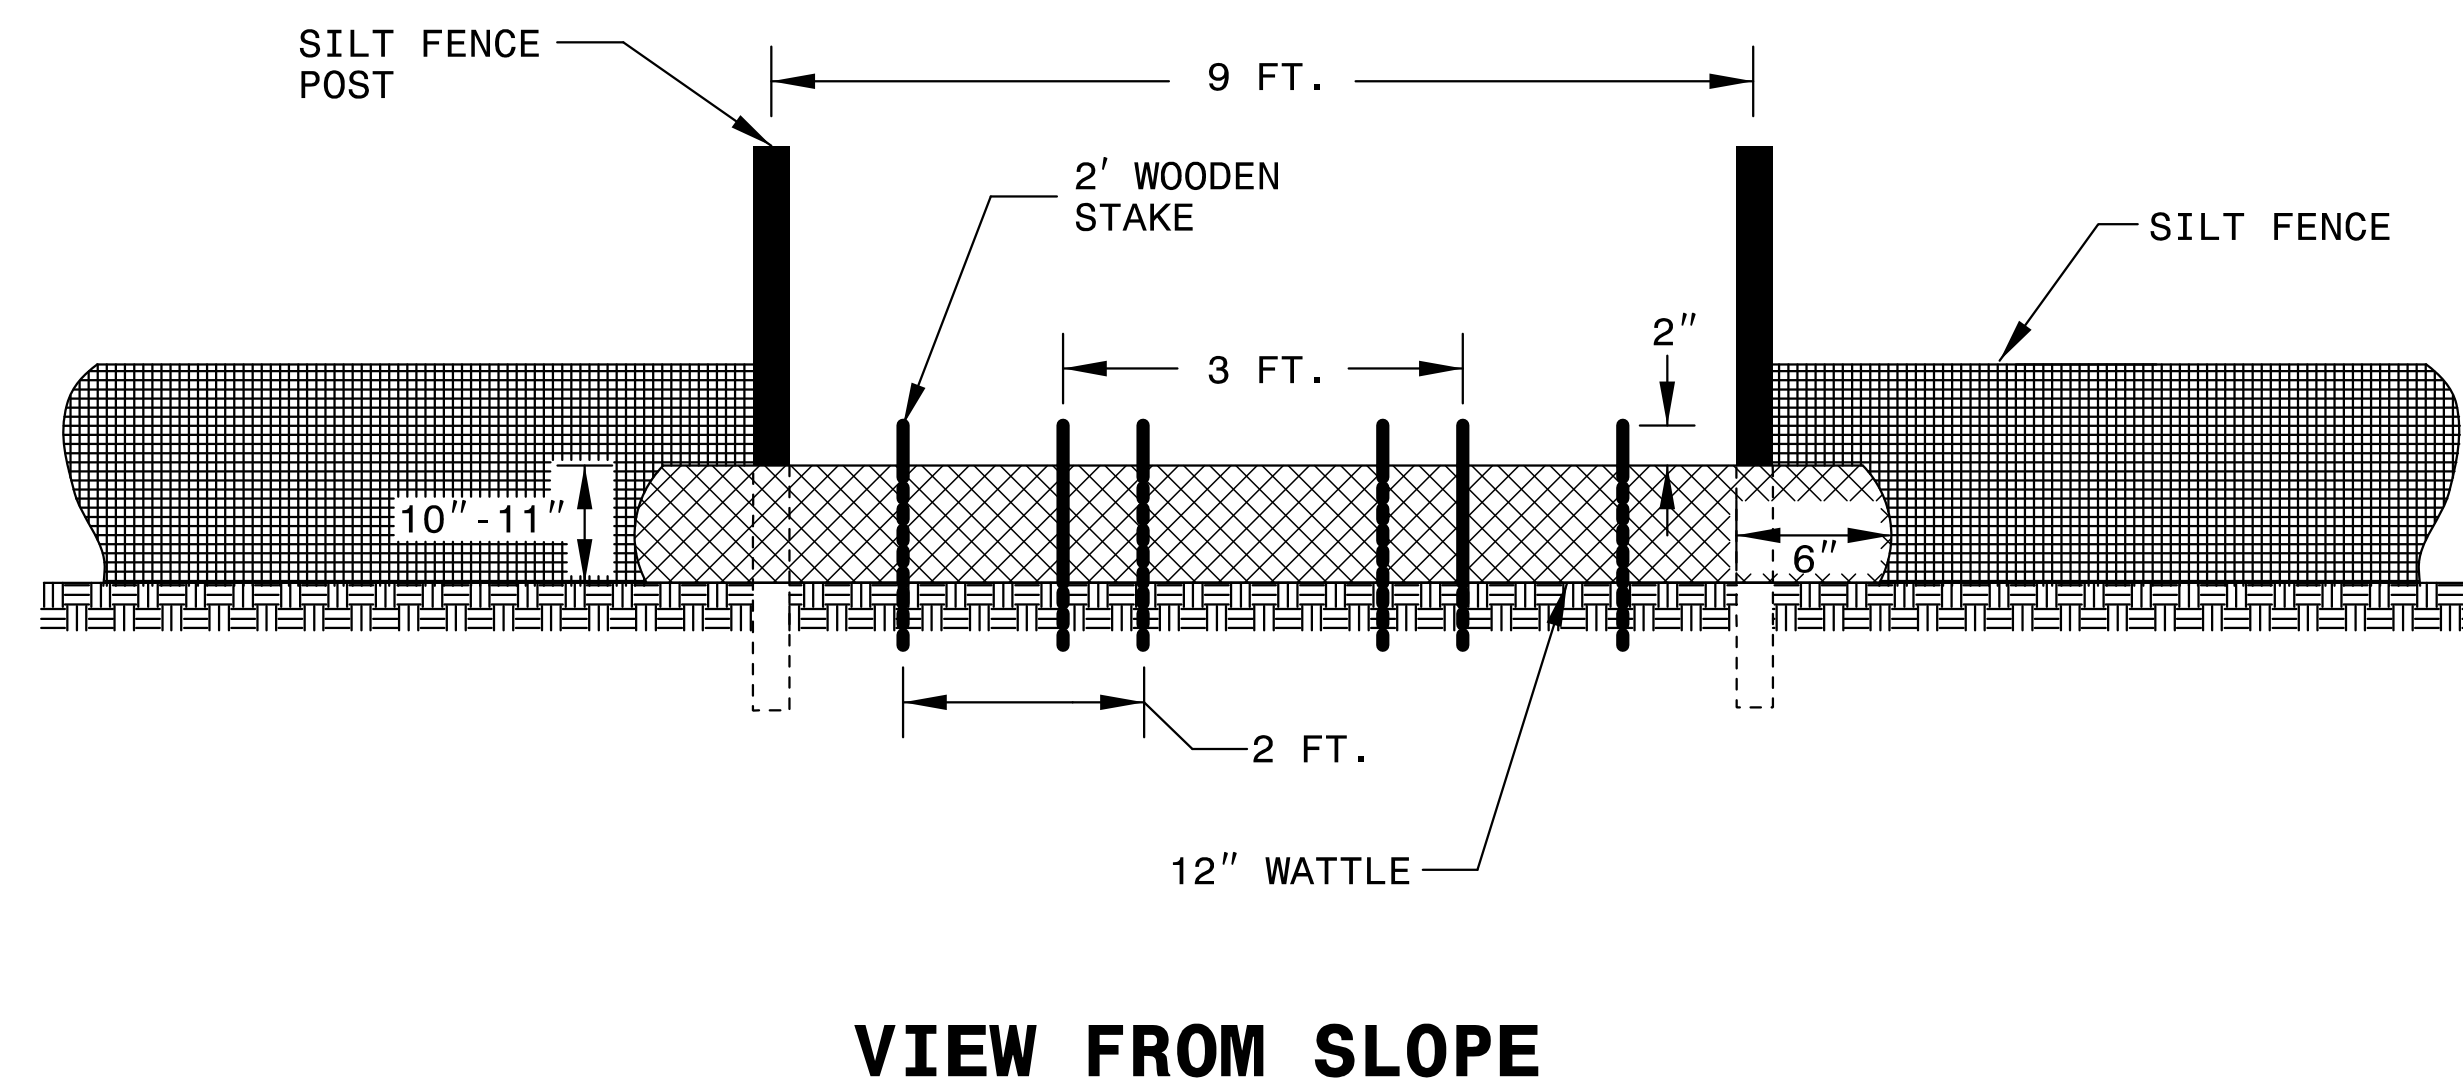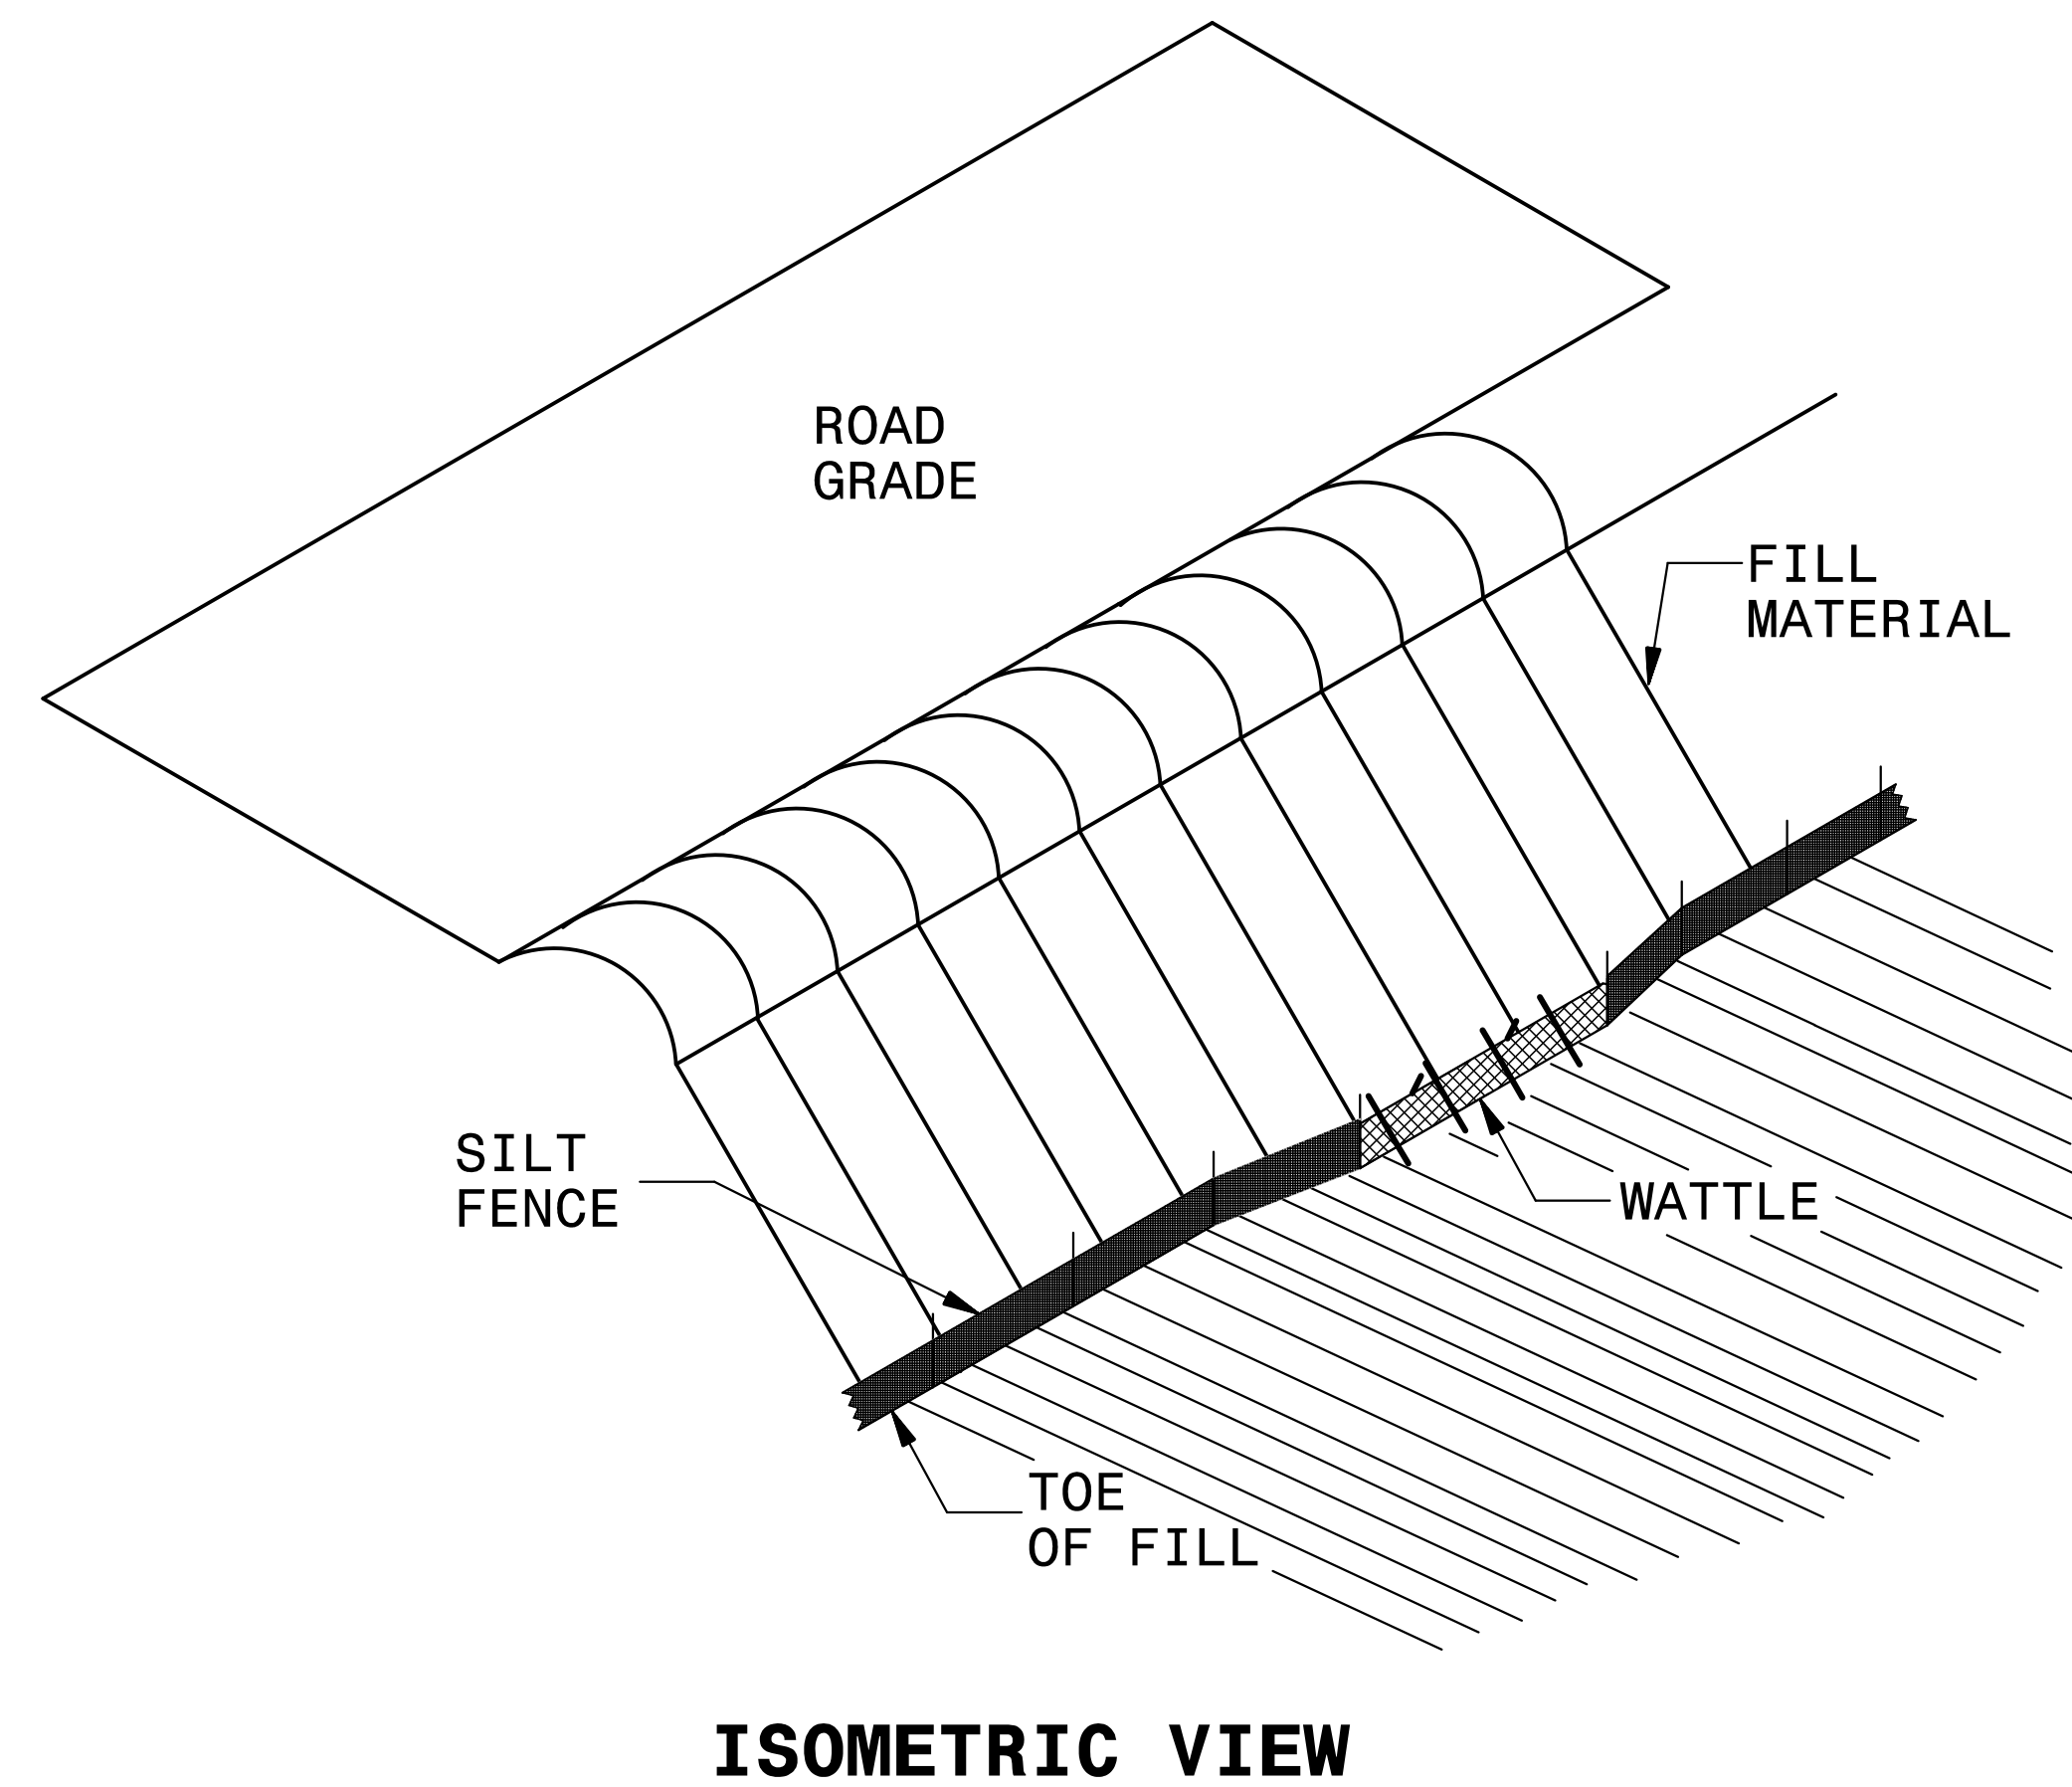

**NOTES:**

USE MINIMUM 12 IN. DIAMETER COIR FIBER (COCONUT FIBER) WATTLE AND LENGTH OF 10 FT.

EXCAVATE A 1 TO 2 INCH TRENCH FOR WATTLE TO BE PLACED.

DO NOT PLACE WATTLE ON TOE OF SLOPE.

USE 2 FT. WOODEN STAKES WITH A 2 IN. BY 2 IN. NOMINAL CROSS SECTION.

INSTALL A MINIMUM OF 2 UPSLOPE STAKES AND 4 DOWNSLOPE STAKES AT AN ANGLE TO WEDGE WATTLE TO GROUND.



PROVIDE STAPLES MADE OF 0.125 IN. DIAMETER STEEL WIRE FORMED INTO A U SHAPE NOT LESS THAN 12" IN LENGTH.

INSTALL STAPLES APPROXIMATELY EVERY 1 LINEAR FOOT ON BOTH SIDES OF WATTLE AND AT EACH END TO SECURE IT TO THE SOIL.


WATTLE INSTALLATION CAN BE ON OUTSIDE OF THE SILT FENCE AS DIRECTED.

INSTALL TEMPORARY SILT FENCE IN ACCORDANCE WITH SECTION 1605 OF THE STANDARD SPECIFICATIONS.


**INSET A**

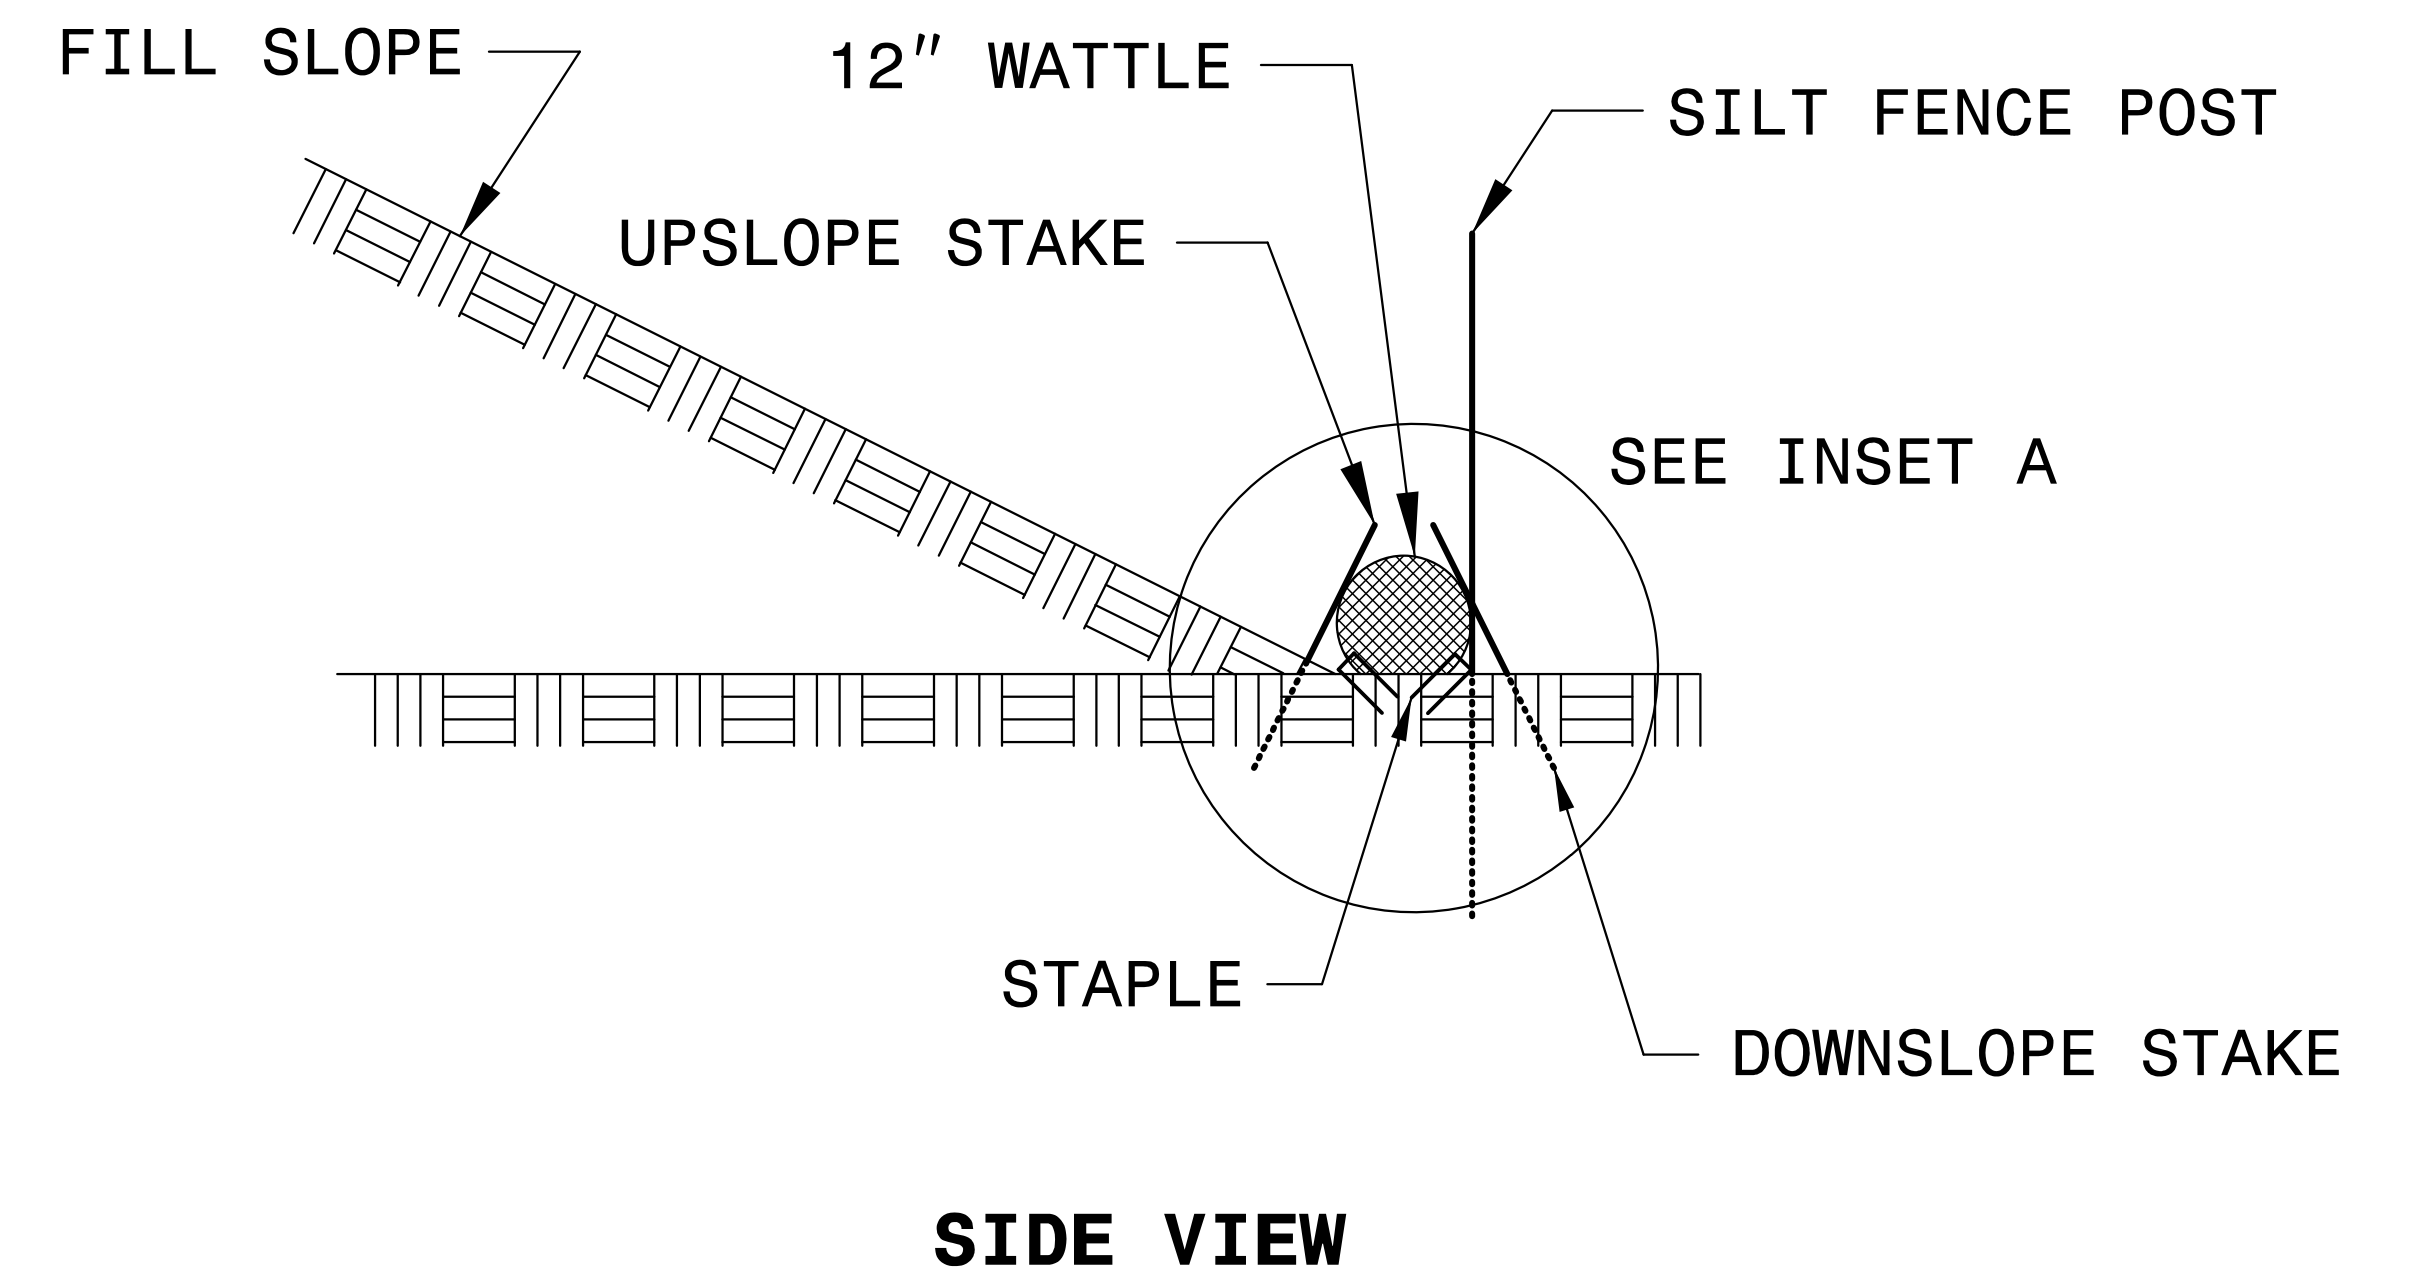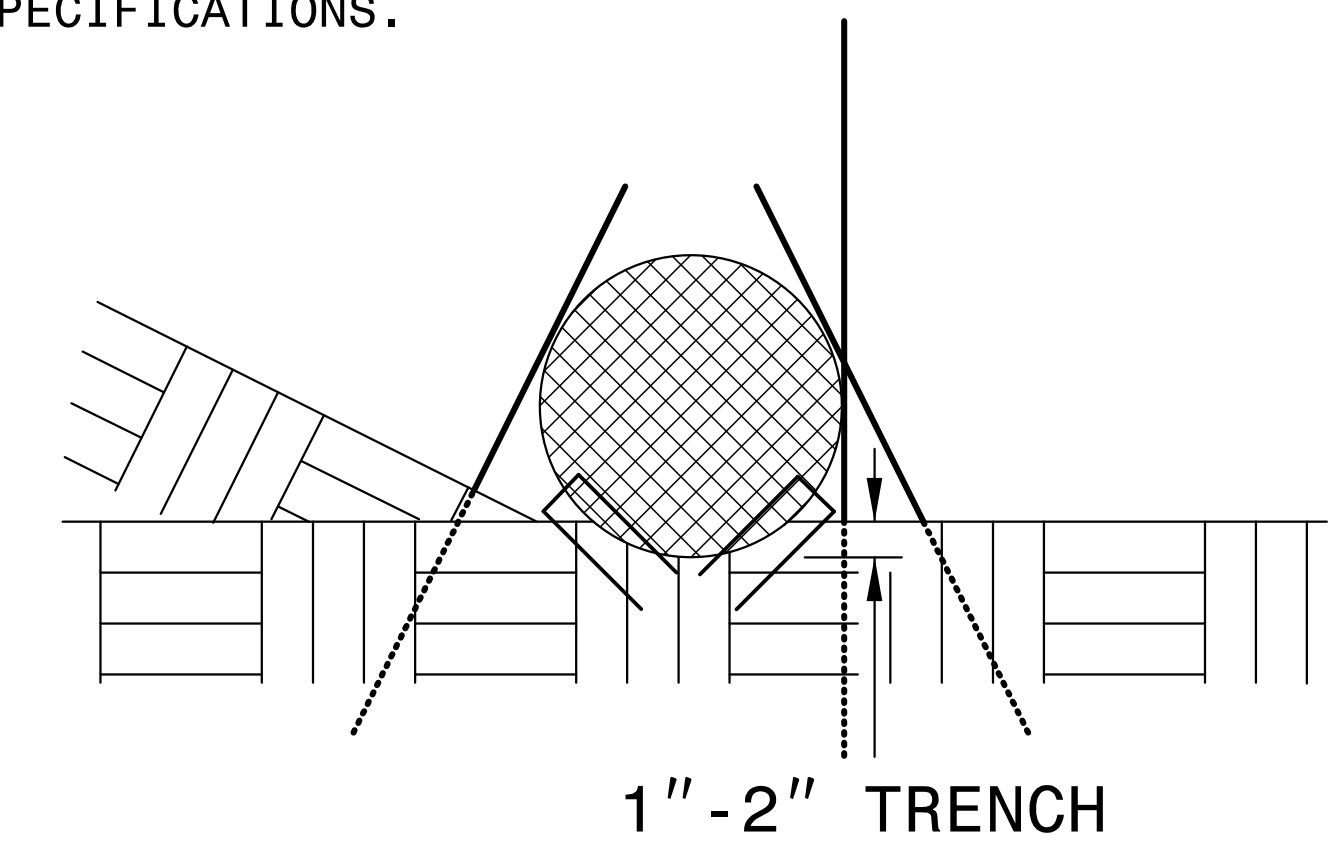

# COIR FIBER WATTLE BARRIER DETAIL

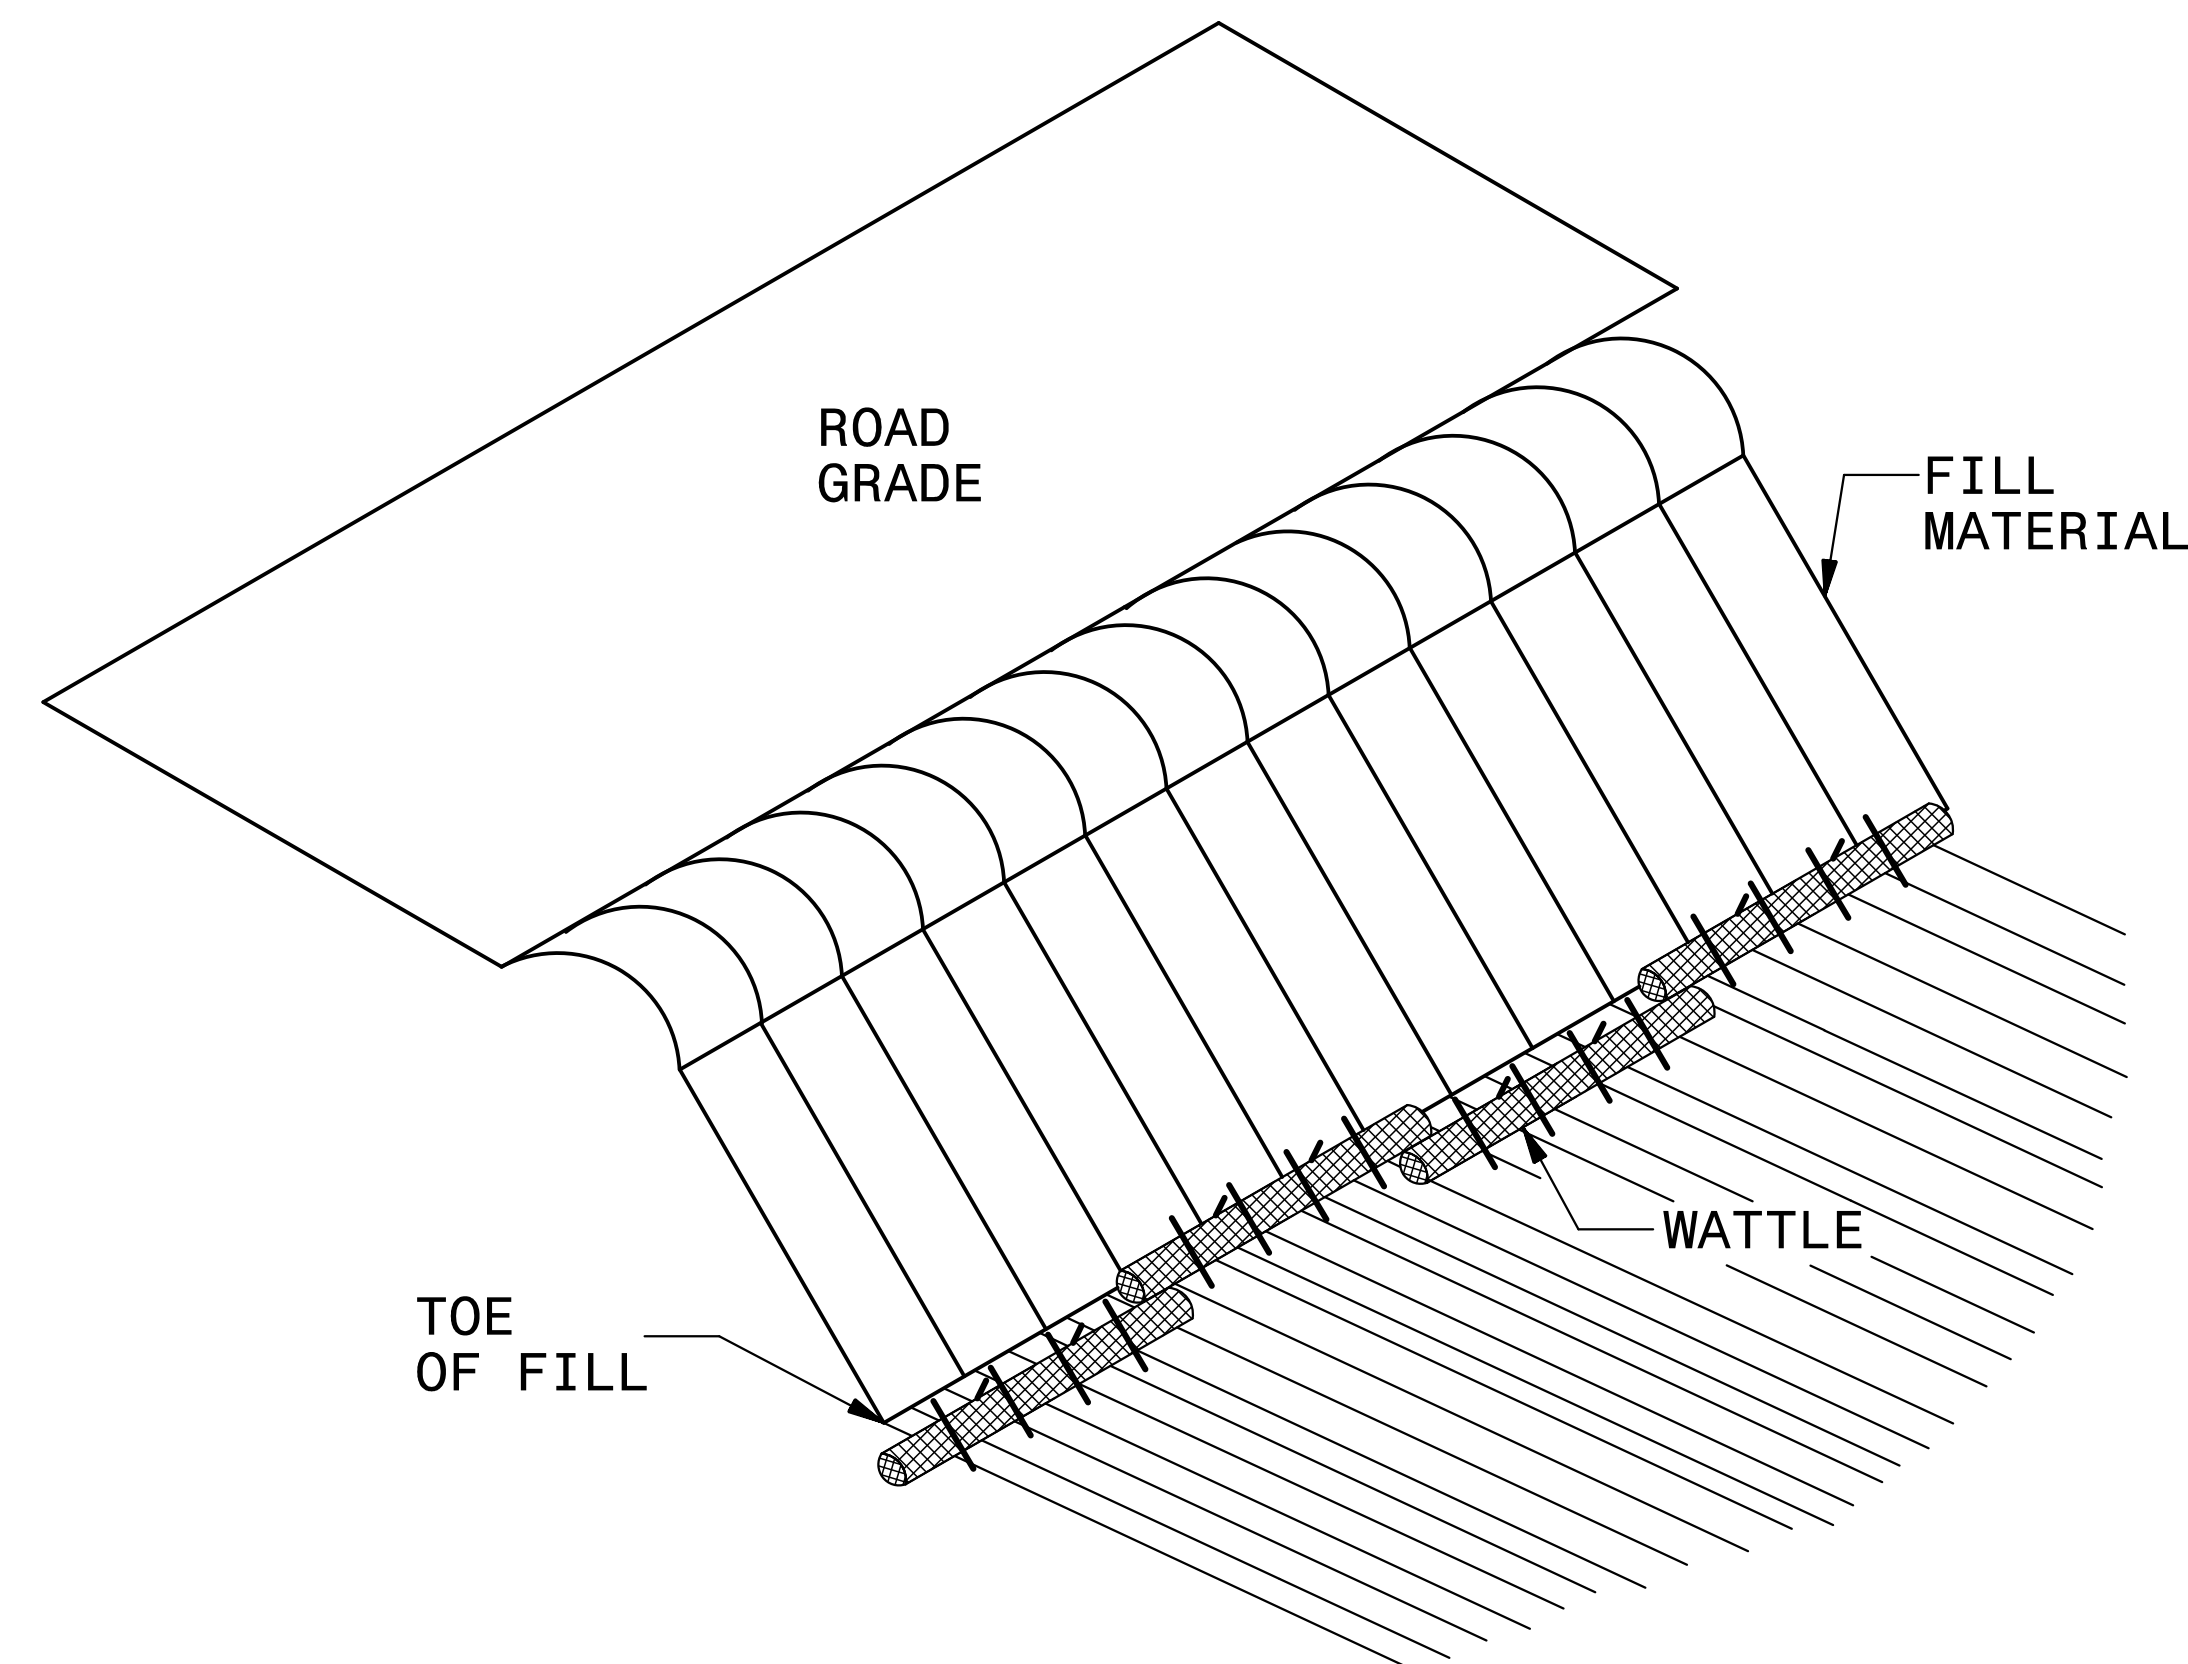

**ISOMETRIC VIEW**

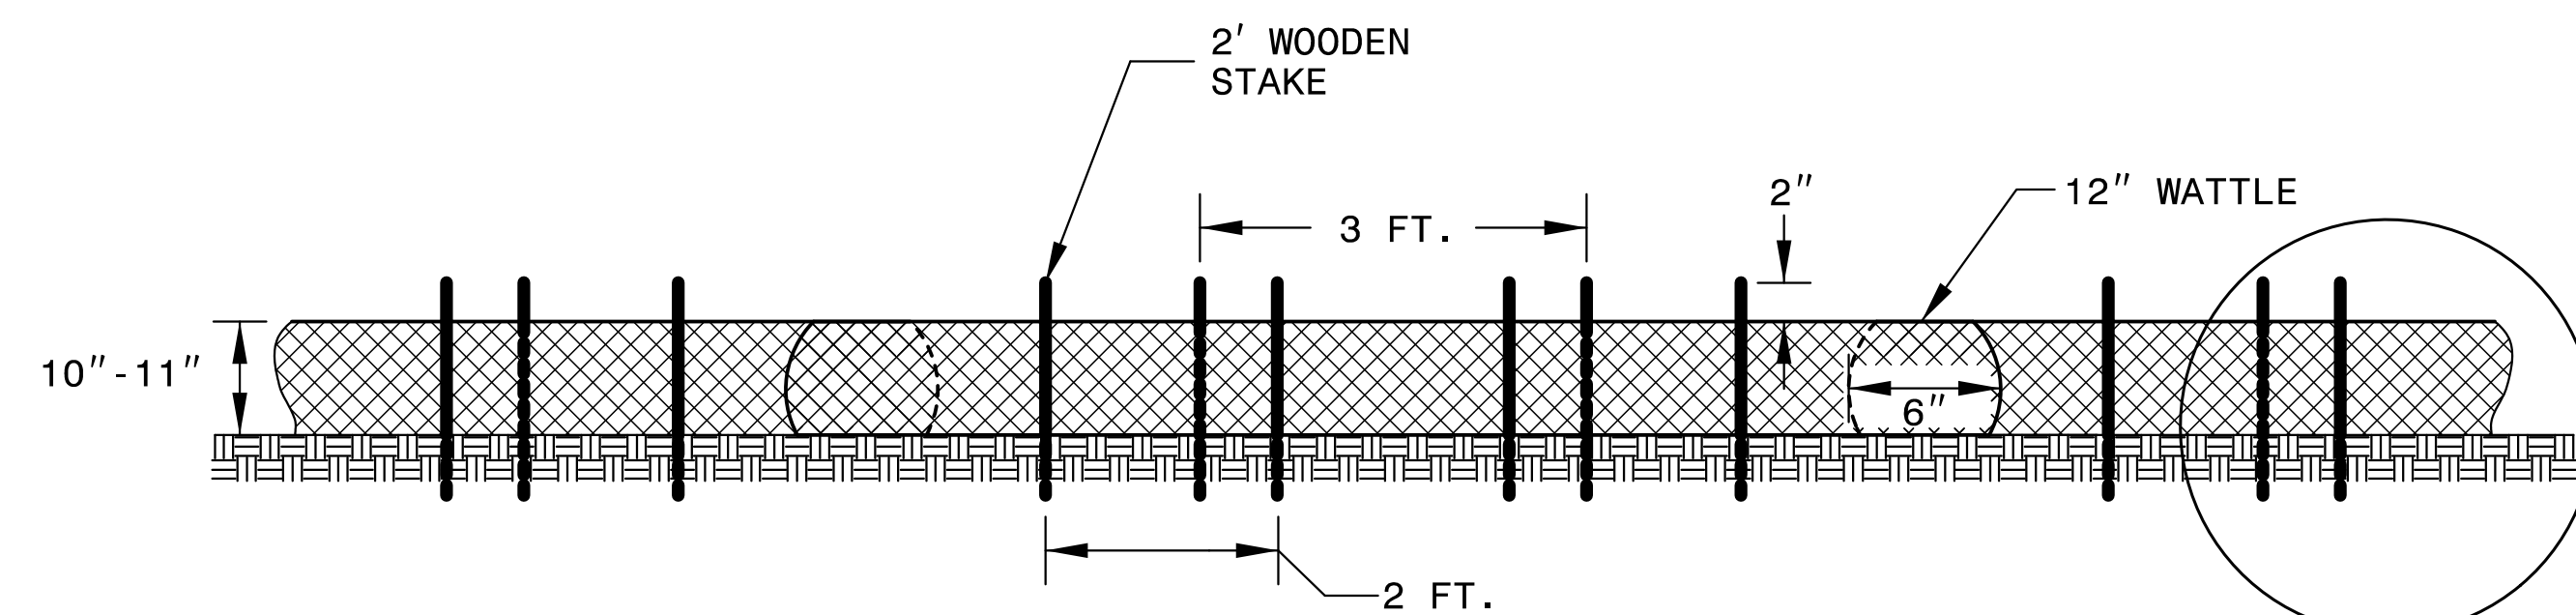

**FRONT VIEW**

**NOTES:**

USE MINIMUM 12 IN. DIAMETER COIR FIBER (COCONUT) WATTLE AND LENGTH OF 10 FT.

EXCAVATE A 1 TO 2 INCH TRENCH FOR WATTLE TO BE PLACED.

DO NOT PLACE WATTLES ON TOE OF SLOPE.



USE 2 FT. WOODEN STAKES WITH A 2 IN. BY 2 IN. NOMINAL CROSS SECTION.

INSTALL A MINIMUM OF 2 UPSLOPE STAKES AND 4 DOWNSLOPE STAKES AT AN ANGLE TO WEDGE WATTLE TO GROUND.

PROVIDE STAPLES MADE OF 0.125 IN. DIAMETER STEEL WIRE FORMED INTO A U SHAPE NOT LESS THAN 12" IN LENGTH.

INSTALL STAPLES APPROXIMATELY EVERY 1 LINEAR FOOT ON BOTH SIDES OF WATTLE AND AT EACH END TO SECURE IT TO THE SOIL.

FOR BREAKS ALONG LARGE SLOPES, USE MAXIMUM SPACING OF 20 FT.

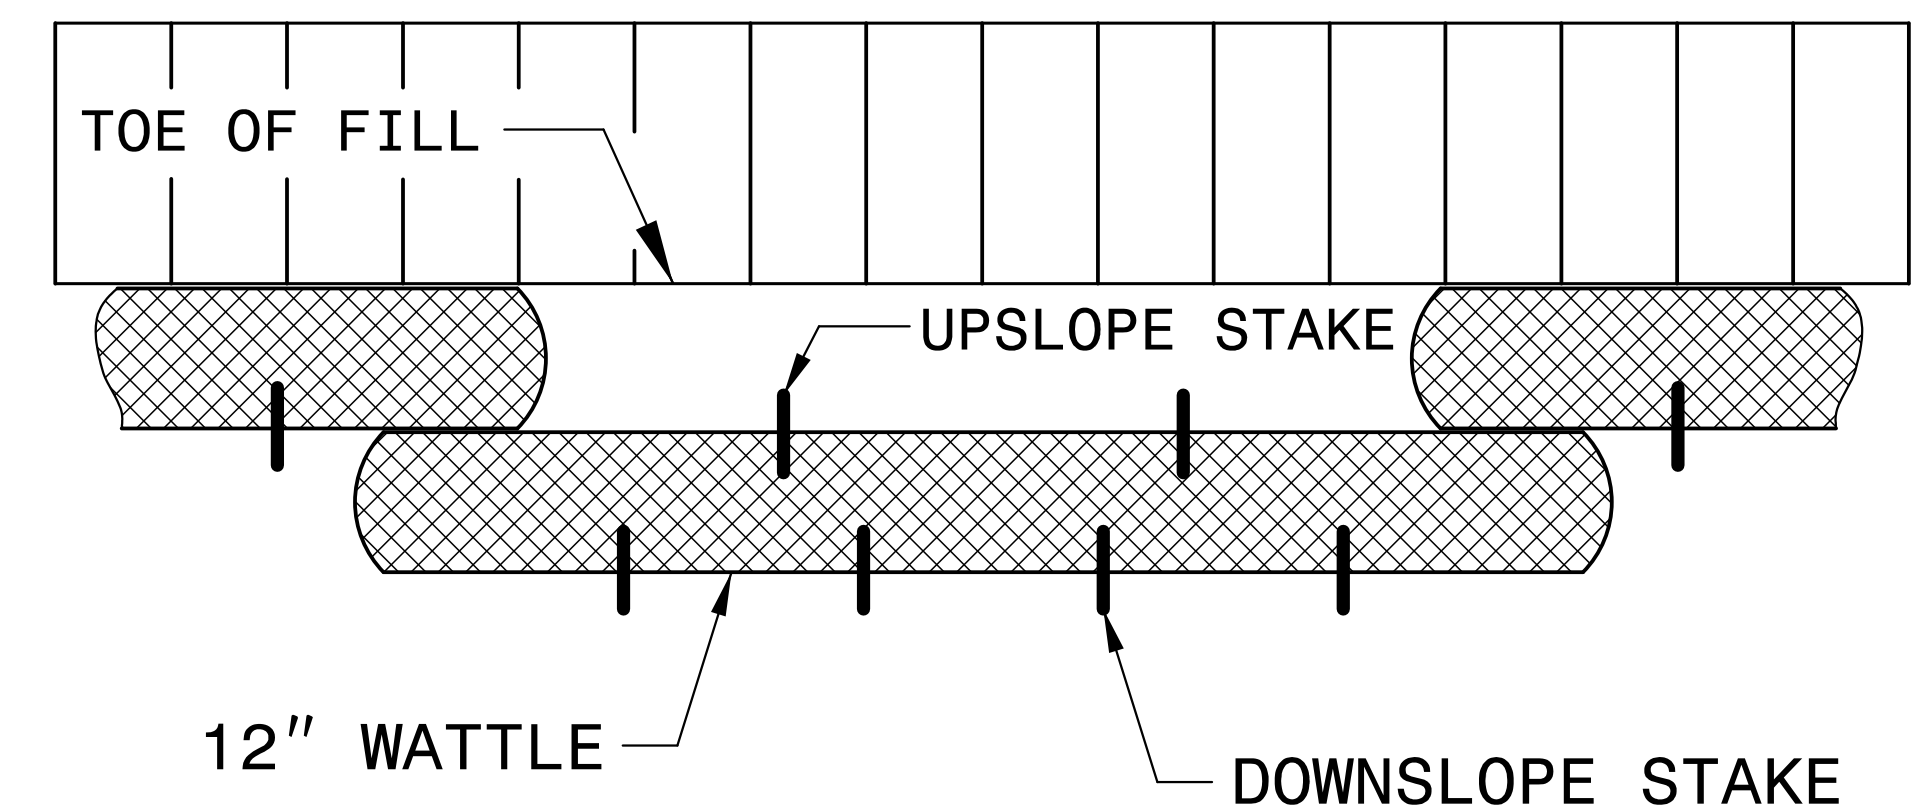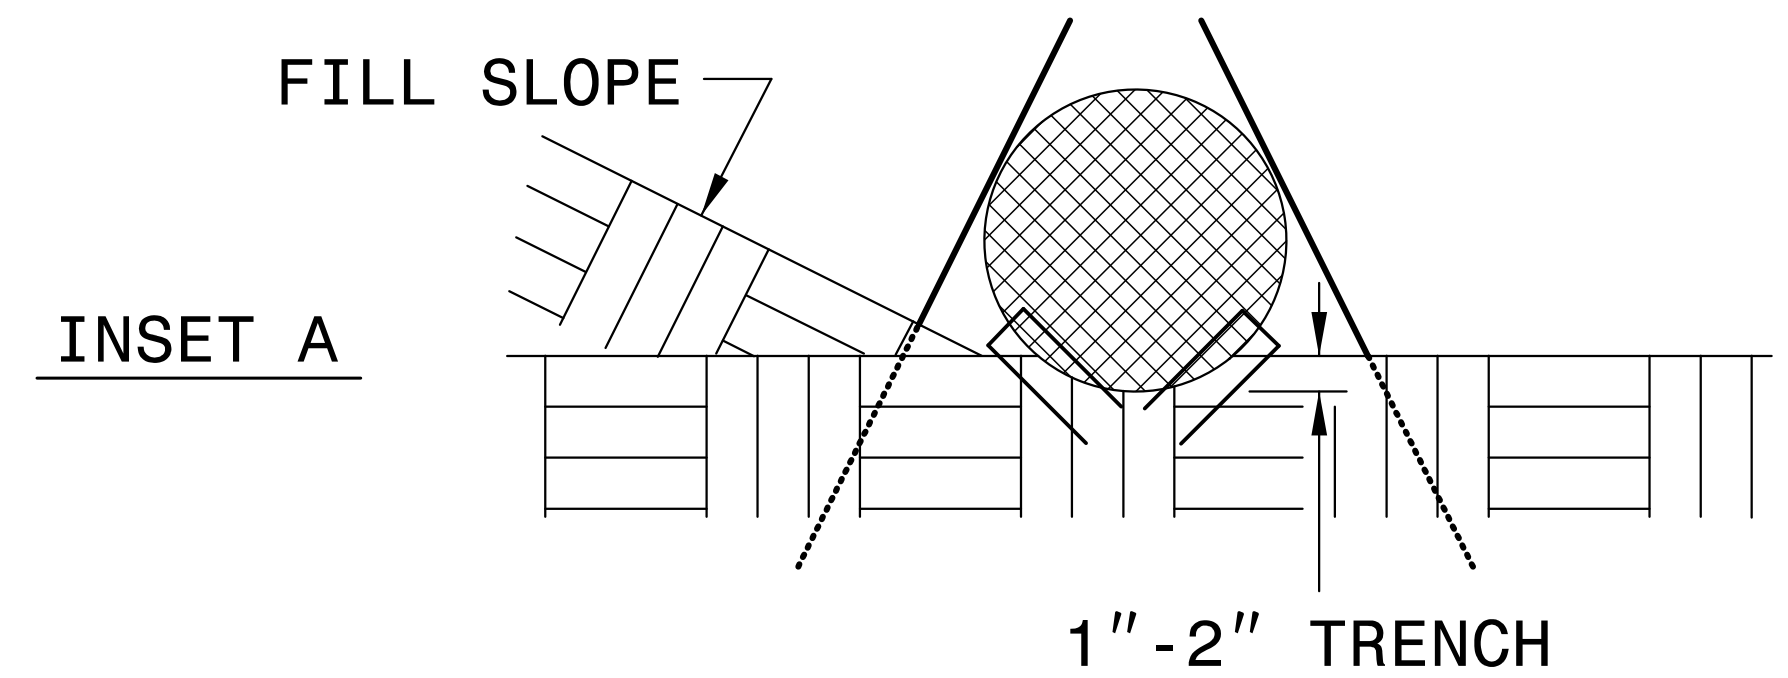

**TOP VIEW**

DIVISION OF HIGHWAYS  
STATE OF NORTH CAROLINA

---



---

## ***SOIL STABILIZATION TIMEFRAMES***


| <i>SITE DESCRIPTION</i>                      | <i>STABILIZATION TIME</i> | <i>TIMEFRAME EXCEPTIONS</i>  |
|--|---------------------------|--|
| PERIMETER DIKES, SWALES, DITCHES AND SLOPES  | 7 DAYS                    | NONE   |
| HIGH QUALITY WATER (HQW) ZONES               | 7 DAYS                    | NONE   |
| SLOPES STEEPER THAN 3:1                      | 7 DAYS                    | IF SLOPES ARE 10' OR LESS IN LENGTH AND ARE NOT STEEPER THAN 2:1, 14 DAYS ARE ALLOWED. |
| SLOPES 3:1 OR FLATTER                        | 14 DAYS                   | 7 DAYS FOR SLOPES GREATER THAN 50' IN LENGTH.  |
| ALL OTHER AREAS WITH SLOPES FLATTER THAN 4:1 | 14 DAYS                   | NONE, EXCEPT FOR PERIMETERS AND HQW ZONES.   |

# PLAN



**HNTB** HNTB NORTH CAROLINA, P.C.  
343 E. Six Forks Road, Suite 200  
Raleigh, North Carolina 27609  
NC License No: C-1554

PROJECT REFERENCE NO. **BD-5102U** SHEET NO. **EC-6**  
RW SHEET NO.


**BENTON R. CARROLL**  
**EROSION CONTROL**  
**LEVEL III-A**  
**CERTIFICATION #3180**

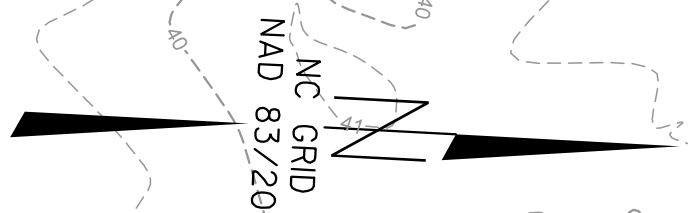

PI Sta 13+22.18 Δ = 9° 09' 03.5" (RT) D = 4' 48" 53.2" L = 190.06' T = 95.23' R = 1,190.00'  
 PI Sta 16+10.55 Δ = 7° 47' 49.0" (RT) D = 2' 01" 02.8" L = 386.47' T = 193.54' R = 2,840.00'  
 PI Sta 18+35.62 Δ = 2° 18' 04.4" (RT) D = 3' 34" 51.6" L = 64.26' T = 32.14' R = 1,600.00'

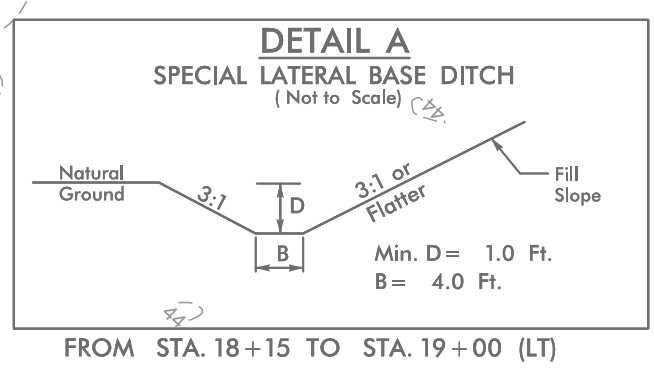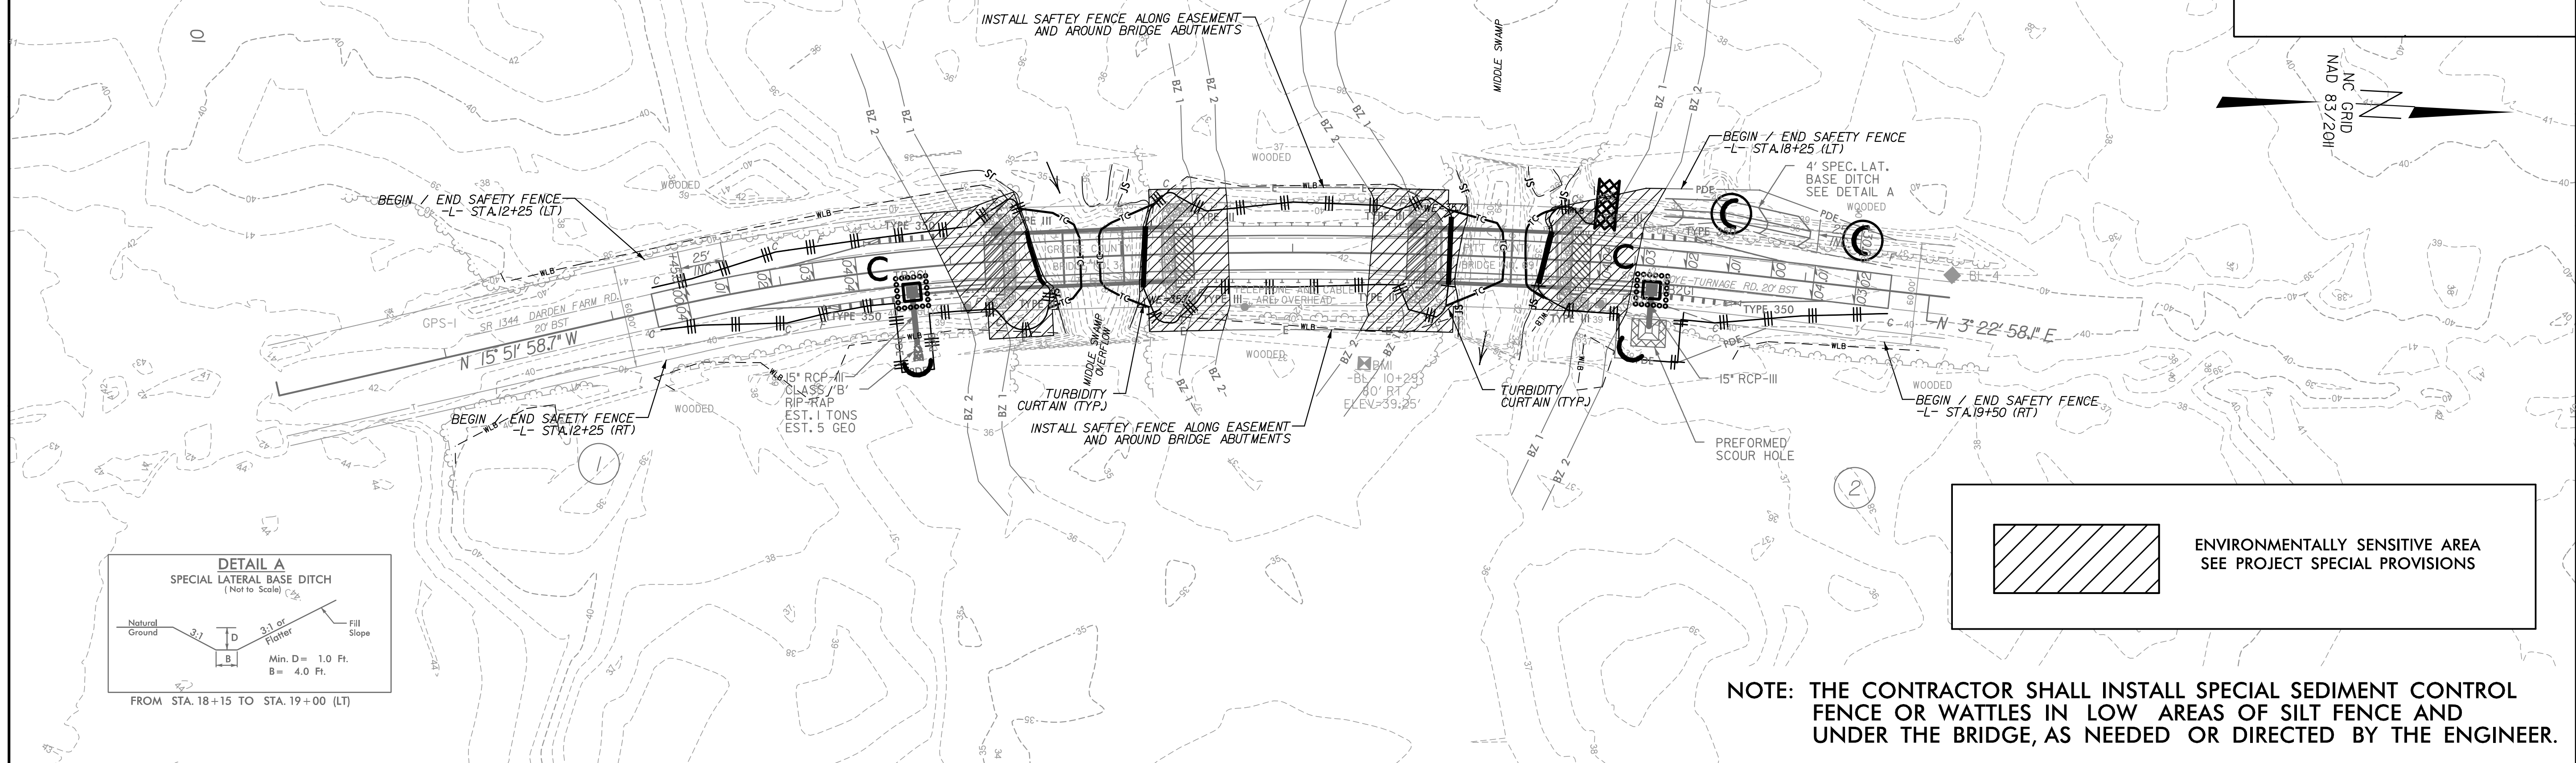

# PROFILE

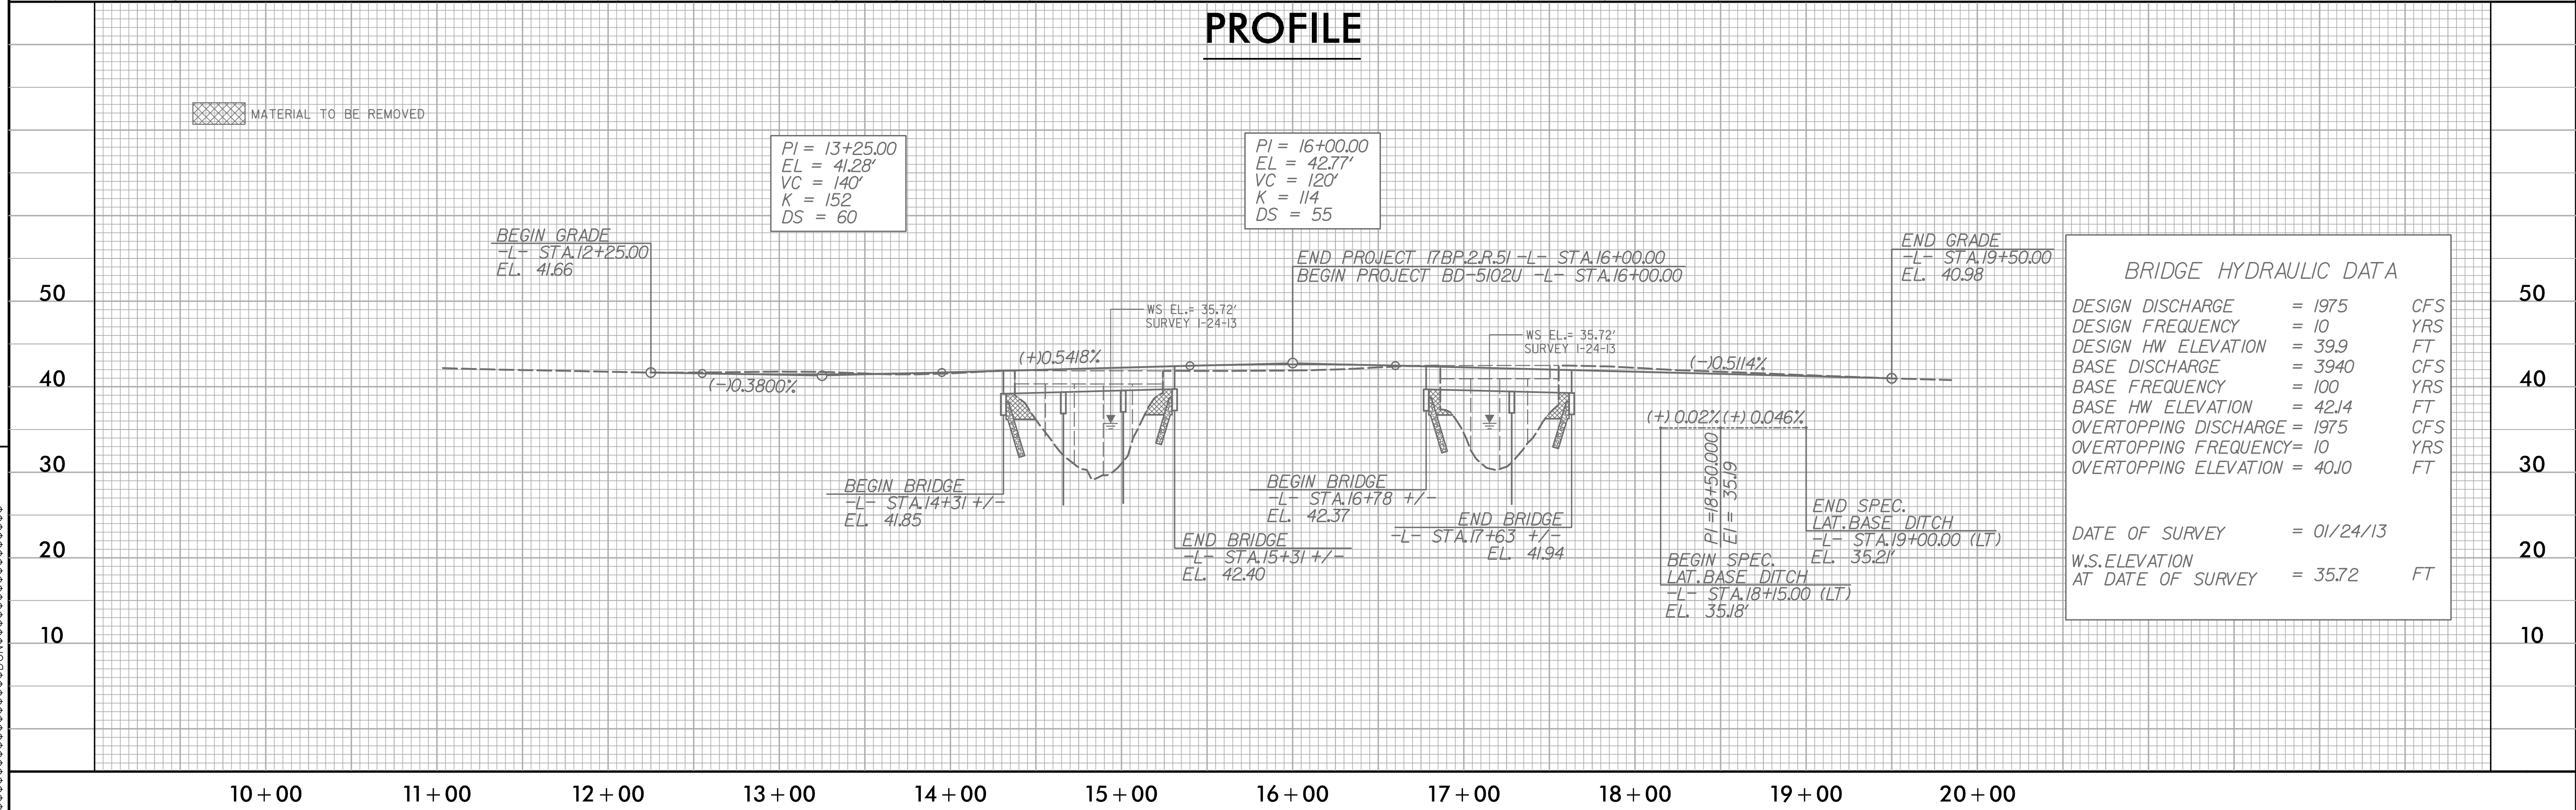

**BRIDGE HYDRAULIC DATA**

|                       |         |     |
|-----------------------|---------|-----|
| DESIGN DISCHARGE      | = 1975  | CFS |
| DESIGN FREQUENCY      | = 10    | YRS |
| DESIGN HW ELEVATION   | = 39.9  | FT  |
| BASE DISCHARGE        | = 3940  | CFS |
| BASE FREQUENCY        | = 100   | YRS |
| BASE HW ELEVATION     | = 42.14 | FT  |
| OVERTOPPING DISCHARGE | = 1975  | CFS |
| OVERTOPPING FREQUENCY | = 10    | YRS |
| OVERTOPPING ELEVATION | = 40.10 | FT  |

|                                  |            |
|----------------------------------|------------|
| DATE OF SURVEY                   | = 01/24/13 |
| W.S. ELEVATION AT DATE OF SURVEY | = 35.72 FT |

REVISIONS


\$\$\$\$\$DATE\$\$\$\$\$  
\$\$\$\$\$SYTIME\$\$\$\$\$  
\$\$\$\$\$SYTIME\$\$\$\$\$

## PLANTING DETAILS


### SEEDLING / LINER BAREROOT PLANTING DETAIL

#### HEALING IN


1. Locate a healing-in site in a shady, well protected area.
2. Excavate a flat bottom trench 12 inches deep and provide drainage.

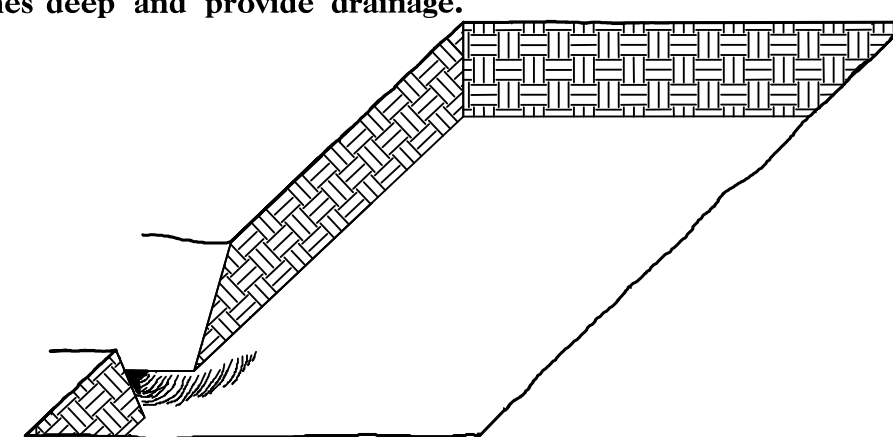


3. Backfill the trench with 2 inches well rotted sawdust. Place a 2 inch layer of well rotted sawdust at a sloping angle at one end of the trench.

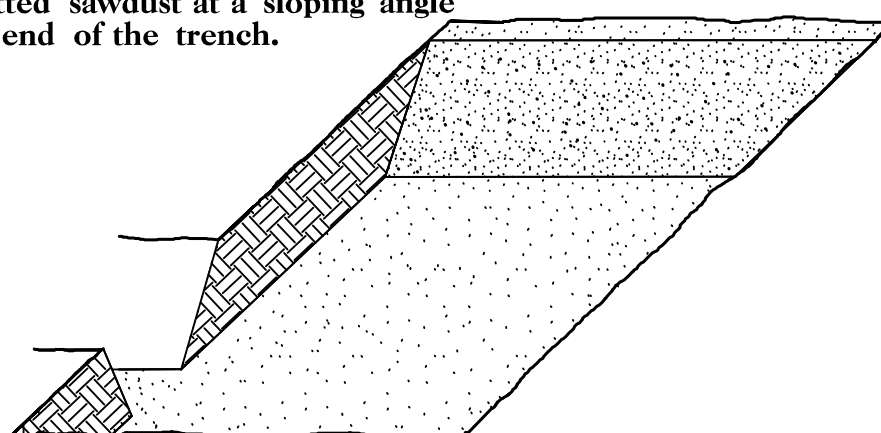

4. Place a single layer of plants against the sloping end so that the root collar is at ground level.

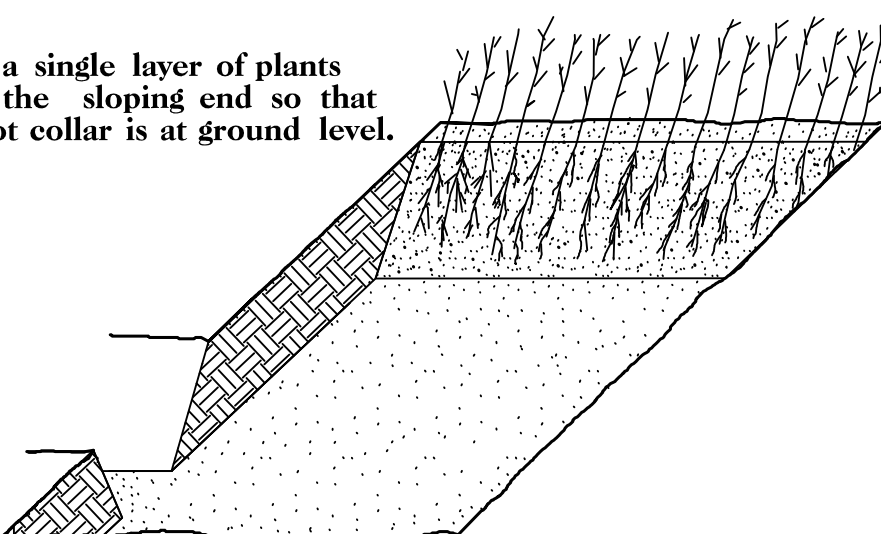


5. Place a 2 inch layer of well rotted sawdust over the roots maintaining a sloping angle.

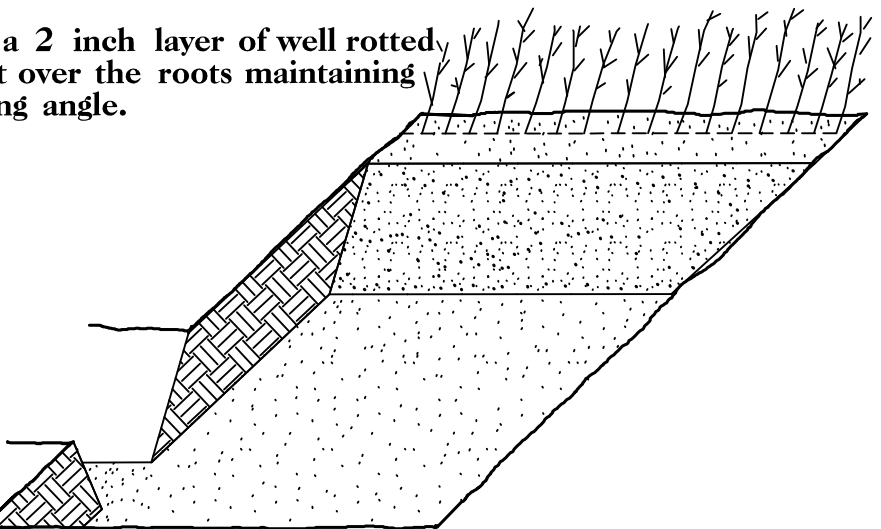


6. Repeat layers of plants and sawdust as necessary and water thoroughly.


#### DIBBLE PLANTING METHOD USING THE KBC PLANTING BAR

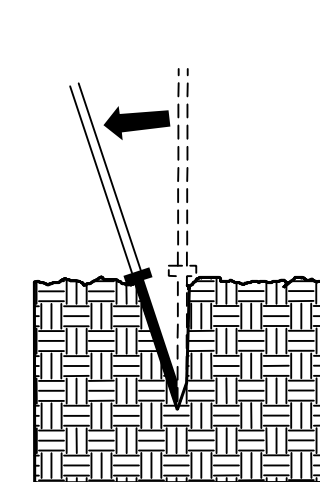


1. Insert planting bar as shown and pull handle toward planter.

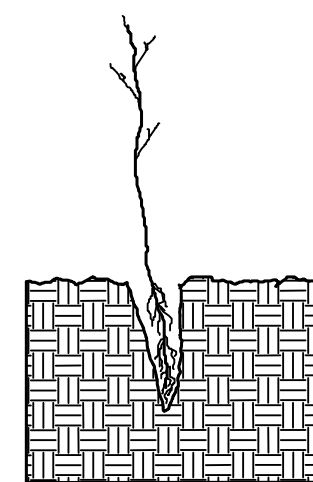


2. Remove planting bar and place seedling at correct depth.

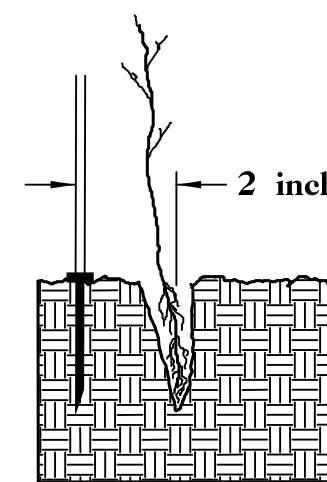


3. Insert planting bar 2 inches toward planter from seedling.

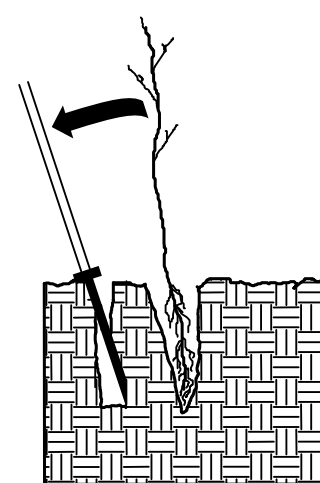

4. Pull handle of bar toward planter, firming soil at bottom.

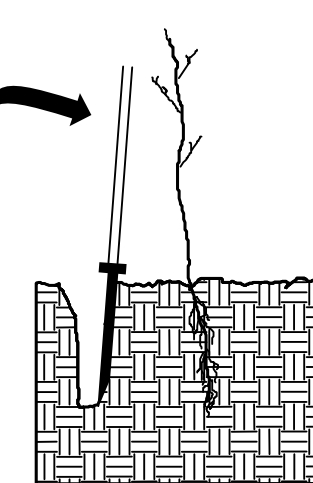

5. Push handle forward firming soil at top.

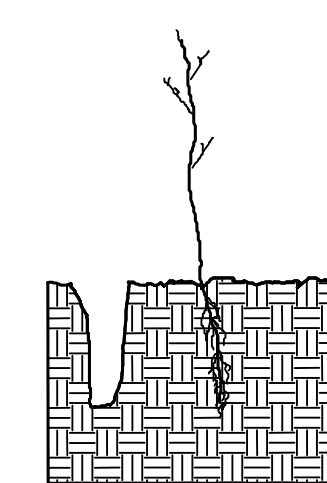


6. Leave compaction hole open. Water thoroughly.

#### PLANTING NOTES:

**PLANTING BAG**  
During planting, seedlings shall be kept in a moist canvas bag or similar container to prevent the root systems from drying.



**KBC PLANTING BAR**  
Planting bar shall have a blade with a triangular cross section, and shall be 12 inches long, 4 inches wide and 1 inch thick at center.

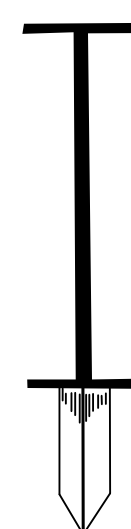

**ROOT PRUNING**  
All seedlings shall be root pruned, if necessary, so that no roots extend more than 10 inches below the root collar.

## REFORESTATION

- TREE REFORESTATION SHALL BE PLANTED 6 FT. TO 10 FT. ON CENTER, RANDOM SPACING, AVERAGING 8 FT. ON CENTER, APPROXIMATELY 680 PLANTS PER ACRE.


#### REFORESTATION

MIXTURE, TYPE, SIZE, AND FURNISH SHALL CONFORM TO THE FOLLOWING:

|     |                         |              |                  |
|-----|-------------------------|--------------|------------------|
| 25% | LIRIODENDRON TULIPIFERA | TULIP POPLAR | 12 in - 18 in BR |
| 25% | PLATANUS OCCIDENTALIS   | SYCAMORE     | 12 in - 18 in BR |
| 25% | FRAXINUS PENNSYLVANICA  | GREEN ASH    | 12 in - 18 in BR |
| 25% | BETULA NIGRA            | RIVER BIRCH  | 12 in - 18 in BR |

## REFORESTATION DETAIL SHEET

N.C.D.O.T. - ROADSIDE ENVIRONMENTAL UNIT

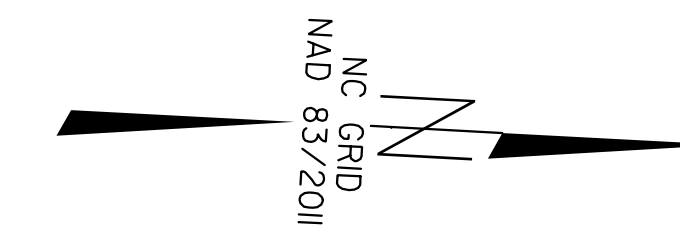

10



15

**Q2**  
 PERMANENT WETLAND IMPACTS = <0.01 Ac /53 SF  
 MECHANIZED CLEARING IN WETLANDS = <0.01 Ac /111 SF  
 PERMANENT STREAM IMPACTS = 0 LF  
 TEMPORARY STREAM IMPACTS = 0 LF  
 BUFFER ZONE 1 IMPACTS = 670 SF  
 BUFFER ZONE 2 IMPACTS = 172 SF

**Q1**  
 PERMANENT WETLAND IMPACTS = <0.01 Ac /134 SF  
 MECHANIZED CLEARING IN WETLANDS = <0.01 Ac /392 SF  
 PERMANENT STREAM IMPACTS = 0 LF  
 TEMPORARY STREAM IMPACTS = 0 LF  
 BUFFER ZONE 1 IMPACTS = 880 SF  
 BUFFER ZONE 2 IMPACTS = 632 SF

**Q3**  
 PERMANENT WETLAND IMPACTS = <0.01 Ac /145 SF  
 MECHANIZED CLEARING IN WETLANDS = 0.02 Ac /920 SF  
 PERMANENT STREAM IMPACTS = 0 LF  
 TEMPORARY STREAM IMPACTS = 0 LF  
 BUFFER ZONE 1 IMPACTS = 1368 SF  
 BUFFER ZONE 2 IMPACTS = 463 SF

**Q4**  
 PERMANENT WETLAND IMPACTS = 0.0 Ac /0 SF  
 MECHANIZED CLEARING IN WETLANDS = <0.01 Ac /220 SF  
 PERMANENT STREAM IMPACTS = 0 LF  
 TEMPORARY STREAM IMPACTS = 0 LF  
 BUFFER ZONE 1 IMPACTS = 940 SF  
 BUFFER ZONE 2 IMPACTS = 395 SF

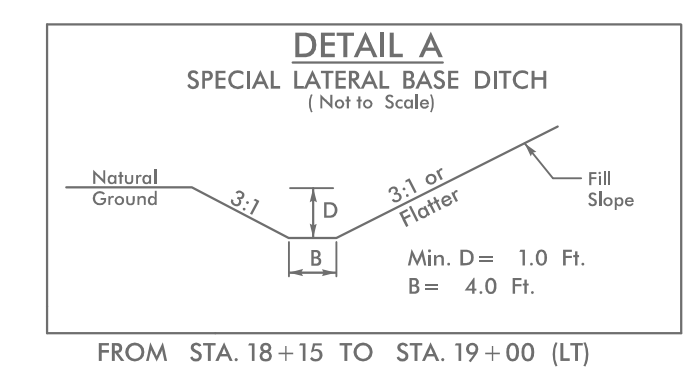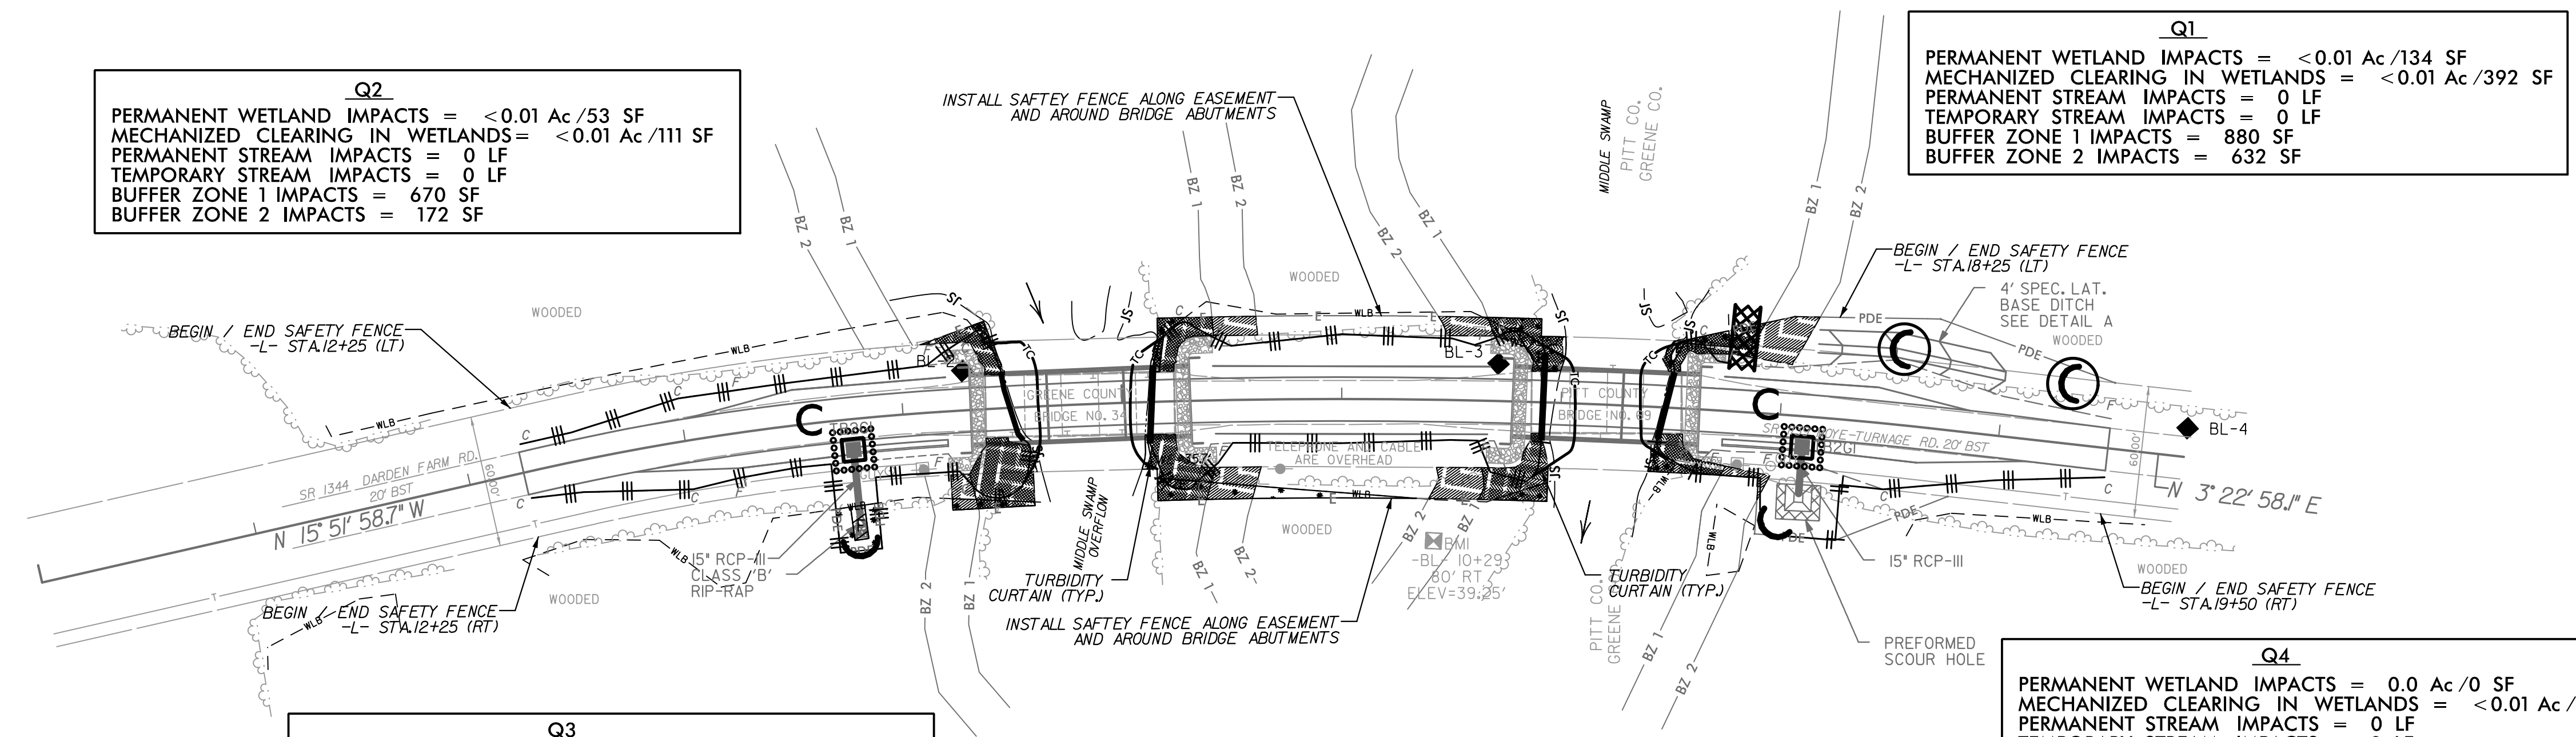

**IMPACT SUMMARY:**  
 404 WETLAND IMPACTS = 0.06 AC  
 STREAM IMPACTS = 0 FT.  
 BUFFER ZONE 1 IMPACT = 3858 SQ. FT.  
 BUFFER ZONE 2 IMPACT = 1662 SQ. FT.

- LEGEND**
- ALLOWABLE IMPACTS ZONE 1
  - ALLOWABLE IMPACTS ZONE 2
  - DENOTES FILL IN WETLAND
  - DENOTES EXCAVATION IN WETLAND
  - DENOTES MECHANIZED CLEARING

**NCDOT**  
 BD-5102U & 17BP.2.R.51  
 PITT & GREENE COUNTY  
 REPLACE BRIDGE NO. 0069 & 0034  
 SR 1139 (MOYE-TURNAGE RD.) &  
 SR 1344 (DARDEN FARM RD.)  
 OVER MIDDLE SWAMP CREEK  
 BETWEEN SR 1335  
 AND SR US HWY 13

SCALE: 1" = 50'  
 OCTOBER 29, 2013  
 FOR PERMITTING ONLY:  
 NOT FOR CONSTRUCTION



Note: Approximate quantities only. Unclassified Excavation, Borrow Excavation, Shoulder Borrow, Fine Grading, Clearing and Grubbing, Breaking of Existing Pavement, and Removal of Existing Pavement will be paid for at the contract lump sum price for "Grading."

STATE OF NORTH CAROLINA  
DIVISION OF HIGHWAYS

**CROSS-SECTION SUMMARY**  
*IN CUBIC YARDS*

NOTE: EMBANKMENT COLUMN DOES NOT INCLUDE BACKFILL FOR UNDERCUT




| STATION           | UNCLASSIFIED EXCAVATION | EMBANK. | UNDERCUT |
|-------------------|-------------------------|---------|----------|
| -L- STA. 12+00.00 | 0                       | 0       | 0        |
| -L- STA. 12+50.00 | 18                      | 0       | 0        |
| -L- STA. 13+00.00 | 44                      | 0       | 0        |
| -L- STA. 13+50.00 | 48                      | 1       | 0        |
| -L- STA. 14+00.00 | 36                      | 5       | 0        |
| -L- STA. 14+50.00 | 93                      | 7       | 0        |
| -L- STA. 15+00.00 | 6                       | 0       | 0        |
| -L- STA. 15+50.00 | 165                     | 9       | 0        |
| -L- STA. 16+00.00 | 7                       | 39      | 0        |
| -L- STA. 16+50.00 | 15                      | 36      | 0        |
| -L- STA. 17+00.00 | 137                     | 10      | 0        |
| -L- STA. 17+50.00 | 4                       | 0       | 0        |
| -L- STA. 18+00.00 | 154                     | 3       | 0        |
| -L- STA. 18+50.00 | 63                      | 22      | 0        |
| -L- STA. 19+00.00 | 50                      | 22      | 0        |
| -L- STA. 19+50.00 | 36                      | 1       | 0        |

02/03/98

| PROJ. REFERENCE NO. | SHEET NO. | TOTAL SHEETS |
|---------------------|-----------|--------------|
| BD-5102U            | X-2       | 7            |

75 70 65 60 55 50 45 40 35 30 25 20 15 10 5 0 5 10 15 20 25 30 35 40 45 50

C

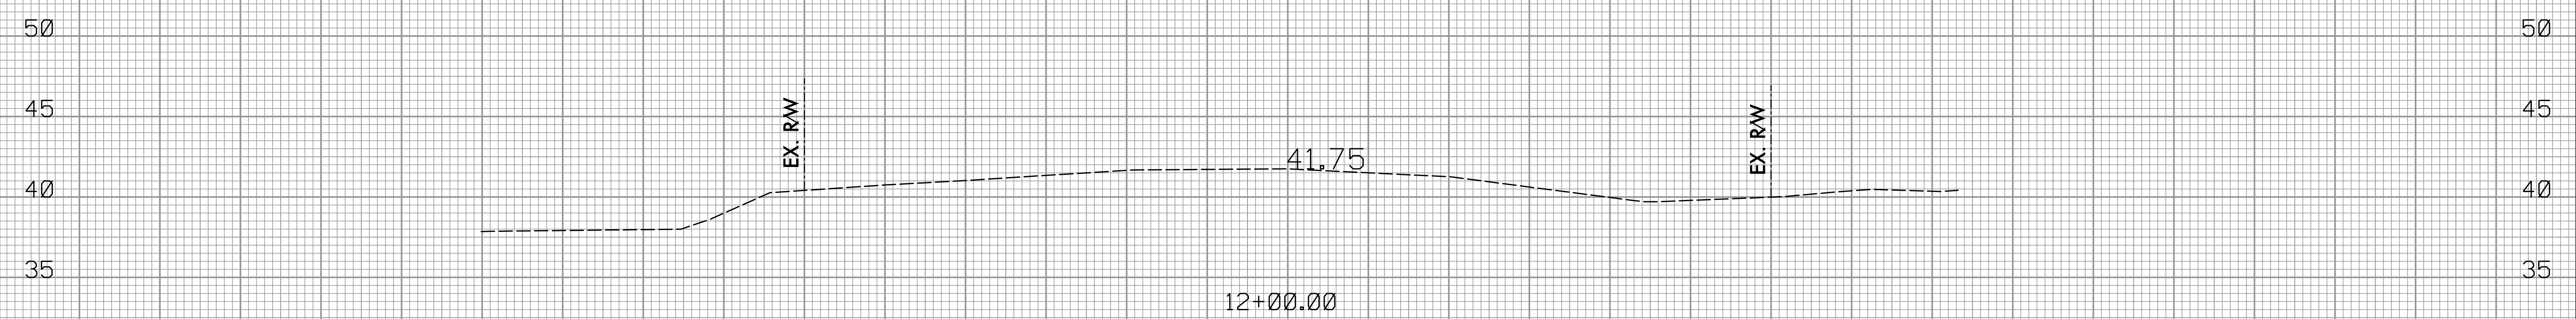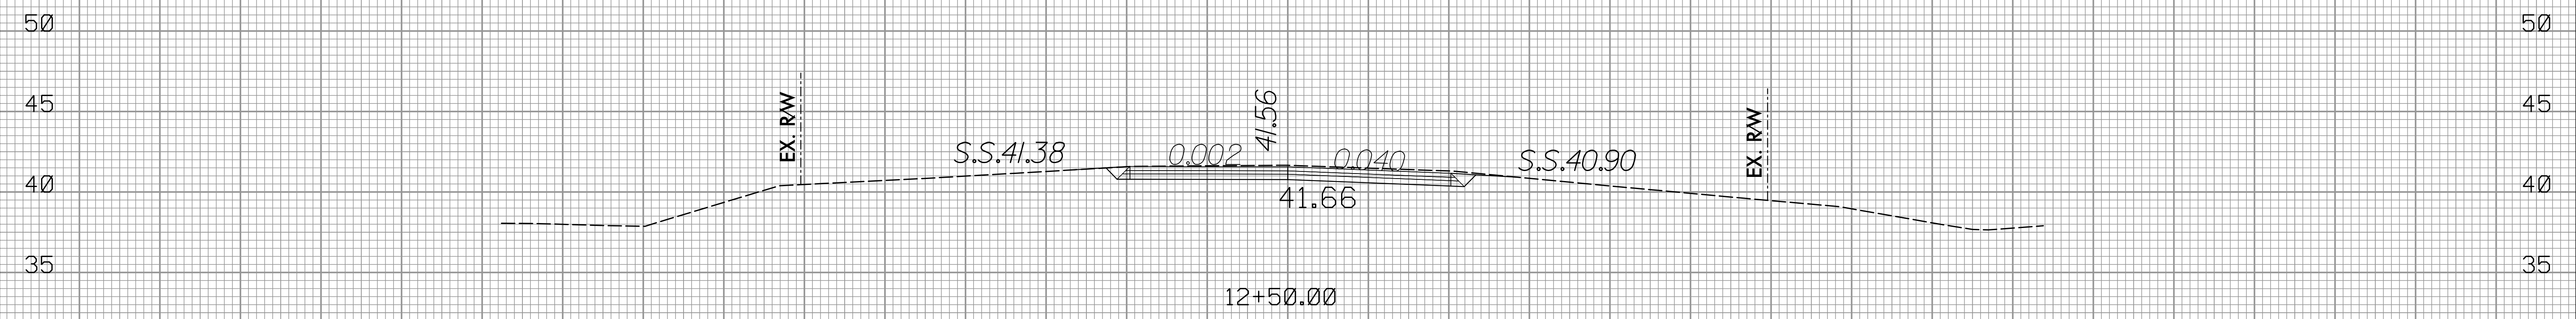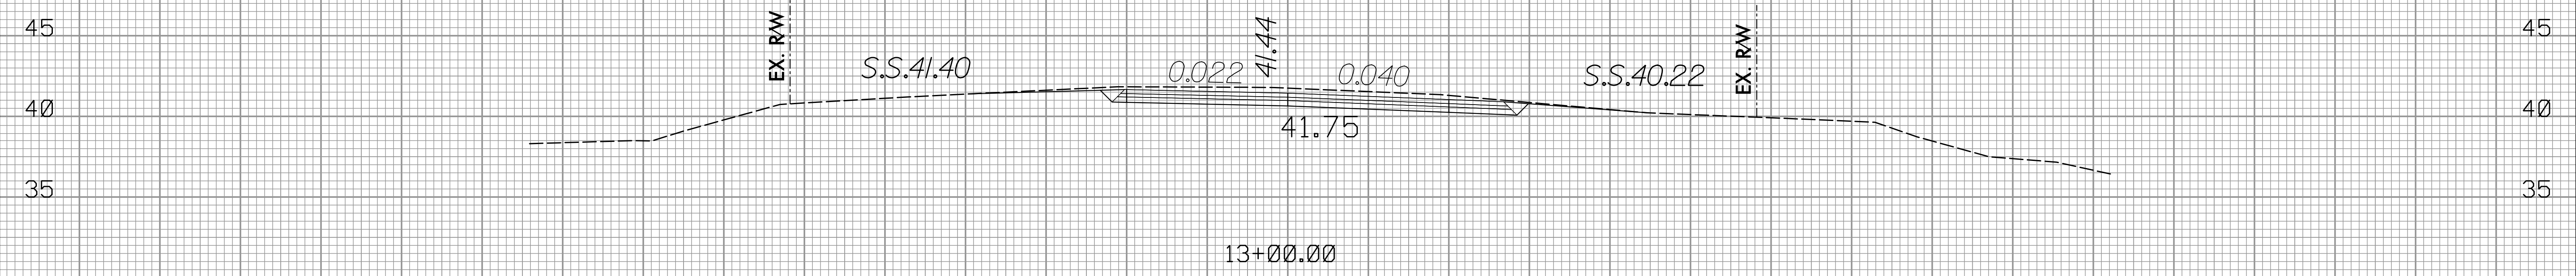




75 70 65 60 55 50 45 40 35 30 25 20 15 10 5 0 5 10 15 20 25 30 35 40 45 50 55 60 65 70 75

6:02:48 PM 05/02/98  
 \$\$\$USFRN(X)C\$\$\$  
 6:02:48 PM 05/02/98

02/03/98

| PROJ. REFERENCE NO. | SHEET NO. | TOTAL SHEETS |
|---------------------|-----------|--------------|
| BD-5102U            | X-3       | 7            |

75 70 65 60 55 50 45 40 35 30 25 20 15 10 5 0 5 10 15 20 25 30 35 40 45 50 55 60 65 70 75

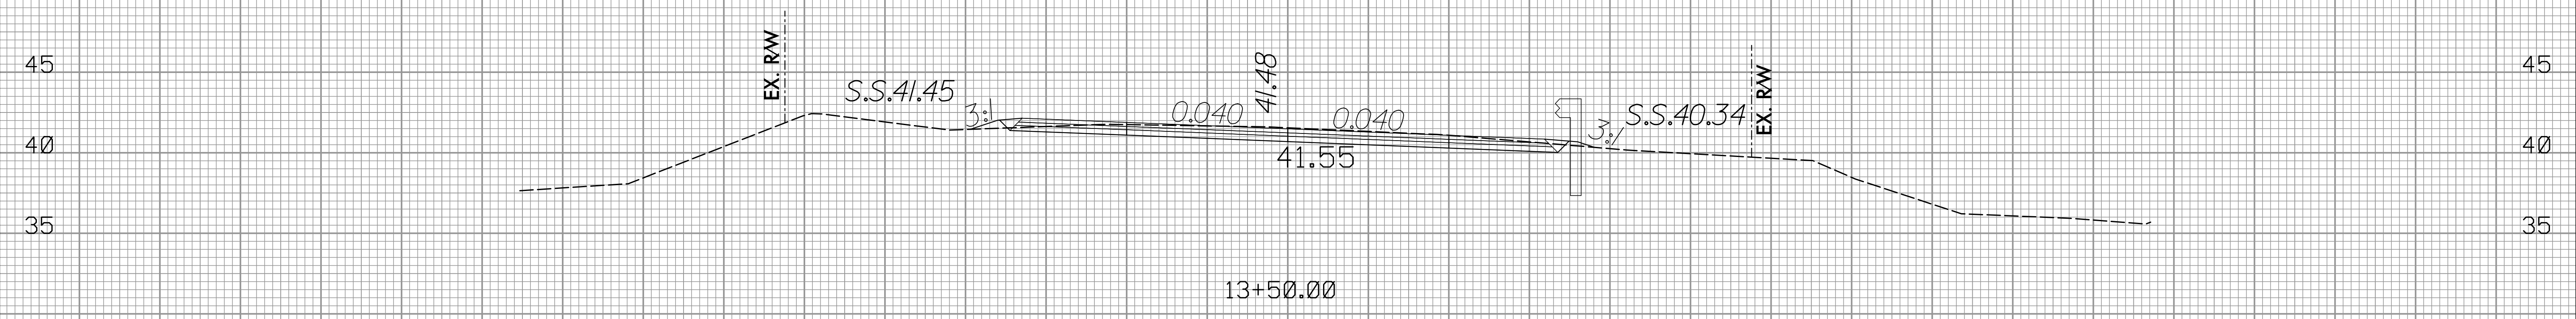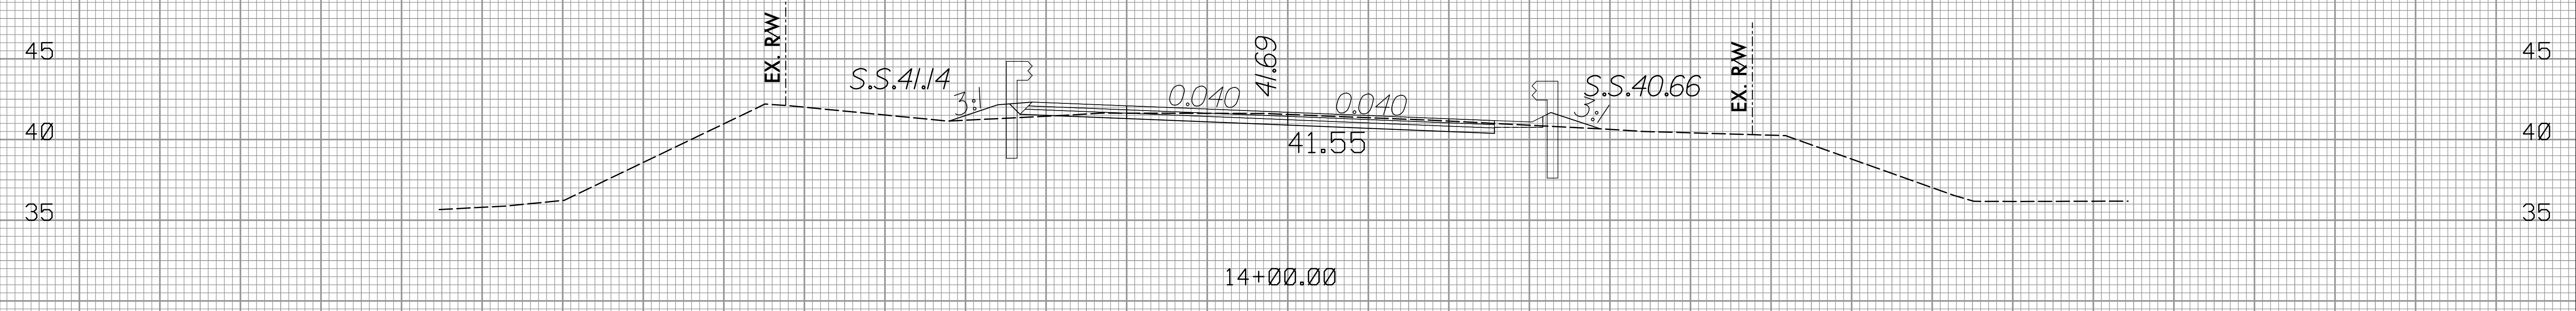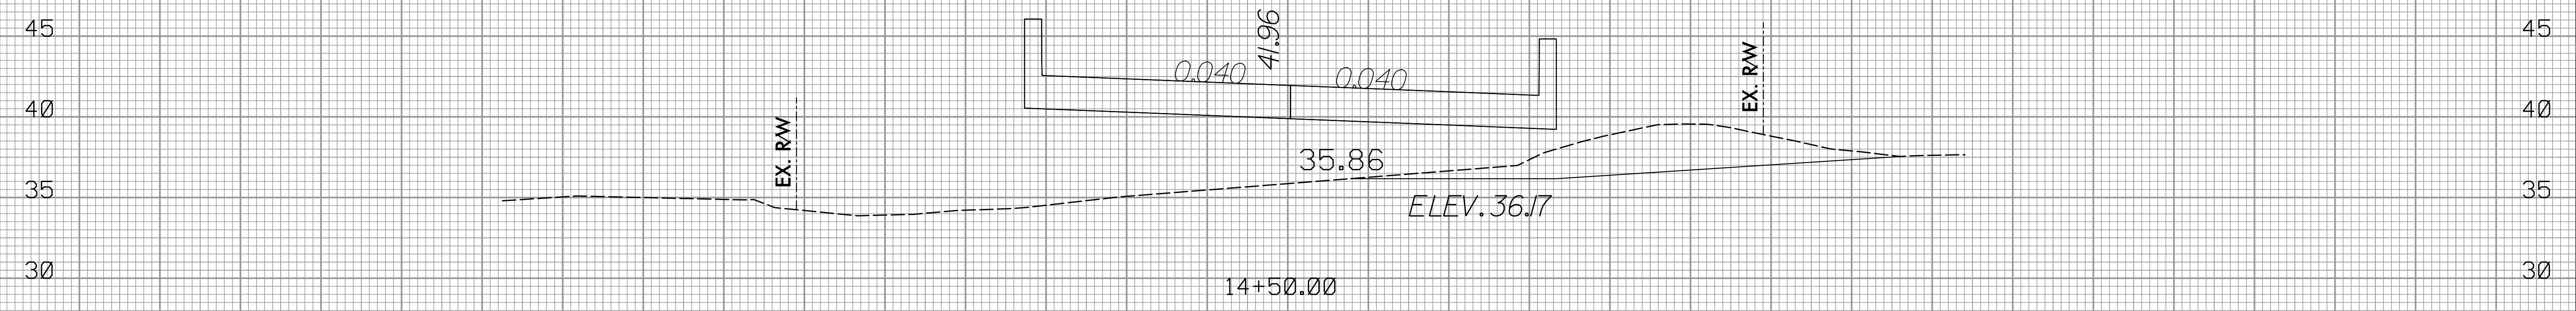




75 70 65 60 55 50 45 40 35 30 25 20 15 10 5 0 5 10 15 20 25 30 35 40 45 50 55 60 65 70 75

6:02:50 PM 05/10/21 14+50.00.dwg xp1.dgn

02/03/98

| PROJ. REFERENCE NO. | SHEET NO. | TOTAL SHEETS |
|---------------------|-----------|--------------|
| BD-5102U            | X-4       | 7            |

75 70 65 60 55 50 45 40 35 30 25 20 15 10 5 0 5 10 15 20 25 30 35 40 45 50

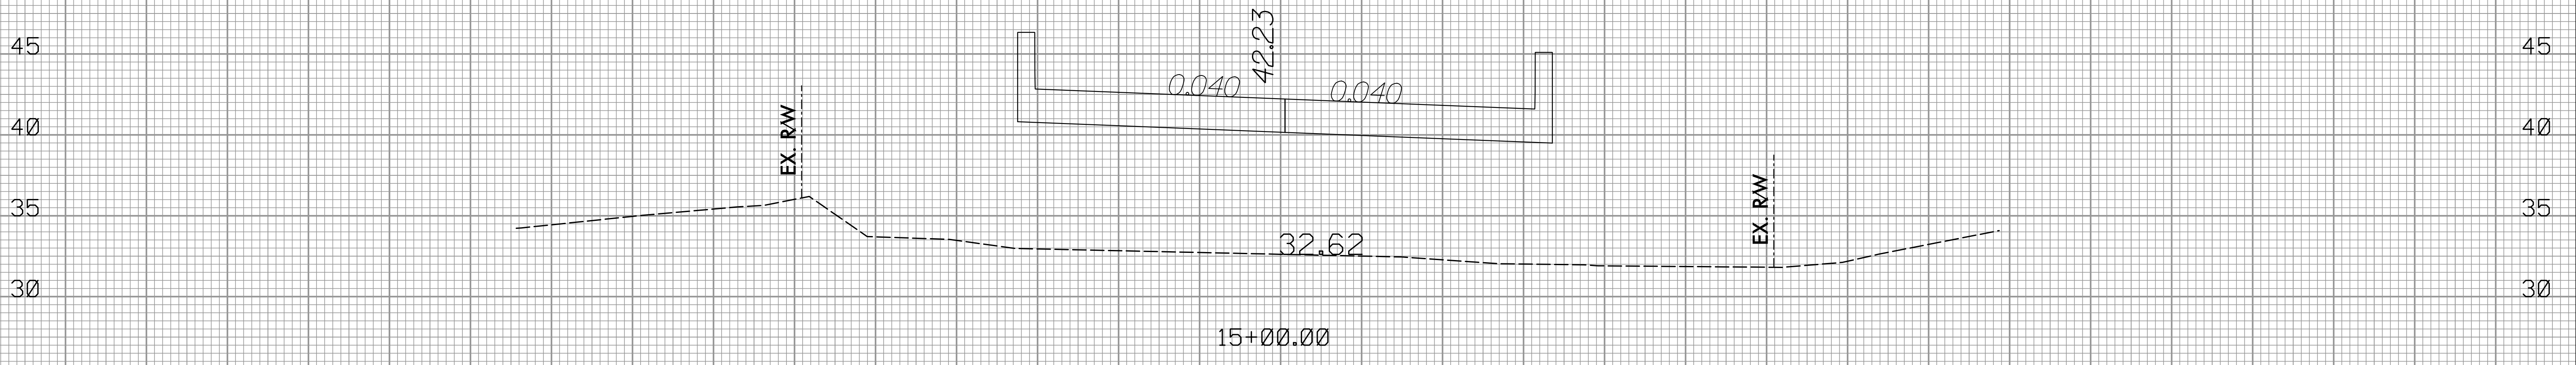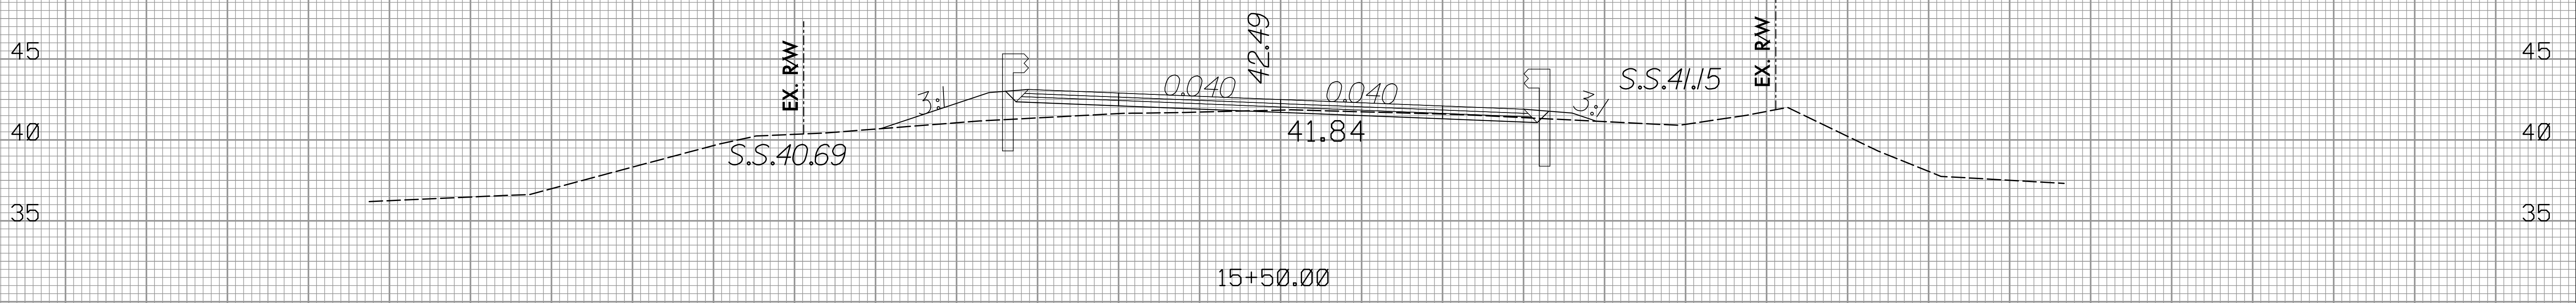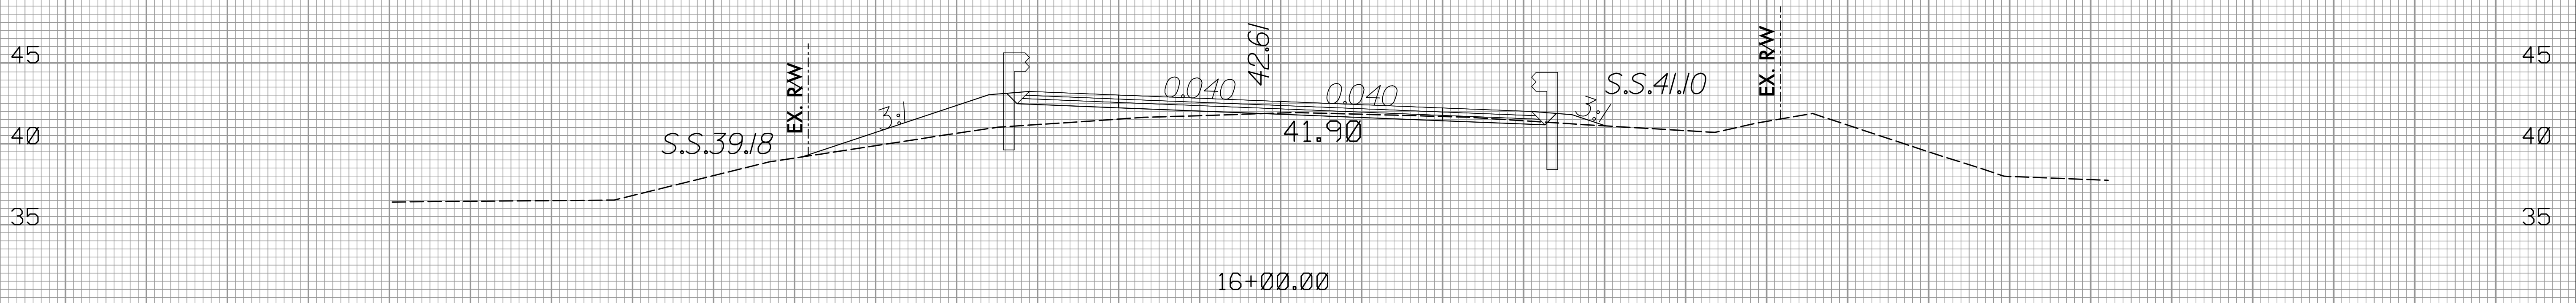




75 70 65 60 55 50 45 40 35 30 25 20 15 10 5 0 5 10 15 20 25 30 35 40 45 50

6:02:32 P:\05102U\_rdy\_xp1.dgn  
 \$\$\$USFEN\CVT\$\$\$\$

02/03/98

| PROJ. REFERENCE NO. | SHEET NO. | TOTAL SHEETS |
|---------------------|-----------|--------------|
| BD-5102U            | X-5       | 7            |

75 70 65 60 55 50 45 40 35 30 25 20 15 10 5 0 5 10 15 20 25 30 35 40 45 50 55 60 65 70 75

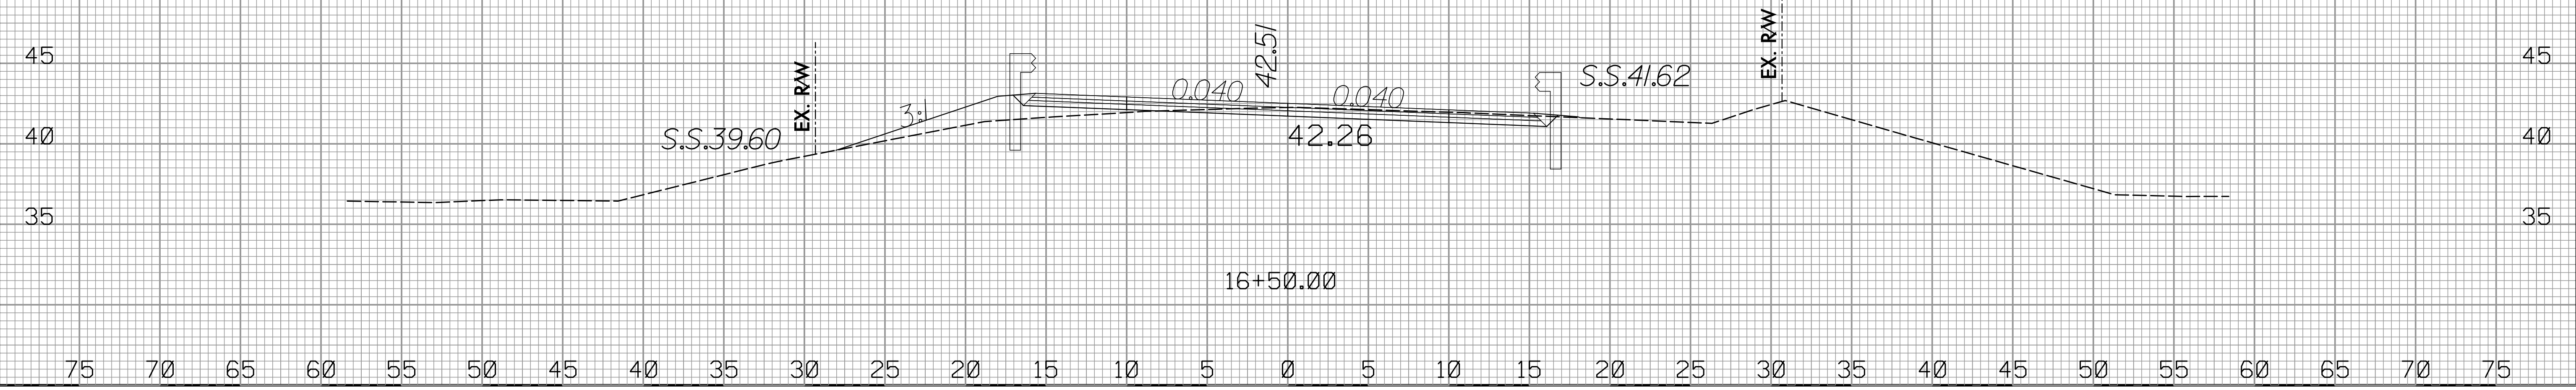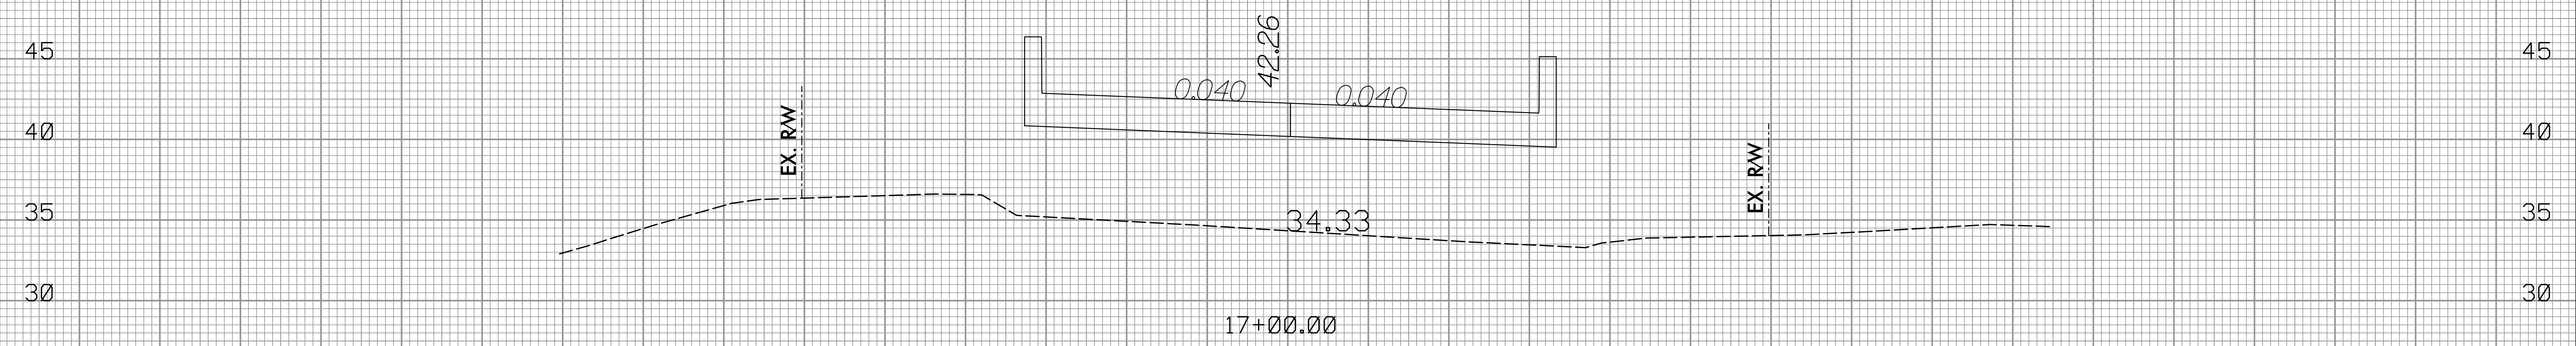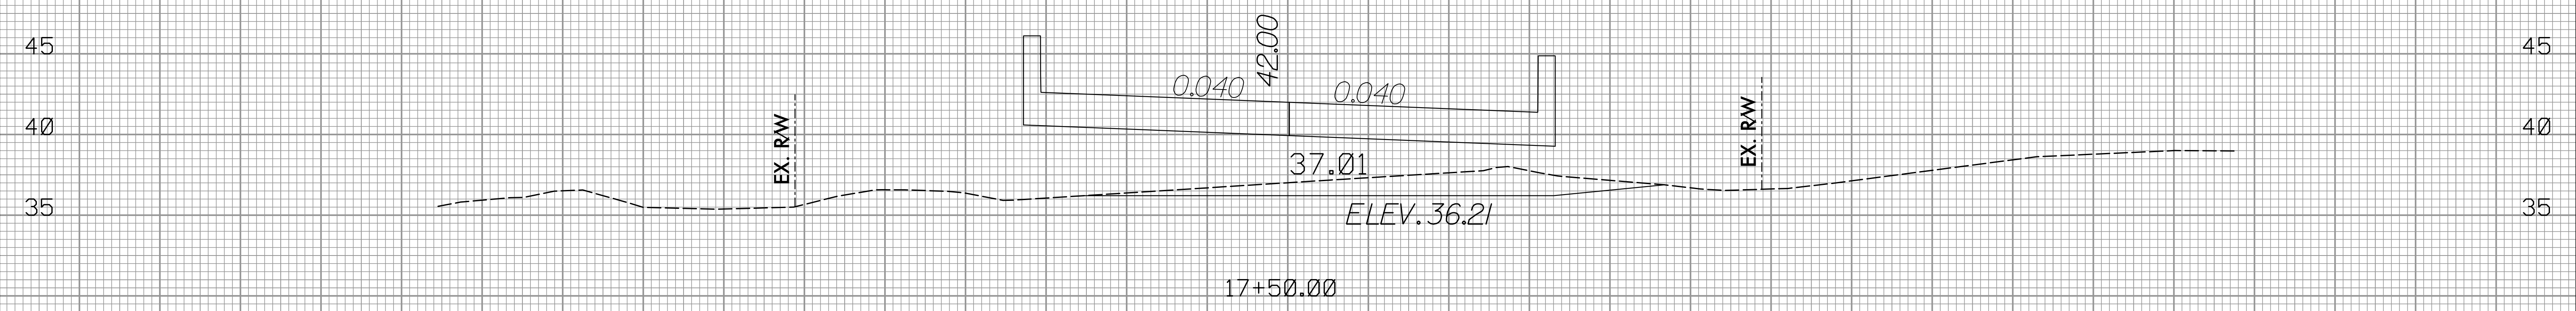


75 70 65 60 55 50 45 40 35 30 25 20 15 10 5 0 5 10 15 20 25 30 35 40 45 50 55 60 65 70 75

6:02:55 PM 05/02/98  
 \$\$\$USFRM(X)C\$\$\$\$

02/03/98

| PROJ. REFERENCE NO. | SHEET NO. | TOTAL SHEETS |
|---------------------|-----------|--------------|
| BD-5102U            | X-6       | 7            |

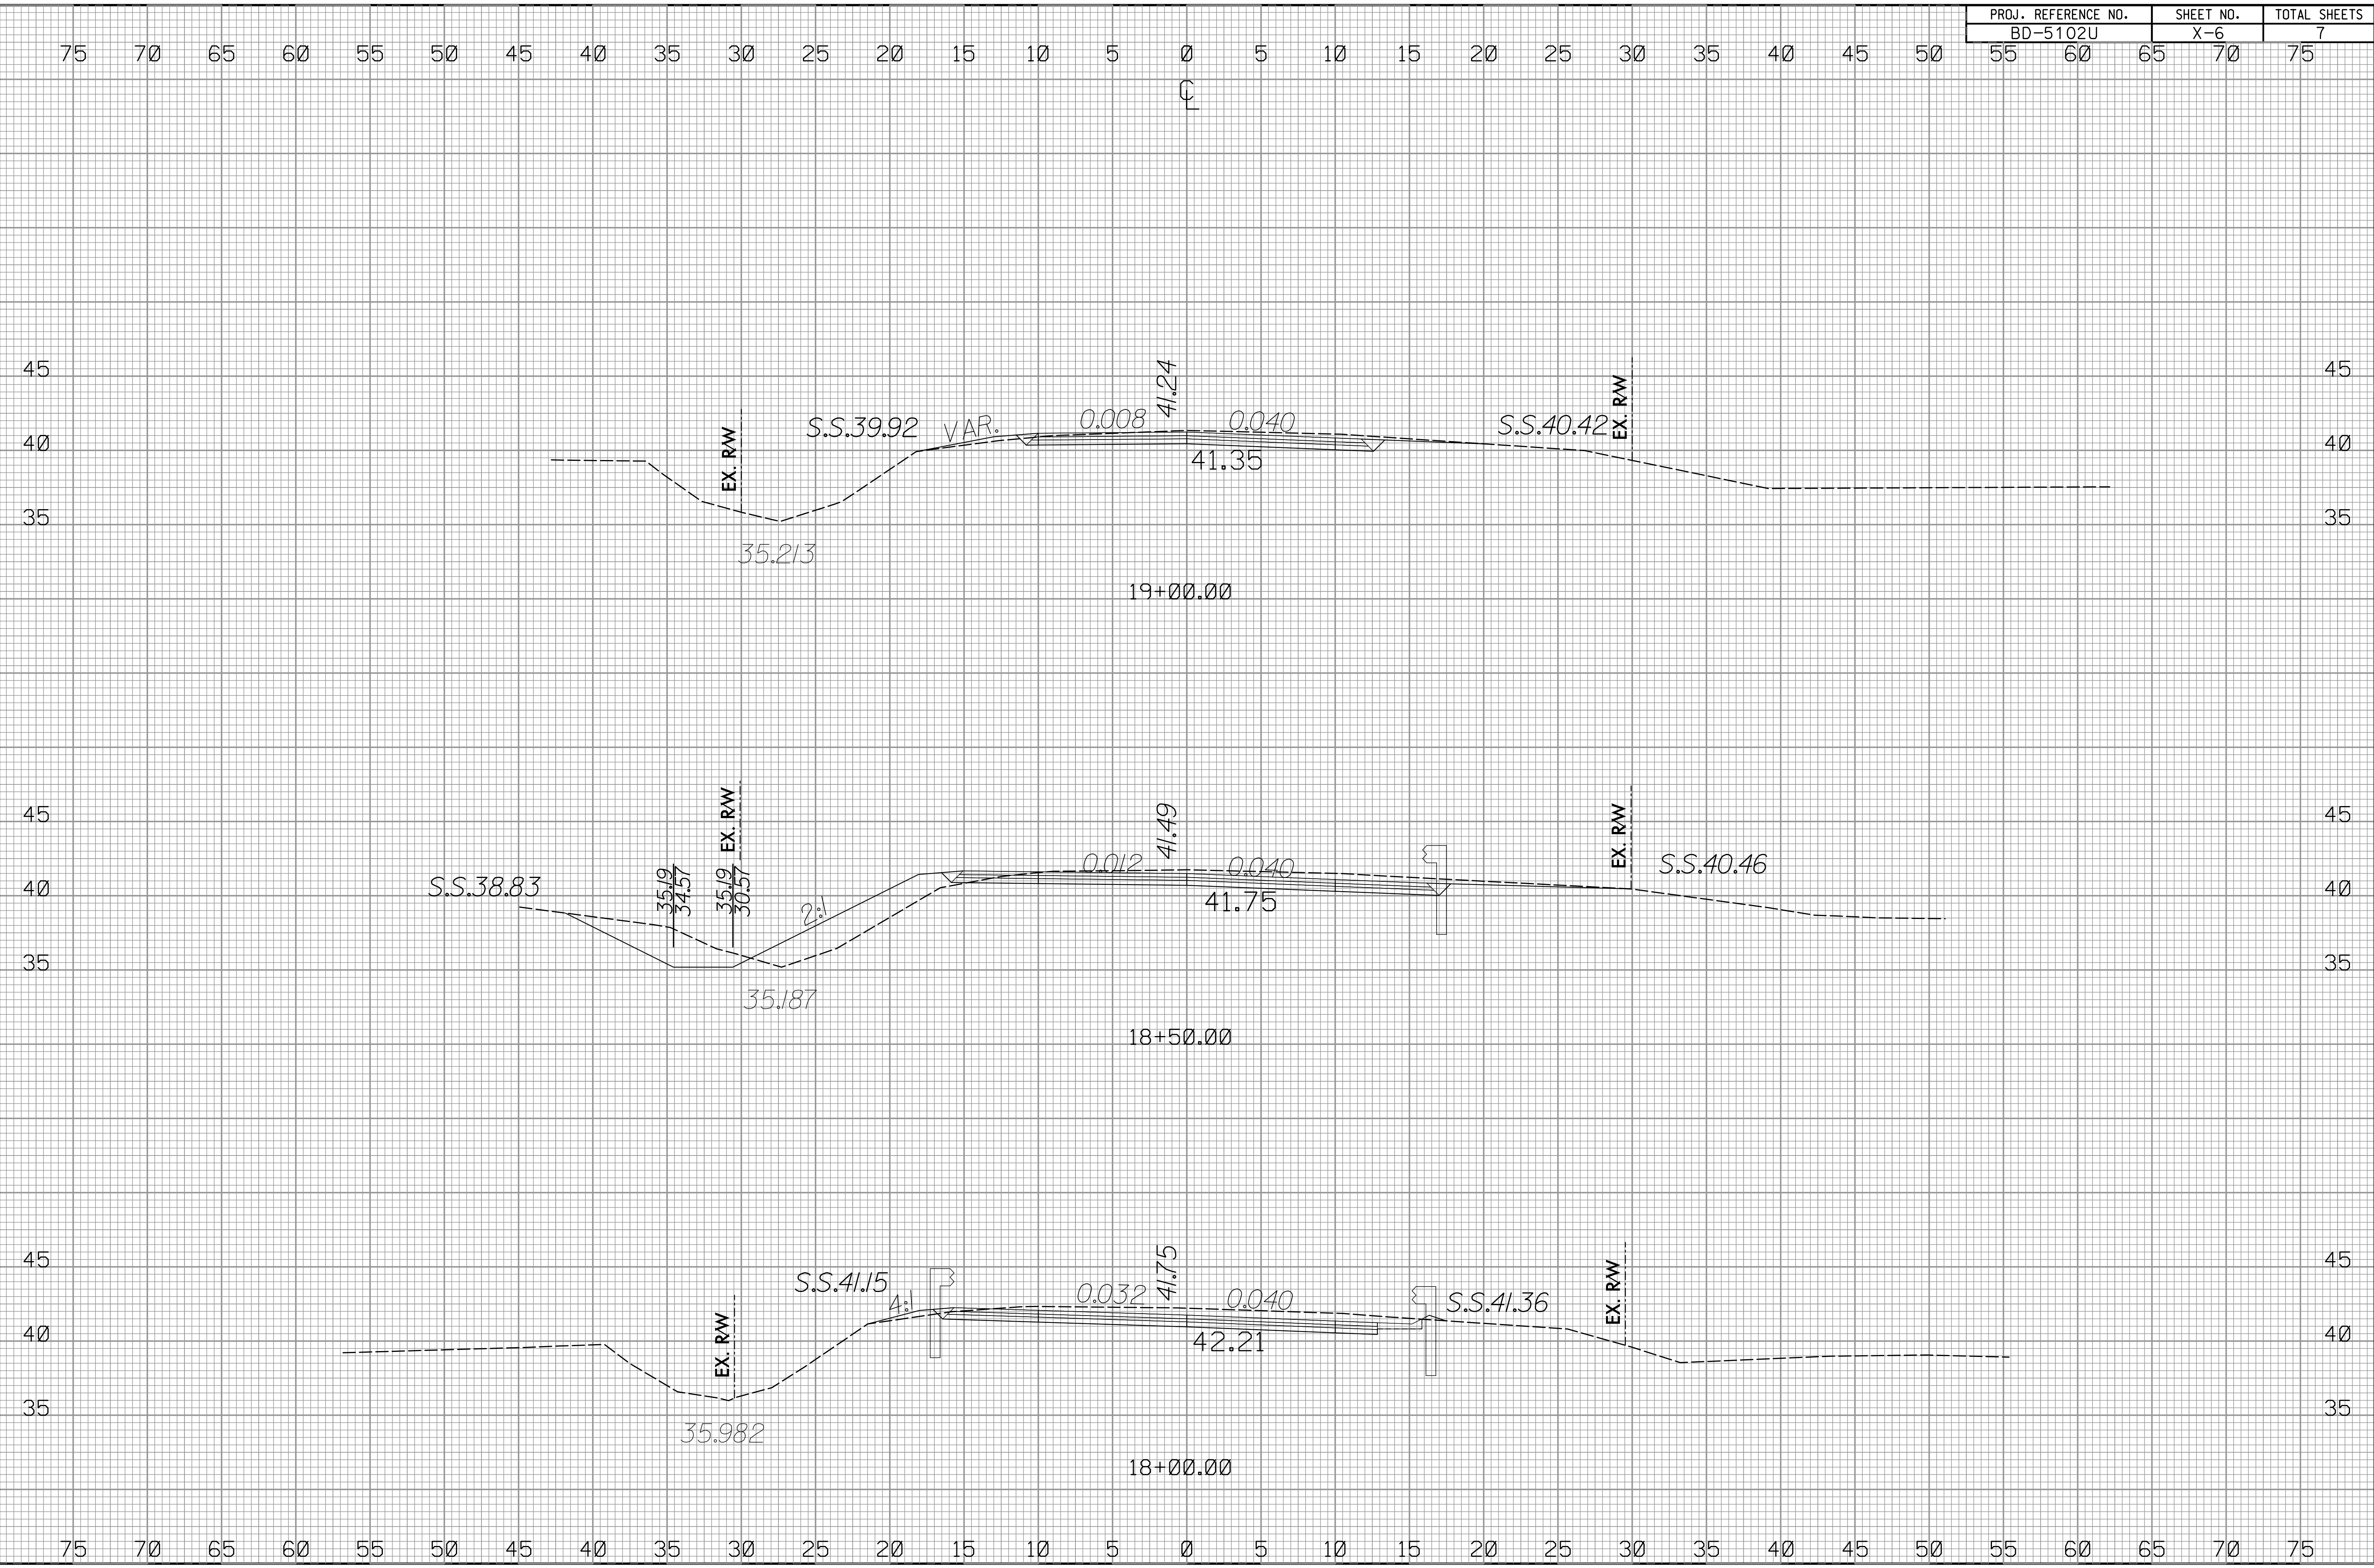

6:02:57 PM 05/02/01\_rdy\_xp1.dgn

02/03/98


| PROJ. REFERENCE NO. | SHEET NO. | TOTAL SHEETS |
|---------------------|-----------|--------------|
| BD-5102U            | X-7       | 7            |

75 70 65 60 55 50 45 40 35 30 25 20 15 10 5 0 5 10 15 20 25 30 35 40 45 50

55 60 65 70 75


CL

6:02:32 PM 05/10/2014 -rdj-xp1.dgn

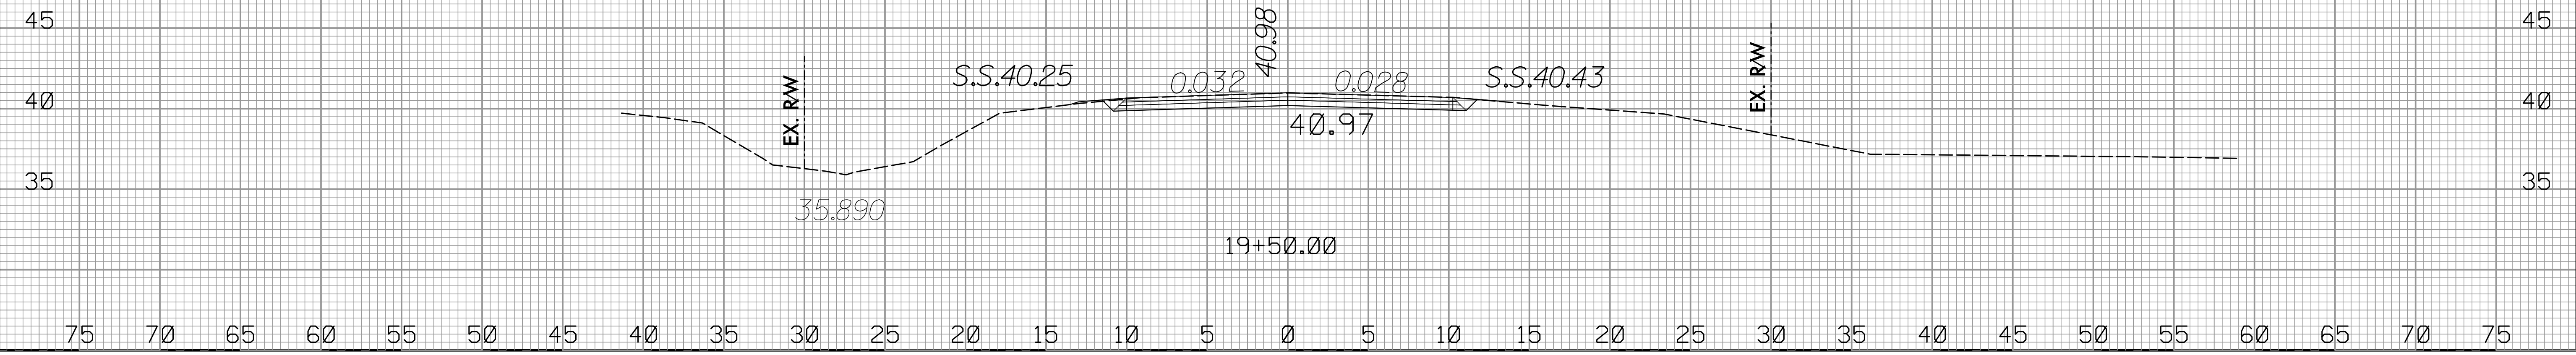

75 70 65 60 55 50 45 40 35 30 25 20 15 10 5 0 5 10 15 20 25 30 35 40 45 50

55 60 65 70 75

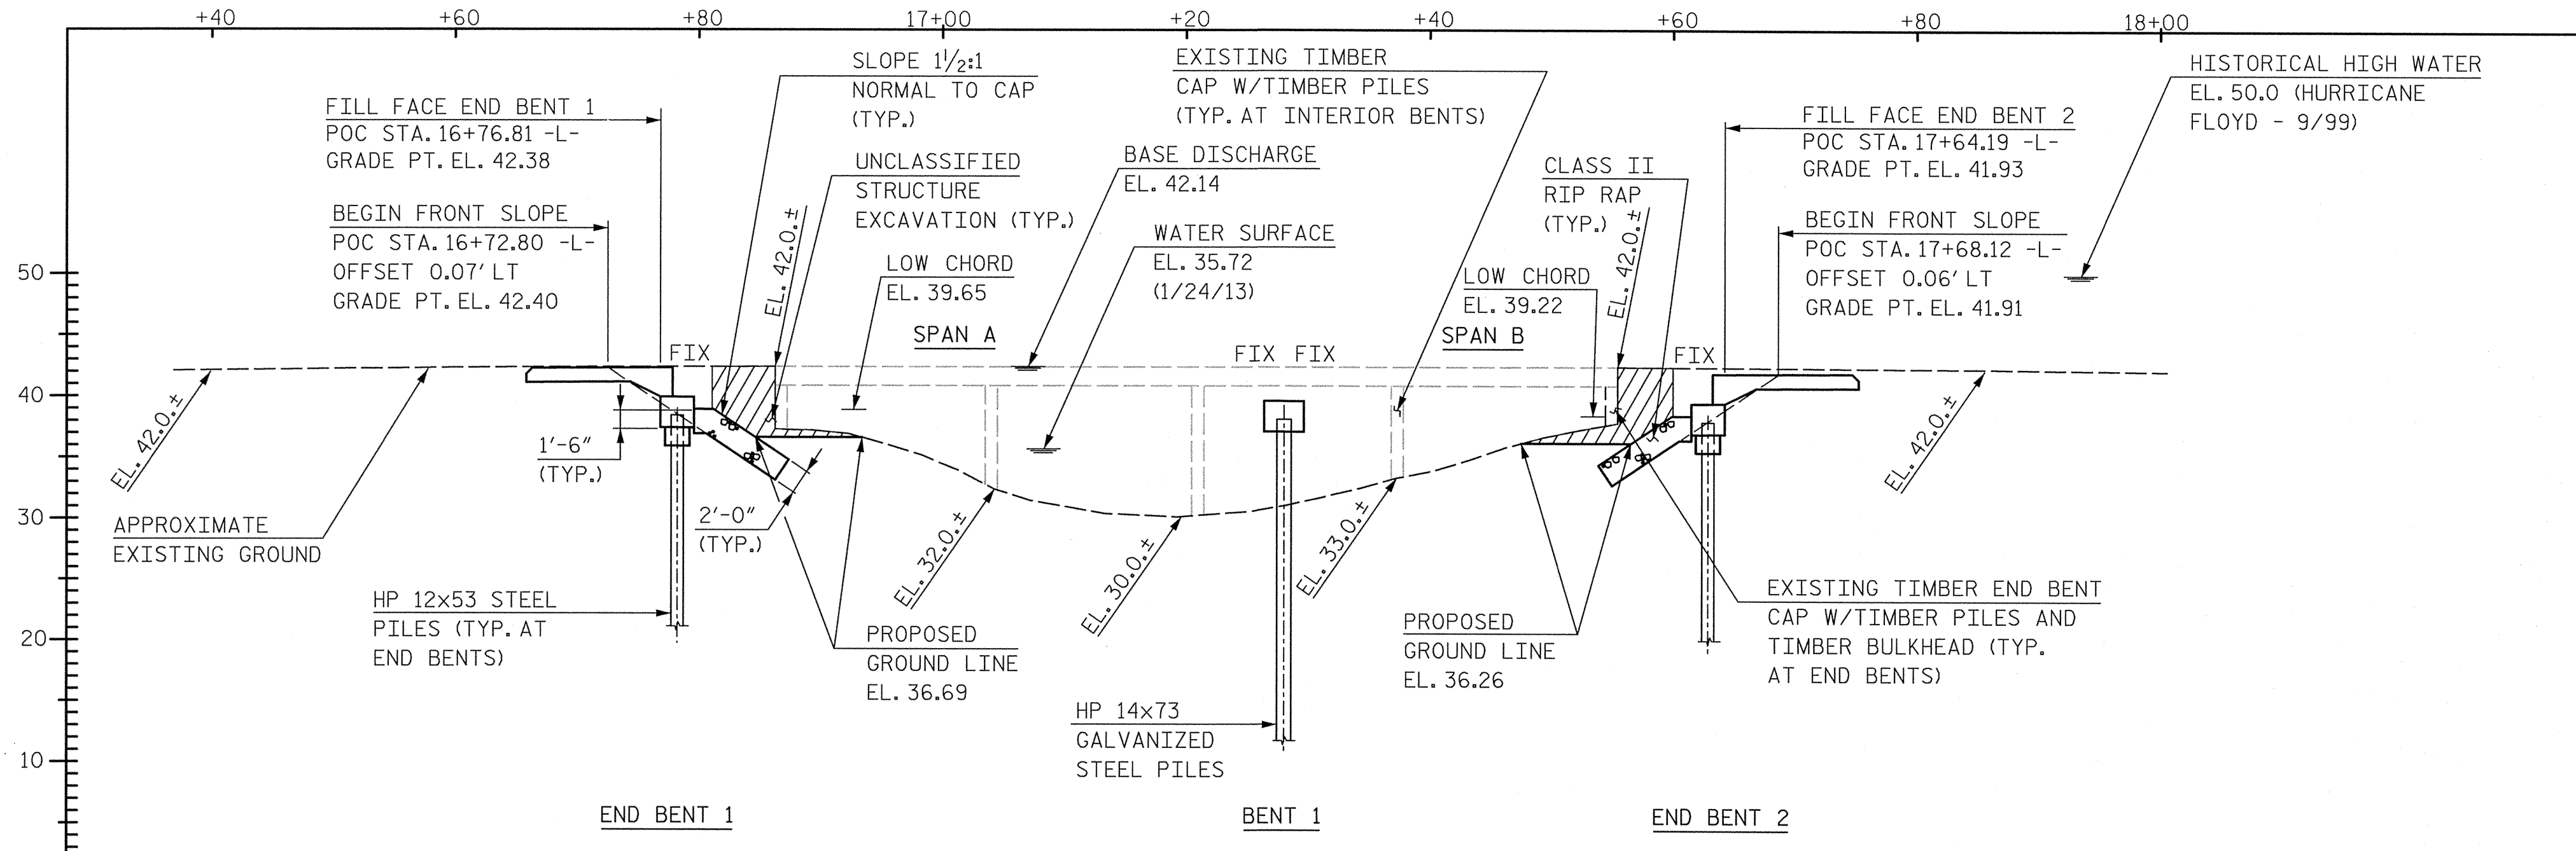

SECTION ALONG C SURVEY -L-

FOR GENERAL NOTES, SEE SHEET 2.

**BRIDGE HYDRAULIC DATA**


|                             |   |              |
|-----------------------------|---|--------------|
| DESIGN DISCHARGE            | = | 1,975 CFS    |
| FREQUENCY OF DESIGN FLOOD   | = | 10 YR        |
| DESIGN HIGH WATER ELEVATION | = | 39.9 FT.     |
| DRAINAGE AREA               | = | 52.2 SQ. MI. |
| BASIC DISCHARGE (Q100)      | = | 3,940 CFS    |
| BASIC HIGH WATER ELEVATION  | = | 42.14 FT.    |

**OVERTOPPING FLOOD DATA**


|                                |   |          |
|--------------------------------|---|----------|
| OVERTOPPING DISCHARGE          | = | 1975 CFS |
| FREQUENCY OF OVERTOPPING FLOOD | = | 10 YR    |
| OVERTOPPING FLOOD ELEVATION    | = | 40.1 FT. |

NOTE: OVERTOPPING OCCURS AT ROADWAY STA. 21+09±

PI STA. = 16+00.00  
 ELEV = 42.77  
 V.C. = 120'

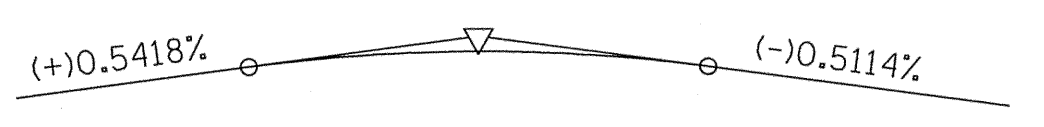

GRADE DATA -L-

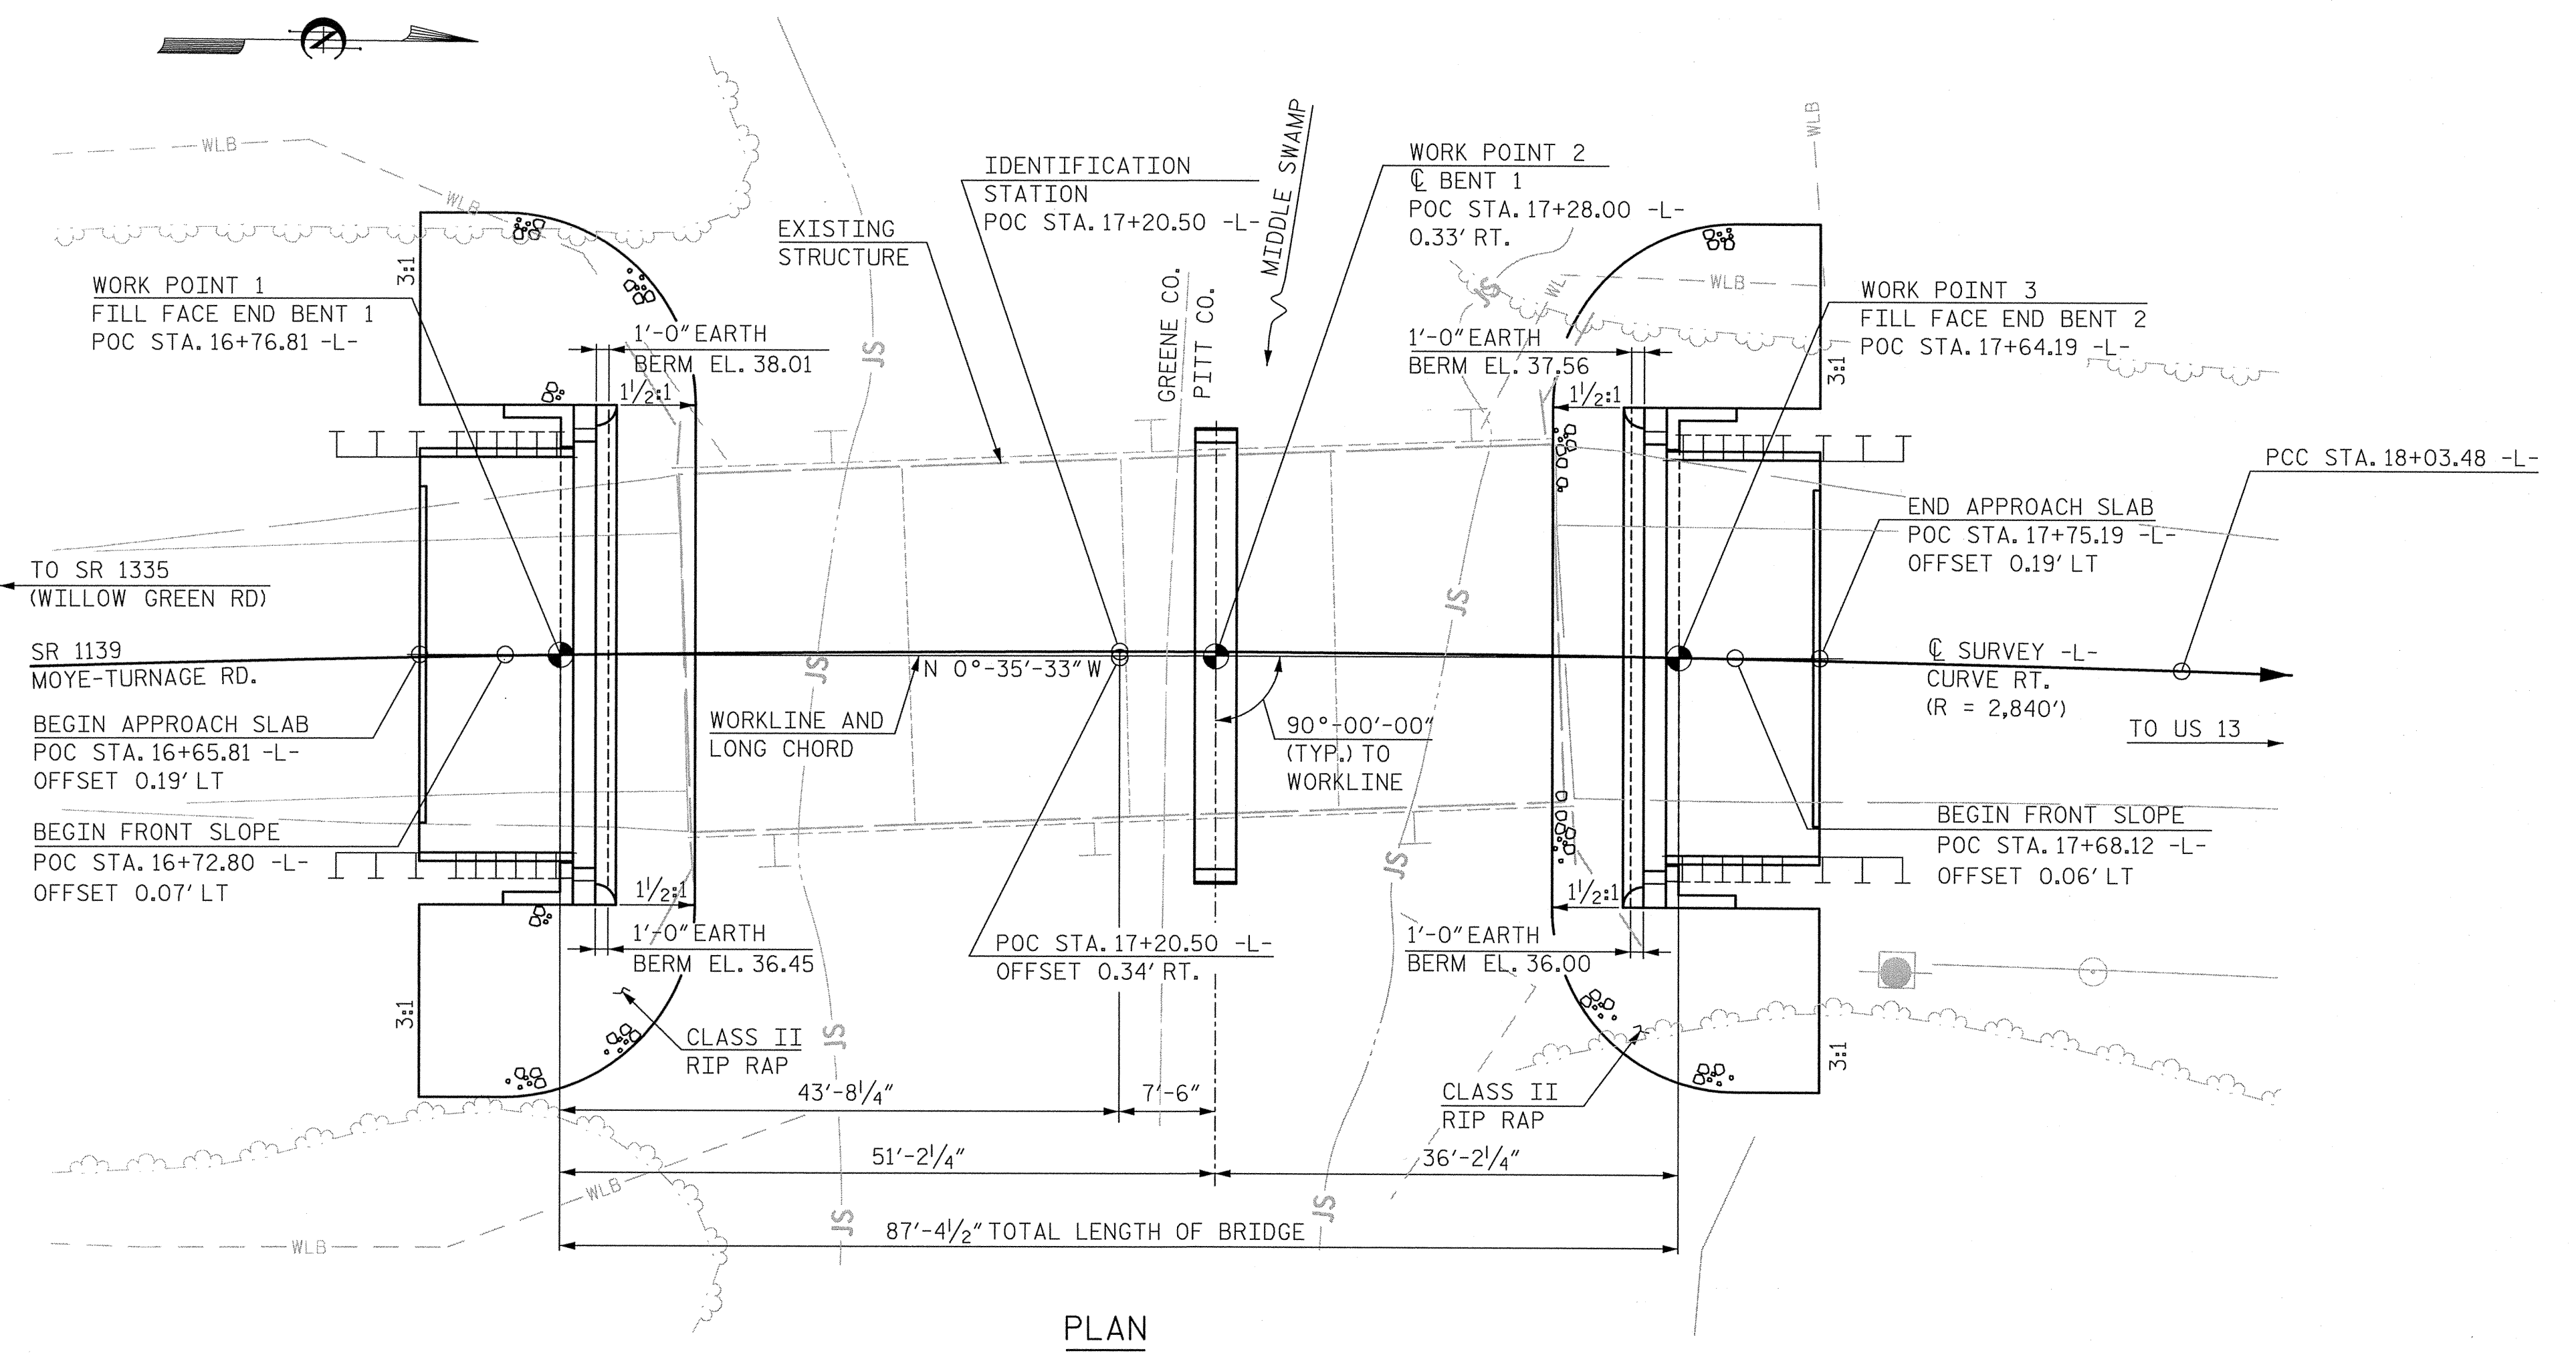

PLAN

NOTES: PILES NOT SHOWN FOR CLARITY.  
 WORKLINE FOR BRIDGE SHALL BE THE ROADWAY LONG CHORD BETWEEN FILL FACE WORK POINTS AND ITS EXTENSION.

CURVE DATA -L-


|                                   |                                   |
|-----------------------------------|-----------------------------------|
| PI STA. = 16+10.55                | PI STA. = 18+35.62                |
| $\Delta = 7^{\circ}47'49.0"$ (RT) | $\Delta = 2^{\circ}18'04.4"$ (RT) |
| D = 2 <sup>o</sup> 01'02.8"       | D = 3 <sup>o</sup> 34'51.6"       |
| L = 386.47'                       | L = 64.26'                        |
| T = 193.54'                       | T = 32.14'                        |
| R = 2,840.00'                     | R = 1,600.00'                     |
| SE = .04                          |                                   |

I HEREBY CERTIFY THESE PLANS ARE AS-BUILT PLANS

PROJECT NO. BD-5102U  
PITT COUNTY  
 STATION: POC 17+20.50 -L-

SHEET 1 OF 2 REPLACES BRIDGE NO. 0069

STATE OF NORTH CAROLINA  
 DEPARTMENT OF TRANSPORTATION  
 RALEIGH  
 GENERAL DRAWING  
 FOR BRIDGE ON SR 1139  
 OVER MIDDLE SWAMP  
 BETWEEN SR 1335  
 AND US 13

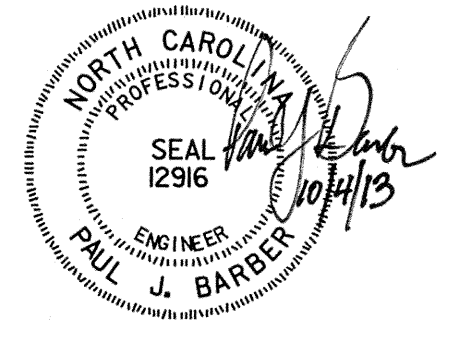

**HNTB** HNTB NORTH CAROLINA, P.C.  
 NC License No. C-1554  
 343 E. Six Forks Rd., Suite 200, Raleigh, N.C. 27609

DRAWN BY: J. BAYNE DATE: 6/13  
 CHECKED BY: P. BARBER DATE: 6/13


DWG. NO. 1

| REVISIONS |    |      |     |    |      |
|-----------|----|------|-----|----|------|
| NO.       | BY | DATE | NO. | BY | DATE |
| 1         |    |      | 3   |    |      |
| 2         |    |      | 4   |    |      |

SHEET NO. S-1  
 TOTAL SHEETS 17



BM - "BM1", STA. 16+43 -L-, 64' RT, RR SPIKE IN 24" OAK TREE, EL. 39.25

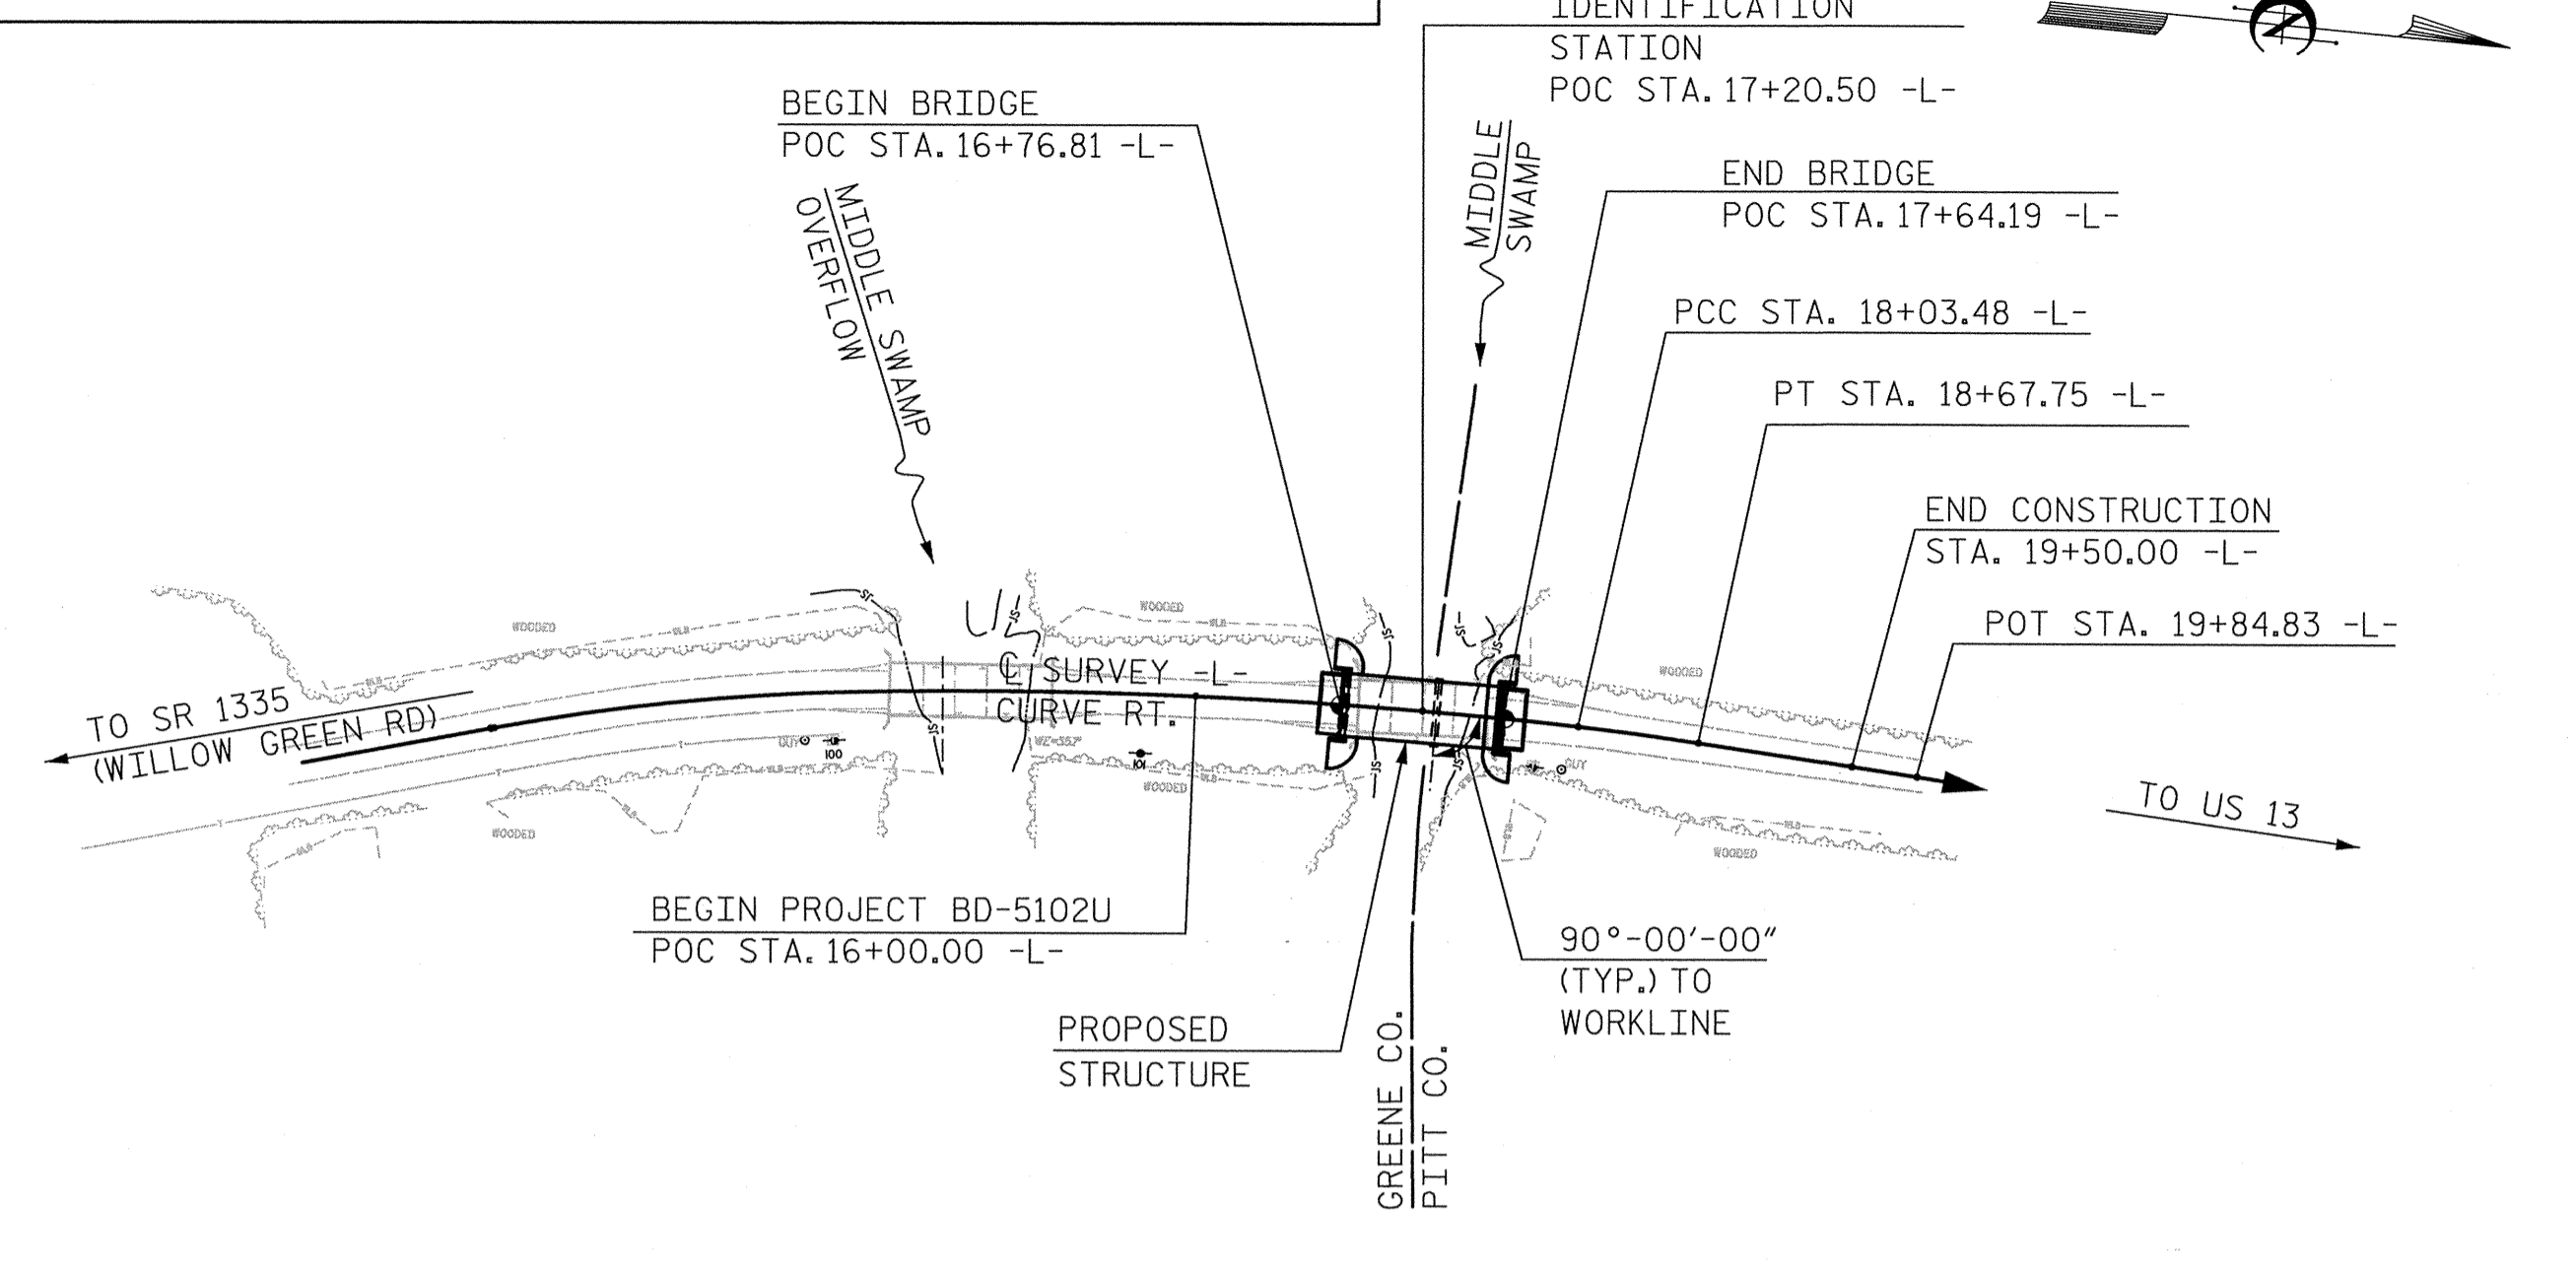

LOCATION SKETCH  
FOR UTILITY INFORMATION, SEE UTILITY PLANS AND SPECIAL PROVISIONS.

FOUNDATION NOTES:

FOR PILES, SEE SECTION 450 OF THE STANDARD SPECIFICATIONS.

PILES AT END BENT NO. 1 ARE DESIGNED FOR A FACTORED RESISTANCE OF 70 TONS PER PILE.

DRIVE PILES AT END BENT NO. 1 TO A REQUIRED DRIVING RESISTANCE OF 120 TONS PER PILE.

PILES AT BENT NO. 1 ARE DESIGNED FOR A FACTORED RESISTANCE OF 100 TONS PER PILE.

DRIVE PILES AT BENT NO. 1 TO A REQUIRED DRIVING RESISTANCE OF 175 TONS PER PILE. THIS REQUIRED DRIVING RESISTANCE INCLUDES ADDITIONAL RESISTANCE FOR DOWNDRAW OR SCOUR.

PILES AT END BENT NO. 2 ARE DESIGNED FOR A FACTORED RESISTANCE OF 55 TONS PER PILE.

DRIVE PILES AT END BENT NO. 2 TO A REQUIRED DRIVING RESISTANCE OF 95 TONS PER PILE.

INSTALL PILES AT BENT NO. 1 TO A TIP ELEVATION NO HIGHER THAN 5.0 FT.

STEEL H-PILE POINTS ARE REQUIRED FOR STEEL H-PILES AT BENT NO. 1. FOR STEEL PILE POINTS, SEE SECTION 450 OF THE STANDARD SPECIFICATIONS.

THE SCOUR CRITICAL ELEVATION FOR BENT NO. 1 IS ELEVATION 25.0 FT. SCOUR CRITICAL ELEVATIONS ARE USED TO MONITOR POSSIBLE SCOUR PROBLEMS DURING THE LIFE OF THE STRUCTURE.

IT HAS BEEN ESTIMATED THAT A HAMMER WITH AN EQUIVALENT RATED ENERGY IN THE RANGE OF 30 TO 40 FT-KIPS PER BLOW WILL BE REQUIRED TO DRIVE PILES AT END BENT NO. 1 AND END BENT NO. 2. THIS ESTIMATED ENERGY RANGE DOES NOT RELEASE THE CONTRACTOR FROM PROVIDING DRIVING EQUIPMENT IN ACCORDANCE WITH SUBARTICLE 450-3(D)(2) OF THE STANDARD SPECIFICATIONS.

IT HAS BEEN ESTIMATED THAT A HAMMER WITH AN EQUIVALENT RATED ENERGY IN THE RANGE OF 40 TO 60 FT-KIPS PER BLOW WILL BE REQUIRED TO DRIVE PILES AT BENT NO. 1. THIS ESTIMATED ENERGY RANGE DOES NOT RELEASE THE CONTRACTOR FROM PROVIDING DRIVING EQUIPMENT IN ACCORDANCE WITH SUBARTICLE 450-3(D)(2) OF THE STANDARD SPECIFICATIONS.

TESTING PILES WITH THE PDA DURING DRIVING, RESTRIKING OR REDRIVING MAY BE REQUIRED. THE ENGINEER WILL DETERMINE THE NEED FOR PDA TESTING. FOR PDA TESTING, SEE SECTION 450 OF THE STANDARD SPECIFICATIONS AND FOR PILE DRIVING CRITERIA, SEE PILE DRIVING CRITERIA PROVISION.

TOTAL BILL OF MATERIAL

|                | REMOVAL OF EXISTING STRUCTURE AT STATION 17+20.50 -L- | PDA TESTING | UNCLASSIFIED STRUCTURE EXCAVATION AT STATION 17+20.50 -L- | CLASS A CONCRETE | BRIDGE APPROACH SLABS AT STATION 17+20.50 -L- | REINFORCING STEEL | HP 12x53 STEEL PILES |          | HP 14x73 GALVANIZED STEEL PILES |          | STEEL PILE POINTS | PILE REDRIVES | VERTICAL CONCRETE BARRIER RAIL | RIP RAP CLASS II (2'-0" THICK) | GEOTEXTILE FOR DRAINAGE | ELASTOMERIC BEARINGS | 3'-0"x1'-9" PRESTRESSED CONCRETE CORED SLABS |      |          |
|----------------|---|-------------|---|------------------|---|-------------------|----------------------|----------|---------------------------------|----------|-------------------|---------------|--------------------------------|--------------------------------|-------------------------|----------------------|--|------|----------|
|                |   |             |   |                  |   |                   | NO.                  | LIN. FT. | NO.                             | LIN. FT. |                   |               |                                |                                |                         |                      | EACH   | EACH | LIN. FT. |
| SUPERSTRUCTURE | LUMP SUM  | EACH        | LUMP SUM  | CU. YDS.         | LUMP SUM                                      | LBS.              |                      |          |                                 |          |                   |               |                                |                                |                         |                      |  |      |          |
| END BENT NO. 1 |   |             | LUMP SUM  | 14.3             |   | 2,127             | 7                    | 455      |                                 |          |                   | 3             |                                |                                | 67                      | 74                   |  |      |          |
| BENT NO. 1     |   |             |   | 10.8             |   | 2,162             |                      |          | 8                               | 520      | 8                 | 4             |                                |                                |                         |                      |  |      |          |
| END BENT NO. 2 |   |             | LUMP SUM  | 14.3             |   | 2,127             | 7                    | 420      |                                 |          |                   | 3             |                                | 67                             | 74                      |                      |  |      |          |
| TOTAL          | LUMP SUM  | 1           | LUMP SUM  | 39.4             | LUMP SUM                                      | 6,416             | 14                   | 875      | 8                               | 520      | 8                 | 10            | 170.50                         | 134                            | 148                     | LUMP SUM             | 22   | 935  |          |

GENERAL NOTES

ASSUMED LIVE LOAD = HL-93 OR ALTERNATE LOADING.

THIS BRIDGE HAS BEEN DESIGNED IN ACCORDANCE WITH THE AASHTO LRFD BRIDGE DESIGN SPECIFICATIONS.

THIS BRIDGE IS LOCATED IN SEISMIC ZONE 1.

THIS BRIDGE SHALL BE CONSTRUCTED USING TOP-DOWN CONSTRUCTION METHODS. THE USE OF A TEMPORARY CAUSEWAY OR WORK BRIDGE IS NOT PERMITTED.

FOR OTHER DESIGN DATA AND GENERAL NOTES, SEE SHEET SN.

FOR SUBMITTAL OF WORKING DRAWINGS, SEE SPECIAL PROVISIONS.

FOR FALSEWORK AND FORMWORK, SEE SPECIAL PROVISIONS.

FOR CRANE SAFETY, SEE SPECIAL PROVISIONS.

FOR GROUT FOR STRUCTURES, SEE SPECIAL PROVISIONS.

THE MATERIAL SHOWN IN THE CROSS-HATCHED AREA SHALL BE EXCAVATED FOR A DISTANCE OF 19'-6" FT. EACH SIDE OF CENTERLINE ROADWAY AS DIRECTED BY THE ENGINEER. THIS WORK WILL BE PAID FOR AT THE CONTRACT LUMP SUM PRICE FOR UNCLASSIFIED STRUCTURE EXCAVATION. SEE SECTION 412 OF THE STANDARD SPECIFICATIONS.

THE EXISTING 4 SPAN STRUCTURE WITH SPAN LENGTHS OF 17'-8", 16'-9", 16'-5" AND 18'-4" WITH REINFORCED CONCRETE DECK AND 22 LINES OF 6x12 TIMBER JOISTS AT VARIOUS CENTERS, WITH A 29.4' OUT TO OUT DECK WIDTH ON TIMBER CAPS AND TIMBER PILES SHALL BE REMOVED. IN ADDITION, ANY PILES REMAINING FROM PREVIOUS BRIDGE CONSTRUCTION OR MAINTENANCE OPERATIONS SHALL BE REMOVED AND INCLUDED IN THE LUMP SUM PAY ITEM FOR "REMOVAL OF EXISTING STRUCTURE AT STATION 17+20.50 -L-".

THE SUBSTRUCTURE OF THE EXISTING BRIDGE INDICATED ON THE PLANS IS FROM THE BEST INFORMATION AVAILABLE. SINCE THIS INFORMATION IS SHOWN FOR THE CONVENIENCE OF THE CONTRACTOR, THE CONTRACTOR SHALL HAVE NO CLAIM WHATSOEVER AGAINST THE DEPARTMENT OF TRANSPORTATION FOR ANY DELAYS OR ADDITIONAL COST INCURRED BASED ON DIFFERENCES BETWEEN THE EXISTING BRIDGE SUBSTRUCTURE SHOWN ON THE PLANS AND THE ACTUAL CONDITIONS AT THE PROJECT SITE.

REMOVAL OF THE EXISTING BRIDGE SHALL BE PERFORMED SO AS NOT TO ALLOW DEBRIS TO FALL INTO THE WATER. THE CONTRACTOR SHALL REMOVE THE BRIDGE AND SUBMIT PLANS FOR DEMOLITION IN ACCORDANCE WITH ARTICLE 402-2 OF THE STANDARD SPECIFICATIONS.

THIS STRUCTURE HAS BEEN DESIGNED IN ACCORDANCE WITH "HEC 18- EVALUATING SCOUR AT BRIDGES".


FOR INTERIOR BENT 1, ONLY PARTIAL GALVANIZING OF THE PILES IS REQUIRED. SEE INTERIOR BENT SHEETS FOR REQUIRED GALVANIZED LENGTHS. PAYMENT FOR PARTIALLY GALVANIZED PILES WILL BE MADE UNDER THE CONTRACT UNIT PRICE FOR GALVANIZED STEEL PILES.

FOR EROSION CONTROL MEASURES SEE EROSION CONTROL PLANS.

ASPHALT WEARING SURFACE IS INCLUDED IN ROADWAY QUANTITY ON ROADWAY PLANS.

PROJECT NO. BD-5102U  
PITT COUNTY  
STATION: POC 17+20.50 -L-

SHEET 2 OF 2

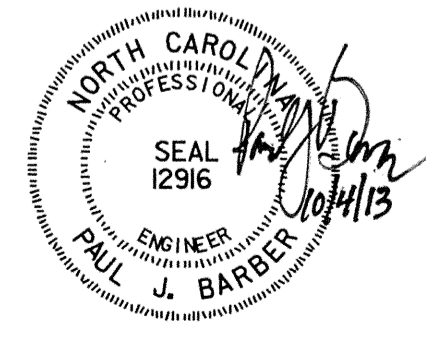

STATE OF NORTH CAROLINA  
DEPARTMENT OF TRANSPORTATION  
RALEIGH  
GENERAL DRAWING  
FOR BRIDGE ON SR 1334  
OVER MIDDLE SWAMP  
BETWEEN SR 1139  
AND US 13

|   |   |                            |                            |                            |                   |                   |  |
|---|---|----------------------------|----------------------------|----------------------------|-------------------|-------------------|--|
| <b>HNTB</b><br>HNTB NORTH CAROLINA, P.C.<br>NC License No. C-1554<br>343 E. Six Forks Rd., Suite 200, Raleigh, N.C. 27609 | REVISIONS   |                            |                            |                            |                   |                   | SHEET NO.<br>S-2<br>TOTAL SHEETS<br>17 |
|   | DRAWN BY <u>J. BAYNE</u> DATE <u>6/13</u><br>CHECKED BY <u>P. BARBER</u> DATE <u>6/13</u> | NO. <u>1</u><br>BY<br>DATE | NO. <u>3</u><br>BY<br>DATE | NO. <u>4</u><br>BY<br>DATE | NO.<br>BY<br>DATE | NO.<br>BY<br>DATE |  |

LOAD AND RESISTANCE FACTOR RATING (LRFD) SUMMARY FOR PRESTRESSED CONCRETE GIRDERS

LOAD FACTORS:

|                            |             |               |               |
|----------------------------|-------------|---------------|---------------|
| DESIGN LOAD RATING FACTORS | LIMIT STATE | $\gamma_{DC}$ | $\gamma_{DW}$ |
|                            | STRENGTH I  | 1.25          | 1.50          |
|                            | SERVICE III | 1.00          | 1.00          |

| LEVEL              | VEHICLE    | WEIGHT (W) (TONS) | CONTROLLING LOAD RATING | MINIMUM RATING FACTORS (RF) | TONS = W X RF | STRENGTH I LIMIT STATE |                           |               |      |                 |                                     |                           |               |      |                 | SERVICE III LIMIT STATE             |                  |                           |               |      | COMMENT NUMBER |                 |                                     |  |
|--------------------|------------|-------------------|-------------------------|-----------------------------|---------------|------------------------|---------------------------|---------------|------|-----------------|-------------------------------------|---------------------------|---------------|------|-----------------|-------------------------------------|------------------|---------------------------|---------------|------|----------------|-----------------|-------------------------------------|--|
|                    |            |                   |                         |                             |               | LIVELOAD FACTORS       | MOMENT                    |               |      |                 |                                     | SHEAR                     |               |      |                 |                                     | LIVELOAD FACTORS | MOMENT                    |               |      |                |                 |                                     |  |
|                    |            |                   |                         |                             |               |                        | DISTRIBUTION FACTORS (DF) | RATING FACTOR | SPAN | GIRDER LOCATION | DISTANCE FROM LEFT END OF SPAN (ft) | DISTRIBUTION FACTORS (DF) | RATING FACTOR | SPAN | GIRDER LOCATION | DISTANCE FROM LEFT END OF SPAN (ft) |                  | DISTRIBUTION FACTORS (DF) | RATING FACTOR | SPAN |                | GIRDER LOCATION | DISTANCE FROM LEFT END OF SPAN (ft) |  |
| DESIGN LOAD RATING | HL-93(In)  | N/A               | 1                       | 1.394                       | --            | 1.75                   | 0.276                     | 1.57          | 50'  | EL              | 24.5                                | 0.531                     | <b>1.39</b>   | 50'  | EL              | <b>2.45</b>                         | 0.80             | 0.276                     | 1.44          | 50'  | EL             | 24.5            |                                     |  |
|                    | HL-93(OPr) | N/A               | --                      | 1.807                       | --            | 1.35                   | 0.276                     | 2.03          | 50'  | EL              | 24.5                                | 0.531                     | 1.81          | 50'  | EL              | 2.45                                | N/A              | --                        | --            | --   | --             | --              |                                     |  |
|                    | HS-20(In)  | 36.000            | 2                       | 1.667                       | 60.007        | 1.75                   | 0.276                     | 1.95          | 50'  | EL              | 24.5                                | 0.531                     | <b>1.67</b>   | 50'  | EL              | <b>2.45</b>                         | 0.80             | 0.276                     | 1.79          | 50'  | EL             | 24.5            |                                     |  |
|                    | HS-20(OPr) | 36.000            | --                      | 2.161                       | 77.787        | 1.35                   | 0.276                     | 2.52          | 50'  | EL              | 24.5                                | 0.531                     | 2.16          | 50'  | EL              | 2.45                                | N/A              | --                        | --            | --   | --             | --              |                                     |  |
| LEGAL LOAD RATING  | SV         | SNSH              | 13.500                  | --                          | 3.635         | 49.079                 | 1.4                       | 0.276         | 4.95 | 50'             | EL                                  | 24.5                      | 0.531         | 4.7  | 50'             | EL                                  | 2.45             | 0.80                      | 0.276         | 3.64 | 50'            | EL              | 24.5                                |  |
|                    |            | SNGARBS2          | 20.000                  | --                          | 2.871         | 57.42                  | 1.4                       | 0.276         | 3.91 | 50'             | EL                                  | 24.5                      | 0.531         | 3.42 | 50'             | EL                                  | 2.45             | 0.80                      | 0.276         | 2.87 | 50'            | EL              | 24.5                                |  |
|                    |            | SNAGRIS2          | 22.000                  | --                          | 2.778         | 61.109                 | 1.4                       | 0.276         | 3.78 | 50'             | EL                                  | 19.6                      | 0.531         | 3.21 | 50'             | EL                                  | 2.45             | 0.80                      | 0.276         | 2.78 | 50'            | EL              | 24.5                                |  |
|                    |            | SNCOTTS3          | 27.250                  | --                          | 1.814         | 49.418                 | 1.4                       | 0.276         | 2.47 | 50'             | EL                                  | 24.5                      | 0.531         | 2.36 | 50'             | EL                                  | 2.45             | 0.80                      | 0.276         | 1.81 | 50'            | EL              | 24.5                                |  |
|                    |            | SNAGGRS4          | 34.925                  | --                          | 1.577         | 55.063                 | 1.4                       | 0.276         | 2.15 | 50'             | EL                                  | 24.5                      | 0.531         | 2.01 | 50'             | EL                                  | 2.45             | 0.80                      | 0.276         | 1.58 | 50'            | EL              | 24.5                                |  |
|                    |            | SNS5A             | 35.550                  | --                          | 1.537         | 54.657                 | 1.4                       | 0.276         | 2.09 | 50'             | EL                                  | 24.5                      | 0.531         | 2.07 | 50'             | EL                                  | 2.45             | 0.80                      | 0.276         | 1.54 | 50'            | EL              | 24.5                                |  |
|                    |            | SNS6A             | 39.950                  | --                          | 1.438         | 57.43                  | 1.4                       | 0.276         | 1.96 | 50'             | EL                                  | 24.5                      | 0.531         | 1.91 | 50'             | EL                                  | 2.45             | 0.80                      | 0.276         | 1.44 | 50'            | EL              | 24.5                                |  |
|                    | SNS7B      | 42.000            | --                      | 1.370                       | 57.54         | 1.4                    | 0.276                     | 1.87          | 50'  | EL              | 24.5                                | 0.531                     | 1.91          | 50'  | EL              | 2.45                                | 0.80             | 0.276                     | 1.37          | 50'  | EL             | 24.5            |                                     |  |
|                    | TTST       | TNAGRIT3          | 33.000                  | --                          | 1.761         | 58.118                 | 1.4                       | 0.276         | 2.4  | 50'             | EL                                  | 24.5                      | 0.531         | 2.25 | 50'             | EL                                  | 2.45             | 0.80                      | 0.276         | 1.76 | 50'            | EL              | 24.5                                |  |
|                    |            | TNT4A             | 33.075                  | --                          | 1.777         | 58.759                 | 1.4                       | 0.276         | 2.42 | 50'             | EL                                  | 24.5                      | 0.531         | 2.17 | 50'             | EL                                  | 2.45             | 0.80                      | 0.276         | 1.78 | 50'            | EL              | 24.5                                |  |
|                    |            | TNT6A             | 41.600                  | --                          | 1.480         | 61.558                 | 1.4                       | 0.276         | 2.01 | 50'             | EL                                  | 24.5                      | 0.531         | 2.08 | 50'             | EL                                  | 2.45             | 0.80                      | 0.276         | 1.48 | 50'            | EL              | 24.5                                |  |
|                    |            | TNT7A             | 42.000                  | --                          | 1.502         | 63.087                 | 1.4                       | 0.276         | 2.05 | 50'             | EL                                  | 24.5                      | 0.531         | 1.94 | 50'             | EL                                  | 2.45             | 0.80                      | 0.276         | 1.50 | 50'            | EL              | 24.5                                |  |
|                    |            | TNT7B             | 42.000                  | --                          | 1.566         | 65.773                 | 1.4                       | 0.276         | 2.13 | 50'             | EL                                  | 24.5                      | 0.531         | 1.84 | 50'             | EL                                  | 2.45             | 0.80                      | 0.276         | 1.57 | 50'            | EL              | 24.5                                |  |
|                    |            | TNAGRIT4          | 43.000                  | --                          | 1.486         | 63.902                 | 1.4                       | 0.276         | 2.02 | 50'             | EL                                  | 24.5                      | 0.531         | 1.77 | 50'             | EL                                  | 2.45             | 0.80                      | 0.276         | 1.49 | 50'            | EL              | 24.5                                |  |
| TNAGT5A            |            | 45.000            | --                      | 1.388                       | 62.47         | 1.4                    | 0.276                     | 1.89          | 50'  | EL              | 24.5                                | 0.531                     | 1.8           | 50'  | EL              | 2.45                                | 0.80             | 0.276                     | 1.39          | 50'  | EL             | 24.5            |                                     |  |
| TNAGT5B            | 45.000     | 3                 | 1.360                   | 61.206                      | 1.4           | 0.276                  | 1.85                      | 50'           | EL   | 24.5            | 0.531                               | 1.68                      | 50'           | EL   | 2.45            | 0.80                                | 0.276            | <b>1.36</b>               | 50'           | EL   | <b>24.5</b>    |                 |                                     |  |

NOTES:

MINIMUM RATING FACTORS ARE BASED ON THE STRENGTH I AND SERVICE III LIMIT STATES.

ALLOWABLE STRESSES FOR SERVICE III LIMIT STATE ARE AS REQUIRED FOR DESIGN.

COMMENTS:

- 1.
- 2.
- 3.
- 4.

**# CONTROLLING LOAD RATING**

① DESIGN LOAD RATING (HL-93)

② DESIGN LOAD RATING (HS-20)


③ LEGAL LOAD RATING \*\*

\*\* SEE CHART FOR VEHICLE TYPE

---

**GIRDER LOCATION**


I - INTERIOR GIRDER  
 EL - EXTERIOR LEFT GIRDER  
 ER - EXTERIOR RIGHT GIRDER

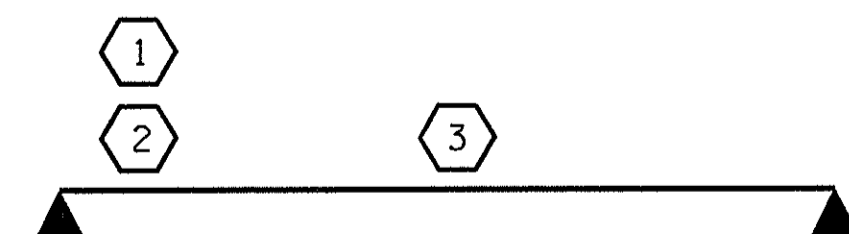

LRFR SUMMARY  
FOR SPAN 'A'

PROJECT NO. BD-5102U  
PITT COUNTY  
 STATION: 17+20.50 -L-

ASSEMBLED BY : A. H. SHIVELY DATE : 6/17/13  
 CHECKED BY : M. L. RORIE DATE : 6/18/13  
 DRAWN BY : CVC 6/10  
 CHECKED BY : DNS 6/10

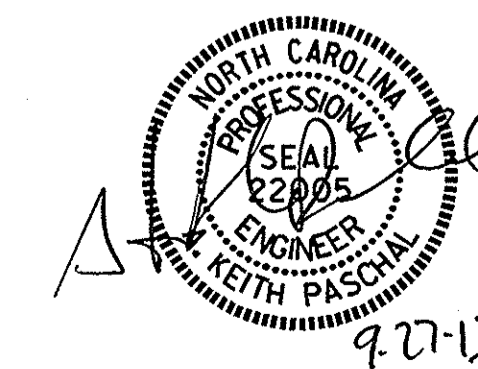

STATE OF NORTH CAROLINA  
 DEPARTMENT OF TRANSPORTATION  
 RALEIGH

STANDARD  
 LRFR SUMMARY FOR  
 50' CORED SLAB UNIT  
 90° SKEW  
 (NON-INTERSTATE TRAFFIC)

| REVISIONS |     |       |     |     |       | SHEET NO.    |
|-----------|-----|-------|-----|-----|-------|--------------|
| NO.       | BY: | DATE: | NO. | BY: | DATE: | S-3          |
| 1         |     |       | 3   |     |       | TOTAL SHEETS |
| 2         |     |       | 4   |     |       | 17           |

LOAD AND RESISTANCE FACTOR RATING (LRFD) SUMMARY FOR PRESTRESSED CONCRETE GIRDERS

LOAD FACTORS:

|                                     |             |               |               |
|-------------------------------------|-------------|---------------|---------------|
| DESIGN<br>LOAD<br>RATING<br>FACTORS | LIMIT STATE | $\gamma_{DC}$ | $\gamma_{DW}$ |
|                                     | STRENGTH I  | 1.25          | 1.50          |
|                                     | SERVICE III | 1.00          | 1.00          |

| LEVEL                    | VEHICLE    | WEIGHT (W)<br>(TONS) | CONTROLLING<br>LOAD RATING | MINIMUM<br>RATING FACTORS<br>(RF) | TONS = W X RF | STRENGTH I LIMIT STATE |                              |               |      |                 |   |                              |               |      |                     | SERVICE III LIMIT STATE |   |                              |               |      | COMMENT NUMBER |                 |   |  |
|--------------------------|------------|----------------------|----------------------------|-----------------------------------|---------------|------------------------|------------------------------|---------------|------|-----------------|---|------------------------------|---------------|------|---------------------|-------------------------|---|------------------------------|---------------|------|----------------|-----------------|---|--|
|                          |            |                      |                            |                                   |               | LIVELOAD<br>FACTORS    | MOMENT                       |               |      |                 | SHEAR                                     |                              |               |      | LIVELOAD<br>FACTORS | MOMENT                  |   |                              |               |      |                |                 |   |  |
|                          |            |                      |                            |                                   |               |                        | DISTRIBUTION<br>FACTORS (DF) | RATING FACTOR | SPAN | GIRDER LOCATION | DISTANCE FROM<br>LEFT END OF<br>SPAN (ft) | DISTRIBUTION<br>FACTORS (DF) | RATING FACTOR | SPAN |                     | GIRDER LOCATION         | DISTANCE FROM<br>LEFT END OF<br>SPAN (ft) | DISTRIBUTION<br>FACTORS (DF) | RATING FACTOR | SPAN |                | GIRDER LOCATION | DISTANCE FROM<br>LEFT END OF<br>SPAN (ft) |  |
| DESIGN<br>LOAD<br>RATING | HL-93(InV) | N/A                  | 1                          | 1.032                             | --            | 1.75                   | 0.28                         | 1.36          | 35'  | EL              | 17  | 0.561                        | <b>1.03</b>   | 35'  | EL                  | 1.7                     | 0.80                                      | 0.28                         | 1.05          | 35'  | EL             | 17              |   |  |
|                          | HL-93(0pr) | N/A                  | --                         | 1.338                             | --            | 1.35                   | 0.28                         | 1.77          | 35'  | EL              | 17  | 0.561                        | 1.34          | 35'  | EL                  | 1.7                     | N/A                                       | --                           | --            | --   | --             | --              |   |  |
|                          | HS-20(InV) | 36,000               | 2                          | 1.189                             | 42,810        | 1.75                   | 0.28                         | 1.79          | 35'  | EL              | 13.6                                      | 0.561                        | <b>1.19</b>   | 35'  | EL                  | 1.7                     | 0.80                                      | 0.28                         | 1.39          | 35'  | EL             | 17              |   |  |
|                          | HS-20(0pr) | 36,000               | --                         | 1.542                             | 55,494        | 1.35                   | 0.28                         | 2.32          | 35'  | EL              | 13.6                                      | 0.561                        | 1.54          | 35'  | EL                  | 1.7                     | N/A                                       | --                           | --            | --   | --             | --              |   |  |
| LEGAL<br>LOAD<br>RATING  | SV         | SNSH                 | 13,500                     | --                                | 2,400         | 32,402                 | 1.4                          | 0.28          | 3.89 | 35'             | EL  | 17                           | 0.561         | 3.06 | 35'                 | EL                      | 1.7                                       | 0.80                         | 0.28          | 2.40 | 35'            | EL              | 17  |  |
|                          |            | SNGARBS2             | 20,000                     | --                                | 2,052         | 41,044                 | 1.4                          | 0.28          | 3.29 | 35'             | EL  | 13.6                         | 0.561         | 2.32 | 35'                 | EL                      | 1.7                                       | 0.80                         | 0.28          | 2.05 | 35'            | EL              | 13.6                                      |  |
|                          |            | SNAGRIS2             | 22,000                     | --                                | 2,053         | 45,174                 | 1.4                          | 0.28          | 3.26 | 35'             | EL  | 13.6                         | 0.561         | 2.21 | 35'                 | EL                      | 1.7                                       | 0.80                         | 0.28          | 2.05 | 35'            | EL              | 13.6                                      |  |
|                          |            | SNCOTTS3             | 27,250                     | --                                | 1,202         | 32,744                 | 1.4                          | 0.28          | 1.95 | 35'             | EL  | 17                           | 0.561         | 1.54 | 35'                 | EL                      | 1.7                                       | 0.80                         | 0.28          | 1.20 | 35'            | EL              | 17  |  |
|                          |            | SNAGGRS4             | 34,925                     | --                                | 1,111         | 38,816                 | 1.4                          | 0.28          | 1.8  | 35'             | EL  | 17                           | 0.561         | 1.38 | 35'                 | EL                      | 1.7                                       | 0.80                         | 0.28          | 1.11 | 35'            | EL              | 17  |  |
|                          |            | SNS5A                | 35,550                     | --                                | 1,079         | 38,354                 | 1.4                          | 0.28          | 1.75 | 35'             | EL  | 17                           | 0.561         | 1.46 | 35'                 | EL                      | 1.7                                       | 0.80                         | 0.28          | 1.08 | 35'            | EL              | 17  |  |
|                          |            | SNS6A                | 39,950                     | --                                | 1,041         | 41,601                 | 1.4                          | 0.28          | 1.69 | 35'             | EL  | 17                           | 0.561         | 1.37 | 35'                 | EL                      | 1.7                                       | 0.80                         | 0.28          | 1.04 | 35'            | EL              | 17  |  |
|                          | SNS7B      | 42,000               | 3                          | 1,000                             | 41,734        | 1.4                    | 0.28                         | 1.61          | 35'  | EL              | 17  | 0.561                        | 1.4           | 35'  | EL                  | 1.7                     | 0.80                                      | 0.28                         | <b>1.00</b>   | 35'  | EL             | 17              |   |  |
|                          | TTST       | TNAGRIT3             | 33,000                     | --                                | 1,286         | 42,439                 | 1.4                          | 0.28          | 2.08 | 35'             | EL  | 17                           | 0.561         | 1.6  | 35'                 | EL                      | 1.7                                       | 0.80                         | 0.28          | 1.29 | 35'            | EL              | 17  |  |
|                          |            | TNT4A                | 33,075                     | --                                | 1,285         | 42,512                 | 1.4                          | 0.28          | 2.08 | 35'             | EL  | 17                           | 0.561         | 1.51 | 35'                 | EL                      | 1.7                                       | 0.80                         | 0.28          | 1.29 | 35'            | EL              | 17  |  |
|                          |            | TNT6A                | 41,600                     | --                                | 1,126         | 46,84                  | 1.4                          | 0.28          | 1.82 | 35'             | EL  | 17                           | 0.561         | 1.48 | 35'                 | EL                      | 1.7                                       | 0.80                         | 0.28          | 1.13 | 35'            | EL              | 17  |  |
|                          |            | TNT7A                | 42,000                     | --                                | 1,163         | 48,833                 | 1.4                          | 0.28          | 1.89 | 35'             | EL  | 17                           | 0.561         | 1.37 | 35'                 | EL                      | 1.7                                       | 0.80                         | 0.28          | 1.16 | 35'            | EL              | 17  |  |
|                          |            | TNT7B                | 42,000                     | --                                | 1,144         | 48,061                 | 1.4                          | 0.28          | 1.85 | 35'             | EL  | 17                           | 0.561         | 1.33 | 35'                 | EL                      | 1.7                                       | 0.80                         | 0.28          | 1.14 | 35'            | EL              | 17  |  |
|                          |            | TNAGRIT4             | 43,000                     | --                                | 1,158         | 49,810                 | 1.4                          | 0.28          | 1.86 | 35'             | EL  | 13.6                         | 0.561         | 1.28 | 35'                 | EL                      | 1.7                                       | 0.80                         | 0.28          | 1.16 | 35'            | EL              | 17  |  |
| TNAGT5A                  |            | 45,000               | --                         | 1,068                             | 48,071        | 1.4                    | 0.28                         | 1.73          | 35'  | EL              | 17  | 0.561                        | 1.35          | 35'  | EL                  | 1.7                     | 0.80                                      | 0.28                         | 1.07          | 35'  | EL             | 17              |   |  |
| TNAGT5B                  | 45,000     | --                   | 1,031                      | 46,373                            | 1.4           | 0.28                   | 1.67                         | 35'           | EL   | 17              | 0.561                                     | 1.21                         | 35'           | EL   | 1.7                 | 0.80                    | 0.28                                      | 1.03                         | 35'           | EL   | 17             |                 |   |  |

NOTES:

MINIMUM RATING FACTORS ARE BASED ON THE STRENGTH I AND SERVICE III LIMIT STATES.

ALLOWABLE STRESSES FOR SERVICE III LIMIT STATE ARE AS REQUIRED FOR DESIGN.

COMMENTS:

- 1.
- 2.
- 3.
- 4.

# CONTROLLING LOAD RATING

1 DESIGN LOAD RATING (HL-93)

2 DESIGN LOAD RATING (HS-20)


3 LEGAL LOAD RATING \*\*

\*\* SEE CHART FOR VEHICLE TYPE

---

GIRDER LOCATION

I - INTERIOR GIRDER  
EL - EXTERIOR LEFT GIRDER  
ER - EXTERIOR RIGHT GIRDER

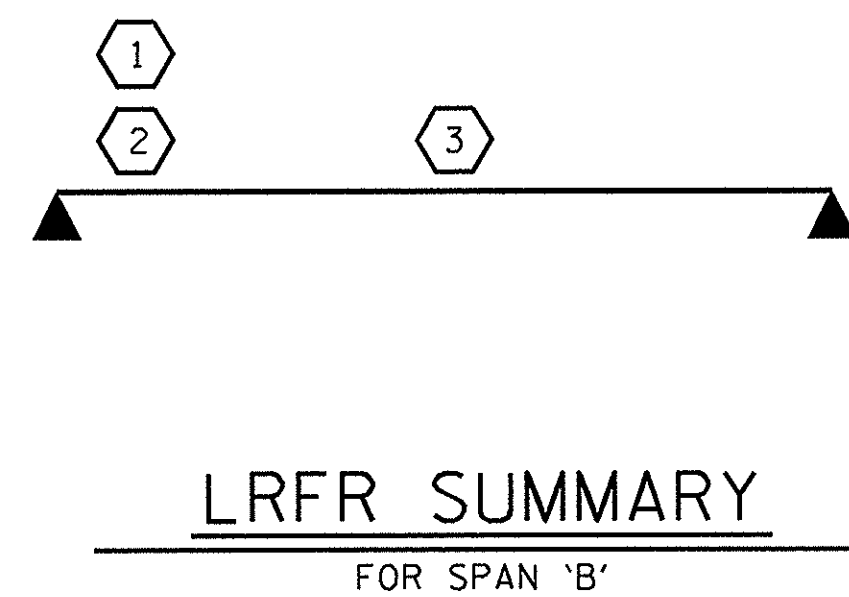

PROJECT NO. BD-5102U  
PITT COUNTY  
STATION: 17+20.50 -L-

STATE OF NORTH CAROLINA  
DEPARTMENT OF TRANSPORTATION  
RALEIGH


STANDARD  
LRFR SUMMARY FOR  
35' CORED SLAB UNIT  
90° SKEW  
(NON-INTERSTATE TRAFFIC)

| REVISIONS |     |       |     |     |       | SHEET NO.    |
|-----------|-----|-------|-----|-----|-------|--------------|
| NO.       | BY: | DATE: | NO. | BY: | DATE: | S-4          |
| 1         |     |       | 3   |     |       | TOTAL SHEETS |
| 2         |     |       | 4   |     |       | 17           |




ASSEMBLED BY : A. H. SHIVELY DATE : 6/17/13  
CHECKED BY : M. L. RORIE DATE : 6/18/13

DRAWN BY : CVC 6/10  
CHECKED BY : DNS 6/10

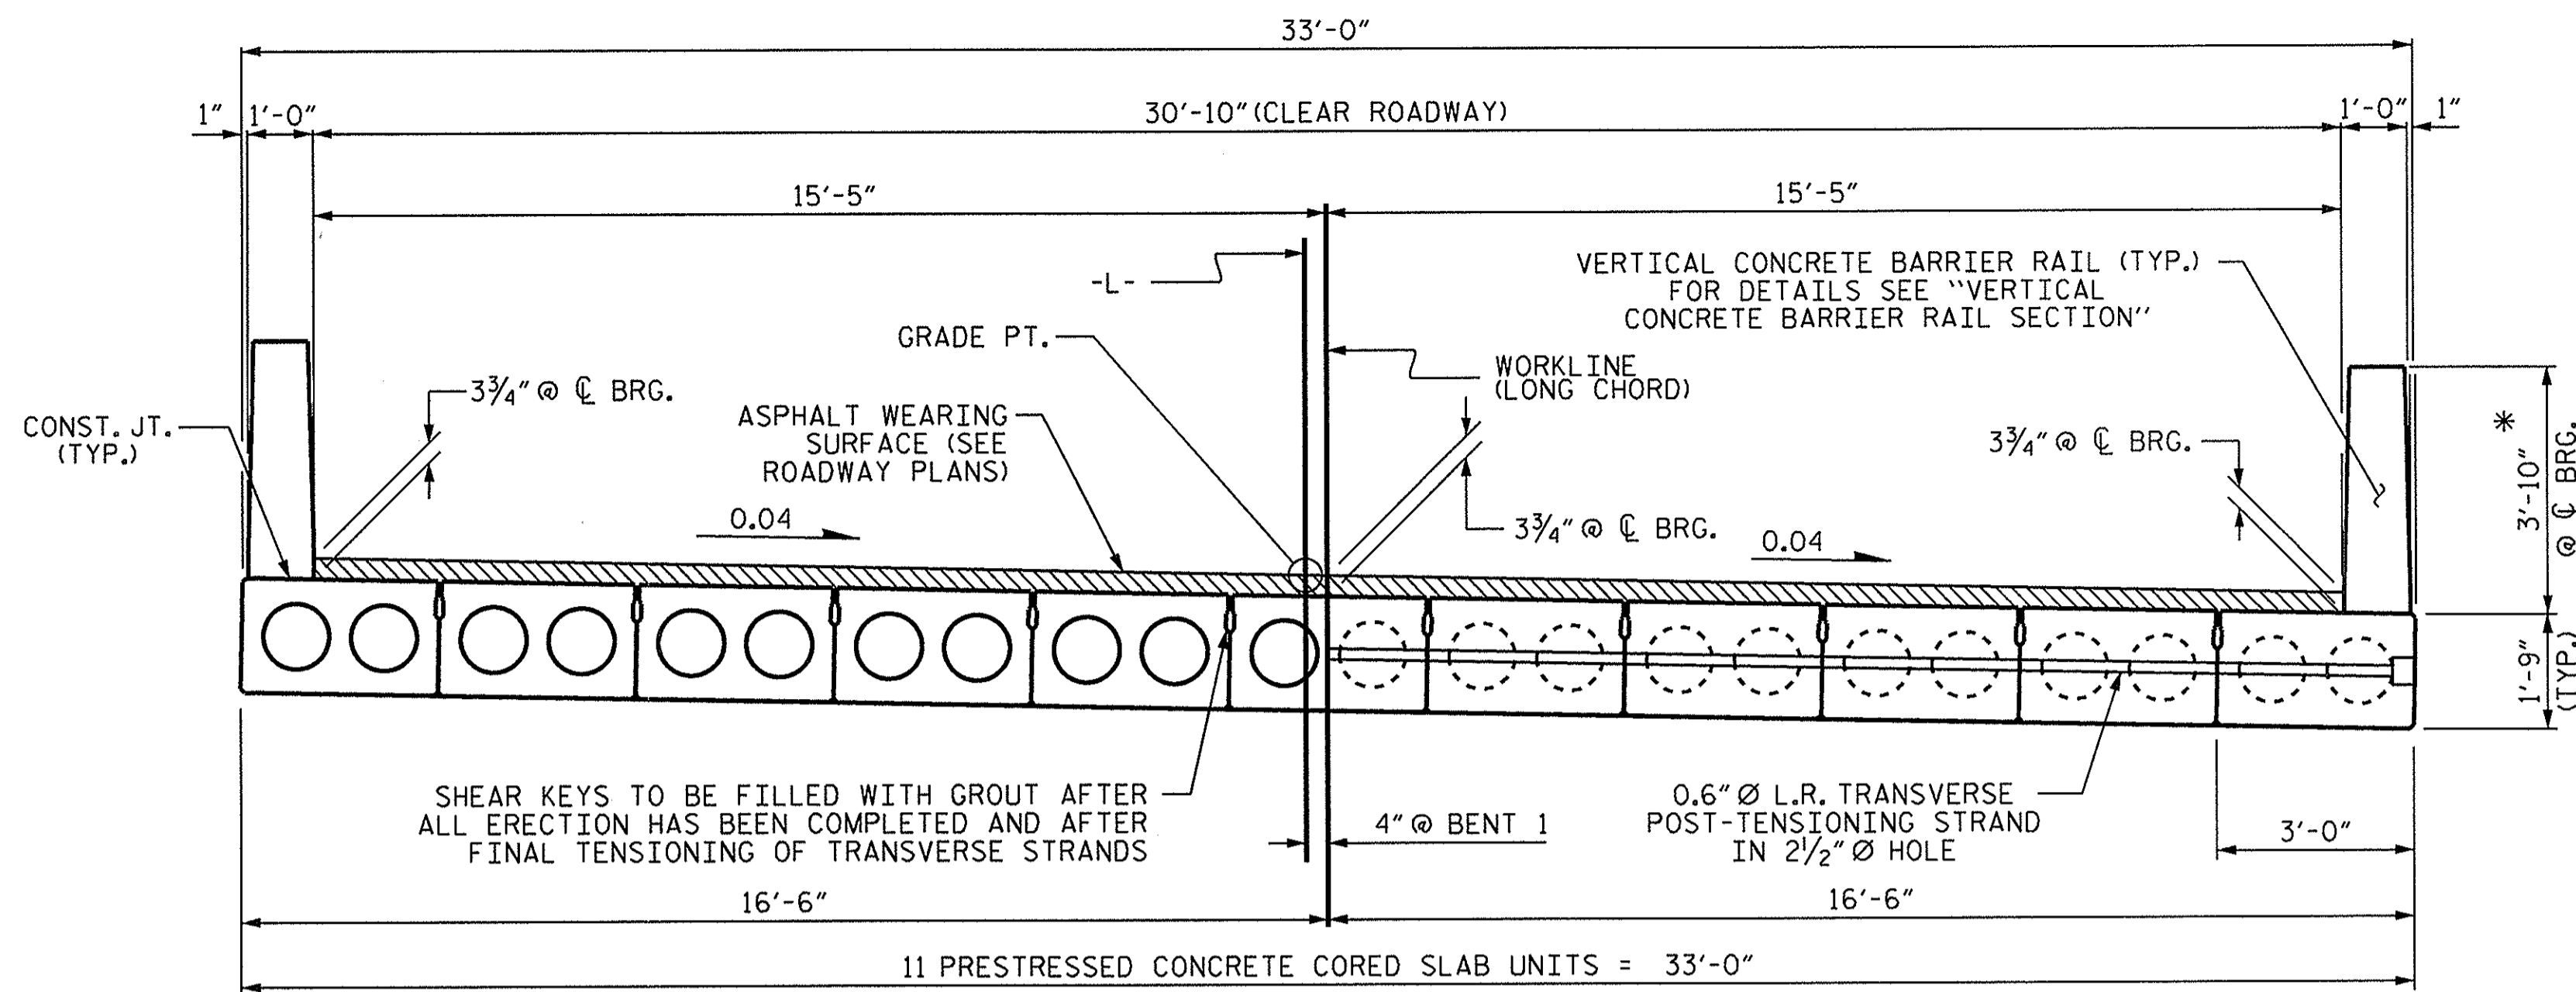


**TYPICAL SECTION**


\* - THE MAXIMUM BARRIER RAIL HEIGHT AND ASPHALT THICKNESS IS SHOWN. THE HEIGHT OF THE BARRIER RAIL AND ASPHALT THICKNESS VARIES WHILE THE TOP OF THE BARRIER RAIL FOLLOWS THE PROFILE OF THE GUTTERLINE. FOR RAIL HEIGHT DETAILS AND ASPHALT THICKNESS SEE THE "VERTICAL CONCRETE BARRIER RAIL SECTION" DETAIL.

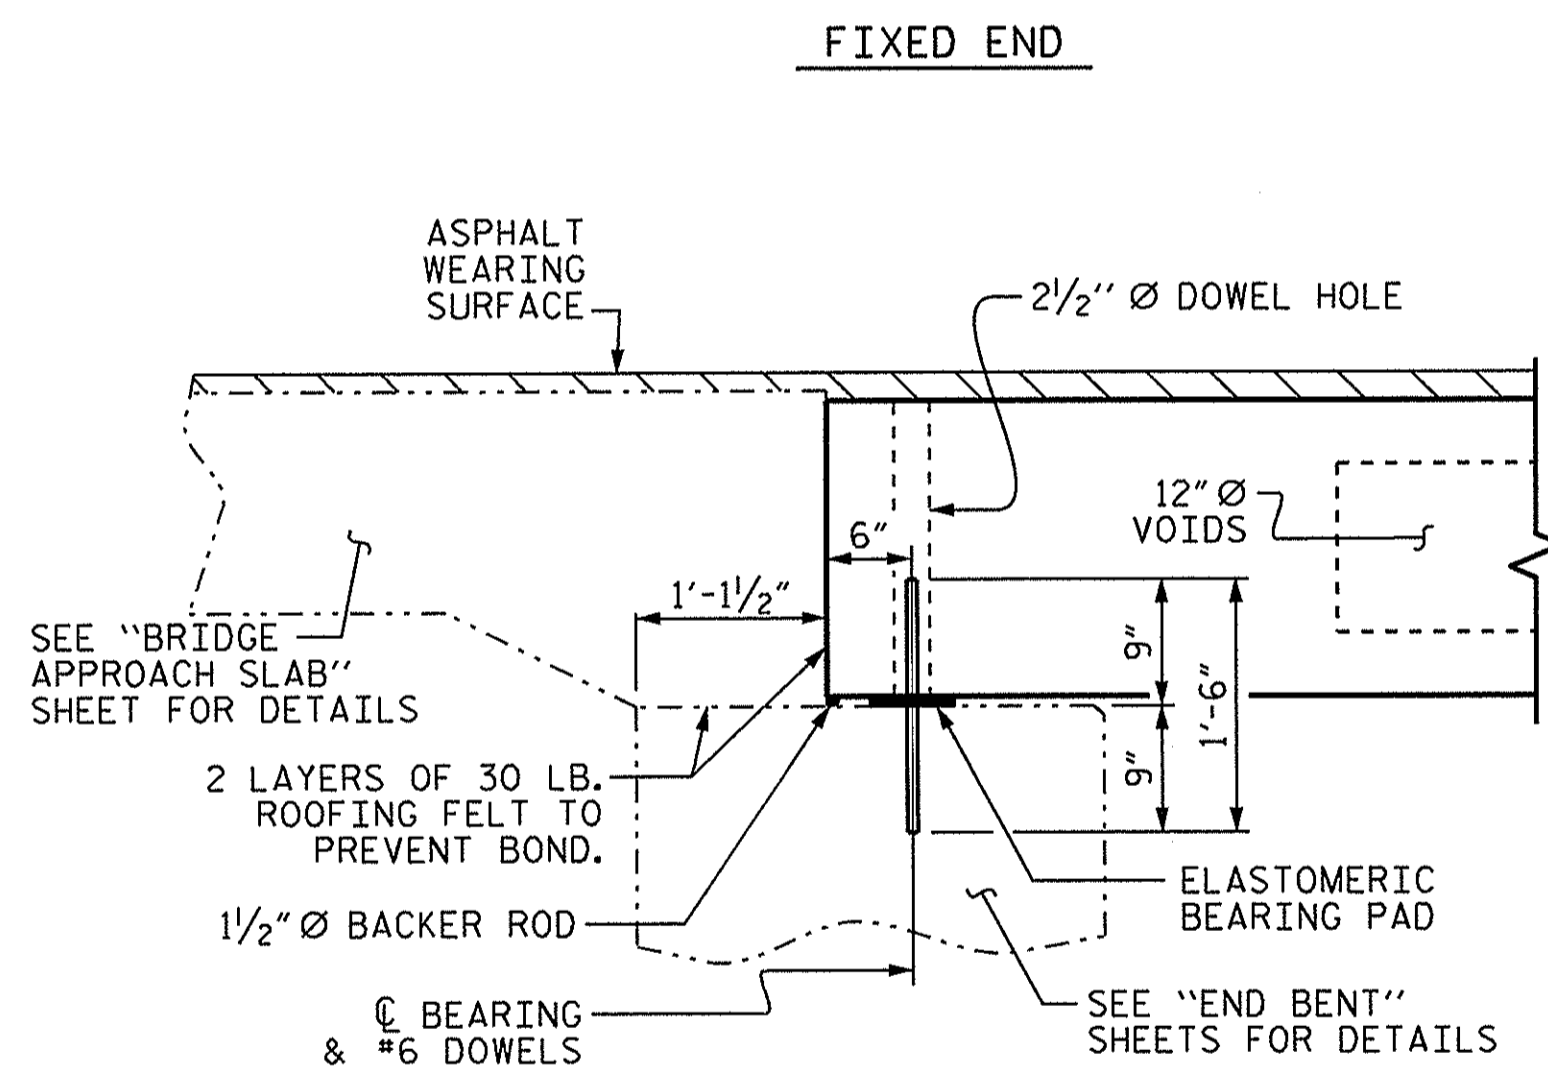


**SECTION AT END BENT**

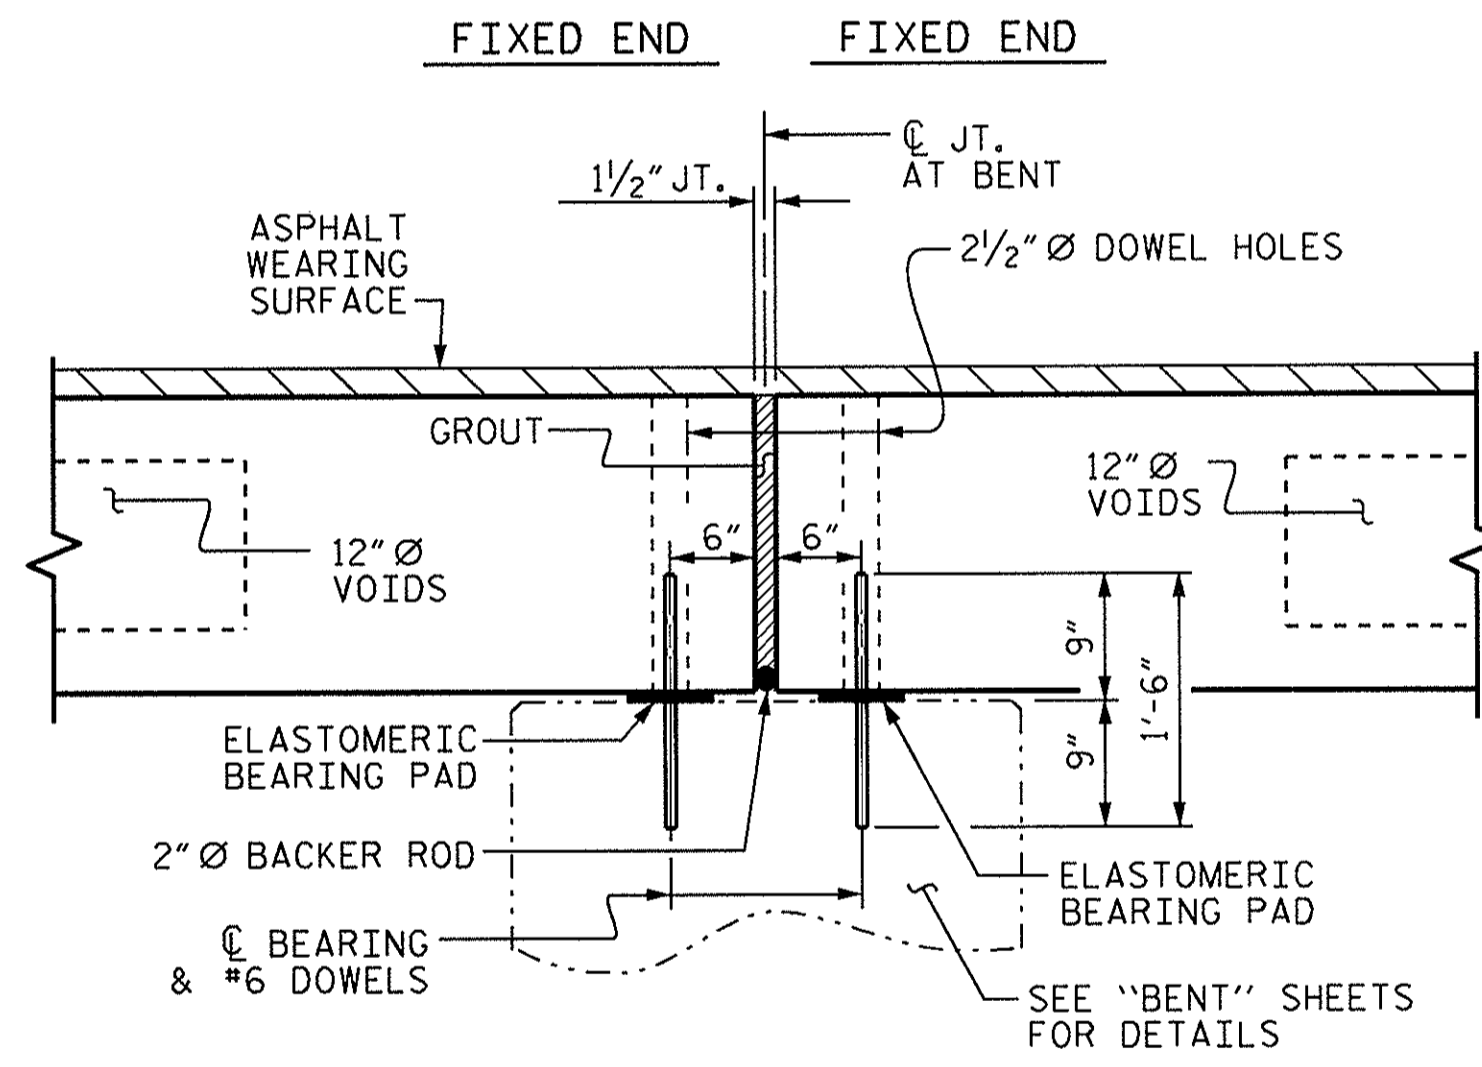

**SECTION AT BENT**

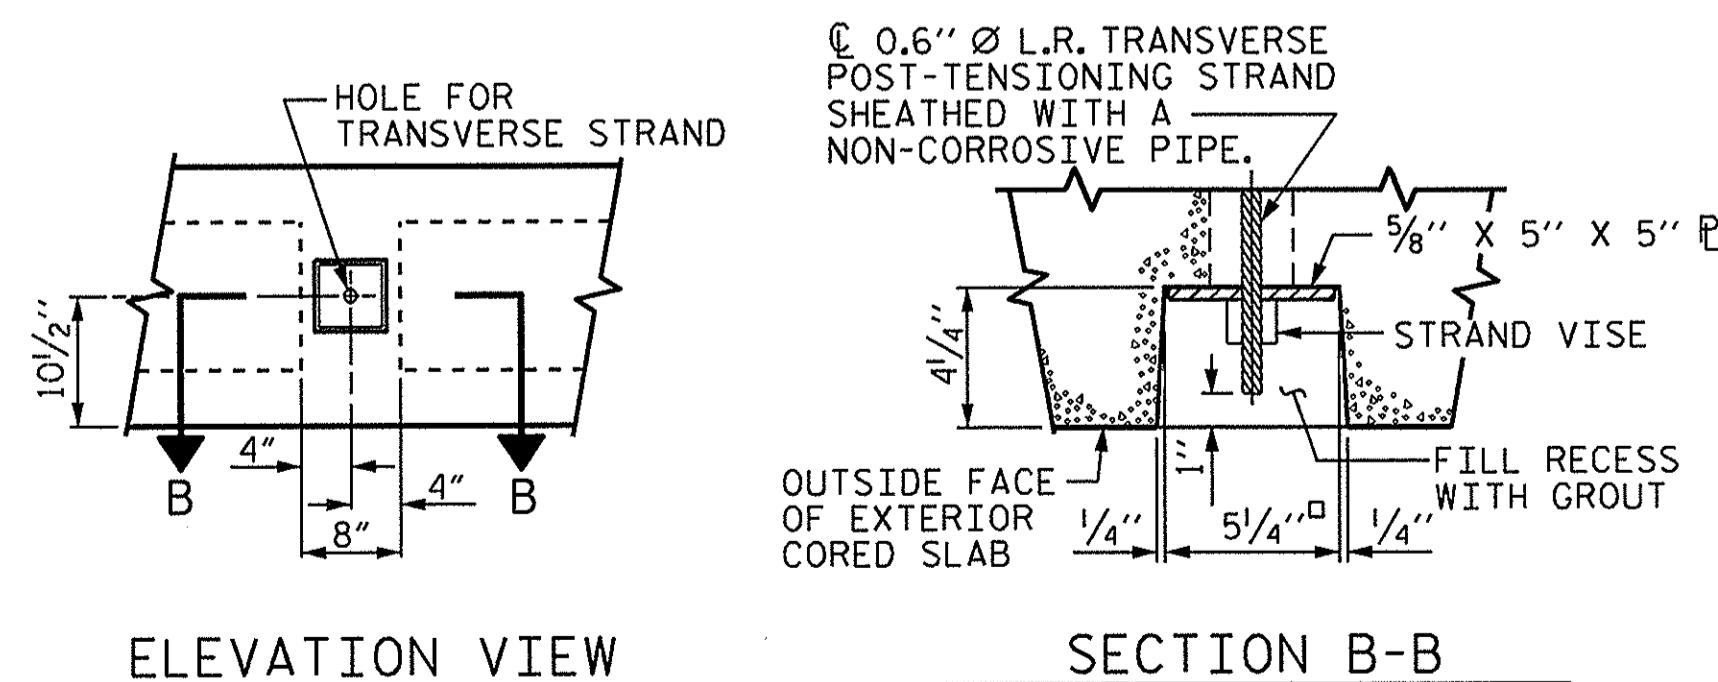


**GROUTED RECESS AT END OF POST-TENSIONED STRAND OF CORED SLABS**

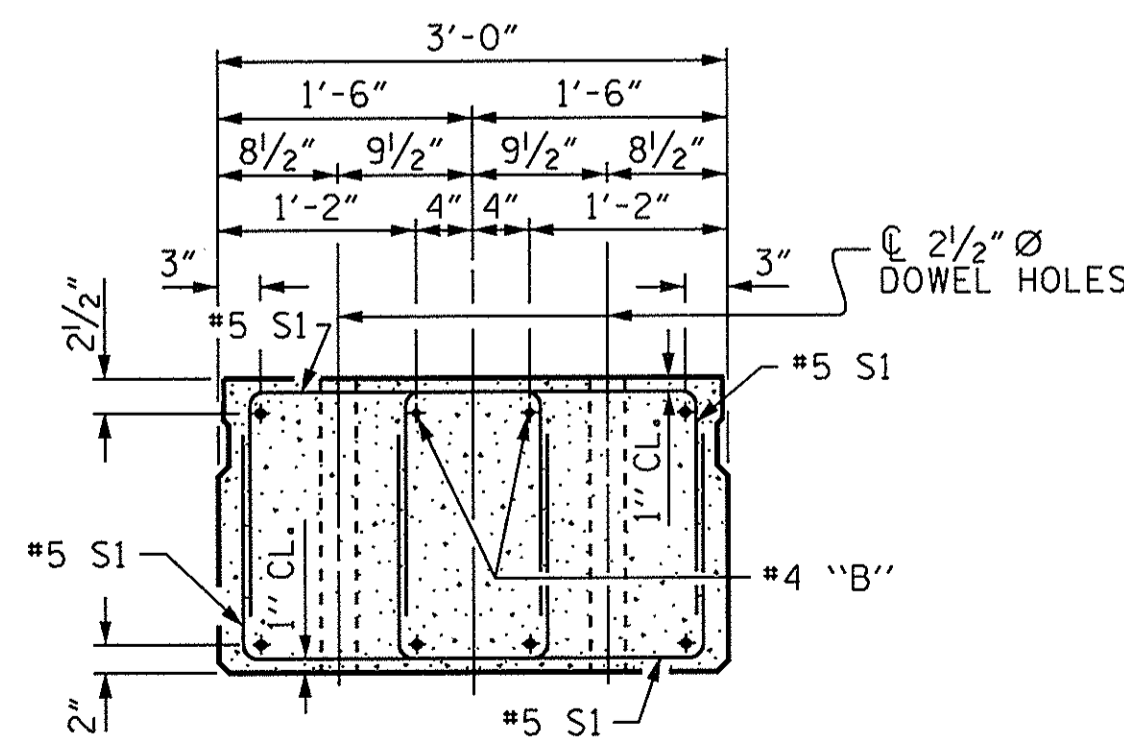


**END ELEVATION**

SHOWING PLACEMENT OF DOUBLE STIRRUPS AND LOCATION OF DOWEL HOLES. (STRAND LAYOUT NOT SHOWN.) INTERIOR SLAB UNIT SHOWN-EXTERIOR SLAB UNIT SIMILAR EXCEPT SHEAR KEY LOCATION.

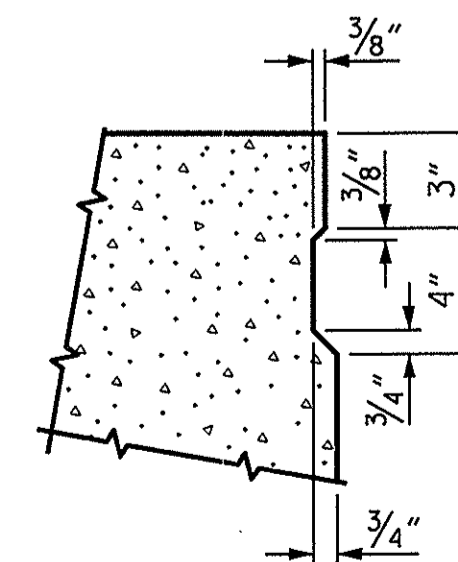


**SHEAR KEY DETAIL**


NOTE: OMIT SHEAR KEY ON OUTSIDE FACE OF EXTERIOR CORED SLABS.

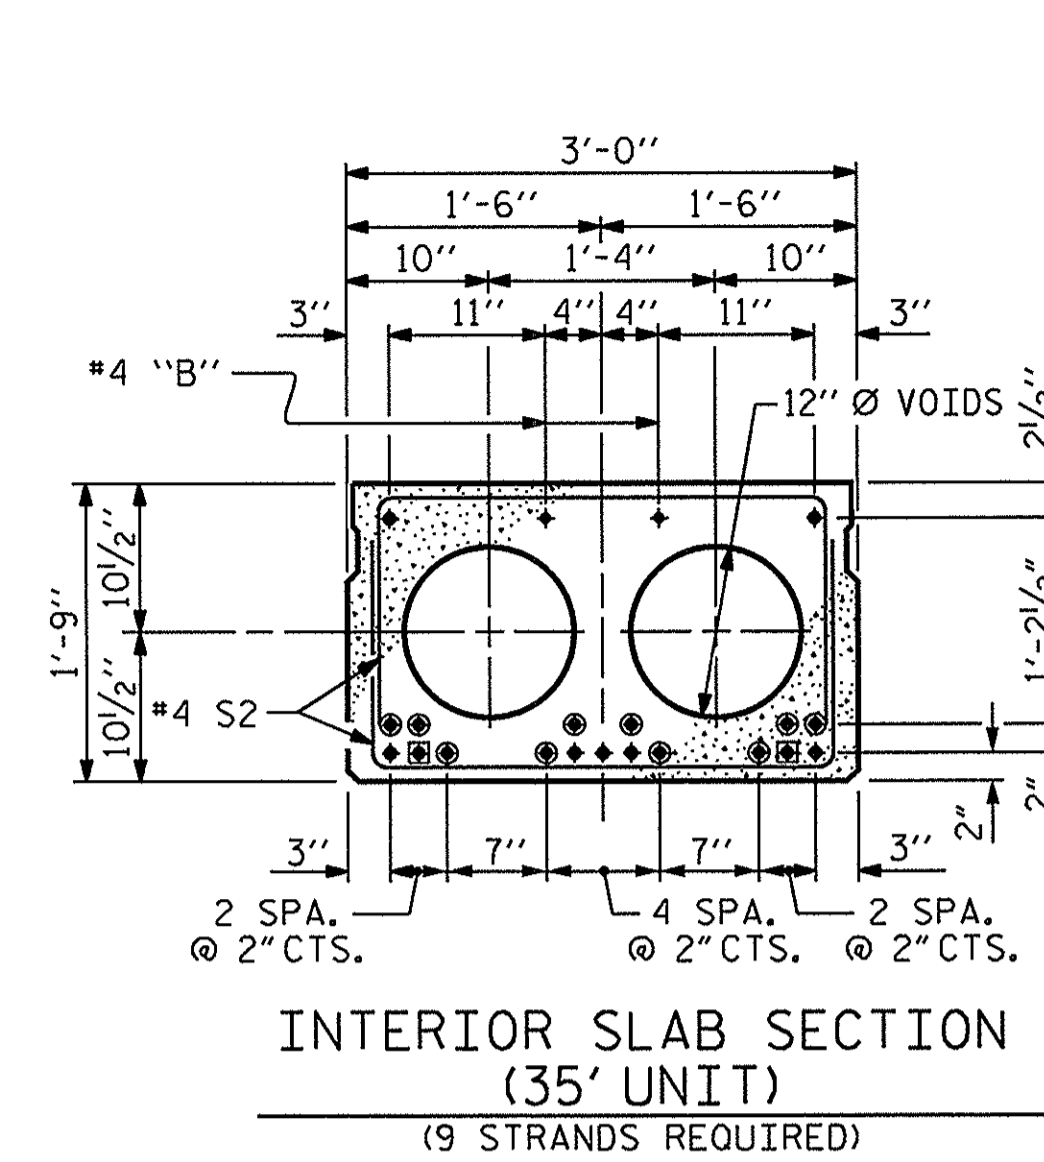

**INTERIOR SLAB SECTION (35' UNIT)**  
(9 STRANDS REQUIRED)

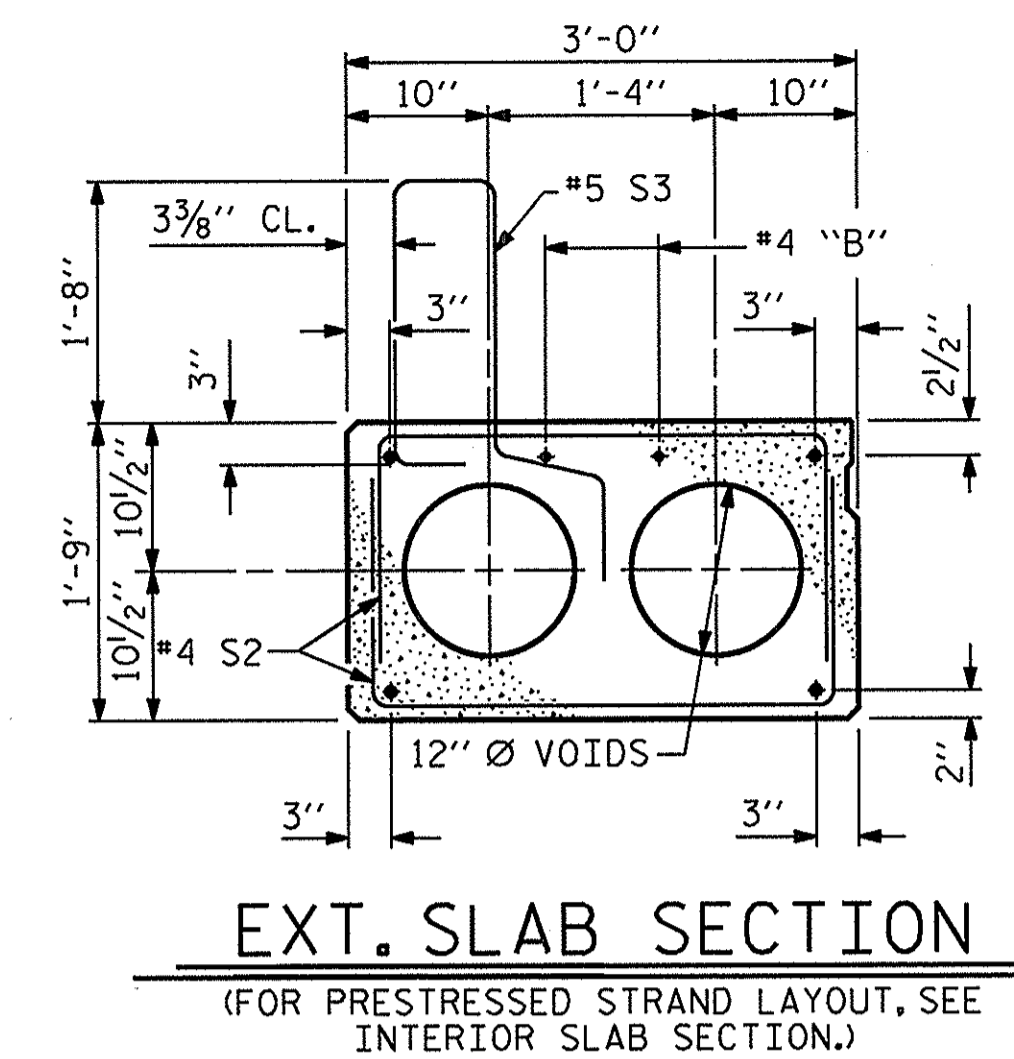

**EXT. SLAB SECTION**  
(FOR PRESTRESSED STRAND LAYOUT, SEE INTERIOR SLAB SECTION.)

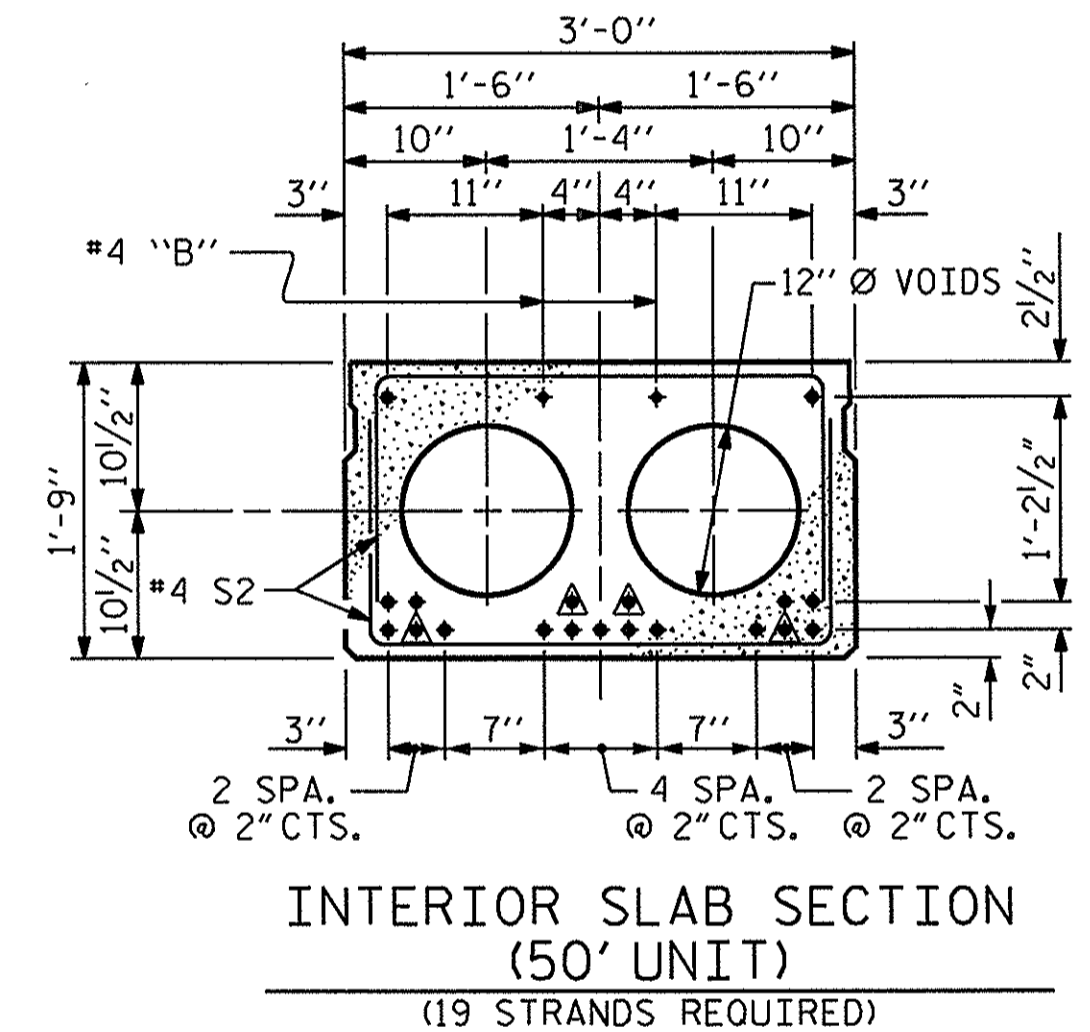

**INTERIOR SLAB SECTION (50' UNIT)**  
(19 STRANDS REQUIRED)  
**0.6" Ø LOW RELAXATION STRAND LAYOUT**


- △ BOND SHALL BE BROKEN ON THESE STRANDS FOR A DISTANCE OF 6'-0" FROM END OF CORED SLAB UNIT. SEE STANDARD SPECIFICATIONS, ARTICLE 1078-7.
- BOND SHALL BE BROKEN ON THESE STRANDS FOR A DISTANCE OF 2'-0" FROM END OF CORED SLAB UNIT. SEE STANDARD SPECIFICATIONS, ARTICLE 1078-7.
- OPTIONAL FULL LENGTH DEBONDED STRANDS. THESE STRANDS ARE NOT REQUIRED, IF THE FABRICATOR CHOOSES TO INCLUDE THESE STRANDS IN THE CORED SLAB UNIT, THE STRANDS SHALL BE DEBONDED FOR THE FULL LENGTH OF THE UNIT AT NO ADDITIONAL COST. SEE STANDARD SPECIFICATIONS, ARTICLE 1078-7.

**DEBONDING LEGEND**

PROJECT NO. BD-5102U  
PITT COUNTY  
STATION: 17+20.50 -L-



SHEET 1 OF 4

STATE OF NORTH CAROLINA  
DEPARTMENT OF TRANSPORTATION  
RALEIGH  
STANDARD  
3'-0" X 1'-9"  
PRESTRESSED CONCRETE  
CORED SLAB UNIT  
90° SKEW

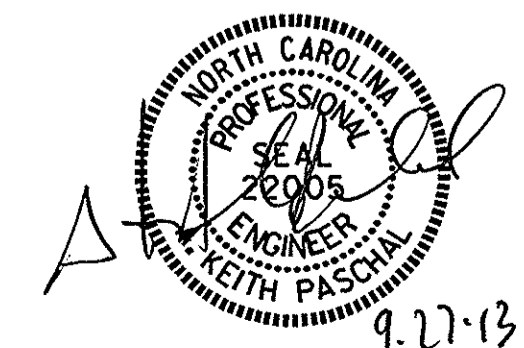

|                              |                |
|------------------------------|----------------|
| ASSEMBLED BY : A. H. SHIVELY | DATE : 6/14/13 |
| CHECKED BY : M. L. RORIE     | DATE : 6/18/13 |
| DRAWN BY : DGE 5/09          | REV. 12/11     |
| CHECKED BY : BCH 6/09        | MAA/AAC        |

| REVISIONS |     |       |     |     |       | SHEET NO.    |
|-----------|-----|-------|-----|-----|-------|--------------|
| NO.       | BY: | DATE: | NO. | BY: | DATE: | S-5          |
| 1         |     |       | 3   |     |       | TOTAL SHEETS |
| 2         |     |       | 4   |     |       | 17           |

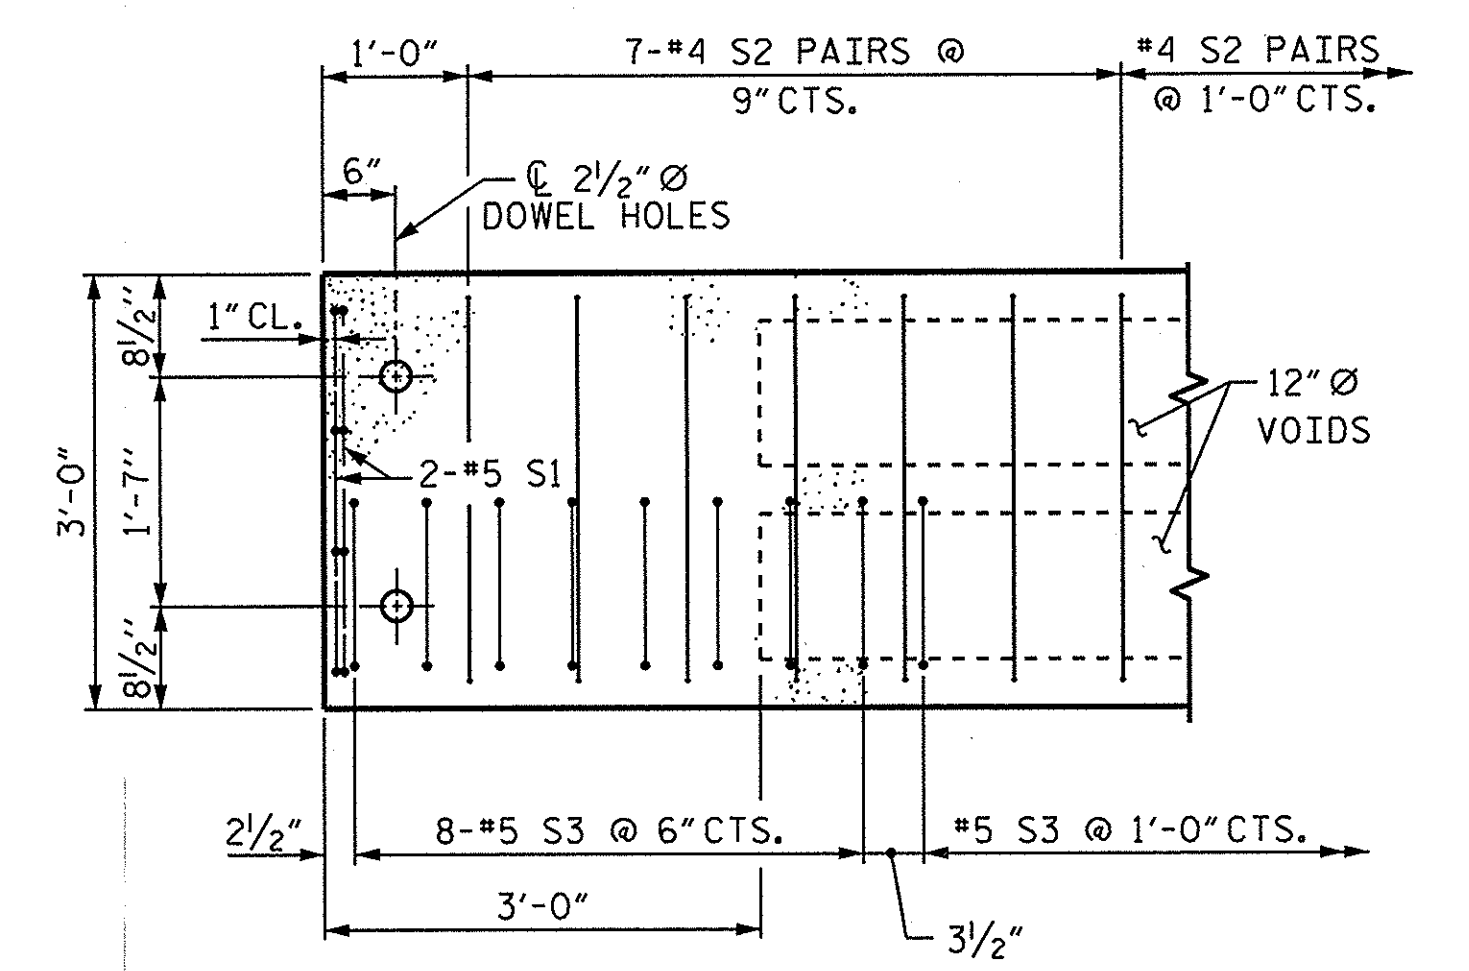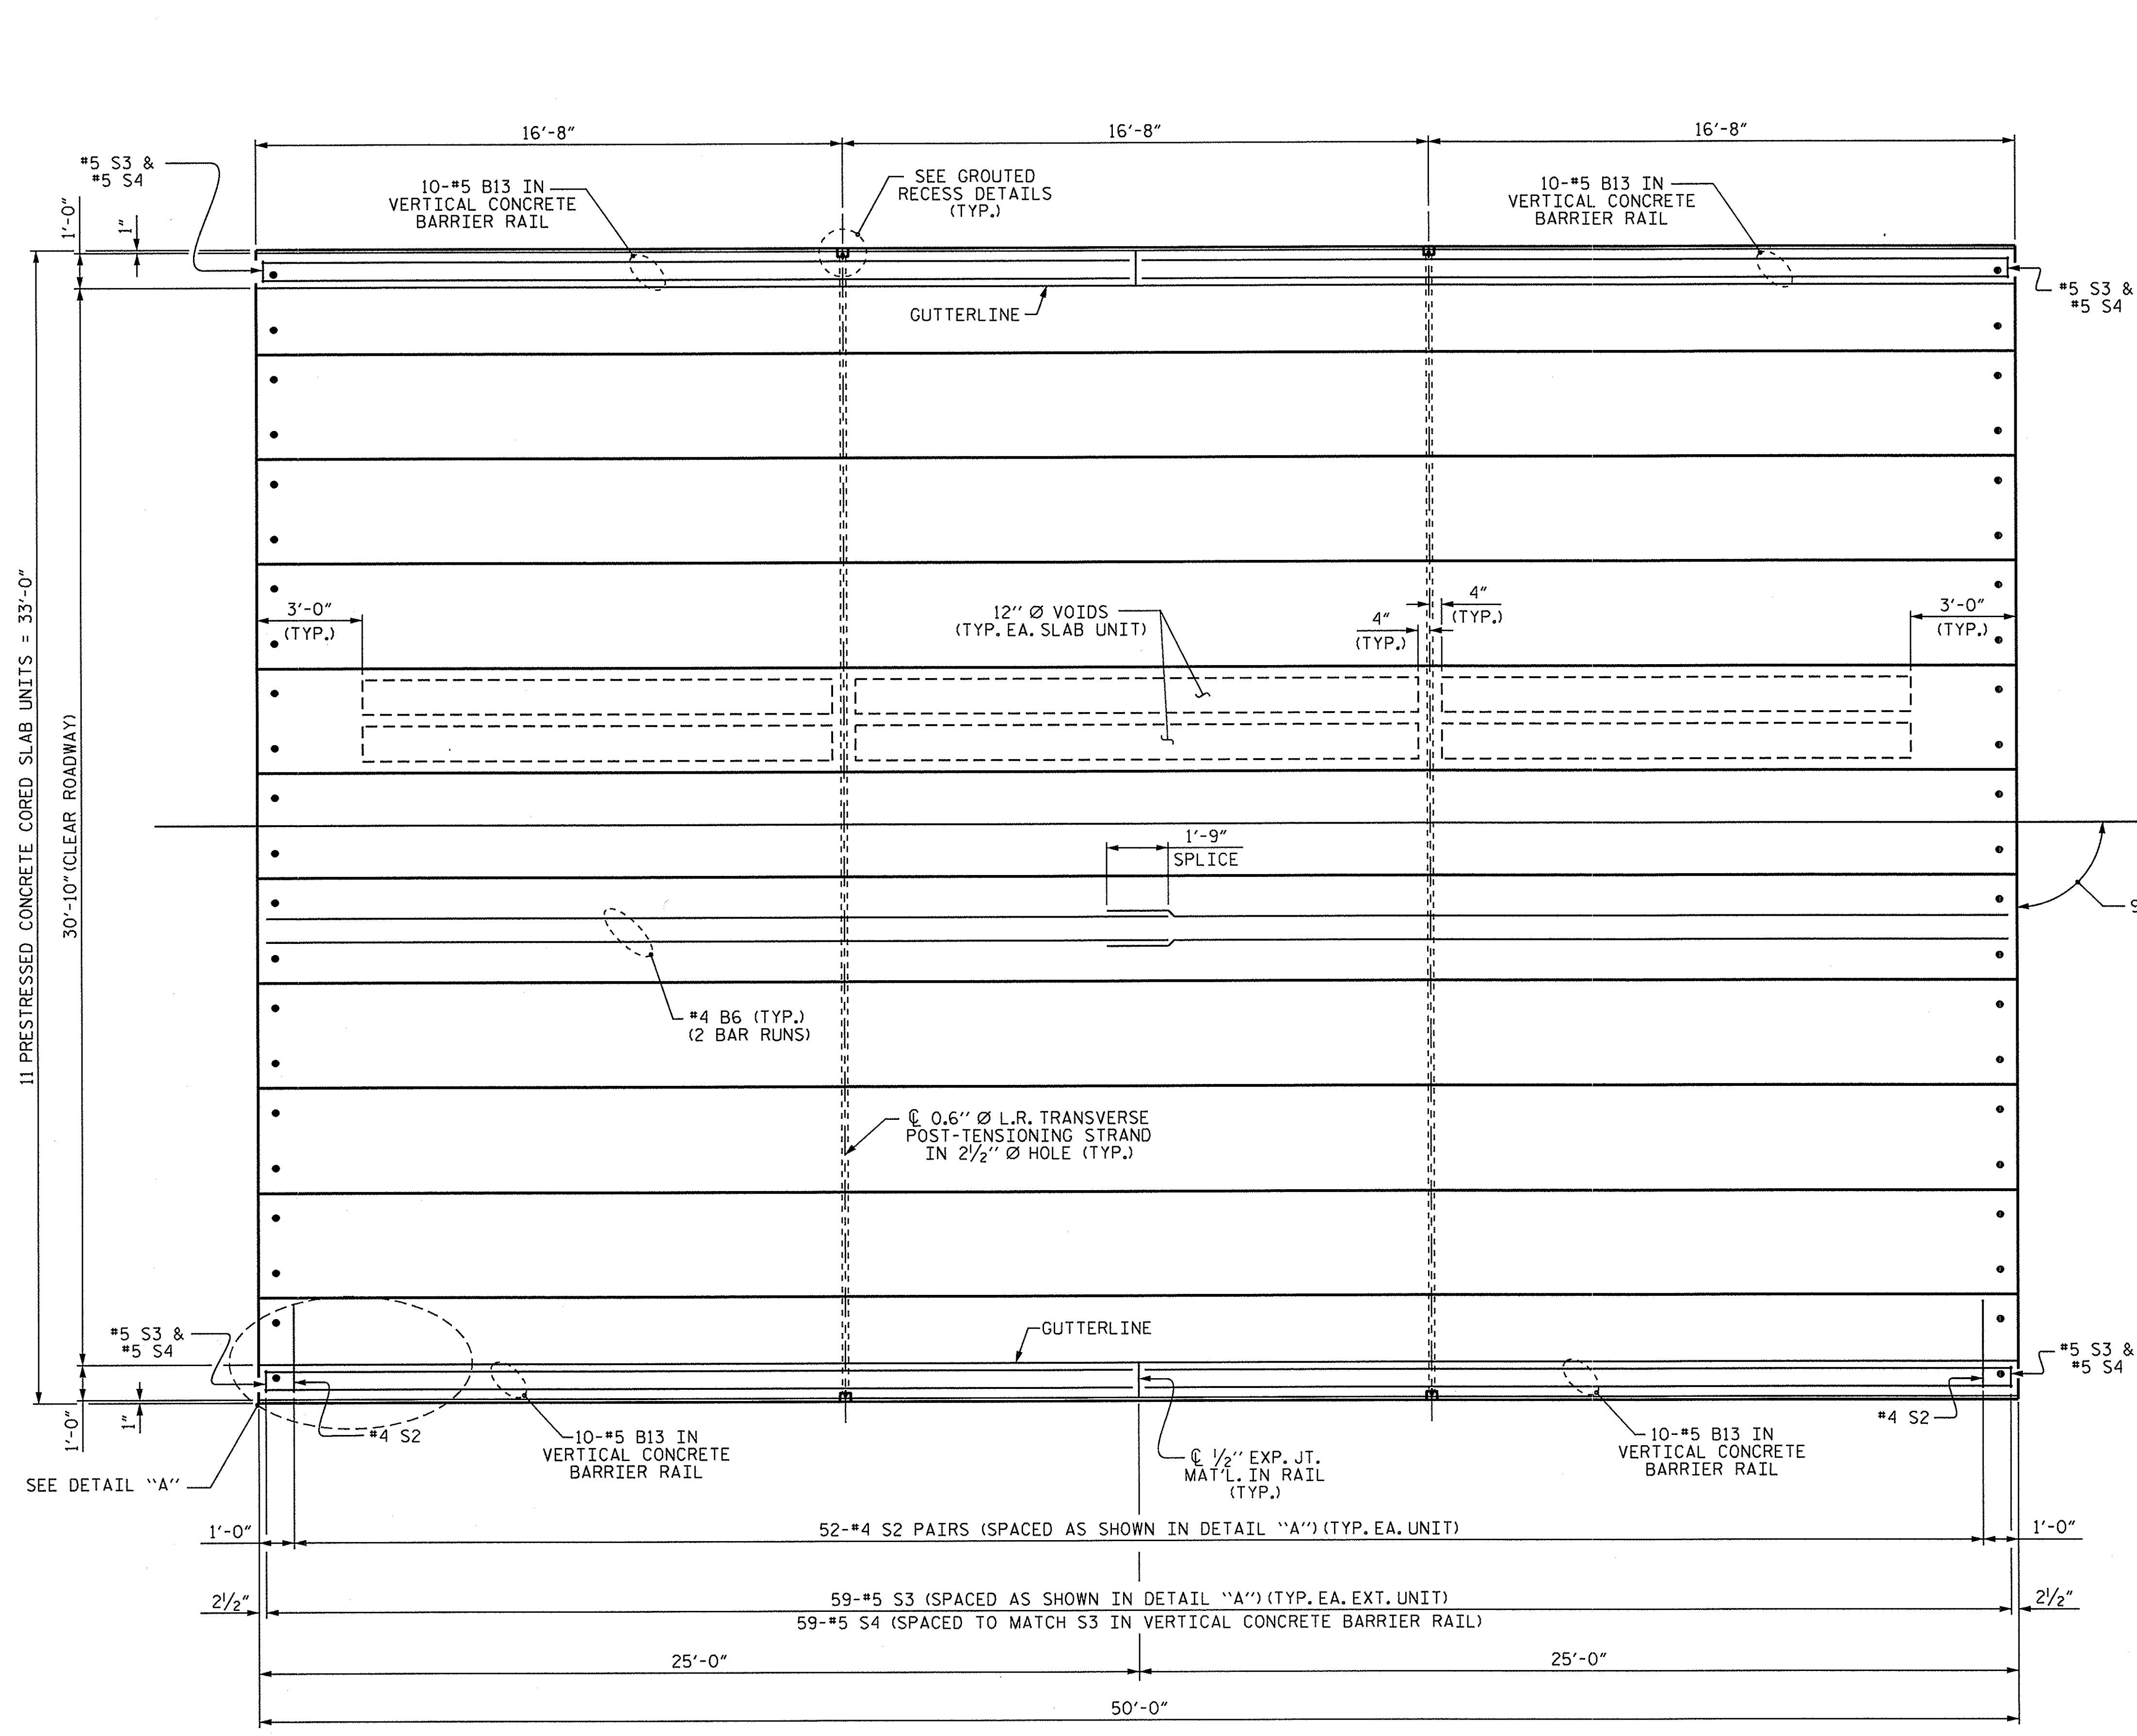


**DETAIL "A"**  
 NOTE: EXTERIOR UNIT SHOWN - INTERIOR UNIT SIMILAR EXCEPT OMIT #5 S3 BARS.

**PLAN OF UNIT**  
 (SPAN A)

PROJECT NO. BD-5102U  
PITT COUNTY  
 STATION: 17+20.50 -L-



SHEET 2 OF 4

STATE OF NORTH CAROLINA  
 DEPARTMENT OF TRANSPORTATION  
 RALEIGH  
 PLAN OF 50' UNIT  
 30'-10" CLEAR ROADWAY  
 90° SKEW

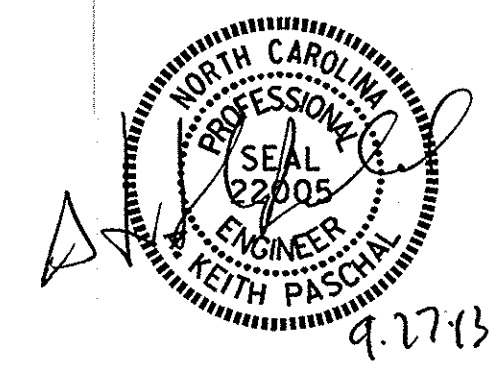

|                              |                      |
|------------------------------|----------------------|
| ASSEMBLED BY : A. H. SHIVELY | DATE : 6/14/13       |
| CHECKED BY : M. L. RORIE     | DATE : 6/18/13       |
| DRAWN BY : DGE 3/09          | REV. 12/5/11 MAA/AAC |
| CHECKED BY : BCH 3/09        |                      |

| REVISIONS |     |       |     |     |       | SHEET NO.    |
|-----------|-----|-------|-----|-----|-------|--------------|
| NO.       | BY: | DATE: | NO. | BY: | DATE: | S-6          |
| 1         |     |       | 3   |     |       | TOTAL SHEETS |
| 2         |     |       | 4   |     |       | 17           |

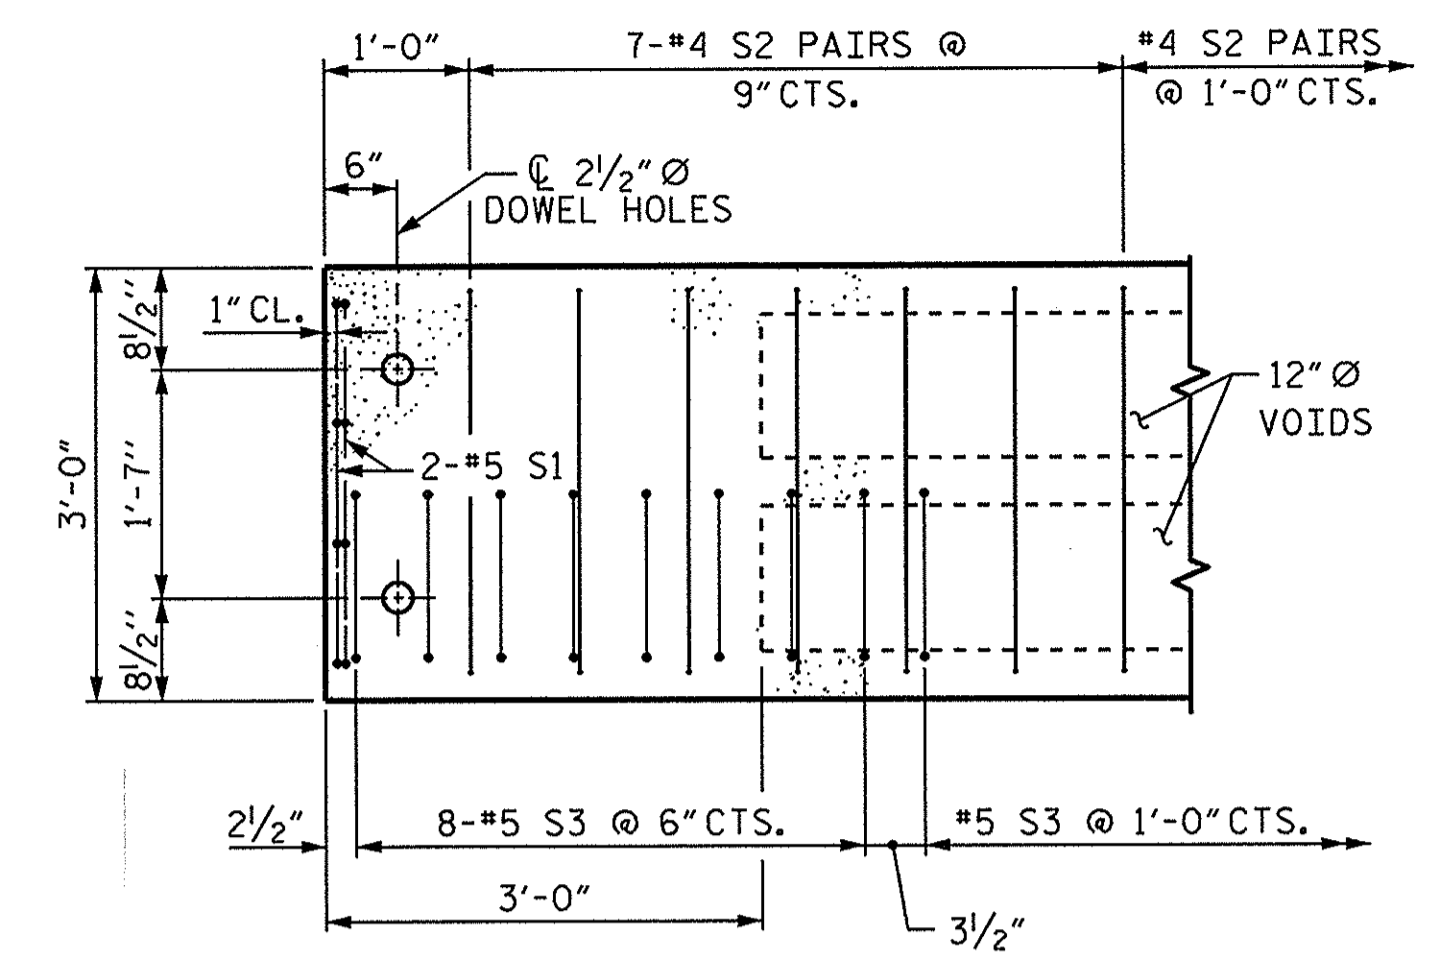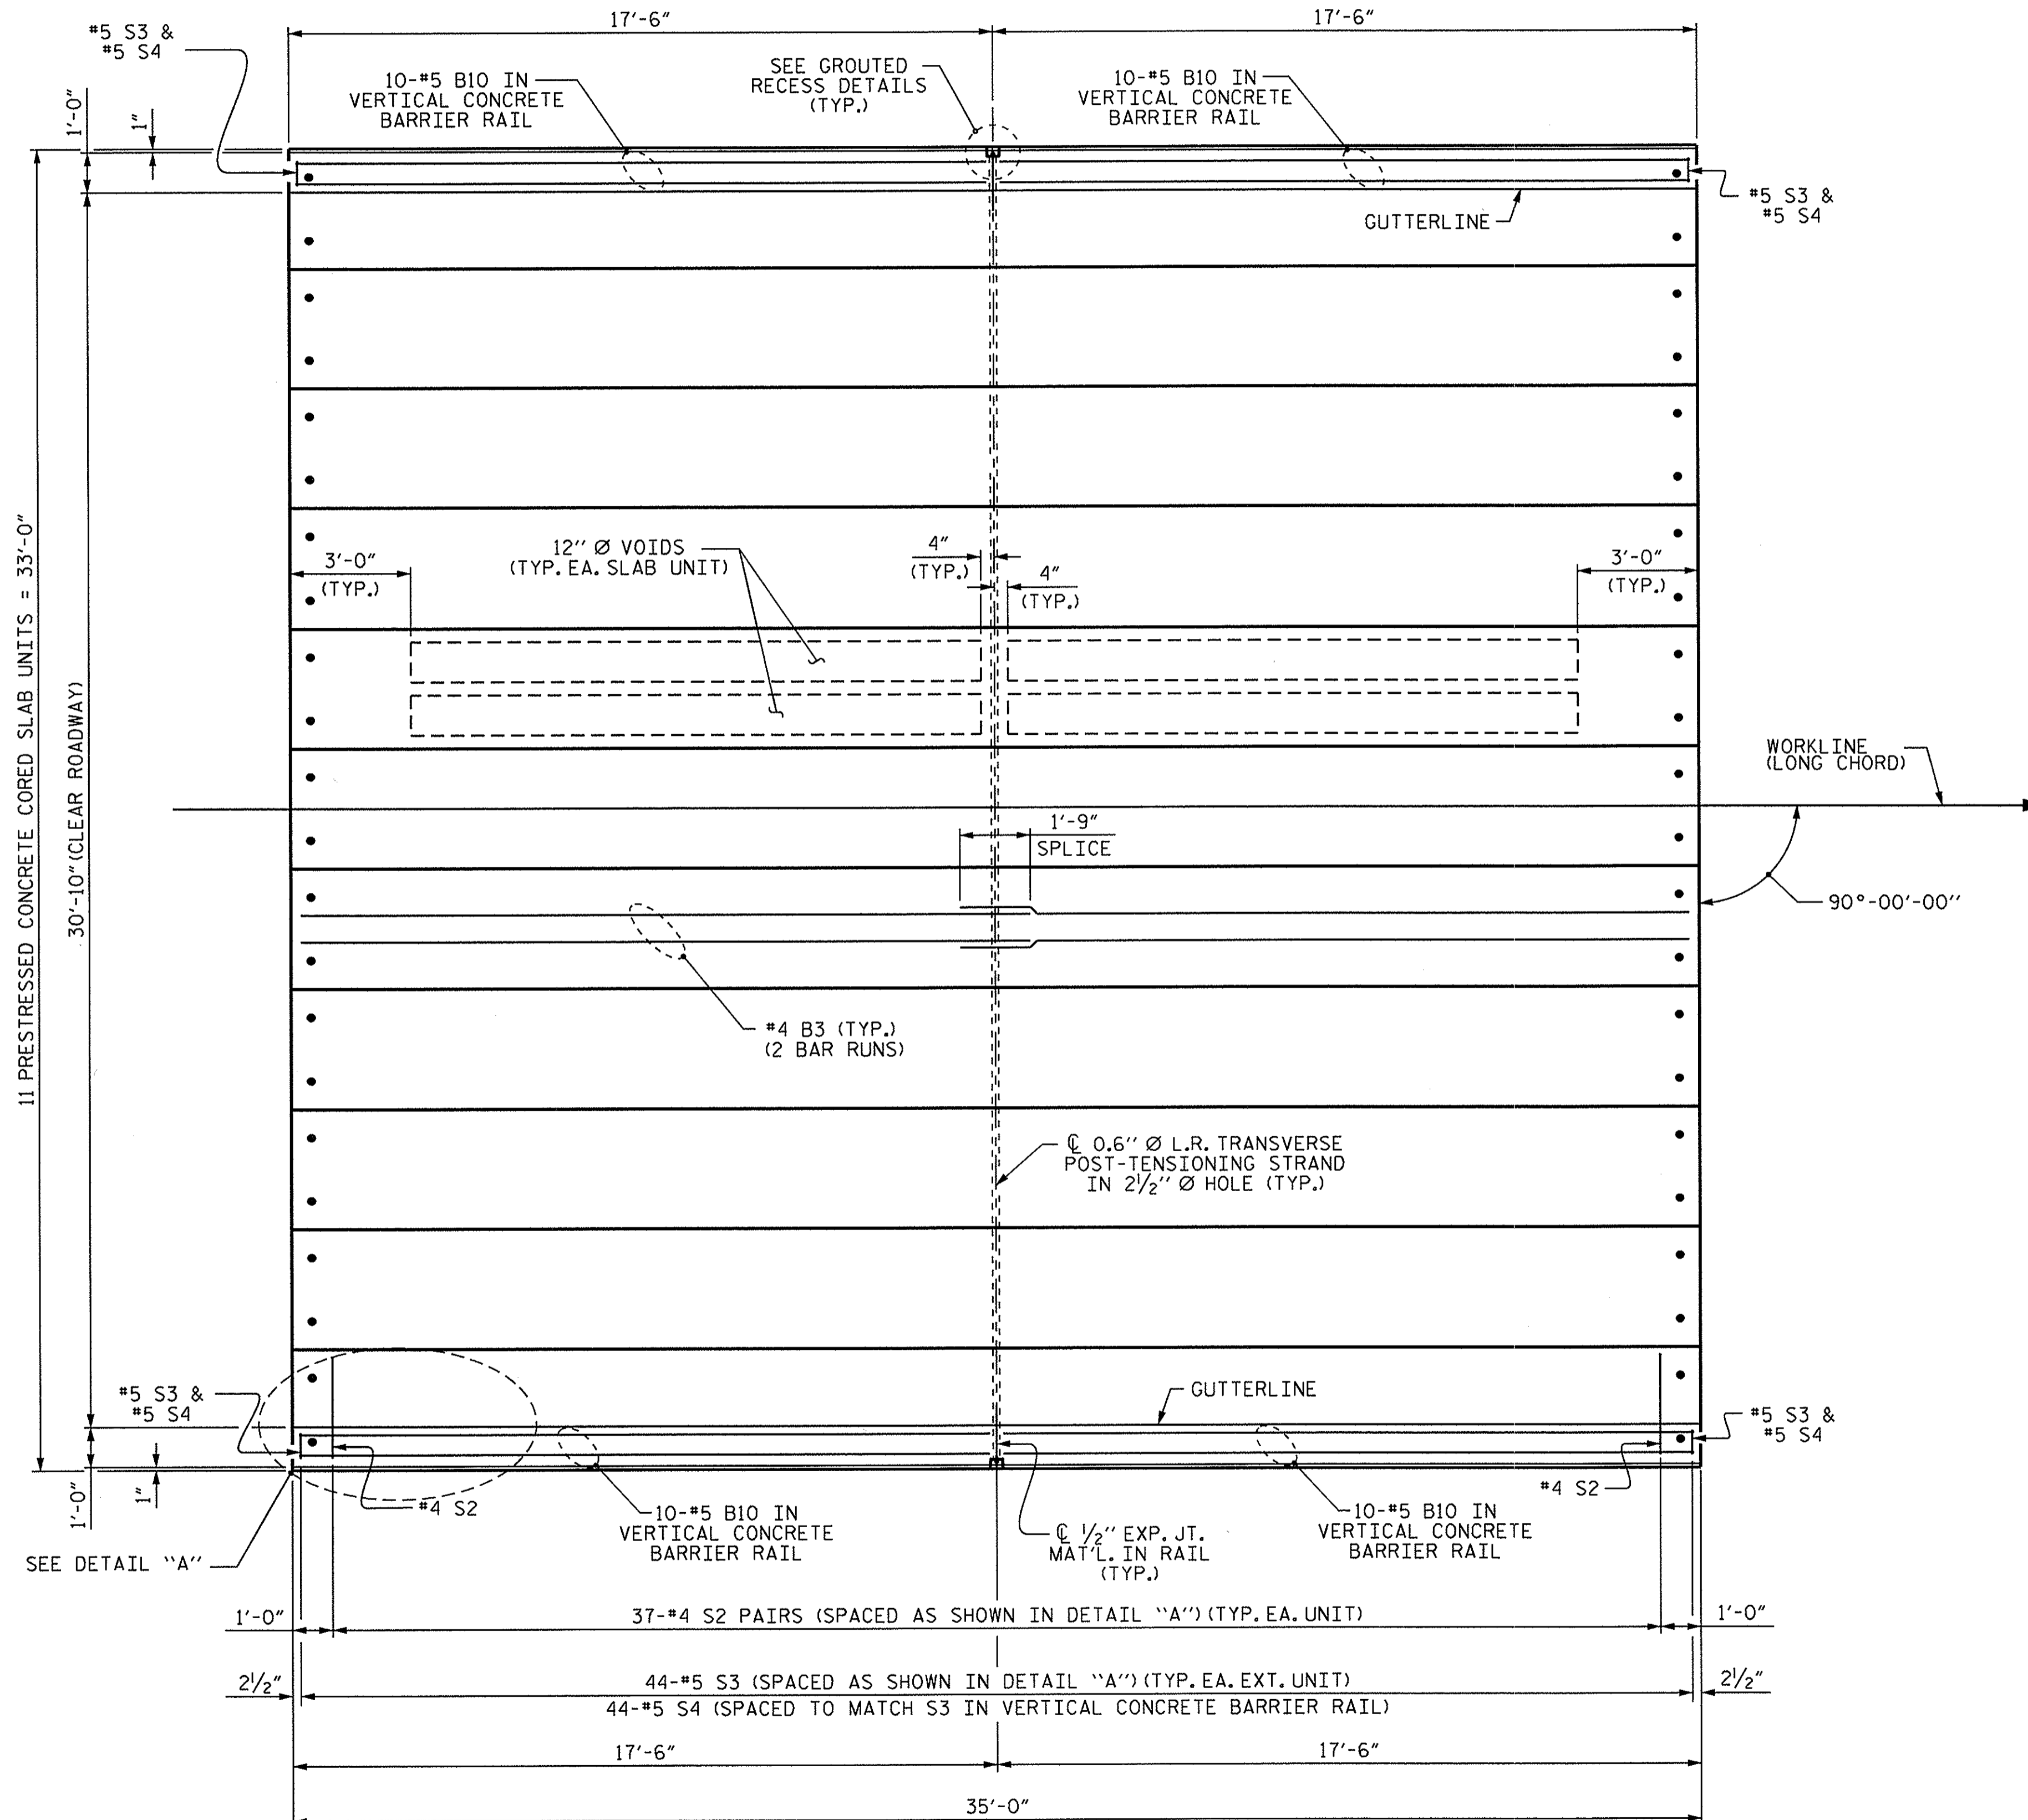


DETAIL "A"  
 NOTE: EXTERIOR UNIT SHOWN - INTERIOR UNIT SIMILAR EXCEPT OMIT #5 S3 BARS.

PLAN OF UNIT  
 (SPAN B)

PROJECT NO. BD-5102U  
 PITT COUNTY  
 STATION: 17+20.50 -L-


SHEET 3 OF 4

STATE OF NORTH CAROLINA  
 DEPARTMENT OF TRANSPORTATION  
 RALEIGH  
 PLAN OF 35' UNIT  
 30'-10" CLEAR ROADWAY  
 90° SKEW

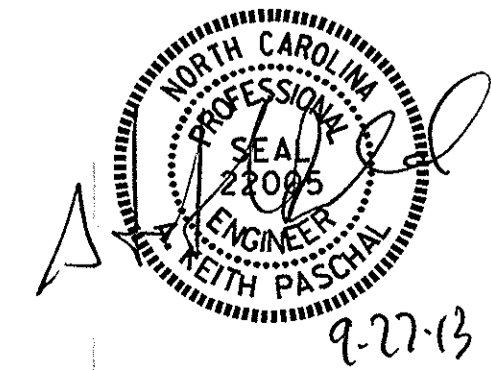

|                              |                      |
|------------------------------|----------------------|
| ASSEMBLED BY : A. H. SHIVELY | DATE : 6/14/13       |
| CHECKED BY : M. L. RORIE     | DATE : 6/18/13       |
| DRAWN BY : DGE 3/09          | REV. 12/5/11 MAA/AAC |
| CHECKED BY : BCH 3/09        |                      |

| REVISIONS |     |       |     |     |       | SHEET NO.    |
|-----------|-----|-------|-----|-----|-------|--------------|
| NO.       | BY: | DATE: | NO. | BY: | DATE: | S-7          |
| 1         |     |       | 3   |     |       | TOTAL SHEETS |
| 2         |     |       | 4   |     |       | 17           |

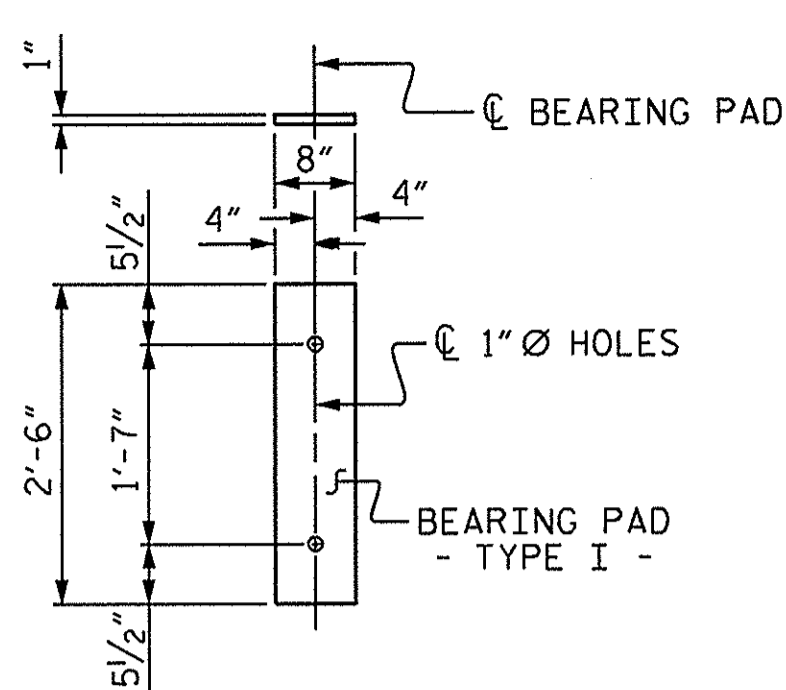

FIXED END  
(TYPE I - 44 REQ'D)

**ELASTOMERIC BEARING DETAILS**

ELASTOMER IN ALL BEARINGS SHALL BE 50 DUROMETER HARDNESS.

| GUTTERLINE ASPHALT THICKNESS & RAIL HEIGHT |                            |             |
|--|----------------------------|-------------|
| 30'-10" CLEAR ROADWAY                      | ASPHALT OVERLAY THICKNESS  | RAIL HEIGHT |
|  | @ MID-SPAN SUPERED SECTION | @ MID-SPAN  |
| 35' UNITS                                  | 3 3/8"                     | 3'-9 3/8"   |
| 50' UNITS                                  | 1 1/2"                     | 3'-7 1/2"   |

**BILL OF MATERIAL FOR VERTICAL CONCRETE BARRIER RAIL**

| BAR                                  | BARS PER PAIR OF EXTERIOR UNITS | TOTAL NO. | SIZE | TYPE | LENGTH | WEIGHT       |
|--------------------------------------|---------------------------------|-----------|------|------|--------|--------------|
| 35' UNIT                             |                                 |           |      |      |        |              |
| *B10                                 | 40                              | 40        | #5   | STR  | 17'-1" | 713          |
| *S4                                  | 88                              | 88        | #5   | 2    | 7'-2"  | 658          |
| * EPOXY COATED REINFORCING STEEL     |                                 |           |      |      |        | LBS. 1371    |
| CLASS AA CONCRETE                    |                                 |           |      |      |        | CU.YDS. 9.2  |
| TOTAL VERTICAL CONCRETE BARRIER RAIL |                                 |           |      |      |        | LN.FT. 70.25 |

**BILL OF MATERIAL FOR VERTICAL CONCRETE BARRIER RAIL**

| BAR                                  | BARS PER PAIR OF EXTERIOR UNITS | TOTAL NO. | SIZE | TYPE | LENGTH | WEIGHT        |
|--------------------------------------|---------------------------------|-----------|------|------|--------|---------------|
| 50' UNIT                             |                                 |           |      |      |        |               |
| *B13                                 | 40                              | 40        | #5   | STR  | 24'-7" | 1026          |
| *S4                                  | 118                             | 118       | #5   | 2    | 7'-2"  | 882           |
| * EPOXY COATED REINFORCING STEEL     |                                 |           |      |      |        | LBS. 1908     |
| CLASS AA CONCRETE                    |                                 |           |      |      |        | CU.YDS. 13.1  |
| TOTAL VERTICAL CONCRETE BARRIER RAIL |                                 |           |      |      |        | LN.FT. 100.25 |

**GRADE 270 STRANDS**


|                                       |             |
|---------------------------------------|-------------|
| AREA ( SQUARE INCHES )                | 0.6" Ø L.R. |
| ULTIMATE STRENGTH ( LBS. PER STRAND ) | 58,600      |
| APPLIED PRESTRESS ( LBS. PER STRAND ) | 43,950      |

**BILL OF MATERIAL FOR ONE 35' CORED SLAB UNIT**

|                                  |        | EXTERIOR UNIT |      | INTERIOR UNIT |        |
|----------------------------------|--------|---------------|------|---------------|--------|
| BAR                              | NUMBER | SIZE          | TYPE | LENGTH        | WEIGHT |
| B3                               | 4      | #4            | STR  | 18'-3"        | 49     |
| S1                               | 8      | #5            | 3    | 4'-3"         | 35     |
| S2                               | 74     | #4            | 3    | 5'-4"         | 264    |
| *S3                              | 44     | #5            | 1    | 6'-2"         | 283    |
| REINFORCING STEEL                |        | LBS.          |      |               | 348    |
| * EPOXY COATED REINFORCING STEEL |        | LBS.          |      |               | 283    |
| 5000 P.S.I. CONCRETE             |        | CU. YDS.      |      |               | 5.1    |
| 0.6" Ø L.R. STRANDS              |        | No.           |      |               | 9      |

**BILL OF MATERIAL FOR ONE 50' CORED SLAB UNIT**

|                                  |        | EXTERIOR UNIT |      | INTERIOR UNIT |        |
|----------------------------------|--------|---------------|------|---------------|--------|
| BAR                              | NUMBER | SIZE          | TYPE | LENGTH        | WEIGHT |
| B6                               | 4      | #4            | STR  | 25'-9"        | 69     |
| S1                               | 8      | #5            | 3    | 4'-3"         | 35     |
| S2                               | 104    | #4            | 3    | 5'-4"         | 371    |
| *S3                              | 59     | #5            | 1    | 6'-2"         | 379    |
| REINFORCING STEEL                |        | LBS.          |      |               | 475    |
| * EPOXY COATED REINFORCING STEEL |        | LBS.          |      |               | 379    |
| 6500 P.S.I. CONCRETE             |        | CU. YDS.      |      |               | 7.1    |
| 0.6" Ø L.R. STRANDS              |        | No.           |      |               | 19     |

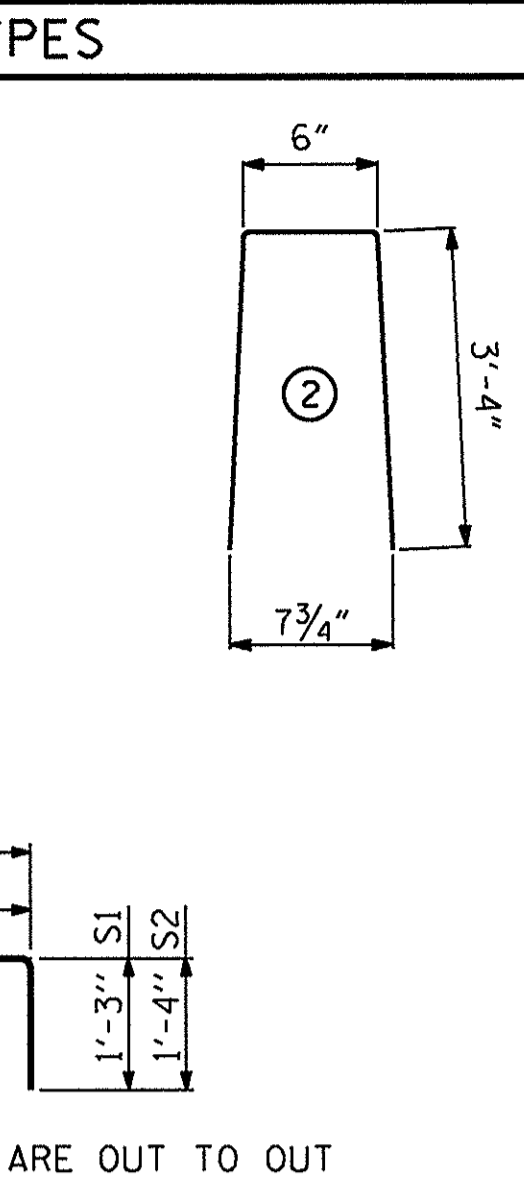

**NOTES**

ALL PRESTRESSING STRANDS SHALL BE 7-WIRE LOW RELAXATION GRADE 270 STRANDS AND SHALL CONFORM TO AASHTO M203 EXCEPT FOR SAMPLING REQUIREMENTS WHICH SHALL BE IN ACCORDANCE WITH THE STANDARD SPECIFICATIONS.

ALL REINFORCING STEEL CAST WITH THE CORED SLAB SECTIONS SHALL BE GRADE 60 AND SHALL BE INCLUDED IN THE UNIT PRICE BID FOR PRESTRESSED CONCRETE CORED SLABS.

RECESSES FOR TRANSVERSE STRANDS SHALL BE GROUTED AFTER THE TENSIONING OF THE STRANDS.

THE 2 1/2" Ø DOWEL HOLES AT FIXED ENDS OF SLAB SECTIONS SHALL BE FILLED WITH NON-SHRINK GROUT.

THE BACKER RODS SHALL CONFORM TO THE REQUIREMENTS OF TYPE M BOND BREAKER. SEE SECTION 1028 OF THE STANDARD SPECIFICATIONS.

WHEN CORED SLABS ARE CAST, AN INTERNAL HOLD-DOWN SYSTEM SHALL BE EMPLOYED TO PREVENT VOIDS FROM RISING OR MOVING SIDEWAYS. AT LEAST SIX WEEKS PRIOR TO CASTING CORED SLABS, THE CONTRACTOR SHALL SUBMIT TO THE ENGINEER FOR REVIEW AND COMMENT, DETAILED DRAWINGS OF THE PROPOSED HOLD-DOWN SYSTEM. IN ADDITION TO STRUCTURAL DETAILS, LOCATION AND SPACING OF THE HOLD-DOWNS SHALL BE INDICATED.

ALL REINFORCING STEEL IN THE VERTICAL CONCRETE BARRIER RAIL SHALL BE EPOXY COATED.

PRESTRESSING STRANDS SHALL BE CUT FLUSH WITH THE CORED SLAB UNIT ENDS.


APPLY EPOXY PROTECTIVE COATING TO CORED SLAB UNIT ENDS.

GROOVED CONTRACTION JOINTS, 1/2" IN DEPTH, SHALL BE TOOLED IN ALL EXPOSED FACES OF THE BARRIER RAIL AND IN ACCORDANCE WITH ARTICLE 825-10(B) OF THE STANDARD SPECIFICATIONS. A CONTRACTION JOINT SHALL BE LOCATED AT EACH THIRD POINT BETWEEN BARRIER RAIL EXPANSION JOINTS. ONLY ONE CONTRACTION JOINT IS REQUIRED AT MIDPOINT OF BARRIER RAIL SEGMENTS LESS THAN 20 FEET IN LENGTH AND NO CONTRACTION JOINTS ARE REQUIRED FOR THOSE SEGMENTS LESS THAN 10 FEET IN LENGTH.

TRANSVERSE POST TENSIONING OF THE CORED SLAB UNITS SHALL BE DONE IN ACCORDANCE WITH THE STANDARD SPECIFICATIONS.

THE TRANSFER OF LOAD FROM THE ANCHORAGES TO THE CORED SLAB UNIT SHALL BE DONE WHEN THE CONCRETE HAS REACHED A COMPRESSIVE STRENGTH OF NOT LESS THAN THE REQUIRED STRENGTH SHOWN IN THE "CONCRETE RELEASE STRENGTH" TABLE.


FOR GROUT FOR STRUCTURES, SEE SPECIAL PROVISIONS.

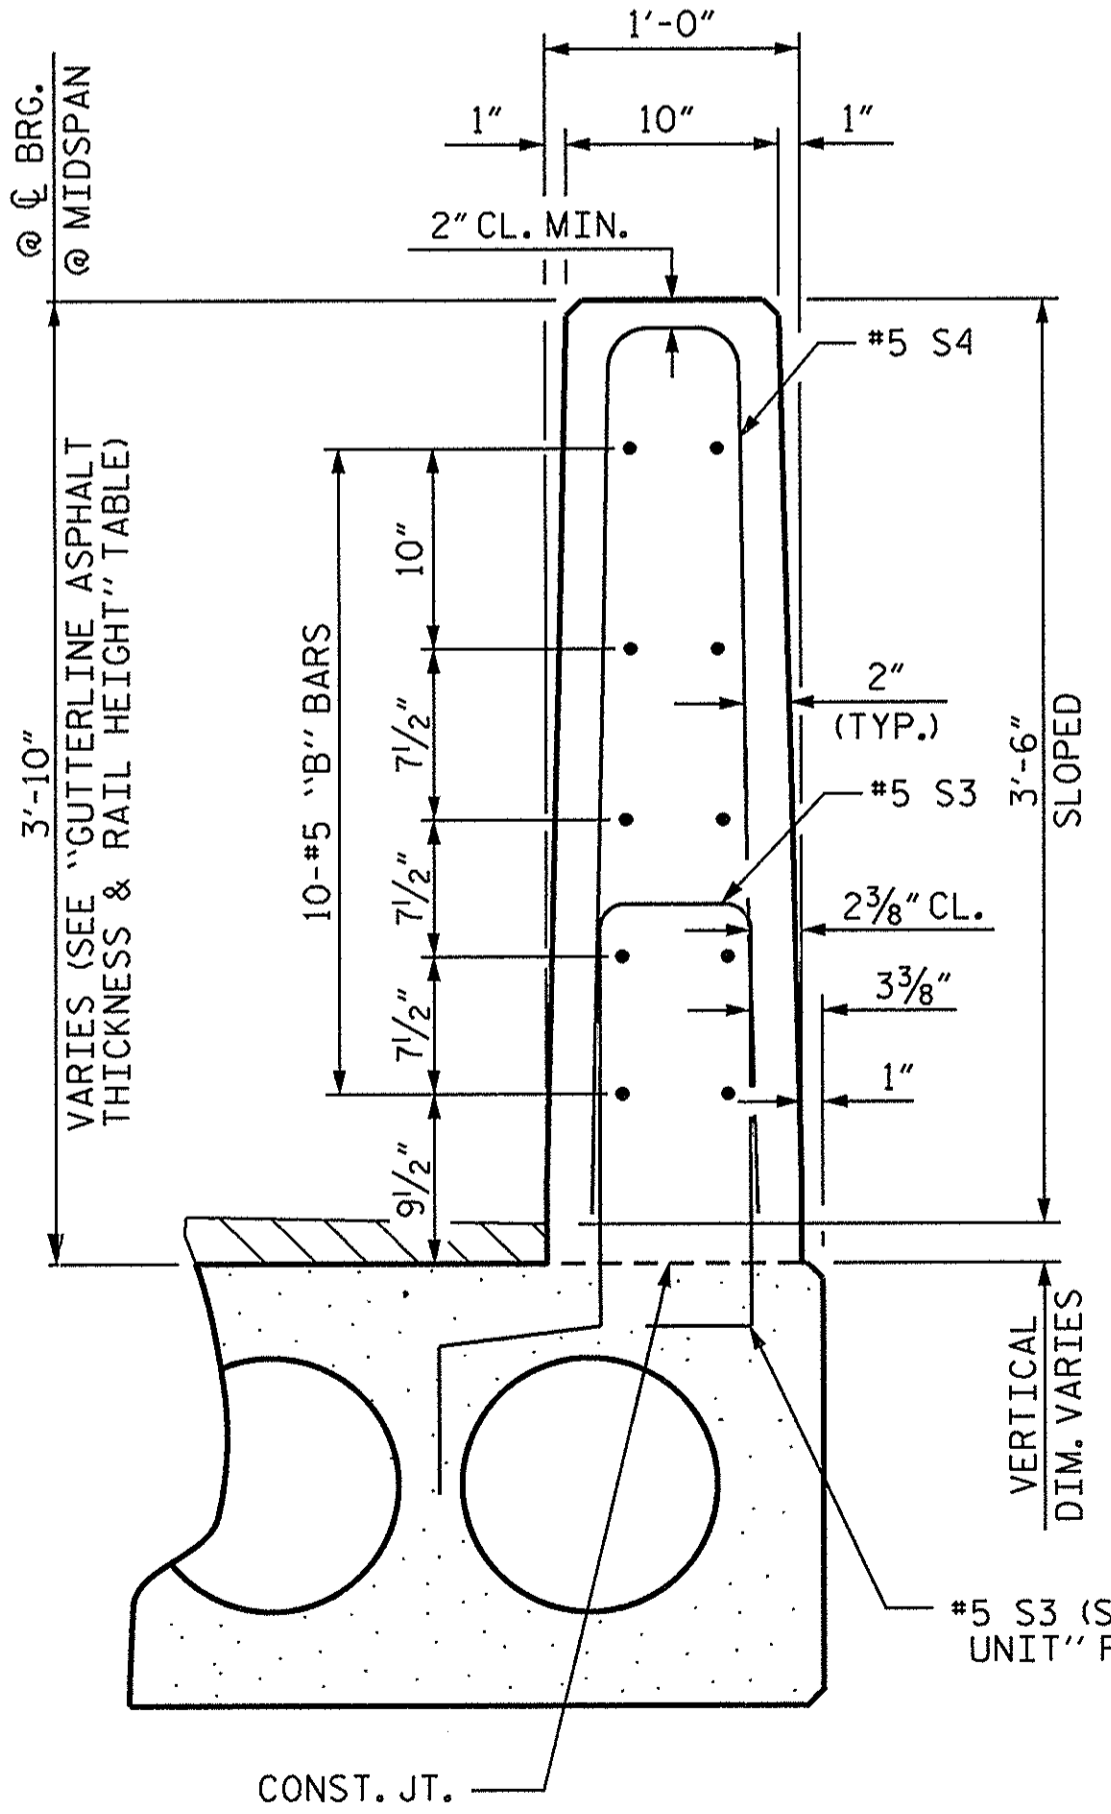

**SECTION S-S**

AT DAM IN OPEN JOINT  
(THIS IS TO BE USED ONLY WHEN SLIP FORM IS USED)  
1/2" EXP. JT. MAT'L HELD IN PLACE WITH GALVANIZED NAILS.  
(NOTE: OMIT EXP. JT. MAT'L WHEN SLIP FORM IS USED)

ELEVATION AT EXPANSION JOINTS

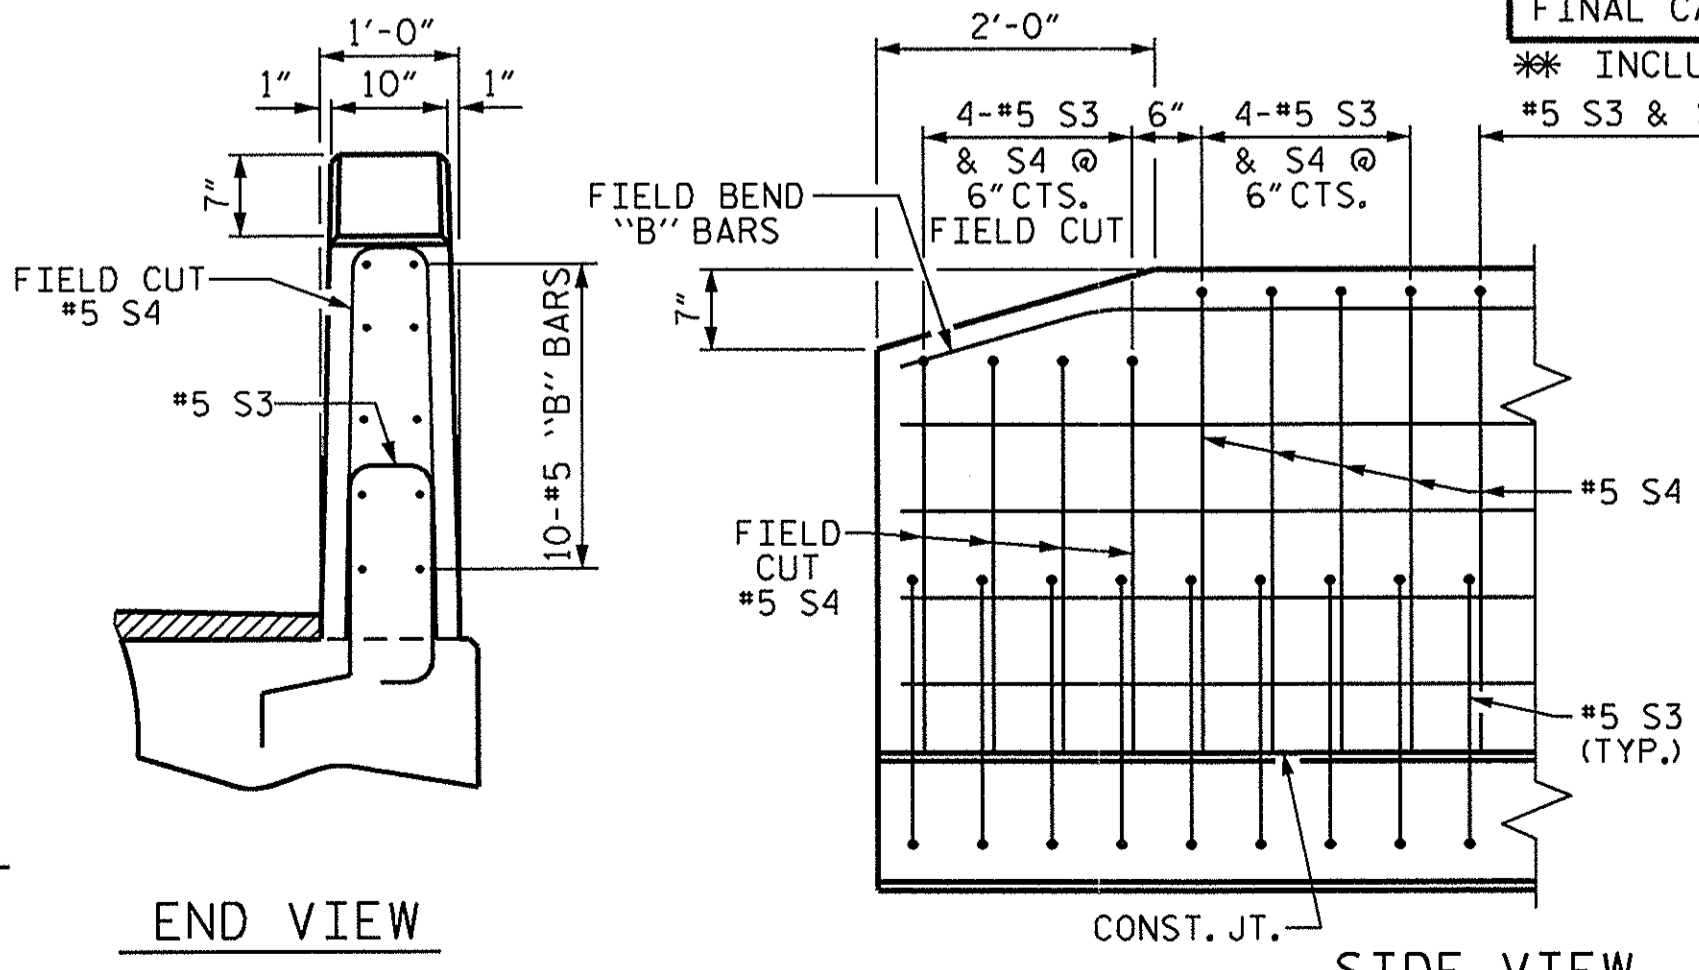

END OF RAIL DETAILS

**DEAD LOAD DEFLECTION AND CAMBER**

|  |  | 3'-0" x 1'-9"      |  |
|--|--|--------------------|--|
|  |  | 0.6" Ø L.R. STRAND |  |
| 35' CORED SLAB UNIT                        |  | 1/2" ↑             |  |
| CAMBER (SLAB ALONE IN PLACE)               |  |                    |  |
| DEFLECTION DUE TO SUPERIMPOSED DEAD LOAD** |  | 1/8" ↓             |  |
| FINAL CAMBER                               |  | 3/8" ↑             |  |

**DEAD LOAD DEFLECTION AND CAMBER**

|  |  | 3'-0" x 1'-9"      |  |
|--|--|--------------------|--|
|  |  | 0.6" Ø L.R. STRAND |  |
| 50' CORED SLAB UNIT                        |  | 2 1/2" ↑           |  |
| CAMBER (SLAB ALONE IN PLACE)               |  |                    |  |
| DEFLECTION DUE TO SUPERIMPOSED DEAD LOAD** |  | 1/4" ↓             |  |
| FINAL CAMBER                               |  | 2 1/4" ↑           |  |

\*\* INCLUDES FUTURE WEARING SURFACE

**CORED SLABS REQUIRED**

| 50' UNIT      | NUMBER | LENGTH | TOTAL LENGTH |
|---------------|--------|--------|--------------|
| EXTERIOR C.S. | 2      | 50'-0" | 100          |
| INTERIOR C.S. | 9      | 50'-0" | 450          |
| TOTAL         | 11     |        | 550          |

**CORED SLABS REQUIRED**

| 35' UNIT      | NUMBER | LENGTH | TOTAL LENGTH |
|---------------|--------|--------|--------------|
| EXTERIOR C.S. | 2      | 35'-0" | 70           |
| INTERIOR C.S. | 9      | 35'-0" | 315          |
| TOTAL         | 11     |        | 385          |

**CONCRETE RELEASE STRENGTH**

| UNIT      | PSI  |
|-----------|------|
| 35' UNITS | 4000 |
| 50' UNITS | 4900 |


PROJECT NO. BD-5102U

PITT COUNTY

STATION: 17+20.50 -L-

SHEET 4 OF 4

STATE OF NORTH CAROLINA  
DEPARTMENT OF TRANSPORTATION  
RALEIGH  
STANDARD  
3'-0" X 1'-9"  
PRESTRESSED CONCRETE  
CORED SLAB UNIT  
90° SKEW

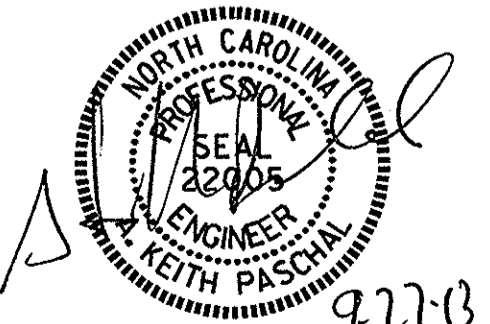

|                              |                |
|------------------------------|----------------|
| ASSEMBLED BY : A. H. SHIVELY | DATE : 6/14/13 |
| CHECKED BY : M. L. RORIE     | DATE : 6/18/13 |
| DRAWN BY : DGE 5/09          | REV. 12/11     |
| CHECKED BY : BCH 6/09        | MAA/AAC        |

| REVISIONS |     |       |     |     |       | SHEET NO.    |
|-----------|-----|-------|-----|-----|-------|--------------|
| NO.       | BY: | DATE: | NO. | BY: | DATE: | S-8          |
| 1         |     |       | 3   |     |       | TOTAL SHEETS |
| 2         |     |       | 4   |     |       | 17           |

NOTES

THE GUARDRAIL ANCHOR ASSEMBLY SHALL CONSIST OF A 1/4" HOLD DOWN PLATE AND 7 - 7/8" Ø BOLTS WITH NUTS AND WASHERS.

THE HOLD-DOWN PLATE SHALL CONFORM TO AASHTO M270 GRADE 36. AFTER FABRICATION, THE HOLD-DOWN PLATE SHALL BE HOT-DIP GALVANIZED IN ACCORDANCE WITH AASHTO M111.

BOLTS SHALL CONFORM TO THE REQUIREMENTS OF ASTM A307 AND NUTS SHALL CONFORM TO THE REQUIREMENTS OF AASHTO M291. BOLTS, NUTS AND WASHERS SHALL BE GALVANIZED. (AT THE CONTRACTOR'S OPTION, STAINLESS STEEL BOLTS, NUTS AND WASHERS MAY BE USED AS AN ALTERNATE FOR THE 7/8" Ø GALVANIZED BOLTS, NUTS AND WASHERS. THEY SHALL CONFORM TO OR EXCEED THE MECHANICAL REQUIREMENTS OF ASTM A307. THE USE OF THIS ALTERNATE SHALL BE APPROVED BY THE ENGINEER.)


THE GUARDRAIL ANCHOR ASSEMBLY IS REQUIRED AT ALL POINTS WHERE APPROACH GUARDRAIL IS TO BE ATTACHED TO THE END OF BARRIER RAIL. FOR POINTS OF ATTACHMENT, SEE SKETCH.

AFTER INSTALLATION, THE EXPOSED THREAD OF THE BOLT SHALL BE BURRED WITH A SHARP POINTED TOOL.

THE COST OF THE GUARDRAIL ANCHOR ASSEMBLY SHALL BE INCLUDED IN THE UNIT CONTRACT PRICE BID FOR VERTICAL CONCRETE BARRIER RAIL.


THE VERTICAL REINFORCING BARS MAY BE SHIFTED SLIGHTLY IN THE VERTICAL CONCRETE BARRIER RAIL TO CLEAR ASSEMBLY BOLTS.

THE 1 1/4" Ø HOLES SHALL BE FORMED OR DRILLED WITH A CORE BIT. IMPACT TOOLS WILL NOT BE PERMITTED. ANY CONCRETE DAMAGED BY THIS WORK SHALL BE REPAIRED TO THE SATISFACTION OF THE ENGINEER.

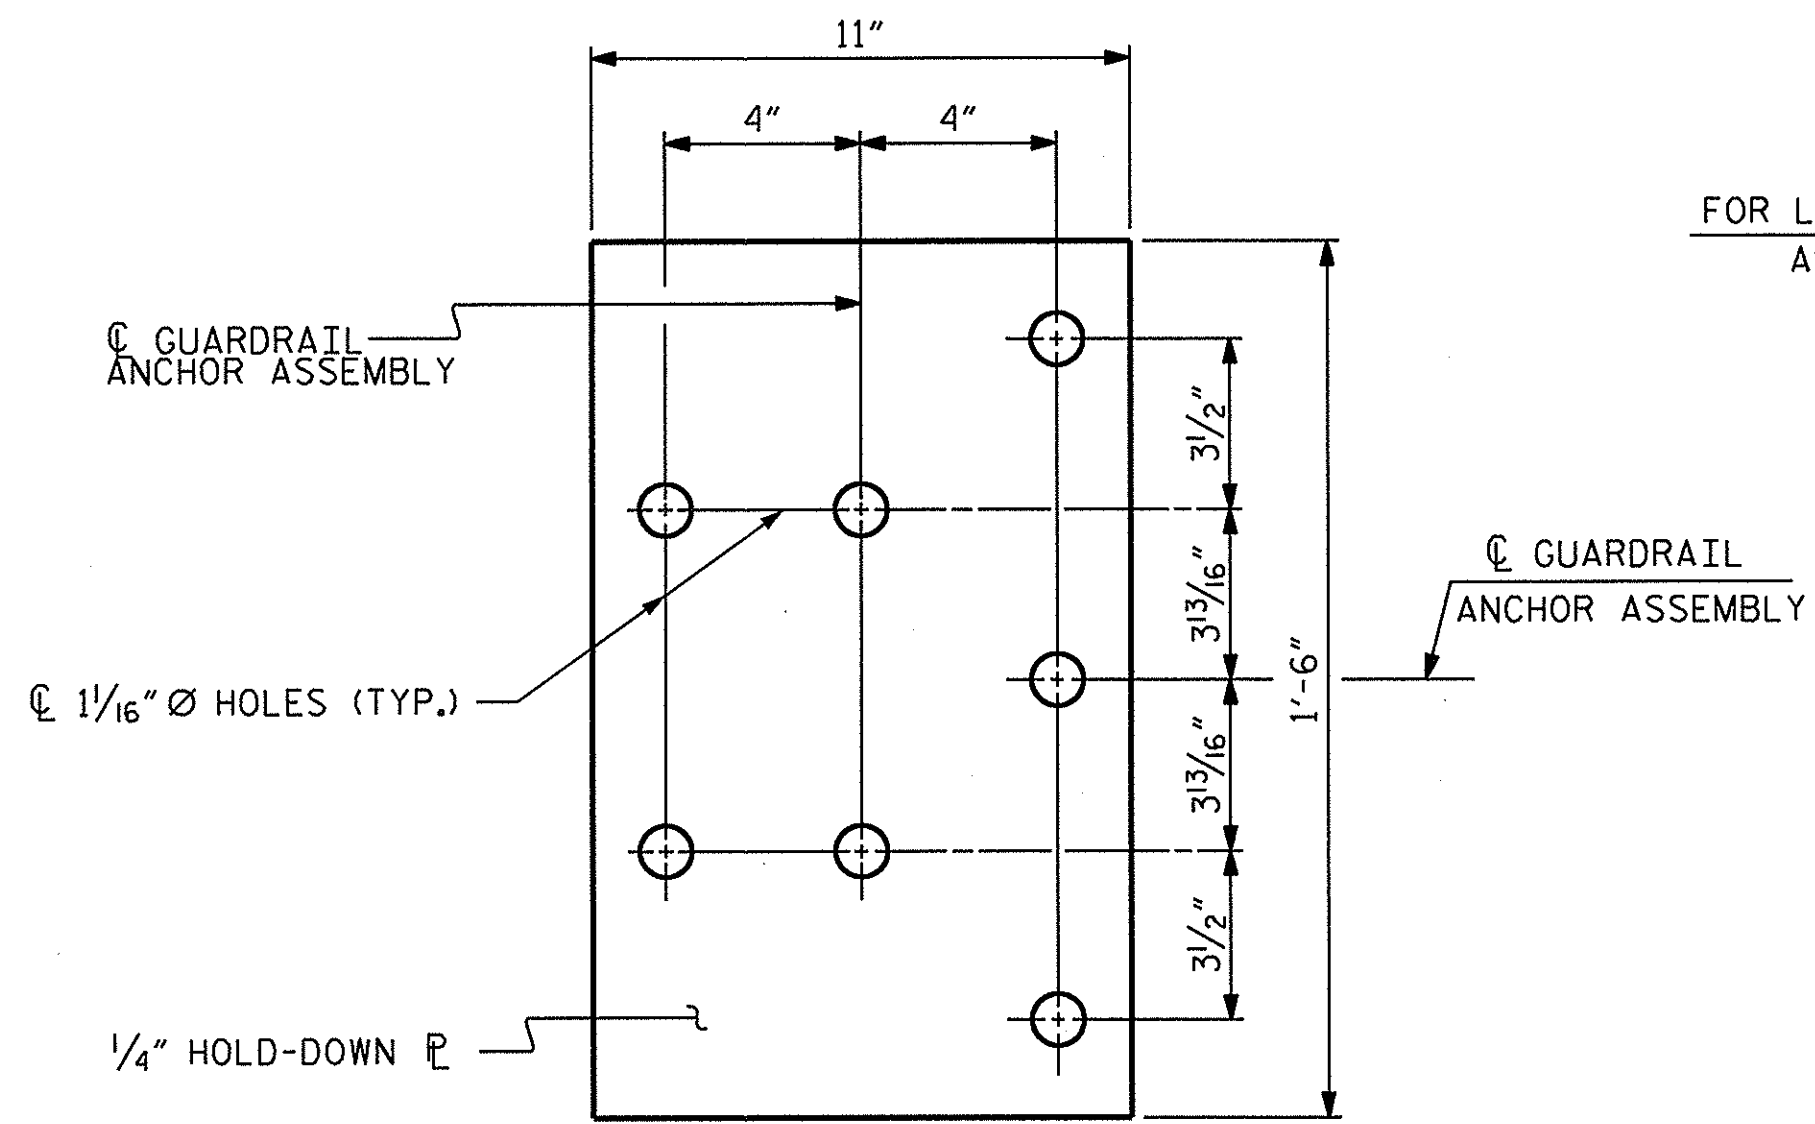


PLAN


FOR LOCATION OF GUARDRAIL ANCHOR ASSEMBLY, SEE "PLAN" BELOW

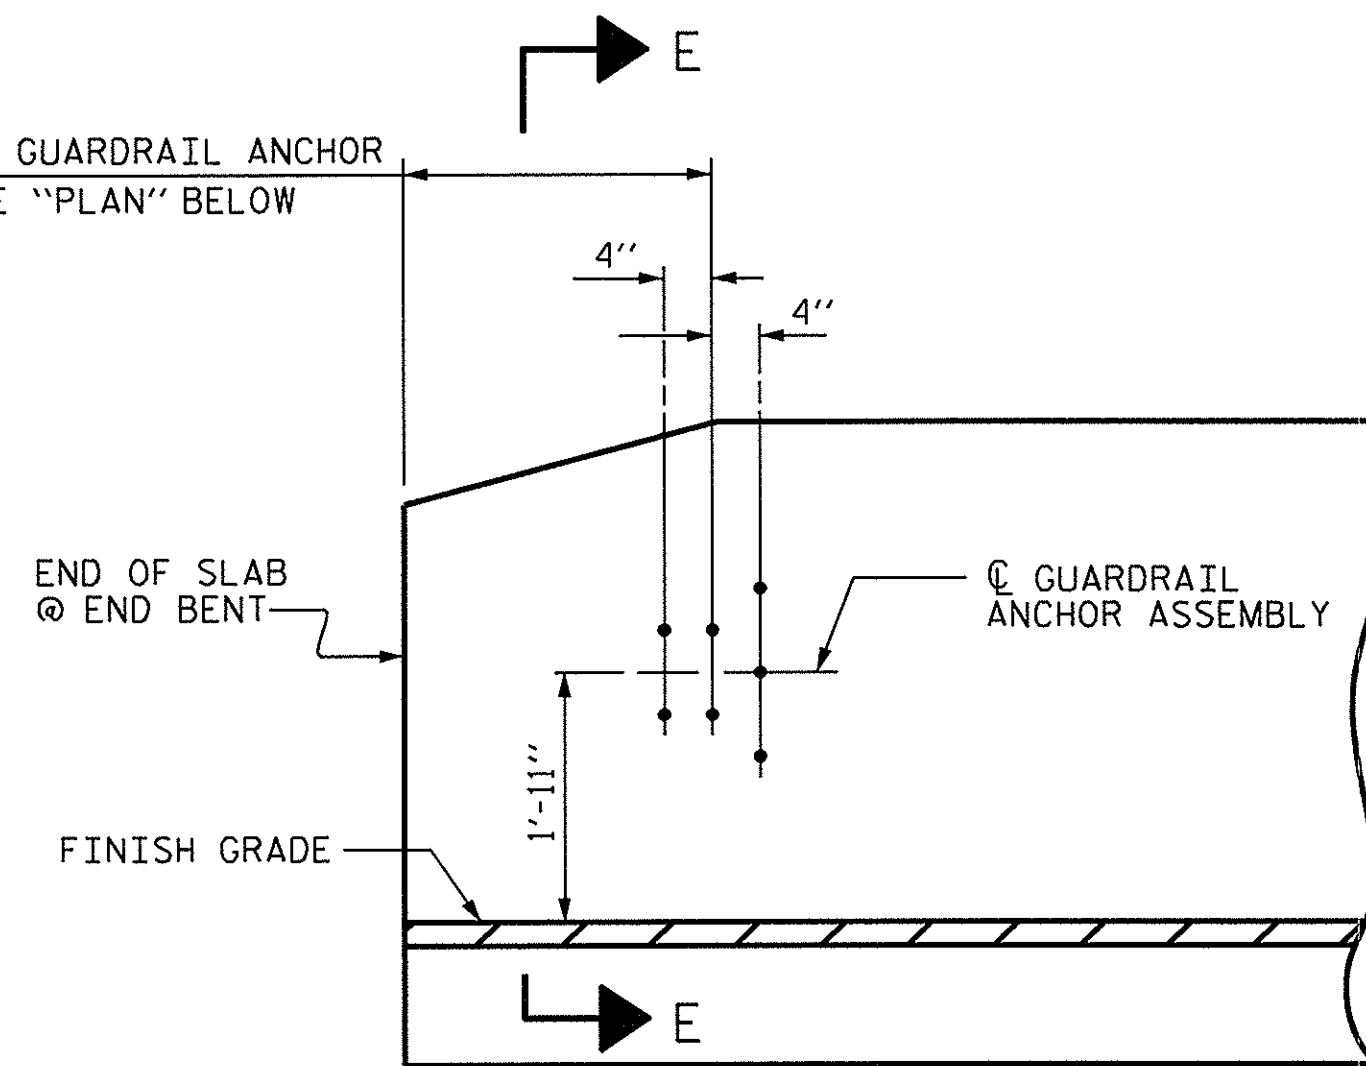

ELEVATION

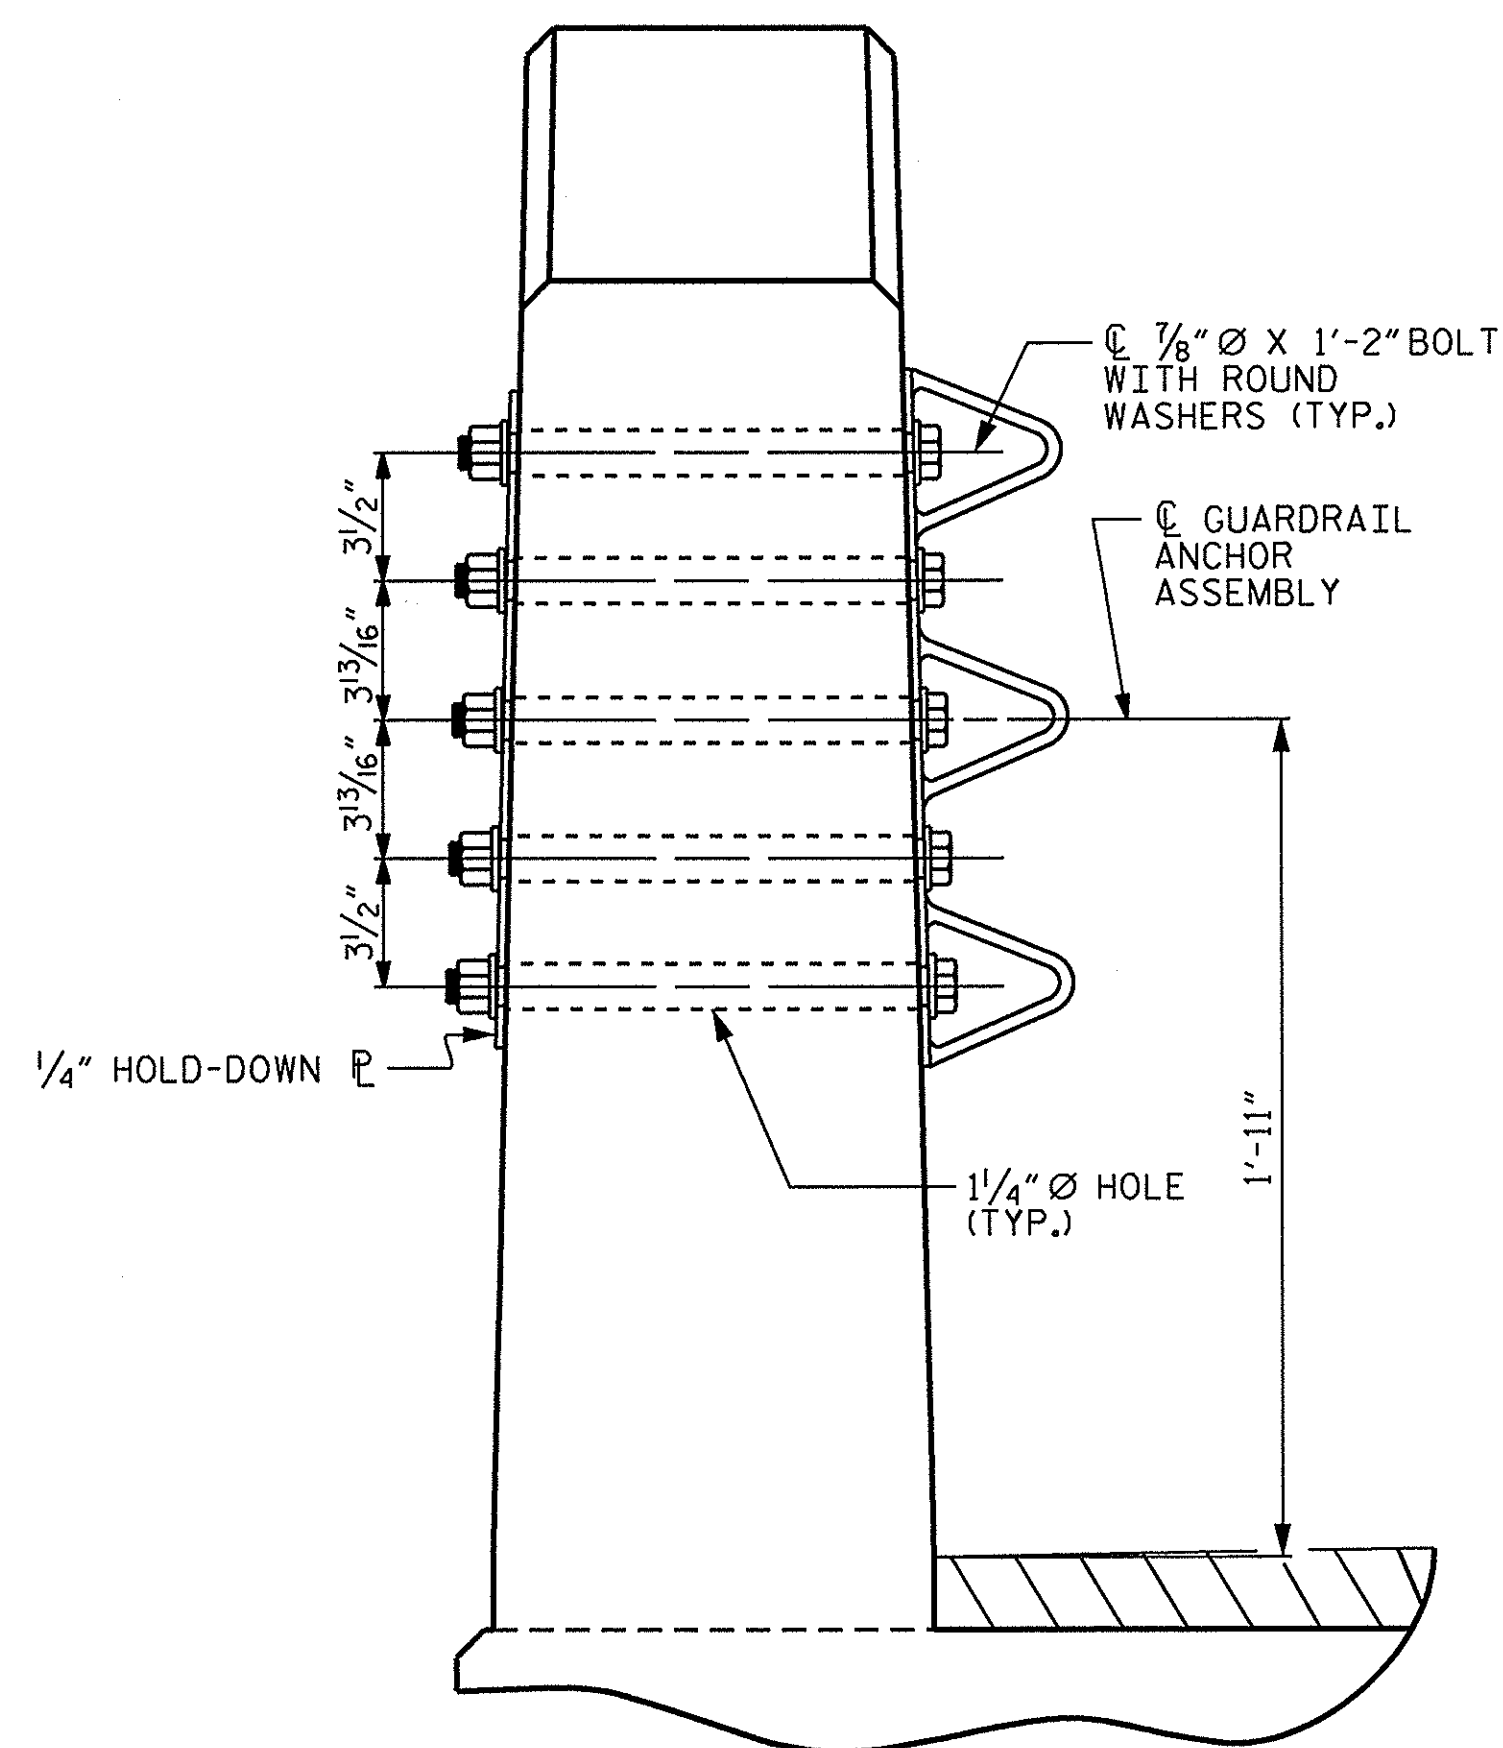


SECTION E-E  
GUARDRAIL ANCHOR ASSEMBLY DETAILS

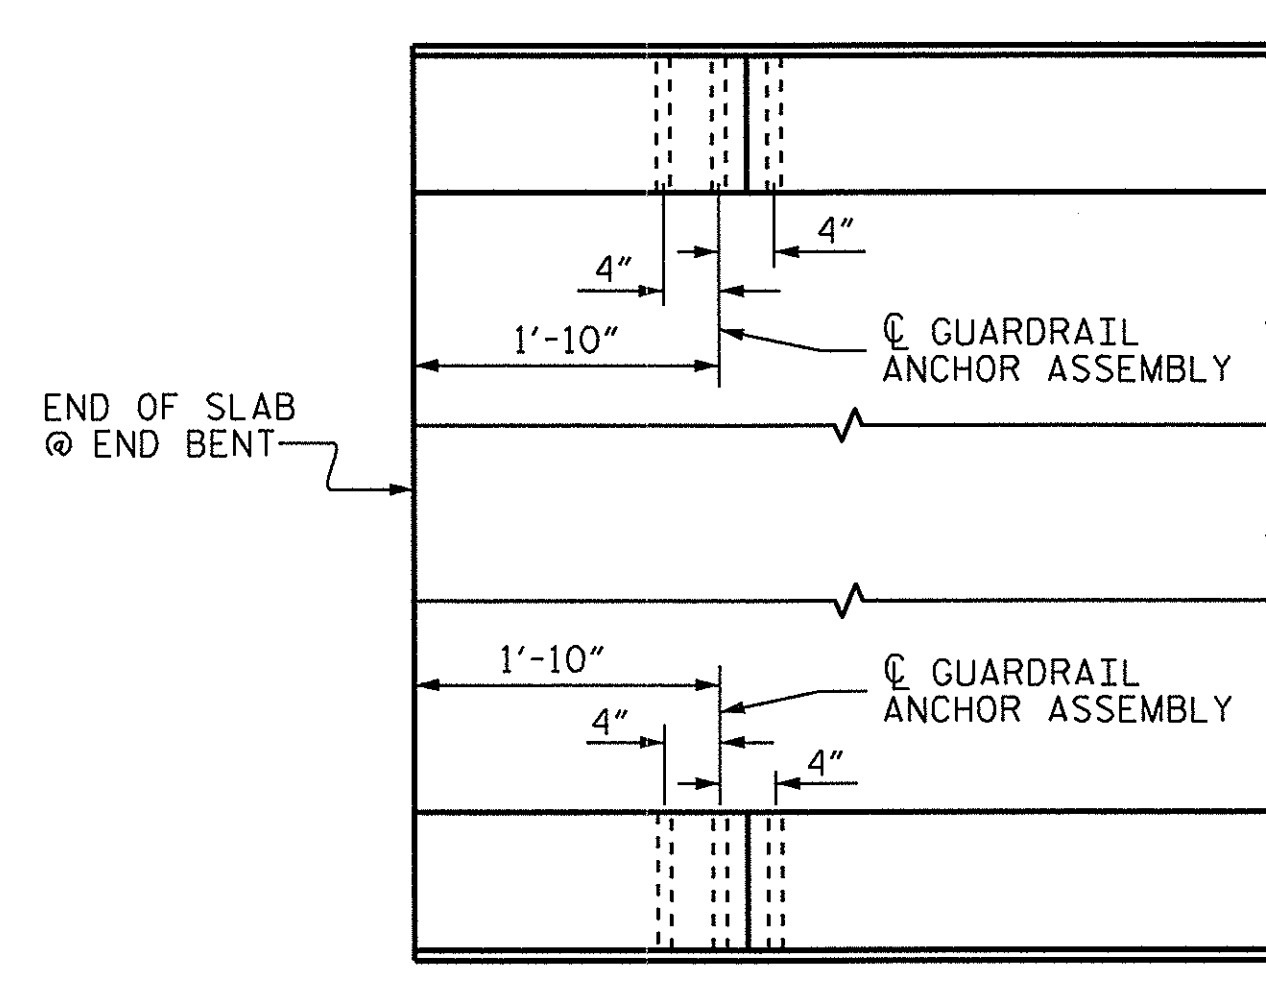

LOCATION OF ANCHORS FOR GUARDRAIL

END BENT #1 SHOWN, END BENT #2 SIMILAR.

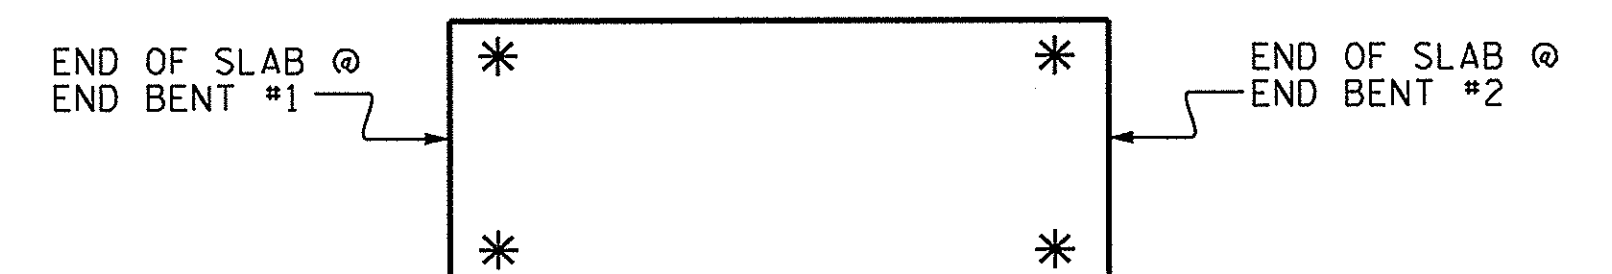


SKETCH SHOWING POINTS OF ATTACHMENT

\* DENOTES GUARDRAIL ANCHOR ASSEMBLY

PROJECT NO. BD-5102U  
PITT COUNTY  
 STATION: 17+20.50 -L-

STATE OF NORTH CAROLINA  
 DEPARTMENT OF TRANSPORTATION  
 RALEIGH  
 STANDARD  
 GUARDRAIL ANCHORAGE  
 FOR VERTICAL CONCRETE  
 BARRIER RAIL

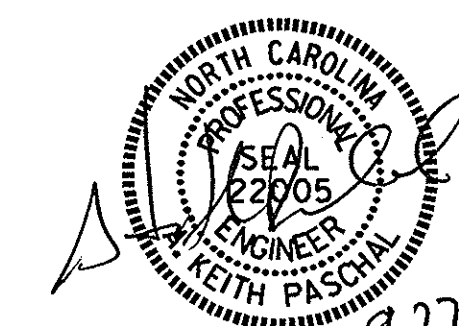

|                            |                     |
|----------------------------|---------------------|
| ASSEMBLED BY : M. D. PISO  | DATE : 09-03-13     |
| CHECKED BY : A. K. PASCHAL | DATE : 09-25-13     |
| DRAWN BY : MAA 5/10        | REV. 10/1/11 MAA/GM |
| CHECKED BY : GM 5/10       | REV. 12/5/11 MAA/GM |
|                            | REV. 6/13 MAA/GM    |

27-SEP-2013 09:04  
 S:\DPC\Keltin\BD-5102U\Design\BD-5102U.LCS.dgn  
 kpaschal

| REVISIONS |     |       |     |     |       | SHEET NO.    |
|-----------|-----|-------|-----|-----|-------|--------------|
| NO.       | BY: | DATE: | NO. | BY: | DATE: | S-9          |
| 1         |     |       | 3   |     |       | TOTAL SHEETS |
| 2         |     |       | 4   |     |       | 17           |

(SHT 1) STD. NO. GRA3



# NOTES

STIRRUPS IN CAP MAY BE SHIFTED AS NECESSARY TO CLEAR DOWELS.

THE LATERAL GUIDES ARE NOT TO BE POURED UNTIL AFTER THE CORED SLAB UNITS ARE IN PLACE.


THE CONCRETE IN THE SHADED AREA OF THE WING SHALL BE POURED AFTER THE VERTICAL CONCRETE BARRIER RAIL IS CAST IF SLIP FORMING IS USED.

FOR PILE SPLICE DETAILS, SEE SHEET 4 OF 4.


FOR WING DETAILS, SEE SHEET 3 OF 4.

THE CONTRACTOR HAS THE OPTION TO OMIT THE LATERAL GUIDE IF APPROVED BY THE ENGINEER.

INSTALL THE 4" Ø DRAIN PIPE THROUGH THE WING WALL AS REQUIRED. FOR REINFORCED BRIDGE APPROACH FILLS, SEE THE ROADWAY PLANS. REINFORCING STEEL IN THE WING WALL MAY BE SHIFTED AS NECESSARY TO CLEAR THE DRAIN PIPE.

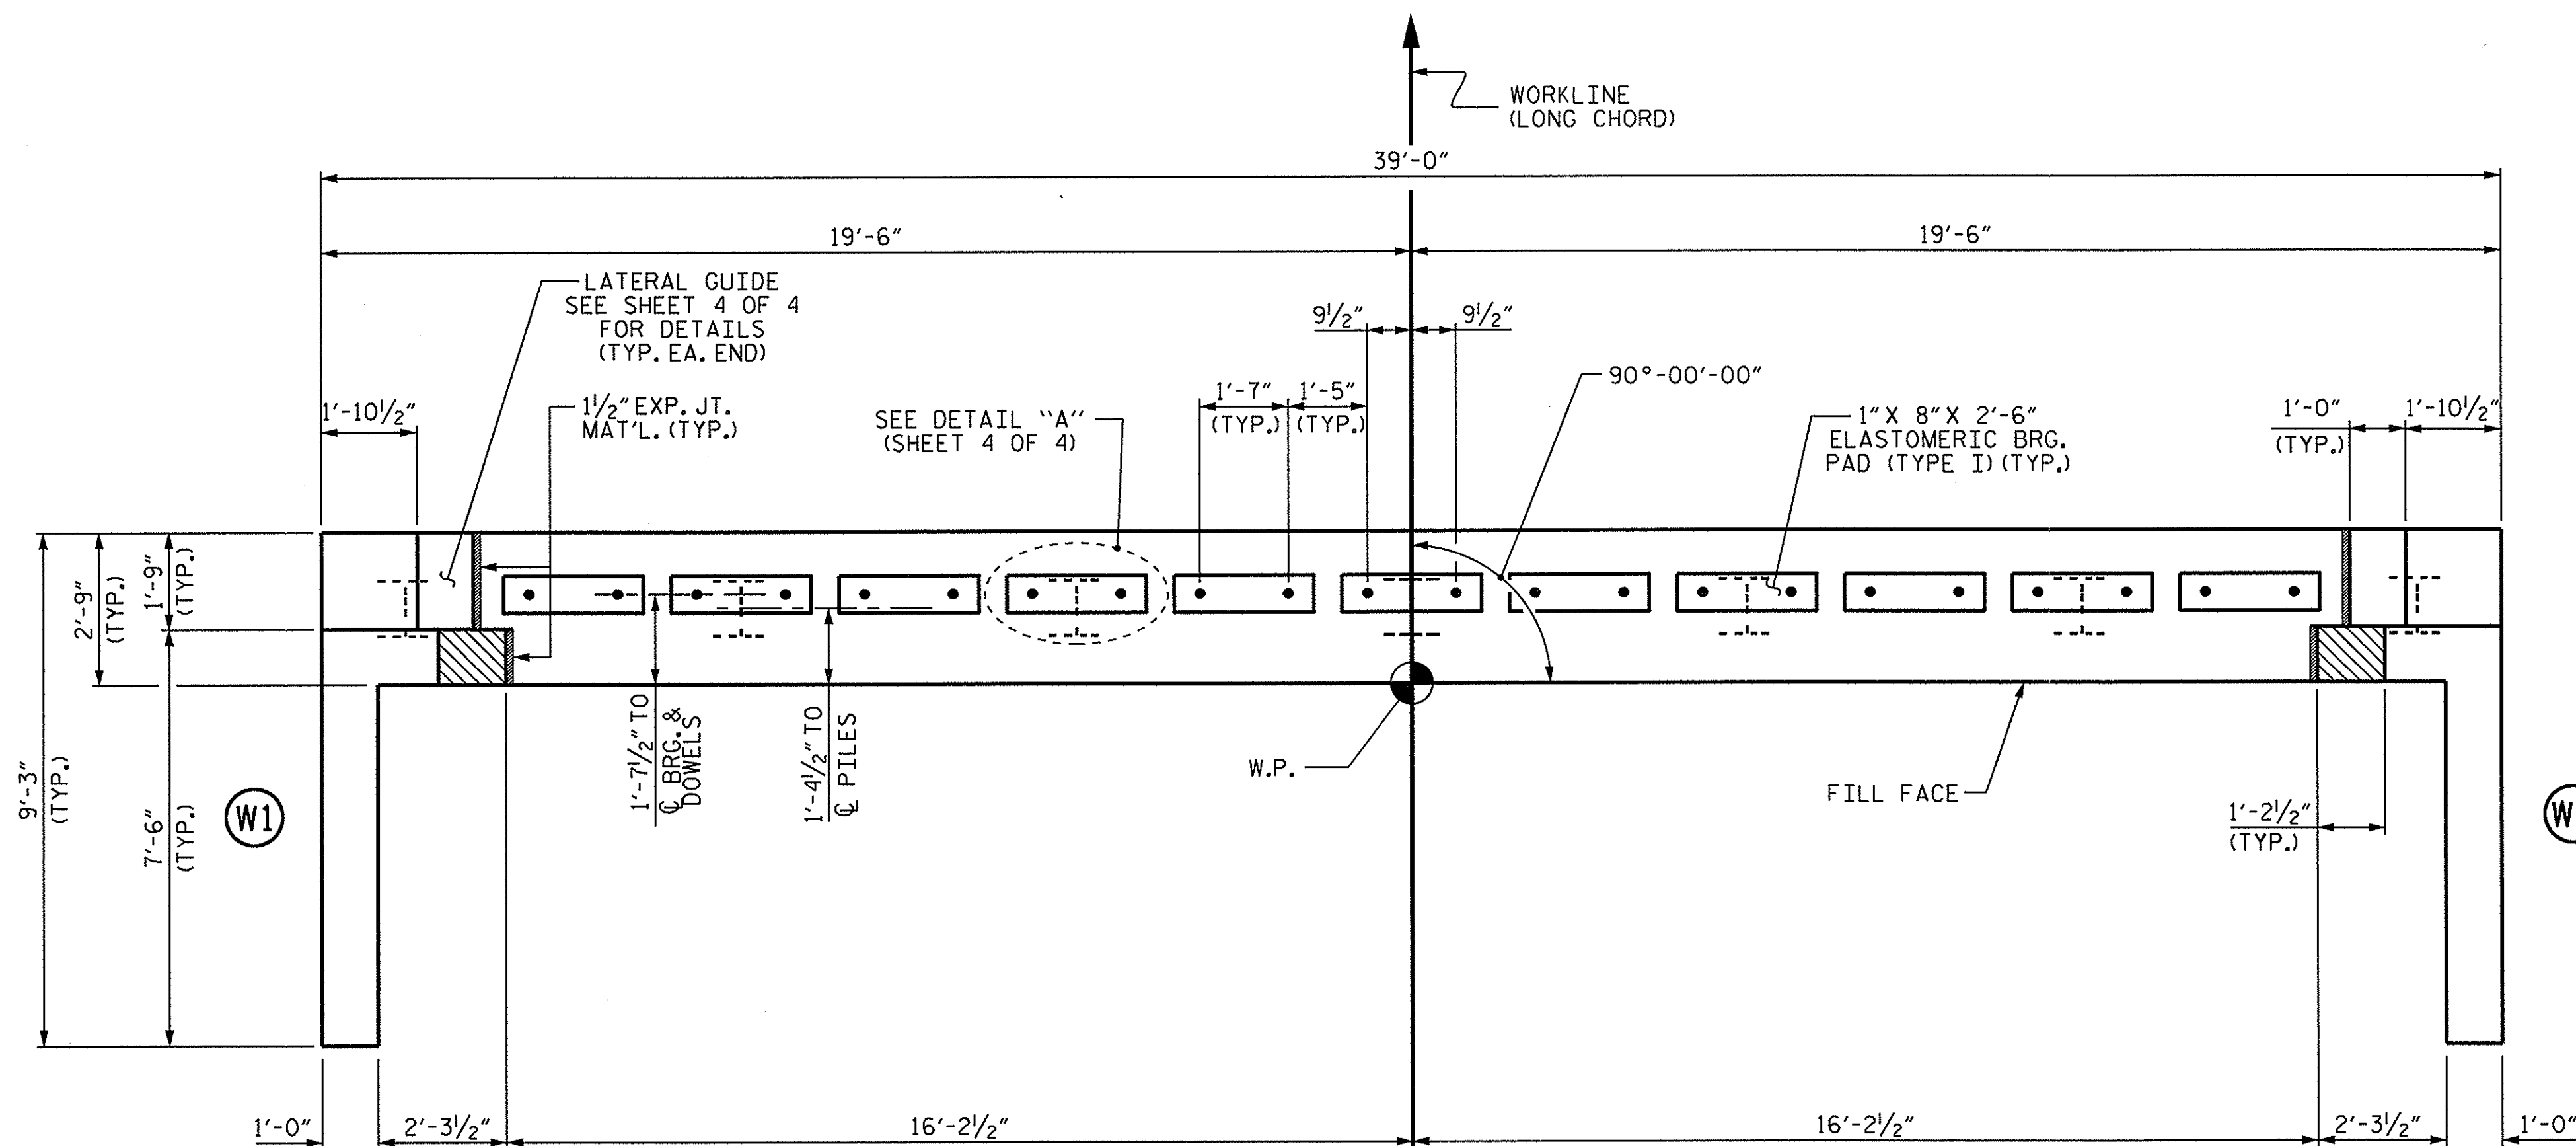

| TOP OF PILE ELEVATIONS |       |
|------------------------|-------|
| ①                      | 39.47 |
| ②                      | 39.23 |
| ③                      | 38.99 |
| ④                      | 38.75 |
| ⑤                      | 38.51 |
| ⑥                      | 38.27 |
| ⑦                      | 38.03 |

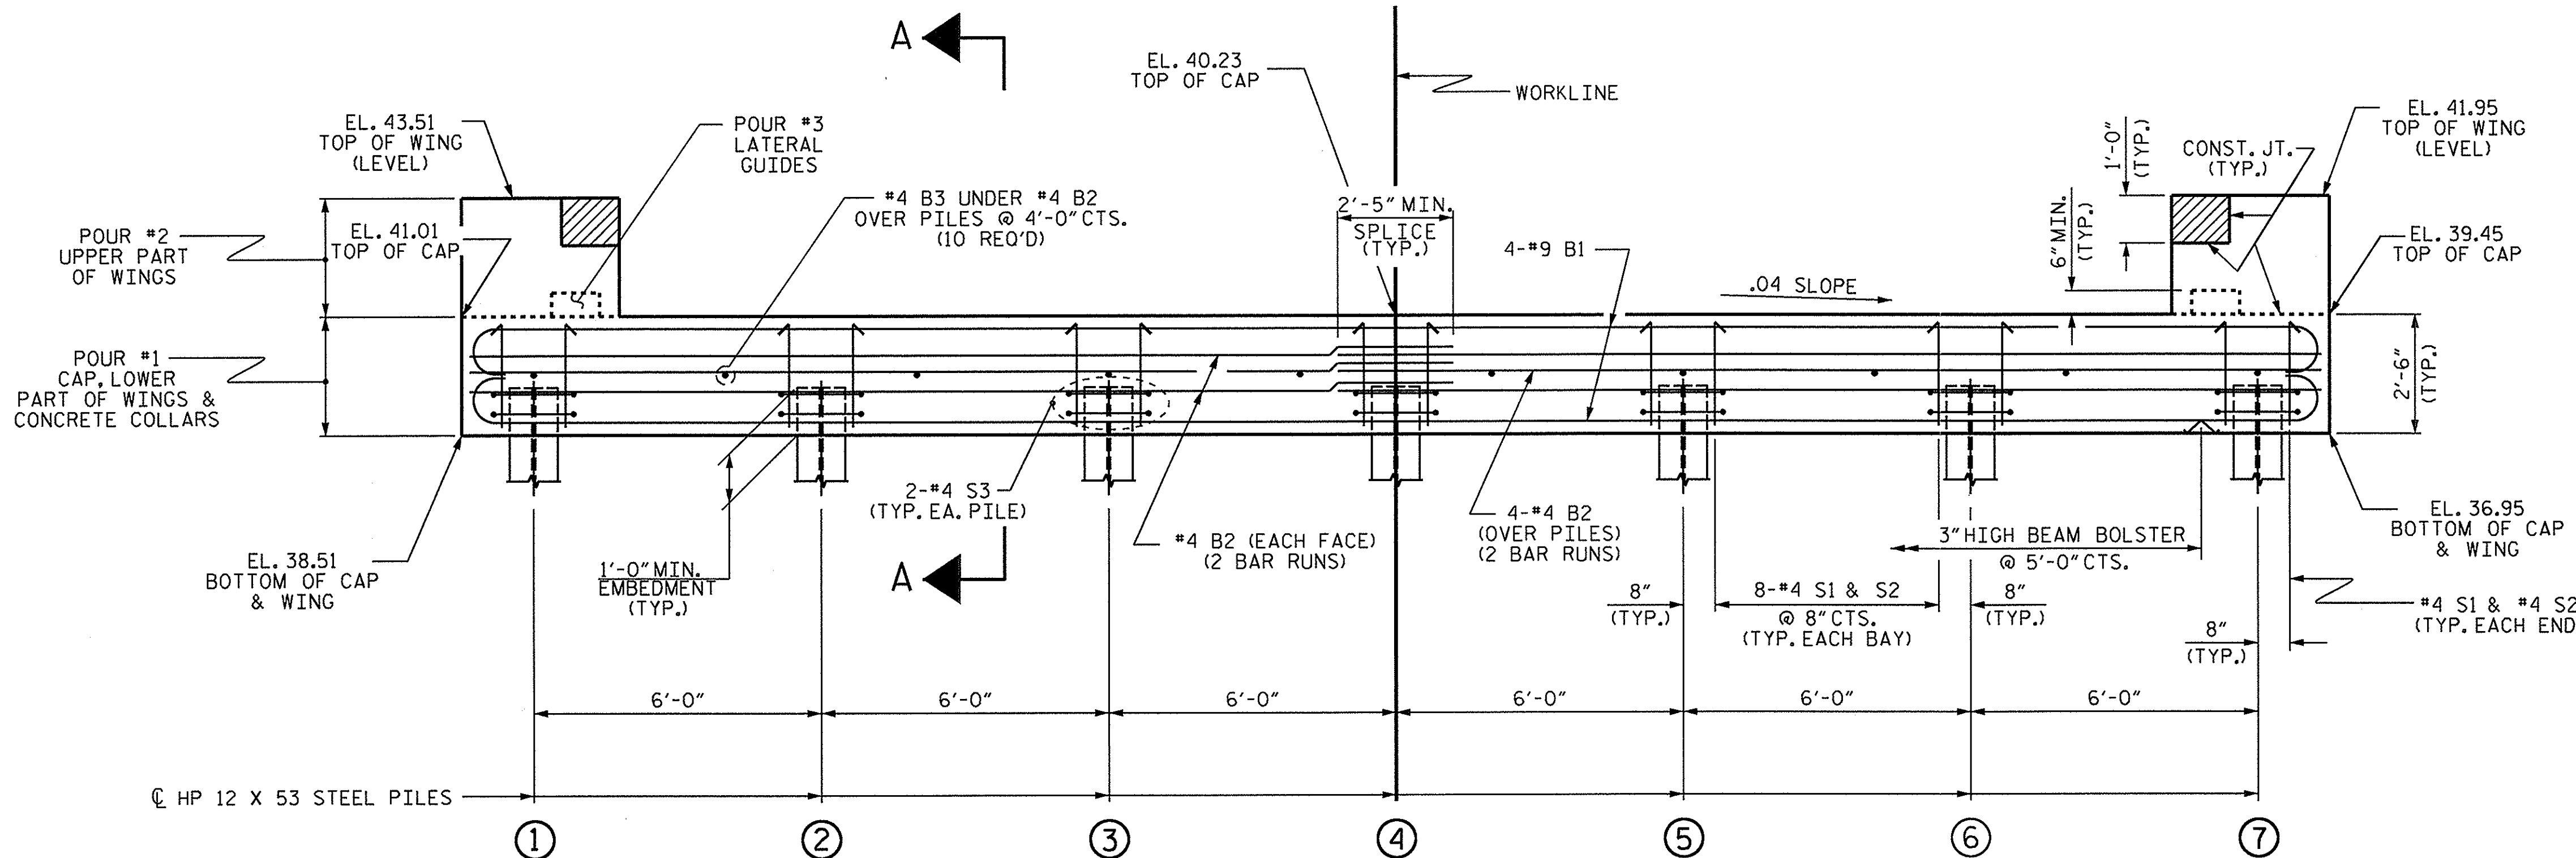


PROJECT NO. BD-5102U  
PITT COUNTY  
 STATION: 17+20.50 -L-

SHEET 1 OF 4

STATE OF NORTH CAROLINA  
 DEPARTMENT OF TRANSPORTATION  
 RALEIGH

SUBSTRUCTURE  
 END BENT No. 1

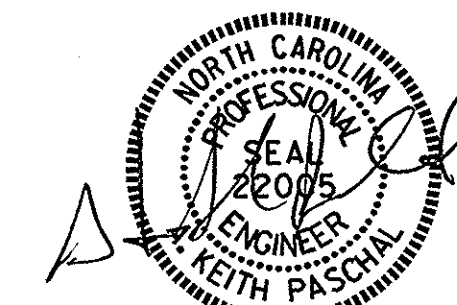


9.27.13

| REVISIONS |     |       |     |     |       | SHEET NO.    |
|-----------|-----|-------|-----|-----|-------|--------------|
| NO.       | BY: | DATE: | NO. | BY: | DATE: | S-10         |
| 1         |     |       | 3   |     |       | TOTAL SHEETS |
| 2         |     |       | 4   |     |       | 17           |


ASSEMBLED BY : A. H. SHIVELY DATE : 6/14/13  
 CHECKED BY : M. L. RORIE DATE : 6/18/13

DRAWN BY : DGE 02/10  
 CHECKED BY : MKT 02/10

WINGS NOT SHOWN FOR CLARITY.  
 FOR SECTION A-A, SEE SHEET 4 OF 4.  
 CONCRETE COLLARS FOR STEEL PILES NOT SHOWN IN PLAN AND ELEVATION VIEWS FOR CLARITY.  
 SEE "CORROSION PROTECTION FOR STEEL PILES DETAIL", SHEET 4 OF 4.

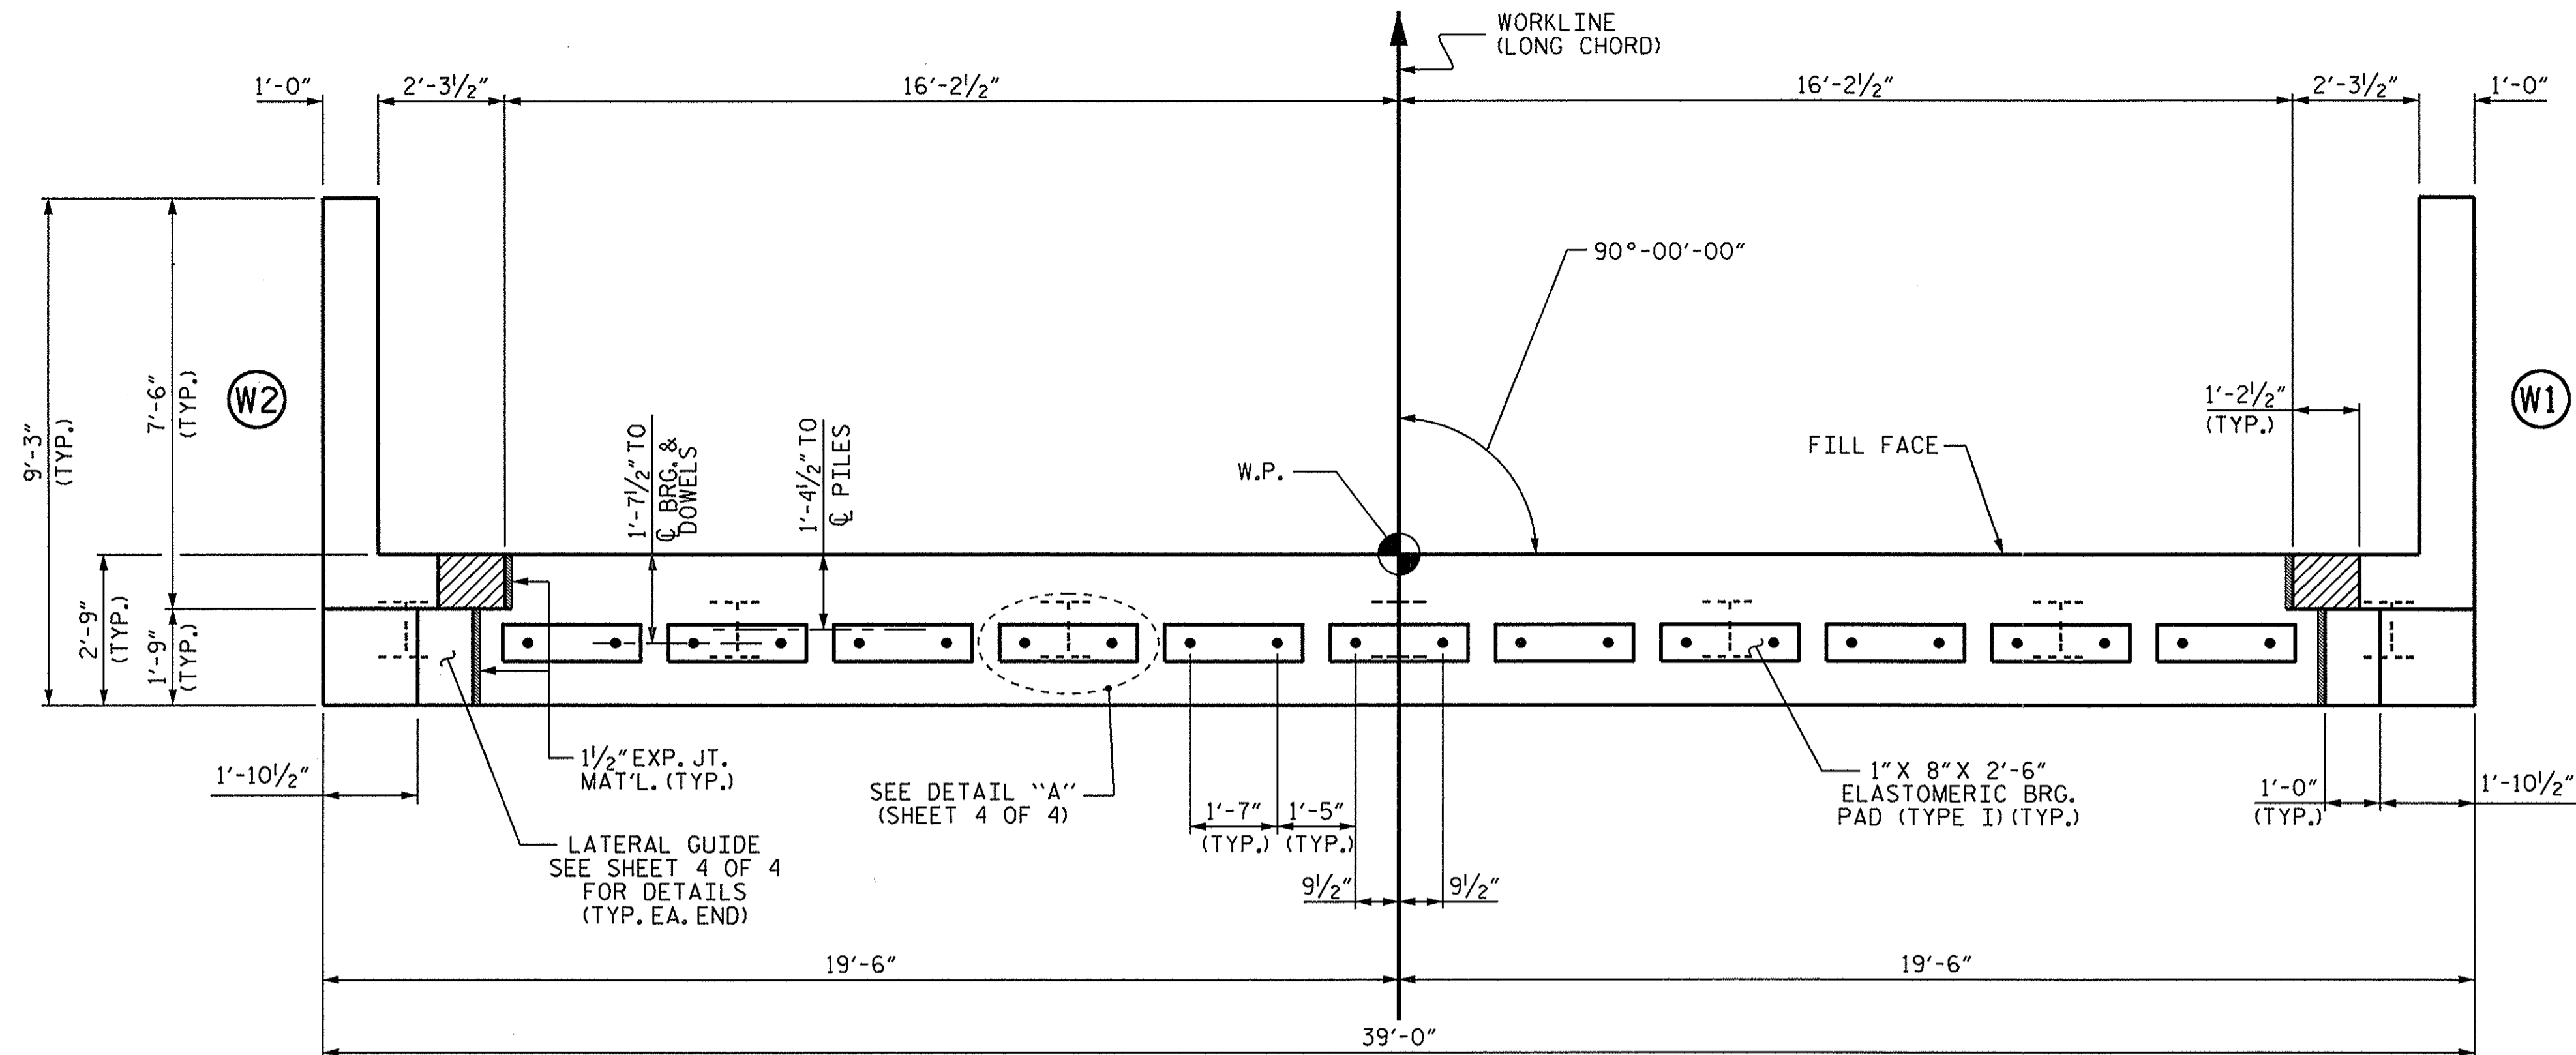

PLAN

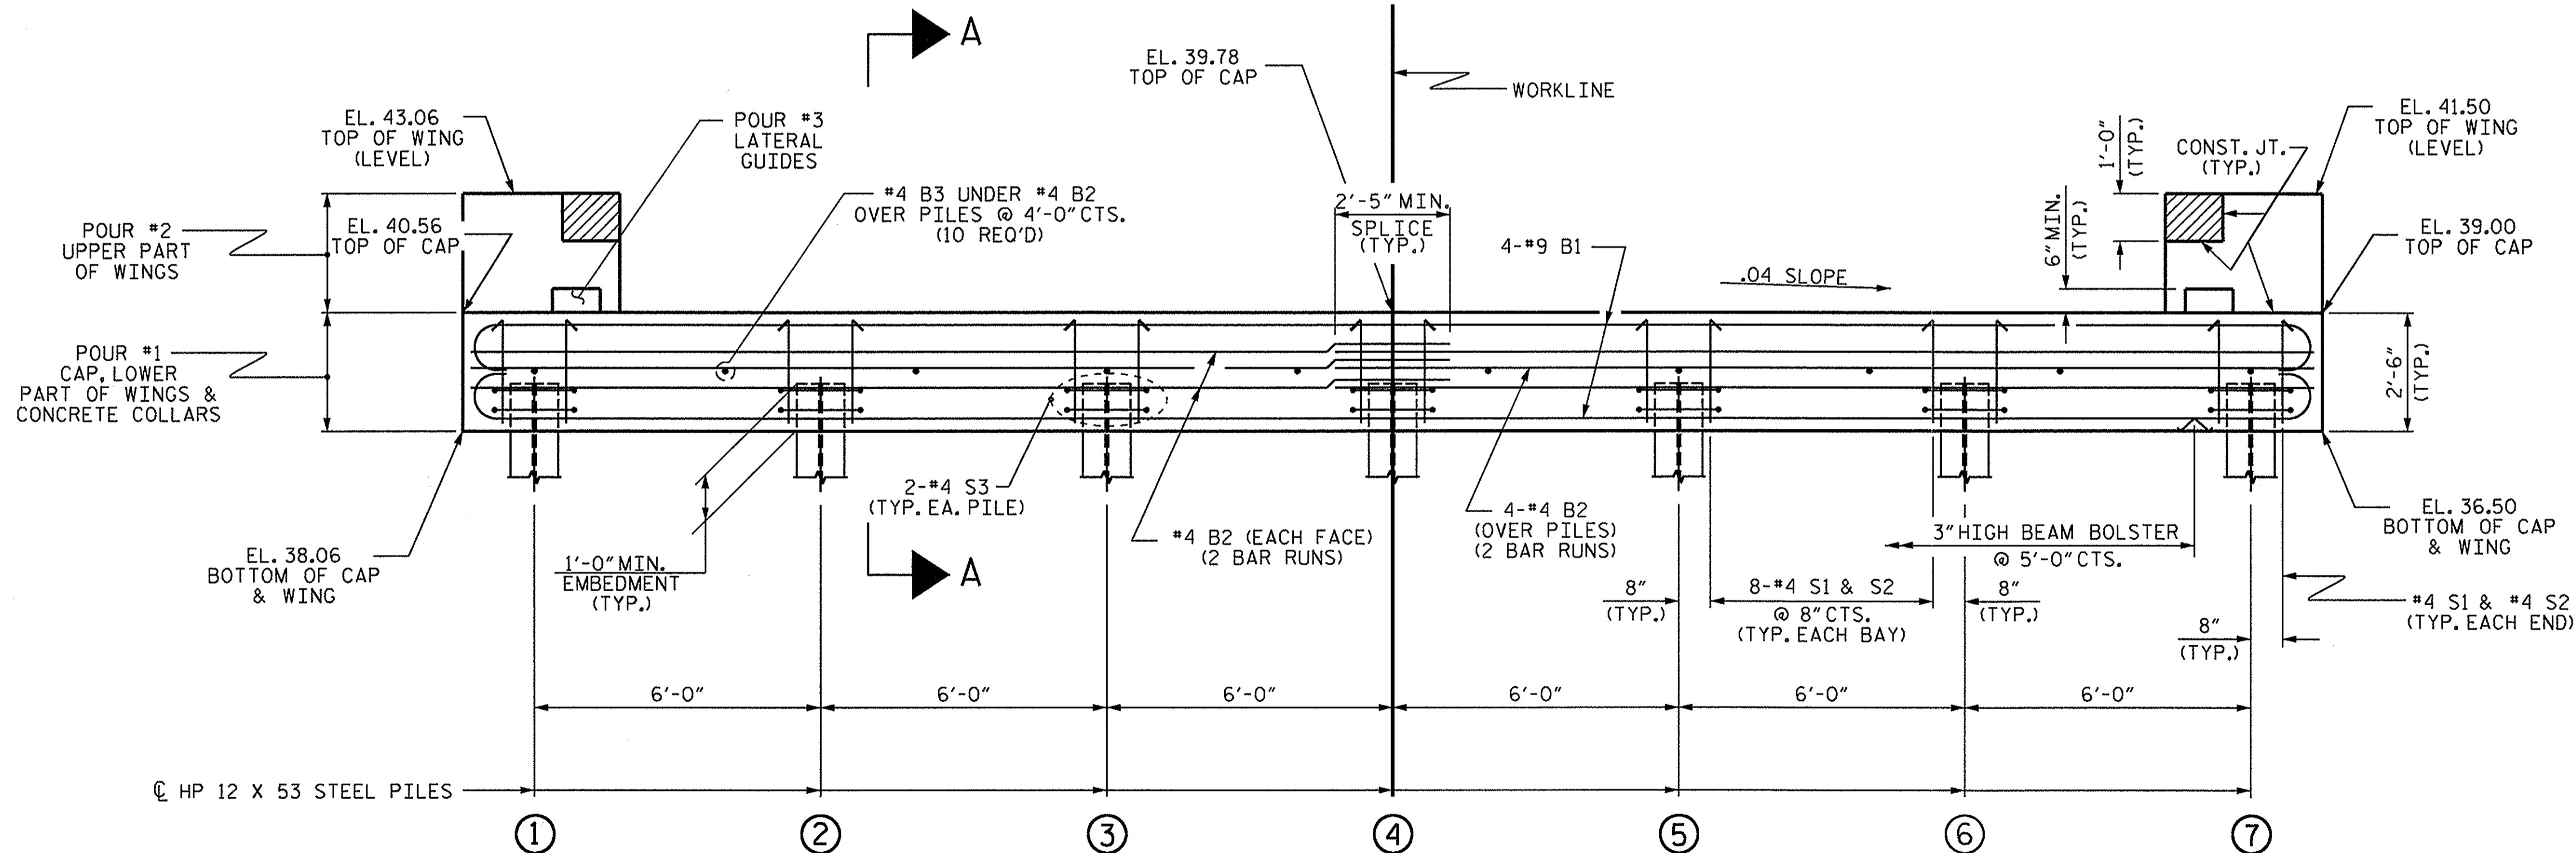

ELEVATION

WINGS NOT SHOWN FOR CLARITY.  
 FOR SECTION A-A, SEE SHEET 4 OF 4.  
 CONCRETE COLLARS FOR STEEL PILES NOT SHOWN IN PLAN AND ELEVATION VIEWS FOR CLARITY.  
 SEE "CORROSION PROTECTION FOR STEEL PILES DETAIL", SHEET 4 OF 4.

NOTES

STIRRUPS IN CAP MAY BE SHIFTED AS NECESSARY TO CLEAR DOWELS.

THE LATERAL GUIDES ARE NOT TO BE POURED UNTIL AFTER THE CORED SLAB UNITS ARE IN PLACE.

THE CONCRETE IN THE SHADED AREA OF THE WING SHALL BE POURED AFTER THE VERTICAL CONCRETE BARRIER RAIL IS CAST IF SLIP FORMING IS USED.

FOR PILE SPLICE DETAILS, SEE SHEET 4 OF 4.

FOR WING DETAILS, SEE SHEET 3 OF 4.

THE CONTRACTOR HAS THE OPTION TO OMIT THE LATERAL GUIDE IF APPROVED BY THE ENGINEER.

INSTALL THE 4" Ø DRAIN PIPE THROUGH THE WING WALL AS REQUIRED. FOR REINFORCED BRIDGE APPROACH FILLS, SEE THE ROADWAY PLANS. REINFORCING STEEL IN THE WING WALL MAY BE SHIFTED AS NECESSARY TO CLEAR THE DRAIN PIPE.

TOP OF PILE ELEVATIONS

|   |       |
|---|-------|
| ① | 39.02 |
| ② | 38.78 |
| ③ | 38.54 |
| ④ | 38.30 |
| ⑤ | 38.06 |
| ⑥ | 37.82 |
| ⑦ | 37.58 |

PROJECT NO. BD-5102U  
PITT COUNTY  
 STATION: 17+20.50 -L-


SHEET 2 OF 4

STATE OF NORTH CAROLINA  
 DEPARTMENT OF TRANSPORTATION  
 RALEIGH


SUBSTRUCTURE  
 END BENT No. 2

REVISIONS


| NO. | BY: | DATE: | NO. | BY: | DATE: | SHEET NO.       |
|-----|-----|-------|-----|-----|-------|-----------------|
| 1   |     |       | 3   |     |       | S-11            |
| 2   |     |       | 4   |     |       | TOTAL SHEETS 17 |

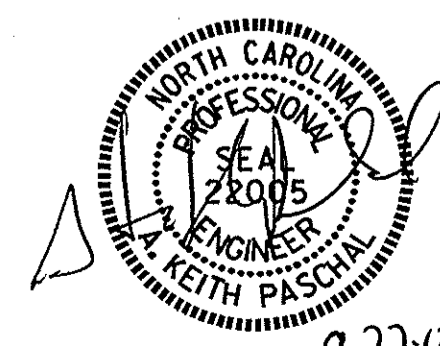


ASSEMBLED BY : A. H. SHIVELY DATE : 6/14/13  
 CHECKED BY : M. L. RORIE DATE : 6/18/13  
 DRAWN BY : DGE 02/10  
 CHECKED BY : MKT 02/10

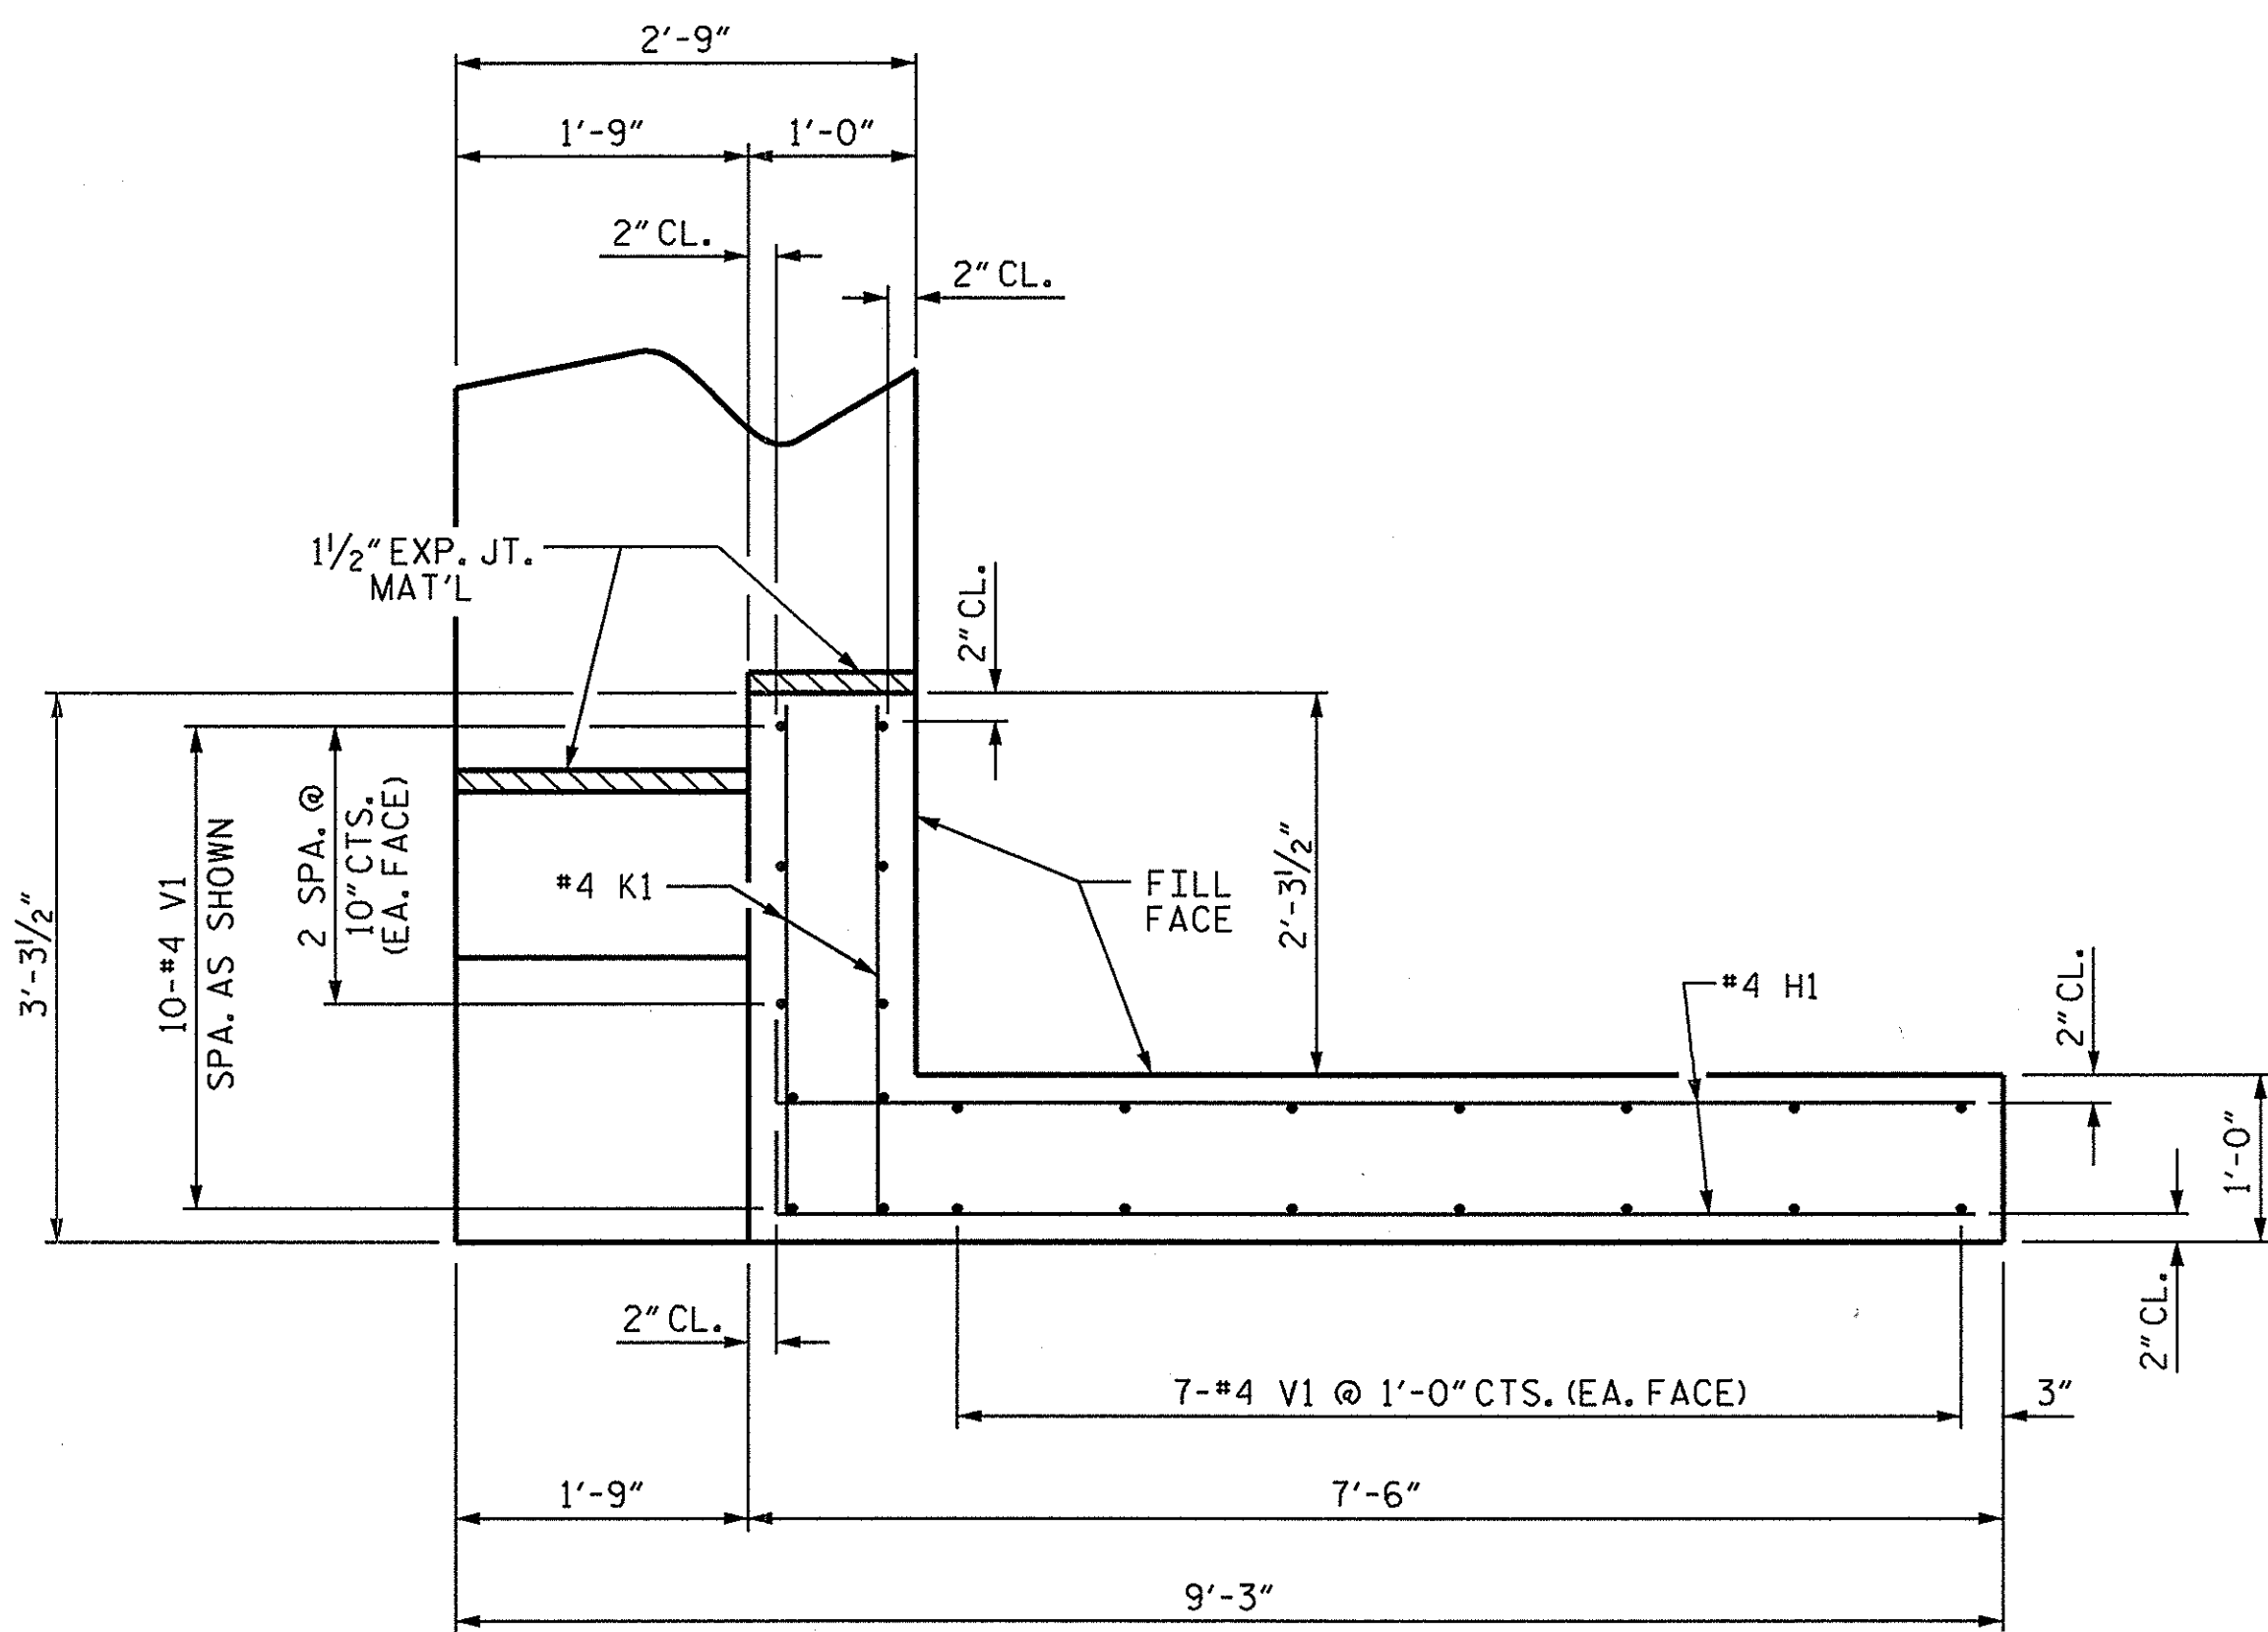


PLAN OF WING (W1)

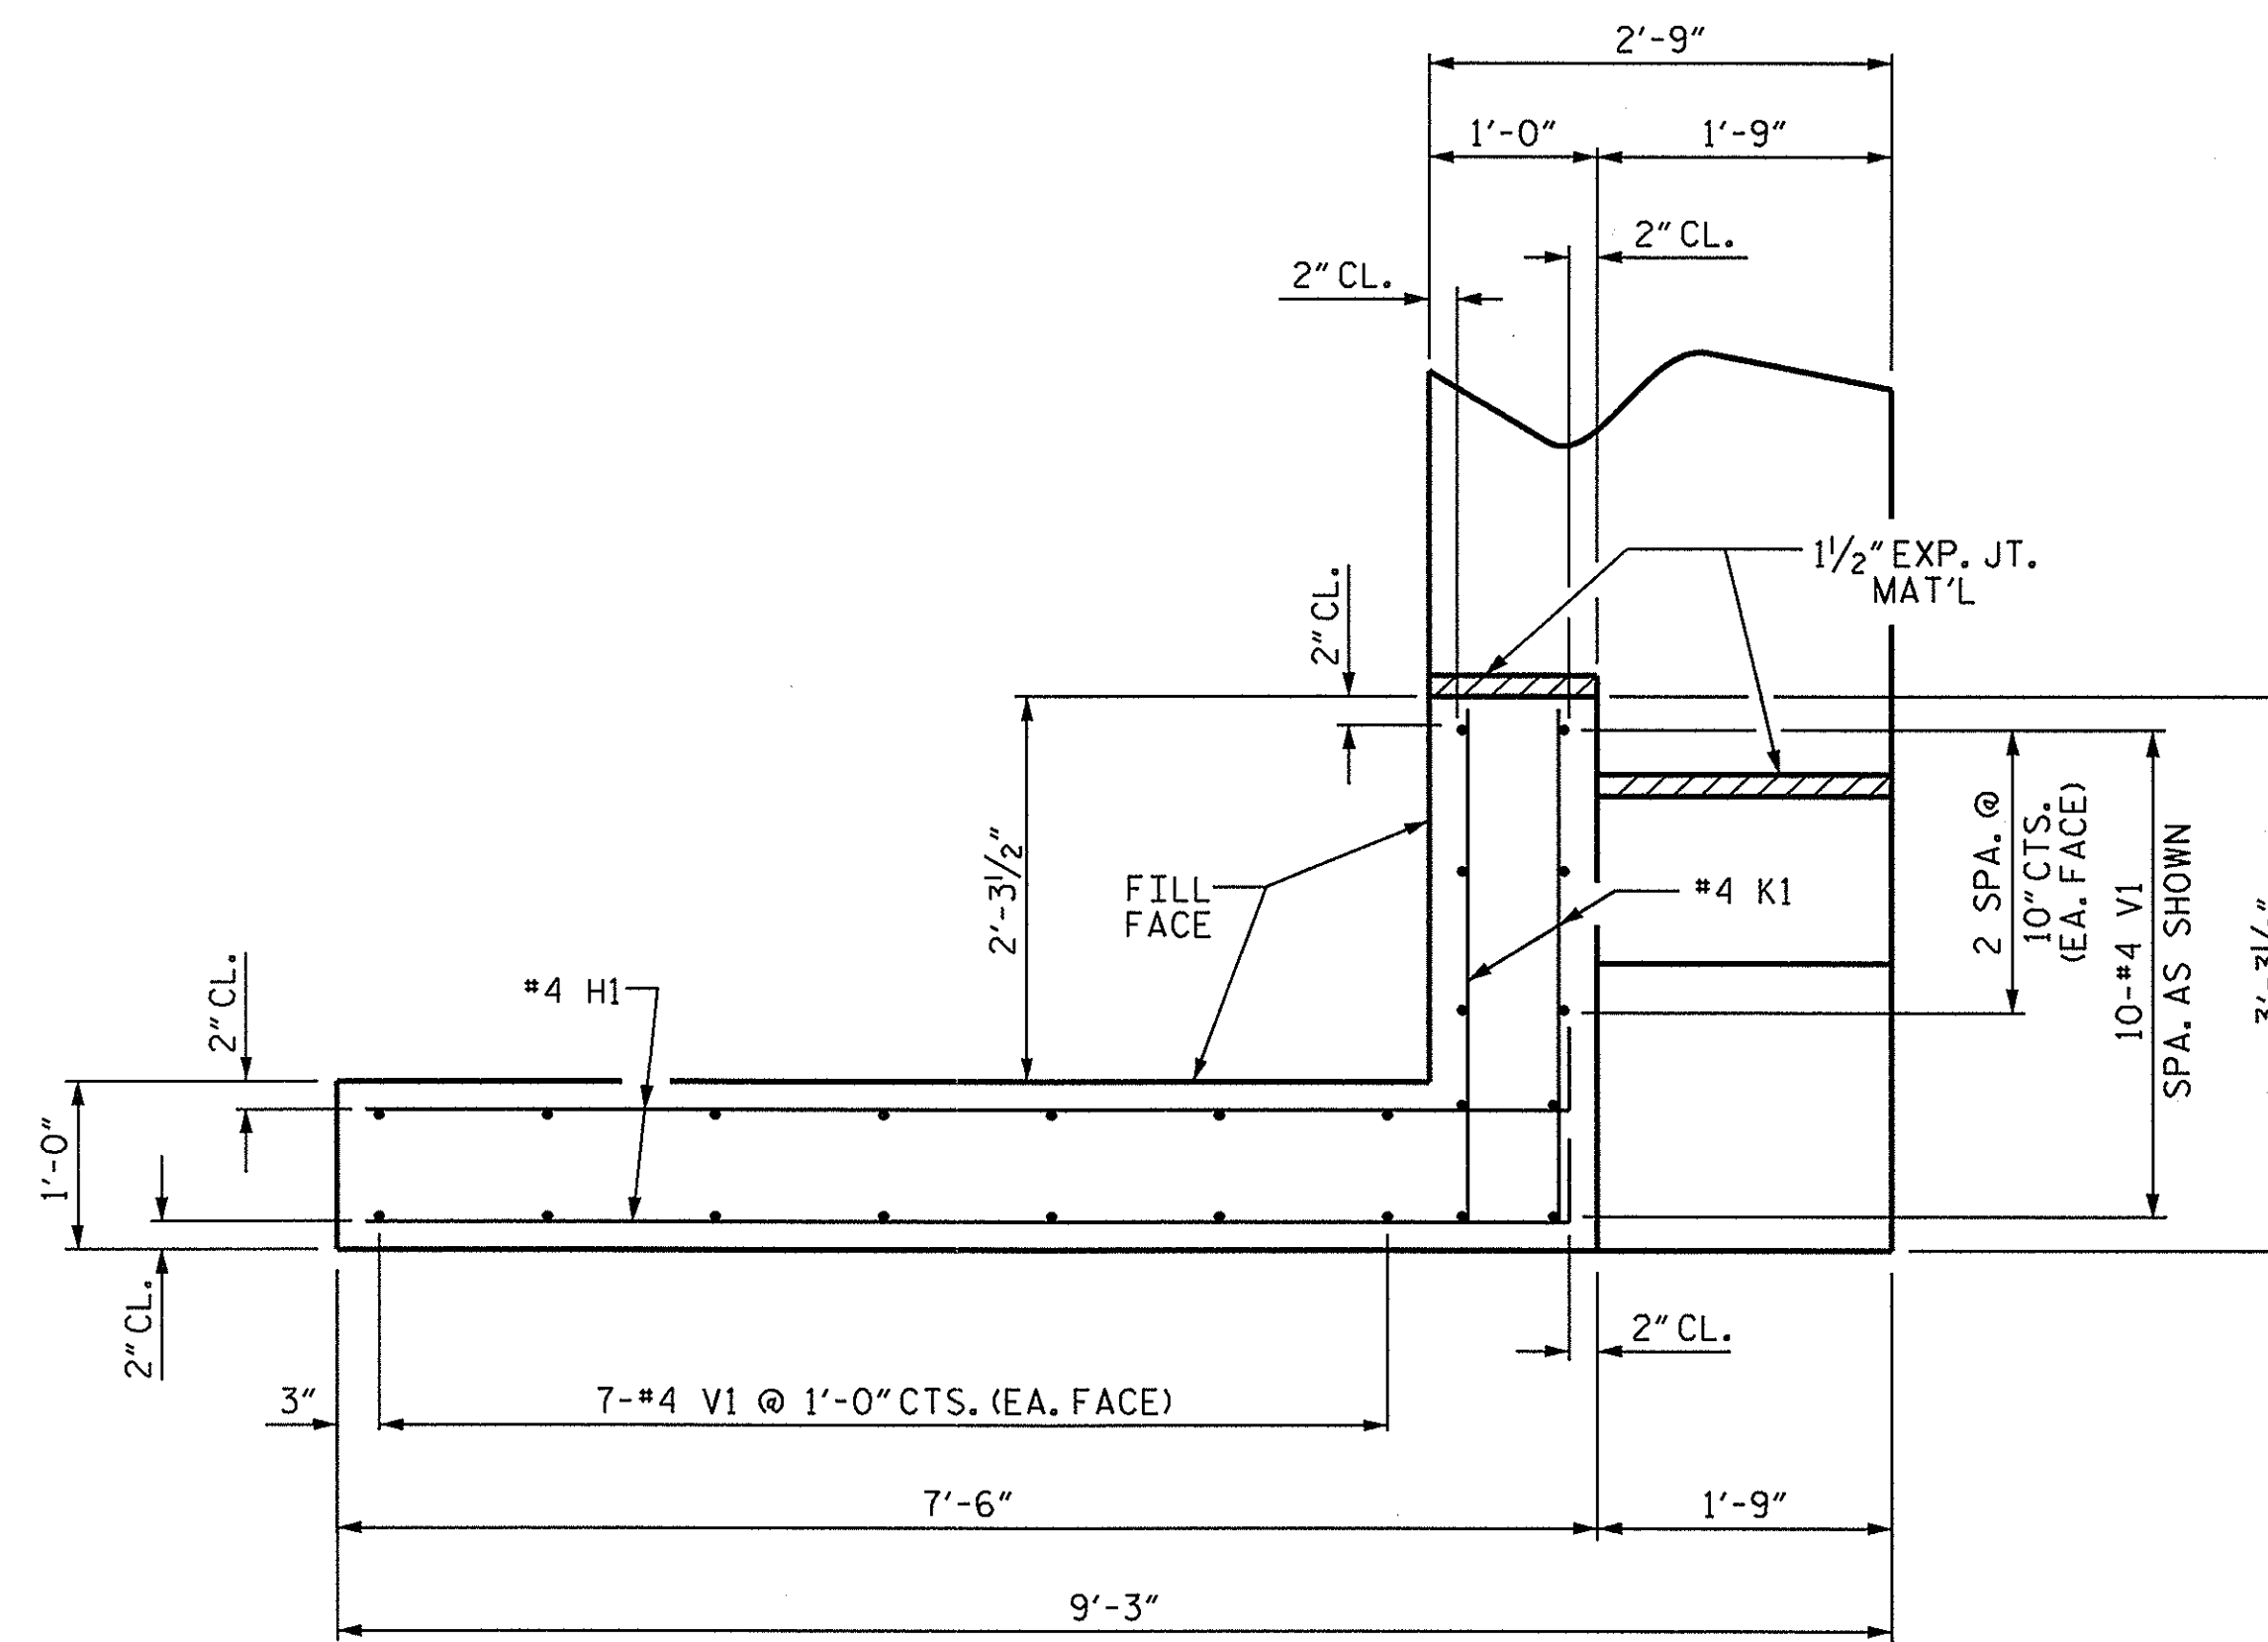


PLAN OF WING (W2)

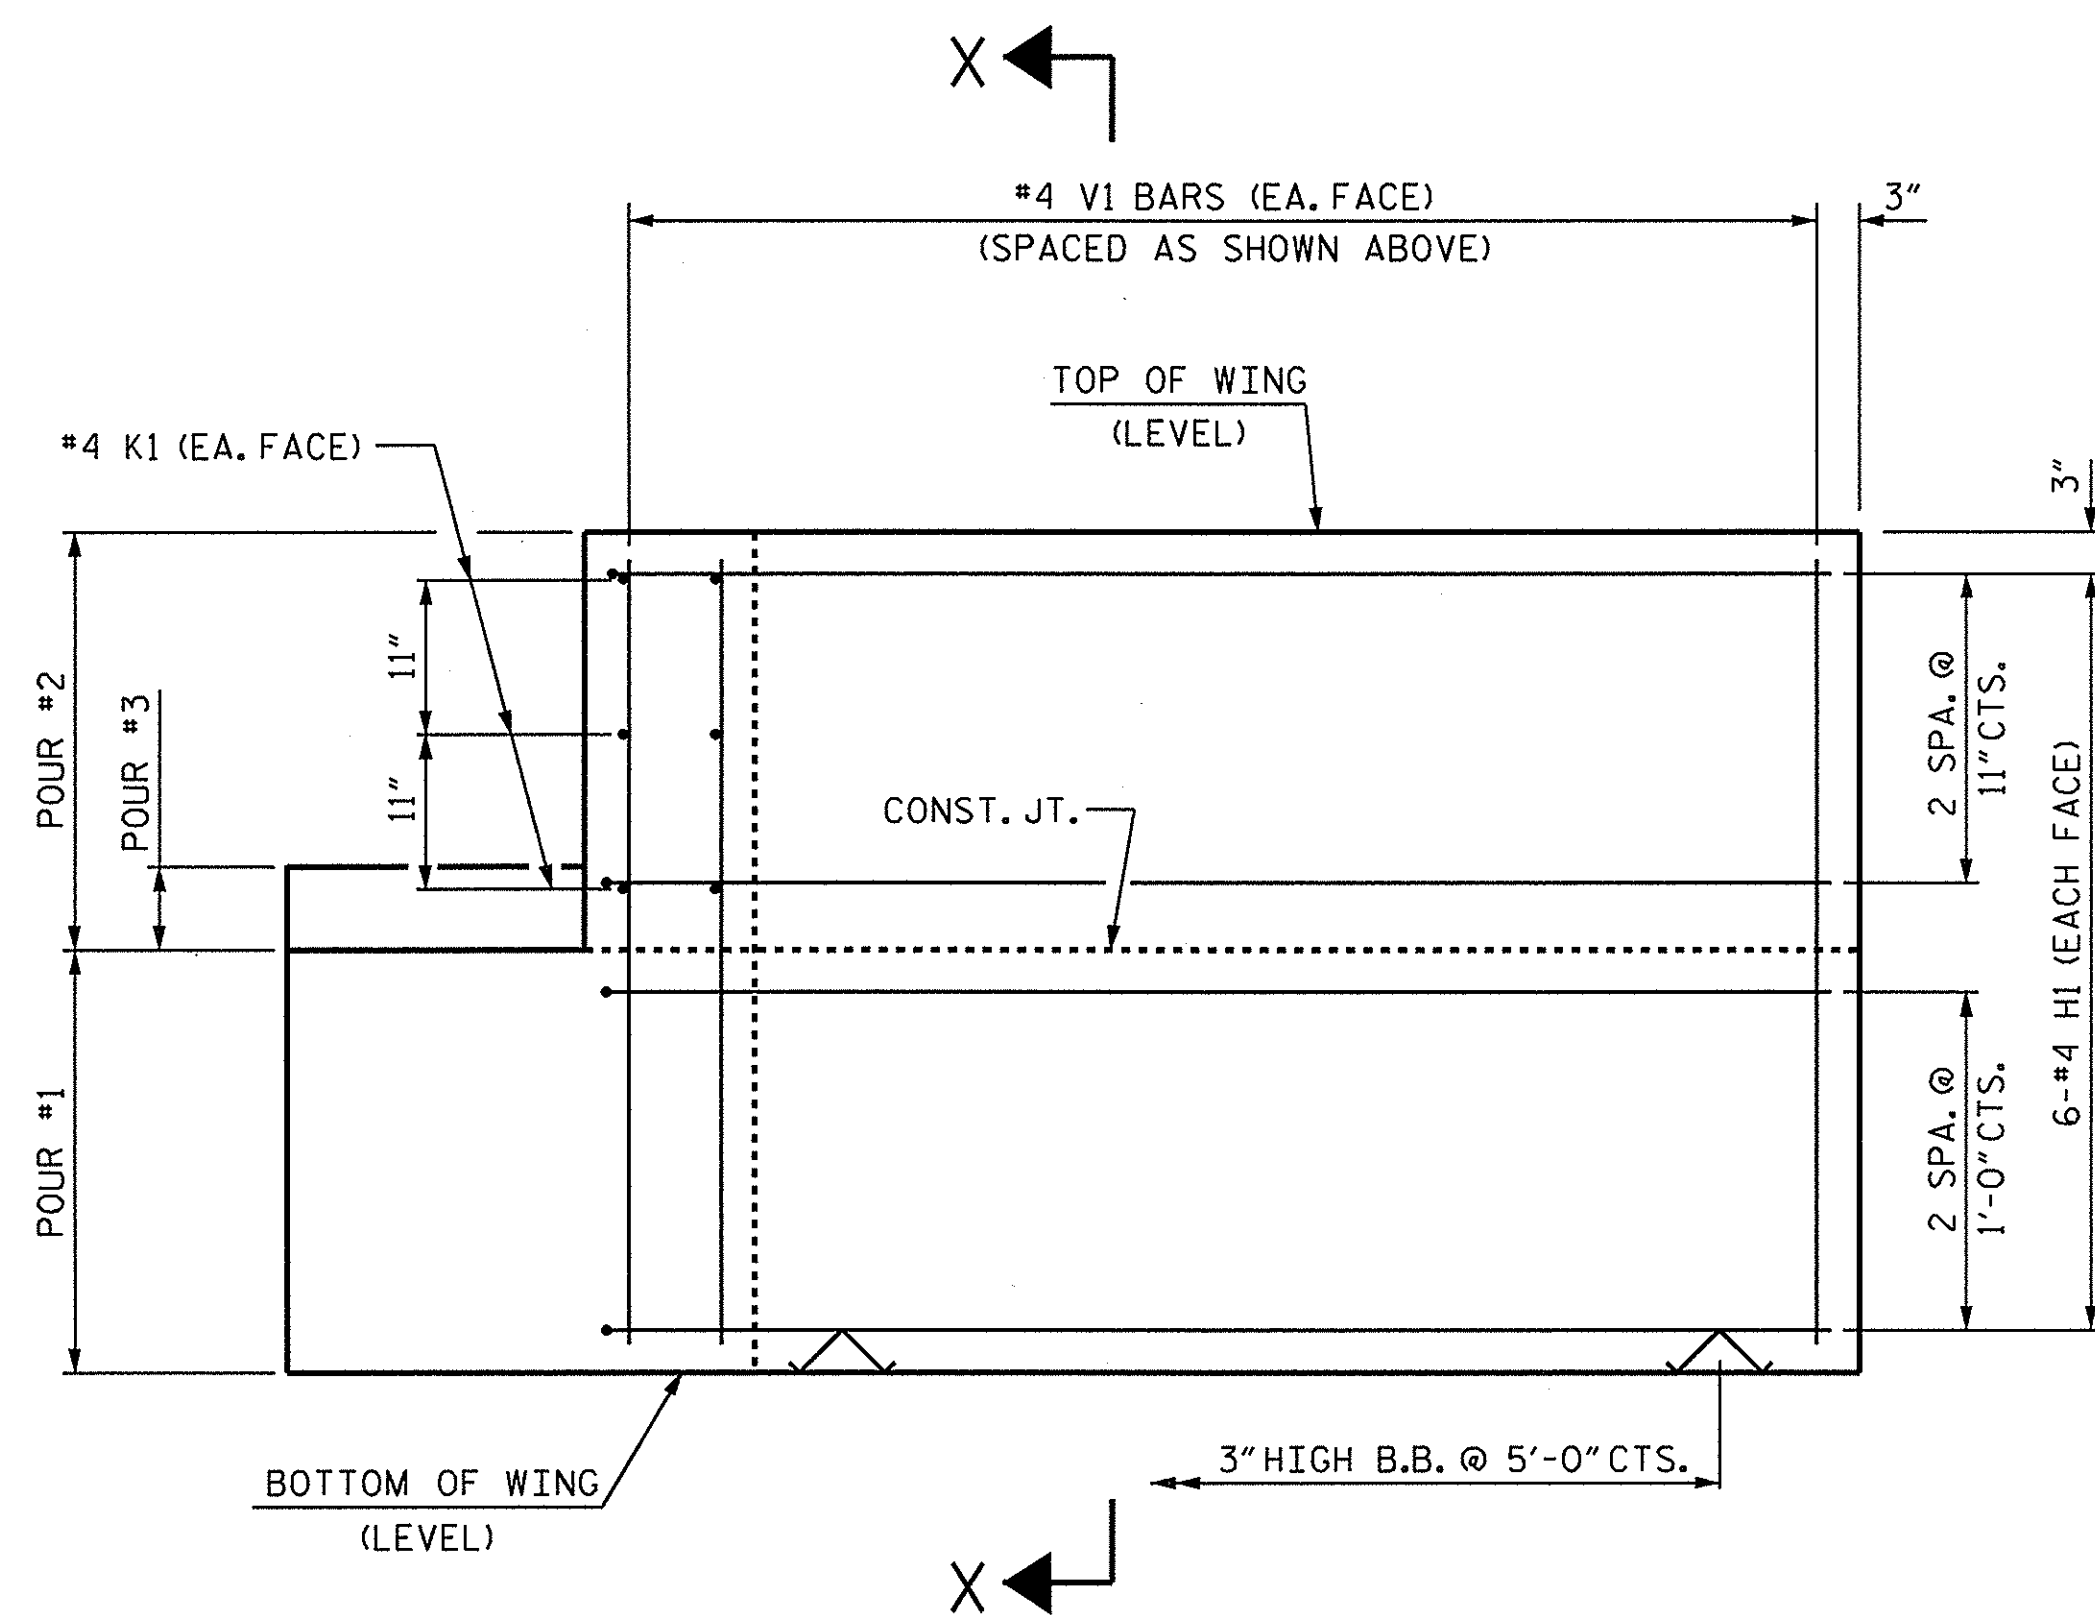


ELEVATION OF WING (W1)

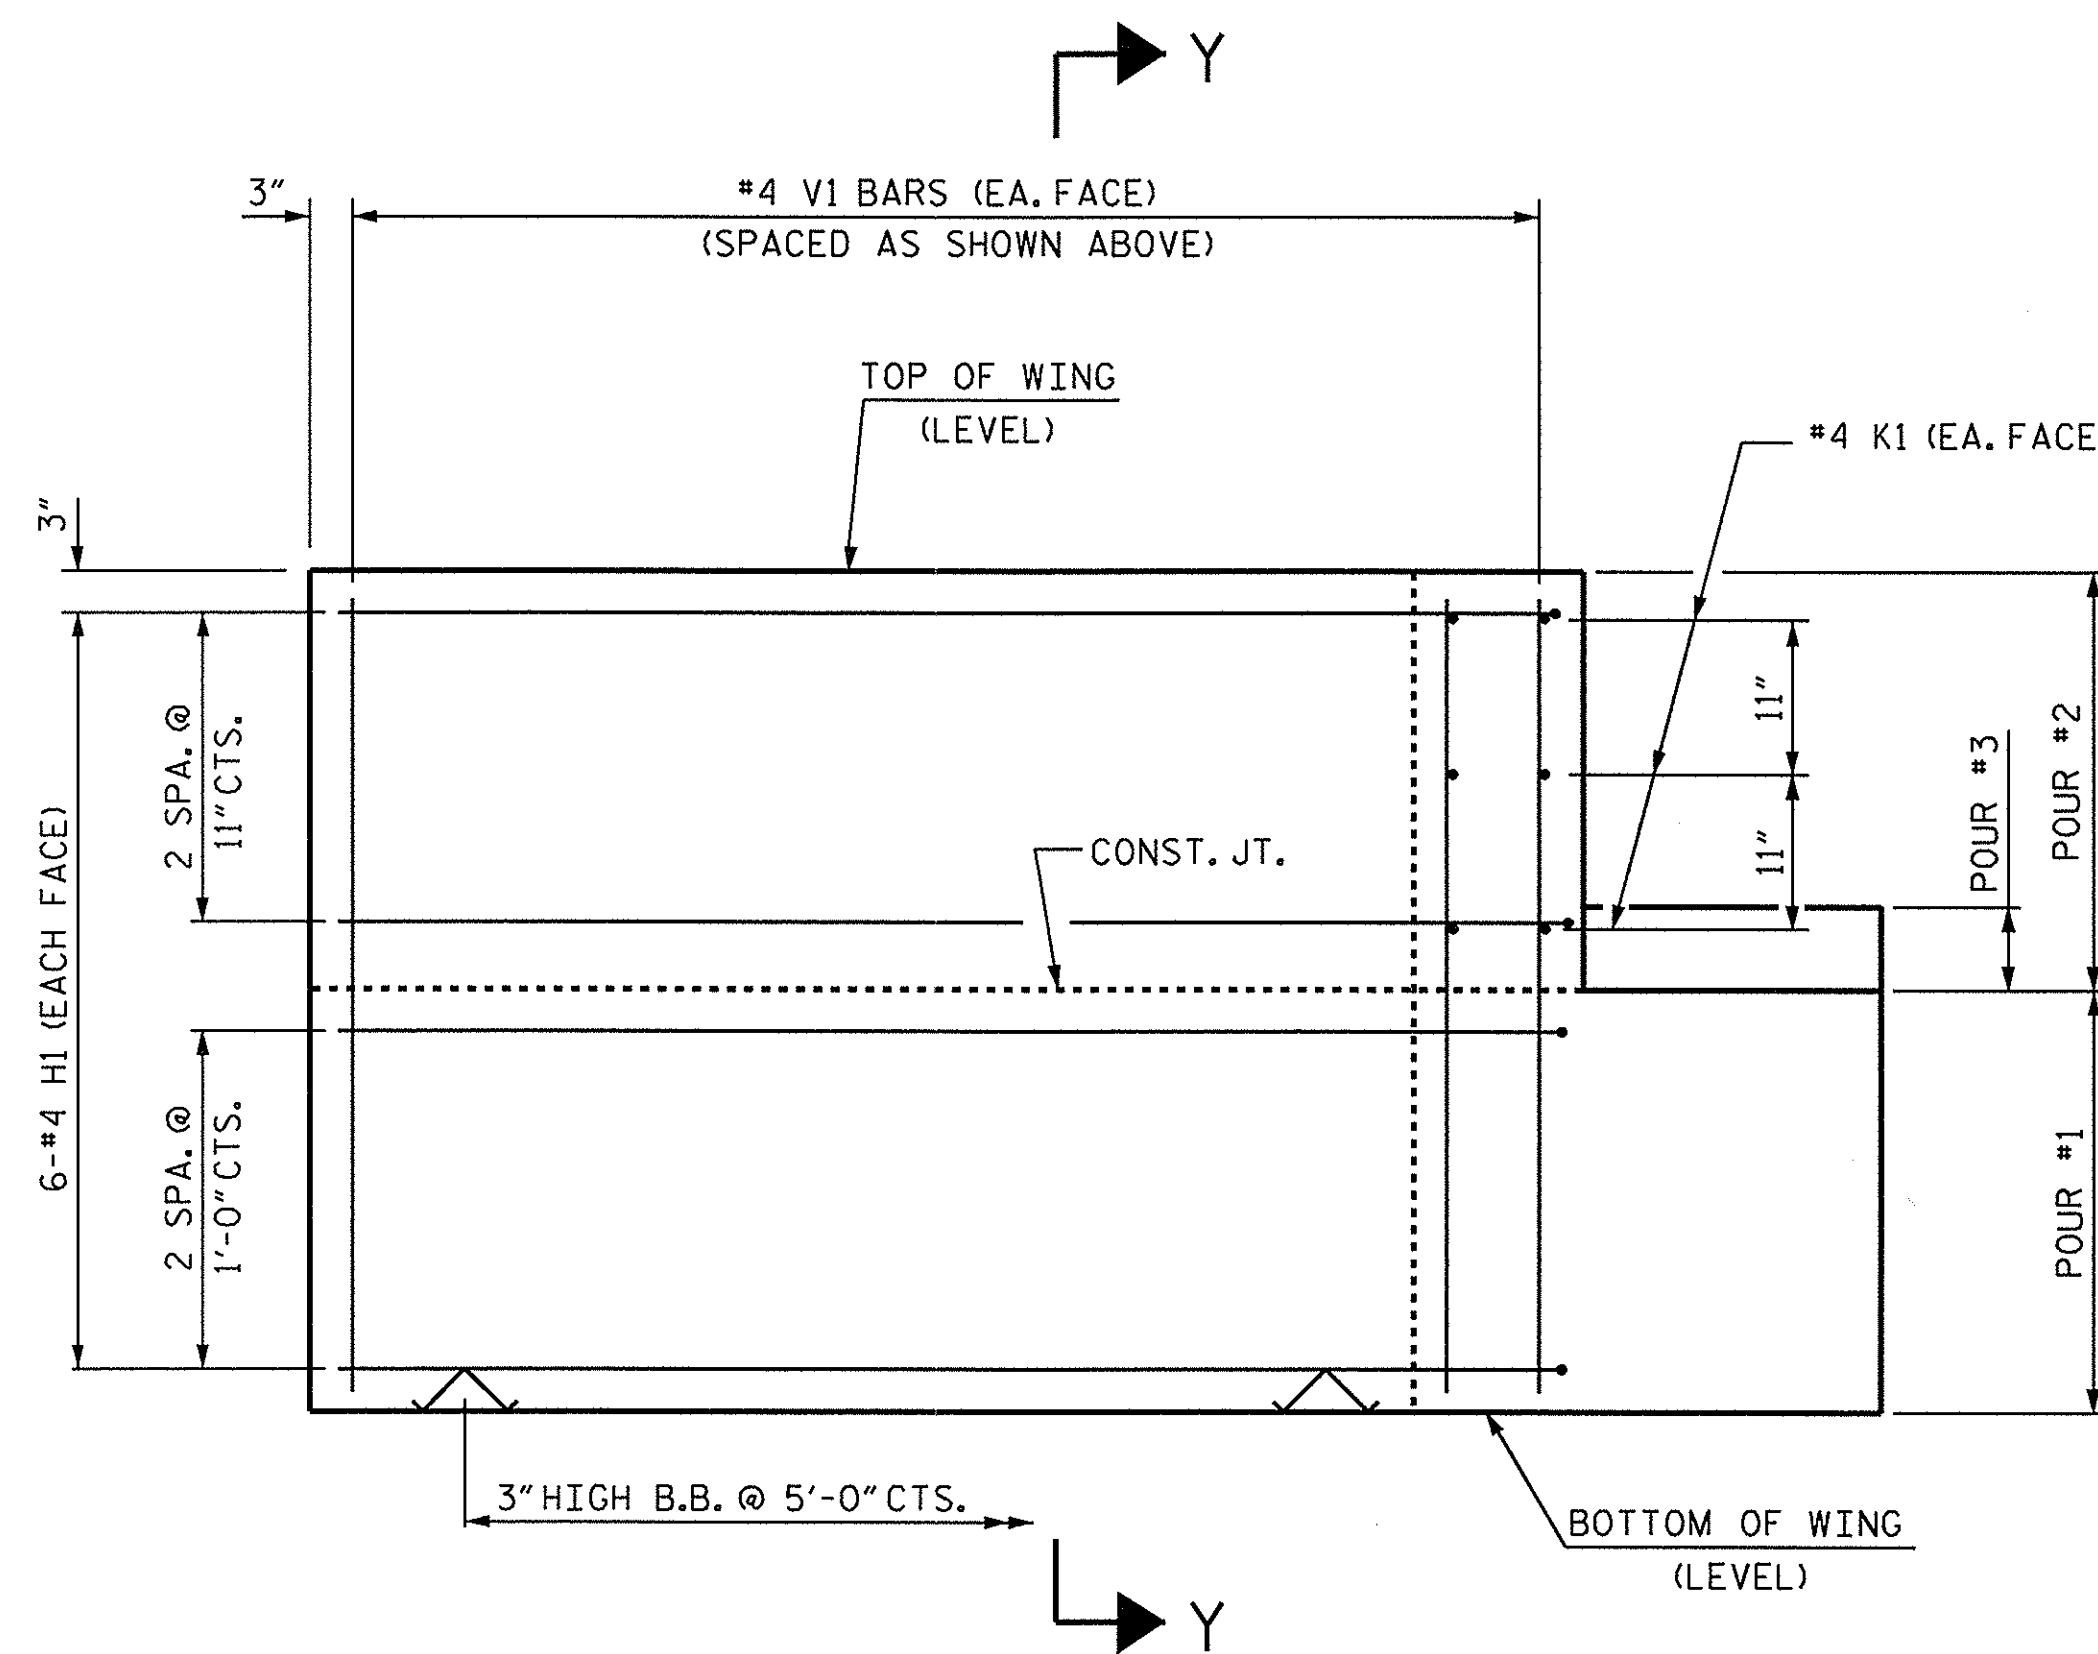

ELEVATION OF WING (W2)

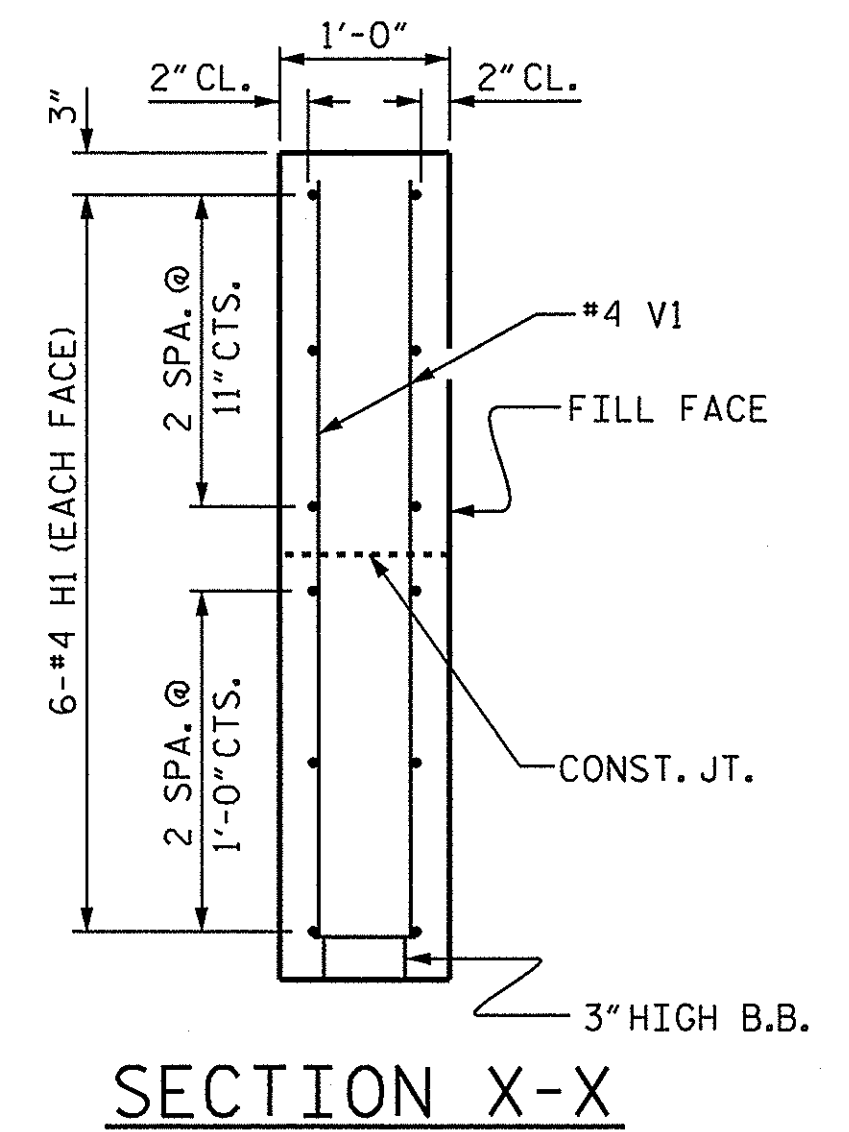

SECTION X-X

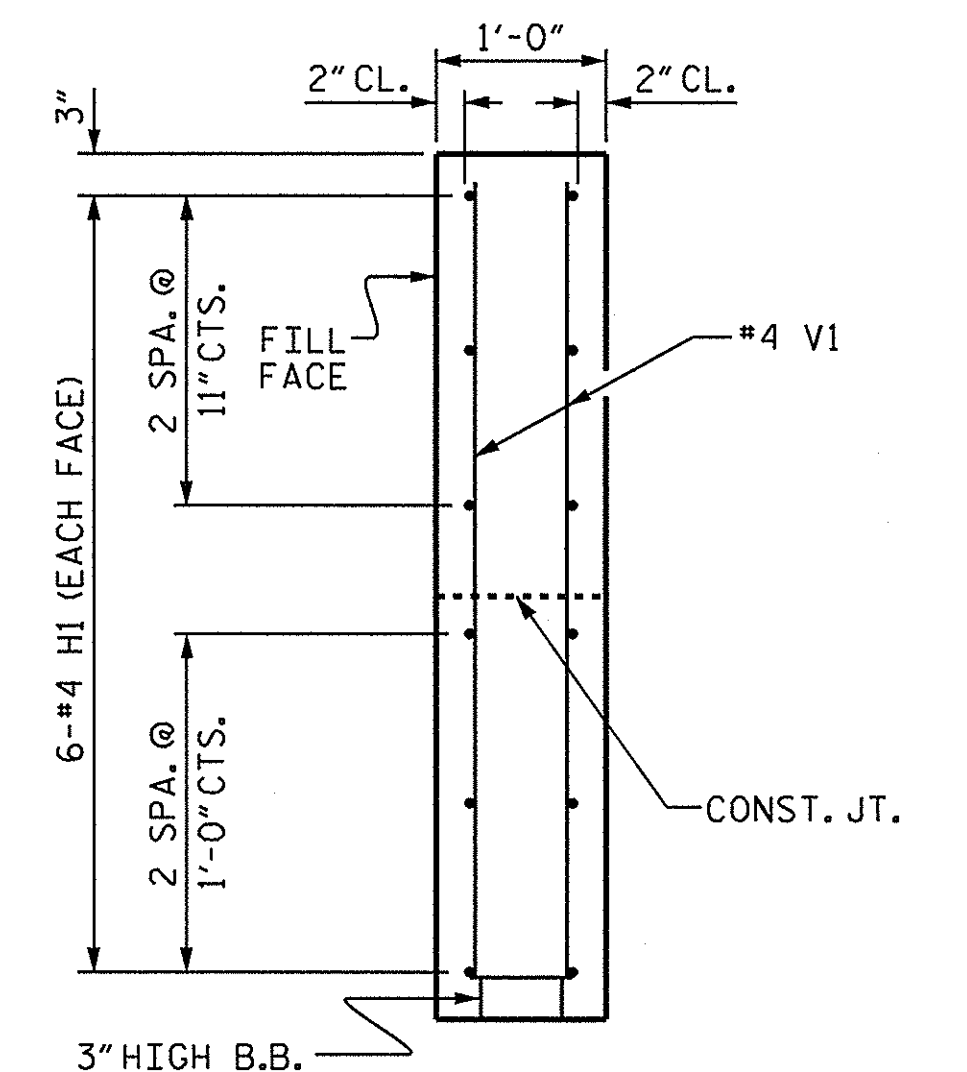


SECTION Y-Y

WING DETAILS

ASSEMBLED BY : A. H. SHIVELY DATE : 6/14/13  
 CHECKED BY : M. L. RORIE DATE : 6/18/13  
 DRAWN BY : DCE 02/10  
 CHECKED BY : MKT 02/10

27-SEP-2013 08:20  
 S:\DPO\Keith\BD-5102U\Design\BD-5102U.SD.EB.dgn  
 kpschd

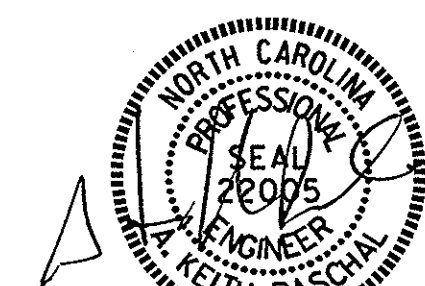


PROJECT NO. BD-5102U  
PITT COUNTY  
 STATION: 17+20.50 -L-

SHEET 3 OF 4

| STATE OF NORTH CAROLINA<br>DEPARTMENT OF TRANSPORTATION<br>RALEIGH |     |       |     |     |       |
|--|-----|-------|-----|-----|-------|
| SUBSTRUCTURE<br>END BENT<br>WING DETAILS                           |     |       |     |     |       |
| REVISIONS  |     |       |     |     |       |
| NO.  | BY: | DATE: | NO. | BY: | DATE: |
| 1  |     |       | 3   |     |       |
| 2  |     |       | 4   |     |       |

SHEET NO.  
S-12  
TOTAL SHEETS  
17

STD. NO. EB.33.90S

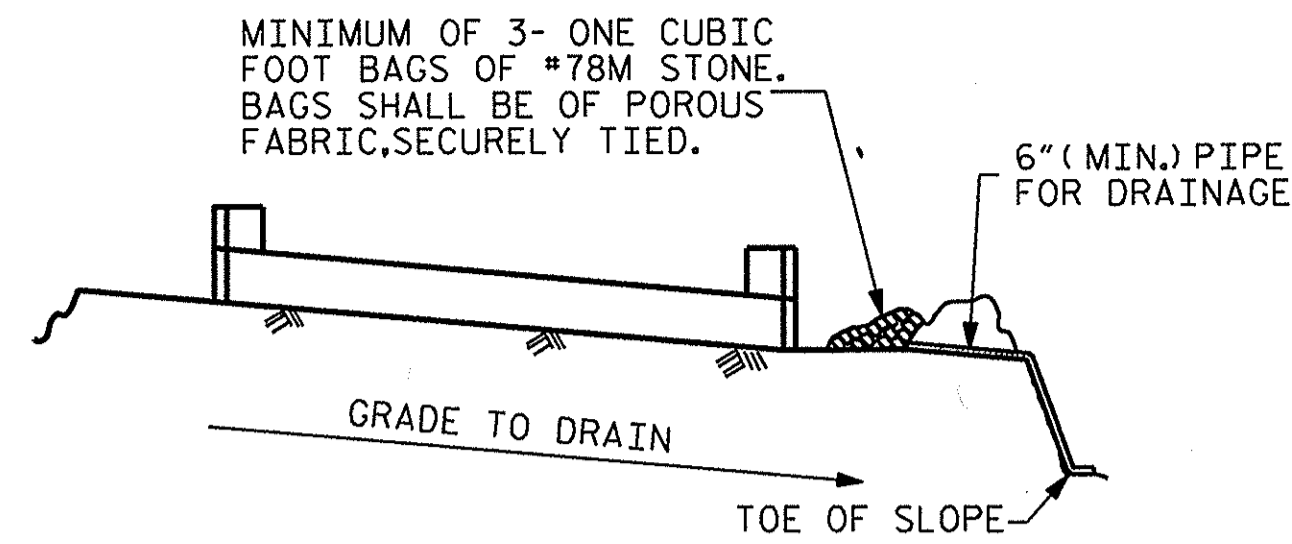


BAGGED STONE AND PIPE SHALL BE PLACED IMMEDIATELY AFTER COMPLETION OF END BENT EXCAVATION. PIPE MAY BE EITHER CONCRETE, CORRUGATED STEEL, CORRUGATED ALUMINUM ALLOY, OR CORRUGATED PLASTIC. PERFORATED PIPE WILL NOT BE ALLOWED.

BAGGED STONE SHALL REMAIN IN PLACE UNTIL THE ENGINEER DIRECTS THAT IT BE REMOVED. THE CONTRACTOR SHALL REMOVE AND DISPOSE OF SILT ACCUMULATIONS AT BAGGED STONE WHEN SO DIRECTED BY THE ENGINEER. BAGS SHALL BE REMOVED AND REPLACED WHENEVER THE ENGINEER DETERMINES THAT THEY HAVE DETERIORATED AND LOST THEIR EFFECTIVENESS.

NO SEPARATE PAYMENT WILL BE MADE FOR THIS WORK AND THE ENTIRE COST OF THIS WORK SHALL BE INCLUDED IN THE UNIT CONTRACT PRICE BID FOR THE SEVERAL PAY ITEMS.


### TEMPORARY DRAINAGE AT END BENT

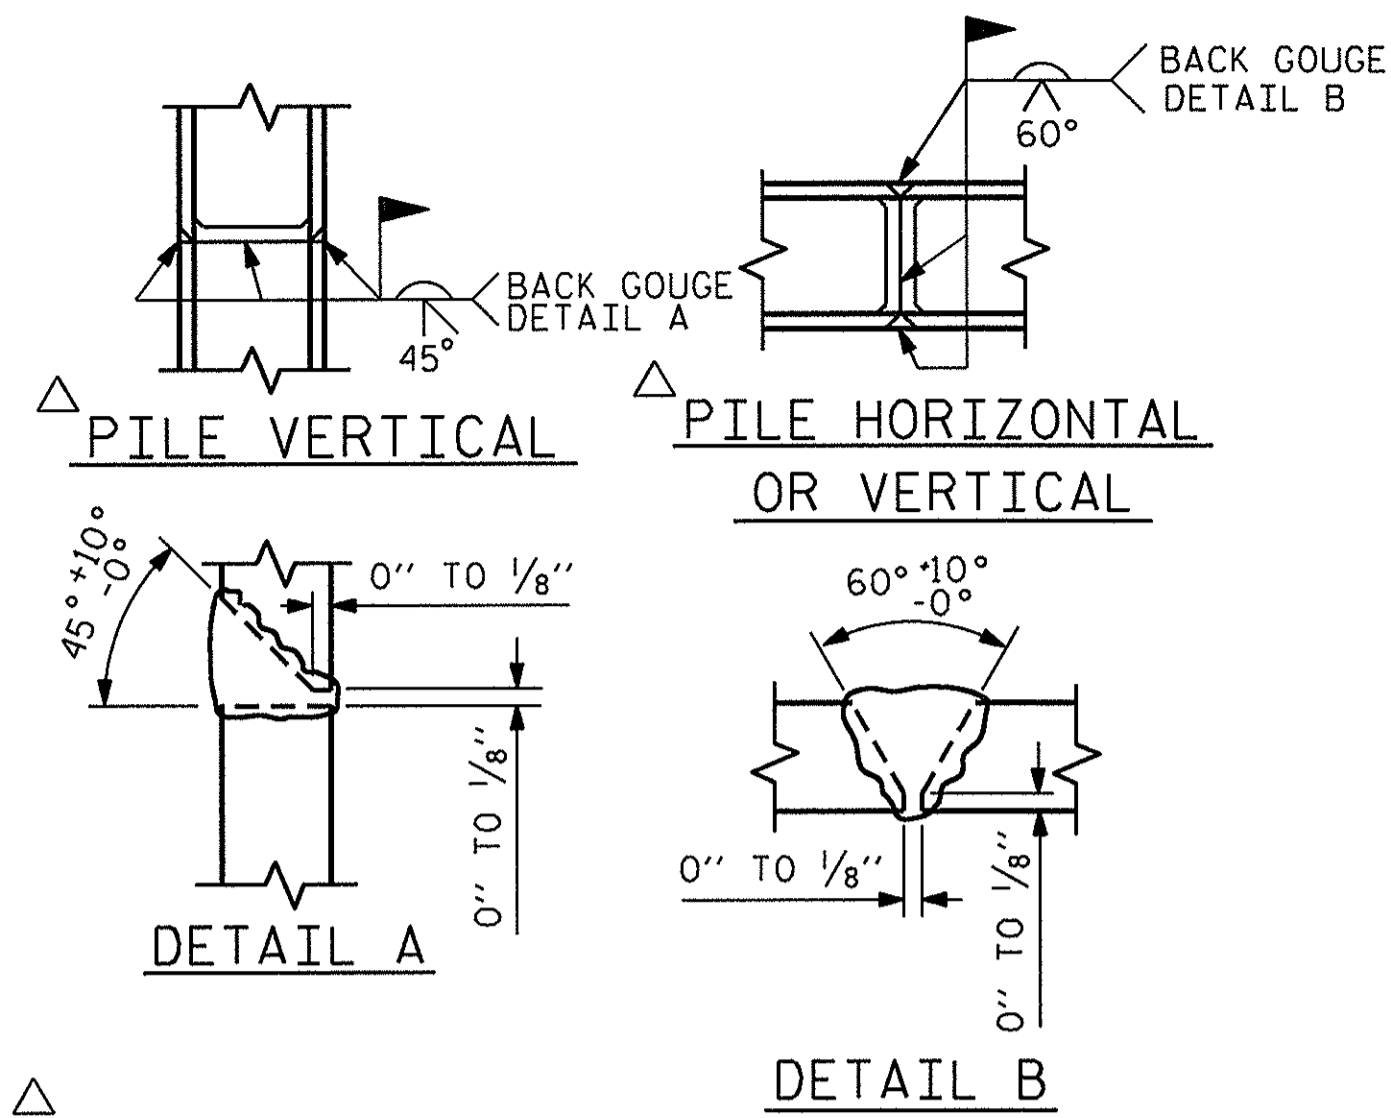

### PILE SPLICE DETAILS


| BILL OF MATERIAL FOR ONE END BENT             |                                    |      |      |        |           |
|---|------------------------------------|------|------|--------|-----------|
| BAR   | NO.                                | SIZE | TYPE | LENGTH | WEIGHT    |
| B1  | 8                                  | #9   | 1    | 41'-0" | 1115      |
| B2  | 16                                 | #4   | STR  | 20'-7" | 220       |
| B3  | 10                                 | #4   | STR  | 2'-5"  | 16        |
| D1  | 22                                 | #6   | STR  | 1'-6"  | 50        |
| H1  | 24                                 | #4   | 2    | 7'-10" | 126       |
| K1  | 12                                 | #4   | STR  | 2'-11" | 23        |
| S1  | 50                                 | #4   | 3    | 7'-5"  | 248       |
| S2  | 50                                 | #4   | 4    | 3'-2"  | 106       |
| S3  | 14                                 | #4   | 5    | 6'-6"  | 61        |
| S4  | 4                                  | #4   | 6    | 4'-5"  | 12        |
| V1  | 48                                 | #4   | STR  | 4'-8"  | 150       |
| REINFORCING STEEL (FOR ONE END BENT)          |                                    |      |      |        | 2127 LBS. |
| CLASS A CONCRETE BREAKDOWN (FOR ONE END BENT) |                                    |      |      |        |           |
| POUR #1                                       | CAP, LOWER PART OF WINGS & COLLARS |      |      | 12.4   | C.Y.      |
| POUR #2                                       | UPPER PART OF WINGS                |      |      | 1.8    | C.Y.      |
| POUR #3                                       | LATERAL GUIDES                     |      |      | 0.1    | C.Y.      |
| TOTAL CLASS A CONCRETE                        |                                    |      |      | 14.3   | C.Y.      |

| BAR TYPES  |  |
|--|--|
| <p>①</p>   | <p>④</p>   |
| <p>②</p>   | <p>⑤</p>   |
| <p>③</p>   | <p>⑥</p>   |
| ALL BAR DIMENSIONS ARE OUT TO OUT.   |  |
| END BENT No. 1<br>HP 12 X 53 STEEL PILES<br>NO: 7 455 LIN. FT.<br>PILE REDRIVES 3 EACH | END BENT No. 2<br>HP 12 X 53 STEEL PILES<br>NO: 7 420 LIN. FT.<br>PILE REDRIVES 3 EACH |

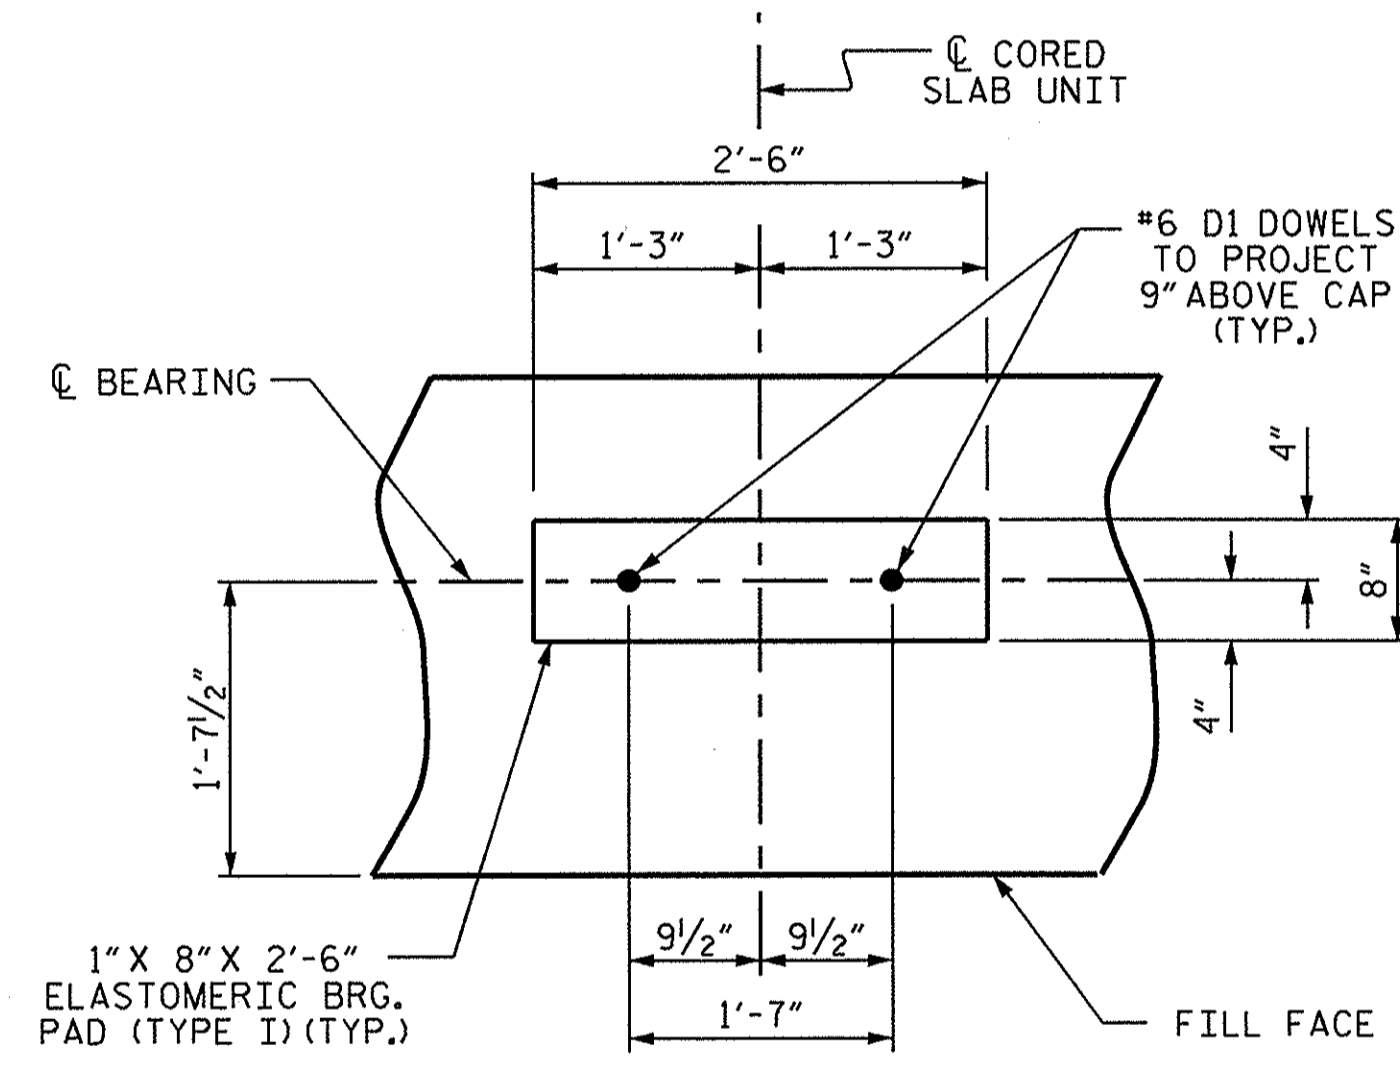


### DETAIL "A"

(END BENT No. 1 SHOWN, END BENT No. 2 SIMILAR BY ROTATION)

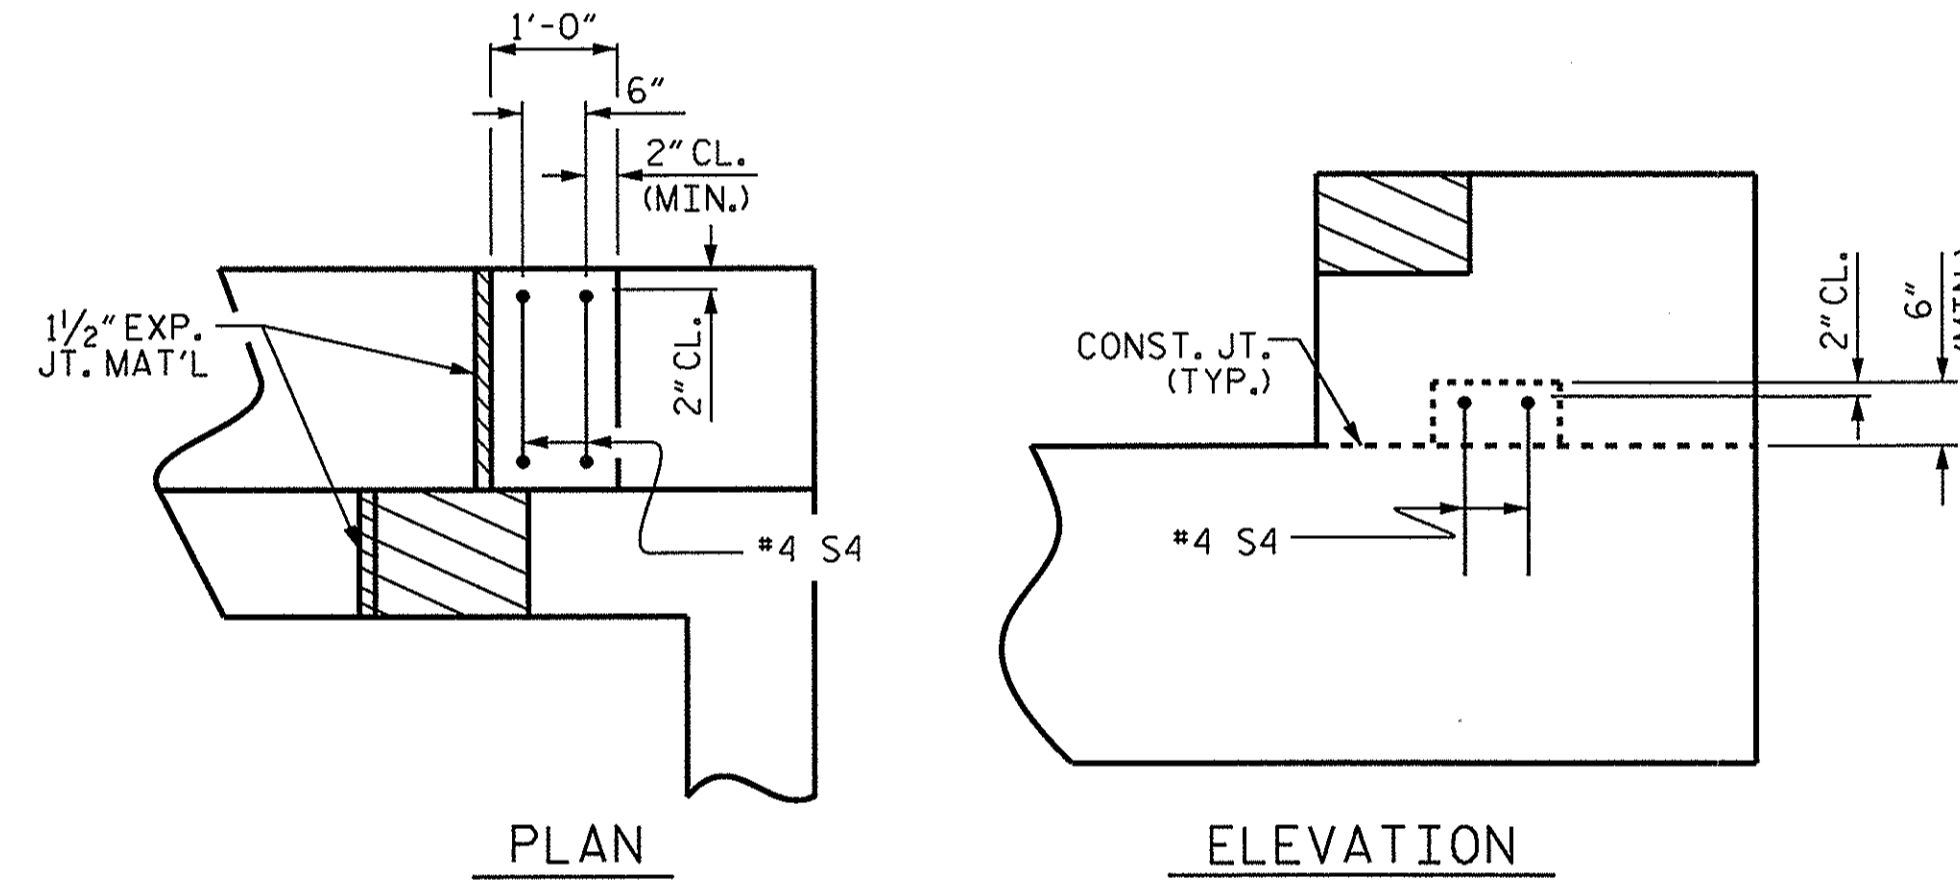



### LATERAL GUIDE DETAILS

(RIGHT LATERAL GUIDE SHOWN, LEFT END SIMILAR)

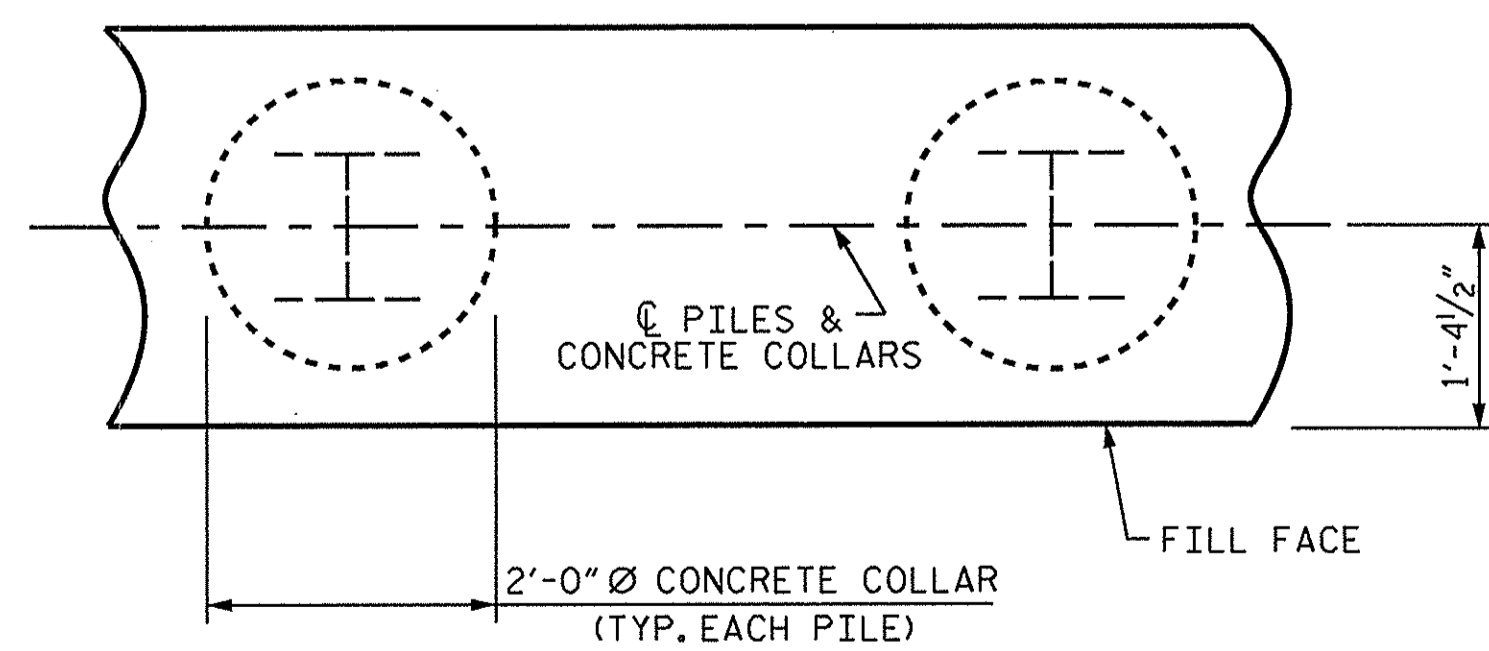

### CORROSION PROTECTION FOR STEEL PILES DETAIL

(END BENT No. 1 SHOWN, END BENT No. 2 SIMILAR BY ROTATION)

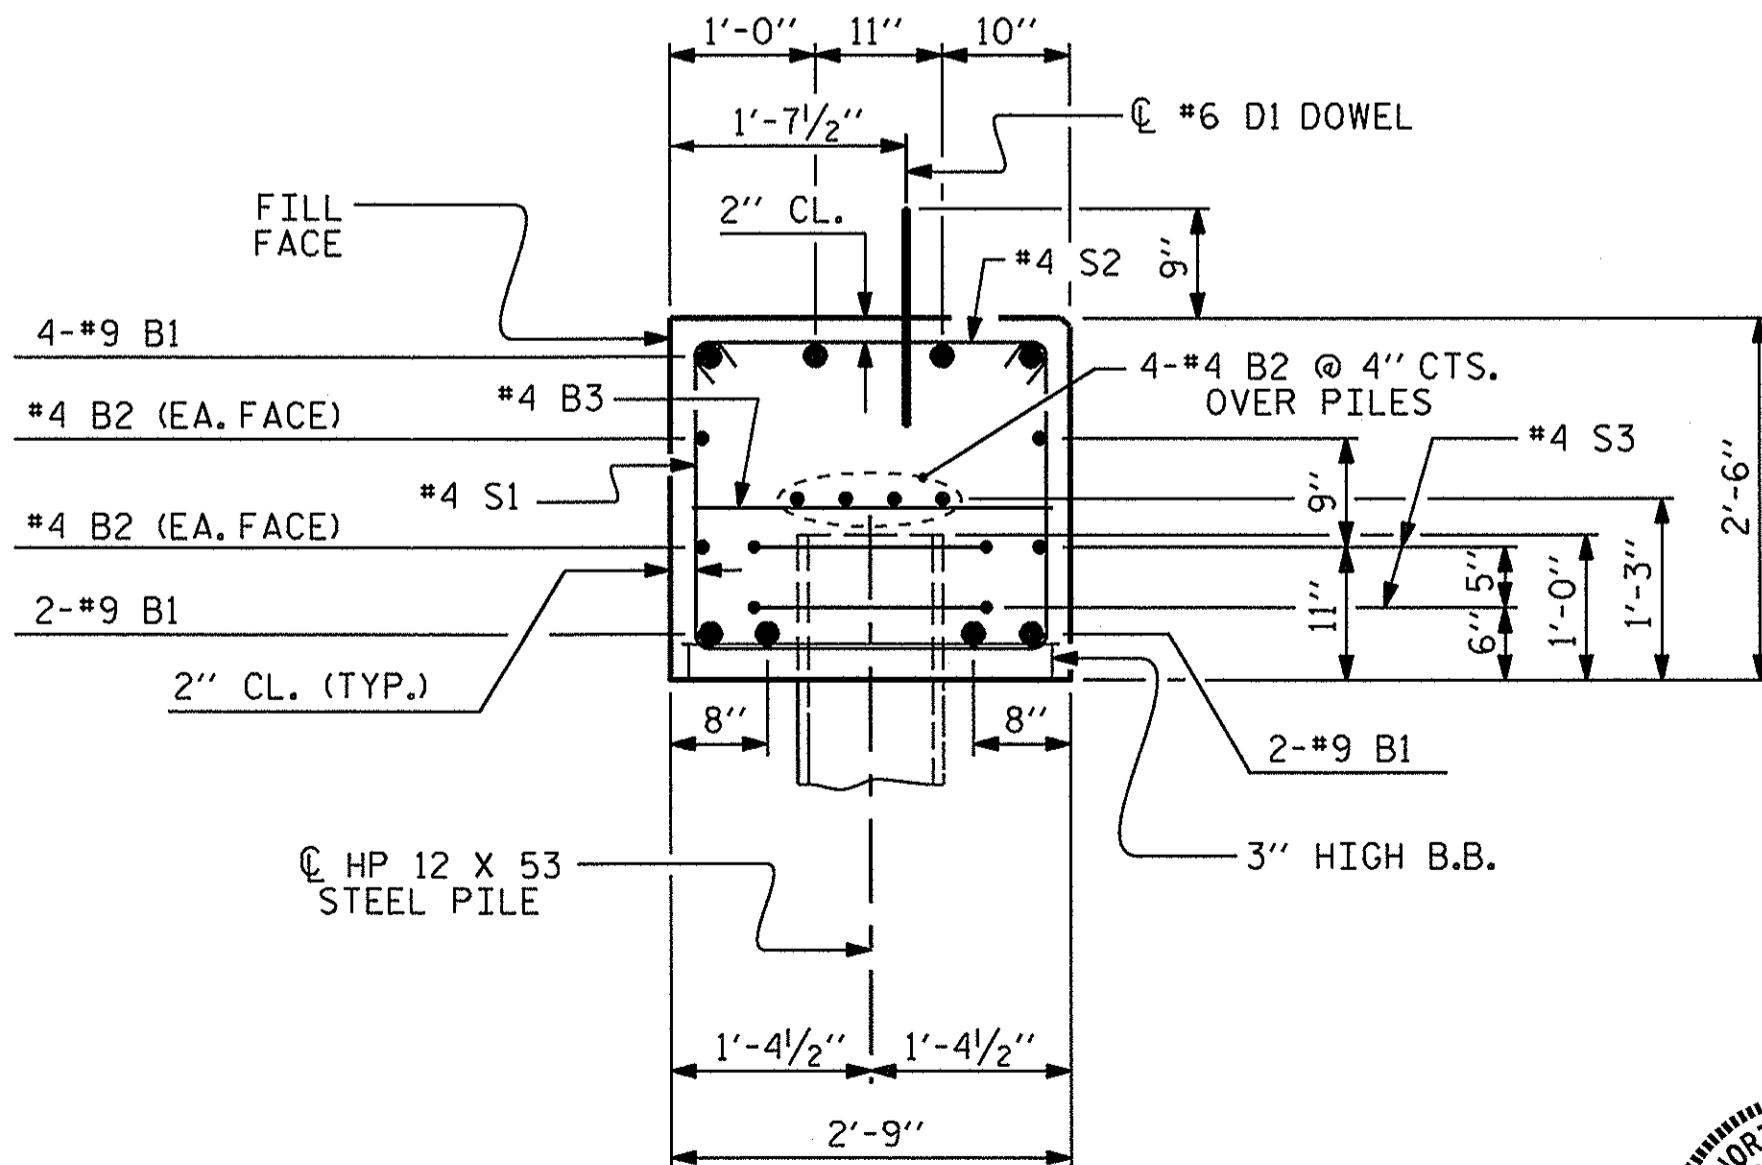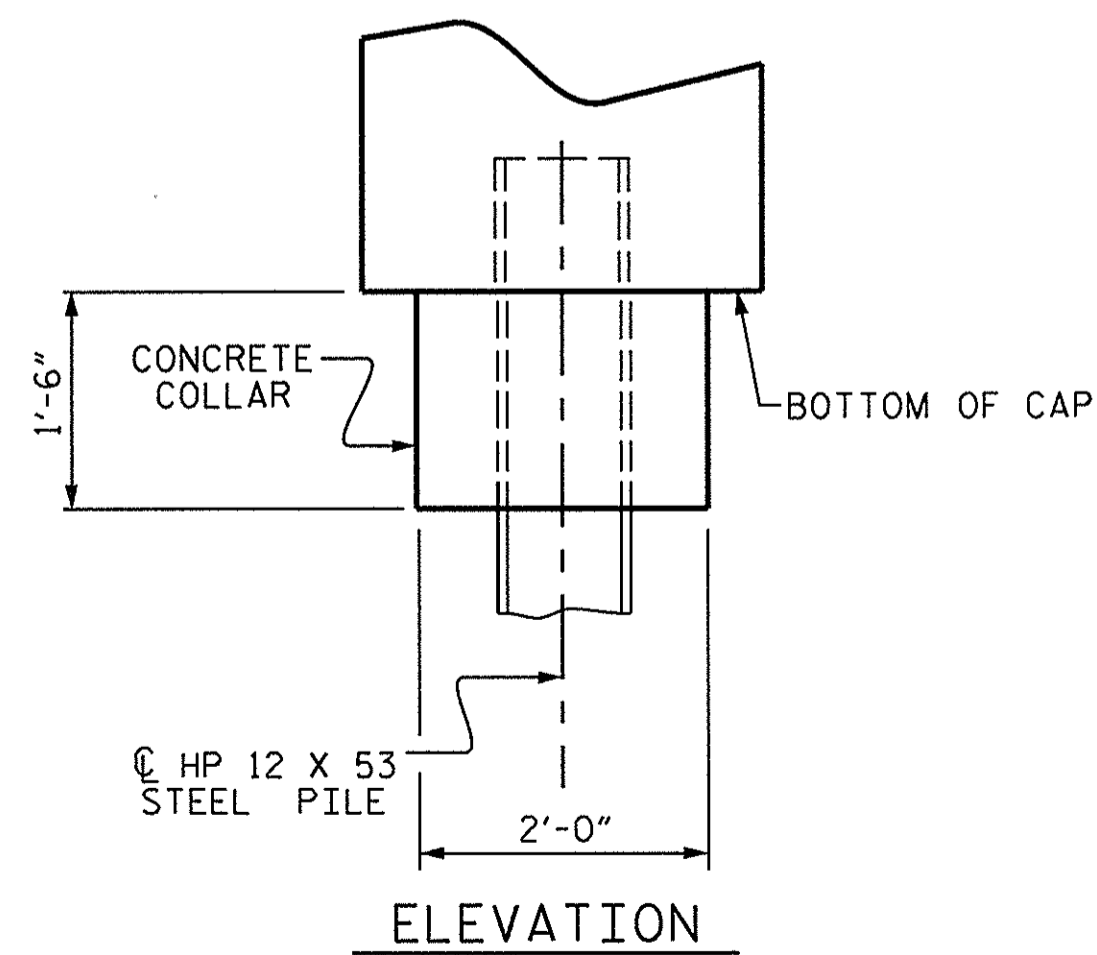

### SECTION A-A

(CONCRETE COLLAR NOT SHOWN FOR CLARITY. SEE "CORROSION PROTECTION FOR STEEL PILES DETAIL.")

PROJECT NO. BD-5102U  
PITT COUNTY  
 STATION: 17+20.50 -L-

SHEET 4 OF 4

STATE OF NORTH CAROLINA  
 DEPARTMENT OF TRANSPORTATION  
 RALEIGH

SUBSTRUCTURE

END BENT No. 1 & 2  
 DETAILS

### REVISIONS

| NO. | BY: | DATE: | NO. | BY: | DATE: |
|-----|-----|-------|-----|-----|-------|
| 1   |     |       | 3   |     |       |
| 2   |     |       | 4   |     |       |

SHEET NO. S-13

TOTAL SHEETS 17

ASSEMBLED BY: A. H. SHIVELY DATE: 6/14/13  
 CHECKED BY: M. L. RORIE DATE: 6/18/13

DRAWN BY: DGE 02/10  
 CHECKED BY: MKT 02/10

**NOTES**




STIRRUPS IN CAP MAY BE SHIFTED AS NECESSARY TO CLEAR DOWELS.

THE LATERAL GUIDES ARE NOT TO BE POURED UNTIL AFTER THE CORED SLAB UNITS ARE IN PLACE.

★ INVERT ALTERNATE STIRRUPS.

GALVANIZE THE TOP OF EACH INTERIOR BENT PILE A MINIMUM OF 25 FEET. GALVANIZE IN ACCORDANCE WITH SECTION 1076 OF THE STANDARD SPECIFICATIONS.

THE CONTRACTOR HAS THE OPTION TO OMIT THE LATERAL GUIDE IF APPROVED BY THE ENGINEER.

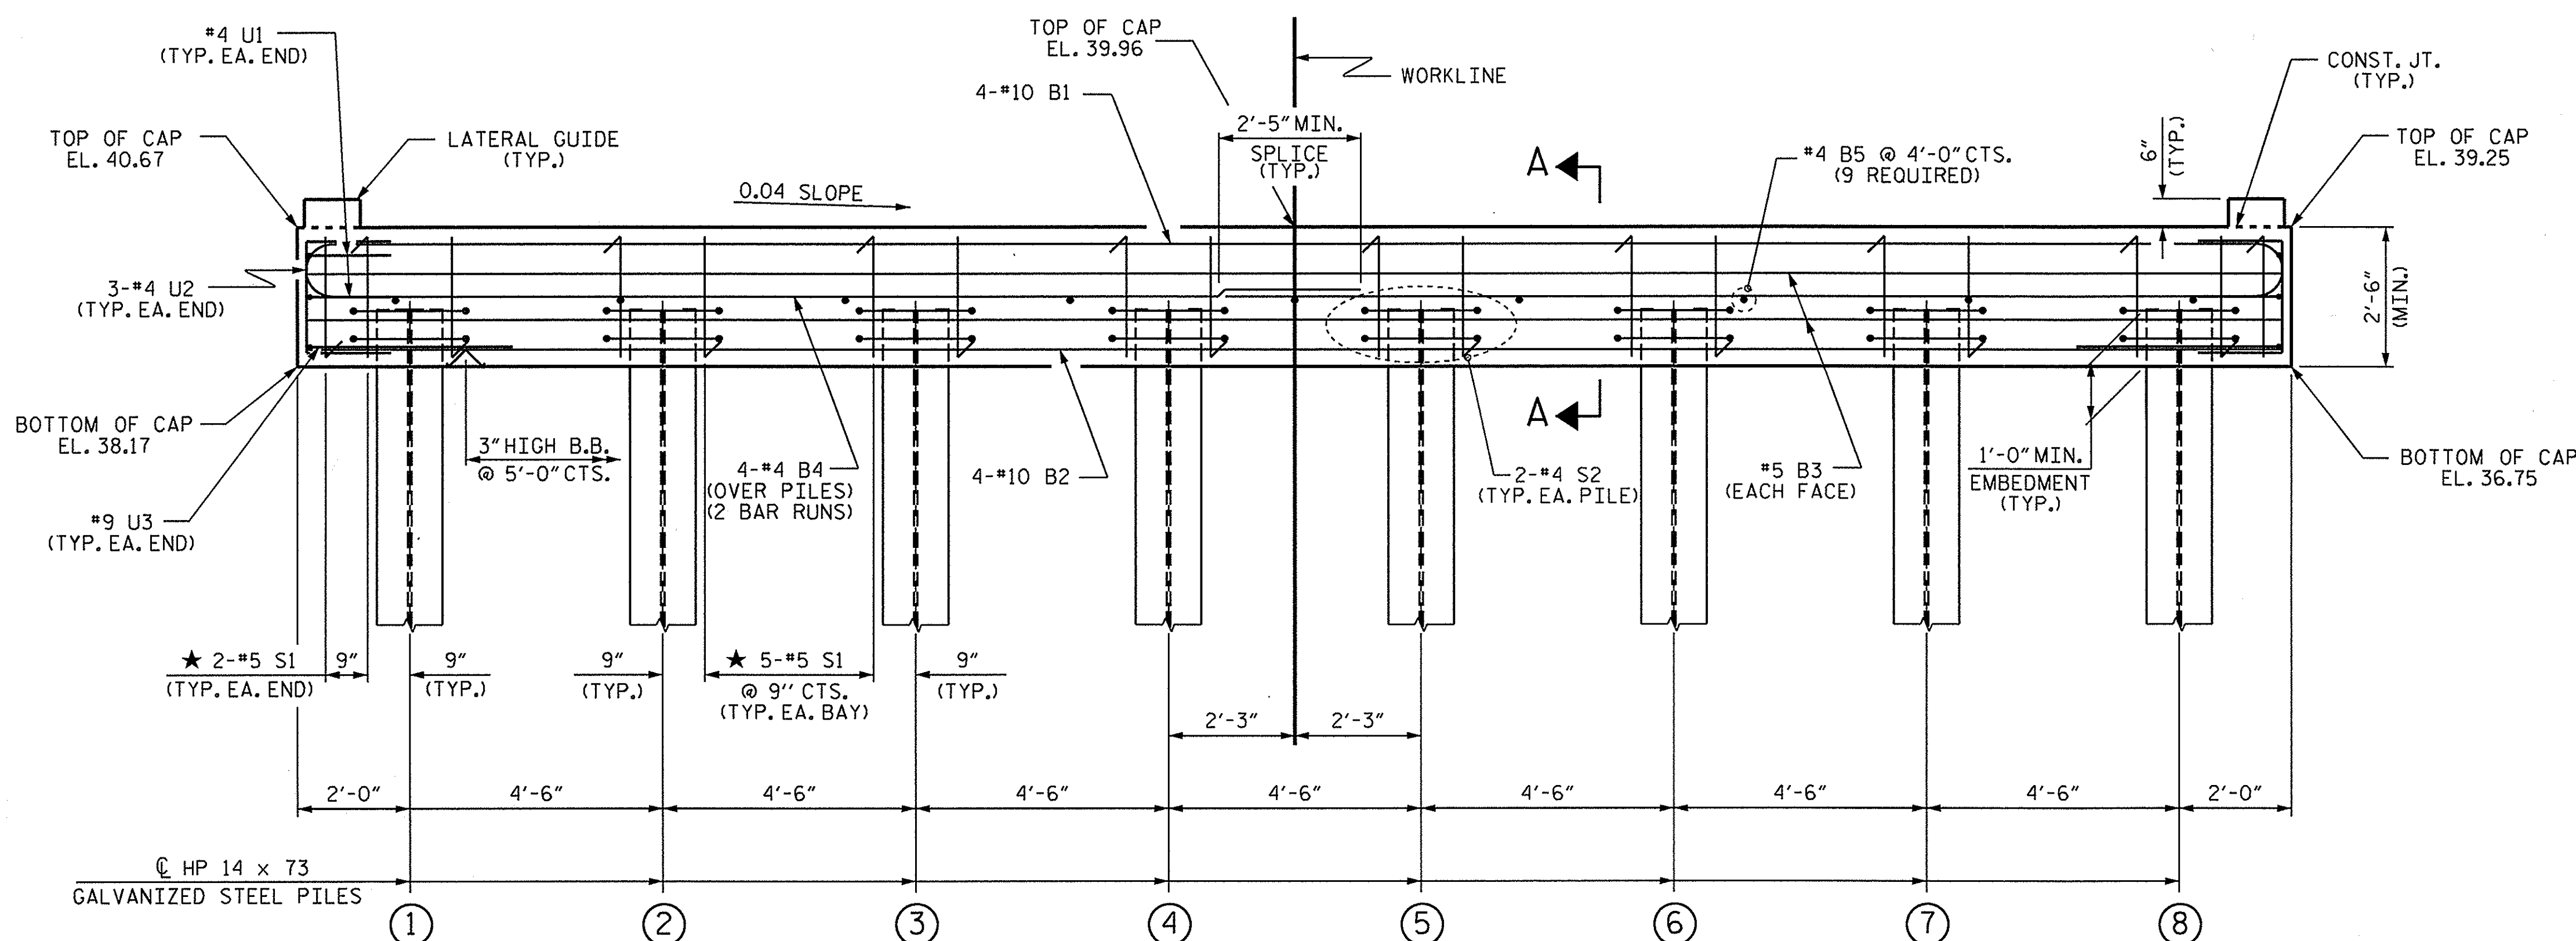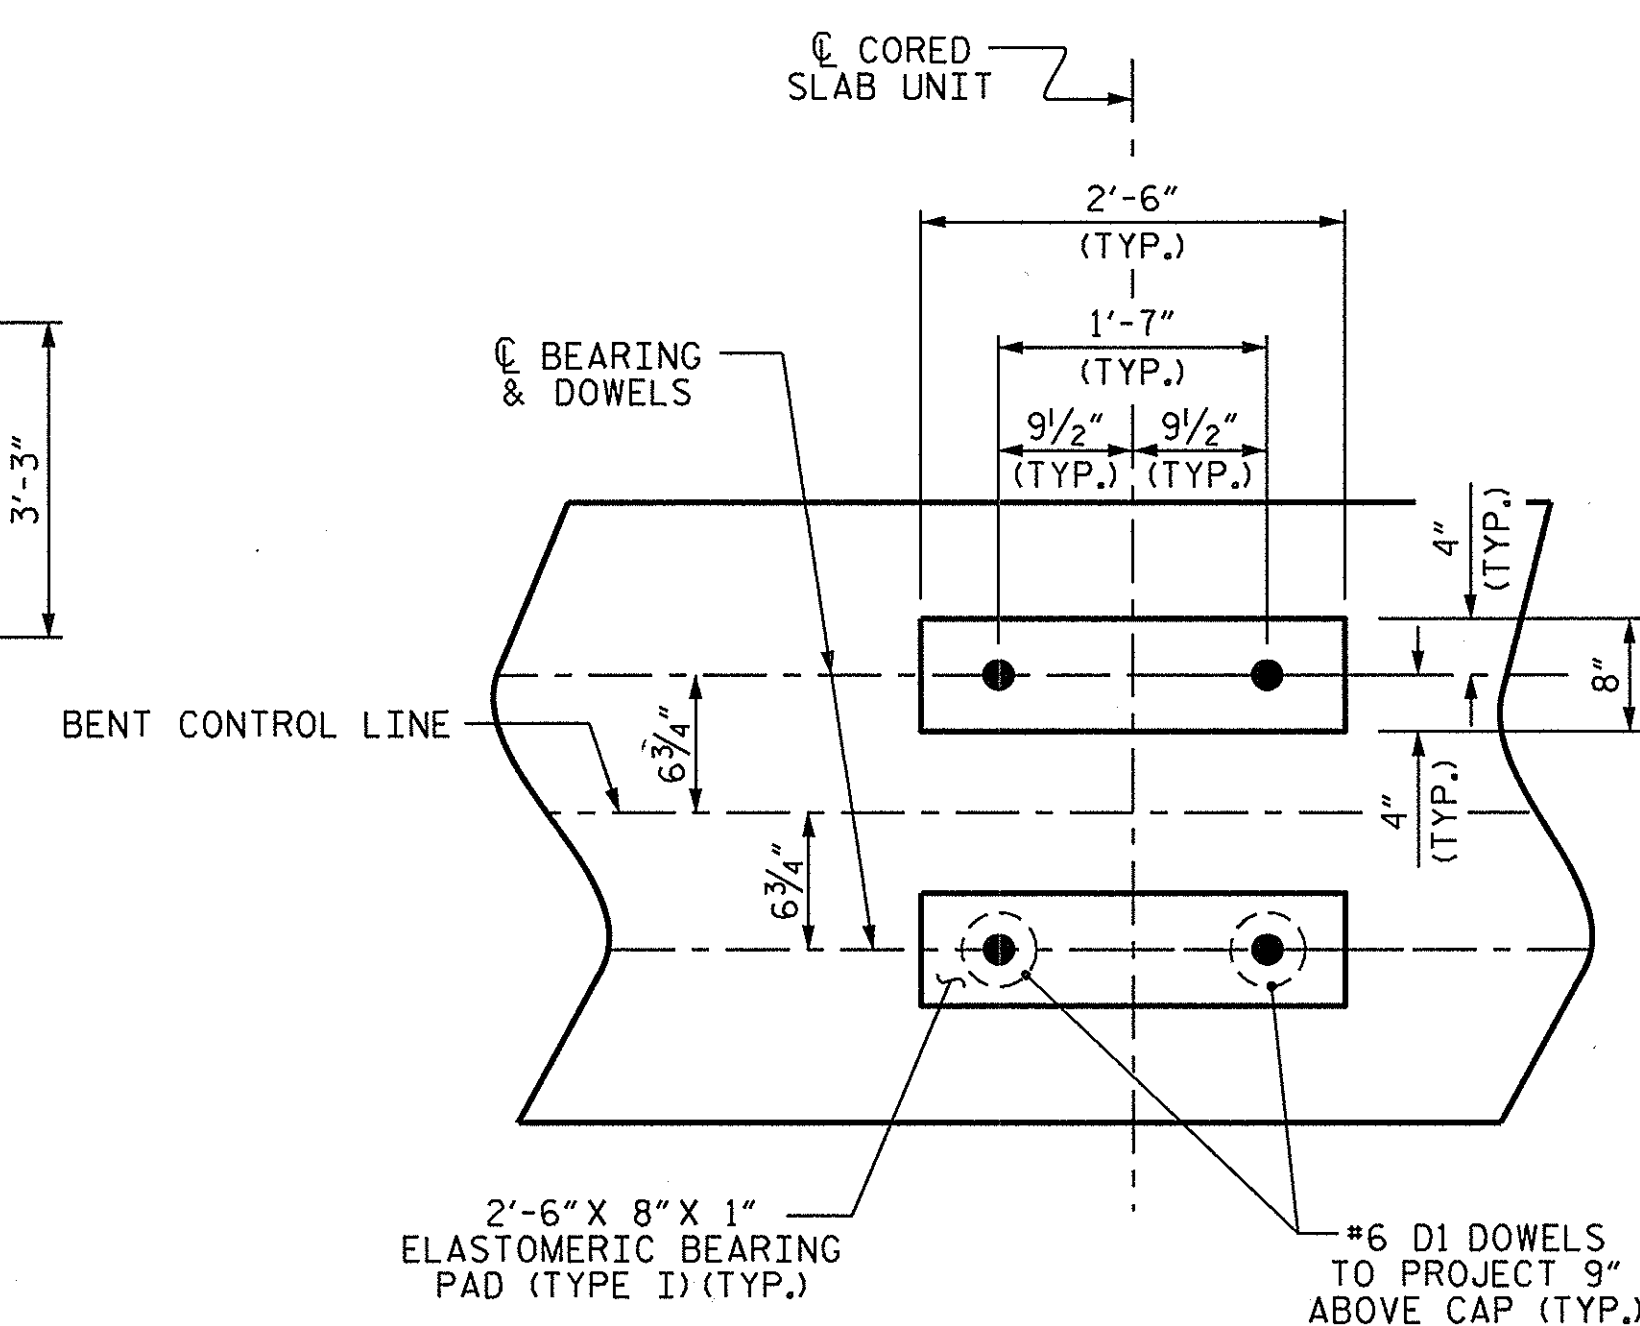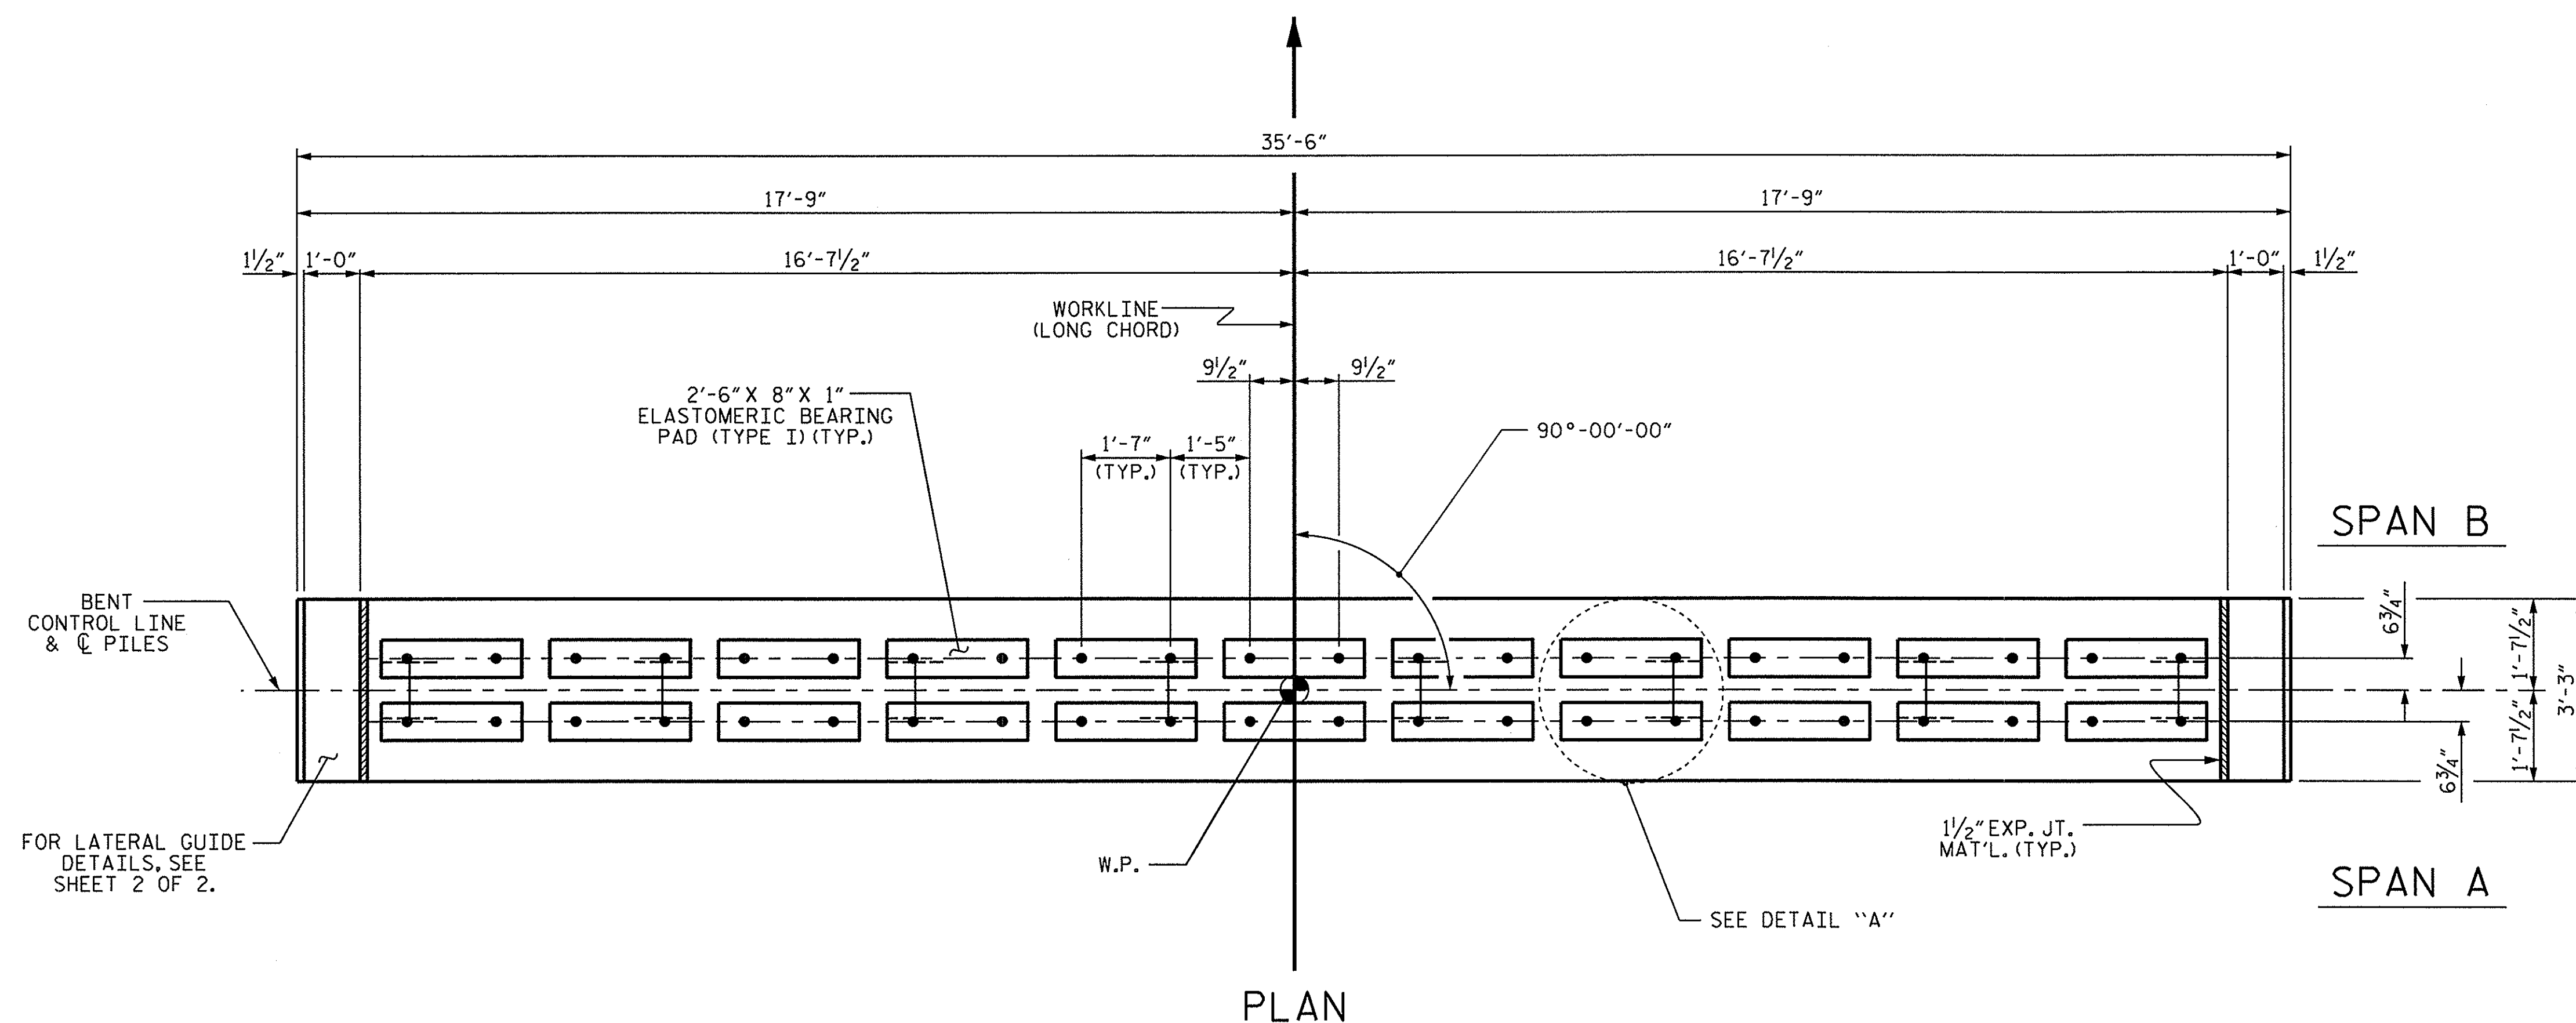

**TOP OF PILE ELEVATIONS**

|   |       |   |       |
|---|-------|---|-------|
| ① | 39.11 | ⑤ | 38.39 |
| ② | 38.93 | ⑥ | 38.21 |
| ③ | 38.75 | ⑦ | 38.03 |
| ④ | 38.57 | ⑧ | 37.85 |


**DETAIL "A"**  
(DIMENSIONS ARE TYPICAL EACH BEARING)

PROJECT NO. BD-5102U  
PITT COUNTY  
 STATION: 17+20.50 -L-

SHEET 1 OF 2


STATE OF NORTH CAROLINA  
 DEPARTMENT OF TRANSPORTATION  
 RALEIGH

SUBSTRUCTURE  
 BENT No. 1

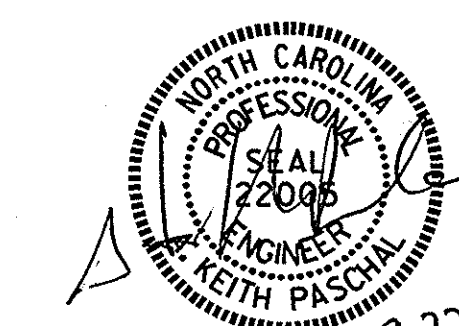


| REVISIONS |     |       |     |     |       | SHEET NO.<br>S-14  |
|-----------|-----|-------|-----|-----|-------|--------------------|
| NO.       | BY: | DATE: | NO. | BY: | DATE: |                    |
| 1         |     |       | 3   |     |       | TOTAL SHEETS<br>17 |
| 2         |     |       | 4   |     |       |                    |

ASSEMBLED BY : M. D. PISO DATE : 09-26-13  
 CHECKED BY : A. K. PASCHAL DATE : 09-26-13  
 DRAWN BY : DGE 05/10  
 CHECKED BY : MKT 05/10

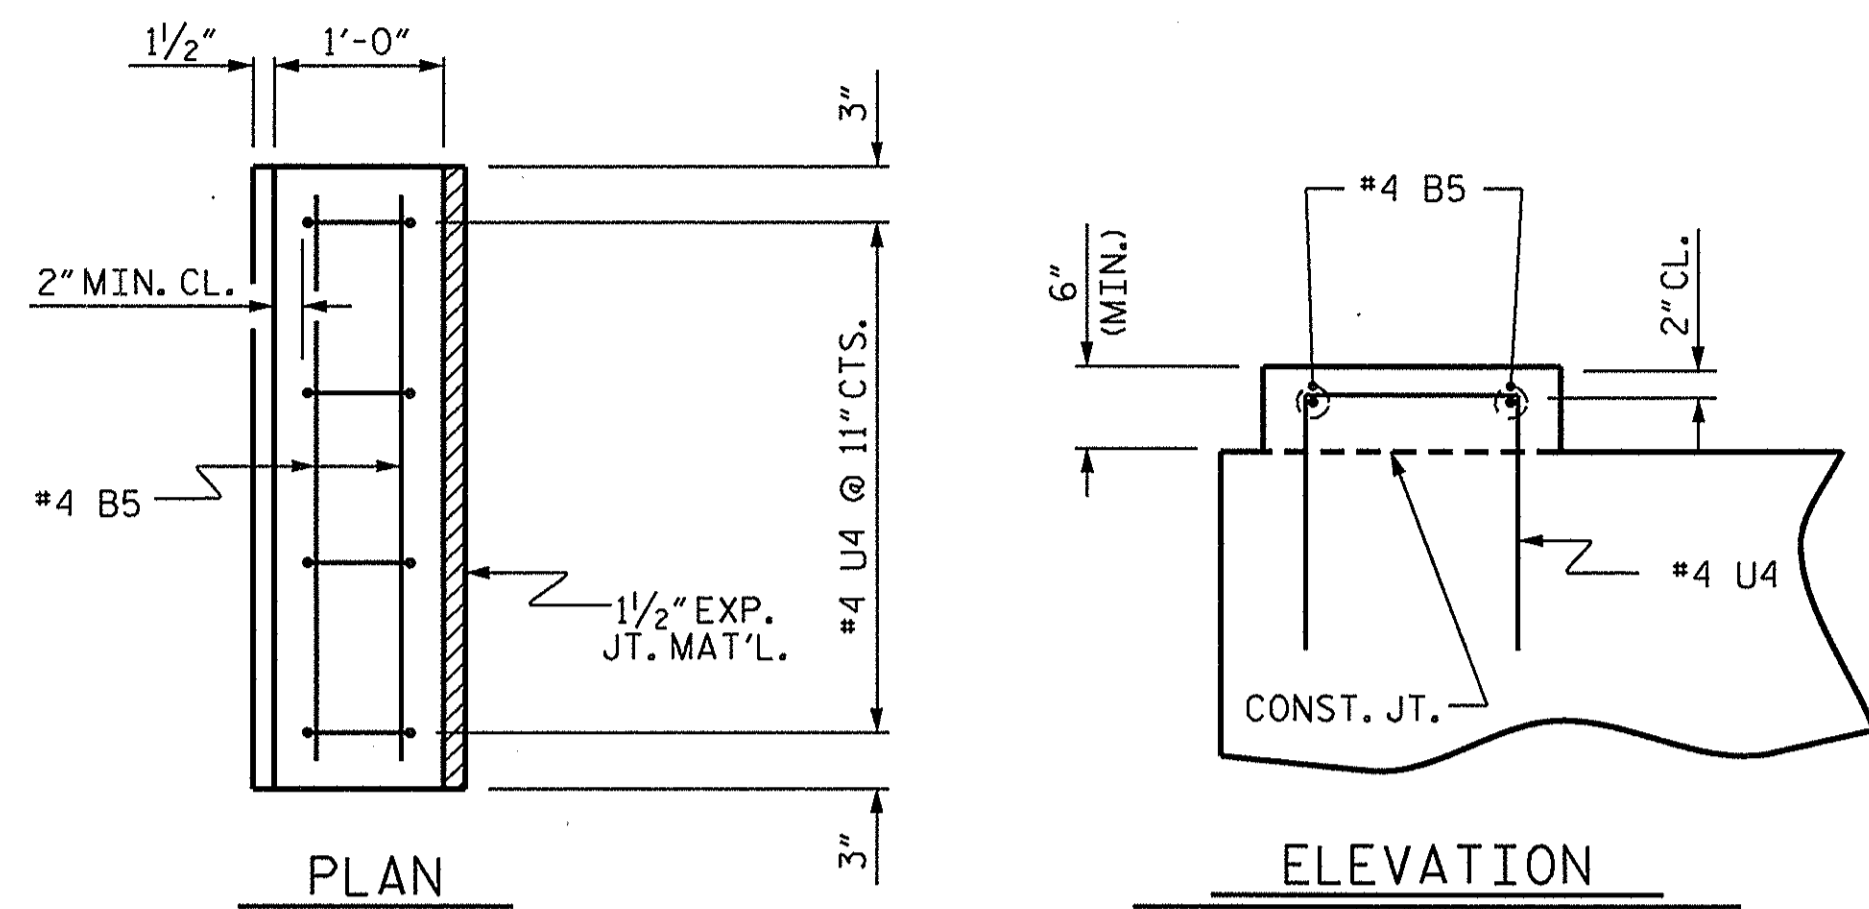


**LATERAL GUIDE DETAILS**

(LEFT LATERAL GUIDE SHOWN, RIGHT SIDE SIMILAR)

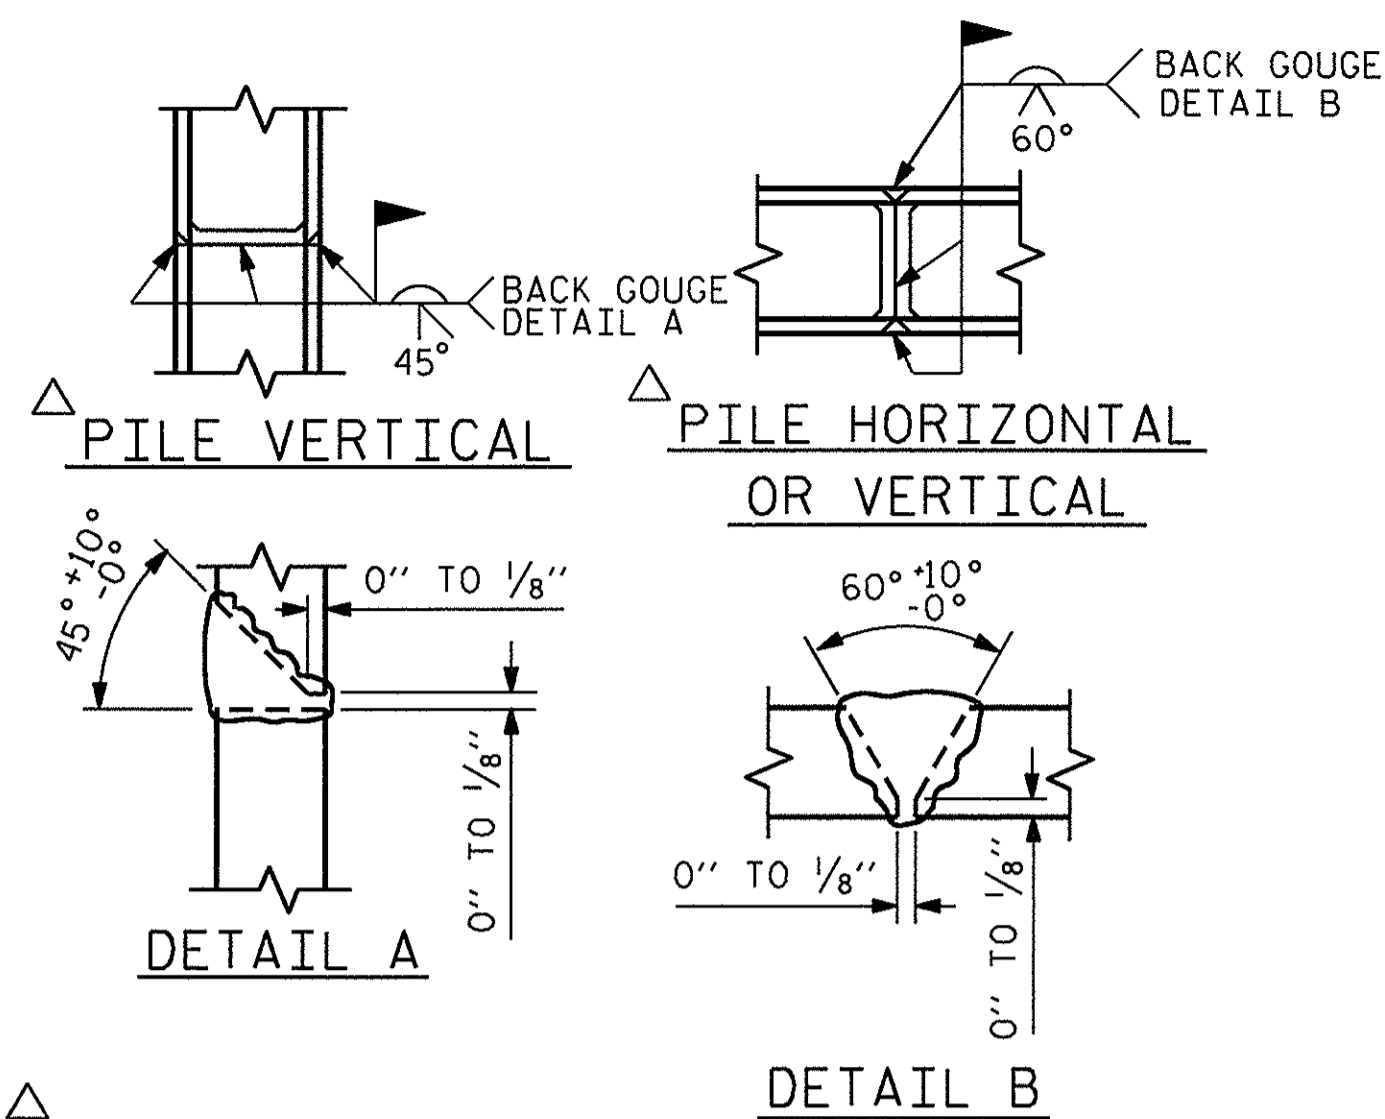


**PILE SPLICE DETAILS**

POSITION OF PILE DURING WELDING.

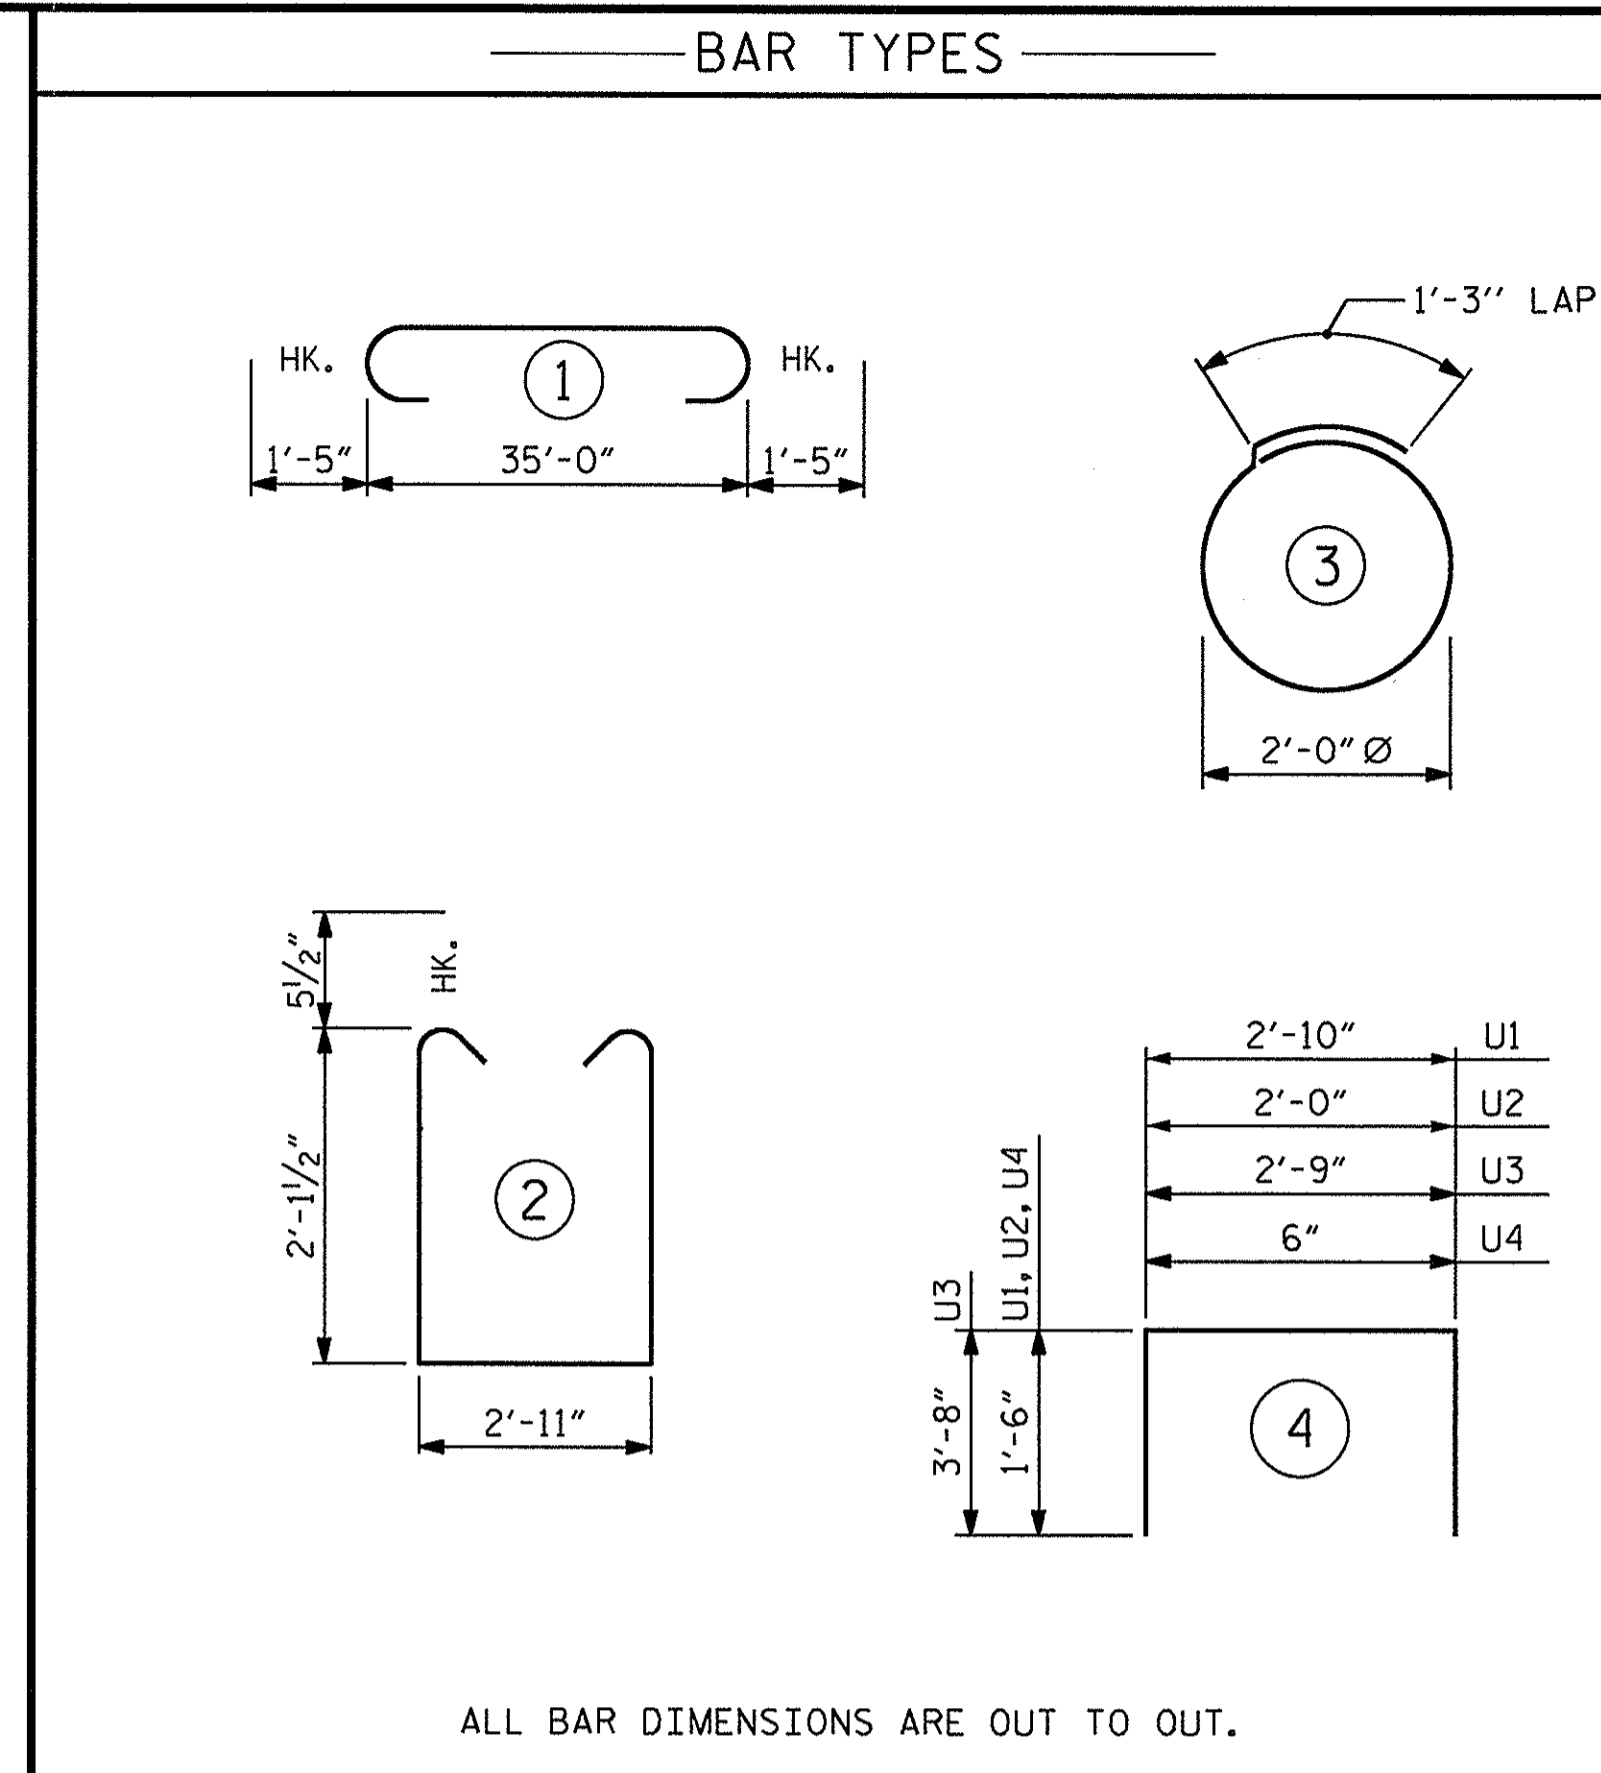


ALL BAR DIMENSIONS ARE OUT TO OUT.

| BILL OF MATERIAL FOR ONE BENT                    |     |      |      |         |            |
|--|-----|------|------|---------|------------|
| BAR  | NO. | SIZE | TYPE | LENGTH  | WEIGHT     |
| B1   | 4   | #10  | 1    | 37'-10" | 651        |
| B2   | 4   | #10  | STR  | 35'-2"  | 605        |
| B3   | 4   | #5   | STR  | 35'-2"  | 147        |
| B4   | 8   | #4   | STR  | 18'-10" | 101        |
| B5   | 13  | #4   | STR  | 2'-11"  | 25         |
| D1   | 44  | #6   | STR  | 1'-6"   | 99         |
| S1   | 39  | #5   | 2    | 8'-1"   | 329        |
| S2   | 16  | #4   | 3    | 7'-7"   | 81         |
| U1   | 4   | #4   | 4    | 5'-10"  | 16         |
| U2   | 6   | #4   | 4    | 5'-0"   | 20         |
| U3   | 2   | #9   | 4    | 10'-1"  | 69         |
| U4   | 8   | #4   | 4    | 3'-6"   | 19         |
| REINFORCING STEEL (FOR ONE BENT)                 |     |      |      |         | 2162 LBS   |
| CLASS A CONCRETE BREAKDOWN (FOR ONE BENT)        |     |      |      |         |            |
| POUR #1 (CAP)                                    |     |      |      |         | 10.7 C.Y.  |
| POUR #2 (LATERAL GUIDES)                         |     |      |      |         | 0.1 C.Y.   |
| TOTAL CLASS A CONCRETE                           |     |      |      |         | 10.8 C.Y.  |
| HP 14 X 73 GALVANIZED STEEL PILES (FOR ONE BENT) |     |      |      |         |            |
| No. 8  |     |      |      |         | 520 LIN.FT |
| PILE REDRIVES                                    |     |      |      |         | 4 EA.      |
| STEEL PILE POINTS                                |     |      |      |         | 8 EA.      |

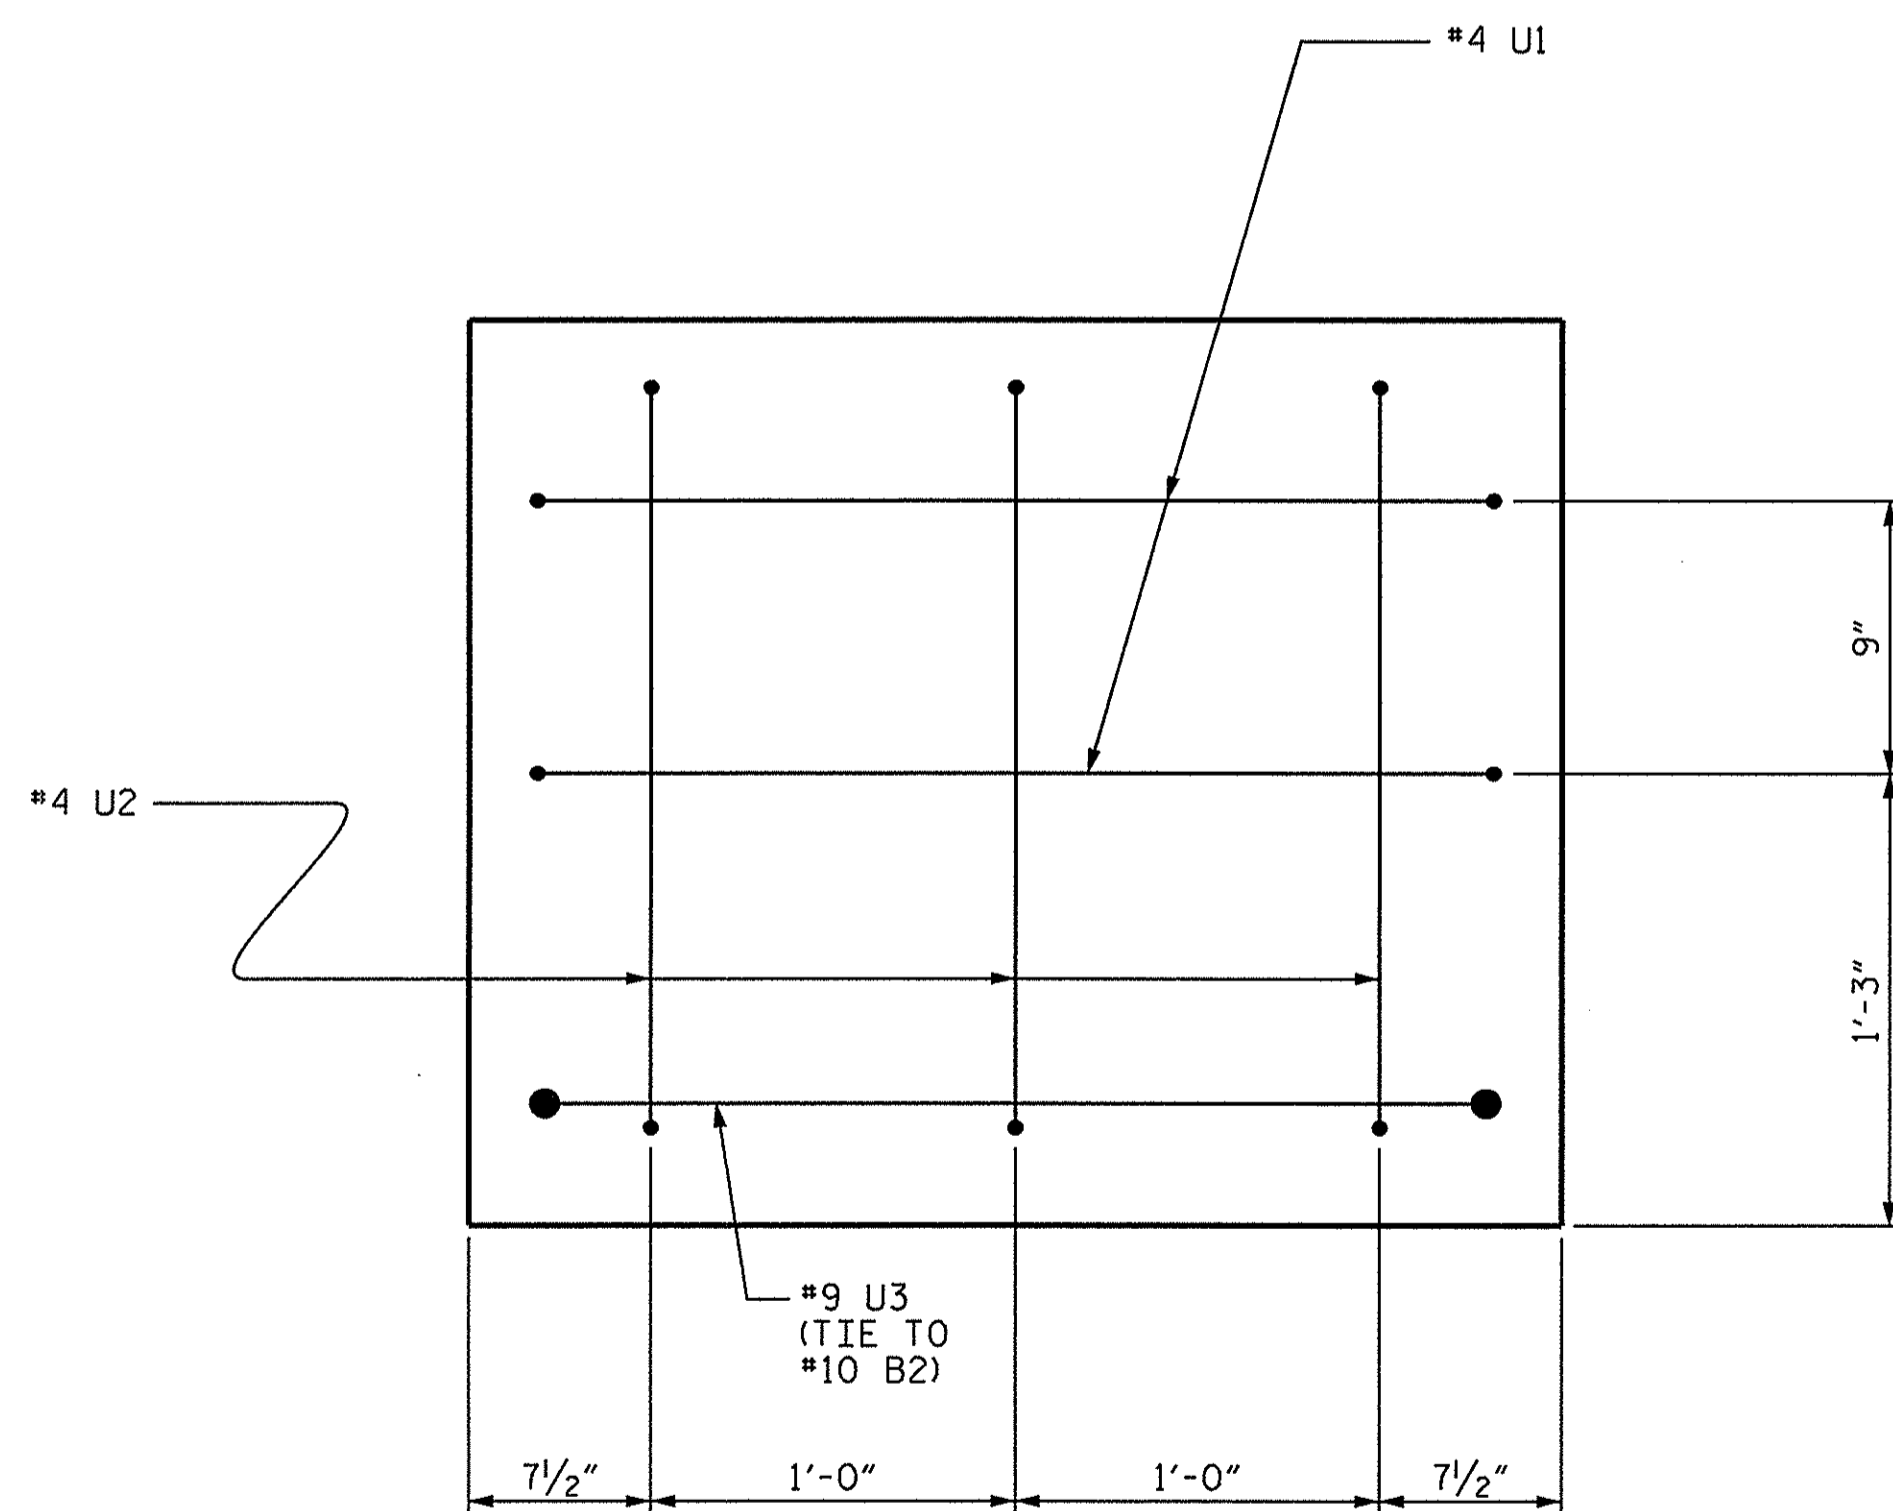


**END OF CAP VIEW**

(TYPICAL BOTH ENDS)

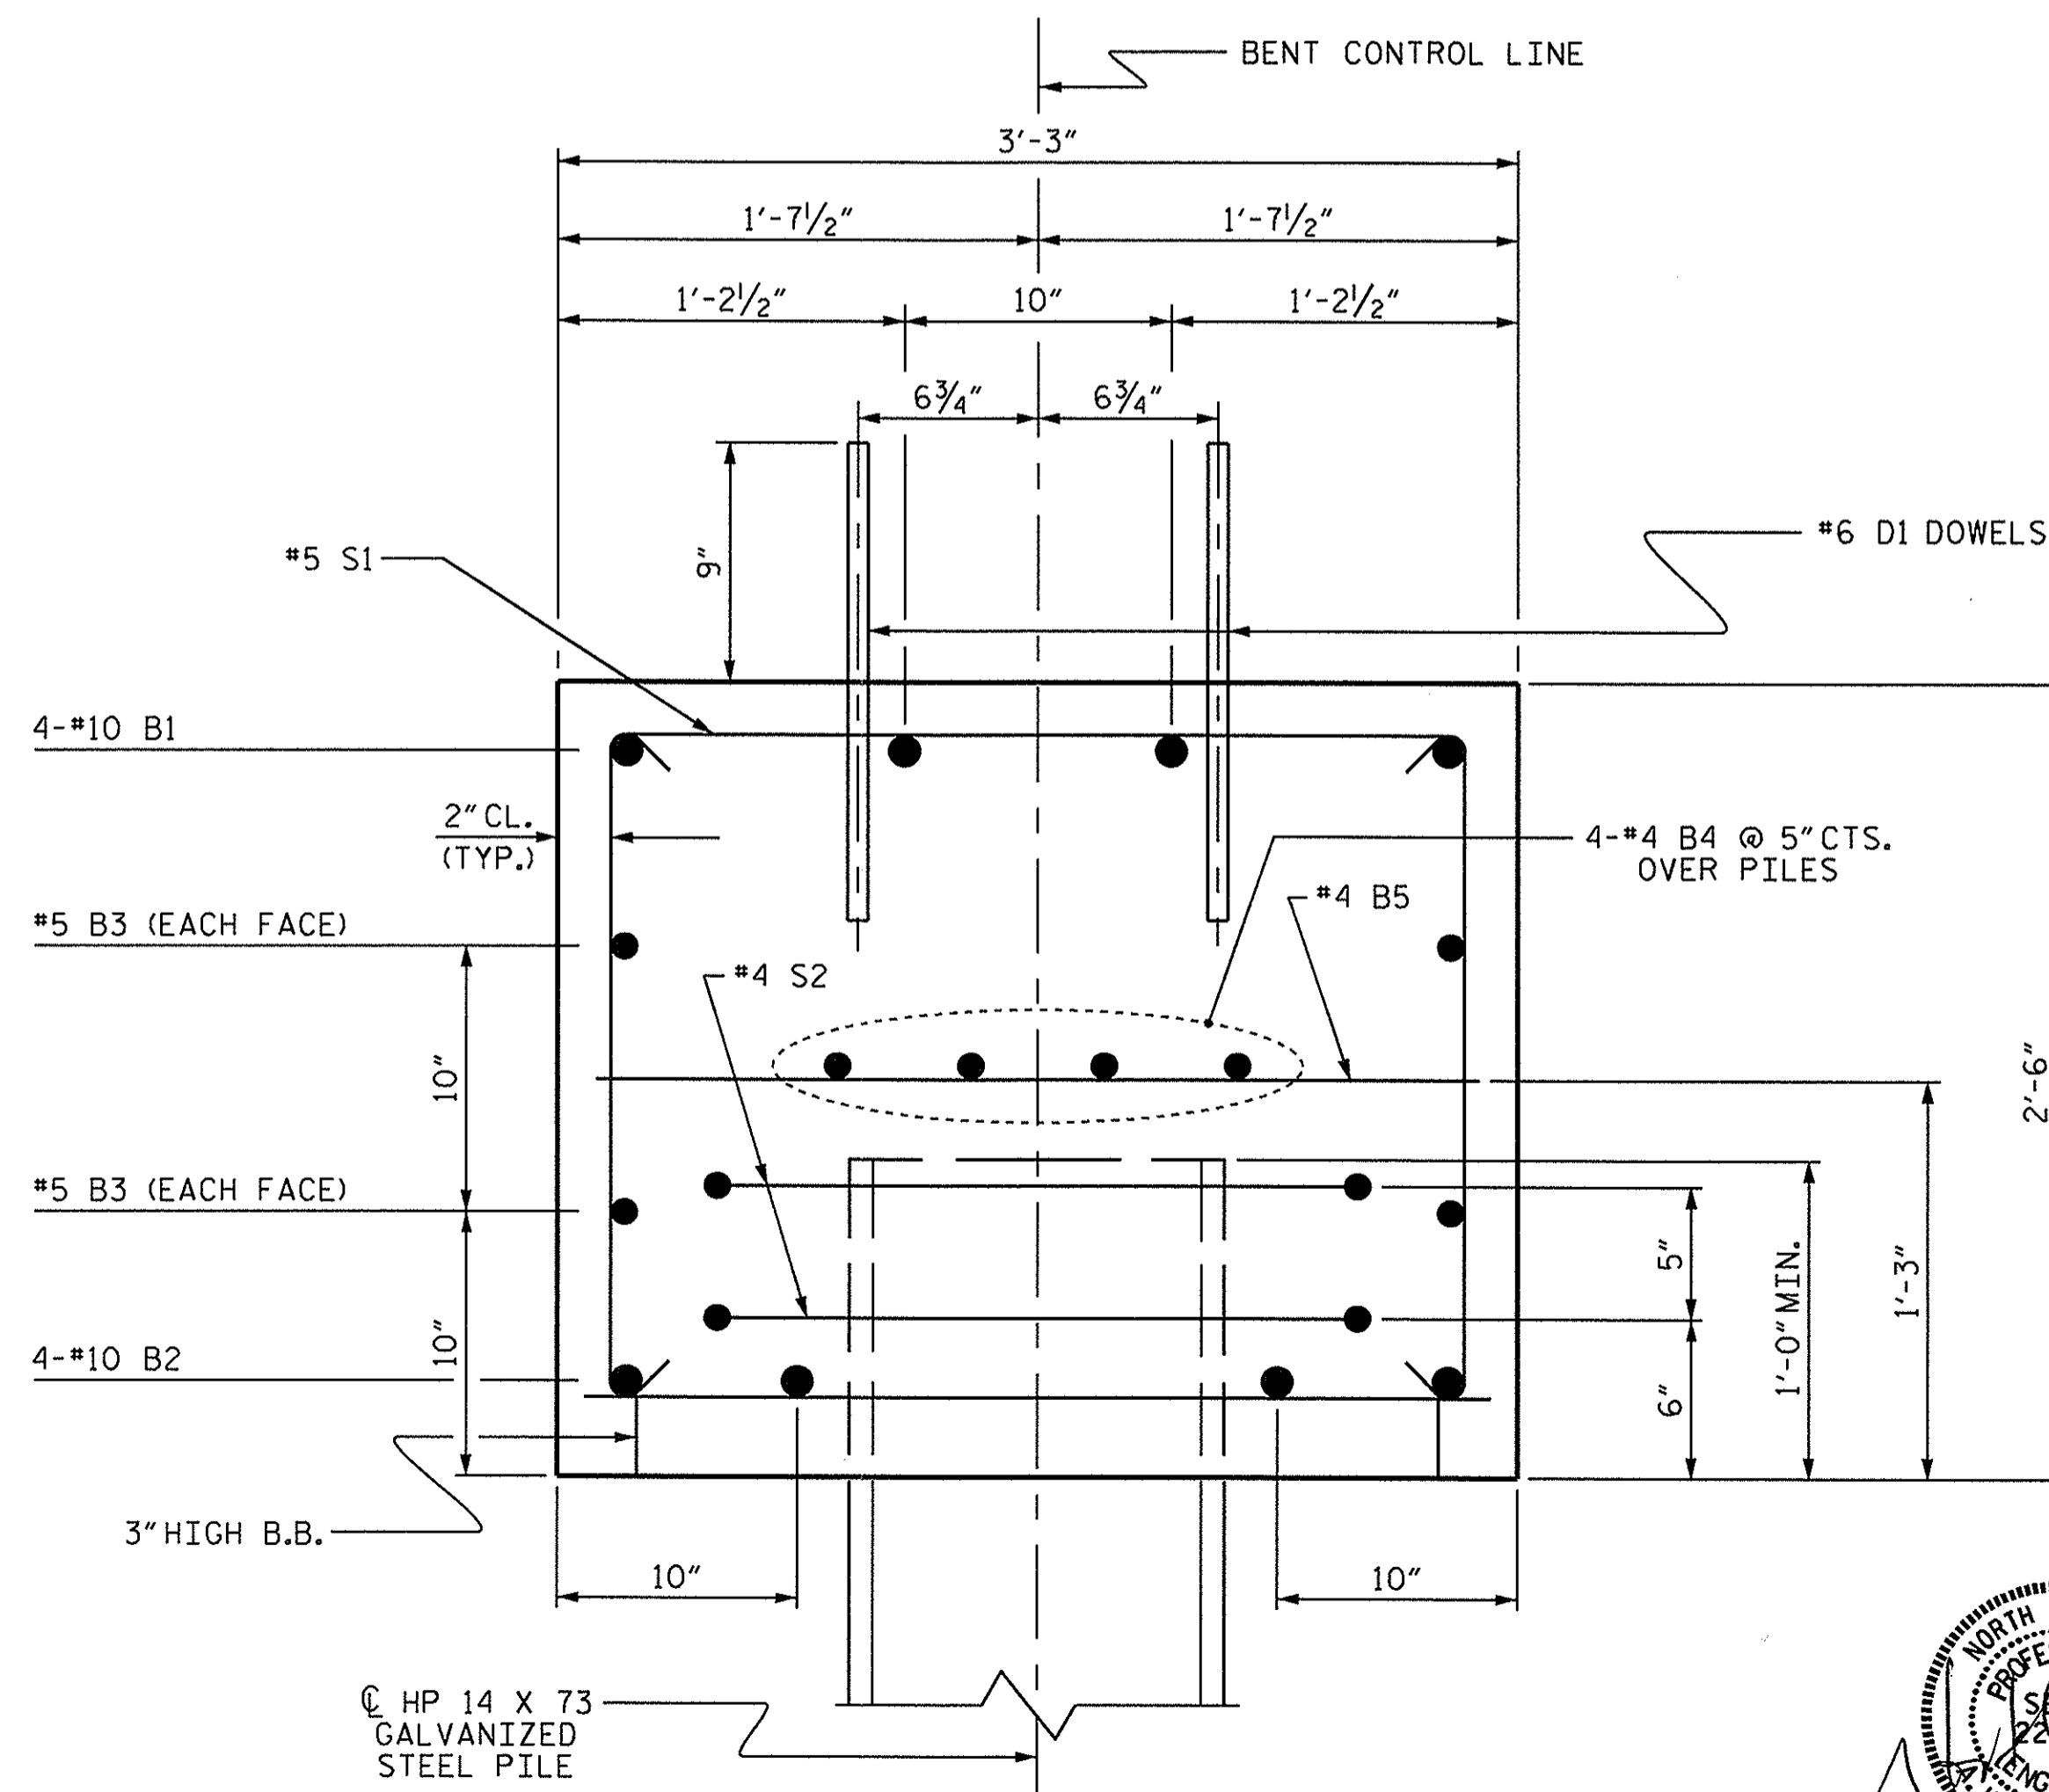

**SECTION A-A**

HP 14 X 73 GALVANIZED STEEL PILE

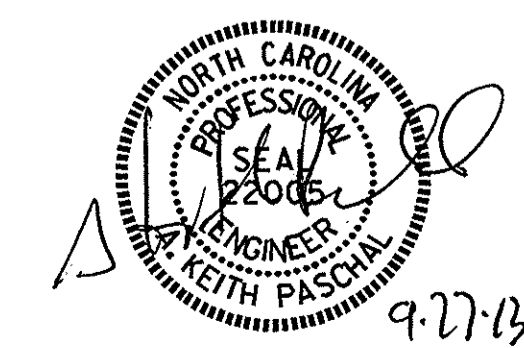


DRAWN BY : M. D. PISO DATE : 09-26-13  
 CHECKED BY : A. K. PASCHAL DATE : 09-26-13  
 DRAWN BY : DGE 05/10  
 CHECKED BY : MKT 05/10

27-SEP-2013 08:18  
 S:\DPC1\Keith\BD-5102U\Design\BD-5102U.S0\_BT.dgn  
 kpaschal



PROJECT NO. BD-5102U  
PITT COUNTY  
 STATION: 17+20.50 -L-  
 SHEET 2 OF 2

| STATE OF NORTH CAROLINA DEPARTMENT OF TRANSPORTATION RALEIGH |     |       |     |     |                 |
|--|-----|-------|-----|-----|-----------------|
| SUBSTRUCTURE BENT No. 1                                      |     |       |     |     |                 |
| REVISIONS  |     |       |     |     | SHEET NO.       |
| NO.  | BY: | DATE: | NO. | BY: | DATE:           |
| 1  |     |       | 3   |     |                 |
| 2  |     |       | 4   |     |                 |
|  |     |       |     |     | S-15            |
|  |     |       |     |     | TOTAL SHEETS 17 |

NOTES :  
FOR BERM WIDTH DIMENSIONS, SEE GENERAL DRAWING.

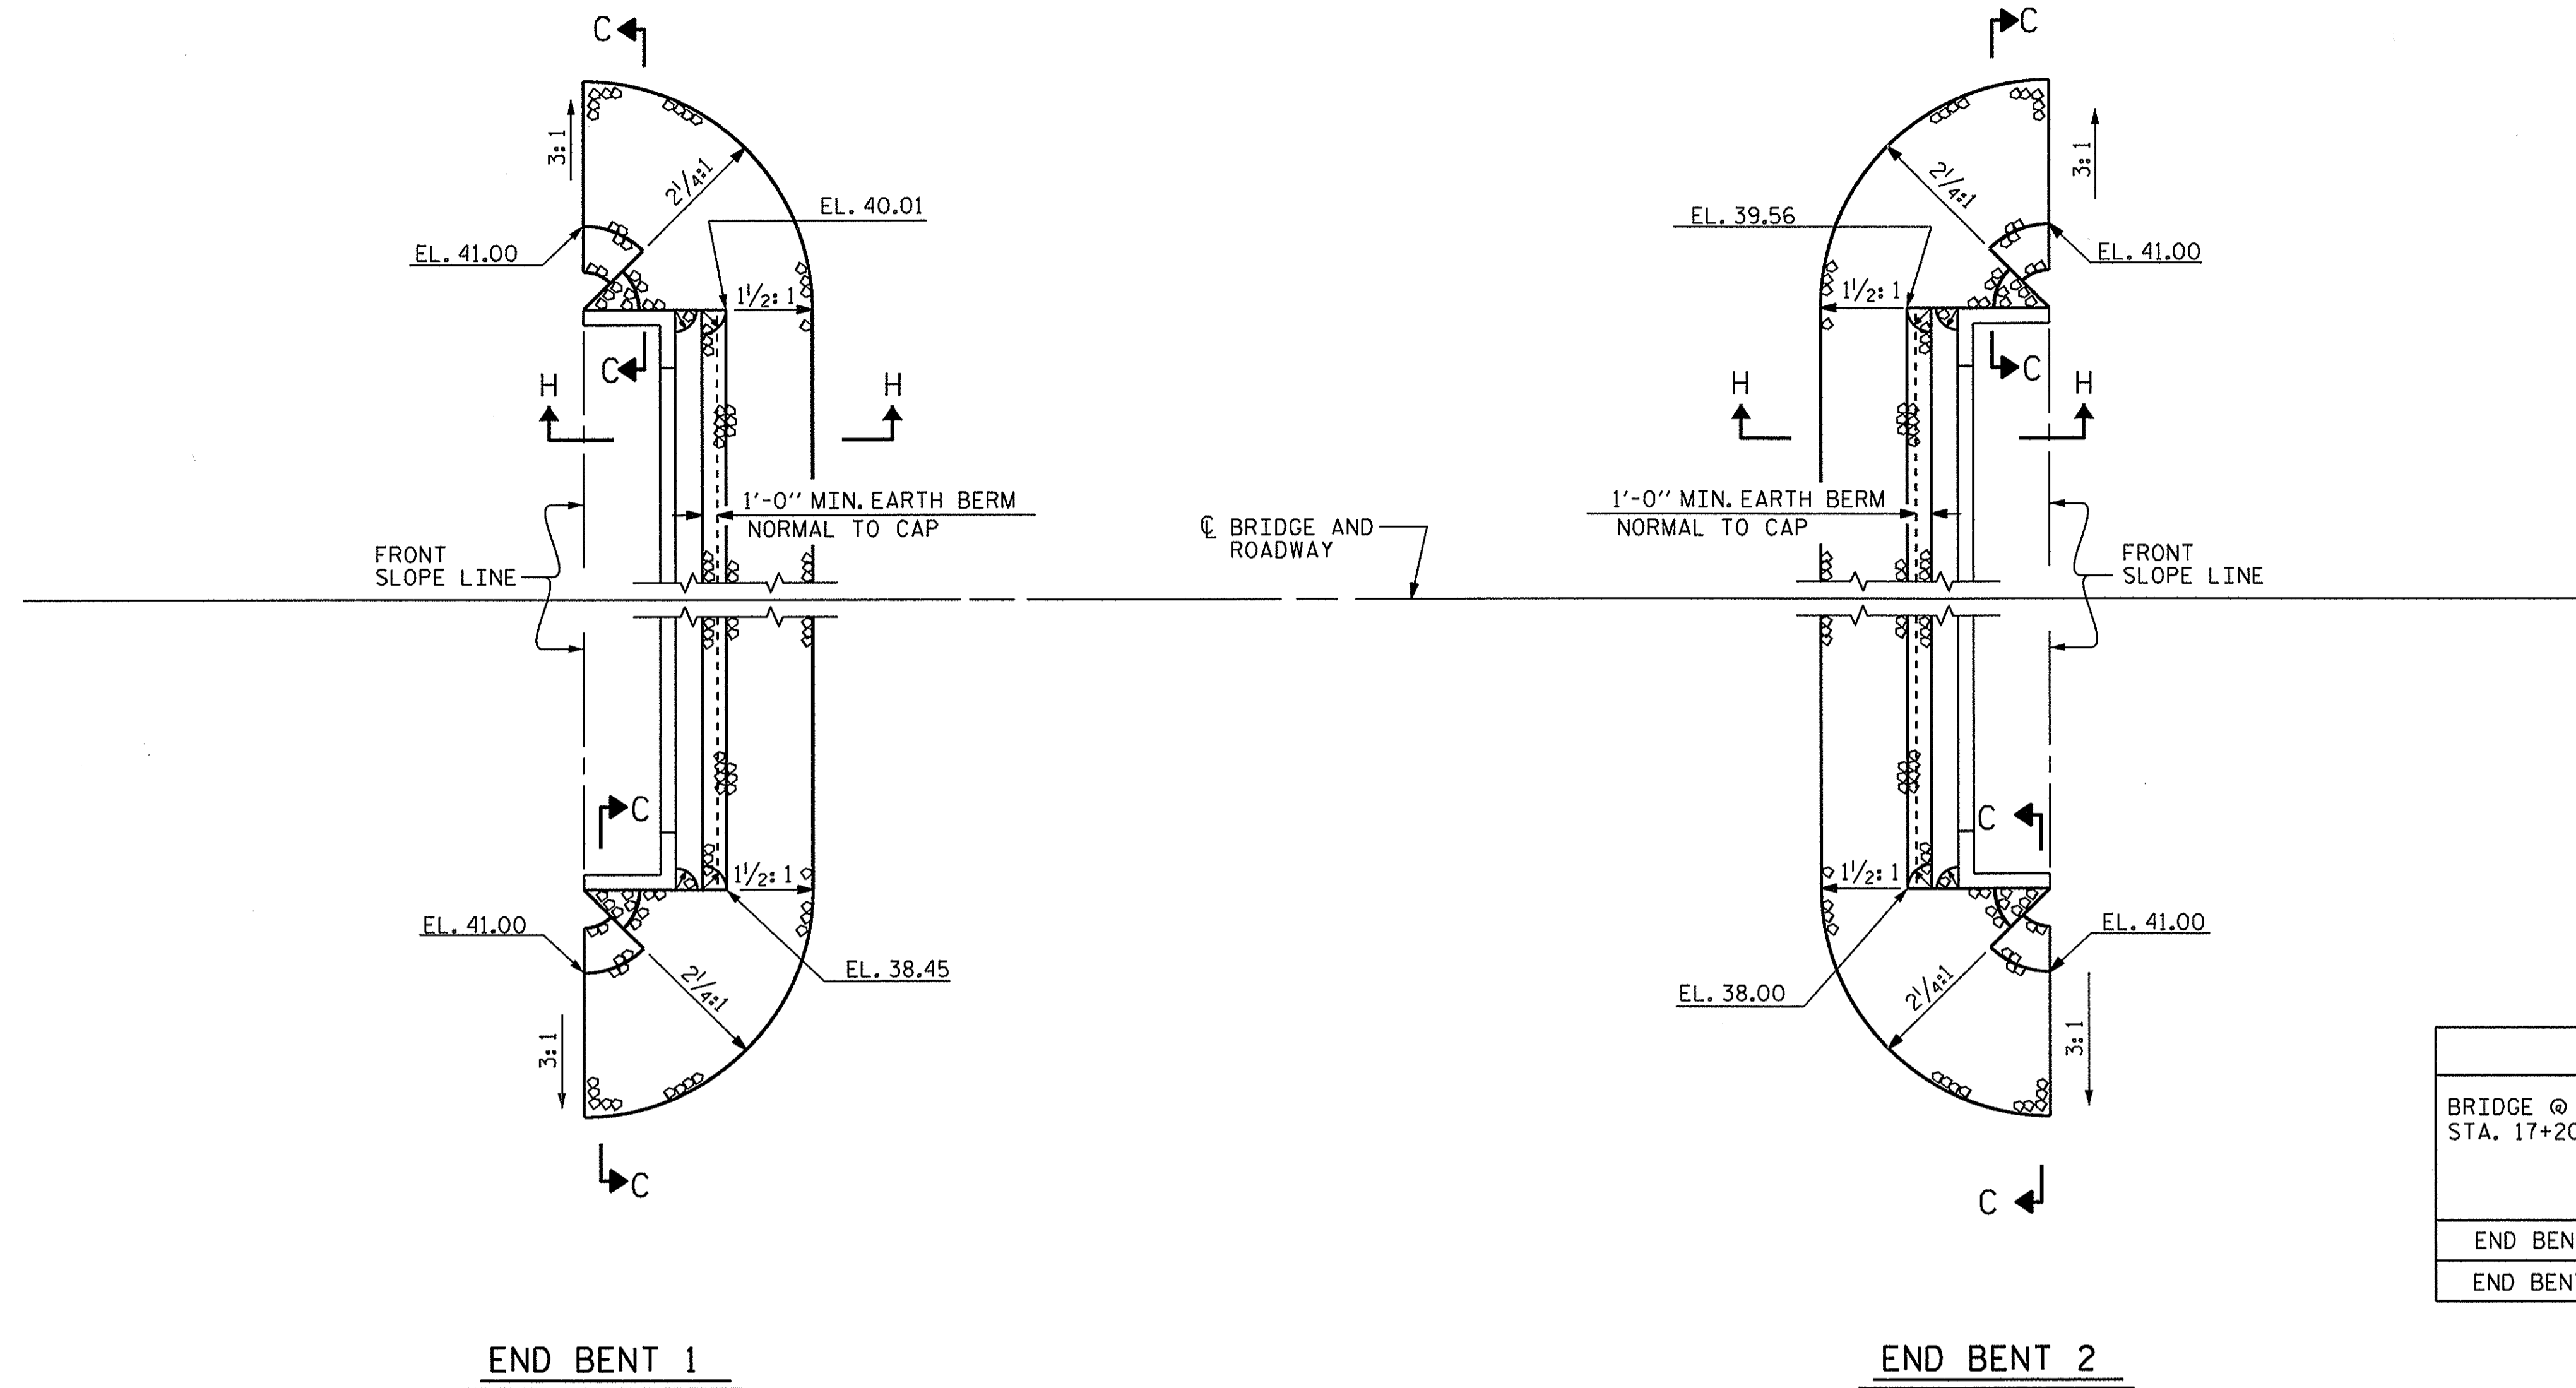


| ESTIMATED QUANTITIES          |                                      |                            |
|-------------------------------|--------------------------------------|----------------------------|
| BRIDGE @<br>STA. 17+20.50 -L- | RIP RAP<br>CLASS II<br>(2'-0" THICK) | GEOTEXTILE<br>FOR DRAINAGE |
|                               | TONS                                 | SQUARE YARDS               |
| END BENT 1                    | 67                                   | 74                         |
| END BENT 2                    | 67                                   | 74                         |

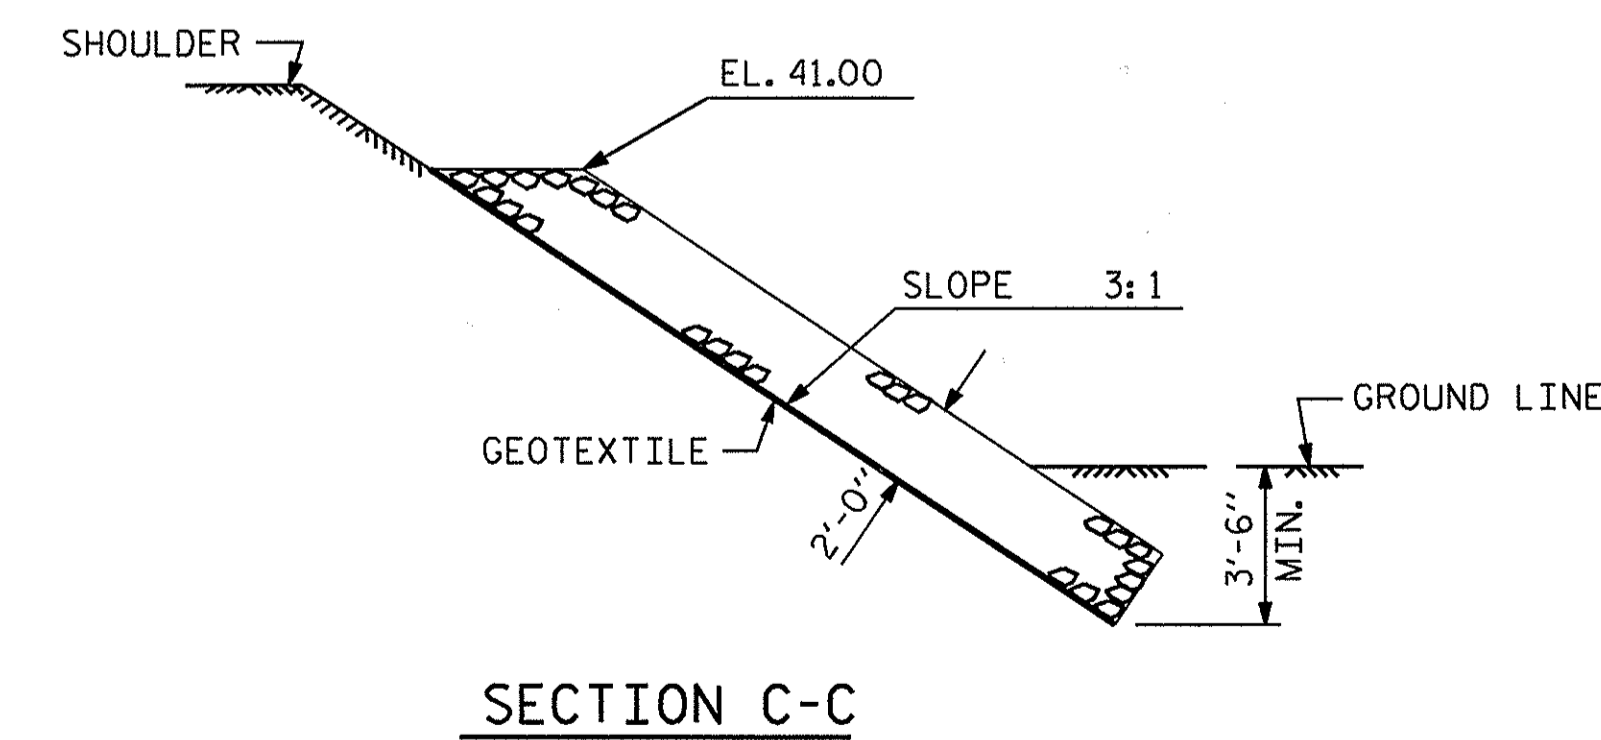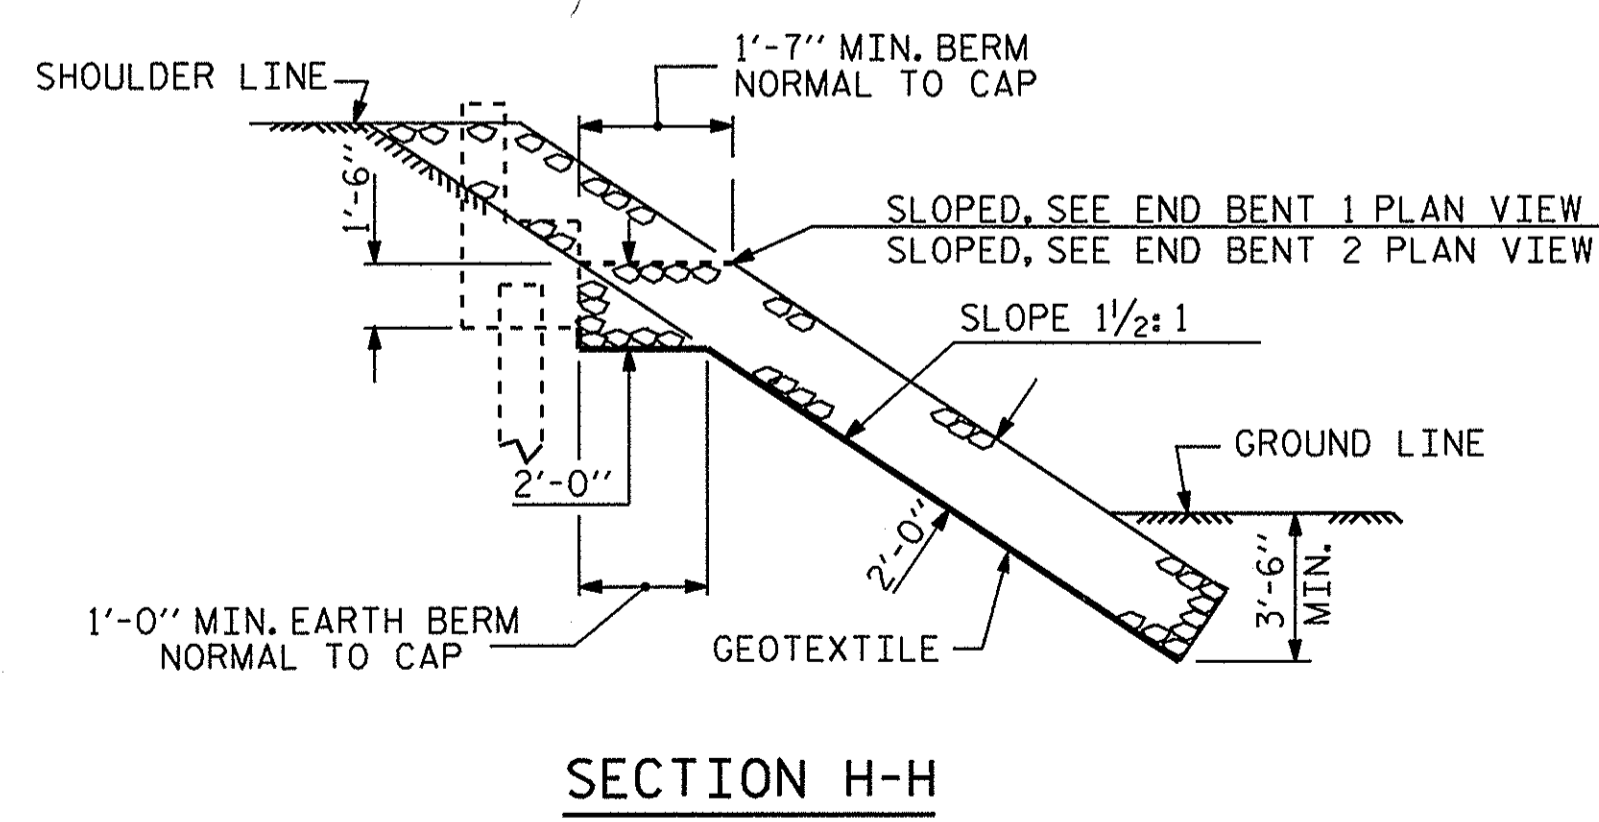

PROJECT NO. BD-5102U  
PITT COUNTY  
STATION: 17+20.50 -L-

STATE OF NORTH CAROLINA  
DEPARTMENT OF TRANSPORTATION  
RALEIGH  
STANDARD  
= RIP RAP DETAILS =

| REVISIONS |     |       |     |     |       | SHEET NO.<br>S-16  |
|-----------|-----|-------|-----|-----|-------|--------------------|
| NO.       | BY: | DATE: | NO. | BY: | DATE: |                    |
| 1         |     |       | 3   |     |       | TOTAL SHEETS<br>17 |
| 2         |     |       | 4   |     |       |                    |

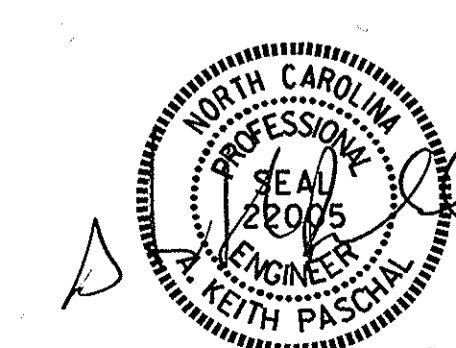


ASSEMBLED BY : A. H. SHIVELY DATE : 6/17/13  
CHECKED BY : M. L. RORIE DATE : 6/18/13  
DRAWN BY : REK 1/84 REV. 5/1/06R TLA/GM  
CHECKED BY : RDU 1/84 REV. 10/1/11 MAA/GM  
REV. 12/21/11 MAA/GM

**NOTES**

FOR REINFORCED BRIDGE APPROACH FILL INCLUDING GEOTEXTILE, IMPERMEABLE GEOMEMBRANE, 4" Ø DRAINAGE PIPE, #78M STONE, AND SELECT MATERIAL, SEE ROADWAY PLANS.


AREA BETWEEN THE WINGWALL AND APPROACH SLAB SHALL BE GRADED TO DRAIN THE WATER AWAY FROM THE FILL FACE OF THE BRIDGE AND SHALL BE PAVED, SEE ROADWAY PLANS.

APPROACH SLAB GROOVING IS NOT REQUIRED.

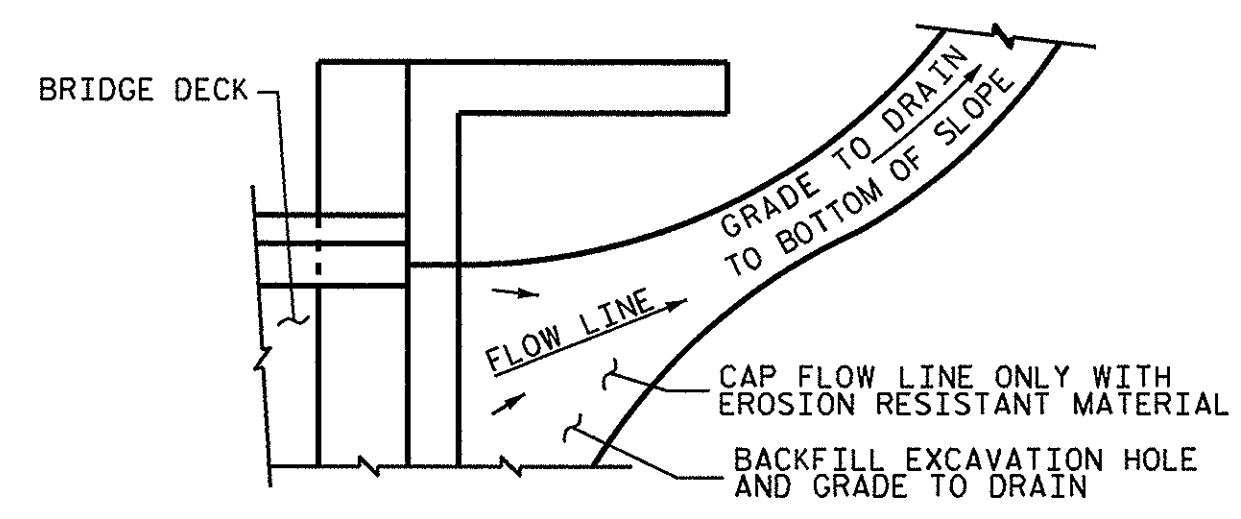


NOTE: IF THE APPROACH SLAB IS NOT CONSTRUCTED IMMEDIATELY AFTER THE BACKFILLING OF THE END BENT EXCAVATION, GRADE TO DRAIN TO THE BOTTOM OF THE SLOPE AND PROVIDE EROSION RESISTANT MATERIAL, SUCH AS FIBERGLASS ROVING OR AS DIRECTED BY THE ENGINEER TO PREVENT SOIL EROSION AND TO PROTECT THE AREA ADJACENT TO THE STRUCTURE. THE CONTRACTOR WILL BE REQUIRED TO REMOVE THESE MATERIALS PRIOR TO CONSTRUCTION OF THE APPROACH SLAB.

**TEMPORARY DRAINAGE DETAIL**

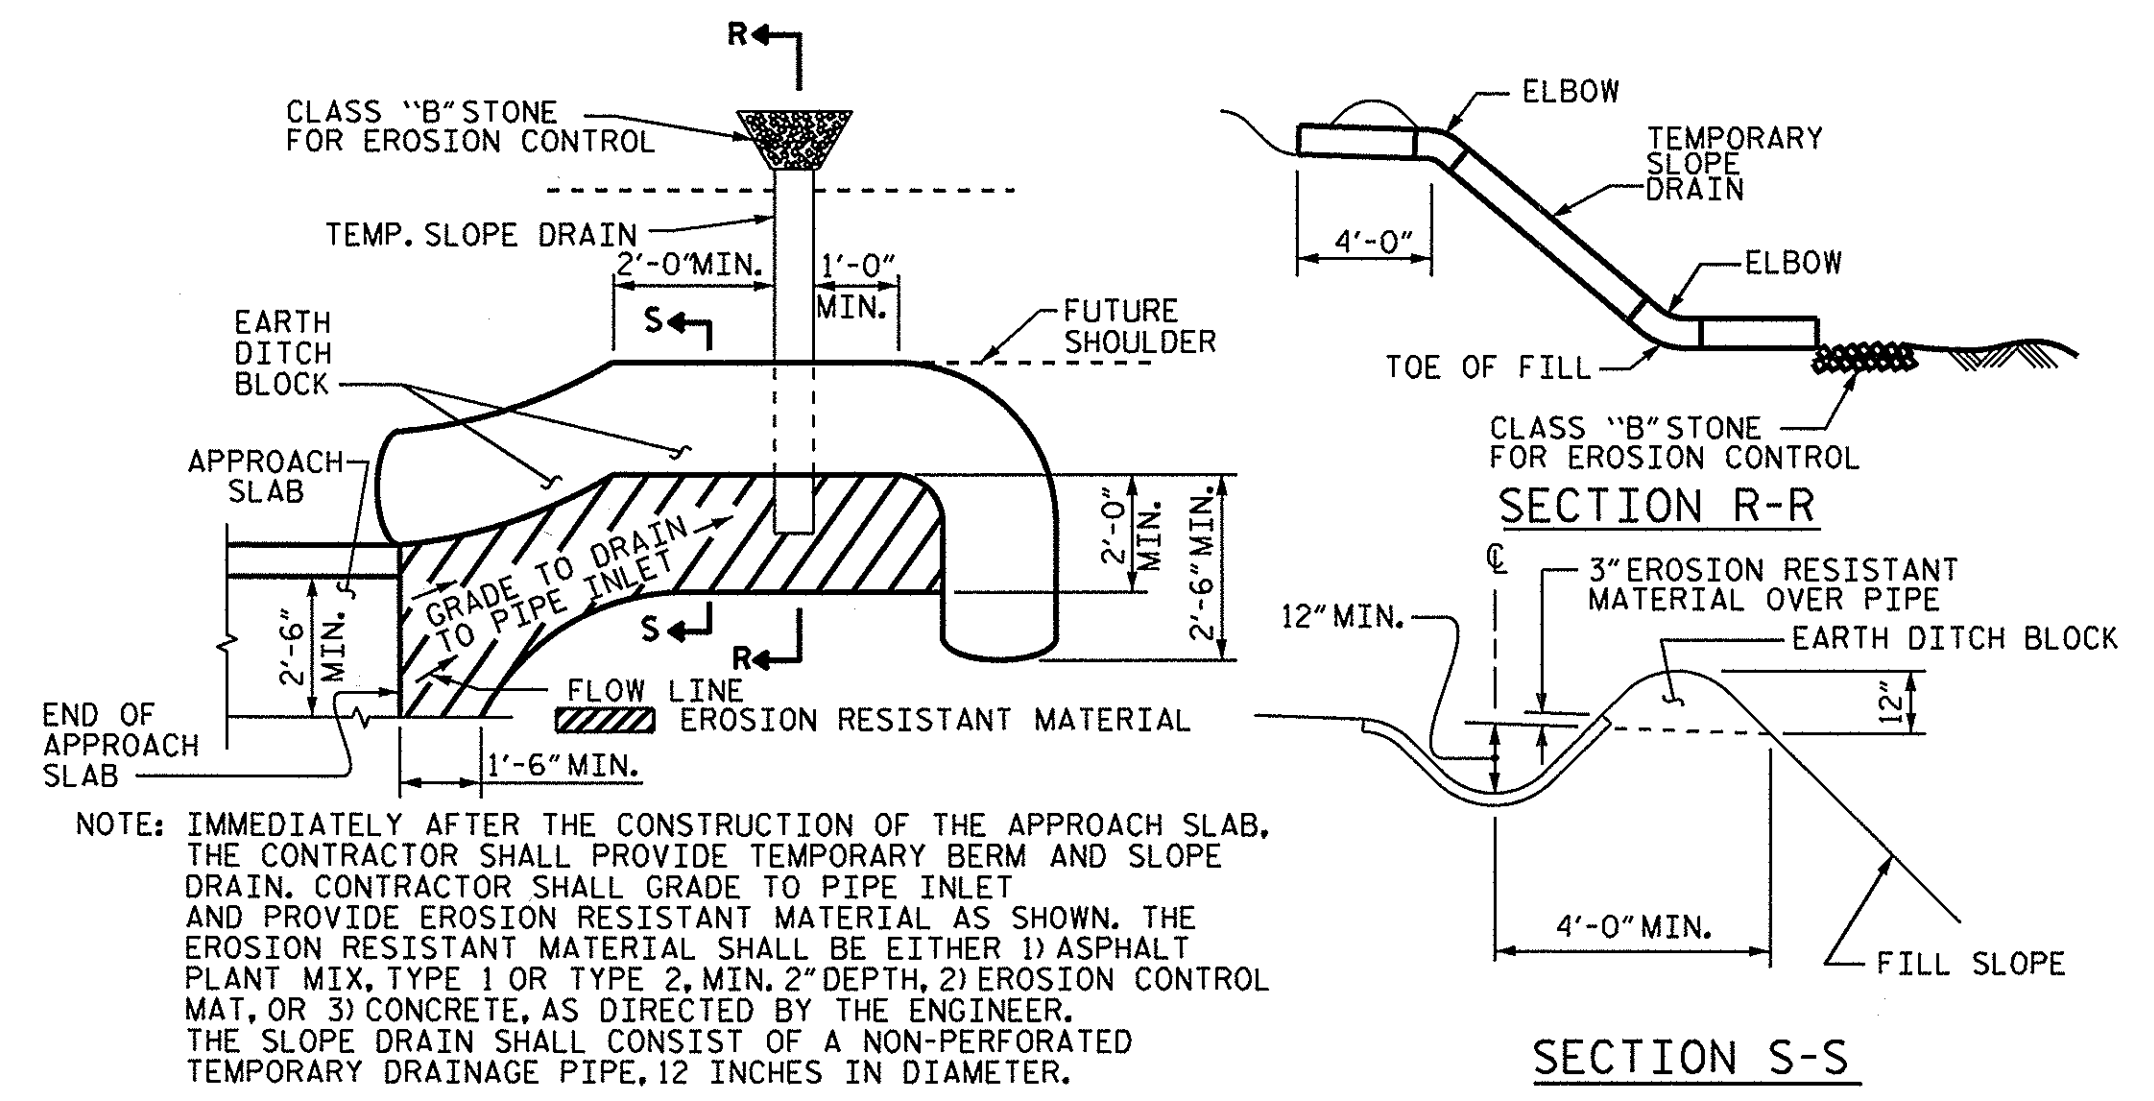


NOTE: IMMEDIATELY AFTER THE CONSTRUCTION OF THE APPROACH SLAB, THE CONTRACTOR SHALL PROVIDE TEMPORARY BERM AND SLOPE DRAIN. CONTRACTOR SHALL GRADE TO PIPE INLET AND PROVIDE EROSION RESISTANT MATERIAL AS SHOWN. THE EROSION RESISTANT MATERIAL SHALL BE EITHER 1) ASPHALT PLANT MIX, TYPE 1 OR TYPE 2, MIN. 2" DEPTH, 2) EROSION CONTROL MAT, OR 3) CONCRETE, AS DIRECTED BY THE ENGINEER. THE SLOPE DRAIN SHALL CONSIST OF A NON-PERFORATED TEMPORARY DRAINAGE PIPE, 12 INCHES IN DIAMETER.

**TEMPORARY BERM AND SLOPE DRAIN DETAILS**  
(TO BE USED WHEN SHOULDER BERM GUTTER IS REQUIRED)


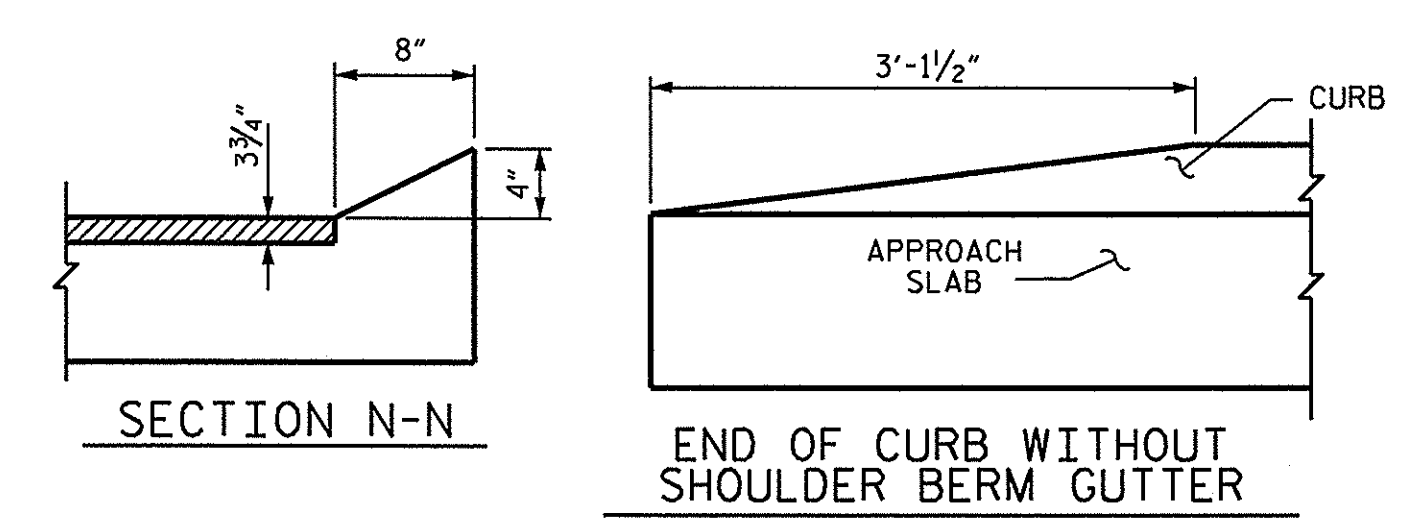


**CURB DETAILS**

| SPLICE LENGTHS |              |          |
|----------------|--------------|----------|
| BAR SIZE       | EPOXY COATED | UNCOATED |
| #4             | 2'-0"        | 1'-9"    |
| #5             | 2'-6"        | 2'-2"    |
| #6             | 3'-10"       | 2'-7"    |

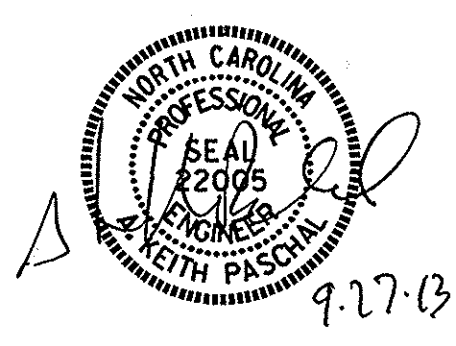

| BILL OF MATERIAL                 |     |      |      |         |        |
|----------------------------------|-----|------|------|---------|--------|
| APPROACH SLAB AT EB #1           |     |      |      |         |        |
| BAR                              | NO. | SIZE | TYPE | LENGTH  | WEIGHT |
| *A1                              | 26  | #4   | STR  | 16'-11" | 294    |
| A2                               | 26  | #4   | STR  | 16'-9"  | 291    |
| *B1                              | 64  | #5   | STR  | 11'-2"  | 745    |
| B2                               | 64  | #6   | STR  | 11'-8"  | 1121   |
| REINFORCING STEEL                |     |      |      | LBS.    | 1412   |
| * EPOXY COATED REINFORCING STEEL |     |      |      | LBS.    | 1039   |
| CLASS AA CONCRETE                |     |      |      | C. Y.   | 18.6   |
| APPROACH SLAB AT EB #2           |     |      |      |         |        |
| BAR                              | NO. | SIZE | TYPE | LENGTH  | WEIGHT |
| *A1                              | 26  | #4   | STR  | 16'-11" | 294    |
| A2                               | 26  | #4   | STR  | 16'-9"  | 291    |
| *B1                              | 64  | #5   | STR  | 11'-2"  | 745    |
| B2                               | 64  | #6   | STR  | 11'-8"  | 1121   |
| REINFORCING STEEL                |     |      |      | LBS.    | 1412   |
| * EPOXY COATED REINFORCING STEEL |     |      |      | LBS.    | 1039   |
| CLASS AA CONCRETE                |     |      |      | C. Y.   | 18.6   |

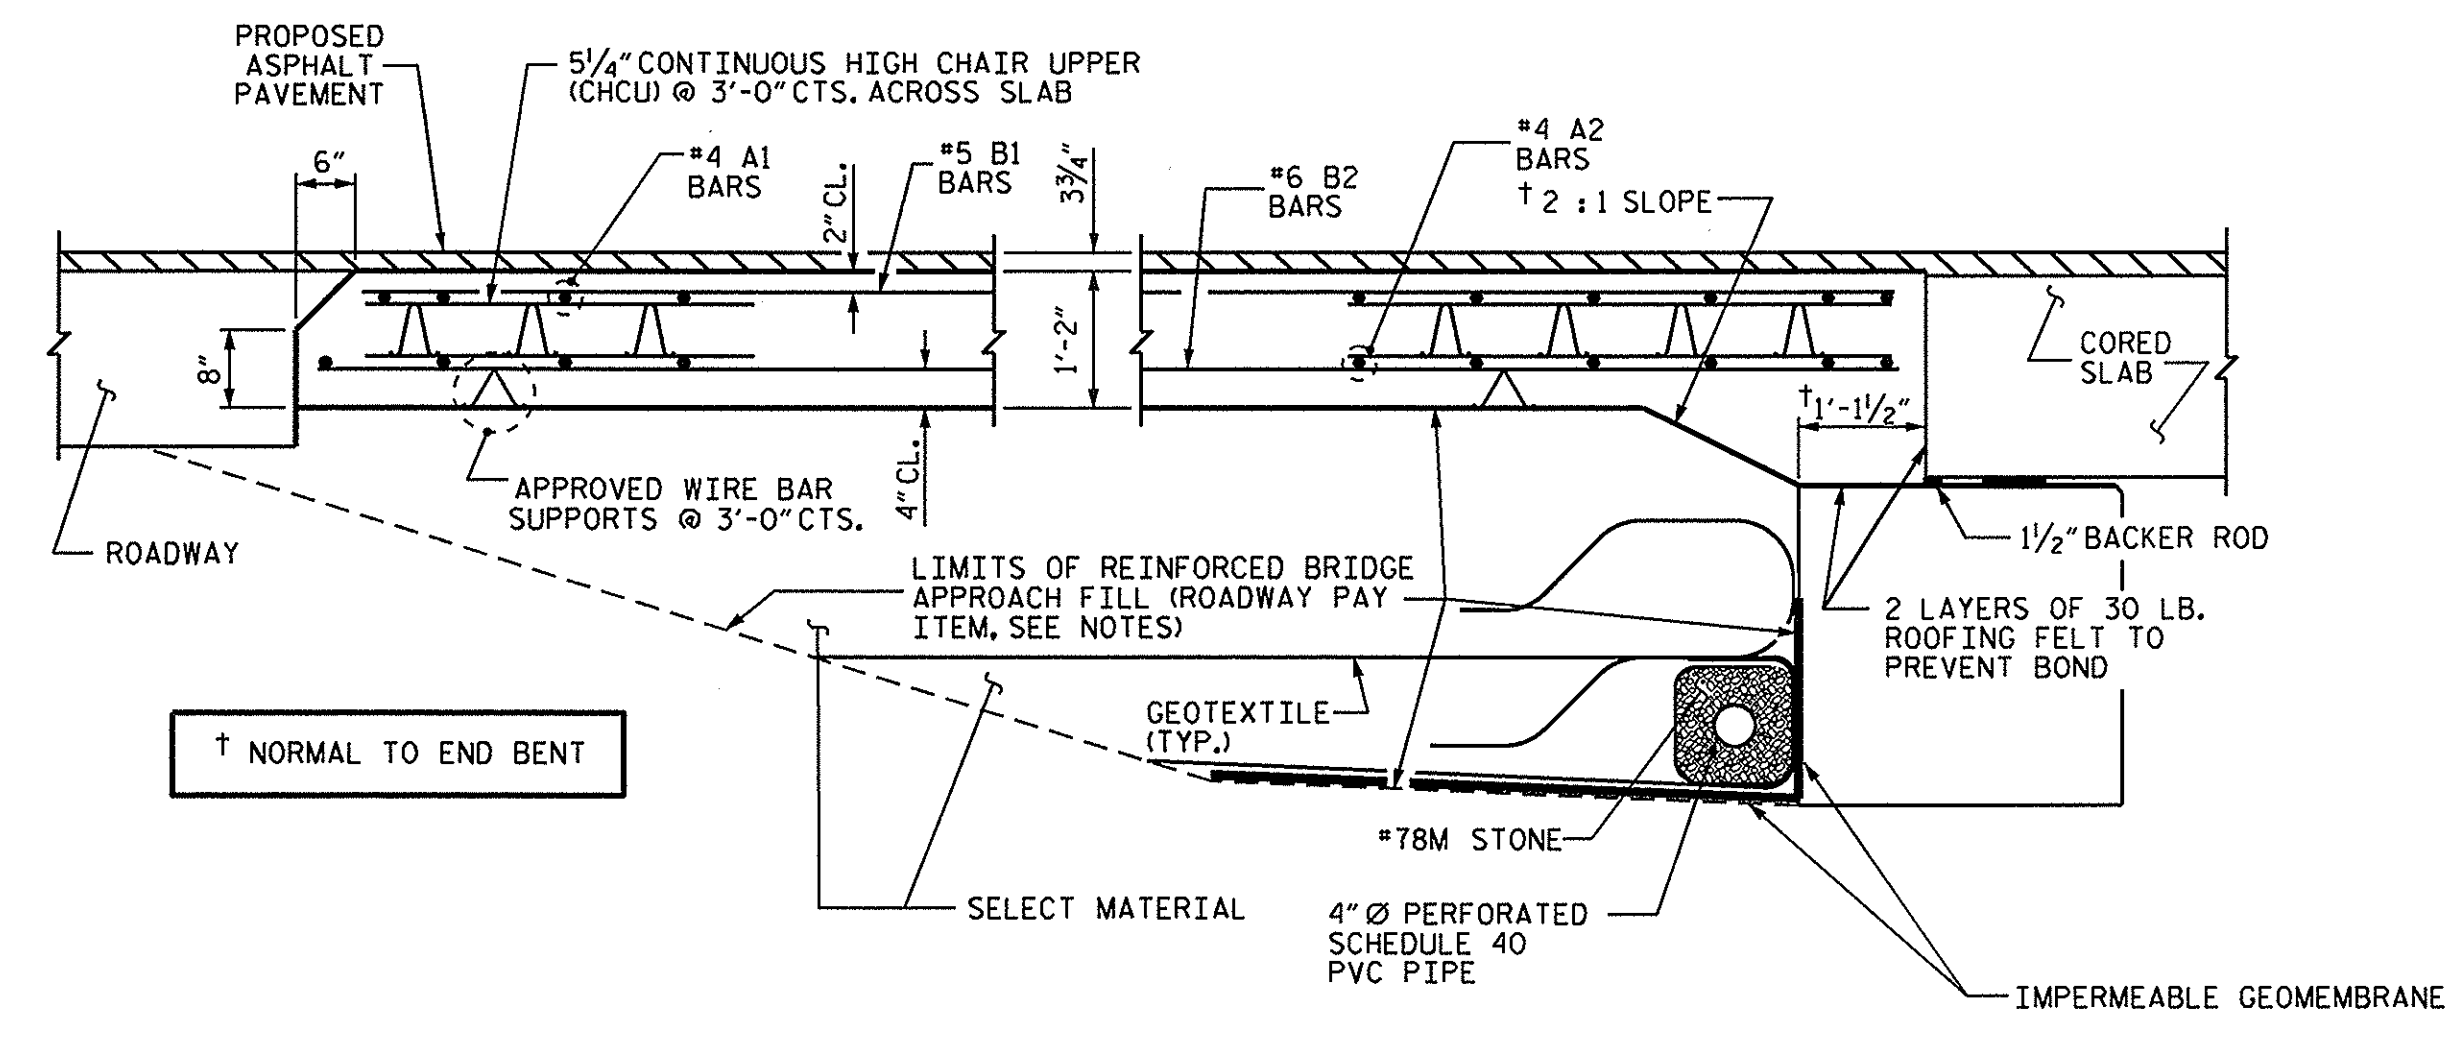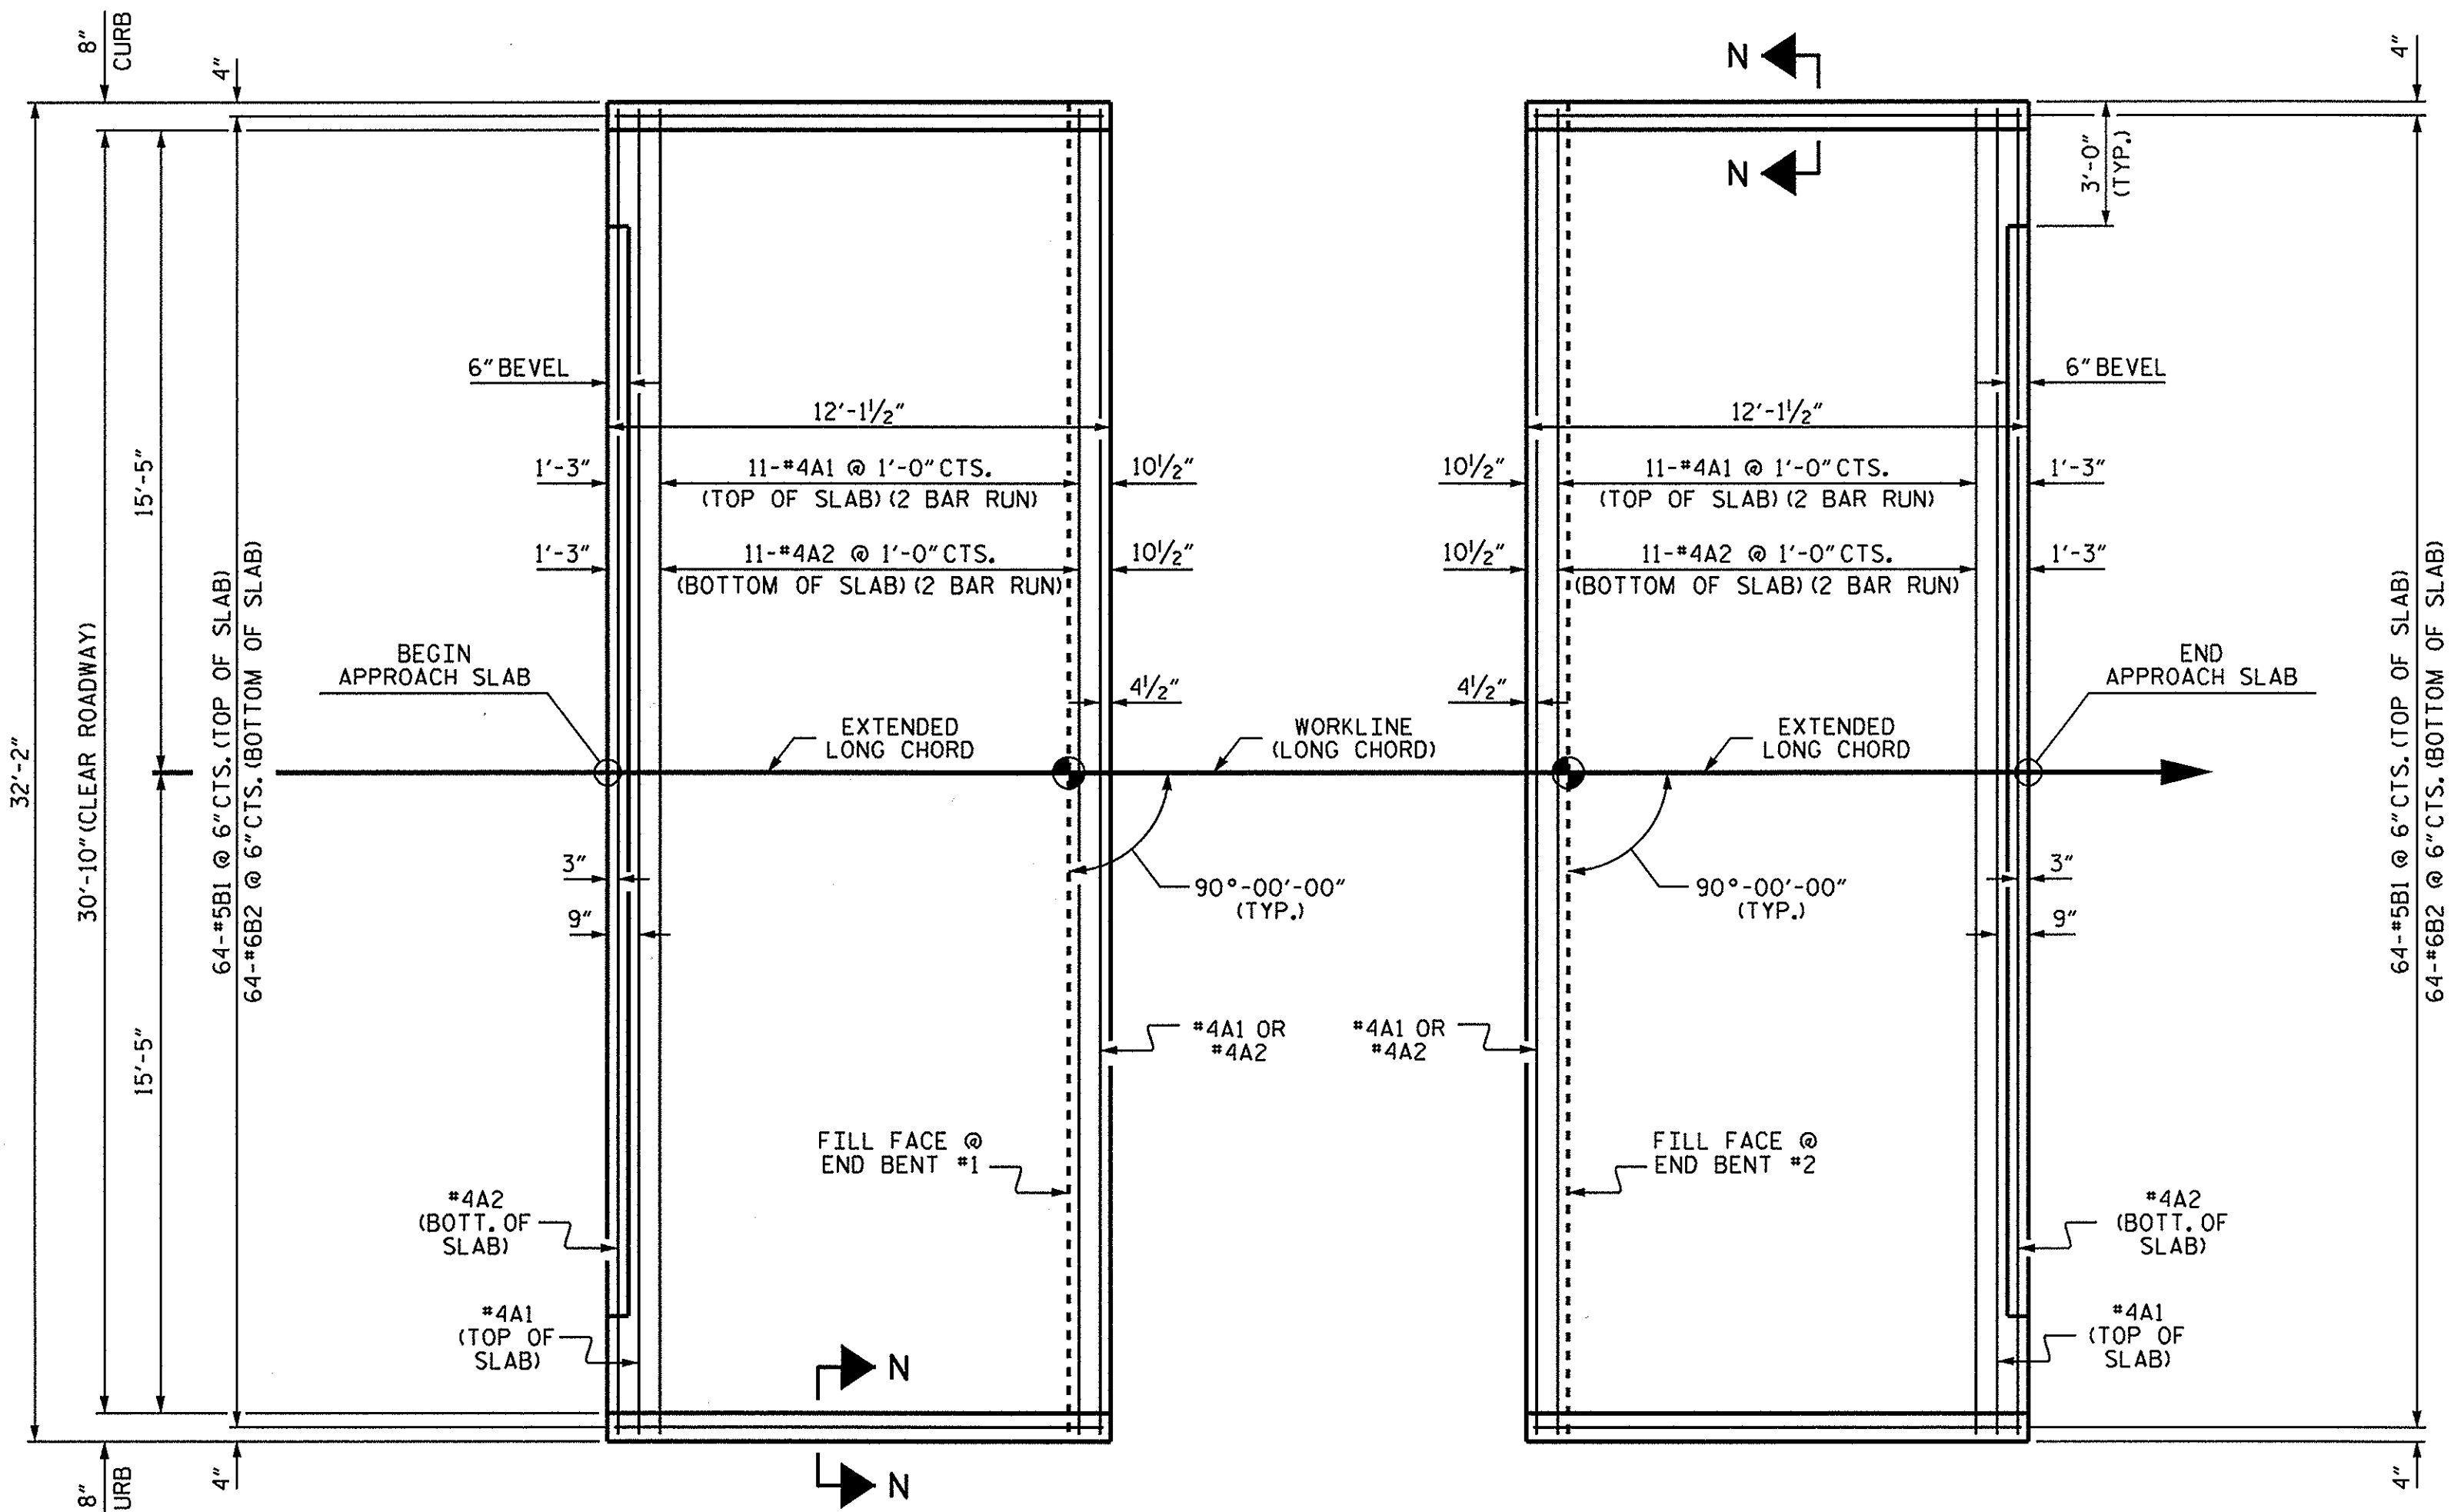

**SECTION THRU SLAB**

ASSEMBLED BY : A. H. SHIVELY DATE : 6/17/13  
CHECKED BY : M. L. RORIE DATE : 6/18/13  
DRAWN BY : SHS/MAA 5-09 REV. 12-11 MAA/AAC  
CHECKED BY : BCH 5-09

27-SEP-2013 08:17  
S:\DPO1\Keith\BD-5102U\Design\BD-5102.SD\_AS.dgn  
Kpaschal

PROJECT NO. BD-5102U  
PITT COUNTY  
STATION: 17+20.50 -L-

| STATE OF NORTH CAROLINA<br>DEPARTMENT OF TRANSPORTATION<br>RALEIGH              |     |       |     |     |       |
|---|-----|-------|-----|-----|-------|
| STANDARD<br>BRIDGE APPROACH SLAB<br>FOR PRESTRESSED CONCRETE<br>CORED SLAB UNIT |     |       |     |     |       |
| 90° SKEW  |     |       |     |     |       |
| REVISIONS   |     |       |     |     |       |
| NO.   | BY: | DATE: | NO. | BY: | DATE: |
| 1   |     |       | 3   |     |       |
| 2   |     |       | 4   |     |       |

SHEET NO. S-17  
TOTAL SHEETS 17



## STANDARD NOTES

### DESIGN DATA:

|   |       |                                  |
|---|-------|----------------------------------|
| SPECIFICATIONS                                  | ----- | A.A.S.H.T.O. (CURRENT)           |
| LIVE LOAD                                       | ----- | SEE PLANS                        |
| IMPACT ALLOWANCE                                | ----- | SEE A.A.S.H.T.O.                 |
| STRESS IN EXTREME FIBER OF                      |       |                                  |
| STRUCTURAL STEEL - AASHTO M270 GRADE 36         | -     | 20,000 LBS. PER SQ. IN.          |
| - AASHTO M270 GRADE 50W                         | -     | 27,000 LBS. PER SQ. IN.          |
| - AASHTO M270 GRADE 50                          | -     | 27,000 LBS. PER SQ. IN.          |
| REINFORCING STEEL IN TENSION                    |       |                                  |
| GRADE 60  | --    | 24,000 LBS. PER SQ. IN.          |
| CONCRETE IN COMPRESSION                         | ----- | 1,200 LBS. PER SQ. IN.           |
| CONCRETE IN SHEAR                               | ----- | SEE A.A.S.H.T.O.                 |
| STRUCTURAL TIMBER - TREATED OR                  |       |                                  |
| UNTREATED - EXTREME FIBER STRESS                | ----- | 1,800 LBS. PER SQ. IN.           |
| COMPRESSION PERPENDICULAR TO GRAIN<br>OF TIMBER | ----- | 375 LBS. PER SQ. IN.             |
| EQUIVALENT FLUID PRESSURE OF EARTH              | ----- | 30 LBS. PER CU. FT.<br>(MINIMUM) |

### MATERIAL AND WORKMANSHIP:

EXCEPT AS MAY OTHERWISE BE SPECIFIED ON PLANS OR IN THE SPECIAL PROVISIONS, ALL MATERIAL AND WORKMANSHIP SHALL BE IN ACCORDANCE WITH THE 2012 "STANDARD SPECIFICATIONS FOR ROADS AND STRUCTURES" OF THE N. C. DEPARTMENT OF TRANSPORTATION.

STEEL SHEET PILING FOR PERMANENT OR TEMPORARY APPLICATIONS SHALL BE HOT ROLLED.

### CONCRETE:

UNLESS OTHERWISE REQUIRED ON PLANS, CLASS A CONCRETE SHALL BE USED FOR ALL PORTIONS OF ALL STRUCTURES WITH THE EXCEPTION THAT: CLASS AA CONCRETE SHALL BE USED IN BRIDGE SUPERSTRUCTURES, ABUTMENT BACKWALLS, AND APPROACH SLABS; AND CLASS B CONCRETE SHALL BE USED FOR SLOPE PROTECTION AND RIP RAP.

### CONCRETE CHAMFERS:

UNLESS OTHERWISE NOTED ON THE PLANS, ALL EXPOSED CORNERS ON STRUCTURES SHALL BE CHAMFERED 3/4" WITH THE FOLLOWING EXCEPTIONS: TOP CORNERS OF CURBS MAY BE ROUNDED TO 1-1/2" RADIUS WHICH IS BUILT INTO CURB FORMS; CORNERS OF TRANSVERSE FLOOR EXPANSION JOINTS SHALL BE ROUNDED WITH A 1/4" FINISHING TOOL UNLESS OTHERWISE REQUIRED ON PLANS; AND CORNERS OF EXPANSION JOINTS IN THE ROADWAY FACES AND TOPS OF CURBS AND SIDEWALKS SHALL BE ROUNDED TO A 1/4" RADIUS WITH A FINISHING STONE OR TOOL UNLESS OTHERWISE REQUIRED ON PLANS.

### DOWELS:

DOWELS WHEN INDICATED ON PLANS AS FOR CULVERT EXTENSIONS, SHALL BE EMBEDDED AT LEAST 12" INTO THE OLD CONCRETE AND GROUTED INTO PLACE WITH 1:2 CEMENT MORTAR.

### ALLOWANCE FOR DEAD LOAD DEFLECTION, SETTLEMENT, ETC. IN CASTING SUPERSTRUCTURES:

BRIDGES SHALL BE BUILT ON THE GRADE OR VERTICAL CURVE SHOWN ON PLANS. SLABS, CURBS AND PARAPETS SHALL CONFORM TO THE GRADE OR CURVE.  
ALL DIMENSIONS WHICH ARE GIVEN IN SECTION AND ARE AFFECTED BY DEAD LOAD DEFLECTIONS ARE DIMENSIONS AT CENTER LINE OF BEARING UNLESS OTHERWISE NOTED ON PLANS. IN SETTING FORMS FOR STEEL BEAM BRIDGES AND PRESTRESSED CONCRETE GIRDER BRIDGES, ADJUSTMENTS SHALL BE MADE DUE TO THE DEAD LOAD DEFLECTIONS FOR THE ELEVATIONS SHOWN. WHERE BLOCKS ARE SHOWN OVER BEAMS FOR BUILDING UP TO THE SLAB, THE VERTICAL DIMENSIONS OF THE BLOCKS SHALL BE ADJUSTED BETWEEN BEARINGS TO COMPENSATE FOR DEAD LOAD DEFLECTIONS, VERTICAL CURVE ORDINATE, AND ACTUAL BEAM CAMBER. WHERE BOTTOM OF SLAB IS IN LINE WITH BOTTOM OF TOP FLANGES, DEPTH OF SLAB BETWEEN BEARINGS SHALL BE ADJUSTED TO COMPENSATE FOR DEAD LOAD DEFLECTION, VERTICAL CURVE ORDINATE, AND ACTUAL BEAM CAMBER.  
IN SETTING FALSEWORK AND FORMS FOR REINFORCED CONCRETE SPANS, AN ALLOWANCE SHALL BE MADE FOR DEAD LOAD DEFLECTIONS, SETTLEMENT OF FALSEWORK, AND PERMANENT CAMBER WHICH SHALL BE PROVIDED FOR IN ADDITION TO THE ELEVATIONS SHOWN. AFTER REMOVAL OF THE FALSEWORK, THE FINISHED STRUCTURES SHALL CONFORM TO THE PROFILE AND ELEVATIONS SHOWN ON THE PLANS AND CONSTRUCTION ELEVATIONS FURNISHED BY THE ENGINEER.  
DETAILED DRAWINGS FOR FALSEWORK OR FORMS FOR BRIDGE SUPERSTRUCTURE AND ANY STRUCTURE OR PARTS OF A STRUCTURE AS NOTED ON THE PLANS SHALL BE SUBMITTED TO THE ENGINEER FOR APPROVAL BEFORE CONSTRUCTION OF THE FALSEWORK OR FORMS IS STARTED.

### REINFORCING STEEL:

ALL REINFORCING STEEL SHALL BE DEFORMED. DIMENSIONS RELATIVE TO PLACEMENT OF REINFORCING ARE TO CENTERS OF BARS UNLESS OTHERWISE INDICATED IN THE PLANS. DIMENSIONS ON BAR DETAILS ARE TO CENTERS OF BARS OR ARE OUT TO OUT AS INDICATED ON PLANS.  
WIRE BAR SUPPORTS SHALL BE PROVIDED FOR REINFORCING STEEL WHERE INDICATED ON THE PLANS. WHEN BAR SUPPORT PIECES ARE PLACED IN CONTINUOUS LINES, THEY SHALL BE SO PLACED THAT THE ENDS OF THE SUPPORTING WIRES SHALL BE LAPPED TO LOCK LEGS ON ADJOINING PIECES.

### STRUCTURAL STEEL:

AT THE CONTRACTOR'S OPTION, HE MAY SUBSTITUTE 7/8" Ø SHEAR STUDS FOR THE 3/4" Ø STUDS SPECIFIED ON THE PLANS. THIS SUBSTITUTION SHALL BE MADE AT THE RATE OF 3 - 7/8" Ø STUDS FOR 4 - 3/4" Ø STUDS, AND STUD SPACING CHANGES SHALL BE MADE AS NECESSARY TO PROVIDE THE SAME EQUIVALENT NUMBER OF 7/8" Ø STUDS ALONG THE BEAM AS SHOWN FOR 3/4" Ø STUDS BASED ON THE RATIO OF 3 - 7/8" Ø STUDS FOR 4 - 3/4" Ø STUDS. STUDS OF THE LENGTH SPECIFIED ON THE PLANS MUST BE PROVIDED. THE MAXIMUM SPACING SHALL BE 2'-0".  
EXCEPT AT THE INTERIOR SUPPORTS OF CONTINUOUS BEAMS WHERE THE COVER PLATE IS IN CONTACT WITH BEARING PLATE, THE CONTRACTOR MAY, AT HIS OPTION, SUBSTITUTE FOR THE COVER PLATES DESIGNATED ON THE PLANS COVER PLATES OF THE EQUIVALENT AREA PROVIDED THESE PLATES ARE AT LEAST 5/16" IN THICKNESS AND DO NOT EXCEED A WIDTH EQUAL TO THE FLANGE WIDTH LESS 2" OR A THICKNESS EQUAL TO 2 TIMES THE FLANGE THICKNESS. THE SIZE OF FILLET WELDS SHALL CONFORM TO THE REQUIREMENTS OF THE CURRENT ANSI/AASHTO/AWS "BRIDGE WELDING CODE". ELECTROSLAG WELDING WILL NOT BE PERMITTED.  
WITH THE SOLE EXCEPTION OF EDGES AT SURFACES WHICH BEAR ON OTHER SURFACES, ALL SHARP EDGES AND ENDS OF SHAPES AND PLATES SHALL BE SLIGHTLY ROUNDED BY SUITABLE MEANS TO A RADIUS OF APPROXIMATELY 1/16 INCH OR EQUIVALENT FLAT SURFACE AT A SUITABLE ANGLE PRIOR TO PAINTING, GALVANIZING, OR METALLIZING.

### HANDRAILS AND POSTS:


METAL STANDARDS AND FACES OF THE CONCRETE END POSTS FOR THE METAL RAIL SHALL BE SET NORMAL TO THE GRADE OF THE CURB, UNLESS OTHERWISE SHOWN ON PLANS. THE METAL RAIL AND TOPS OF CONCRETE POSTS USED WITH THE ALUMINUM RAIL SHALL BE BUILT PARALLEL TO THE GRADE OF THE CURB.  
METAL HANDRAILS SHALL BE IN ACCORDANCE WITH THE PLANS. RAILS SHALL BE AS MANUFACTURED FOR BRIDGE RAILING. CASTINGS SHALL BE OF A UNIFORM APPEARANCE. FINIS AND OTHER DEFORMATIONS RESULTING FROM CASTING OR OTHERWISE SHALL BE REMOVED IN A MANNER SO THAT A UNIFORM COLORING OF THE COMPLETED CASTING SHALL BE OBTAINED. CASTINGS WITH DISCOLORATIONS OR OF NON-UNIFORM COLORING WILL NOT BE ACCEPTED. CERTIFIED MILL REPORTS ARE REQUIRED FOR METAL RAILS AND POSTS.

### SPECIAL NOTES:

GENERALLY, IN CASE OF DISCREPANCY, THIS STANDARD SHEET OF NOTES SHALL GOVERN OVER THE SPECIFICATIONS, BUT THE REMAINDER OF THE PLANS SHALL GOVERN OVER NOTES HEREON, AND SPECIAL PROVISIONS SHALL GOVERN OVER ALL. SEE SPECIFICATIONS ARTICLE 105-4.

ENGLISH

JANUARY, 1990

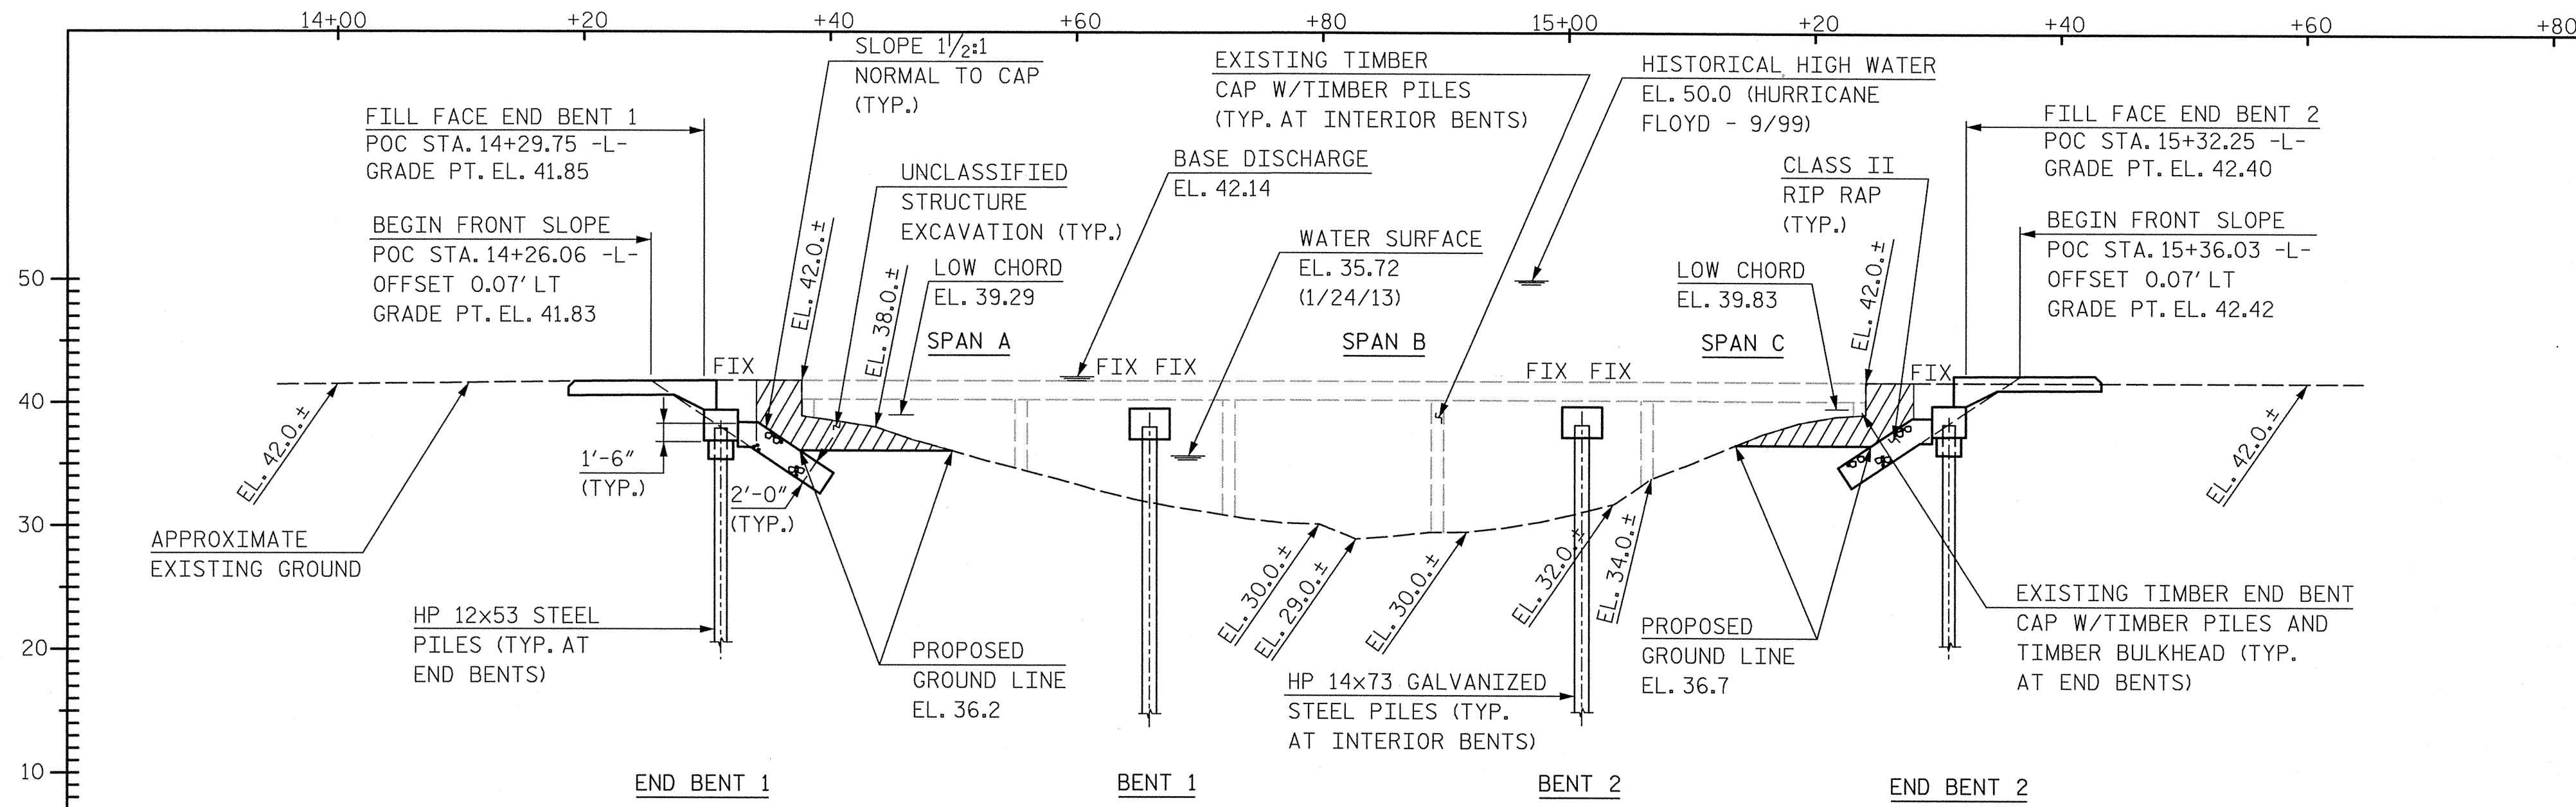

FOR GENERAL NOTES, SEE SHEET 2.

**BRIDGE HYDRAULIC DATA**

|                             |   |              |
|-----------------------------|---|--------------|
| DESIGN DISCHARGE            | = | 1,975 CFS    |
| FREQUENCY OF DESIGN FLOOD   | = | 10 YR        |
| DESIGN HIGH WATER ELEVATION | = | 39.9 FT.     |
| DRAINAGE AREA               | = | 52.2 SQ. MI. |
| BASIC DISCHARGE (Q100)      | = | 3,940 CFS    |
| BASIC HIGH WATER ELEVATION  | = | 42.1 FT.     |



**OVERTOPPING FLOOD DATA**

|                                |   |           |
|--------------------------------|---|-----------|
| OVERTOPPING DISCHARGE          | = | 1,975 CFS |
| FREQUENCY OF OVERTOPPING FLOOD | = | 10 YR     |
| OVERTOPPING FLOOD ELEVATION    | = | 40.1 FT.  |

NOTE: OVERTOPPING OCCURS AT ROADWAY STA. 21+09±

PI STA. = 13+25.00  
ELEV = 41.28  
V.C. = 140'

PI STA. = 16+00.00  
ELEV = 42.77  
V.C. = 120'

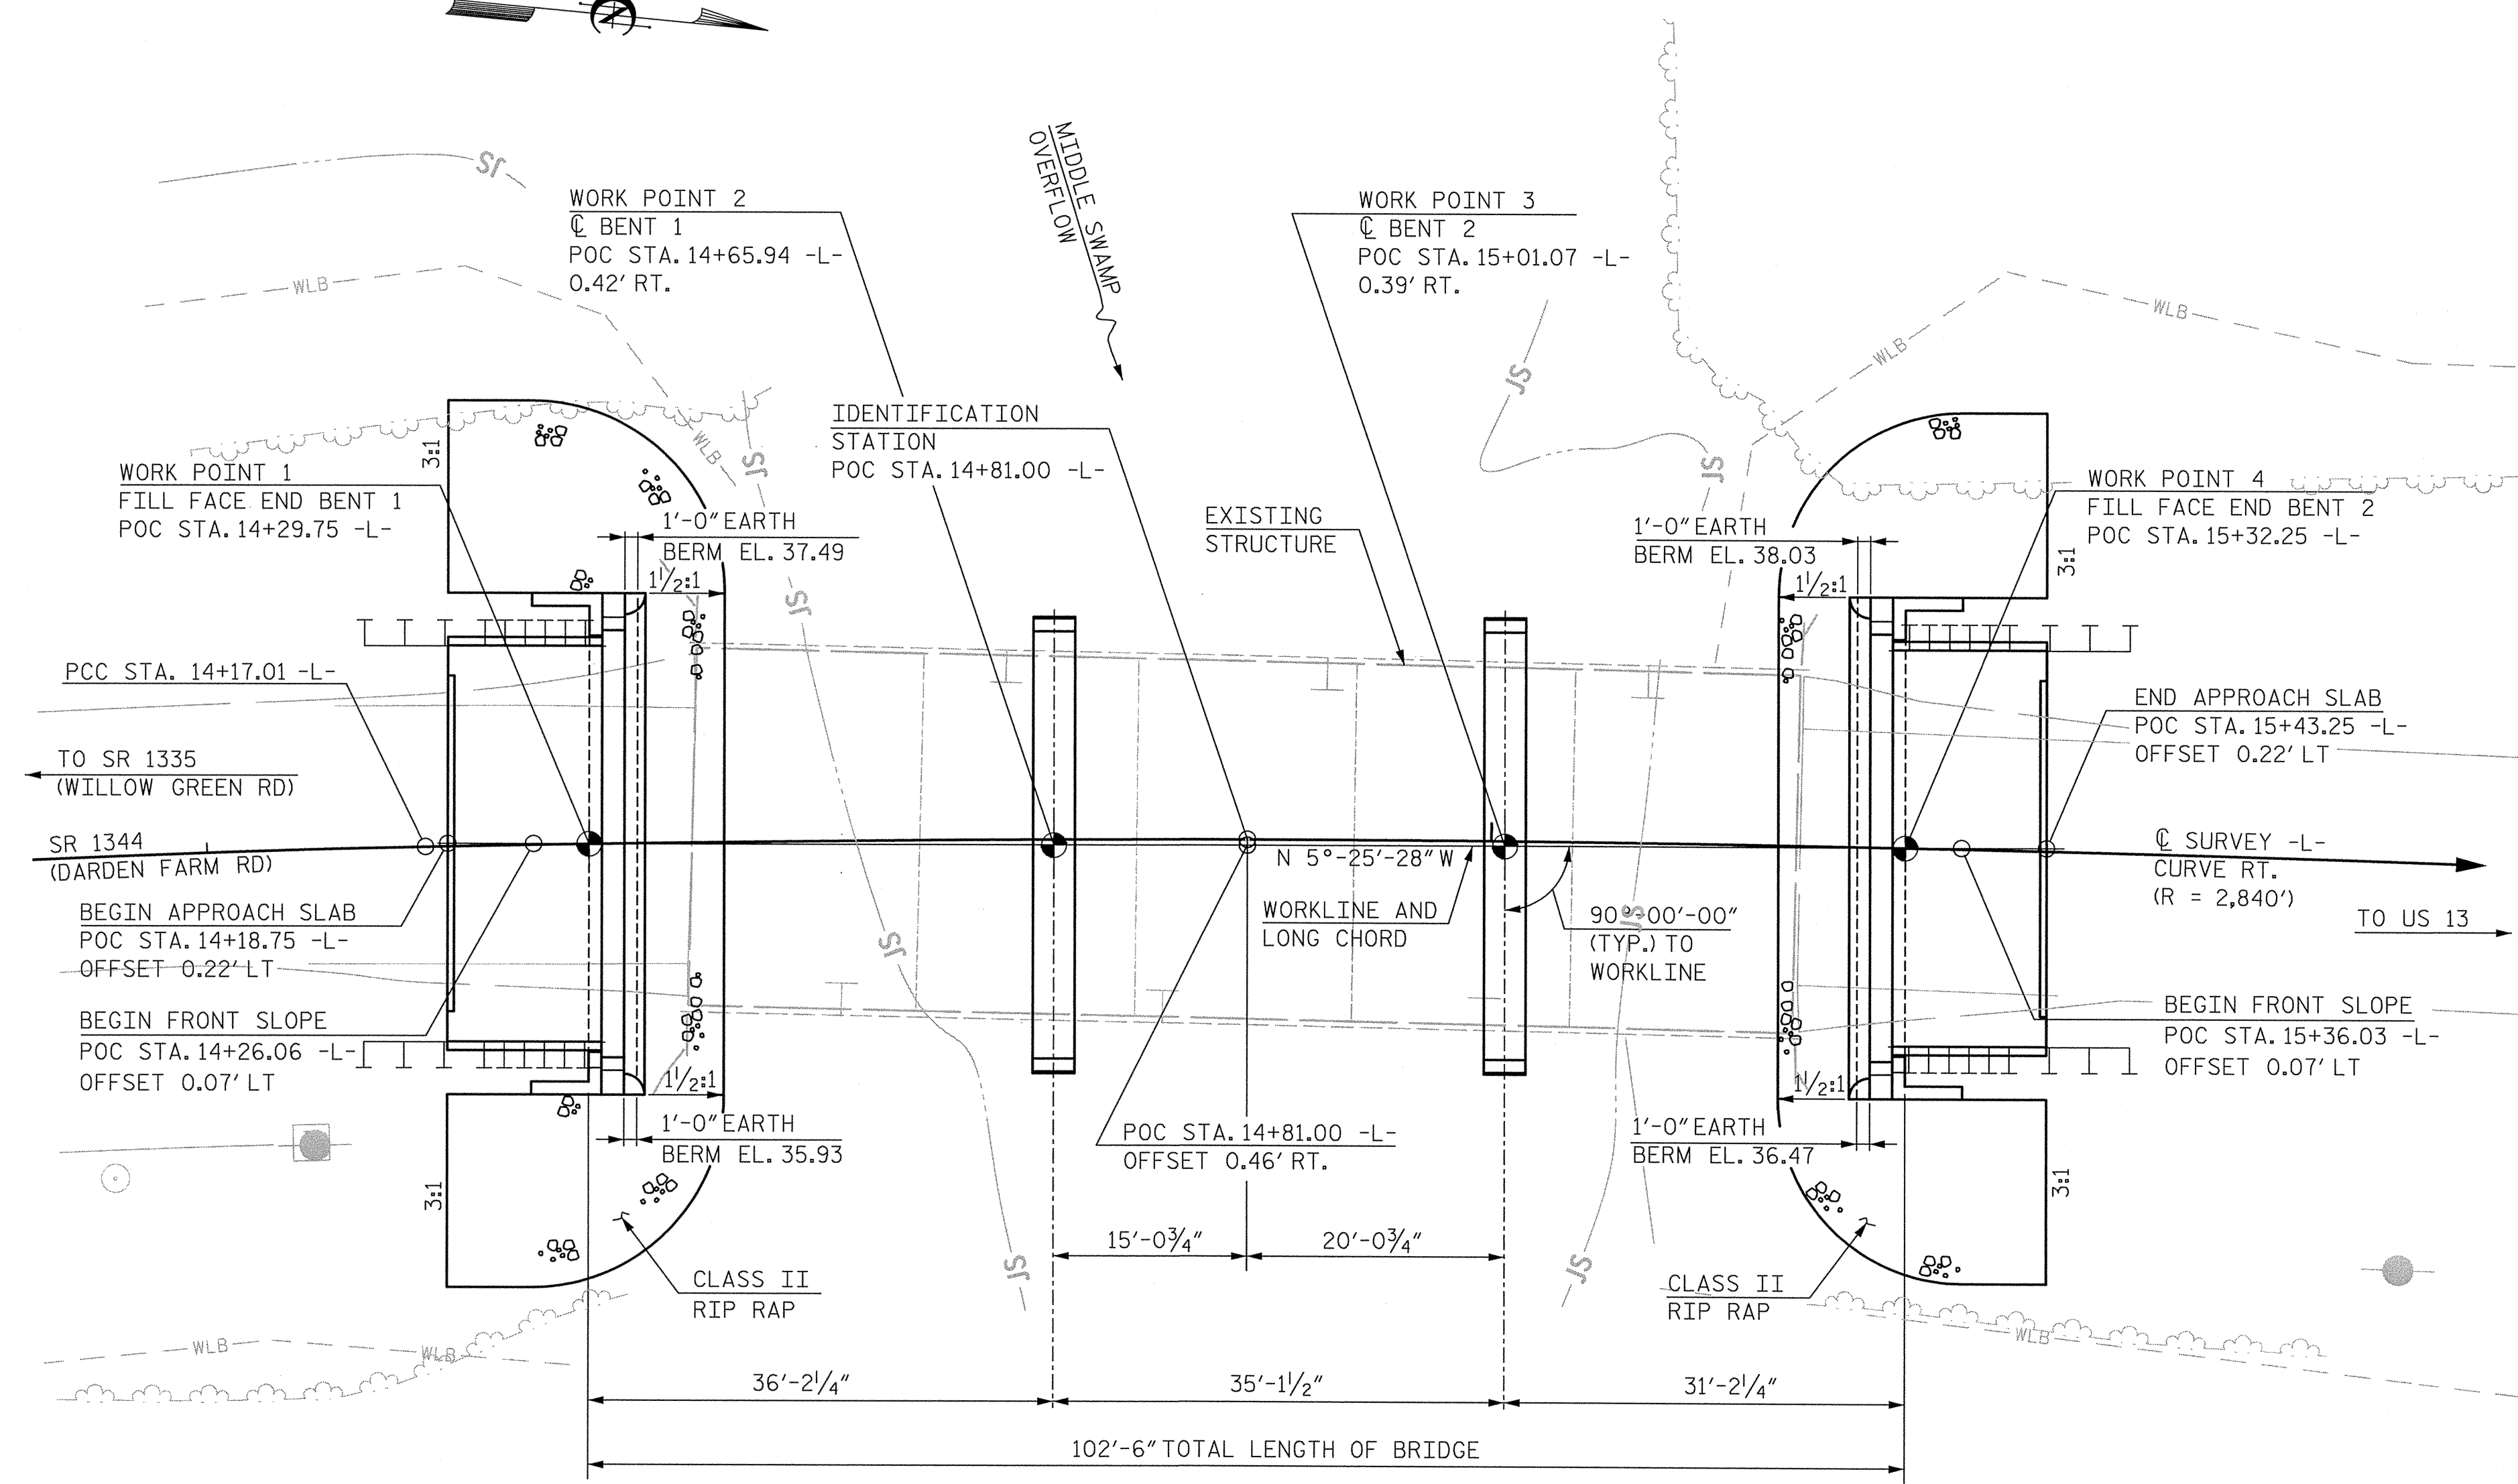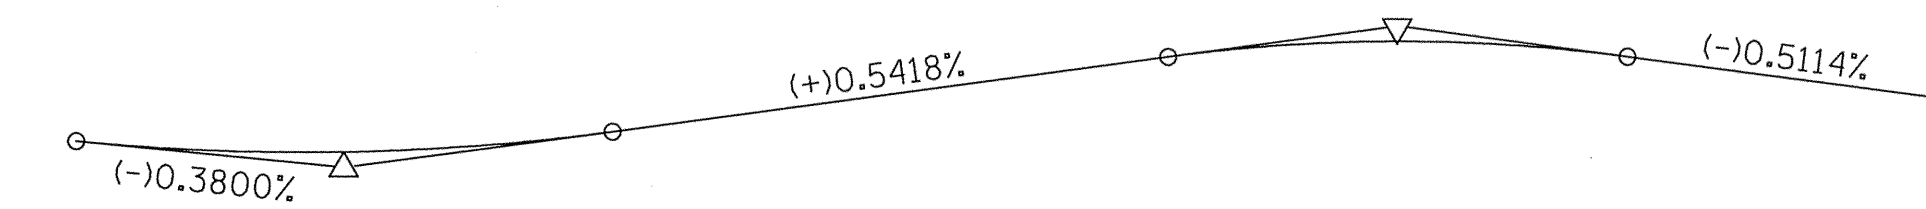

NOTES: PILES NOT SHOWN FOR CLARITY.  
WORKLINE FOR BRIDGE SHALL BE THE ROADWAY LONG CHORD BETWEEN FILL FACE WORK POINTS AND ITS EXTENSION.

**CURVE DATA -L-**


|                                    |                                    |
|------------------------------------|------------------------------------|
| PI STA. = 13+22.18                 | PI STA. = 16+10.55                 |
| $\Delta = 9^{\circ}09'03.5''$ (RT) | $\Delta = 7^{\circ}47'49.0''$ (RT) |
| D = 4°48'53.2"                     | D = 2°01'02.8"                     |
| L = 190.06'                        | L = 386.47'                        |
| T = 95.23'                         | T = 193.54'                        |
| R = 1,190.00'                      | R = 2,840.00'                      |
|                                    | SE = .04                           |

I HEREBY CERTIFY THESE PLANS ARE AS-BUILT PLANS


PROJECT NO. 17BP.2.R.51  
GREENE COUNTY  
STATION: POC 14+81.00 -L-

SHEET 1 OF 2 REPLACES BRIDGE NO. 0034

STATE OF NORTH CAROLINA  
DEPARTMENT OF TRANSPORTATION  
RALEIGH  
GENERAL DRAWING  
FOR BRIDGE ON SR 1334  
OVER MIDDLE SWAMP OVERFLOW  
BETWEEN SR 1335  
AND US 13

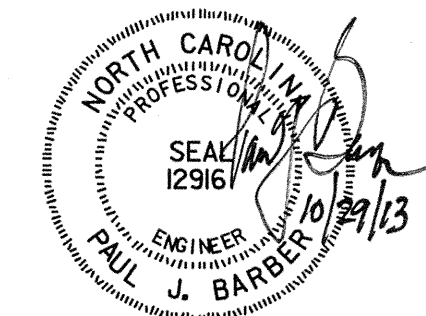

|             |           |  |      |           |    |                  |              |
|-------------|-----------|--|------|-----------|----|------------------|--------------|
| <b>HNTB</b> |           | HNTB NORTH CAROLINA, P.C.<br>NC License No. C-1554<br>343 E. Six Forks Rd., Suite 200, Raleigh, N.C. 27609 |      | REVISIONS |    | SHEET NO.<br>S-1 |              |
| DRAWN BY    | J. BAYNE  | DATE   | 6/13 | NO.       | BY | DATE             | TOTAL SHEETS |
| CHECKED BY  | P. BARBER | DATE   | 6/13 | 1         |    |                  | 17           |
|             |           |  |      | 2         |    |                  |              |
|             |           |  |      | 3         |    |                  |              |
|             |           |  |      | 4         |    |                  |              |

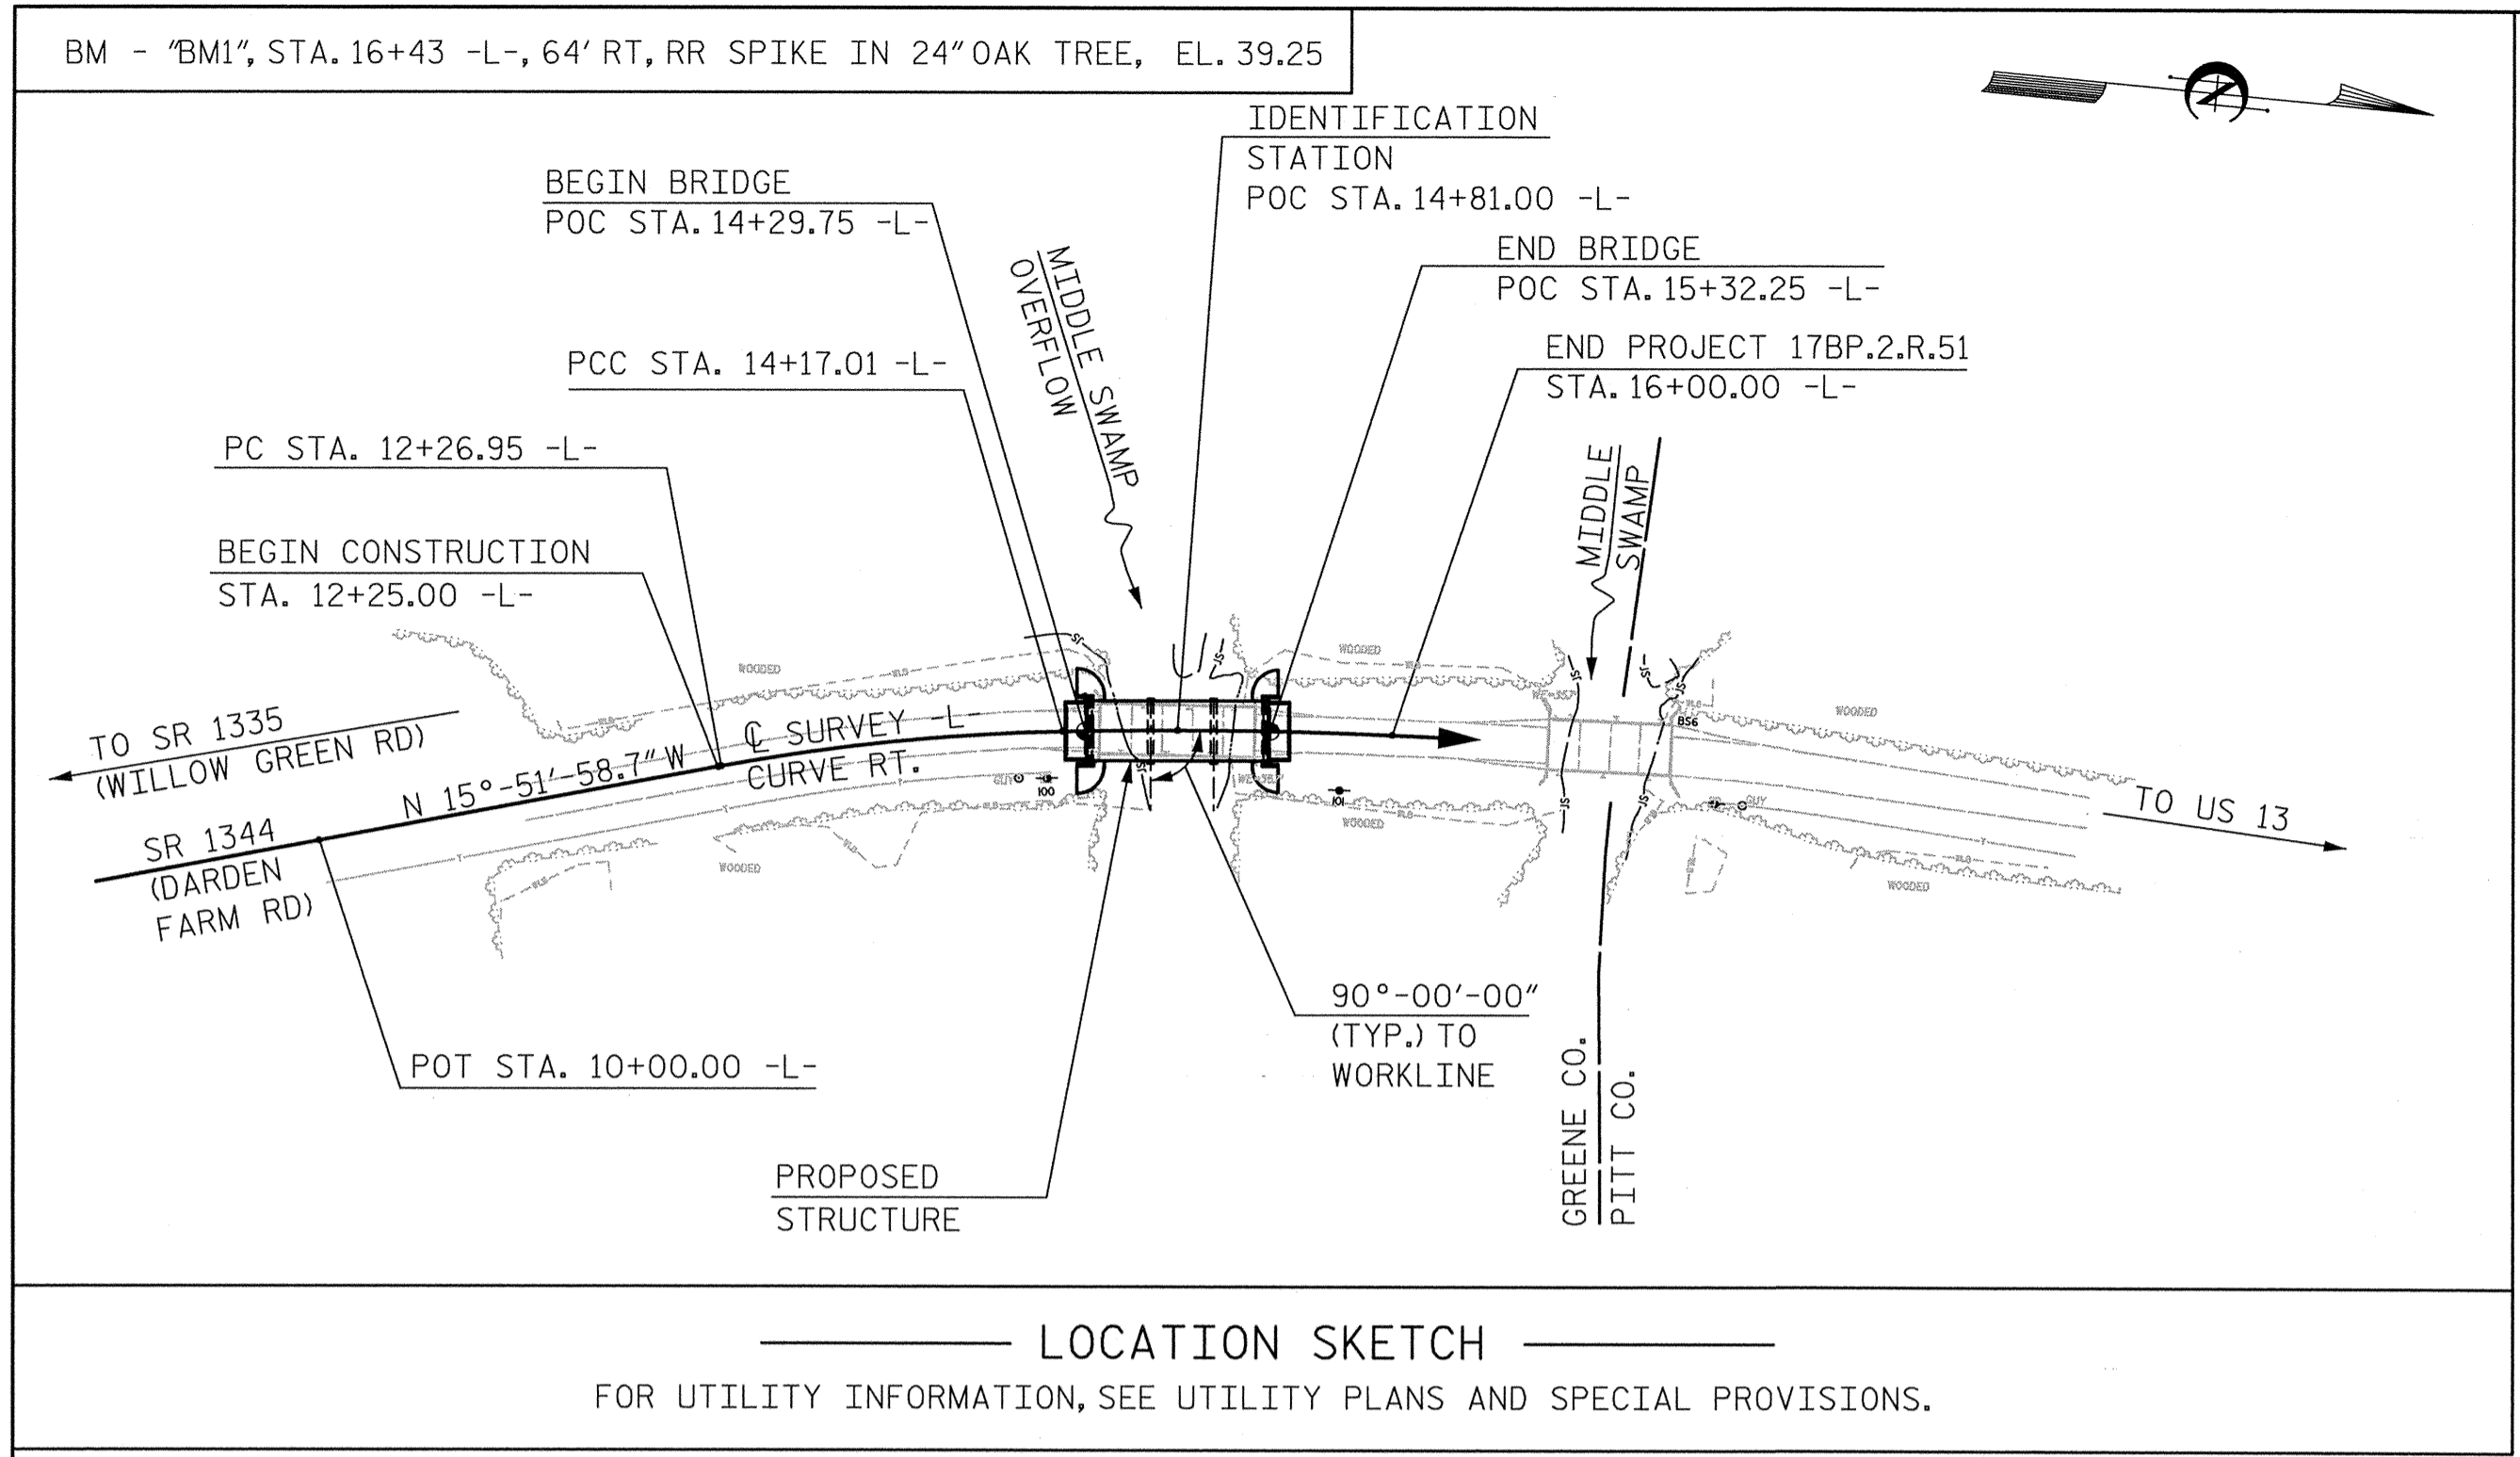

**FOUNDATION NOTES:**

FOR PILES, SEE SECTION 450 OF THE STANDARD SPECIFICATIONS.

PILES AT END BENT NO. 1 AND END BENT NO. 2 ARE DESIGNED FOR A FACTORED RESISTANCE OF 55 TONS PER PILE.

DRIVE PILES AT END BENT NO. 1 AND END BENT NO. 2 TO A REQUIRED DRIVING RESISTANCE OF 95 TONS PER PILE.

PILES AT BENT NO. 1 AND BENT NO. 2 ARE DESIGNED FOR A FACTORED RESISTANCE OF 90 TONS PER PILE.

DRIVE PILES AT BENT NO. 1 AND BENT NO. 2 TO A REQUIRED DRIVING RESISTANCE OF 160 TONS PER PILE. THIS REQUIRED DRIVING RESISTANCE INCLUDES ADDITIONAL RESISTANCE FOR DOWNDRAW OR SCOUR.

INSTALL PILES AT BENT NO. 1 AND BENT NO. 2 TO A TIP ELEVATION NO HIGHER THAN 8 FT.

THE SCOUR CRITICAL ELEVATION FOR BENT NO. 1 AND BENT NO. 2 IS ELEVATION 25 FT. SCOUR CRITICAL ELEVATIONS ARE USED TO MONITOR POSSIBLE SCOUR PROBLEMS DURING THE LIFE OF THE STRUCTURE.

TESTING PILES WITH THE PILE DRIVING ANALYZER (PDA) DURING DRIVING, RESTRIKING OR REDRIVING MAY BE REQUIRED. THE ENGINEER WILL DETERMINE THE NEED FOR PDA TESTING. FOR PDA TESTING, SEE SECTION 450 OF THE STANDARD SPECIFICATIONS AND FOR PILE DRIVING CRITERIA, SEE PILE DRIVING CRITERIA PROVISION.

| TOTAL BILL OF MATERIAL |   |             |   |                  |   |                   |                      |          |                                 |          |               |                                |                                |                         |                      |  |          |
|------------------------|---|-------------|---|------------------|---|-------------------|----------------------|----------|---------------------------------|----------|---------------|--------------------------------|--------------------------------|-------------------------|----------------------|--|----------|
|                        | REMOVAL OF EXISTING STRUCTURE AT STATION 14+81.00 -L- | PDA TESTING | UNCLASSIFIED STRUCTURE EXCAVATION AT STATION 14+81.00 -L- | CLASS A CONCRETE | BRIDGE APPROACH SLABS AT STATION 14+81.00 -L- | REINFORCING STEEL | HP 12x53 STEEL PILES |          | HP 14x73 GALVANIZED STEEL PILES |          | PILE REDRIVES | VERTICAL CONCRETE BARRIER RAIL | RIP RAP CLASS II (2'-0" THICK) | GEOTEXTILE FOR DRAINAGE | ELASTOMERIC BEARINGS | 3'-0"x1'-9" PRESTRESSED CONCRETE CORED SLABS |          |
|                        | LUMP SUM  | EACH        | LUMP SUM  | CU. YDS.         | LUMP SUM                                      | LBS.              | NO.                  | LIN. FT. | NO.                             | LIN. FT. | EACH          | LIN. FT.                       | TONS                           | SQ. YDS.                | LUMP SUM             | NO.  | LIN. FT. |
| SUPERSTRUCTURE         | LUMP SUM  |             |   |                  | LUMP SUM                                      |                   |                      |          |                                 |          |               | 200.75                         |                                |                         | LUMP SUM             | 33   | 1,100    |
| END BENT NO. 1         |   |             | LUMP SUM  | 14.3             |   | 2,127             | 7                    | 385      |                                 |          | 4             |                                | 98                             | 109                     |                      |  |          |
| BENT NO. 1             |   |             |   | 10.8             |   | 2,162             |                      |          | 8                               | 440      | 4             |                                |                                |                         |                      |  |          |
| BENT NO. 2             |   |             |   | 10.8             |   | 2,162             |                      |          | 8                               | 440      | 4             |                                |                                |                         |                      |  |          |
| END BENT NO. 2         |   |             | LUMP SUM  | 14.3             |   | 2,127             | 7                    | 385      |                                 |          | 4             |                                | 99                             | 110                     |                      |  |          |
| TOTAL                  | LUMP SUM  | 1           | LUMP SUM  | 50.2             | LUMP SUM                                      | 8,578             | 14                   | 770      | 16                              | 880      | 16            | 200.75                         | 197                            | 219                     | LUMP SUM             | 33   | 1,100    |

**GENERAL NOTES**

ASSUMED LIVE LOAD = HL-93 OR ALTERNATE LOADING.

THIS BRIDGE HAS BEEN DESIGNED IN ACCORDANCE WITH THE AASHTO LRFD BRIDGE DESIGN SPECIFICATIONS.

THIS BRIDGE IS LOCATED IN SEISMIC ZONE 1.

THIS BRIDGE SHALL BE CONSTRUCTED USING TOP-DOWN CONSTRUCTION METHODS. THE USE OF A TEMPORARY CAUSEWAY OR WORK BRIDGE IS NOT PERMITTED.

FOR OTHER DESIGN DATA AND GENERAL NOTES, SEE SHEET SN.

FOR SUBMITTAL OF WORKING DRAWINGS, SEE SPECIAL PROVISIONS.

FOR FALSEWORK AND FORMWORK, SEE SPECIAL PROVISIONS.

FOR CRANE SAFETY, SEE SPECIAL PROVISIONS.

FOR GROUT FOR STRUCTURES, SEE SPECIAL PROVISIONS.

THE MATERIAL SHOWN IN THE CROSS-HATCHED AREA SHALL BE EXCAVATED FOR A DISTANCE OF 19'-6" FT. EACH SIDE OF CENTERLINE ROADWAY AS DIRECTED BY THE ENGINEER. THIS WORK WILL BE PAID FOR AT THE CONTRACT LUMP SUM PRICE FOR UNCLASSIFIED STRUCTURE EXCAVATION. SEE SECTION 412 OF THE STANDARD SPECIFICATIONS.

THE EXISTING 5 SPAN STRUCTURE WITH SPAN LENGTHS OF 17'-10", 17'-1", 16'-10", 17'-1" AND 17'-9" WITH REINFORCED CONCRETE DECK AND TIMBER JOISTS WITH A 29'-4" OUT TO OUT DECK WIDTH ON TIMBER CAPS AND TIMBER PILES SHALL BE REMOVED. IN ADDITION, ANY PILES REMAINING FROM PREVIOUS BRIDGE CONSTRUCTION OR MAINTENANCE OPERATIONS SHALL BE REMOVED AND INCLUDED IN THE LUMP SUM PAY ITEM FOR "REMOVAL OF EXISTING STRUCTURE AT STATION 14+81.00 -L-".

THE SUBSTRUCTURE OF THE EXISTING BRIDGE INDICATED ON THE PLANS IS FROM THE BEST INFORMATION AVAILABLE. SINCE THIS INFORMATION IS SHOWN FOR THE CONVENIENCE OF THE CONTRACTOR, THE CONTRACTOR SHALL HAVE NO CLAIM WHATSOEVER AGAINST THE DEPARTMENT OF TRANSPORTATION FOR ANY DELAYS OR ADDITIONAL COST INCURRED BASED ON DIFFERENCES BETWEEN THE EXISTING BRIDGE SUBSTRUCTURE SHOWN ON THE PLANS AND THE ACTUAL CONDITIONS AT THE PROJECT SITE.

REMOVAL OF THE EXISTING BRIDGE SHALL BE PERFORMED SO AS NOT TO ALLOW DEBRIS TO FALL INTO THE WATER. THE CONTRACTOR SHALL REMOVE THE BRIDGE AND SUBMIT PLANS FOR DEMOLITION IN ACCORDANCE WITH ARTICLE 402-2 OF THE STANDARD SPECIFICATIONS.

THIS STRUCTURE HAS BEEN DESIGNED IN ACCORDANCE WITH "HEC 18-EVALUATING SCOUR AT BRIDGES".

FOR INTERIOR BENTS 1 AND 2, ONLY PARTIAL GALVANIZING OF THE PILES IS REQUIRED. SEE INTERIOR BENT SHEETS FOR REQUIRED GALVANIZED LENGTHS. PAYMENT FOR PARTIALLY GALVANIZED PILES WILL BE MADE UNDER THE CONTRACT UNIT PRICE FOR GALVANIZED STEEL PILES.


FOR EROSION CONTROL MEASURES SEE EROSION CONTROL PLANS.

ASPHALT WEARING SURFACE IS INCLUDED IN ROADWAY QUANTITY ON ROADWAY PLANS.

PROJECT NO. 17BP.2.R.51  
GREENE COUNTY  
 STATION: POC 14+81.00 -L-

SHEET 2 OF 2

STATE OF NORTH CAROLINA  
 DEPARTMENT OF TRANSPORTATION  
 RALEIGH  
 GENERAL DRAWING  
 FOR BRIDGE ON SR 1334  
 OVER MIDDLE SWAMP OVERFLOW  
 BETWEEN SR 1335  
 AND US 13

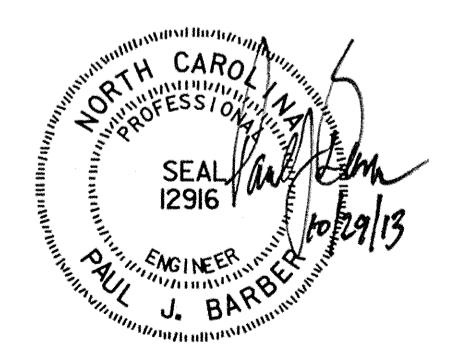

|   |            |    |      |     |    |                    |                  |
|---|------------|----|------|-----|----|--------------------|------------------|
| <b>HNTB</b><br>HNTB NORTH CAROLINA, P.C.<br>NC License No. C-1554<br>343 E. Six Forks Rd., Suite 200, Raleigh, N.C. 27609 | REVISIONS  |    |      |     |    |                    | SHEET NO.<br>S-2 |
|   | NO.        | BY | DATE | NO. | BY | DATE               |                  |
|   | 1          |    |      | 3   |    |                    |                  |
| DRAWN BY <u>J. BAYNE</u> DATE <u>6/13</u><br>CHECKED BY <u>P. BARBER</u> DATE <u>6/13</u>                                 | DWG. NO. 2 | 2  | 4    |     |    | TOTAL SHEETS<br>17 |                  |

LOAD AND RESISTANCE FACTOR RATING (LRFD) SUMMARY FOR PRESTRESSED CONCRETE GIRDERS

| LEVEL                    | VEHICLE    | WEIGHT (W)<br>(TONS) | CONTROLLING<br>LOAD RATING | MINIMUM<br>RATING FACTORS<br>(RF) | TONS = W X RF | STRENGTH I LIMIT STATE |                              |               |      |                 |   |                              |               |      |                 | SERVICE III LIMIT STATE                   |                     |                              |               |             | COMMENT NUMBER |                 |   |  |
|--------------------------|------------|----------------------|----------------------------|-----------------------------------|---------------|------------------------|------------------------------|---------------|------|-----------------|---|------------------------------|---------------|------|-----------------|---|---------------------|------------------------------|---------------|-------------|----------------|-----------------|---|--|
|                          |            |                      |                            |                                   |               | MOMENT                 |                              |               |      |                 | SHEAR                                     |                              |               |      |                 | MOMENT                                    |                     |                              |               |             |                |                 |   |  |
|                          |            |                      |                            |                                   |               | LIVELOAD<br>FACTORS    | DISTRIBUTION<br>FACTORS (DF) | RATING FACTOR | SPAN | GIRDER LOCATION | DISTANCE FROM<br>LEFT END OF<br>SPAN (ft) | DISTRIBUTION<br>FACTORS (DF) | RATING FACTOR | SPAN | GIRDER LOCATION | DISTANCE FROM<br>LEFT END OF<br>SPAN (ft) | LIVELOAD<br>FACTORS | DISTRIBUTION<br>FACTORS (DF) | RATING FACTOR | SPAN        |                | GIRDER LOCATION | DISTANCE FROM<br>LEFT END OF<br>SPAN (ft) |  |
| DESIGN<br>LOAD<br>RATING | HL-93(Inv) | N/A                  | 1                          | 1.032                             | --            | 1.75                   | 0.28                         | 1.36          | 35'  | EL              | 17  | 0.561                        | <b>1.03</b>   | 35'  | EL              | <b>1.7</b>                                | 0.80                | 0.28                         | 1.05          | 35'         | EL             | 17              |   |  |
|                          | HL-93(Opr) | N/A                  | --                         | 1.338                             | --            | 1.35                   | 0.28                         | 1.77          | 35'  | EL              | 17  | 0.561                        | 1.34          | 35'  | EL              | 1.7                                       | N/A                 | --                           | --            | --          | --             | --              |   |  |
|                          | HS-20(Inv) | 36.000               | 2                          | 1.189                             | 42.810        | 1.75                   | 0.28                         | 1.79          | 35'  | EL              | 13.6                                      | 0.561                        | <b>1.19</b>   | 35'  | EL              | <b>1.7</b>                                | 0.80                | 0.28                         | 1.39          | 35'         | EL             | 17              |   |  |
|                          | HS-20(Opr) | 36.000               | --                         | 1.542                             | 55.494        | 1.35                   | 0.28                         | 2.32          | 35'  | EL              | 13.6                                      | 0.561                        | 1.54          | 35'  | EL              | 1.7                                       | N/A                 | --                           | --            | --          | --             | --              |   |  |
| LEGAL<br>LOAD<br>RATING  | SV         | SNSH                 | 13.500                     | --                                | 2.400         | 32.402                 | 1.4                          | 0.28          | 3.89 | 35'             | EL  | 17                           | 0.561         | 3.06 | 35'             | EL  | 1.7                 | 0.80                         | 0.28          | 2.40        | 35'            | EL              | 17  |  |
|                          |            | SNGARBS2             | 20.000                     | --                                | 2.052         | 41.044                 | 1.4                          | 0.28          | 3.29 | 35'             | EL  | 13.6                         | 0.561         | 2.32 | 35'             | EL  | 1.7                 | 0.80                         | 0.28          | 2.05        | 35'            | EL              | 13.6                                      |  |
|                          |            | SNAGRIS2             | 22.000                     | --                                | 2.053         | 45.174                 | 1.4                          | 0.28          | 3.26 | 35'             | EL  | 13.6                         | 0.561         | 2.21 | 35'             | EL  | 1.7                 | 0.80                         | 0.28          | 2.05        | 35'            | EL              | 13.6                                      |  |
|                          |            | SNCOTTS3             | 27.250                     | --                                | 1.202         | 32.744                 | 1.4                          | 0.28          | 1.95 | 35'             | EL  | 17                           | 0.561         | 1.54 | 35'             | EL  | 1.7                 | 0.80                         | 0.28          | 1.20        | 35'            | EL              | 17  |  |
|                          |            | SNAGGRS4             | 34.925                     | --                                | 1.111         | 38.816                 | 1.4                          | 0.28          | 1.8  | 35'             | EL  | 17                           | 0.561         | 1.38 | 35'             | EL  | 1.7                 | 0.80                         | 0.28          | 1.11        | 35'            | EL              | 17  |  |
|                          |            | SNS5A                | 35.550                     | --                                | 1.079         | 38.354                 | 1.4                          | 0.28          | 1.75 | 35'             | EL  | 17                           | 0.561         | 1.46 | 35'             | EL  | 1.7                 | 0.80                         | 0.28          | 1.08        | 35'            | EL              | 17  |  |
|                          |            | SNS6A                | 39.950                     | --                                | 1.041         | 41.601                 | 1.4                          | 0.28          | 1.69 | 35'             | EL  | 17                           | 0.561         | 1.37 | 35'             | EL  | 1.7                 | 0.80                         | 0.28          | 1.04        | 35'            | EL              | 17  |  |
|                          | TTST       | SNS7B                | 42.000                     | 3                                 | 1.000         | 41.734                 | 1.4                          | 0.28          | 1.61 | 35'             | EL  | 17                           | 0.561         | 1.4  | 35'             | EL  | 1.7                 | 0.80                         | 0.28          | <b>1.00</b> | 35'            | EL              | <b>17</b>                                 |  |
|                          |            | TNAGRIT3             | 33.000                     | --                                | 1.286         | 42.439                 | 1.4                          | 0.28          | 2.08 | 35'             | EL  | 17                           | 0.561         | 1.6  | 35'             | EL  | 1.7                 | 0.80                         | 0.28          | 1.29        | 35'            | EL              | 17  |  |
|                          |            | TNT4A                | 33.075                     | --                                | 1.285         | 42.512                 | 1.4                          | 0.28          | 2.08 | 35'             | EL  | 17                           | 0.561         | 1.51 | 35'             | EL  | 1.7                 | 0.80                         | 0.28          | 1.29        | 35'            | EL              | 17  |  |
|                          |            | TNT6A                | 41.600                     | --                                | 1.126         | 46.84                  | 1.4                          | 0.28          | 1.82 | 35'             | EL  | 17                           | 0.561         | 1.48 | 35'             | EL  | 1.7                 | 0.80                         | 0.28          | 1.13        | 35'            | EL              | 17  |  |
|                          |            | TNT7A                | 42.000                     | --                                | 1.163         | 48.833                 | 1.4                          | 0.28          | 1.89 | 35'             | EL  | 17                           | 0.561         | 1.37 | 35'             | EL  | 1.7                 | 0.80                         | 0.28          | 1.16        | 35'            | EL              | 17  |  |
|                          |            | TNT7B                | 42.000                     | --                                | 1.144         | 48.061                 | 1.4                          | 0.28          | 1.85 | 35'             | EL  | 17                           | 0.561         | 1.33 | 35'             | EL  | 1.7                 | 0.80                         | 0.28          | 1.14        | 35'            | EL              | 17  |  |
|                          |            | TNAGRIT4             | 43.000                     | --                                | 1.158         | 49.810                 | 1.4                          | 0.28          | 1.86 | 35'             | EL  | 13.6                         | 0.561         | 1.28 | 35'             | EL  | 1.7                 | 0.80                         | 0.28          | 1.16        | 35'            | EL              | 17  |  |
| TNAGT5A                  | 45.000     | --                   | 1.068                      | 48.071                            | 1.4           | 0.28                   | 1.73                         | 35'           | EL   | 17              | 0.561                                     | 1.35                         | 35'           | EL   | 1.7             | 0.80                                      | 0.28                | 1.07                         | 35'           | EL          | 17             |                 |   |  |
| TNAGT5B                  | 45.000     | --                   | 1.031                      | 46.373                            | 1.4           | 0.28                   | 1.67                         | 35'           | EL   | 17              | 0.561                                     | 1.21                         | 35'           | EL   | 1.7             | 0.80                                      | 0.28                | 1.03                         | 35'           | EL          | 17             |                 |   |  |

LOAD FACTORS:

|                                     |             |               |               |
|-------------------------------------|-------------|---------------|---------------|
| DESIGN<br>LOAD<br>RATING<br>FACTORS | LIMIT STATE | $\gamma_{DC}$ | $\gamma_{DW}$ |
|                                     | STRENGTH I  | 1.25          | 1.50          |
|                                     | SERVICE III | 1.00          | 1.00          |

NOTES:

MINIMUM RATING FACTORS ARE BASED ON THE STRENGTH I AND SERVICE III LIMIT STATES.

ALLOWABLE STRESSES FOR SERVICE III LIMIT STATE ARE AS REQUIRED FOR DESIGN.

COMMENTS:

- 1.
- 2.
- 3.
- 4.

# CONTROLLING LOAD RATING

1 DESIGN LOAD RATING (HL-93)

2 DESIGN LOAD RATING (HS-20)


3 LEGAL LOAD RATING \*\*

\*\* SEE CHART FOR VEHICLE TYPE

---


GIRDER LOCATION

I - INTERIOR GIRDER  
EL - EXTERIOR LEFT GIRDER  
ER - EXTERIOR RIGHT GIRDER

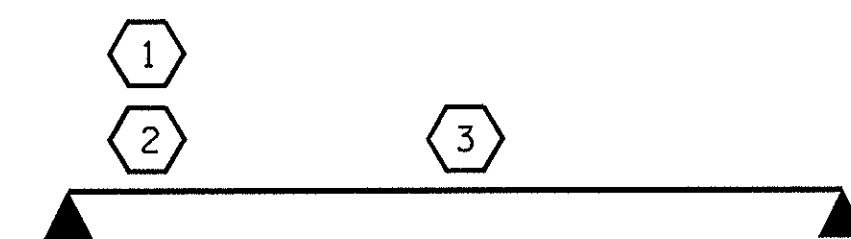

LRFR SUMMARY  
FOR SPAN 'A & B'

PROJECT NO. 17BP.2.R.51  
GREENE COUNTY  
 STATION: 14+81.00 -L-

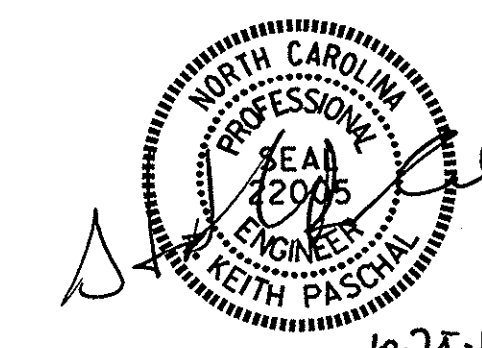

STATE OF NORTH CAROLINA  
 DEPARTMENT OF TRANSPORTATION  
 RALEIGH  
 STANDARD  
 LRFR SUMMARY FOR  
 35' CORED SLAB UNIT  
 90° SKEW  
 (NON-INTERSTATE TRAFFIC)

| REVISIONS |     |       |     |     |       | SHEET NO.    |
|-----------|-----|-------|-----|-----|-------|--------------|
| NO.       | BY: | DATE: | NO. | BY: | DATE: | S-3          |
| 1         |     |       | 3   |     |       | TOTAL SHEETS |
| 2         |     |       | 4   |     |       | 17           |

ASSEMBLED BY : A.H. SHIVELY DATE : 6/24/13  
 CHECKED BY : M.L. RORIE DATE : 7/22/13  
 DRAWN BY : CVC 6/10  
 CHECKED BY : DNS 6/10

LOAD AND RESISTANCE FACTOR RATING (LRFD) SUMMARY FOR PRESTRESSED CONCRETE GIRDERS

| LEVEL                    | VEHICLE    | WEIGHT (W)<br>(TONS) | CONTROLLING<br>LOAD RATING | MINIMUM<br>RATING FACTORS<br>(RF) | TONS = W X RF | STRENGTH I LIMIT STATE |                              |               |      |                 |   |                              |               |      |                 | SERVICE III LIMIT STATE                   |                     |                              |               |      | COMMENT NUMBER |                 |   |  |
|--------------------------|------------|----------------------|----------------------------|-----------------------------------|---------------|------------------------|------------------------------|---------------|------|-----------------|---|------------------------------|---------------|------|-----------------|---|---------------------|------------------------------|---------------|------|----------------|-----------------|---|--|
|                          |            |                      |                            |                                   |               | MOMENT                 |                              |               |      |                 | SHEAR                                     |                              |               |      |                 | MOMENT                                    |                     |                              |               |      |                |                 |   |  |
|                          |            |                      |                            |                                   |               | LIVELOAD<br>FACTORS    | DISTRIBUTION<br>FACTORS (DF) | RATING FACTOR | SPAN | GIRDER LOCATION | DISTANCE FROM<br>LEFT END OF<br>SPAN (ft) | DISTRIBUTION<br>FACTORS (DF) | RATING FACTOR | SPAN | GIRDER LOCATION | DISTANCE FROM<br>LEFT END OF<br>SPAN (ft) | LIVELOAD<br>FACTORS | DISTRIBUTION<br>FACTORS (DF) | RATING FACTOR | SPAN |                | GIRDER LOCATION | DISTANCE FROM<br>LEFT END OF<br>SPAN (ft) |  |
| DESIGN<br>LOAD<br>RATING | HL-93(Inv) | N/A                  | 1                          | 1.037                             | --            | 1.75                   | 0.283                        | 1.83          | 30'  | EL              | 14.5                                      | 0.574                        | <b>1.04</b>   | 30'  | EL              | <b>1.45</b>                               | 0.80                | 0.283                        | 1.58          | 30'  | EL             | 14.5            |   |  |
|                          | HL-93(Opr) | N/A                  | --                         | 1.344                             | --            | 1.35                   | 0.283                        | 2.38          | 30'  | EL              | 14.5                                      | 0.574                        | 1.34          | 30'  | EL              | 1.45                                      | N/A                 | --                           | --            | --   | --             | --              |   |  |
|                          | HS-20(Inv) | 36.000               | 2                          | 1.183                             | 42.587        | 1.75                   | 0.283                        | 2.53          | 30'  | EL              | 11.6                                      | 0.574                        | <b>1.18</b>   | 30'  | EL              | <b>1.45</b>                               | 0.80                | 0.283                        | 2.20          | 30'  | EL             | 11.6            |   |  |
|                          | HS-20(Opr) | 36.000               | --                         | 1.533                             | 55.205        | 1.35                   | 0.283                        | 3.28          | 30'  | EL              | 11.6                                      | 0.574                        | 1.53          | 30'  | EL              | 1.45                                      | N/A                 | --                           | --            | --   | --             | --              |   |  |
| LEGAL<br>LOAD<br>RATING  | SV         | SNSH                 | 13.500                     | --                                | 2.895         | 39.081                 | 1.4                          | 0.283         | 5.18 | 30'             | EL  | 14.5                         | 0.574         | 2.89 | 30'             | EL  | 1.45                | 0.80                         | 0.283         | 3.56 | 30'            | EL              | 14.5                                      |  |
|                          |            | SNGARBS2             | 20.000                     | --                                | 2.240         | 44.792                 | 1.4                          | 0.283         | 4.53 | 30'             | EL  | 11.6                         | 0.574         | 2.24 | 30'             | EL  | 1.45                | 0.80                         | 0.283         | 3.15 | 30'            | EL              | 11.6                                      |  |
|                          |            | SNAGRIS2             | 22.000                     | --                                | 2.157         | 47.463                 | 1.4                          | 0.283         | 4.6  | 30'             | EL  | 11.6                         | 0.574         | 2.16 | 30'             | EL  | 1.45                | 0.80                         | 0.283         | 3.20 | 30'            | EL              | 11.6                                      |  |
|                          |            | SNCOTTS3             | 27.250                     | --                                | 1.462         | 39.849                 | 1.4                          | 0.283         | 2.6  | 30'             | EL  | 14.5                         | 0.574         | 1.46 | 30'             | EL  | 1.45                | 0.80                         | 0.283         | 1.79 | 30'            | EL              | 14.5                                      |  |
|                          |            | SNAGGRS4             | 34.925                     | --                                | 1.346         | 46.999                 | 1.4                          | 0.283         | 2.5  | 30'             | EL  | 14.5                         | 0.574         | 1.35 | 30'             | EL  | 1.45                | 0.80                         | 0.283         | 1.72 | 30'            | EL              | 14.5                                      |  |
|                          |            | SNS5A                | 35.550                     | --                                | 1.427         | 50.733                 | 1.4                          | 0.283         | 2.42 | 30'             | EL  | 14.5                         | 0.574         | 1.43 | 30'             | EL  | 1.45                | 0.80                         | 0.283         | 1.67 | 30'            | EL              | 14.5                                      |  |
|                          |            | SNS6A                | 39.950                     | --                                | 1.341         | 53.59                  | 1.4                          | 0.283         | 2.29 | 30'             | EL  | 14.5                         | 0.574         | 1.34 | 30'             | EL  | 1.45                | 0.80                         | 0.283         | 1.58 | 30'            | EL              | 14.5                                      |  |
|                          | SNS7B      | 42.000               | --                         | 1.369                             | 57.505        | 1.4                    | 0.283                        | 2.23          | 30'  | EL              | 14.5                                      | 0.574                        | 1.37          | 30'  | EL              | 1.45                                      | 0.80                | 0.283                        | 1.53          | 30'  | EL             | 14.5            |   |  |
|                          | TTST       | TNAGRIT3             | 33.000                     | --                                | 1.593         | 52.58                  | 1.4                          | 0.283         | 2.97 | 30'             | EL  | 14.5                         | 0.574         | 1.59 | 30'             | EL  | 1.45                | 0.80                         | 0.283         | 2.04 | 30'            | EL              | 14.5                                      |  |
|                          |            | TNT4A                | 33.075                     | --                                | 1.483         | 49.043                 | 1.4                          | 0.283         | 2.82 | 30'             | EL  | 14.5                         | 0.574         | 1.48 | 30'             | EL  | 1.45                | 0.80                         | 0.283         | 1.94 | 30'            | EL              | 14.5                                      |  |
|                          |            | TNT6A                | 41.600                     | --                                | 1.433         | 59.622                 | 1.4                          | 0.283         | 2.56 | 30'             | EL  | 14.5                         | 0.574         | 1.43 | 30'             | EL  | 1.45                | 0.80                         | 0.283         | 1.76 | 30'            | EL              | 14.5                                      |  |
|                          |            | TNT7A                | 42.000                     | --                                | 1.363         | 57.264                 | 1.4                          | 0.283         | 2.64 | 30'             | EL  | 14.5                         | 0.574         | 1.36 | 30'             | EL  | 1.45                | 0.80                         | 0.283         | 1.82 | 30'            | EL              | 14.5                                      |  |
|                          |            | TNT7B                | 42.000                     | --                                | 1.331         | 55.915                 | 1.4                          | 0.283         | 2.49 | 30'             | EL  | 14.5                         | 0.574         | 1.33 | 30'             | EL  | 1.45                | 0.80                         | 0.283         | 1.72 | 30'            | EL              | 14.5                                      |  |
|                          |            | TNAGRIT4             | 43.000                     | --                                | 1.287         | 55.356                 | 1.4                          | 0.283         | 2.58 | 30'             | EL  | 14.5                         | 0.574         | 1.29 | 30'             | EL  | 1.45                | 0.80                         | 0.283         | 1.78 | 30'            | EL              | 14.5                                      |  |
| TNAGT5A                  |            | 45.000               | --                         | 1.381                             | 62.151        | 1.4                    | 0.283                        | 2.5           | 30'  | EL              | 14.5                                      | 0.574                        | 1.38          | 30'  | EL              | 1.45                                      | 0.80                | 0.283                        | 1.72          | 30'  | EL             | 14.5            |   |  |
| TNAGT5B                  | 45.000     | 3                    | 1.212                      | 54.54                             | 1.4           | 0.283                  | 2.41                         | 30'           | EL   | 11.6            | 0.574                                     | <b>1.21</b>                  | 30'           | EL   | <b>1.45</b>     | 0.80                                      | 0.283               | 1.66                         | 30'           | EL   | 11.6           |                 |   |  |

LOAD FACTORS:

|                                     |             |               |               |
|-------------------------------------|-------------|---------------|---------------|
| DESIGN<br>LOAD<br>RATING<br>FACTORS | LIMIT STATE | $\gamma_{DC}$ | $\gamma_{DW}$ |
|                                     | STRENGTH I  | 1.25          | 1.50          |
|                                     | SERVICE III | 1.00          | 1.00          |

NOTES:

MINIMUM RATING FACTORS ARE BASED ON THE STRENGTH I AND SERVICE III LIMIT STATES.

ALLOWABLE STRESSES FOR SERVICE III LIMIT STATE ARE AS REQUIRED FOR DESIGN.

COMMENTS:

- 1.
- 2.
- 3.
- 4.

# CONTROLLING LOAD RATING

1 DESIGN LOAD RATING (HL-93)

2 DESIGN LOAD RATING (HS-20)


3 LEGAL LOAD RATING \*\*

\*\* SEE CHART FOR VEHICLE TYPE

---


GIRDER LOCATION

I - INTERIOR GIRDER  
EL - EXTERIOR LEFT GIRDER  
ER - EXTERIOR RIGHT GIRDER

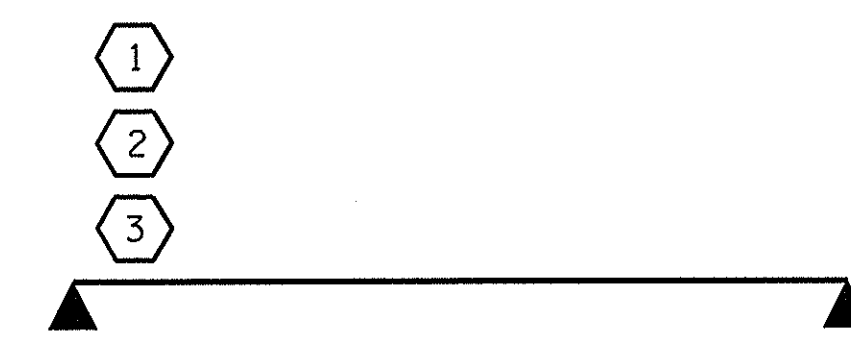

LRFR SUMMARY  
FOR SPAN 'C'


PROJECT NO. 17BP.2.R.51  
GREENE COUNTY  
 STATION: 14+81.00 -L-

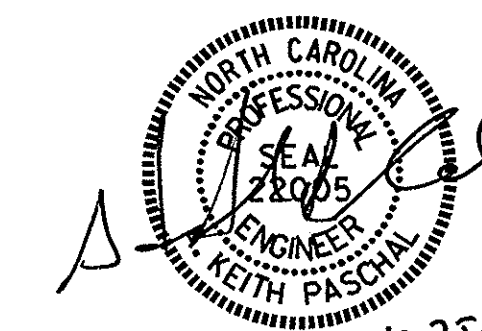

STATE OF NORTH CAROLINA  
 DEPARTMENT OF TRANSPORTATION  
 RALEIGH  
 STANDARD  
 LRFR SUMMARY FOR  
 30' CORED SLAB UNIT  
 90° SKEW  
 (NON-INTERSTATE TRAFFIC)

ASSEMBLED BY: A.H. SHIVELY DATE: 6/24/13  
 CHECKED BY: M.L. RORIE DATE: 7/22/13  
 DRAWN BY: CVC 6/10  
 CHECKED BY: DNS 6/10


| REVISIONS |     |       |     |     |       | SHEET NO.    |
|-----------|-----|-------|-----|-----|-------|--------------|
| NO.       | BY: | DATE: | NO. | BY: | DATE: | S-4          |
| 1         |     |       | 3   |     |       | TOTAL SHEETS |
| 2         |     |       | 4   |     |       | 17           |

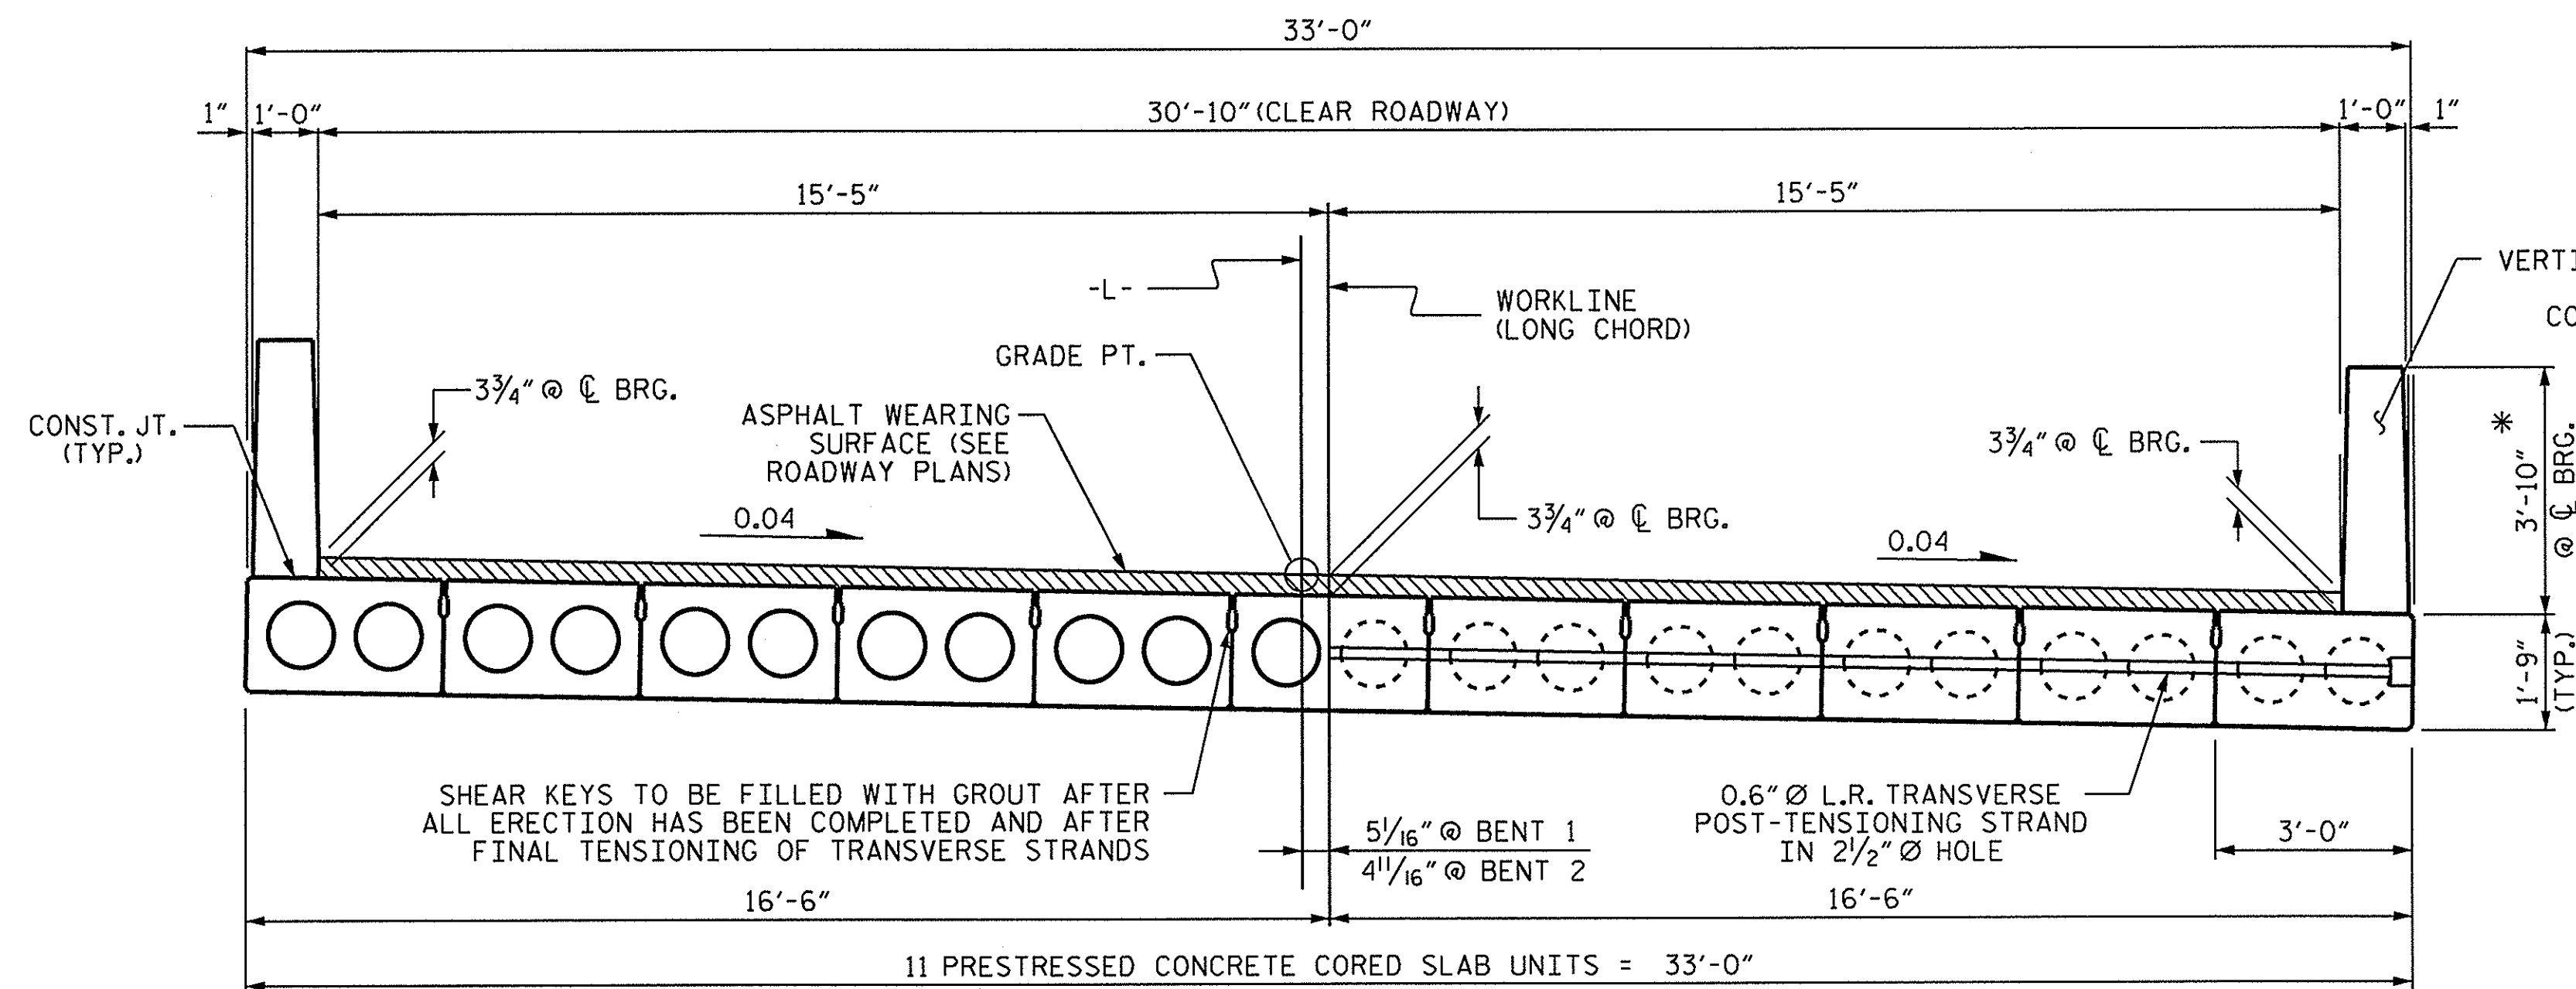

**TYPICAL SECTION**


\* - THE MAXIMUM BARRIER RAIL HEIGHT AND ASPHALT THICKNESS IS SHOWN. THE HEIGHT OF THE BARRIER RAIL AND ASPHALT THICKNESS VARIES WHILE THE TOP OF THE BARRIER RAIL FOLLOWS THE PROFILE OF THE GUTTERLINE. FOR RAIL HEIGHT DETAILS AND ASPHALT THICKNESS SEE THE "VERTICAL CONCRETE BARRIER RAIL SECTION" DETAIL.

**FIXED END**

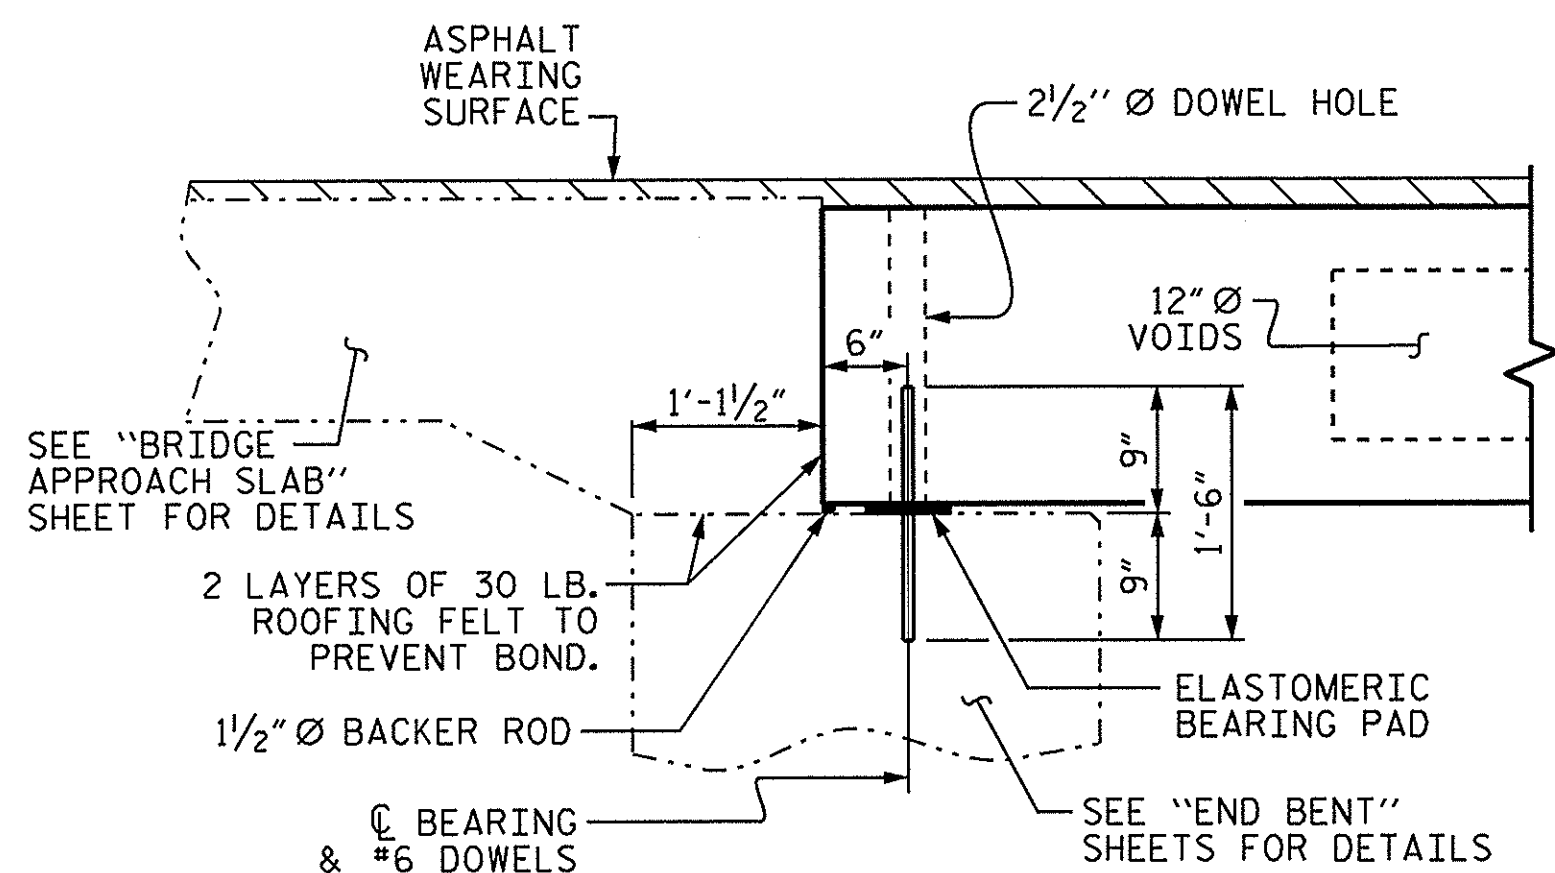


**SECTION AT END BENT**


**FIXED END**

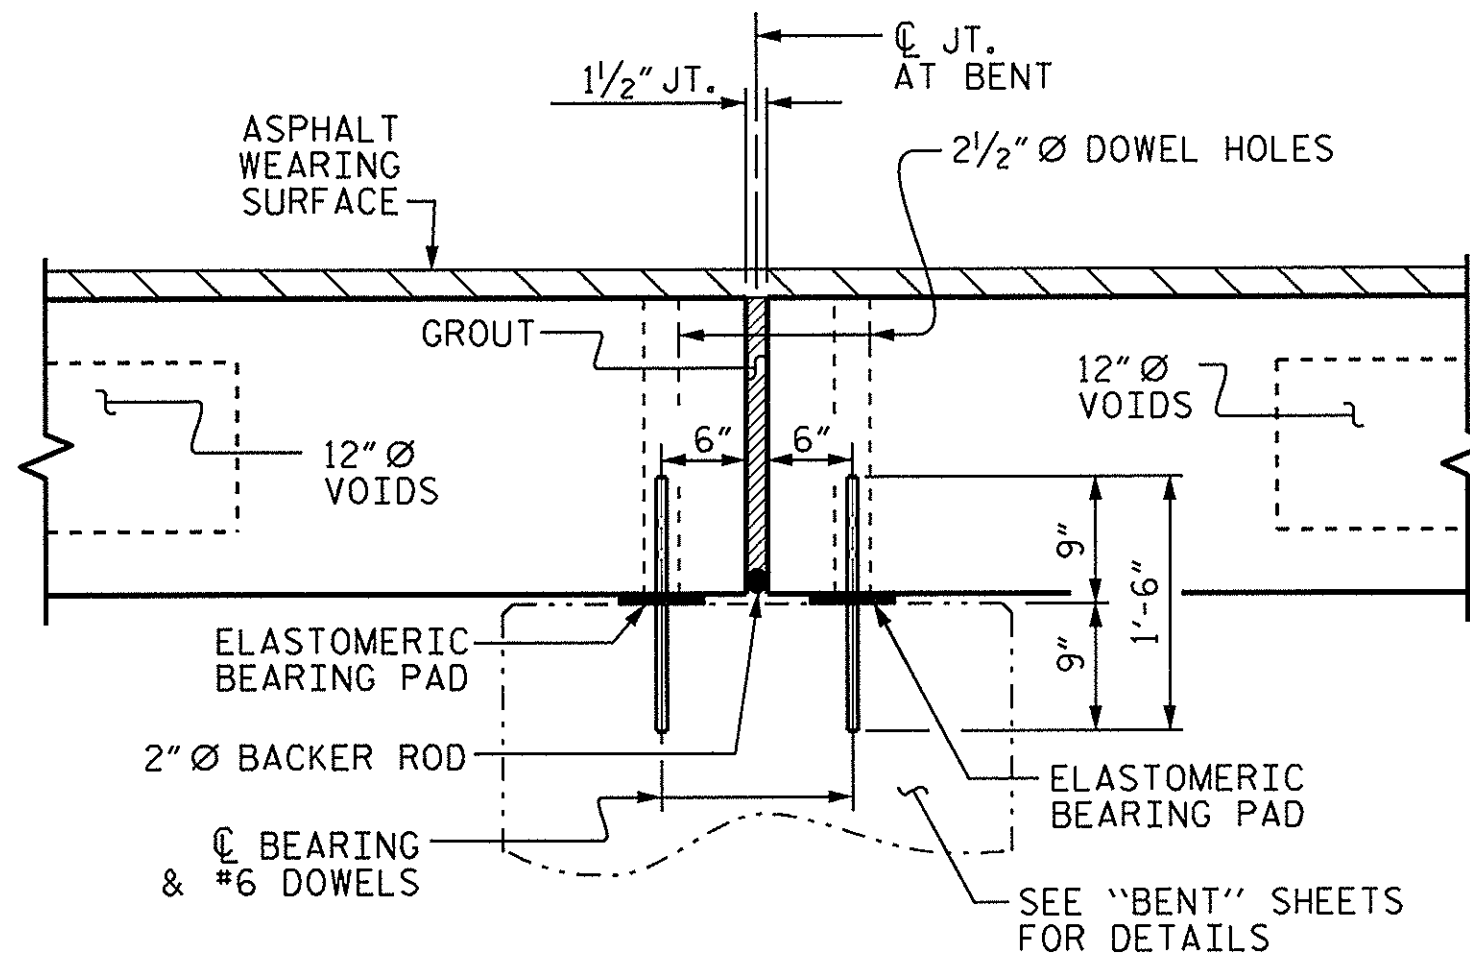

**SECTION AT BENT**

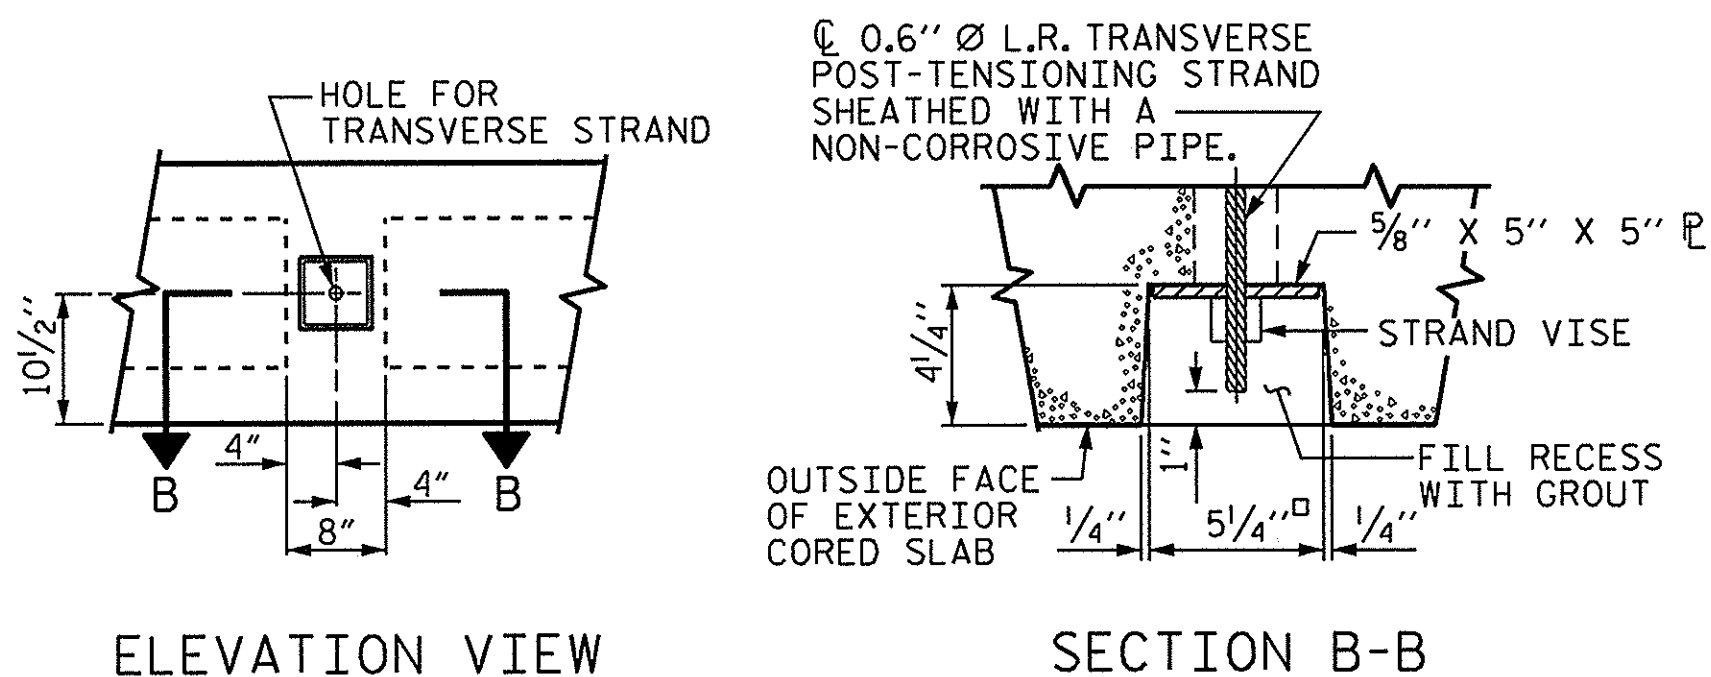


**GROUTED RECESS AT END OF POST-TENSIONED STRAND OF CORED SLABS**

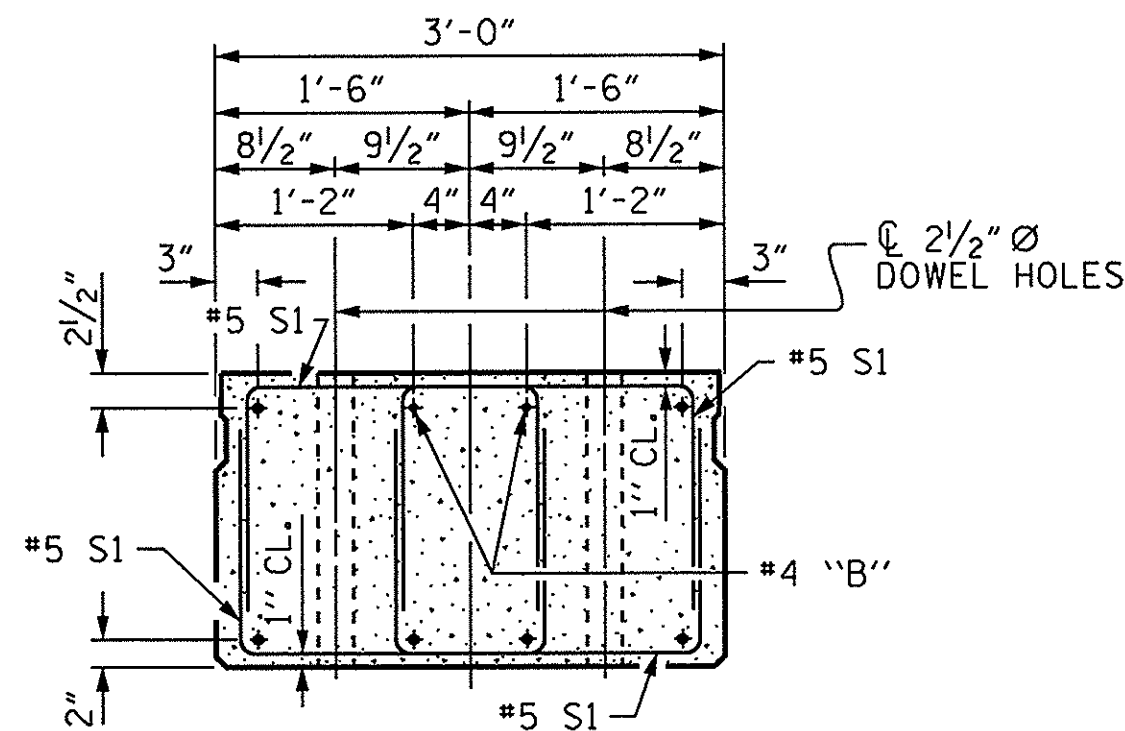


**END ELEVATION**

SHOWING PLACEMENT OF DOUBLE STIRRUPS AND LOCATION OF DOWEL HOLES. (STRAND LAYOUT NOT SHOWN.) INTERIOR SLAB UNIT SHOWN-EXTERIOR SLAB UNIT SIMILAR EXCEPT SHEAR KEY LOCATION.

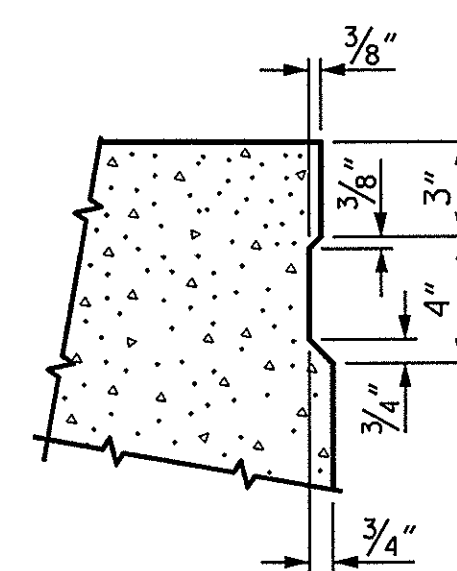


**SHEAR KEY DETAIL**

NOTE: OMIT SHEAR KEY ON OUTSIDE FACE OF EXTERIOR CORED SLABS.

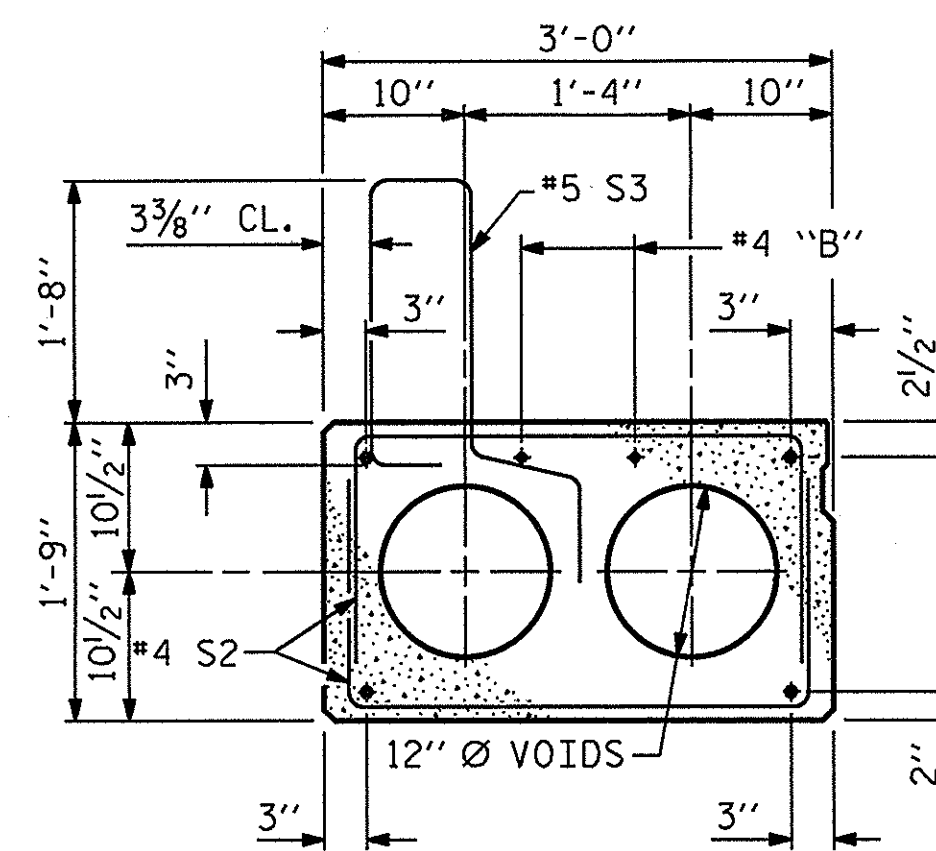

**EXT. SLAB SECTION**

(FOR PRESTRESSED STRAND LAYOUT, SEE INTERIOR SLAB SECTION.)

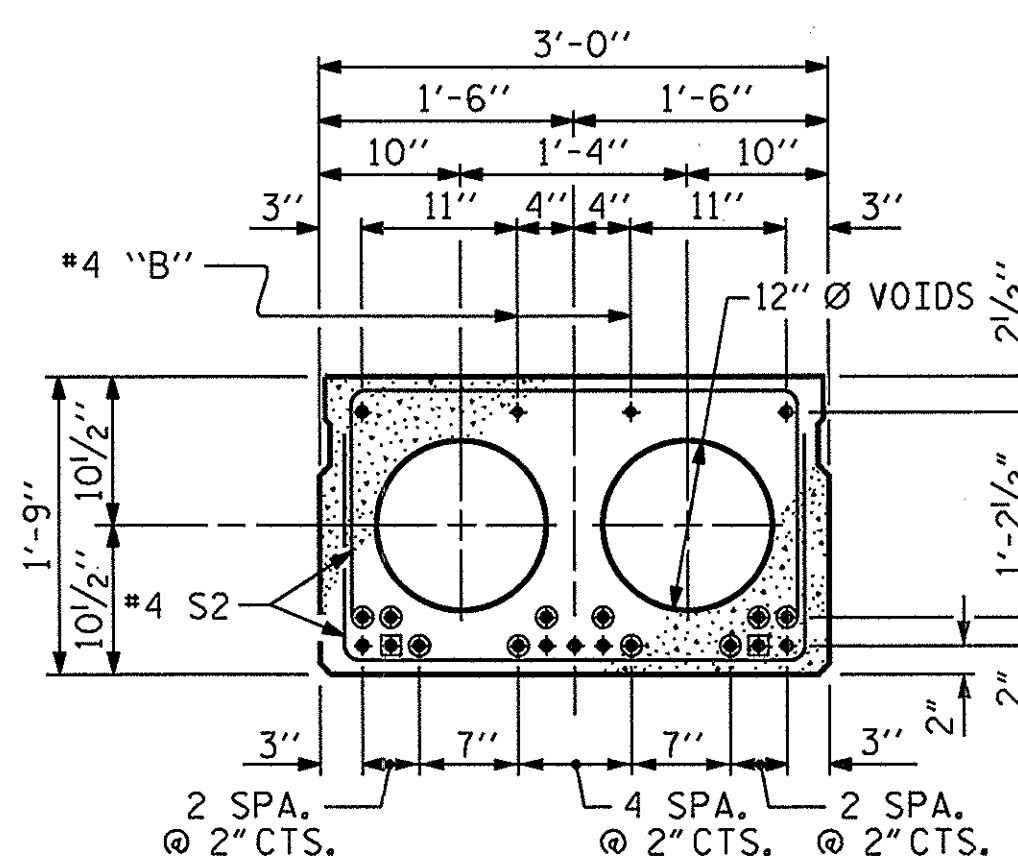

**INTERIOR SLAB SECTION (30' & 35' UNIT)**

**0.6" Ø LOW RELAXATION STRAND LAYOUT**


- ▲ BOND SHALL BE BROKEN ON THESE STRANDS FOR A DISTANCE OF 6'-0" FROM END OF CORED SLAB UNIT. SEE STANDARD SPECIFICATIONS, ARTICLE 1078-7.
- BOND SHALL BE BROKEN ON THESE STRANDS FOR A DISTANCE OF 2'-0" FROM END OF CORED SLAB UNIT. SEE STANDARD SPECIFICATIONS, ARTICLE 1078-7.
- OPTIONAL FULL LENGTH DEBONDED STRANDS. THESE STRANDS ARE NOT REQUIRED. IF THE FABRICATOR CHOOSES TO INCLUDE THESE STRANDS IN THE CORED SLAB UNIT, THE STRANDS SHALL BE DEBONDED FOR THE FULL LENGTH OF THE UNIT AT NO ADDITIONAL COST. SEE STANDARD SPECIFICATIONS, ARTICLE 1078-7.

**DEBONDING LEGEND**

PROJECT NO. 17BP.2.R.51  
 GREENE COUNTY  
 STATION: 14+81.00 -L-



SHEET 1 OF 4

STATE OF NORTH CAROLINA  
 DEPARTMENT OF TRANSPORTATION  
 RALEIGH  
 STANDARD  
 3'-0" X 1'-9"  
 PRESTRESSED CONCRETE  
 CORED SLAB UNIT  
 90° SKEW

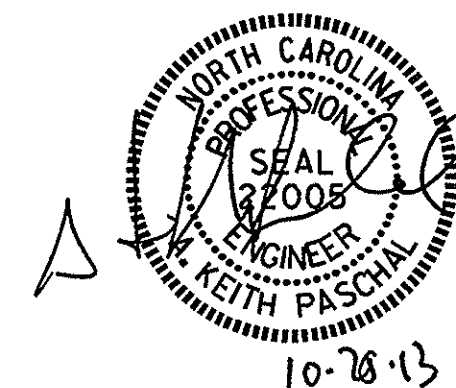

| REVISIONS |    |      |     |    |      | SHEET NO.    |
|-----------|----|------|-----|----|------|--------------|
| NO.       | BY | DATE | NO. | BY | DATE | S-5          |
| 1         |    |      | 3   |    |      | TOTAL SHEETS |
| 2         |    |      | 4   |    |      | 17           |

STD. NO. 21" PCS2\_33\_90S

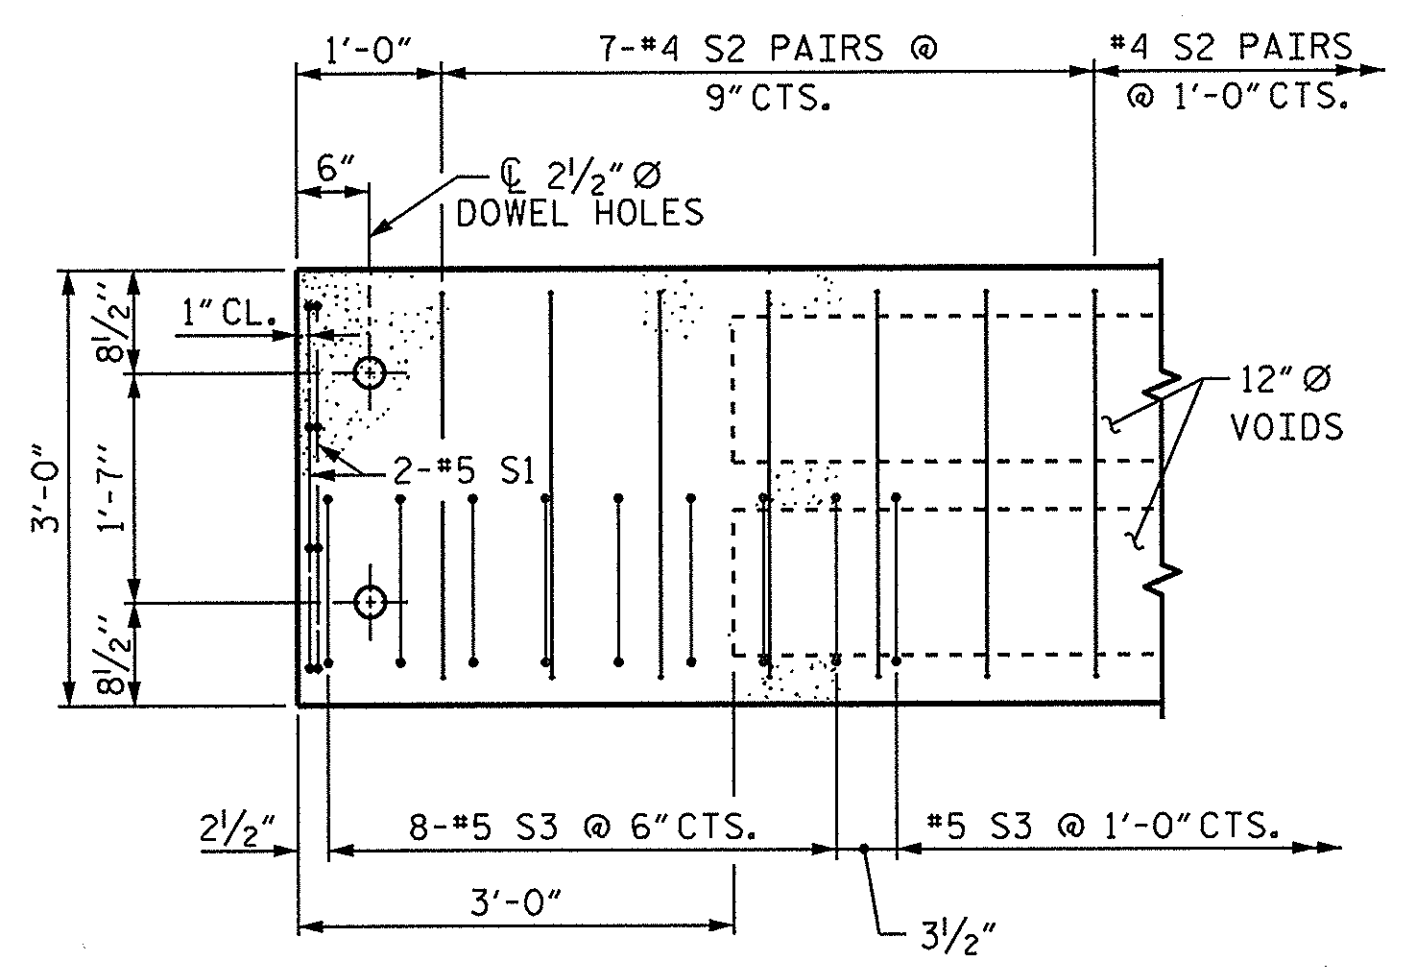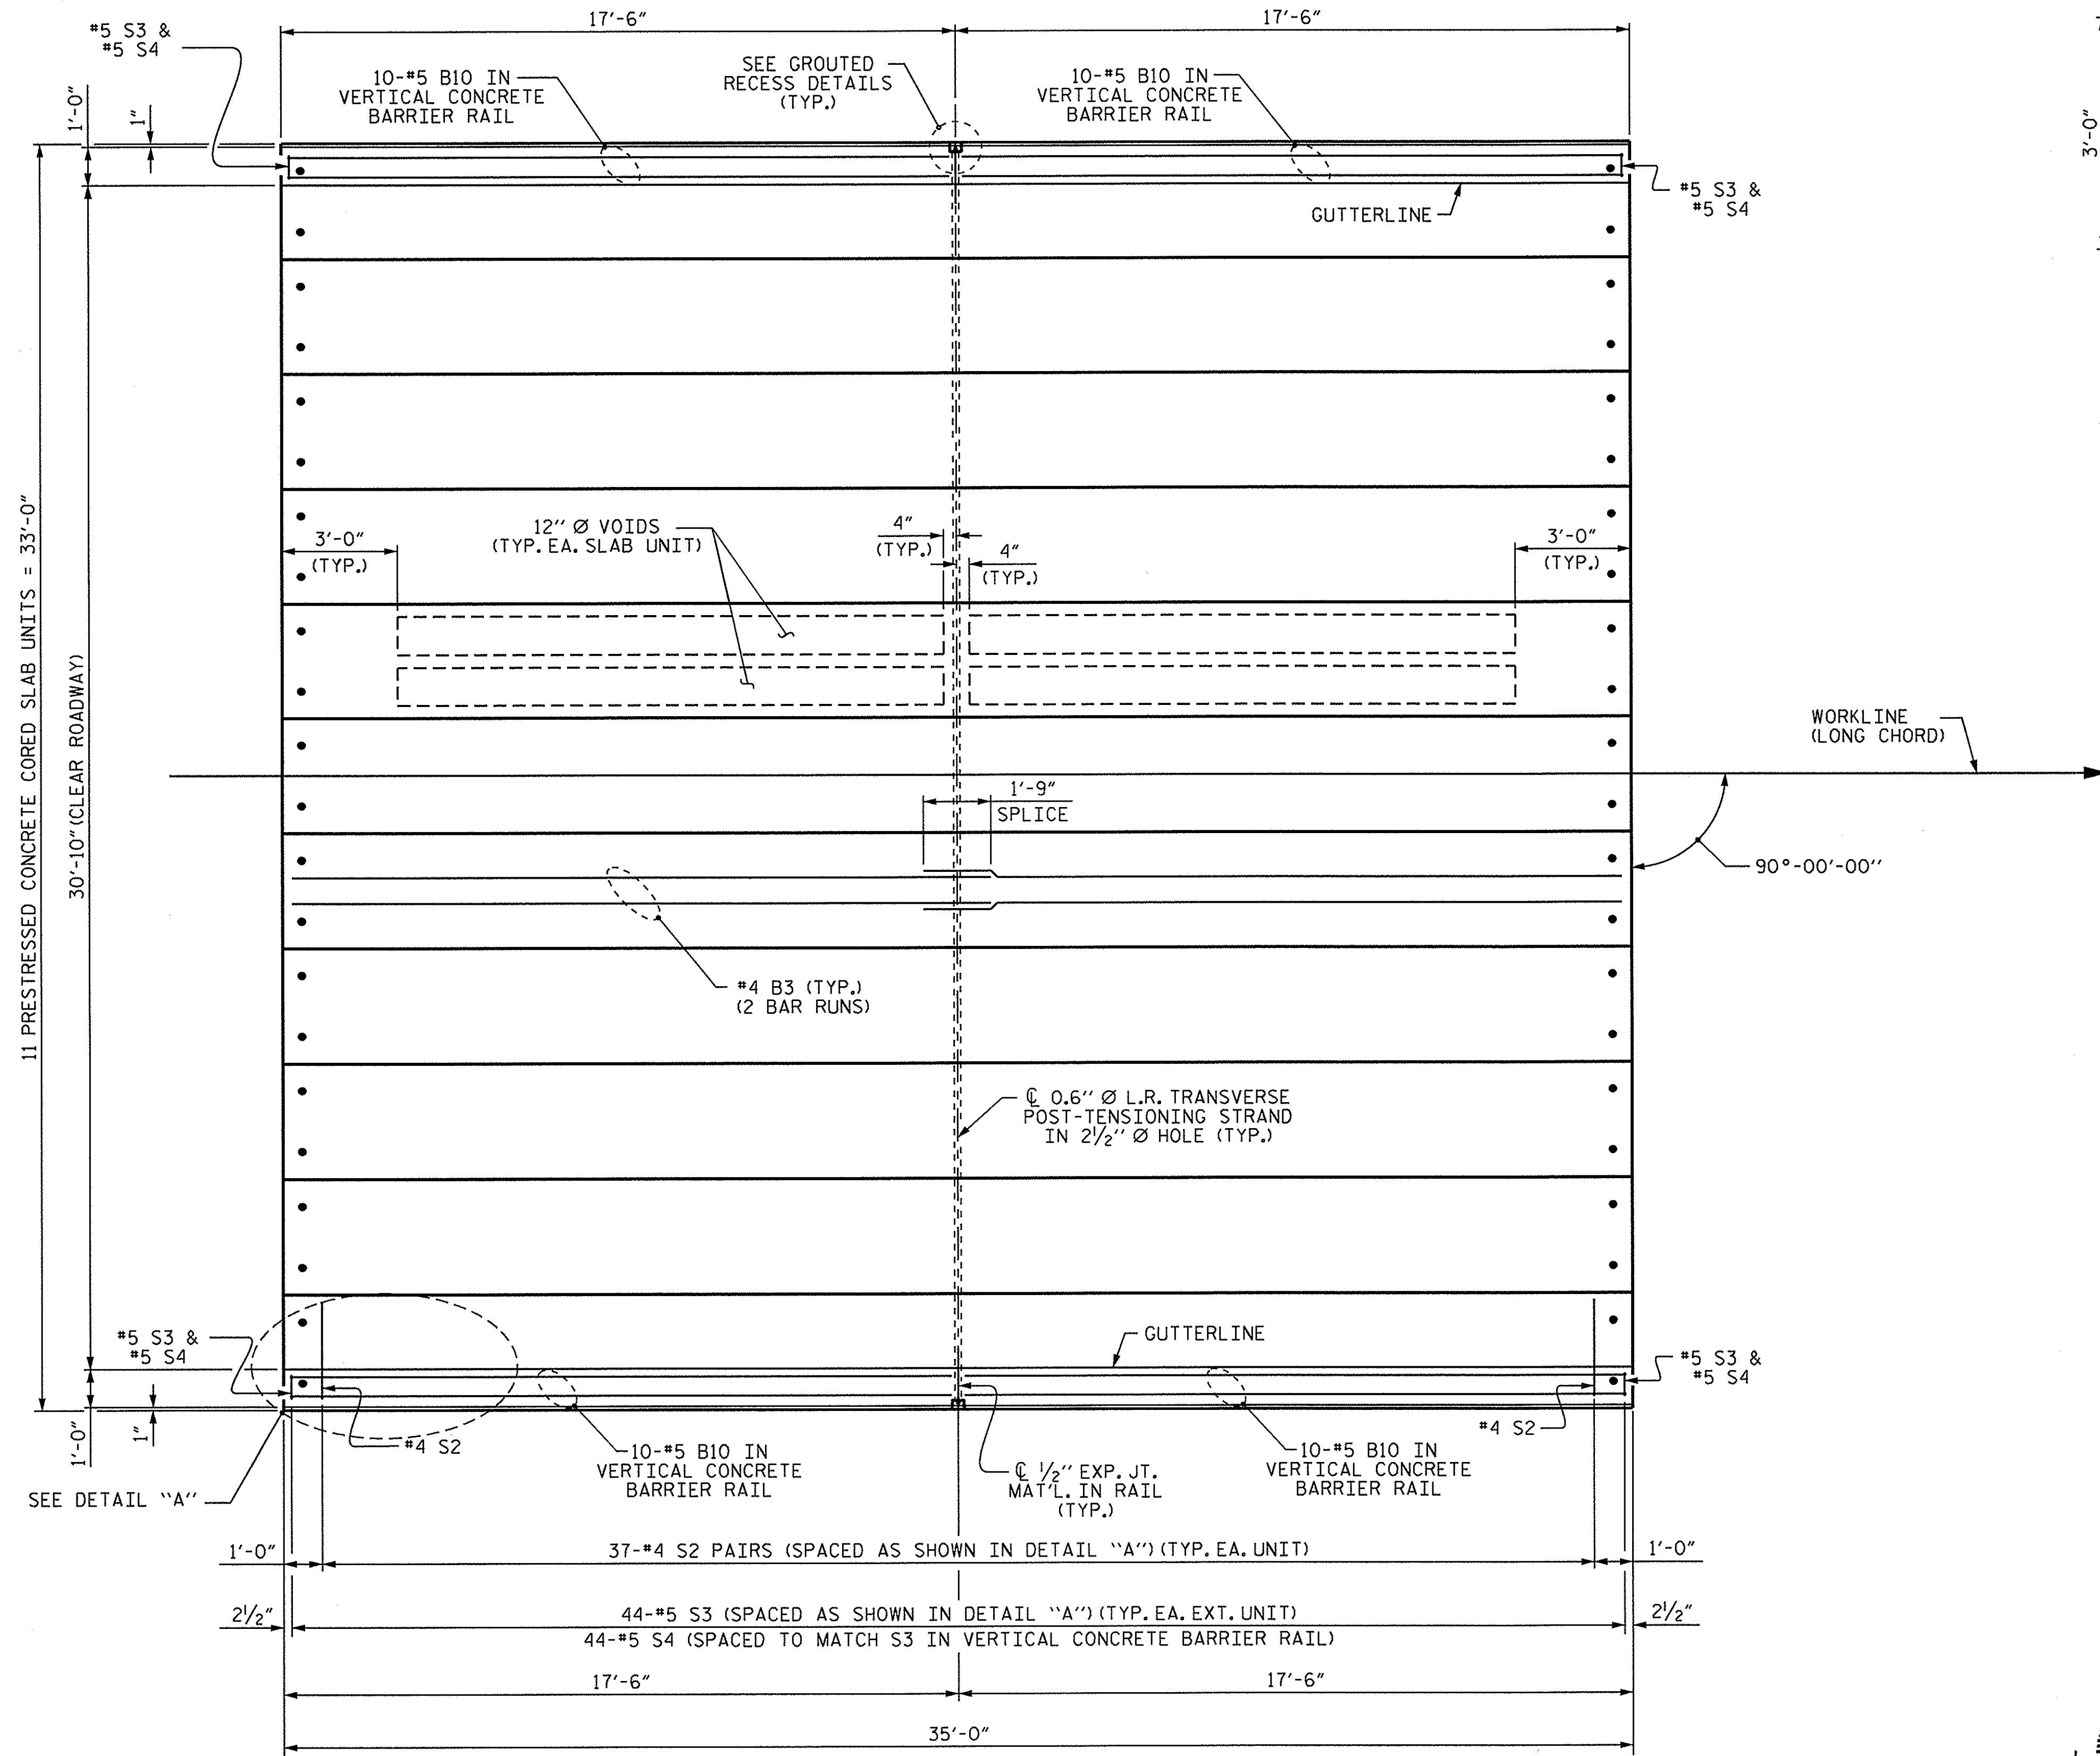

DETAIL "A"  
 NOTE: EXTERIOR UNIT SHOWN - INTERIOR UNIT SIMILAR EXCEPT OMIT #5 S3 BARS.


PLAN OF UNIT

PROJECT NO. 17BP.2.R.51  
 GREENE COUNTY  
 STATION: 14+81.00 -L-

SHEET 2 OF 4

STATE OF NORTH CAROLINA  
 DEPARTMENT OF TRANSPORTATION  
 RALEIGH


PLAN OF 35' UNIT  
 30'-10" CLEAR ROADWAY  
 90° SKEW

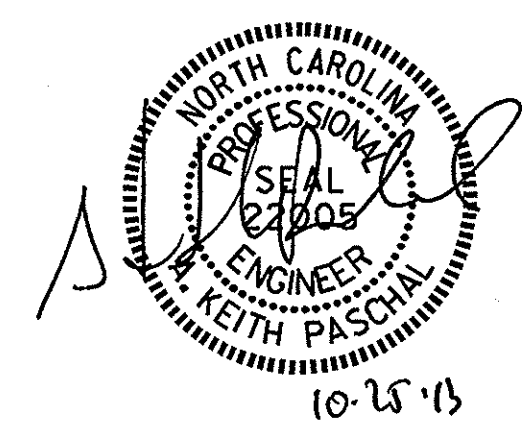


|                              |                |
|------------------------------|----------------|
| ASSEMBLED BY : A. H. SHIVELY | DATE : 6/24/13 |
| CHECKED BY : M. L. RORIE     | DATE : 7/22/13 |
| DRAWN BY : DGE               | 3/09           |
| CHECKED BY : BCH             | 3/09           |
| REV. 12/5/11                 | MAA/AAC        |

| REVISIONS |     |       |     |     |       | SHEET NO.    |
|-----------|-----|-------|-----|-----|-------|--------------|
| NO.       | BY: | DATE: | NO. | BY: | DATE: | S-6          |
| 1         |     |       | 3   |     |       | TOTAL SHEETS |
| 2         |     |       | 4   |     |       | 17           |

25-OCT-2013 07:39  
 S:\DPS\Kait\17BP.2.R.51\Final Plans\17BP.2.R.51\_CS.dgn  
 kpaschal

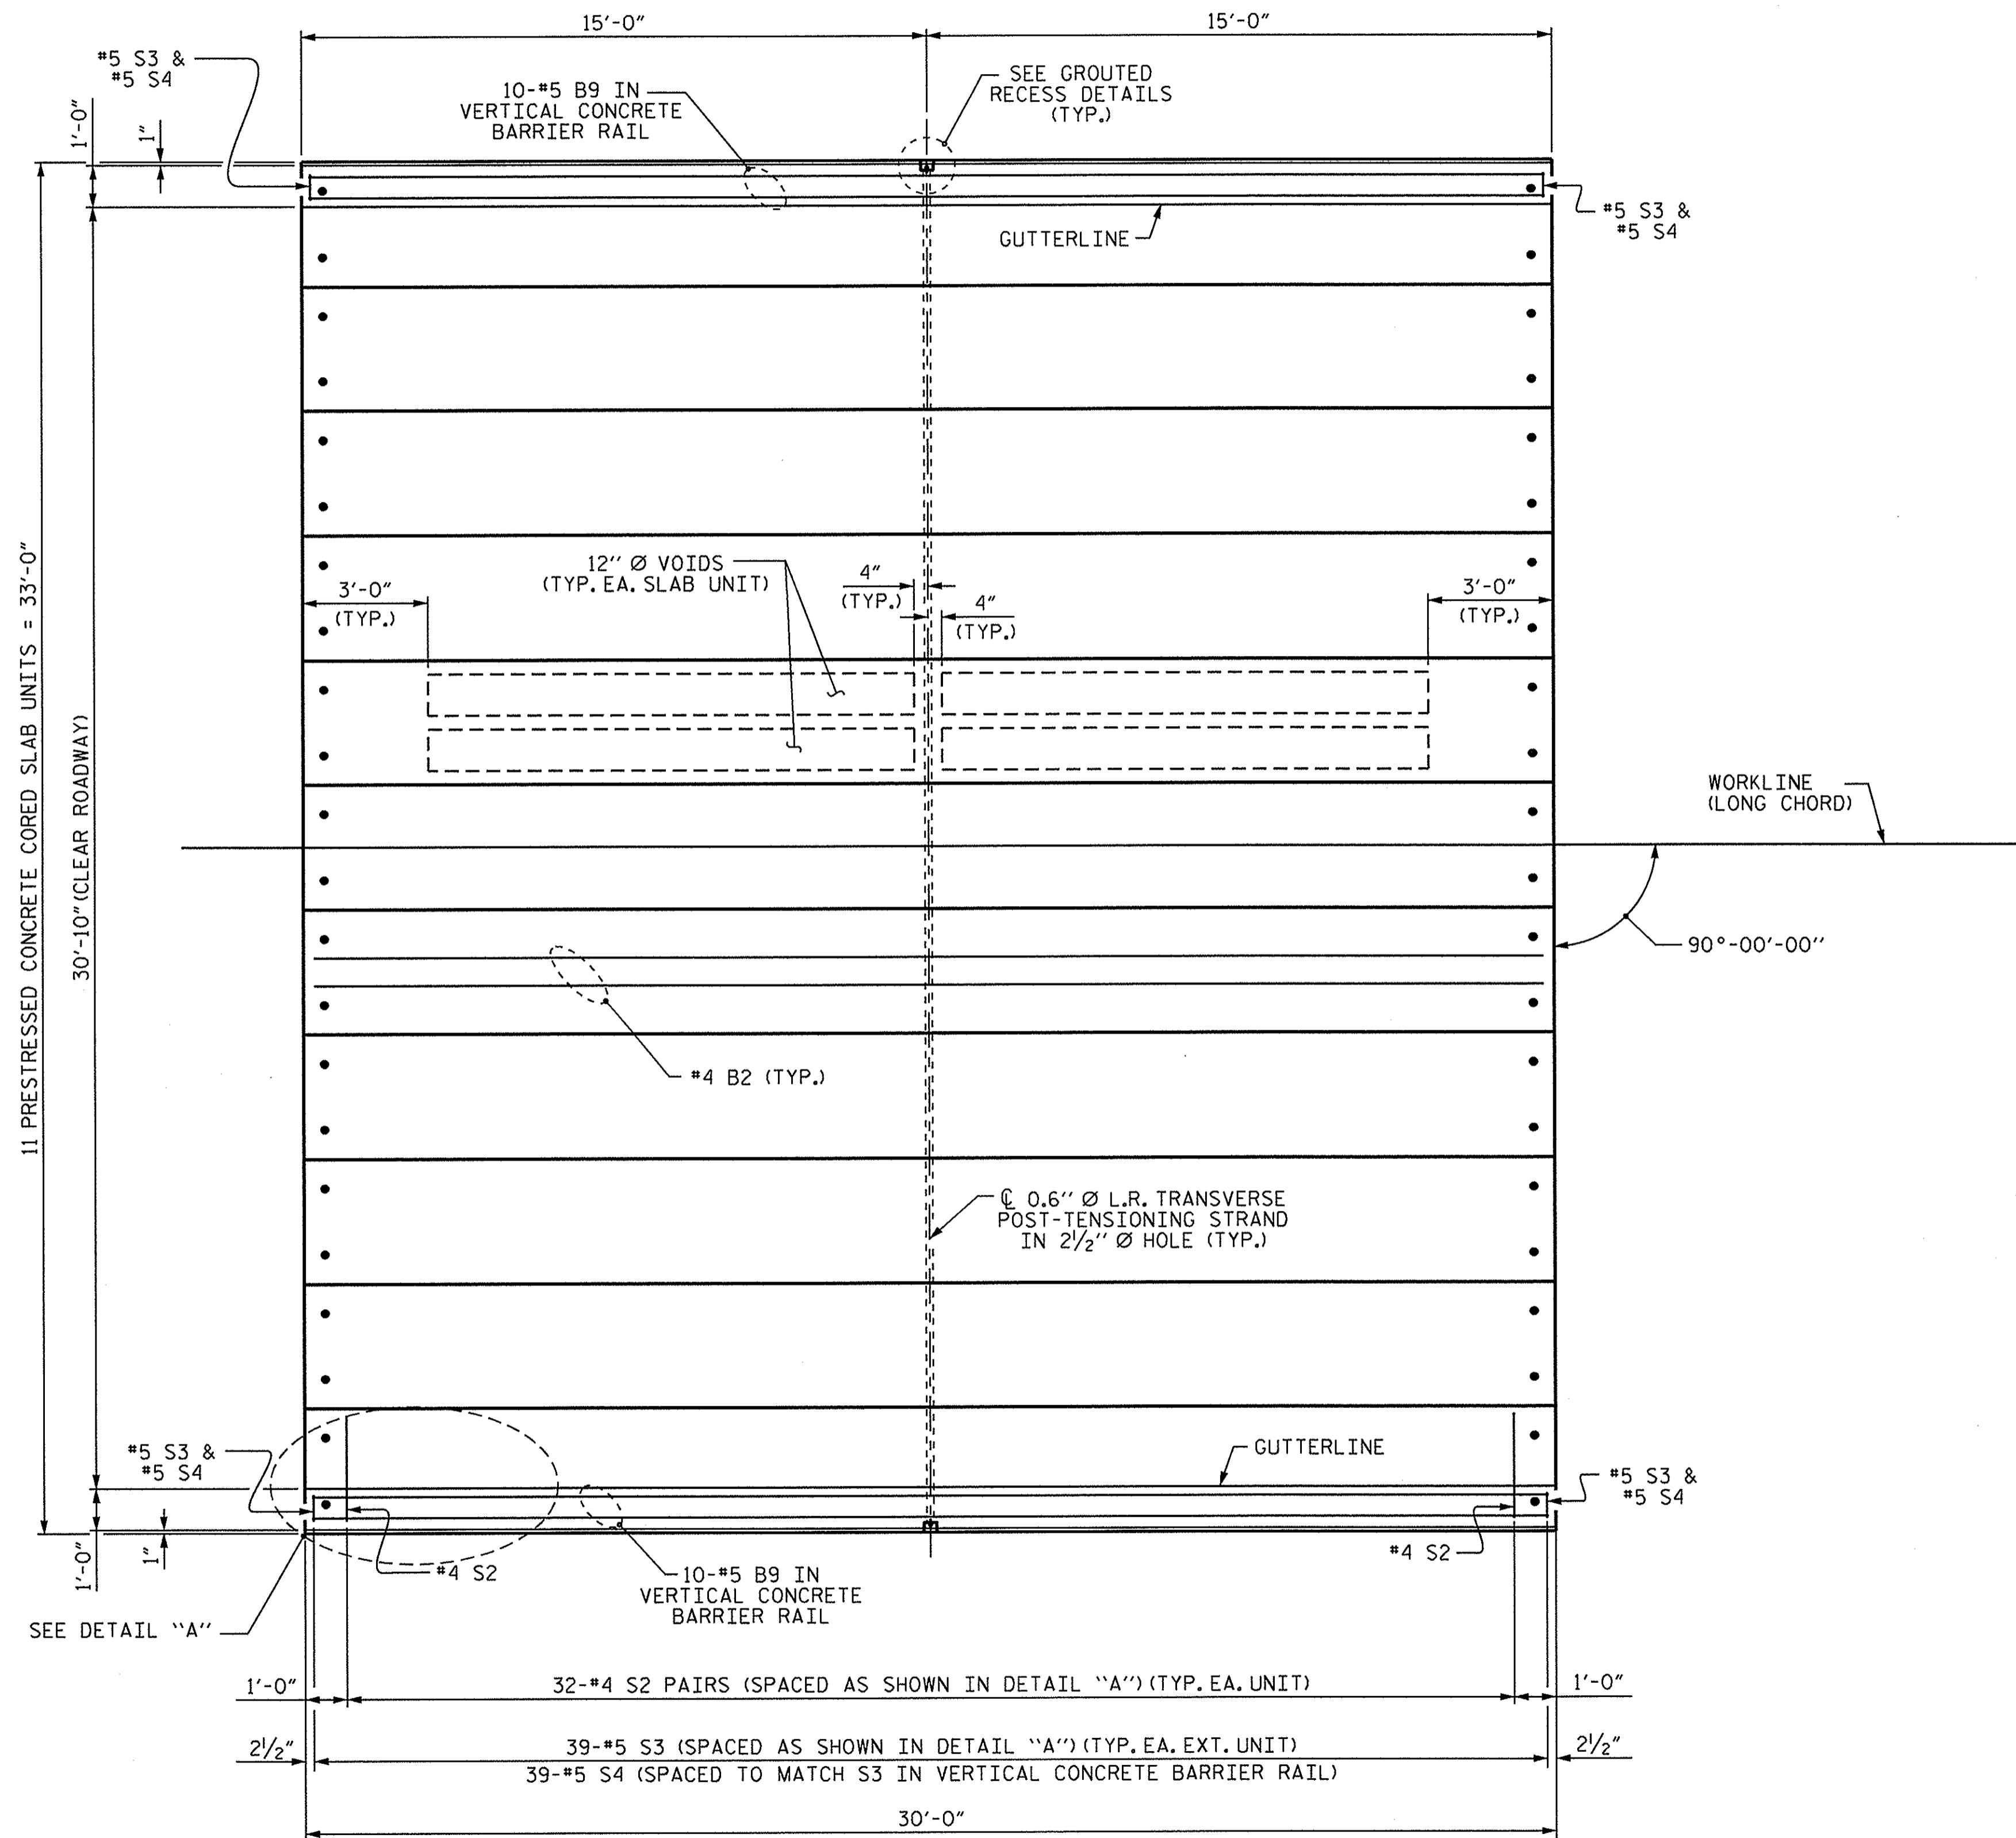

PLAN OF UNIT

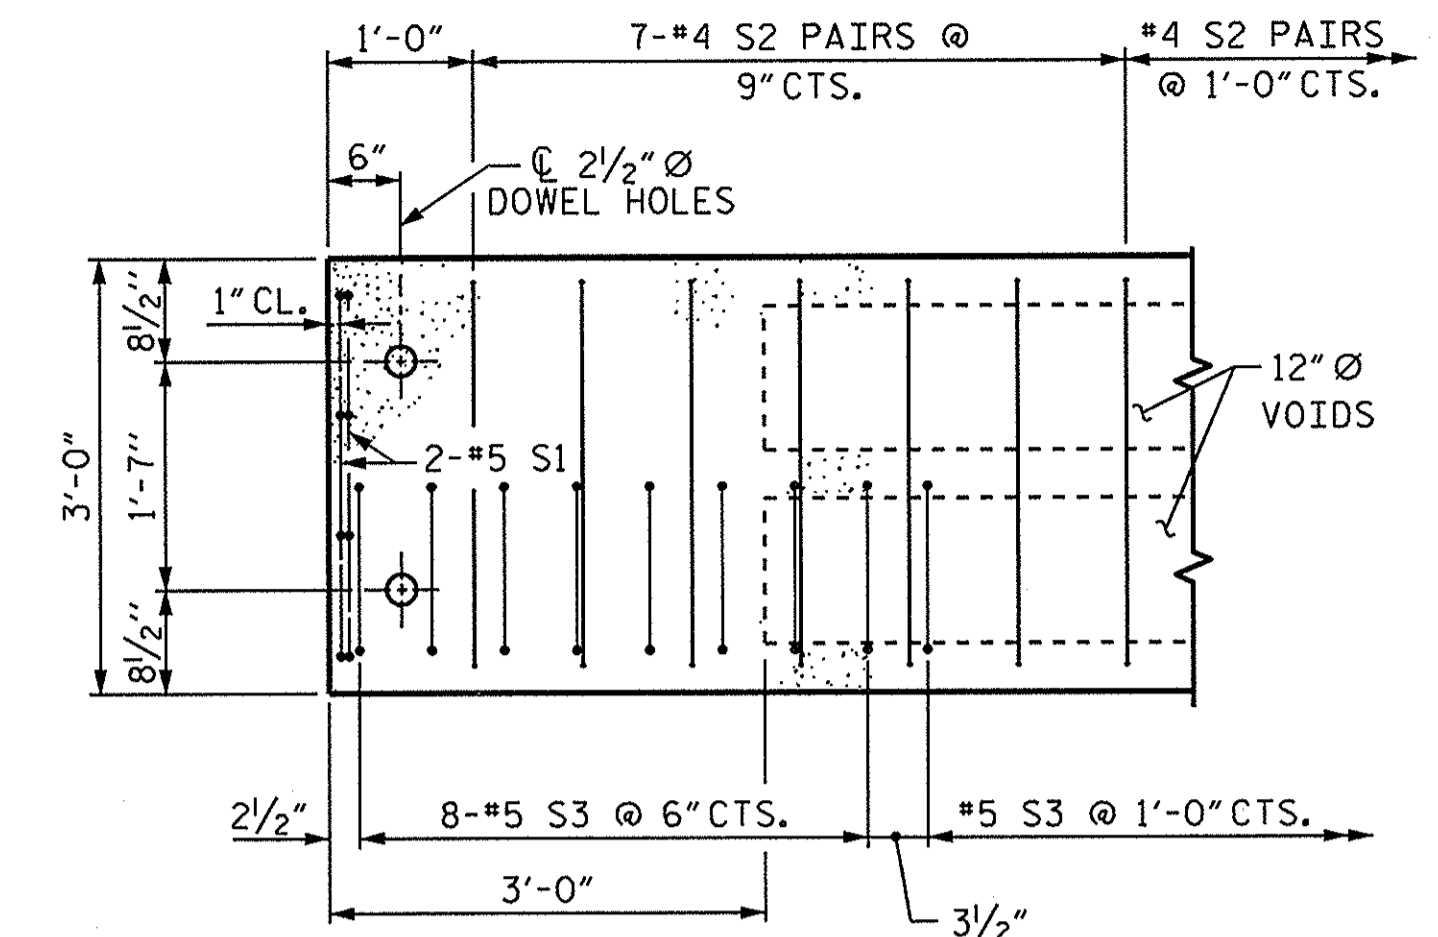

DETAIL "A"


NOTE: EXTERIOR UNIT SHOWN - INTERIOR UNIT SIMILAR EXCEPT OMIT #5 S3 BARS.

PROJECT NO. 17BP.2.R.51  
 GREENE COUNTY  
 STATION: 14+81.00 -L-

SHEET 3 OF 4

STATE OF NORTH CAROLINA  
 DEPARTMENT OF TRANSPORTATION  
 RALEIGH


PLAN OF 30' UNIT  
 30'-10" CLEAR ROADWAY  
 90° SKEW

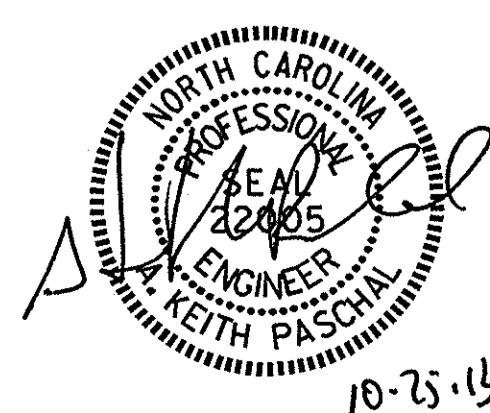

| REVISIONS |     |       |     |     |       | SHEET NO.    |  |
|-----------|-----|-------|-----|-----|-------|--------------|--|
| NO.       | BY: | DATE: | NO. | BY: | DATE: | S-7          |  |
| 1         |     |       | 3   |     |       | TOTAL SHEETS |  |
| 2         |     |       | 4   |     |       | 17           |  |

|                              |                 |
|------------------------------|-----------------|
| ASSEMBLED BY : A. H. SHIVELY | DATE : 6/24/13  |
| CHECKED BY : M. L. RORIE     | DATE : 7/22/13  |
| DRAWN BY : DGE               | 3/09            |
| CHECKED BY : BCH             | 3/09            |
| REV.                         | 12/5/11 MAA/AAC |



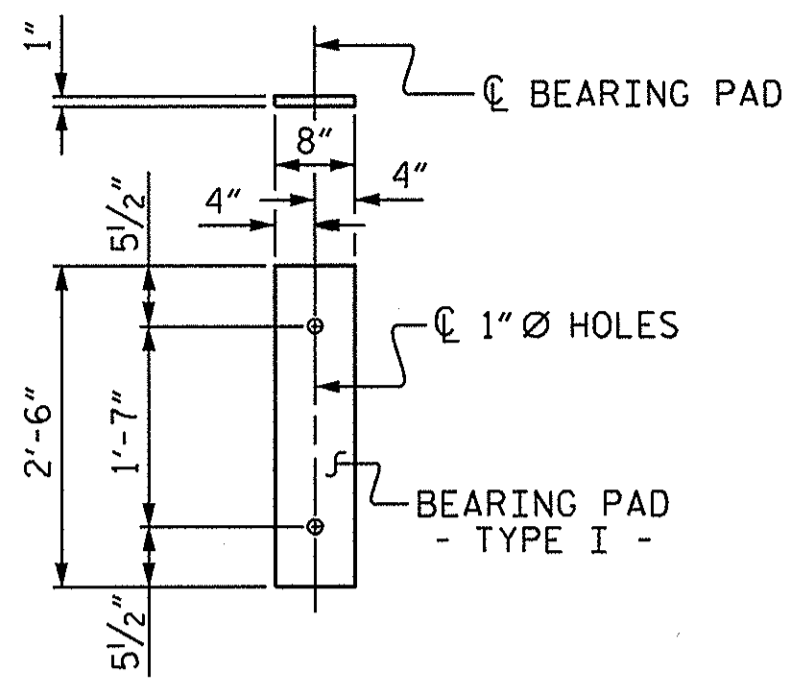

FIXED END  
(TYPE I - 66 REQ'D)

**ELASTOMERIC BEARING DETAILS**

ELASTOMER IN ALL BEARINGS SHALL BE 50 DUROMETER HARDNESS.

| DEAD LOAD DEFLECTION AND CAMBER            |                                  |
|--|----------------------------------|
| 30' & 35' CORED SLAB UNIT                  | 3'-0" x 1'-9" 0.6" Ø L.R. STRAND |
| CAMBER (SLAB ALONE IN PLACE)               | 1/2" ↑                           |
| DEFLECTION DUE TO SUPERIMPOSED DEAD LOAD** | 1/8" ↓                           |
| FINAL CAMBER                               | 3/8" ↑                           |

\*\* INCLUDES FUTURE WEARING SURFACE

| GRADE 270 STRANDS                   |        |
|-------------------------------------|--------|
| AREA (SQUARE INCHES)                | 0.217  |
| ULTIMATE STRENGTH (LBS. PER STRAND) | 58,600 |
| APPLIED PRESTRESS (LBS. PER STRAND) | 43,950 |


**BILL OF MATERIAL FOR ONE 30' CORED SLAB UNIT**

| BAR                              | NUMBER | SIZE | TYPE | EXTERIOR UNIT |        | INTERIOR UNIT |        |
|----------------------------------|--------|------|------|---------------|--------|---------------|--------|
|                                  |        |      |      | LENGTH        | WEIGHT | LENGTH        | WEIGHT |
| B2                               | 2      | #4   | STR  | 29'-8"        | 40     | 29'-8"        | 40     |
| S1                               | 8      | #5   | 3    | 4'-3"         | 35     | 4'-3"         | 35     |
| S2                               | 64     | #4   | 3    | 5'-4"         | 228    | 5'-4"         | 228    |
| * S3                             | 39     | #5   | 1    | 6'-2"         | 251    |               |        |
| REINFORCING STEEL                |        |      |      | LBS.          | 303    |               | 303    |
| * EPOXY COATED REINFORCING STEEL |        |      |      | LBS.          | 251    |               |        |
| 5000 P.S.I. CONCRETE             |        |      |      | CU. YDS.      | 4.4    |               | 4.4    |
| 0.6" Ø L.R. STRANDS              |        |      |      | No.           | 9      |               | 9      |

**BILL OF MATERIAL FOR ONE 35' CORED SLAB UNIT**

| BAR                              | NUMBER | SIZE | TYPE | EXTERIOR UNIT |        | INTERIOR UNIT |        |
|----------------------------------|--------|------|------|---------------|--------|---------------|--------|
|                                  |        |      |      | LENGTH        | WEIGHT | LENGTH        | WEIGHT |
| B3                               | 4      | #4   | STR  | 18'-3"        | 49     | 18'-3"        | 49     |
| S1                               | 8      | #5   | 3    | 4'-3"         | 35     | 4'-3"         | 35     |
| S2                               | 74     | #4   | 3    | 5'-4"         | 264    | 5'-4"         | 264    |
| * S3                             | 44     | #5   | 1    | 6'-2"         | 283    |               |        |
| REINFORCING STEEL                |        |      |      | LBS.          | 348    |               | 348    |
| * EPOXY COATED REINFORCING STEEL |        |      |      | LBS.          | 283    |               |        |
| 5000 P.S.I. CONCRETE             |        |      |      | CU. YDS.      | 5.1    |               | 5.1    |
| 0.6" Ø L.R. STRANDS              |        |      |      | No.           | 9      |               | 9      |

**BAR TYPES**

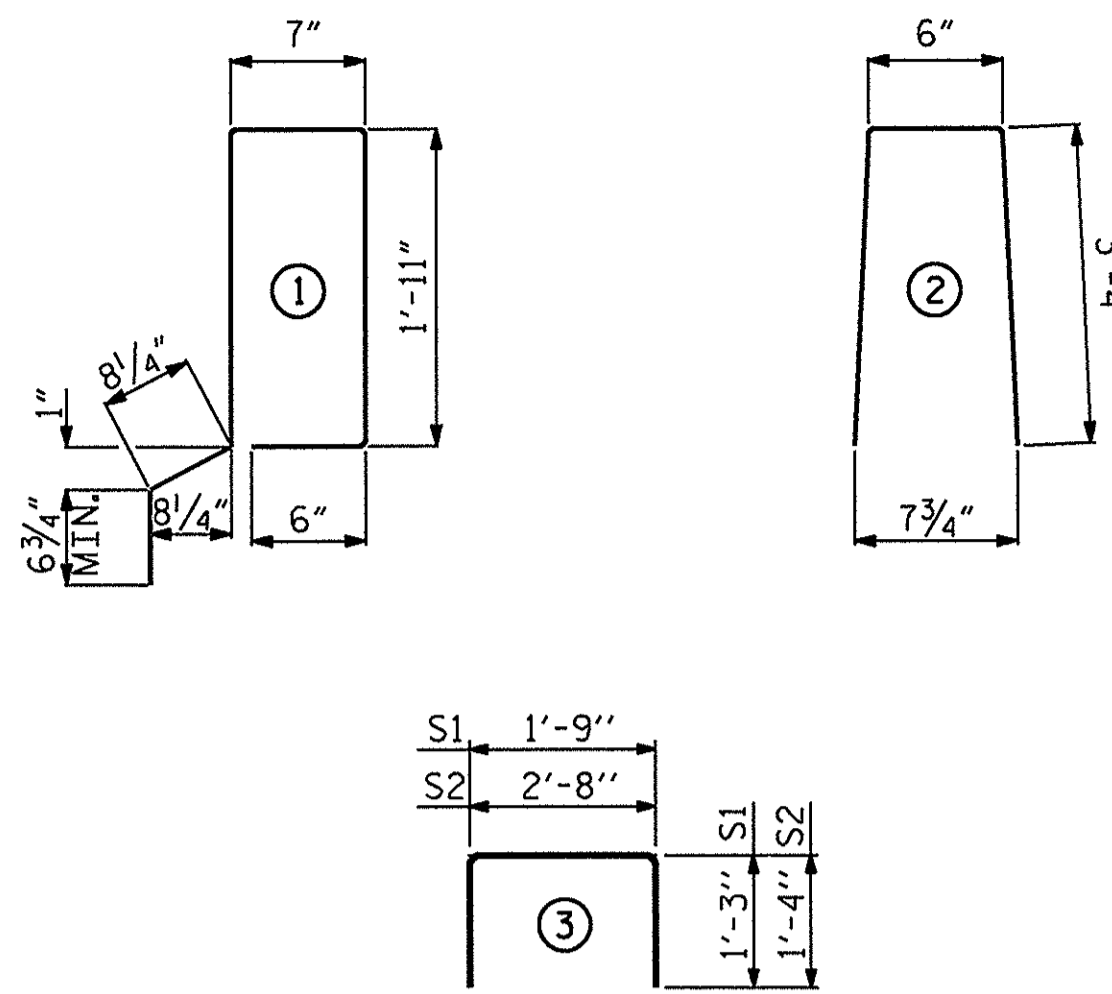

ALL BAR DIMENSIONS ARE OUT TO OUT

**CONCRETE RELEASE STRENGTH**

| UNIT            | PSI  |
|-----------------|------|
| 30' & 35' UNITS | 4000 |

**NOTES**

ALL PRESTRESSING STRANDS SHALL BE 7-WIRE LOW RELAXATION GRADE 270 STRANDS AND SHALL CONFORM TO AASHTO M203 EXCEPT FOR SAMPLING REQUIREMENTS WHICH SHALL BE IN ACCORDANCE WITH THE STANDARD SPECIFICATIONS.

ALL REINFORCING STEEL CAST WITH THE CORED SLAB SECTIONS SHALL BE GRADE 60 AND SHALL BE INCLUDED IN THE UNIT PRICE BID FOR PRESTRESSED CONCRETE CORED SLABS.

RECESSES FOR TRANSVERSE STRANDS SHALL BE GROUTED AFTER THE TENSIONING OF THE STRANDS.

THE 2 1/2" Ø DOWEL HOLES AT FIXED ENDS OF SLAB SECTIONS SHALL BE FILLED WITH NON-SHRINK GROUT.

THE BACKER RODS SHALL CONFORM TO THE REQUIREMENTS OF TYPE M BOND BREAKER. SEE SECTION 1028 OF THE STANDARD SPECIFICATIONS.

WHEN CORED SLABS ARE CAST, AN INTERNAL HOLD-DOWN SYSTEM SHALL BE EMPLOYED TO PREVENT VOIDS FROM RISING OR MOVING SIDEWAYS. AT LEAST SIX WEEKS PRIOR TO CASTING CORED SLABS, THE CONTRACTOR SHALL SUBMIT TO THE ENGINEER FOR REVIEW AND COMMENT, DETAILED DRAWINGS OF THE PROPOSED HOLD-DOWN SYSTEM. IN ADDITION TO STRUCTURAL DETAILS, LOCATION AND SPACING OF THE HOLD-DOWNS SHALL BE INDICATED.

ALL REINFORCING STEEL IN THE VERTICAL CONCRETE BARRIER RAIL SHALL BE EPOXY COATED.

PRESTRESSING STRANDS SHALL BE CUT FLUSH WITH THE CORED SLAB UNIT ENDS.

APPLY EPOXY PROTECTIVE COATING TO CORED SLAB UNIT ENDS.

GROOVED CONTRACTION JOINTS, 1/2" IN DEPTH, SHALL BE TOOLED IN ALL EXPOSED FACES OF THE BARRIER RAIL AND IN ACCORDANCE WITH ARTICLE 825-10(B) OF THE STANDARD SPECIFICATIONS. A CONTRACTION JOINT SHALL BE LOCATED AT EACH THIRD POINT BETWEEN BARRIER RAIL EXPANSION JOINTS. ONLY ONE CONTRACTION JOINT IS REQUIRED AT MIDPOINT OF BARRIER RAIL SEGMENTS LESS THAN 20 FEET IN LENGTH AND NO CONTRACTION JOINTS ARE REQUIRED FOR THOSE SEGMENTS LESS THAN 10 FEET IN LENGTH.

TRANSVERSE POST TENSIONING OF THE CORED SLAB UNITS SHALL BE DONE IN ACCORDANCE WITH THE STANDARD SPECIFICATIONS.

THE TRANSFER OF LOAD FROM THE ANCHORAGES TO THE CORED SLAB UNIT SHALL BE DONE WHEN THE CONCRETE HAS REACHED A COMPRESSIVE STRENGTH OF NOT LESS THAN THE REQUIRED STRENGTH SHOWN IN THE "CONCRETE RELEASE STRENGTH" TABLE.

FOR GROUT FOR STRUCTURES, SEE SPECIAL PROVISIONS.

| GUTTERLINE ASPHALT THICKNESS & RAIL HEIGHT |                           |             |
|--|---------------------------|-------------|
| 30'-10" CLEAR ROADWAY                      | ASPHALT OVERLAY THICKNESS | RAIL HEIGHT |
|  | @ MID-SPAN                | @ MID-SPAN  |
|  | SUPERED SECTION           |             |
| 30' & 35' UNITS                            | 3 3/8"                    | 3'-9 5/8"   |

**CORED SLABS REQUIRED**

|               | NUMBER | LENGTH | TOTAL LENGTH |
|---------------|--------|--------|--------------|
| 30' UNIT      |        |        |              |
| EXTERIOR C.S. | 2      | 30'-0" | 60           |
| INTERIOR C.S. | 9      | 30'-0" | 270          |
| TOTAL         | 11     |        | 330          |

**CORED SLABS REQUIRED**



|               | NUMBER | LENGTH | TOTAL LENGTH |
|---------------|--------|--------|--------------|
| 35' UNIT      |        |        |              |
| EXTERIOR C.S. | 4      | 35'-0" | 140          |
| INTERIOR C.S. | 18     | 35'-0" | 630          |
| TOTAL         | 22     |        | 770          |

**BILL OF MATERIAL FOR VERTICAL CONCRETE BARRIER RAIL**

| BAR                                  | BARS PER PAIR OF EXTERIOR UNITS | TOTAL NO. | SIZE | TYPE     | LENGTH | WEIGHT |
|--------------------------------------|---------------------------------|-----------|------|----------|--------|--------|
| 30' UNIT                             |                                 |           |      |          |        |        |
| * B9                                 | 20                              | 20        | #5   | STR      | 29'-7" | 617    |
| * S4                                 | 78                              | 78        | #5   | 2        | 7'-2"  | 583    |
| * EPOXY COATED REINFORCING STEEL     |                                 |           |      | LBS.     |        | 1200   |
| CLASS AA CONCRETE                    |                                 |           |      | CU. YDS. |        | 7.9    |
| TOTAL VERTICAL CONCRETE BARRIER RAIL |                                 |           |      | LN. FT.  |        | 60.25  |


**BILL OF MATERIAL FOR VERTICAL CONCRETE BARRIER RAIL**

| BAR                                  | BARS PER PAIR OF EXTERIOR UNITS | TOTAL NO. | SIZE | TYPE     | LENGTH | WEIGHT |
|--------------------------------------|---------------------------------|-----------|------|----------|--------|--------|
| 35' UNIT                             |                                 |           |      |          |        |        |
| * B10                                | 40                              | 80        | #5   | STR      | 17'-1" | 1426   |
| * S4                                 | 88                              | 176       | #5   | 2        | 7'-2"  | 1316   |
| * EPOXY COATED REINFORCING STEEL     |                                 |           |      | LBS.     |        | 2742   |
| CLASS AA CONCRETE                    |                                 |           |      | CU. YDS. |        | 18.40  |
| TOTAL VERTICAL CONCRETE BARRIER RAIL |                                 |           |      | LN. FT.  |        | 140.50 |

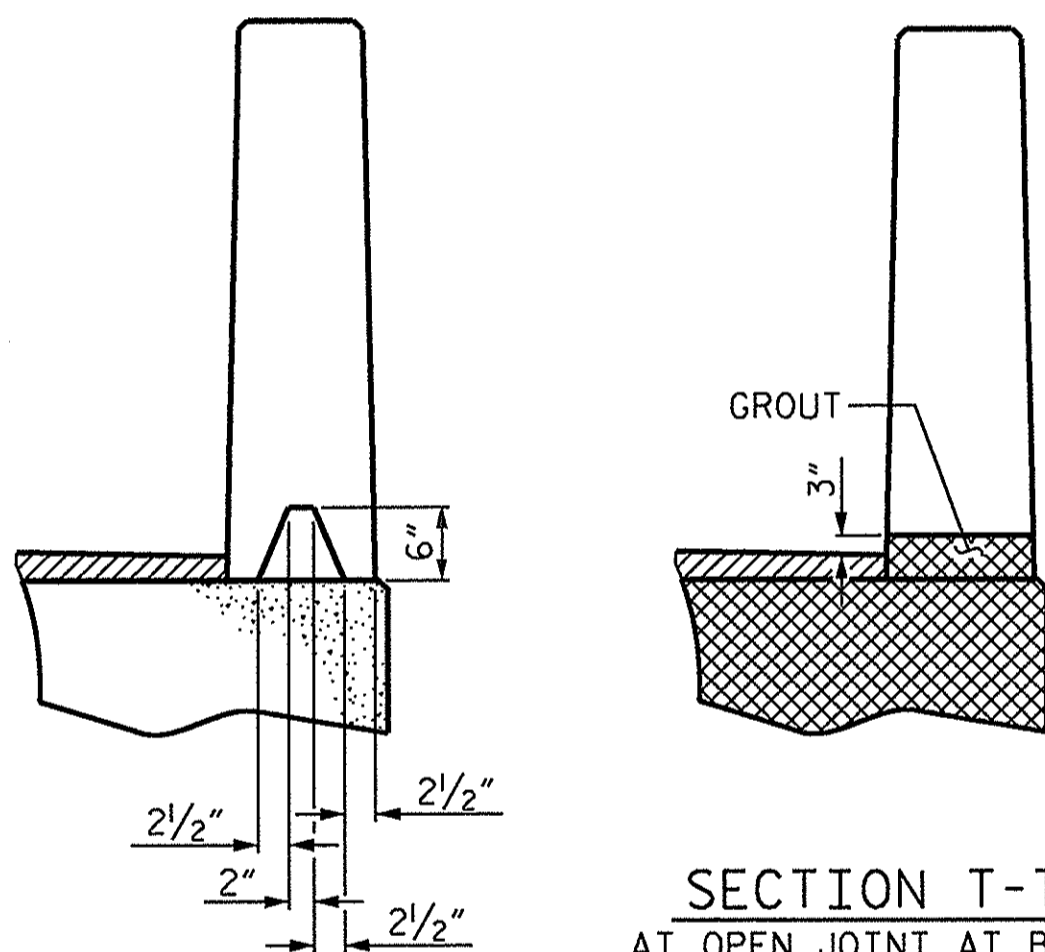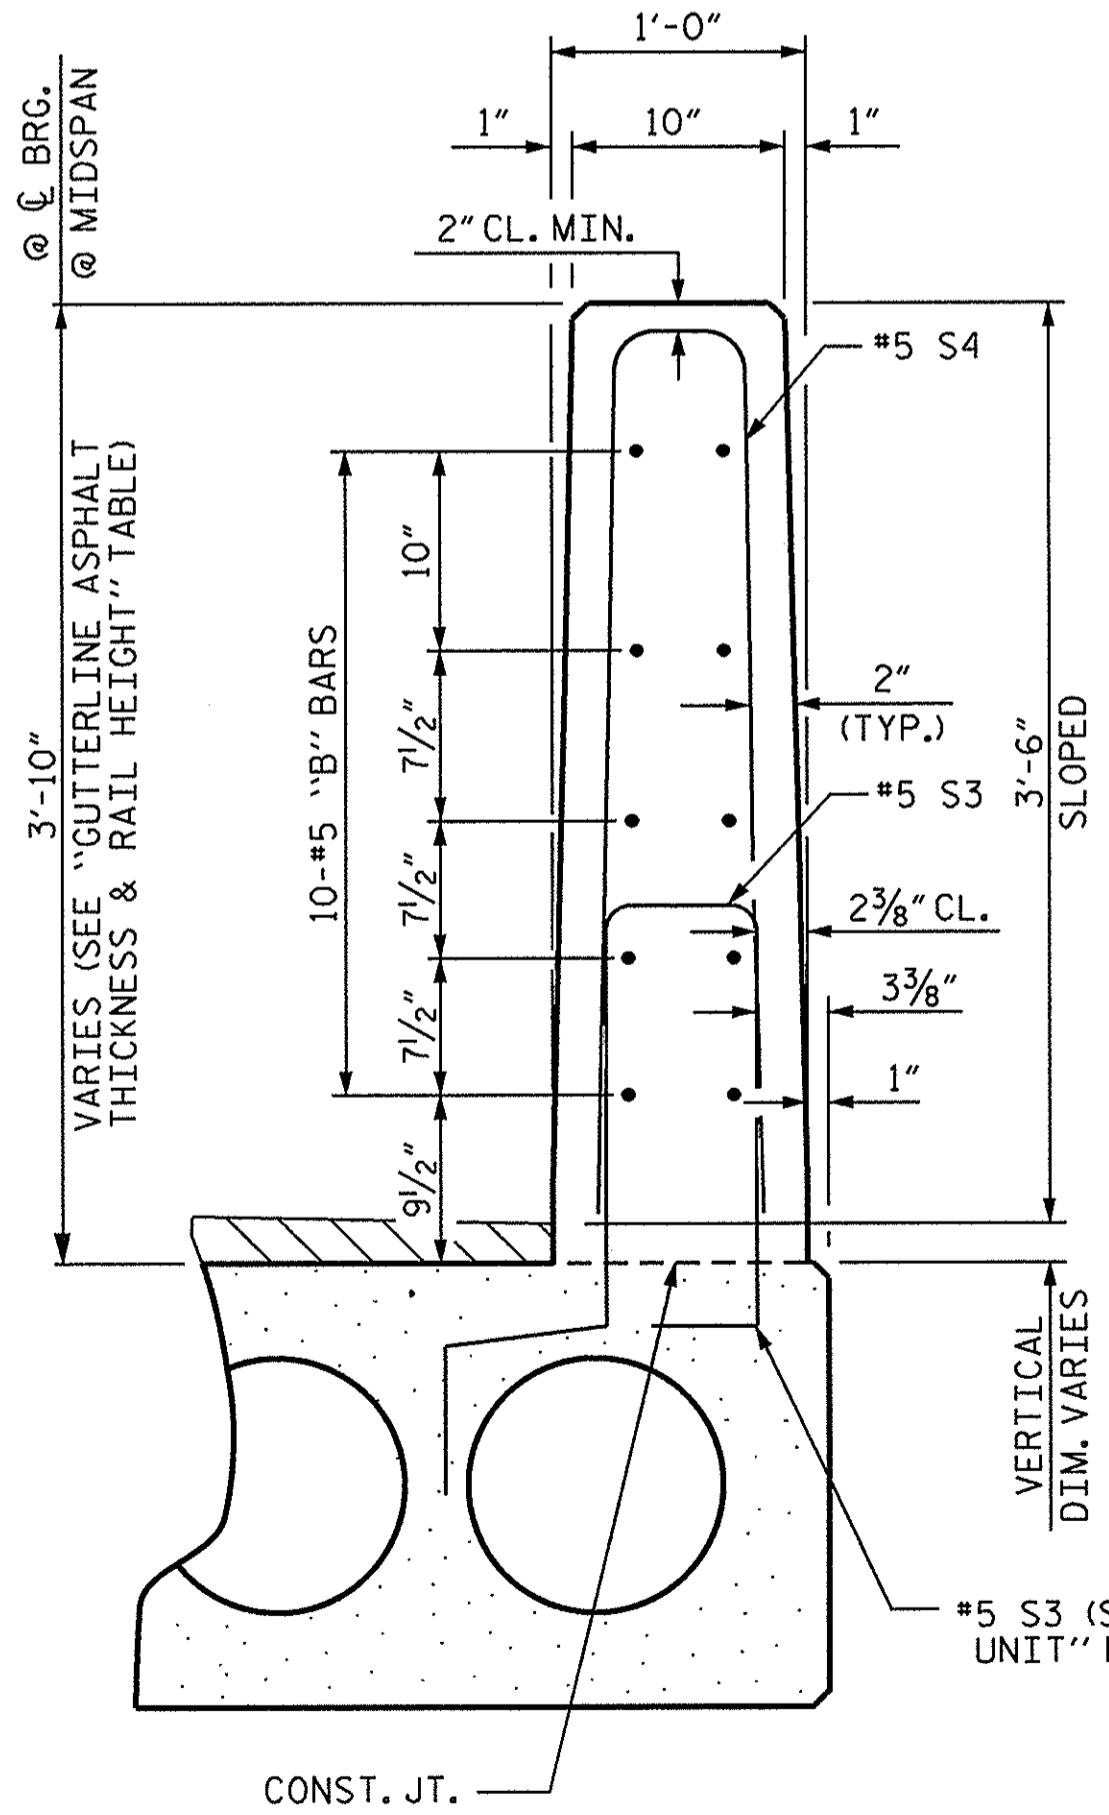


SECTION T-T  
AT OPEN JOINT AT BENT  
(THIS IS TO BE USED WHERE FOAM JOINT IS NOT USED)


SECTION S-S  
AT DAM IN OPEN JOINT  
(THIS IS TO BE USED ONLY WHEN SLIP FORM IS USED)

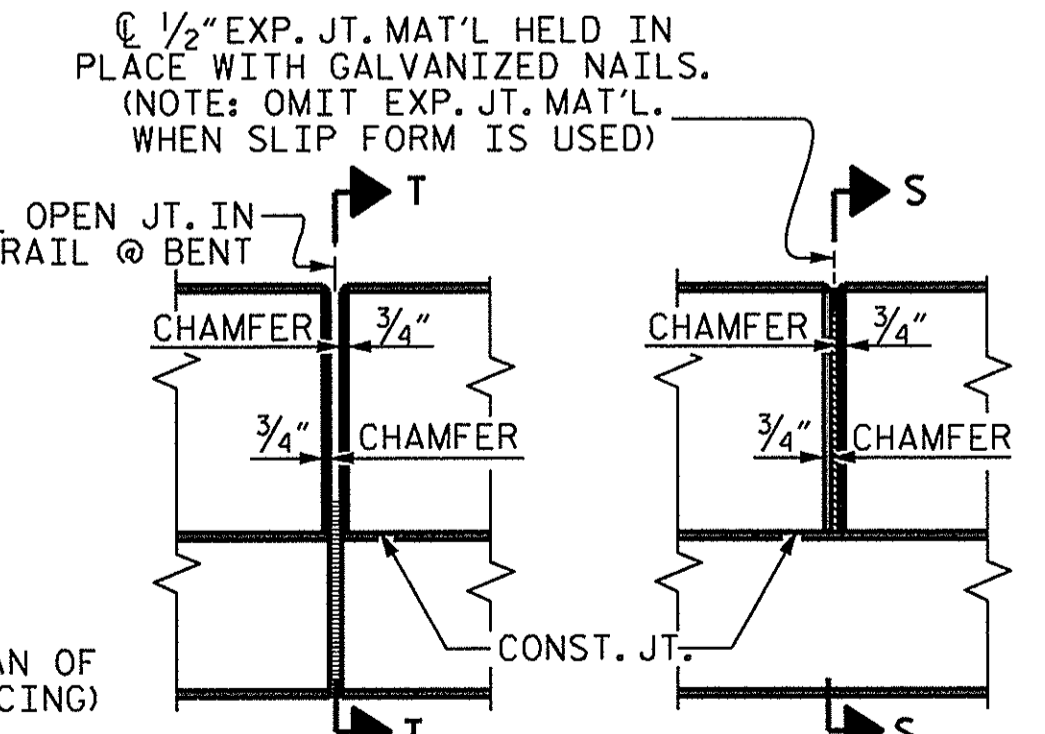

ELEVATION AT EXPANSION JOINTS

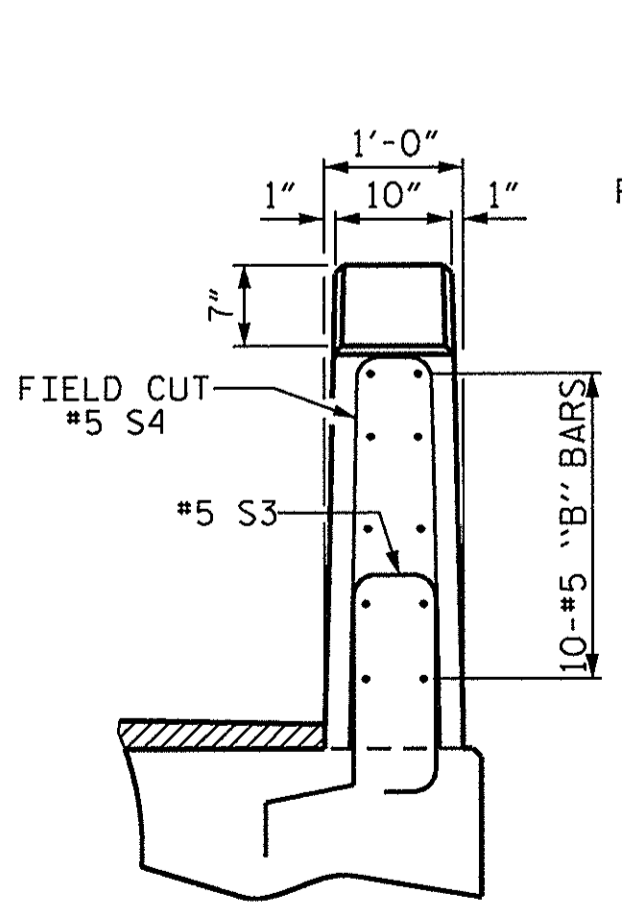

END VIEW

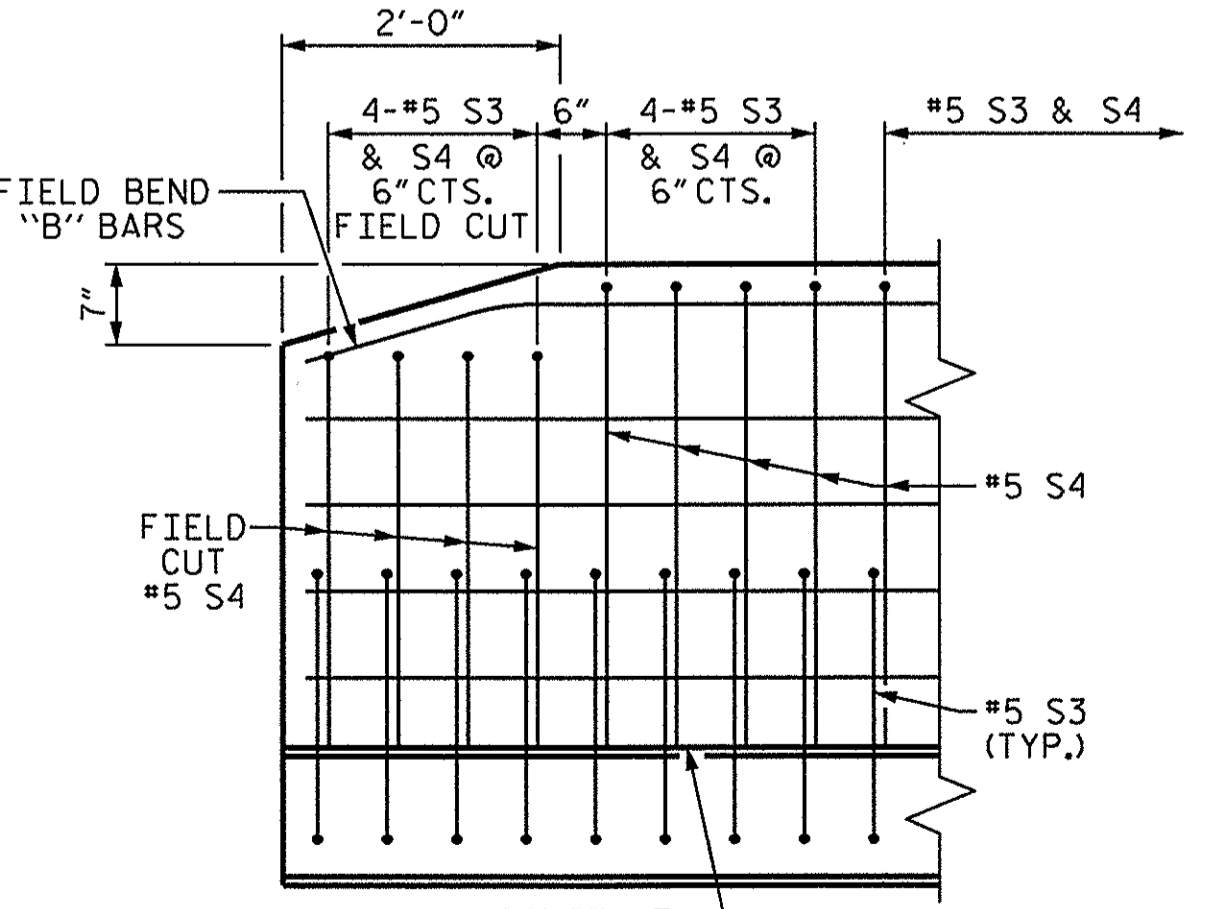


SIDE VIEW

**END OF RAIL DETAILS**

PROJECT NO. 17BP.2.R.51  
GREENE COUNTY  
STATION: 14+81.00 -L-

SHEET 4 OF 4

STATE OF NORTH CAROLINA  
DEPARTMENT OF TRANSPORTATION  
RALEIGH  
STANDARD  
3'-0" X 1'-9"  
PRESTRESSED CONCRETE  
CORED SLAB UNIT  
90° SKEW

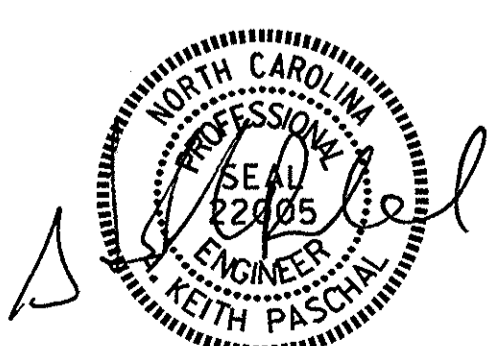

| REVISIONS |     |       |     |     |       | SHEET NO.    |
|-----------|-----|-------|-----|-----|-------|--------------|
| NO.       | BY: | DATE: | NO. | BY: | DATE: | S-8          |
| 1         |     |       | 3   |     |       | TOTAL SHEETS |
| 2         |     |       | 4   |     |       | 17           |

STD. NO. 21" PCS3.33.90S

NOTES

THE GUARDRAIL ANCHOR ASSEMBLY SHALL CONSIST OF A 1/4" HOLD DOWN PLATE AND 7 - 7/8" Ø BOLTS WITH NUTS AND WASHERS.

THE HOLD-DOWN PLATE SHALL CONFORM TO AASHTO M270 GRADE 36. AFTER FABRICATION, THE HOLD-DOWN PLATE SHALL BE HOT-DIP GALVANIZED IN ACCORDANCE WITH AASHTO M111.

BOLTS SHALL CONFORM TO THE REQUIREMENTS OF ASTM A307 AND NUTS SHALL CONFORM TO THE REQUIREMENTS OF AASHTO M291. BOLTS, NUTS AND WASHERS SHALL BE GALVANIZED. (AT THE CONTRACTOR'S OPTION, STAINLESS STEEL BOLTS, NUTS AND WASHERS MAY BE USED AS AN ALTERNATE FOR THE 7/8" Ø GALVANIZED BOLTS, NUTS AND WASHERS. THEY SHALL CONFORM TO OR EXCEED THE MECHANICAL REQUIREMENTS OF ASTM A307. THE USE OF THIS ALTERNATE SHALL BE APPROVED BY THE ENGINEER.)


THE GUARDRAIL ANCHOR ASSEMBLY IS REQUIRED AT ALL POINTS WHERE APPROACH GUARDRAIL IS TO BE ATTACHED TO THE END OF BARRIER RAIL. FOR POINTS OF ATTACHMENT, SEE SKETCH.

AFTER INSTALLATION, THE EXPOSED THREAD OF THE BOLT SHALL BE BURRED WITH A SHARP POINTED TOOL.

THE COST OF THE GUARDRAIL ANCHOR ASSEMBLY SHALL BE INCLUDED IN THE UNIT CONTRACT PRICE BID FOR VERTICAL CONCRETE BARRIER RAIL.


THE VERTICAL REINFORCING BARS MAY BE SHIFTED SLIGHTLY IN THE VERTICAL CONCRETE BARRIER RAIL TO CLEAR ASSEMBLY BOLTS.

THE 1 1/4" Ø HOLES SHALL BE FORMED OR DRILLED WITH A CORE BIT. IMPACT TOOLS WILL NOT BE PERMITTED. ANY CONCRETE DAMAGED BY THIS WORK SHALL BE REPAIRED TO THE SATISFACTION OF THE ENGINEER.

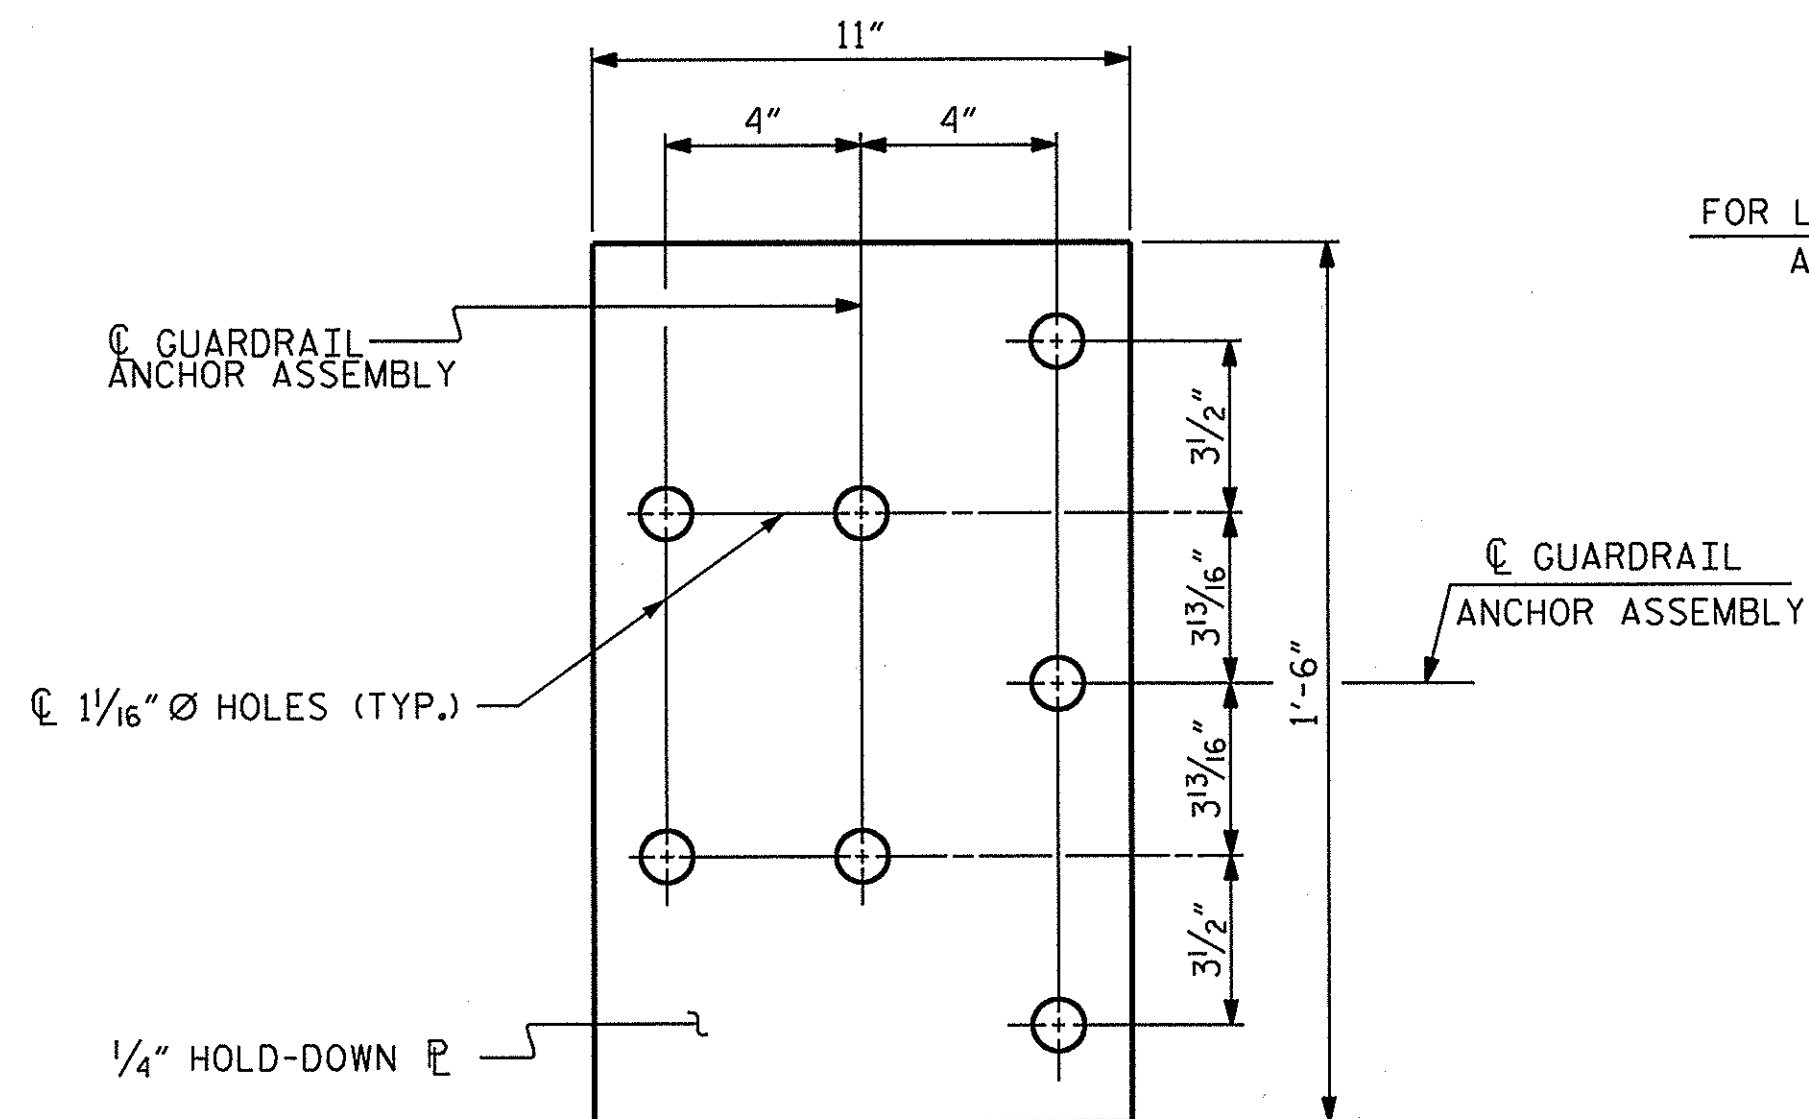


PLAN


FOR LOCATION OF GUARDRAIL ANCHOR ASSEMBLY, SEE "PLAN" BELOW

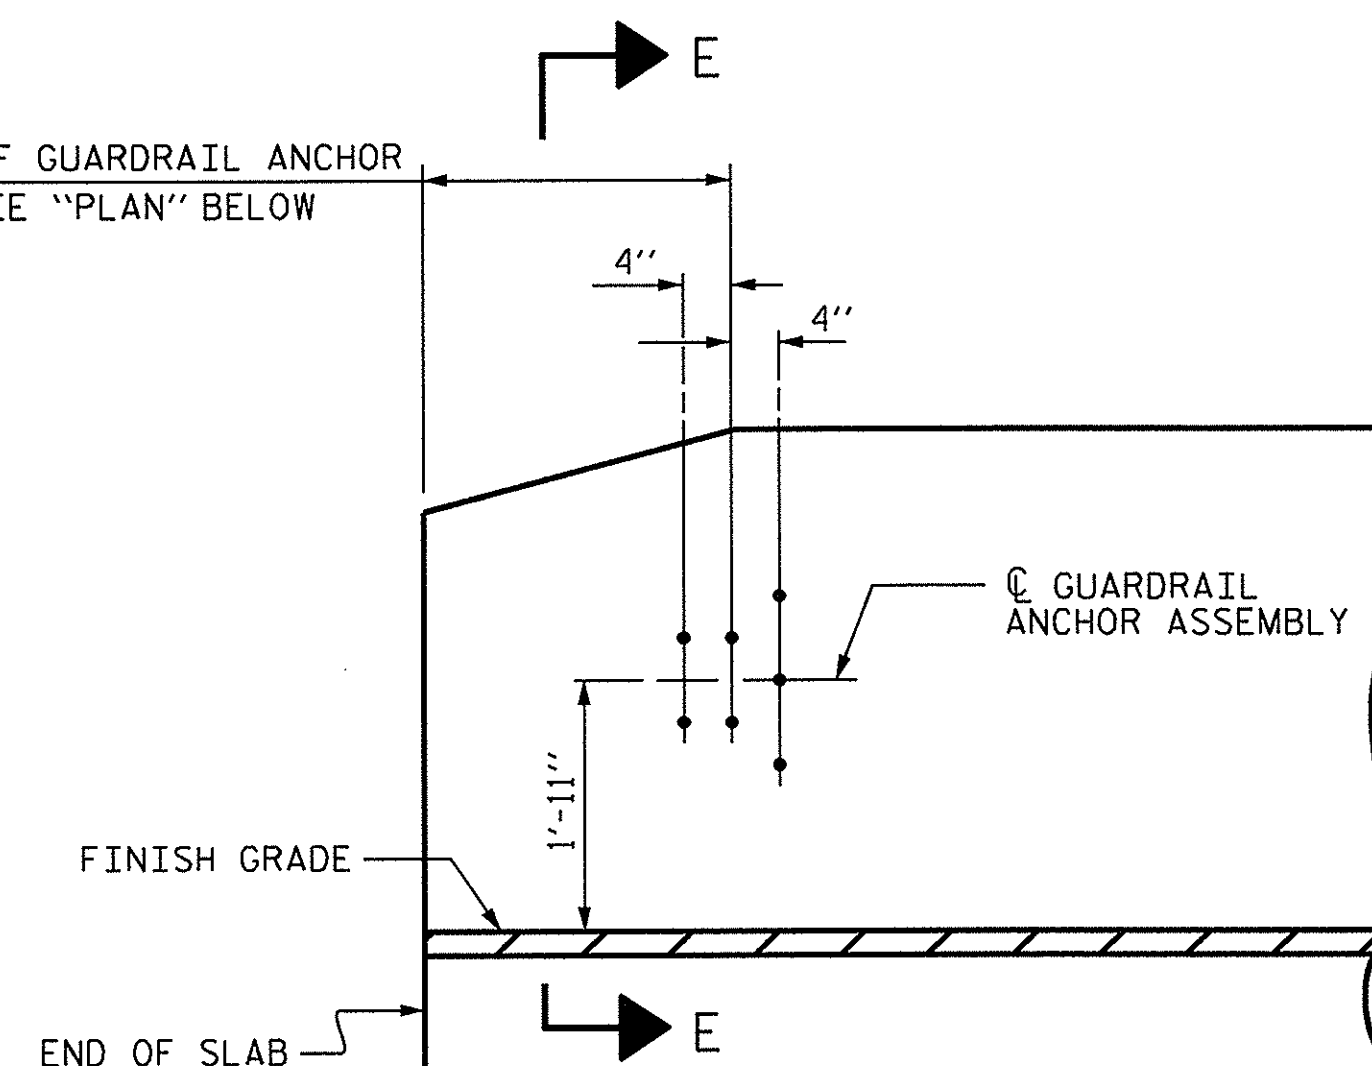

ELEVATION

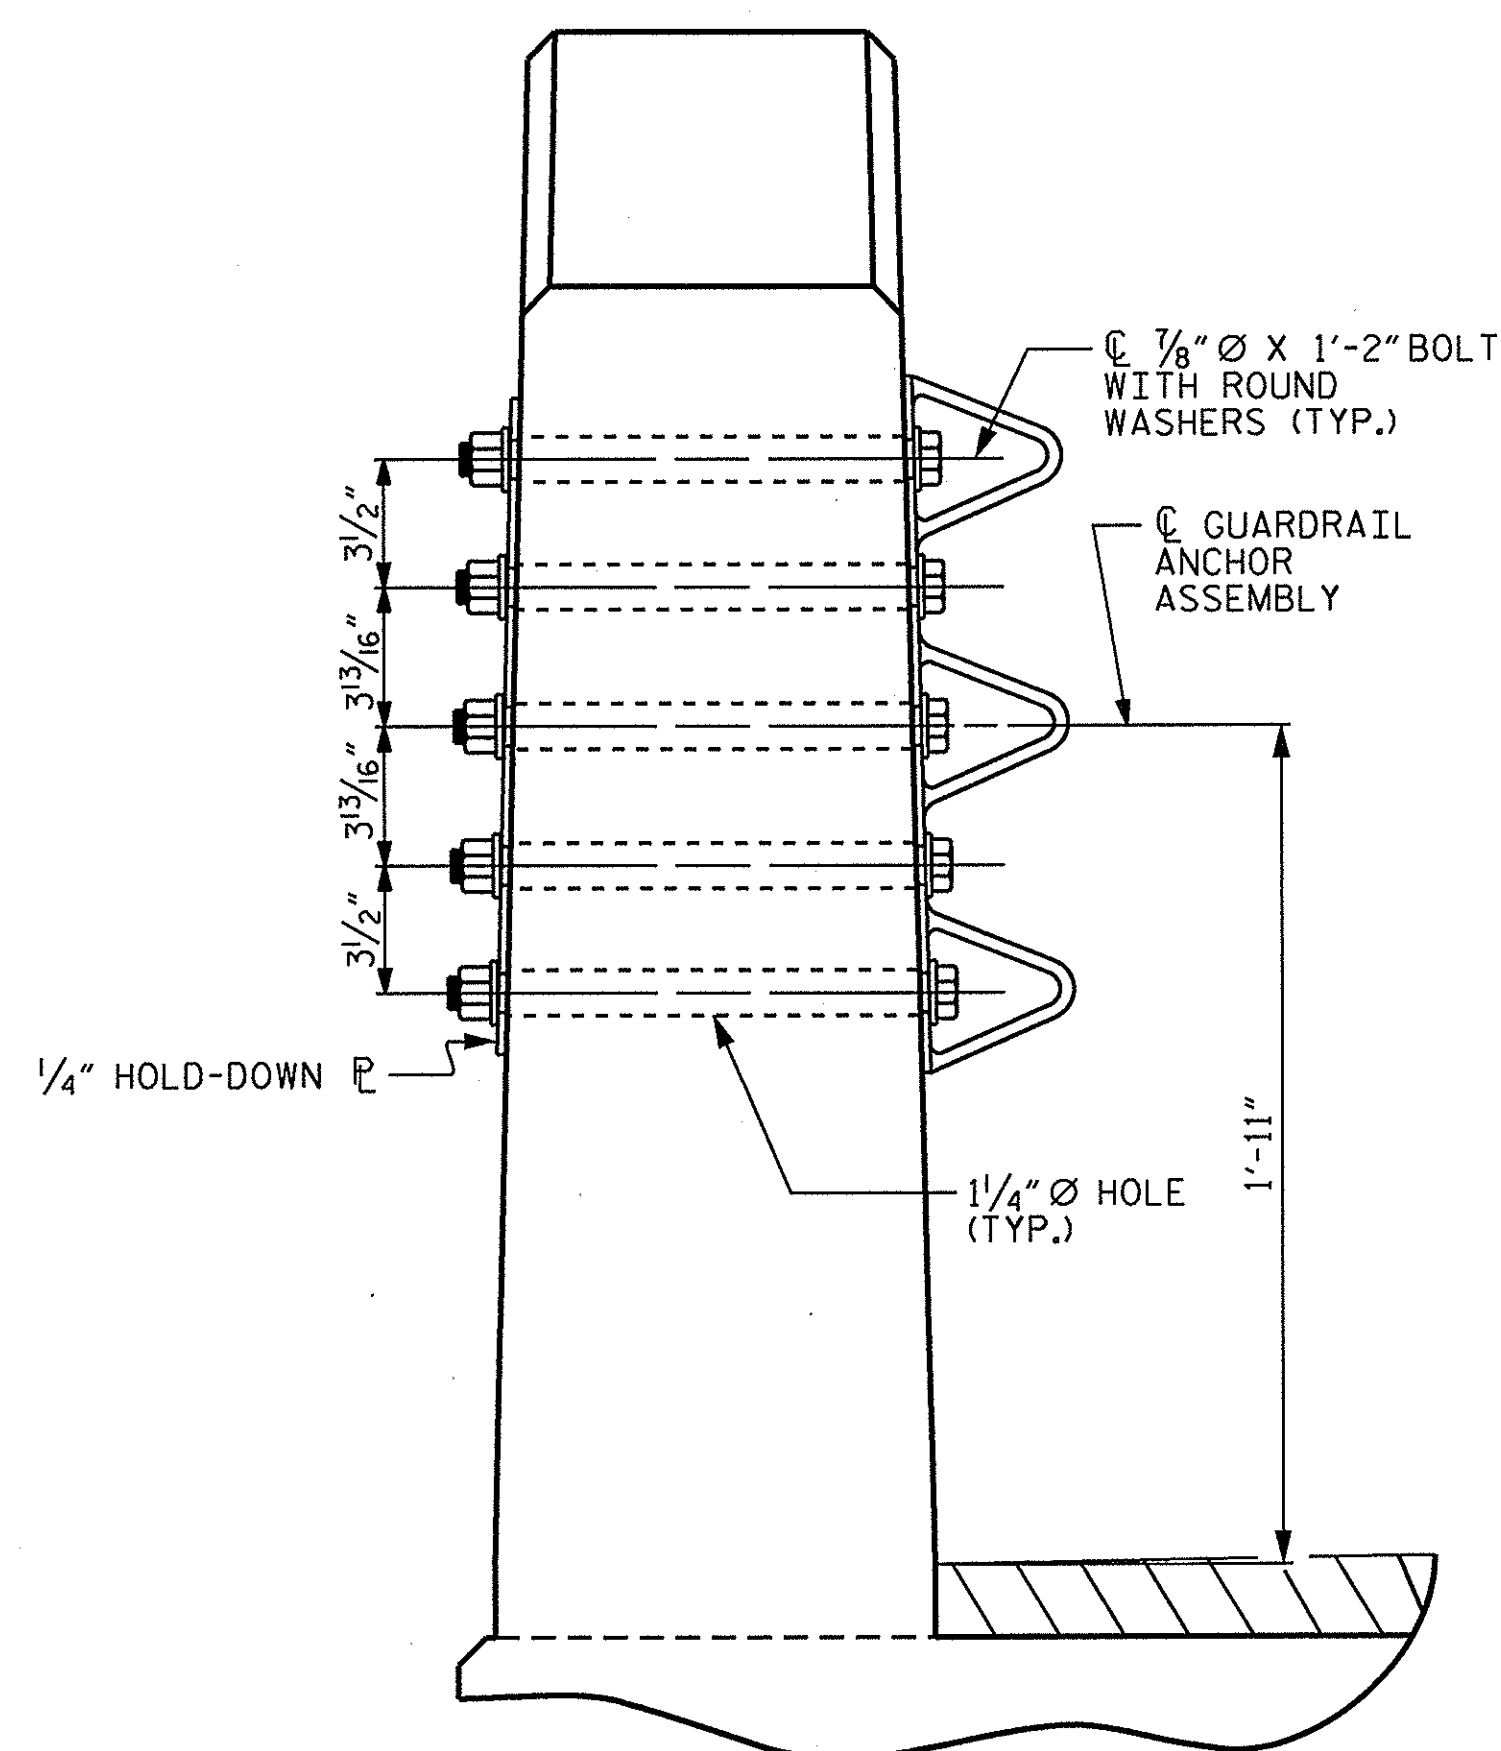


SECTION E-E  
GUARDRAIL ANCHOR ASSEMBLY DETAILS

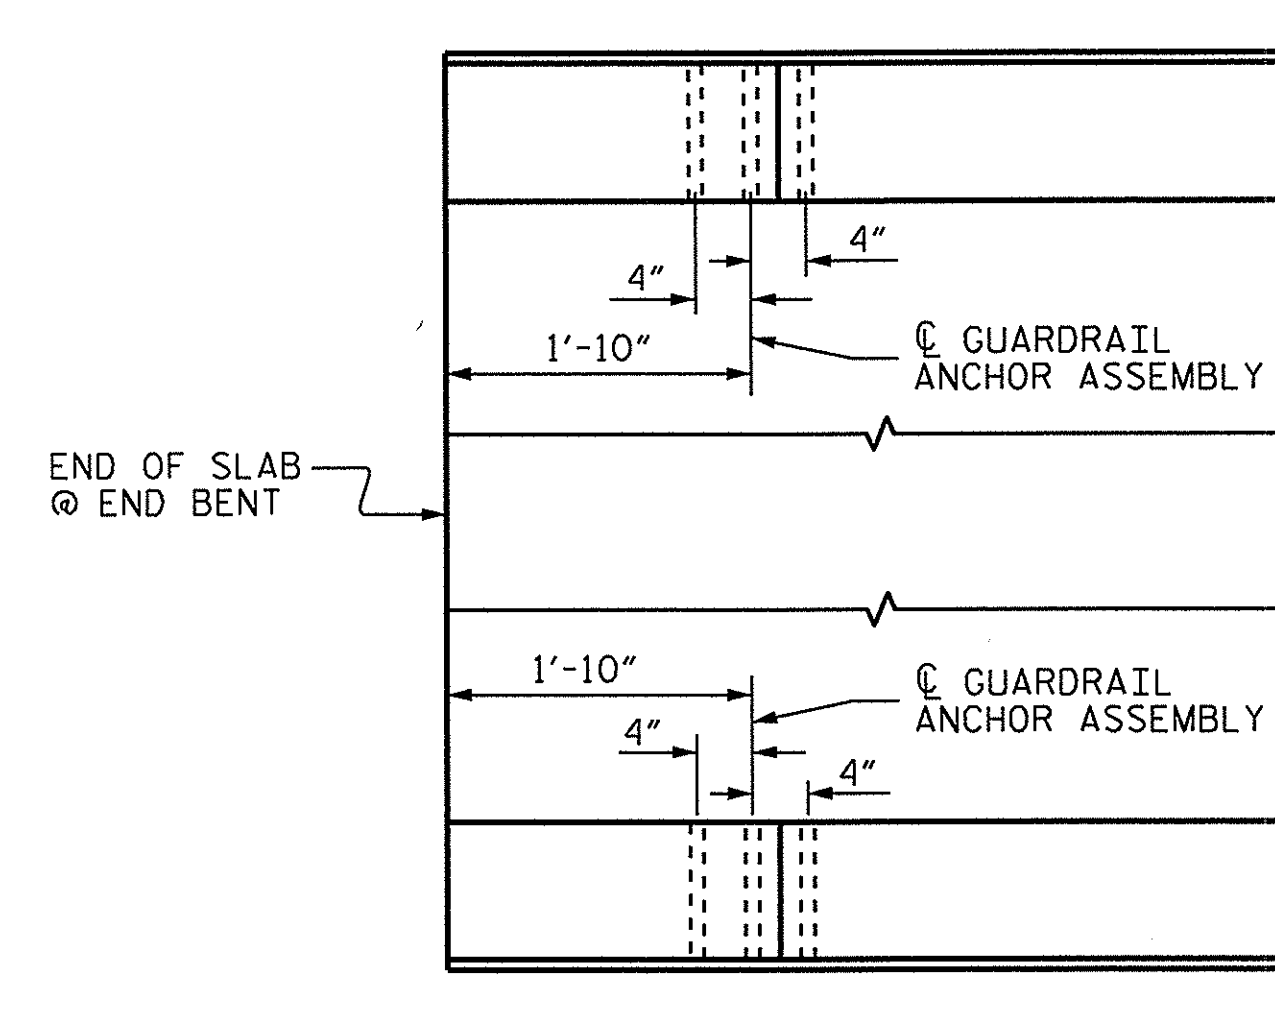

PLAN

LOCATION OF ANCHORS FOR GUARDRAIL

END BENT 1 SHOWN, END BENT 2 SIMILAR.

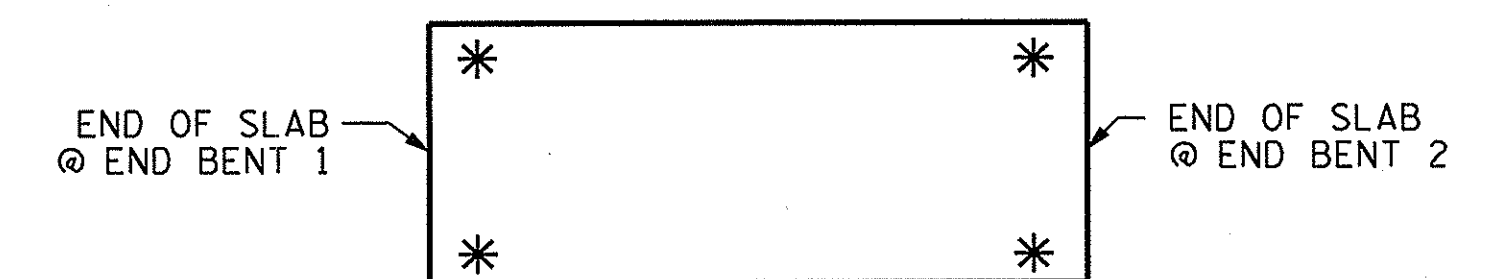


SKETCH SHOWING POINTS OF ATTACHMENT

\* DENOTES GUARDRAIL ANCHOR ASSEMBLY

PROJECT NO. 17BP.2.R.51  
GREENE COUNTY  
STATION: 14+81.00 -L-

STATE OF NORTH CAROLINA  
DEPARTMENT OF TRANSPORTATION  
RALEIGH  
STANDARD  
GUARDRAIL ANCHORAGE  
FOR VERTICAL CONCRETE  
BARRIER RAIL

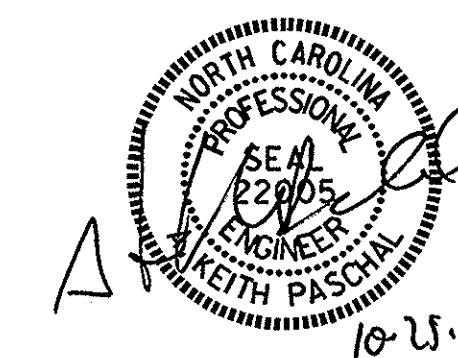

| REVISIONS |     |       |     |     |       | SHEET NO.    |
|-----------|-----|-------|-----|-----|-------|--------------|
| NO.       | BY: | DATE: | NO. | BY: | DATE: | S-9          |
| 1         |     |       | 3   |     |       | TOTAL SHEETS |
| 2         |     |       | 4   |     |       | 17           |

|                              |                     |
|------------------------------|---------------------|
| ASSEMBLED BY : A. H. SHIVELY | DATE : 6/25/13      |
| CHECKED BY : M. L. RORIE     | DATE : 7/22/13      |
| DRAWN BY : MAA 5/10          | REV. 10/1/11 MAA/GM |
| CHECKED BY : GM 5/10         | REV. 12/5/11 MAA/GM |
|                              | REV. 6/13 MAA/GM    |

**NOTES**

STIRRUPS IN CAP MAY BE SHIFTED AS NECESSARY TO CLEAR DOWELS.

THE LATERAL GUIDES ARE NOT TO BE POURED UNTIL AFTER THE CORED SLAB UNITS ARE IN PLACE.


THE CONCRETE IN THE SHADED AREA OF THE WING SHALL BE POURED AFTER THE VERTICAL CONCRETE BARRIER RAIL IS CAST IF SLIP FORMING IS USED.

FOR PILE SPLICE DETAILS, SEE SHEET 4 OF 4.

FOR WING DETAILS, SEE SHEET 3 OF 4.


THE CONTRACTOR HAS THE OPTION TO OMIT THE LATERAL GUIDE IF APPROVED BY THE ENGINEER.

INSTALL THE 4" Ø DRAIN PIPE THROUGH THE WING WALL AS REQUIRED. FOR REINFORCED BRIDGE APPROACH FILLS, SEE ROADWAY PLANS. REINFORCING STEEL IN THE WING WALL MAY BE SHIFTED AS NECESSARY TO CLEAR THE DRAIN PIPE.

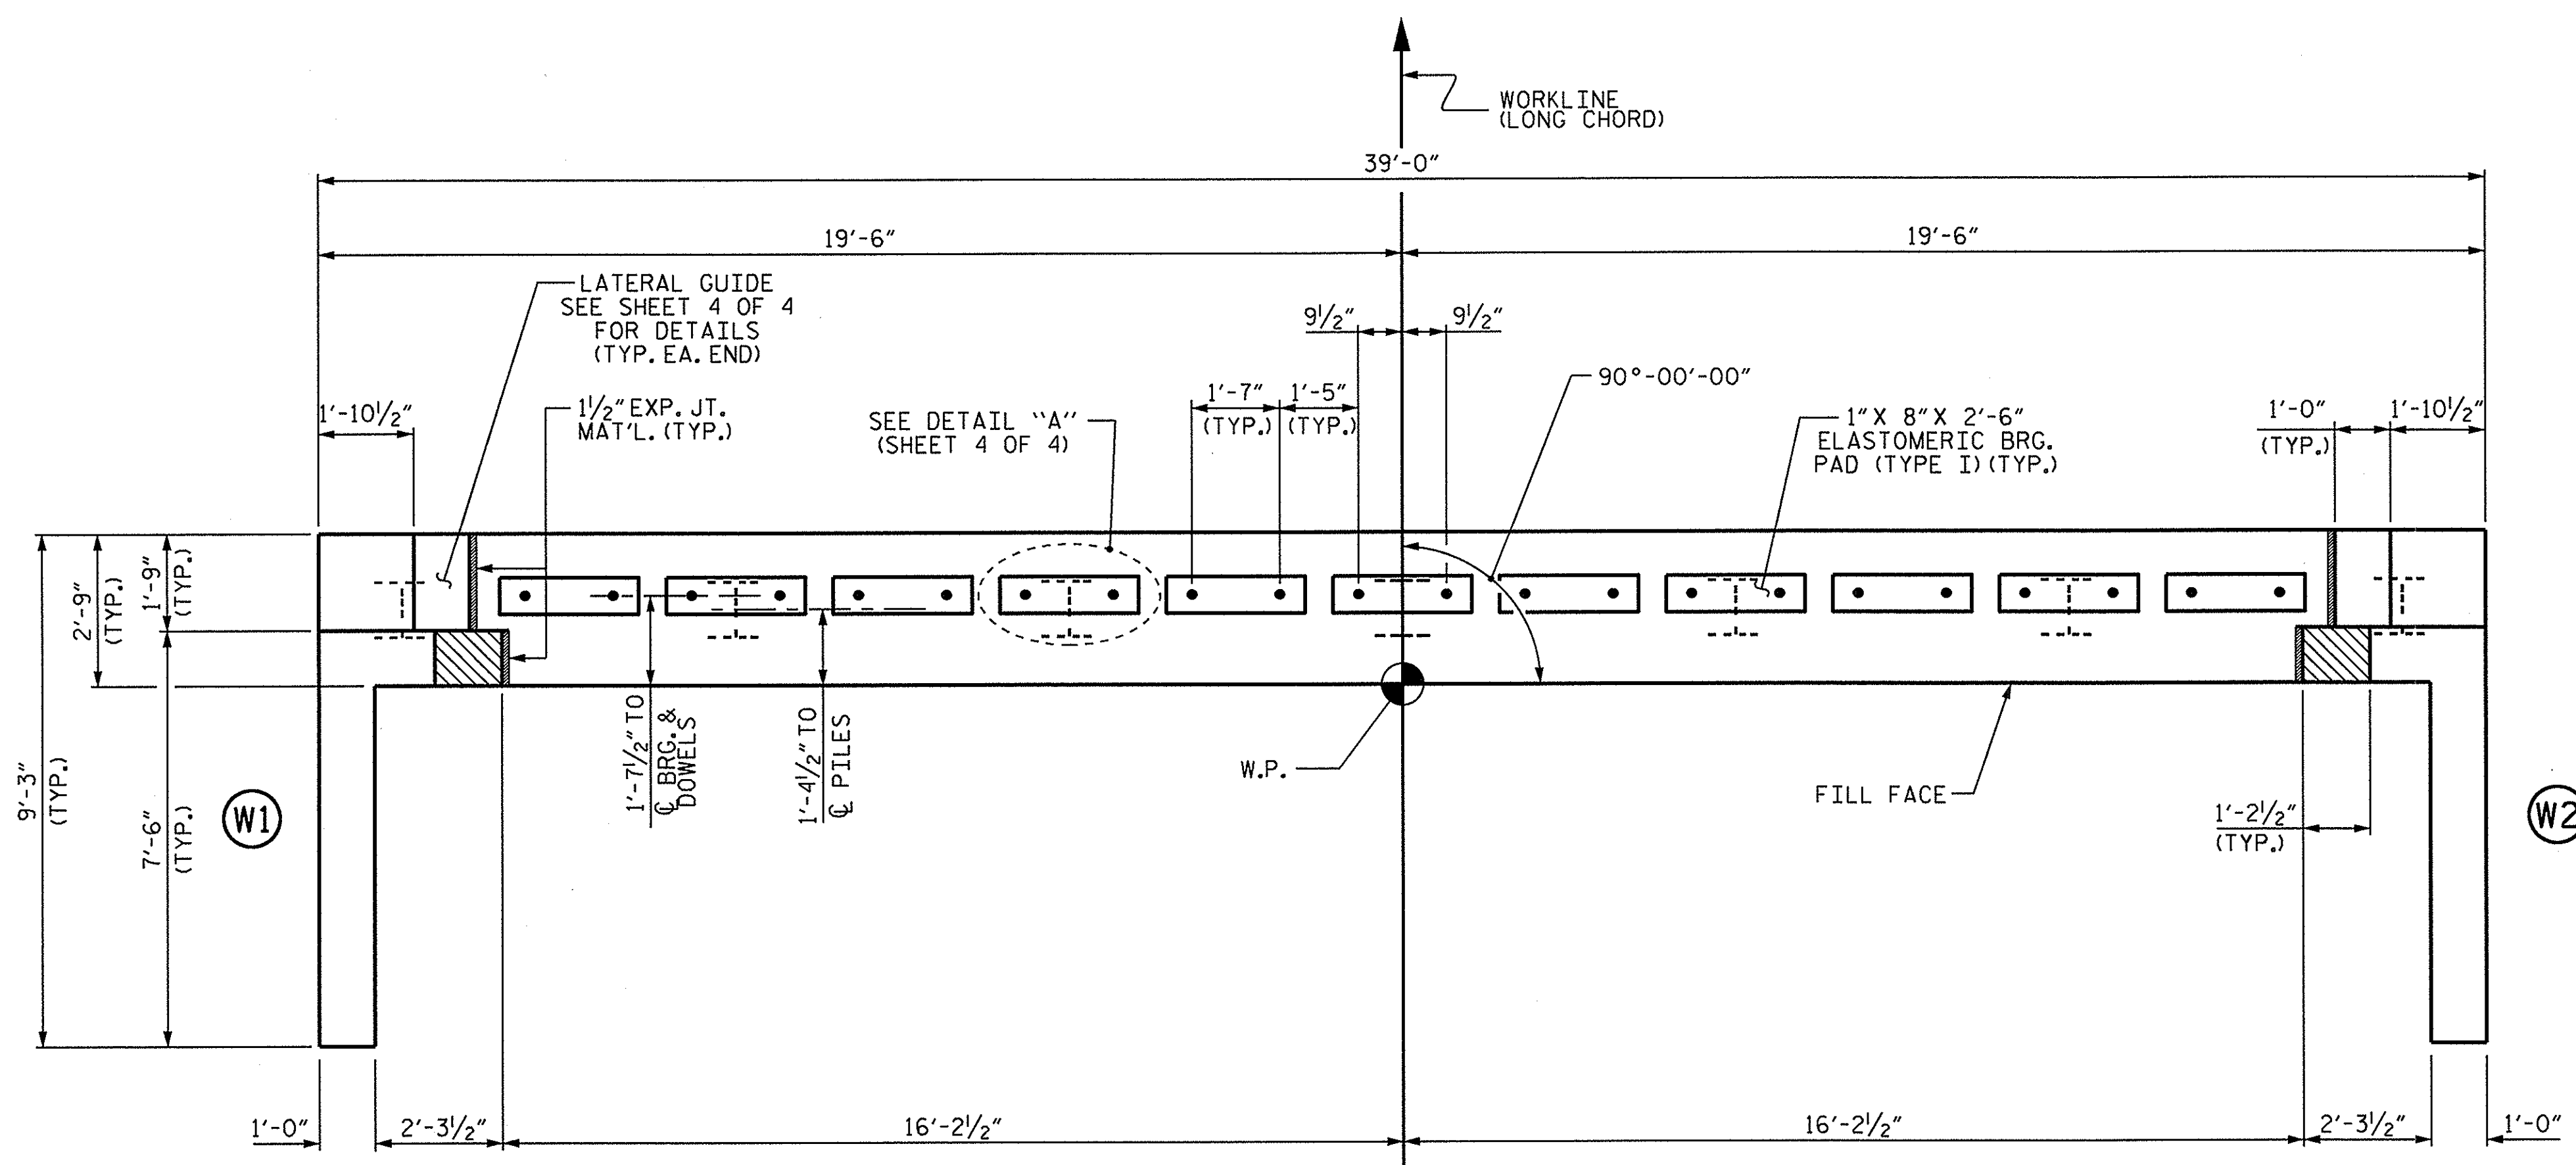

**PLAN**

| TOP OF PILE ELEVATIONS |       |
|------------------------|-------|
| ①                      | 38.95 |
| ②                      | 38.71 |
| ③                      | 38.47 |
| ④                      | 38.23 |
| ⑤                      | 37.99 |
| ⑥                      | 37.75 |
| ⑦                      | 37.51 |

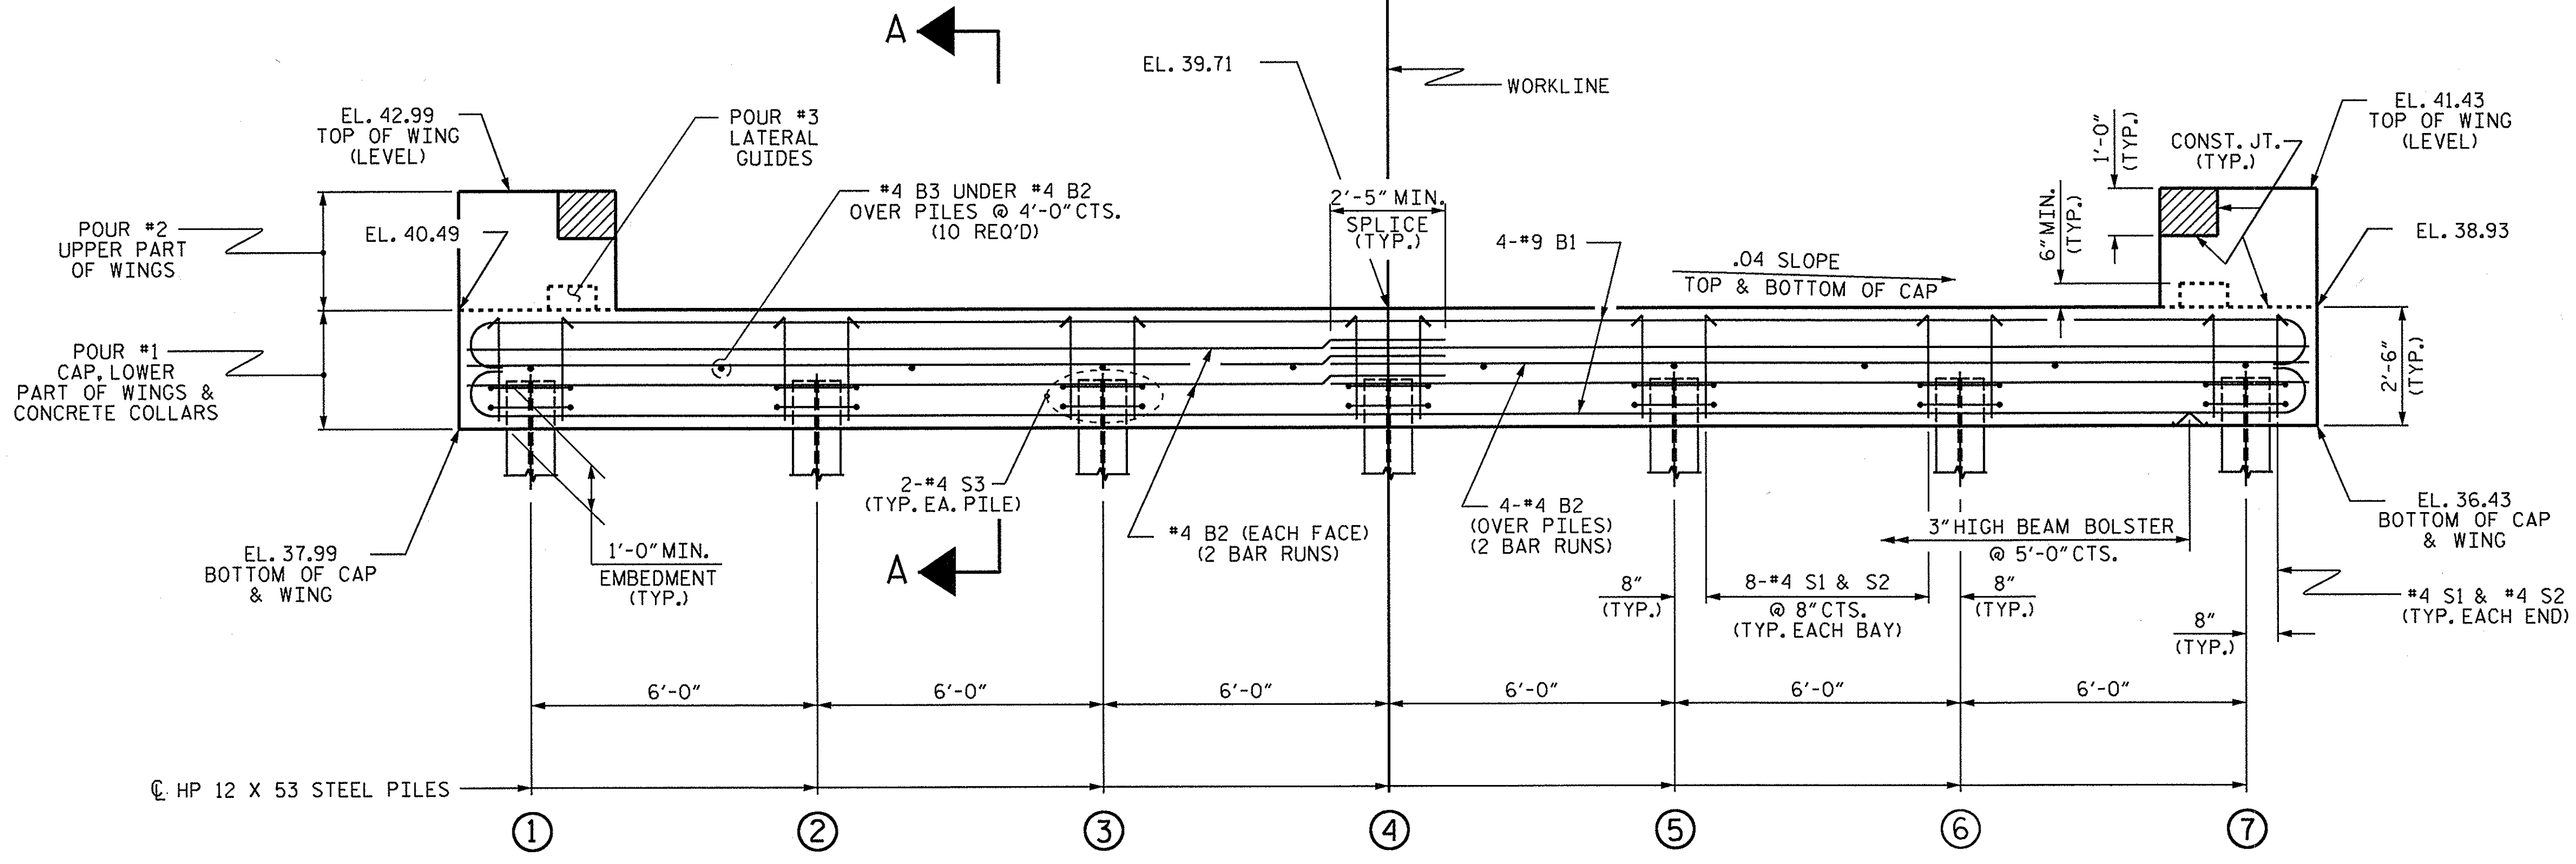

**ELEVATION**


WINGS NOT SHOWN FOR CLARITY.  
 FOR SECTION A-A, SEE SHEET 4 OF 4.  
 CONCRETE COLLARS FOR STEEL PILES NOT SHOWN IN PLAN AND ELEVATION VIEWS FOR CLARITY.  
 SEE "CORROSION PROTECTION FOR STEEL PILES DETAIL", SHEET 4 OF 4.

PROJECT NO. 17BP.2.R.51  
 GREENE COUNTY  
 STATION: 14+81.00 -L-

SHEET 1 OF 4

STATE OF NORTH CAROLINA  
 DEPARTMENT OF TRANSPORTATION  
 RALEIGH

SUBSTRUCTURE  
 END BENT No. 1

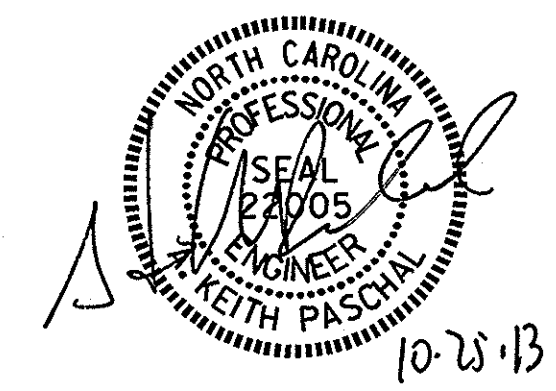

ASSEMBLED BY: A. H. SHIVELY DATE: 6/24/13  
 CHECKED BY: M. L. RORIE DATE: 8/9/13  
 DRAWN BY: DGE 02/10  
 CHECKED BY: MKT 02/10

| REVISIONS |     |       |     |     |       | SHEET NO.    |
|-----------|-----|-------|-----|-----|-------|--------------|
| NO.       | BY: | DATE: | NO. | BY: | DATE: | S-10         |
| 1         |     |       | 3   |     |       | TOTAL SHEETS |
| 2         |     |       | 4   |     |       | 17           |

STD. NO. EB-33-90S

**NOTES**

STIRRUPS IN CAP MAY BE SHIFTED AS NECESSARY TO CLEAR DOWELS.

THE LATERAL GUIDES ARE NOT TO BE POURED UNTIL AFTER THE CORED SLAB UNITS ARE IN PLACE.


THE CONCRETE IN THE SHADED AREA OF THE WING SHALL BE POURED AFTER THE VERTICAL CONCRETE BARRIER RAIL IS CAST IF SLIP FORMING IS USED.

FOR PILE SPLICE DETAILS, SEE SHEET 4 OF 4.


FOR WING DETAILS, SEE SHEET 3 OF 4.

THE CONTRACTOR HAS THE OPTION TO OMIT THE LATERAL GUIDE IF APPROVED BY THE ENGINEER.

INSTALL THE 4" Ø DRAIN PIPE THROUGH THE WING WALL AS REQUIRED. FOR REINFORCED BRIDGE APPROACH FILLS, SEE ROADWAY PLANS. REINFORCING STEEL IN THE WING WALL MAY BE SHIFTED AS NECESSARY TO CLEAR THE DRAIN PIPE.

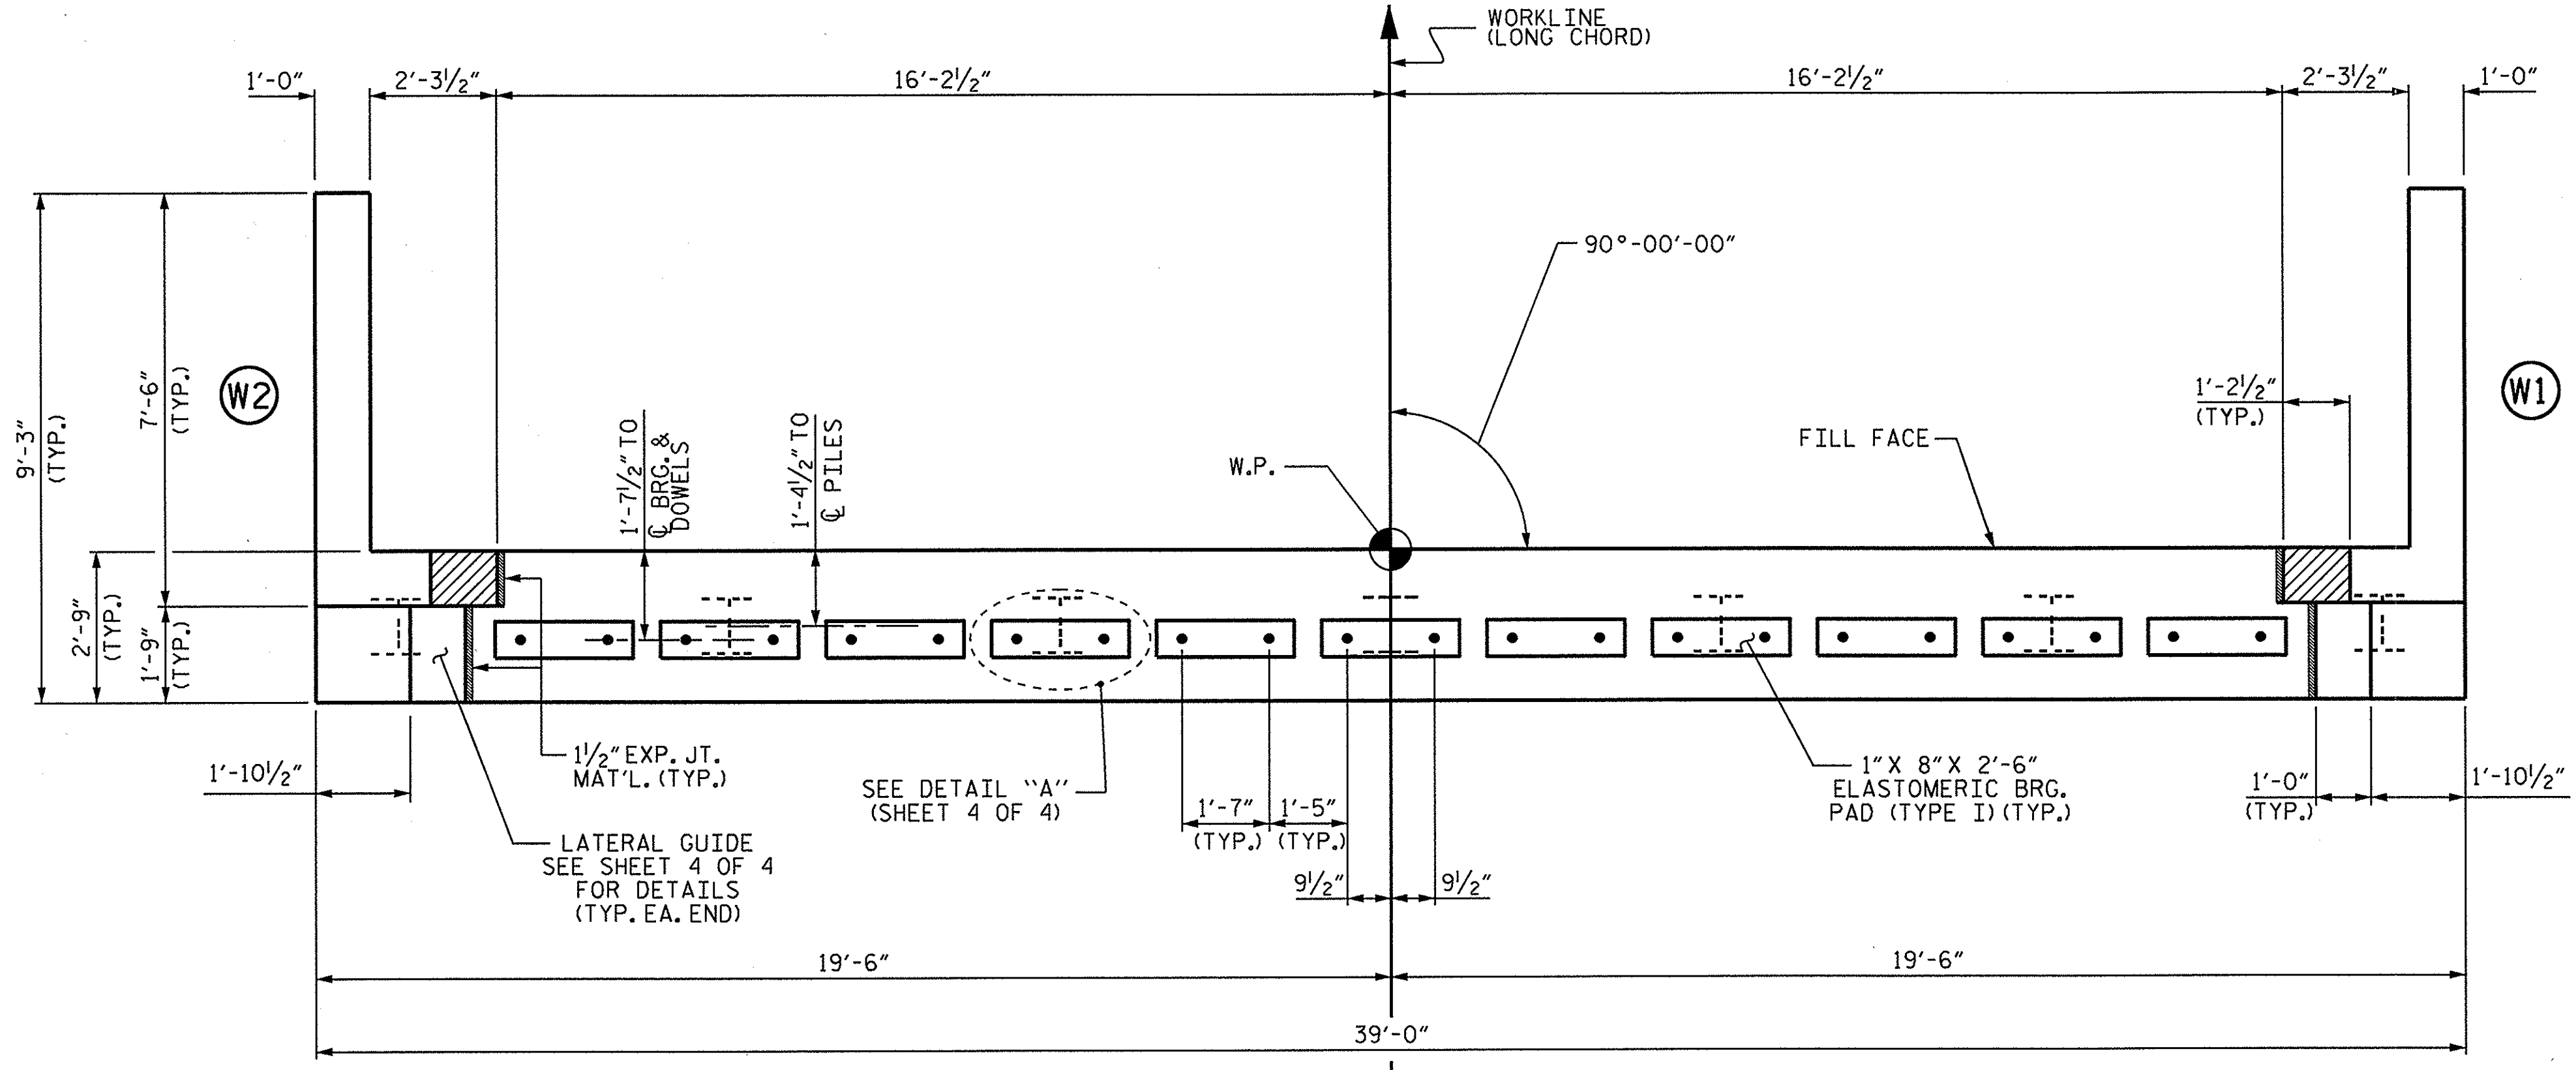

**PLAN**

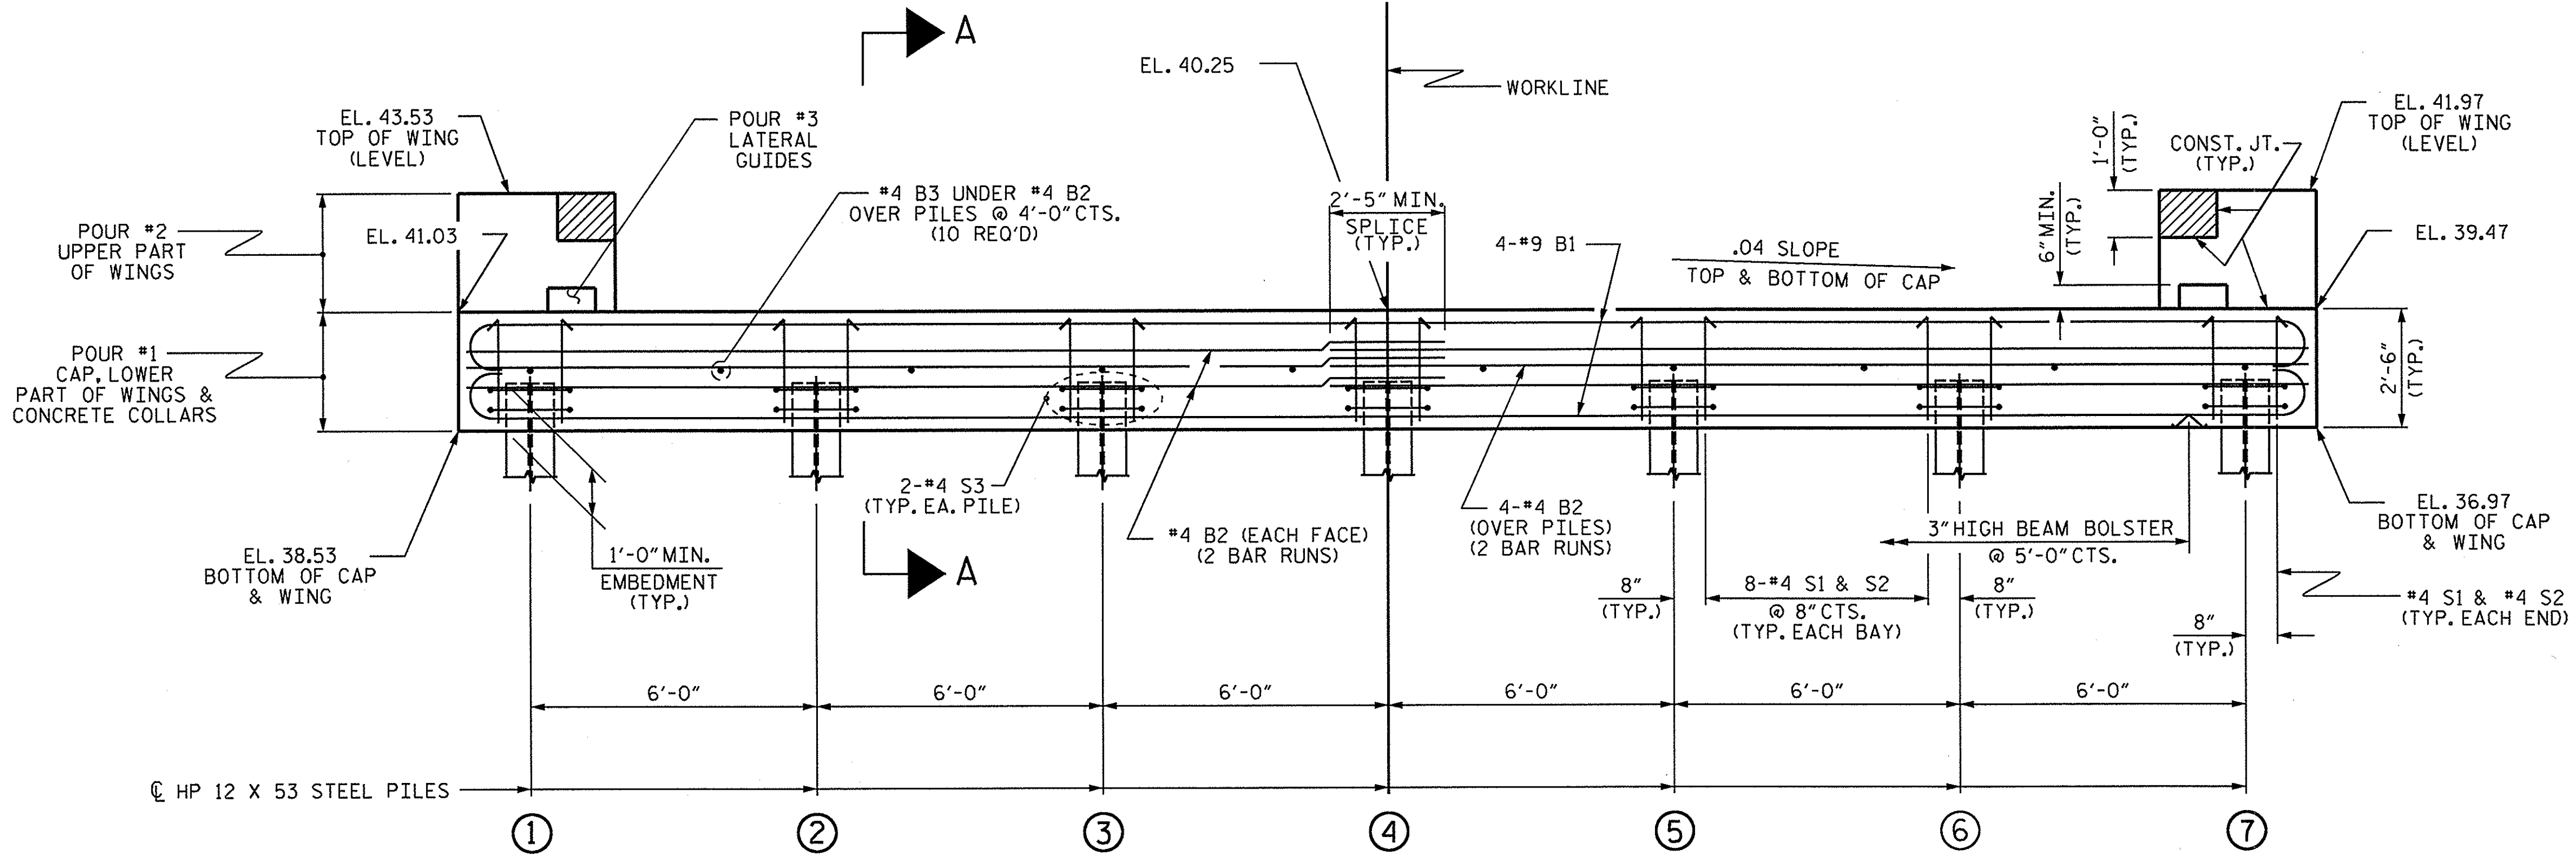

**ELEVATION**

WINGS NOT SHOWN FOR CLARITY. FOR SECTION A-A, SEE SHEET 4 OF 4.

CONCRETE COLLARS FOR STEEL PILES NOT SHOWN IN PLAN AND ELEVATION VIEWS FOR CLARITY. SEE "CORROSION PROTECTION FOR STEEL PILES DETAIL", SHEET 4 OF 4.


| TOP OF PILE ELEVATIONS |       |
|------------------------|-------|
| ①                      | 39.49 |
| ②                      | 39.25 |
| ③                      | 39.01 |
| ④                      | 38.77 |
| ⑤                      | 38.53 |
| ⑥                      | 38.29 |
| ⑦                      | 38.05 |

PROJECT NO. 17BP.2.R.51  
GREENE COUNTY  
 STATION: 14+81.00 -L-

SHEET 2 OF 4


STATE OF NORTH CAROLINA  
 DEPARTMENT OF TRANSPORTATION  
 RALEIGH

SUBSTRUCTURE  
 END BENT No. 2

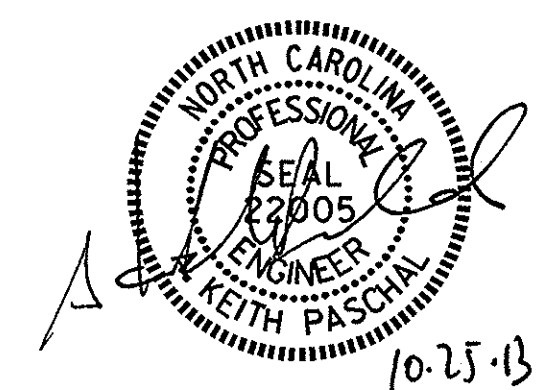


| REVISIONS |     |       |     |     |       | SHEET NO.<br>S-11  |
|-----------|-----|-------|-----|-----|-------|--------------------|
| NO.       | BY: | DATE: | NO. | BY: | DATE: |                    |
| 1         |     |       | 3   |     |       | TOTAL SHEETS<br>17 |
| 2         |     |       | 4   |     |       |                    |


ASSEMBLED BY : A. H. SHIVELY DATE : 6/24/13  
 CHECKED BY : M. L. RORIE DATE : 8/9/13  
 DRAWN BY : DGE 02/10  
 CHECKED BY : MKT 02/10

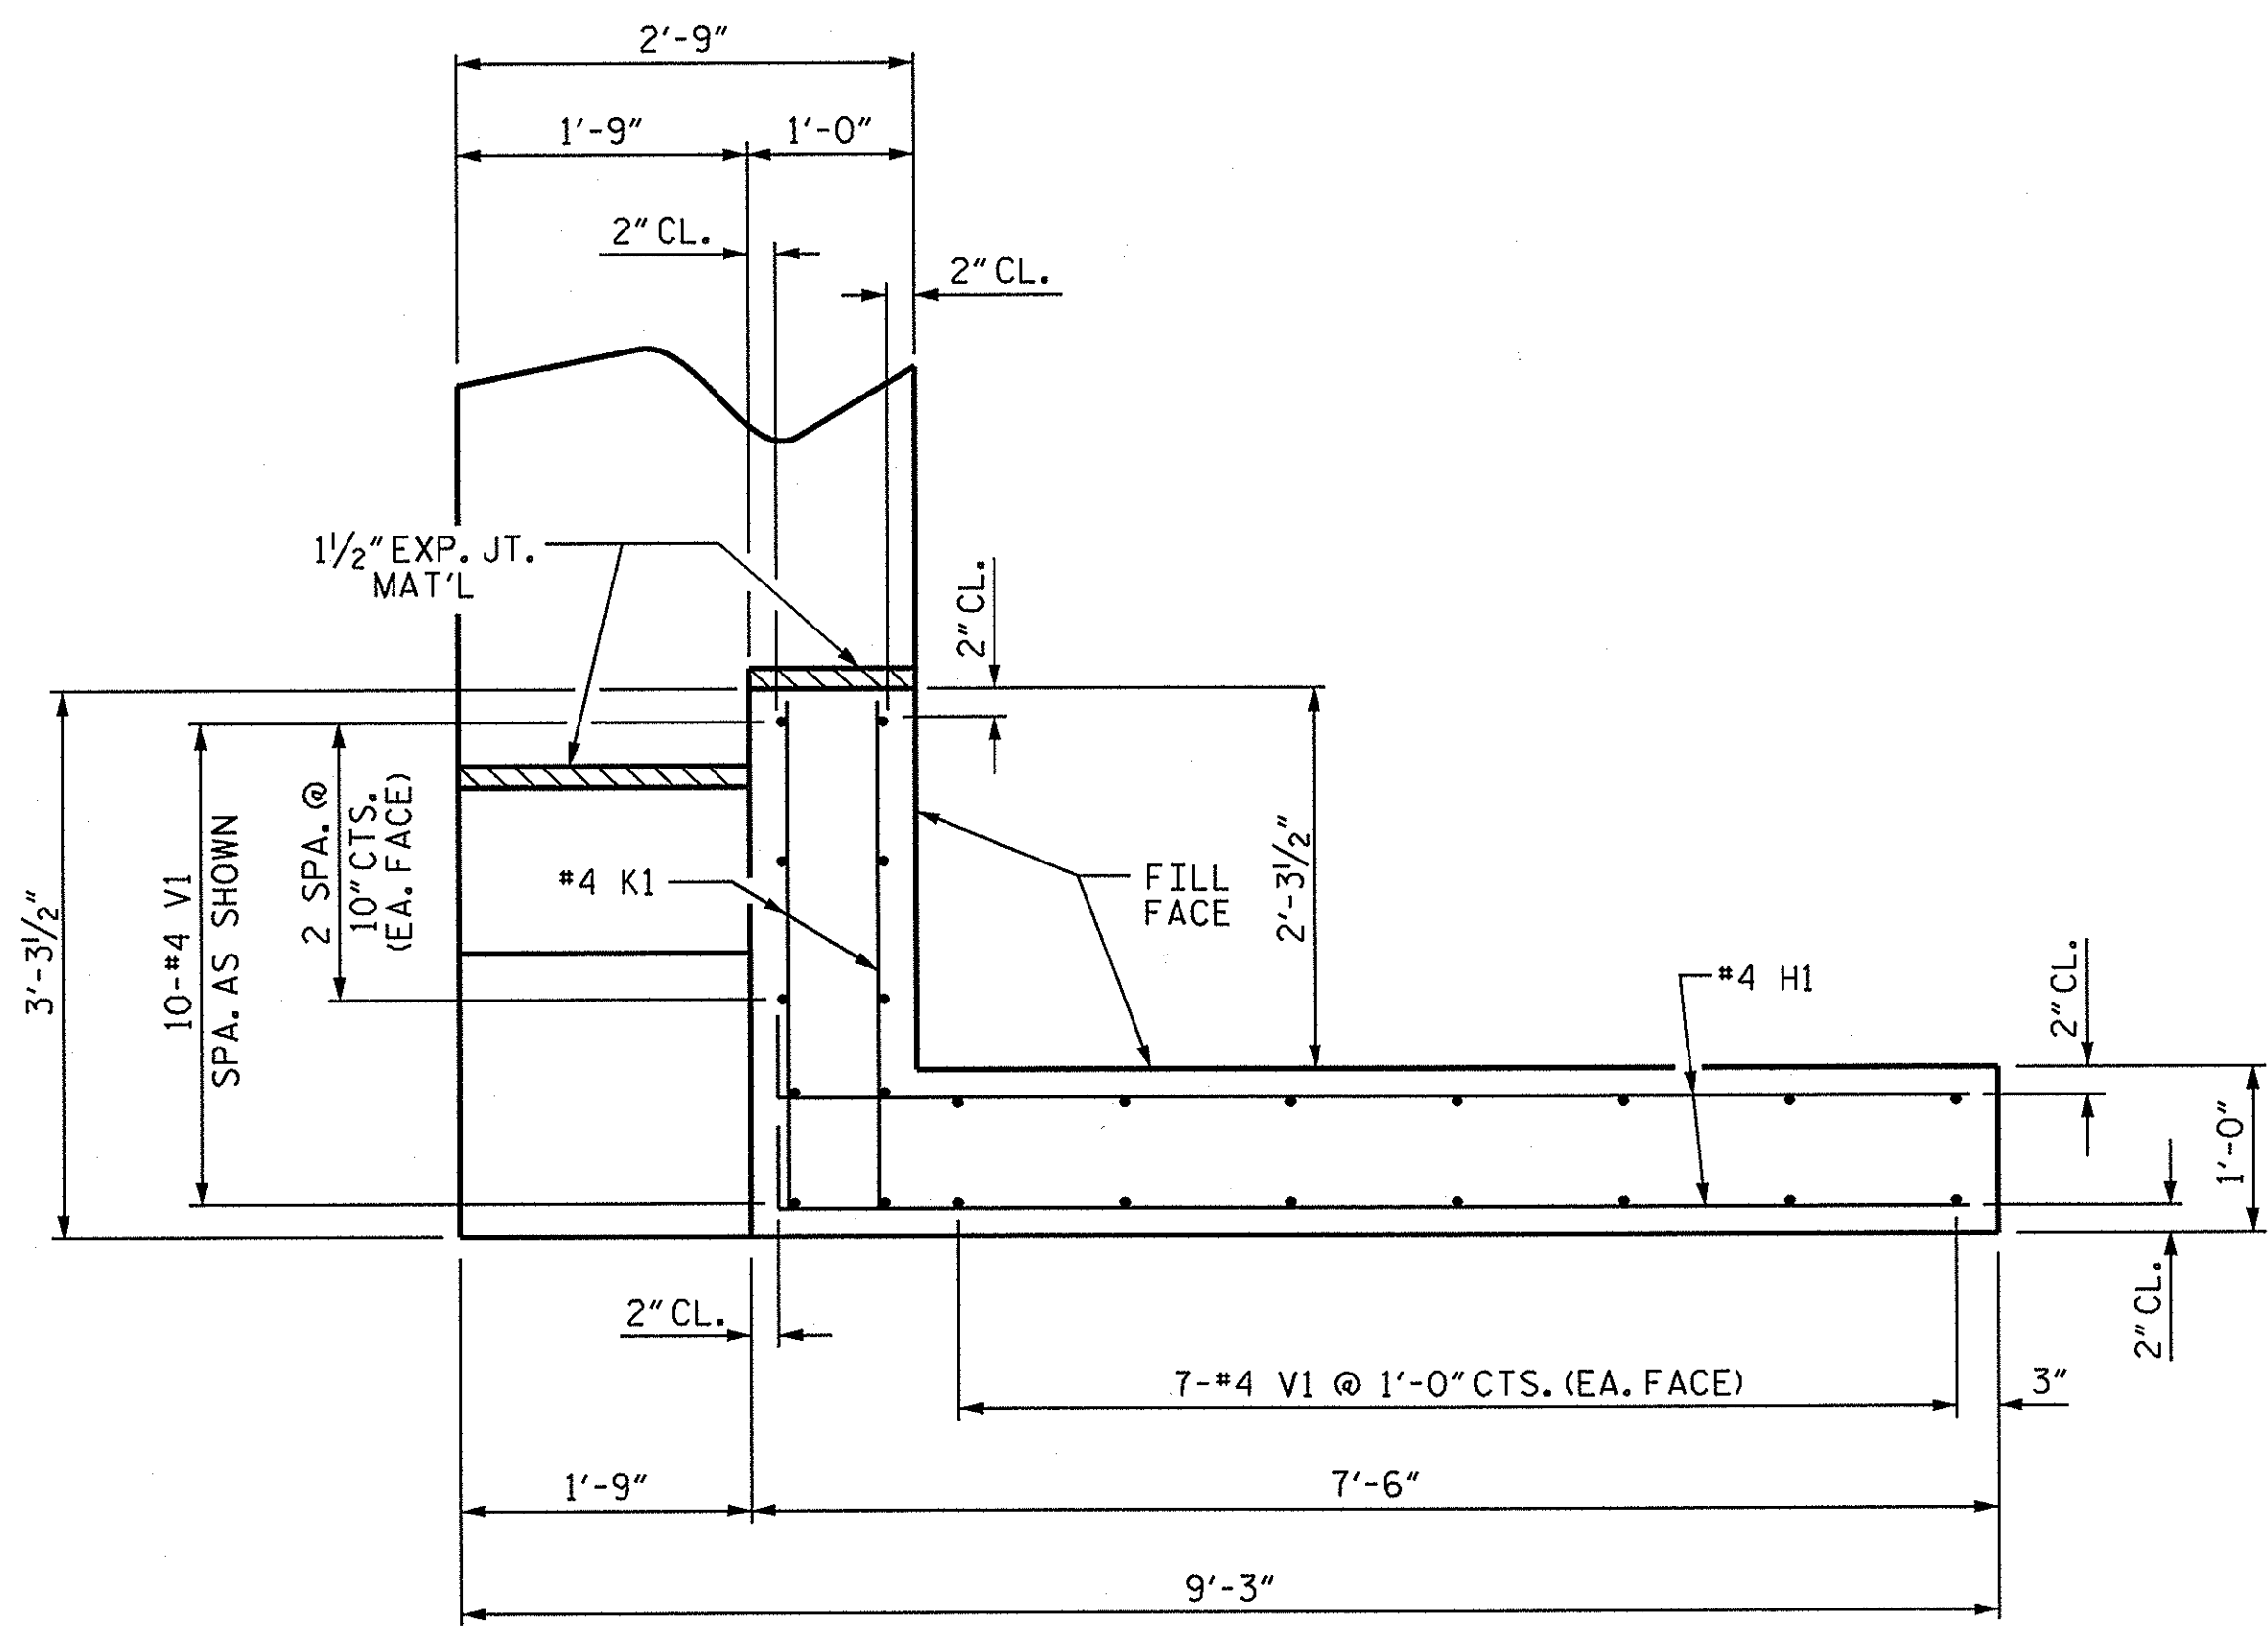


PLAN OF WING (W1)

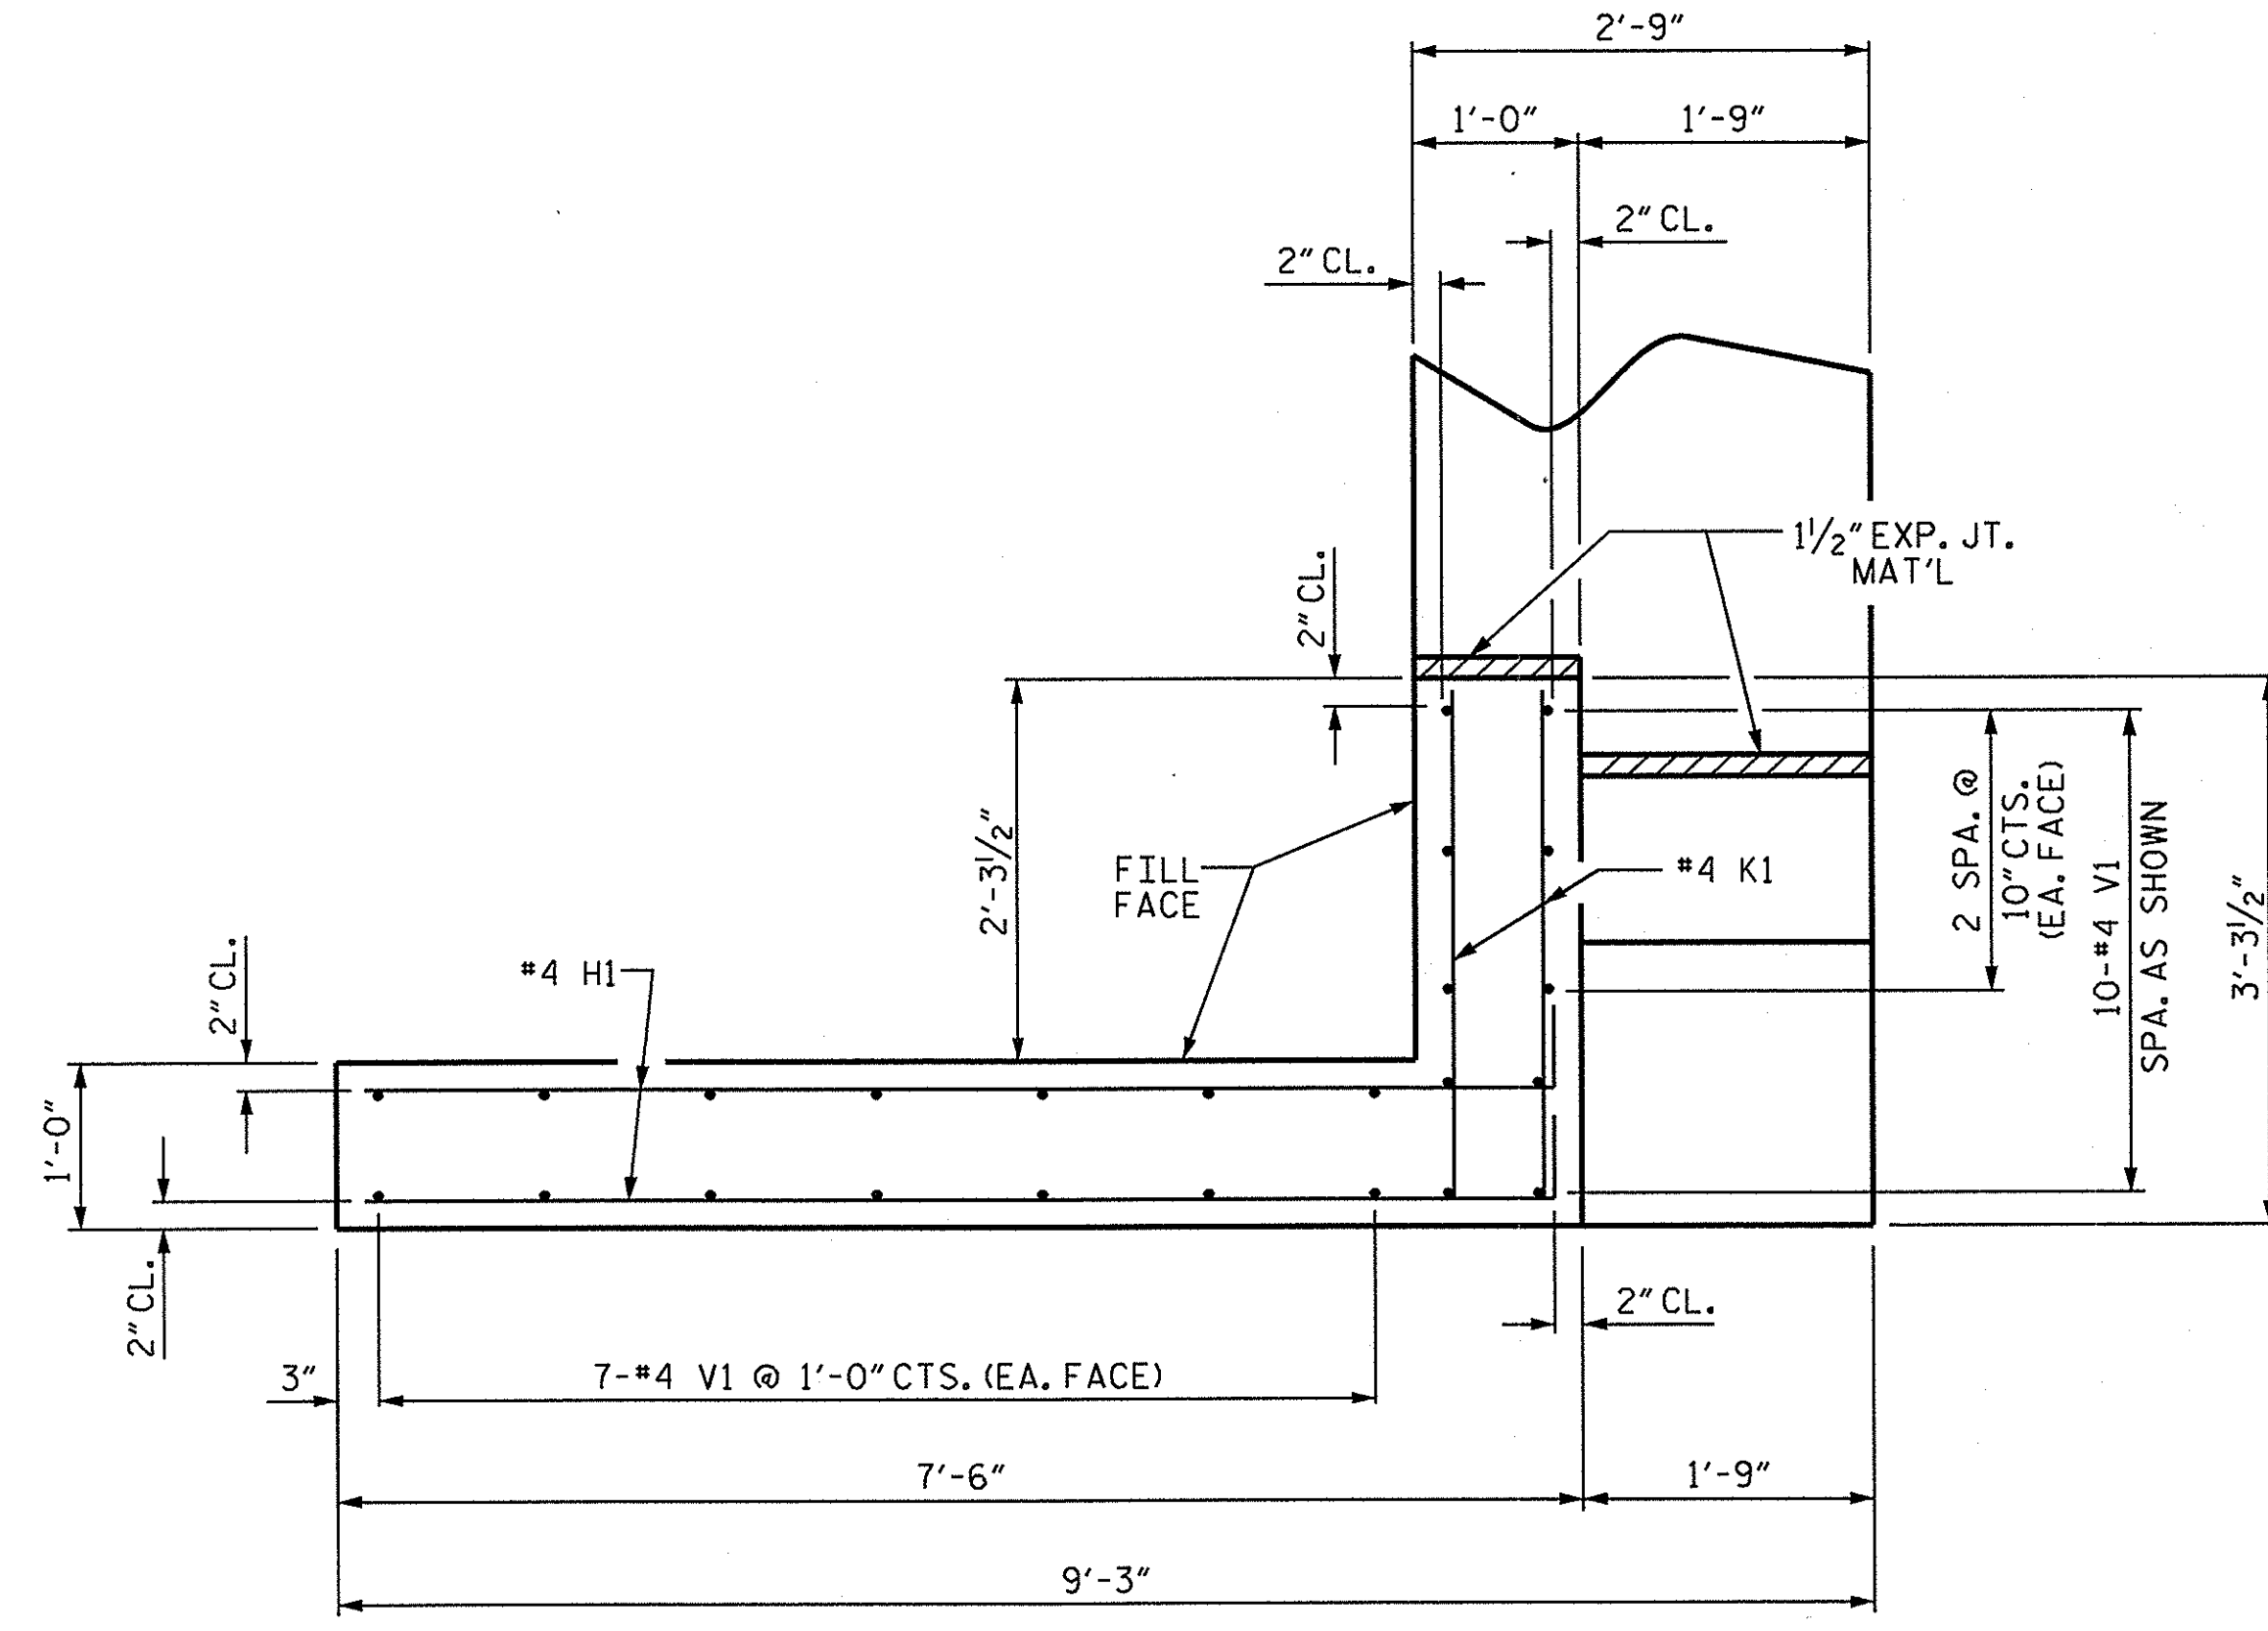

PLAN OF WING (W2)

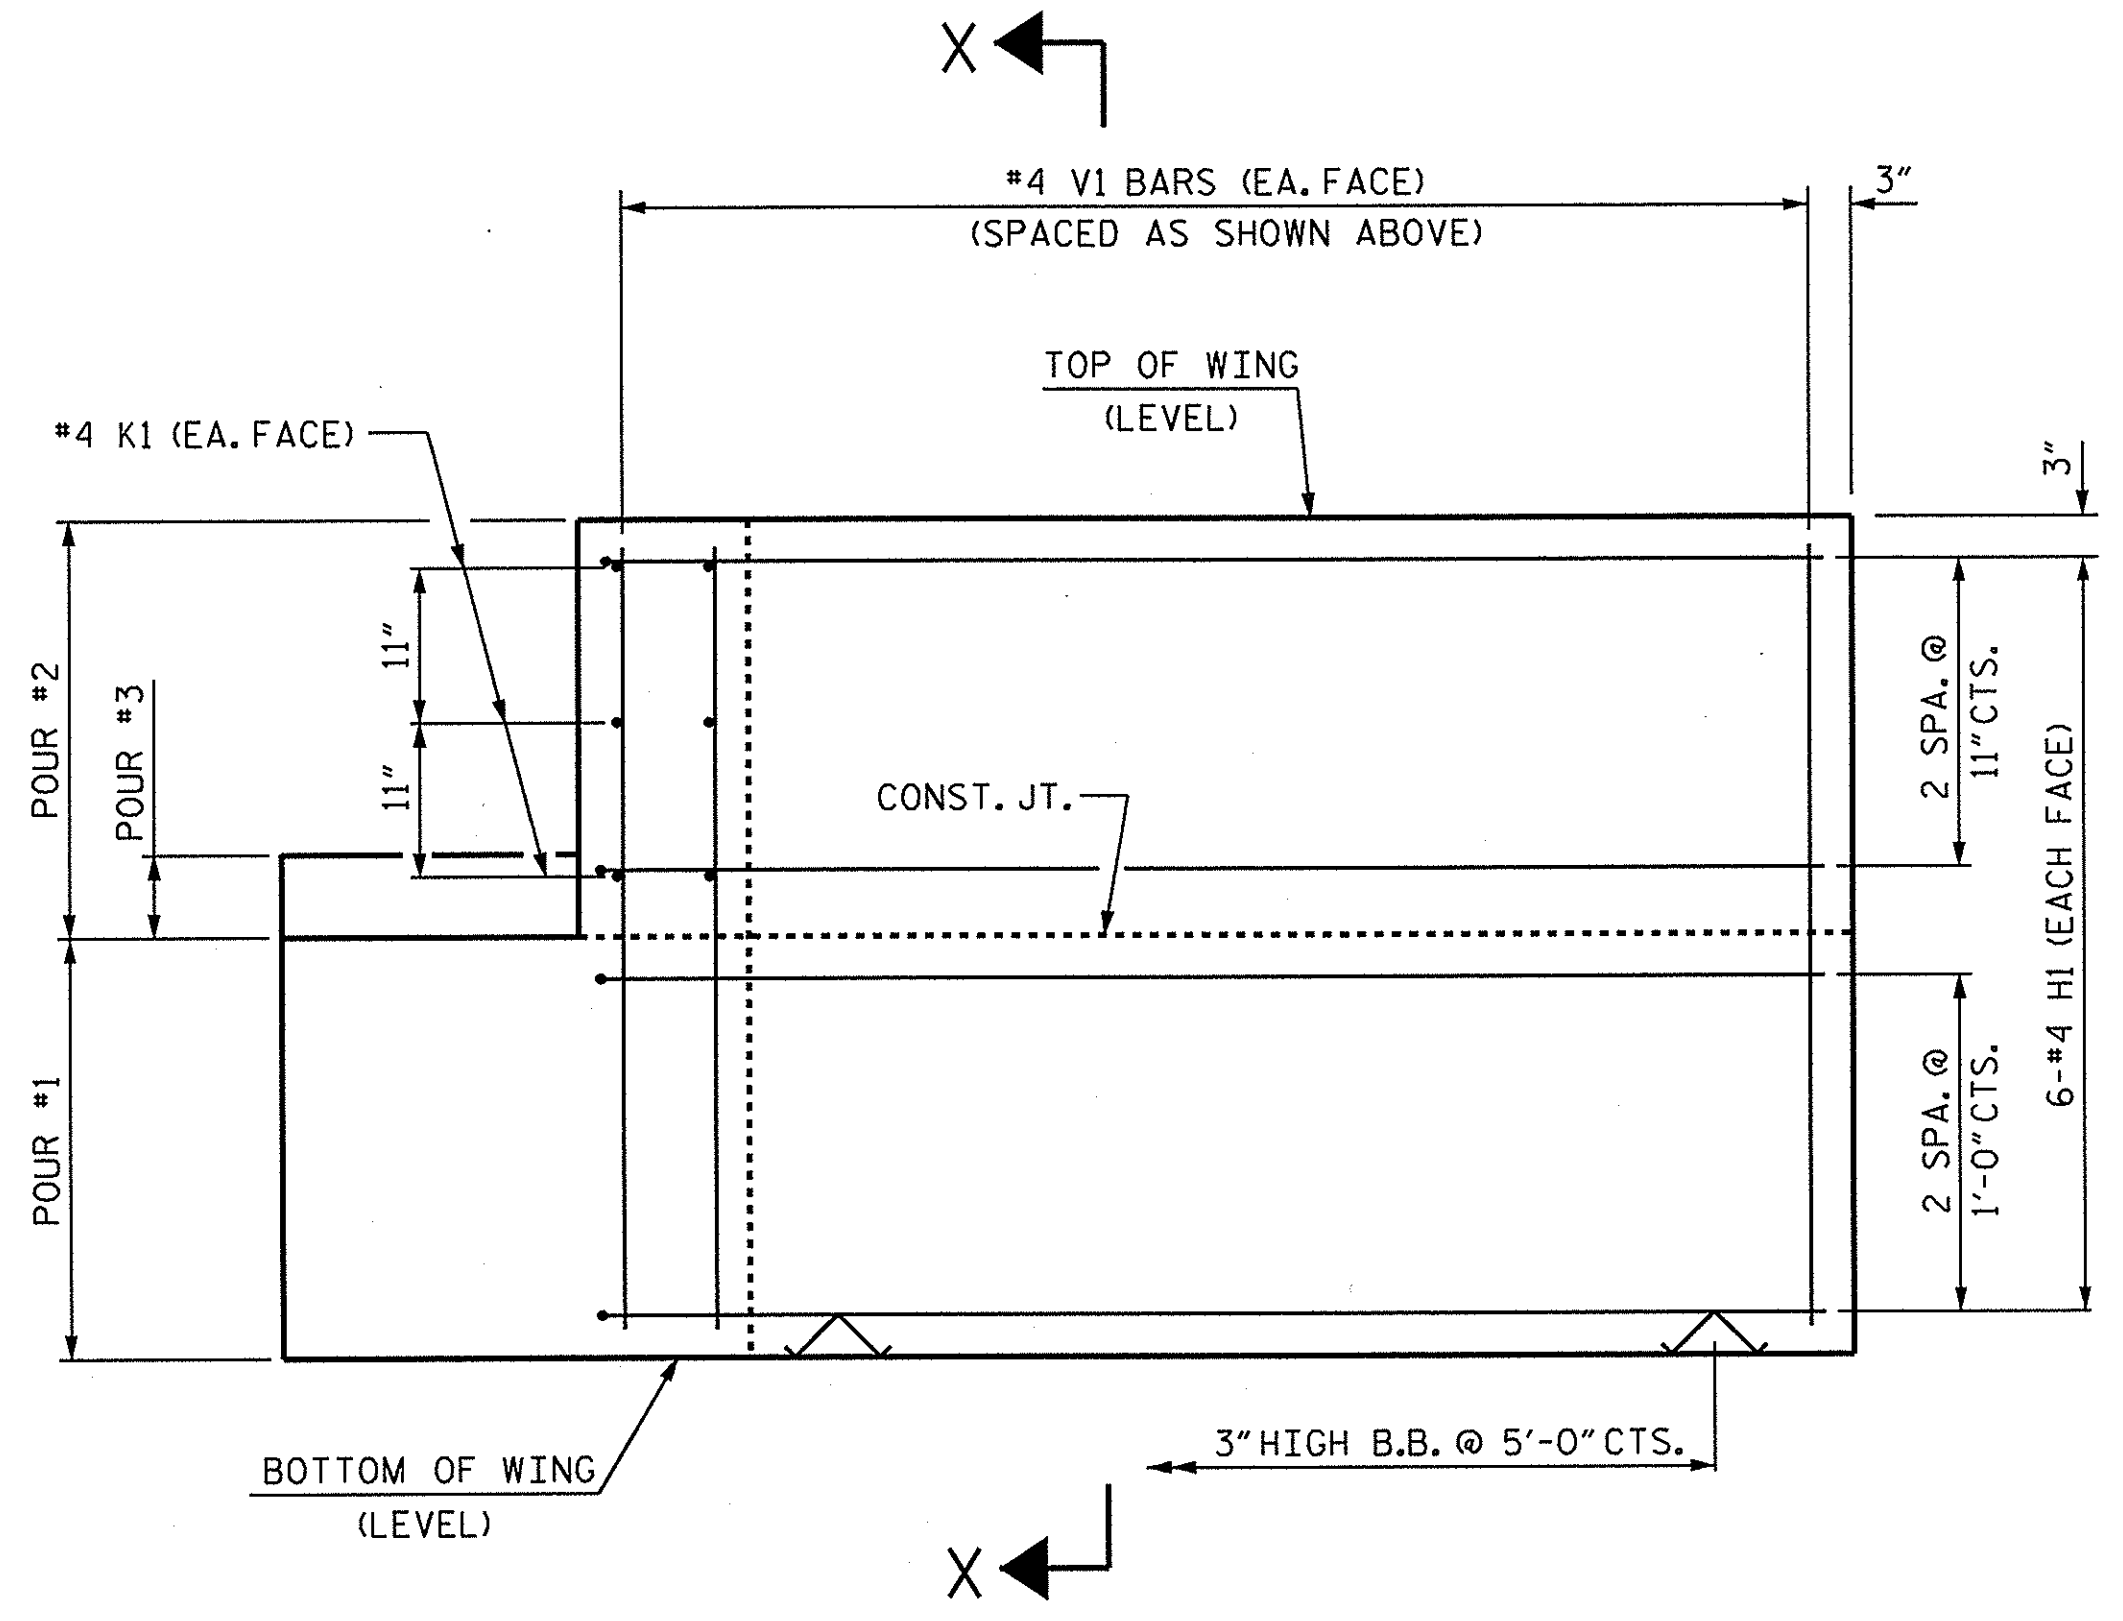


ELEVATION OF WING (W1)

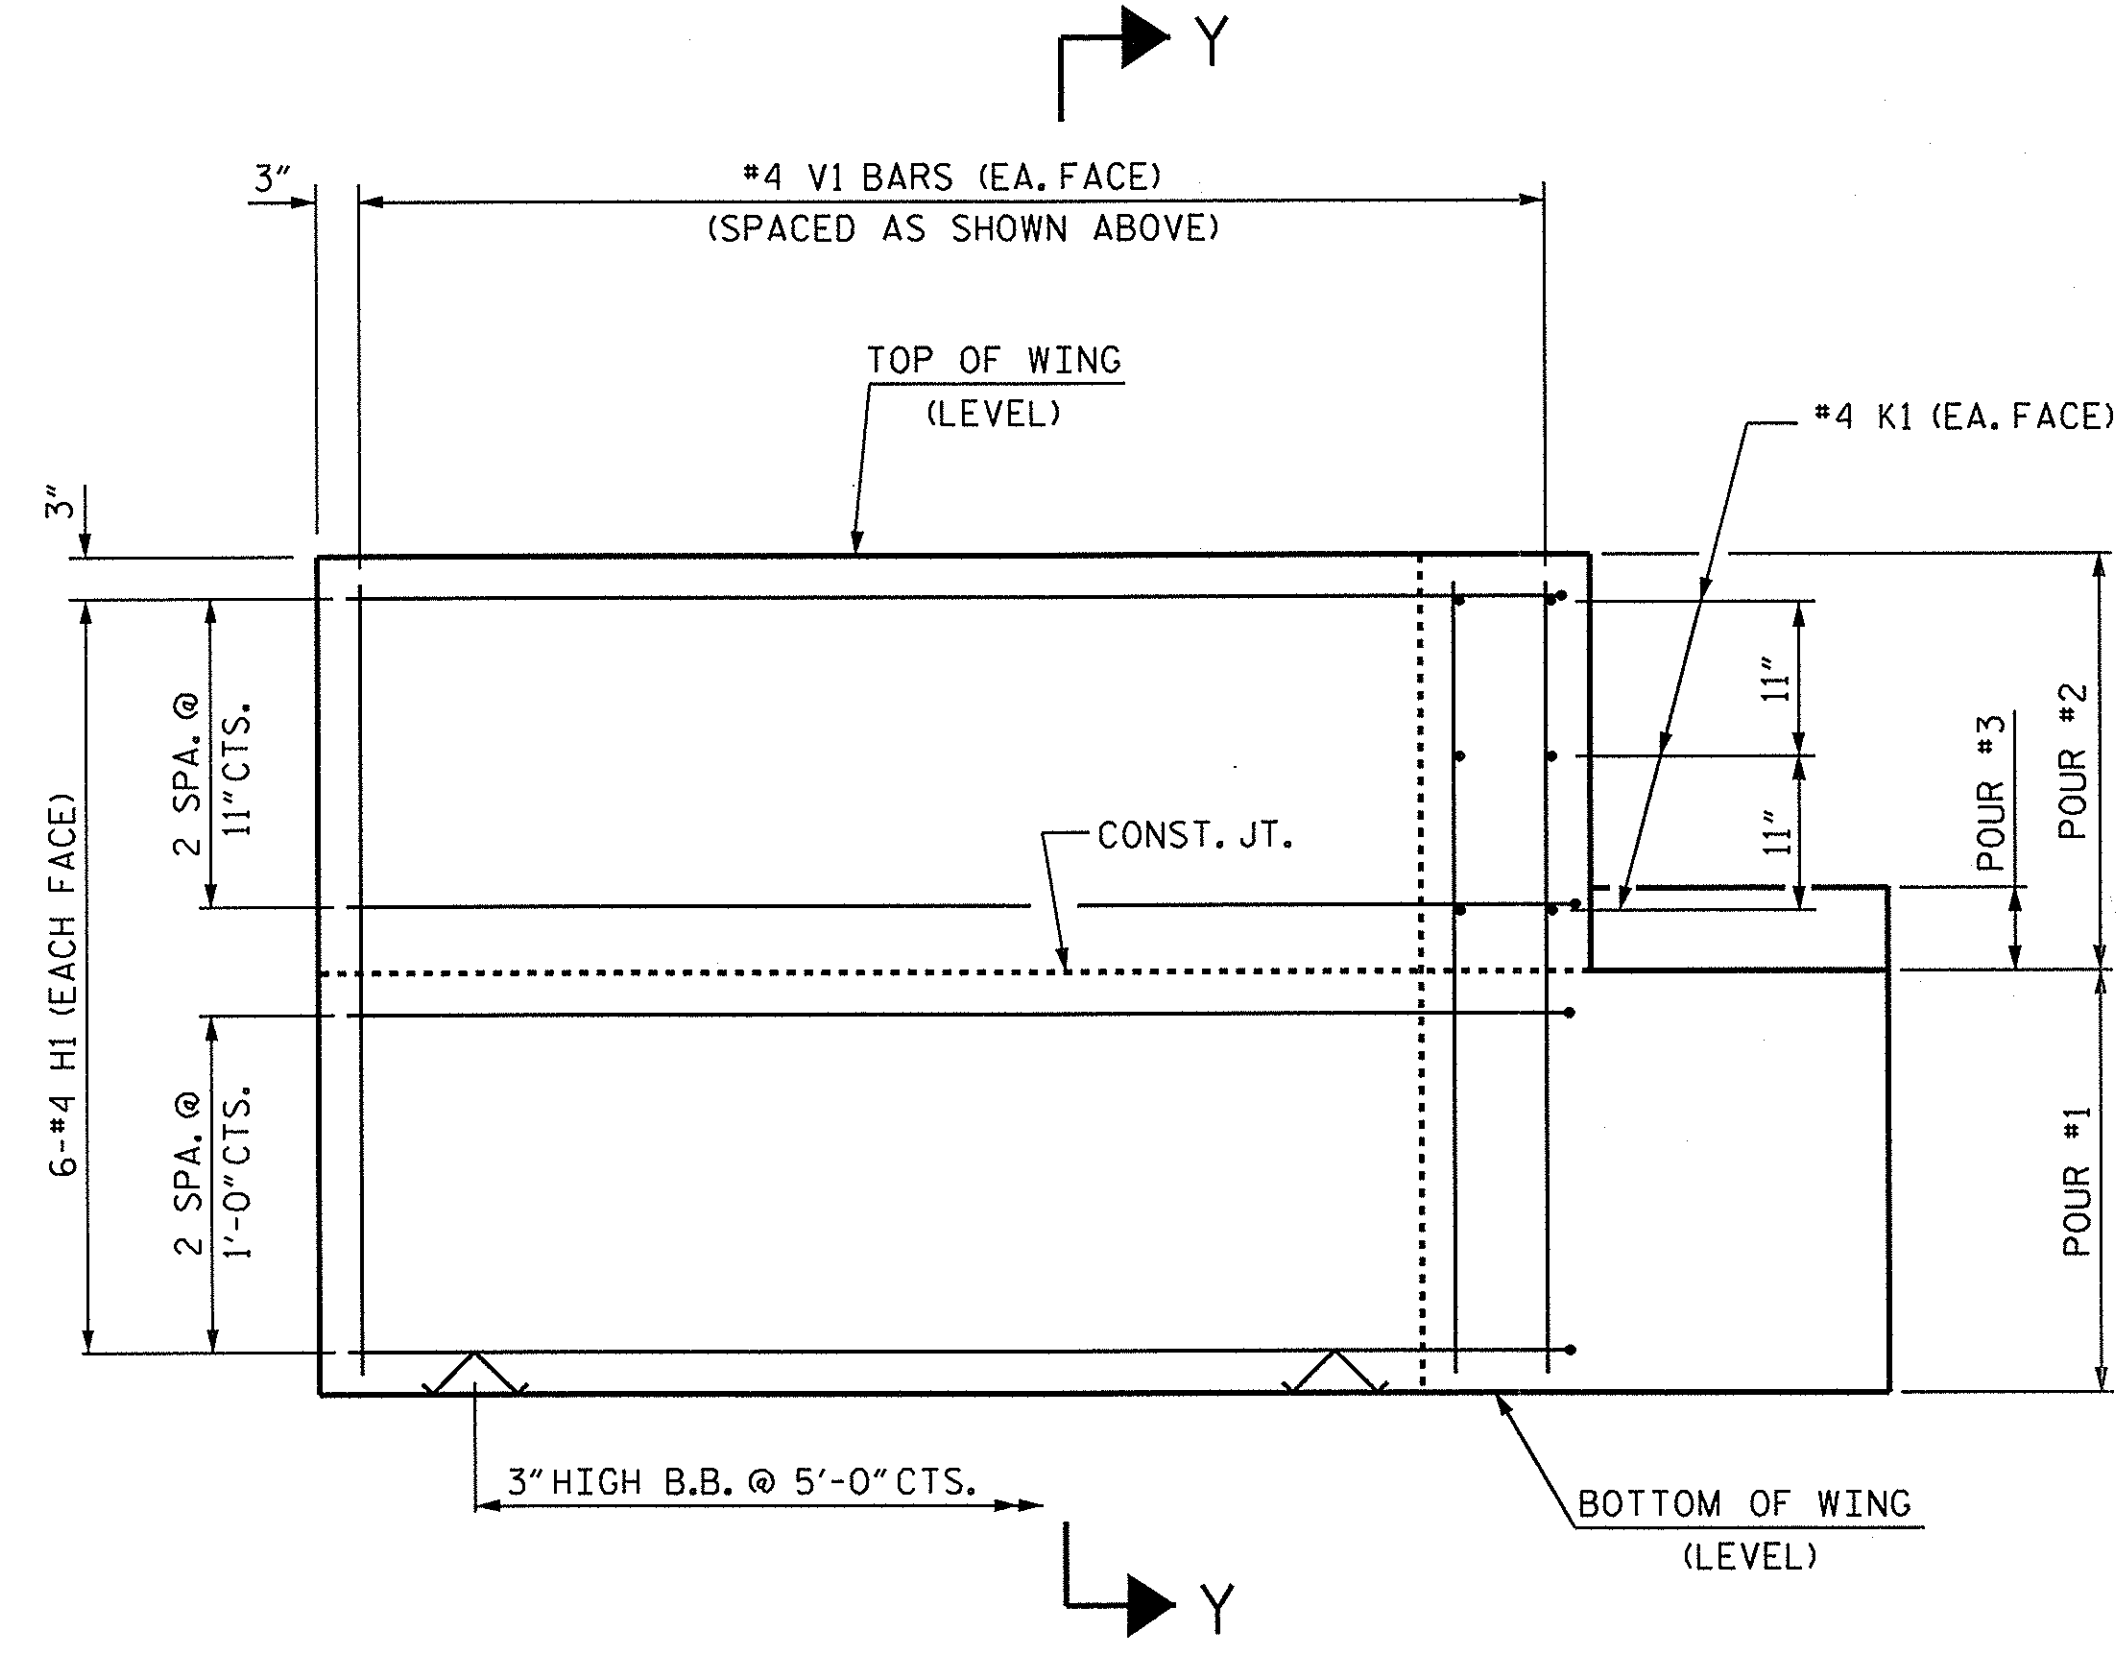


ELEVATION OF WING (W2)

WING DETAILS

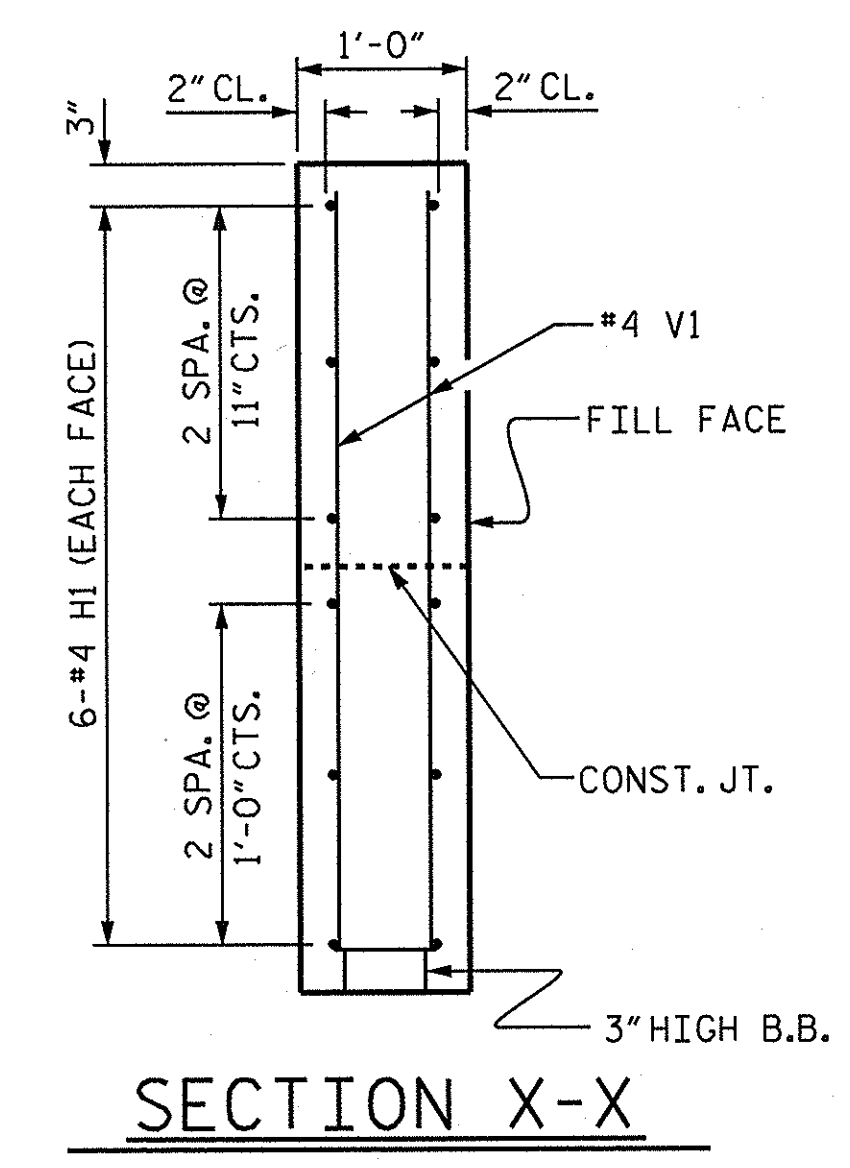

SECTION X-X

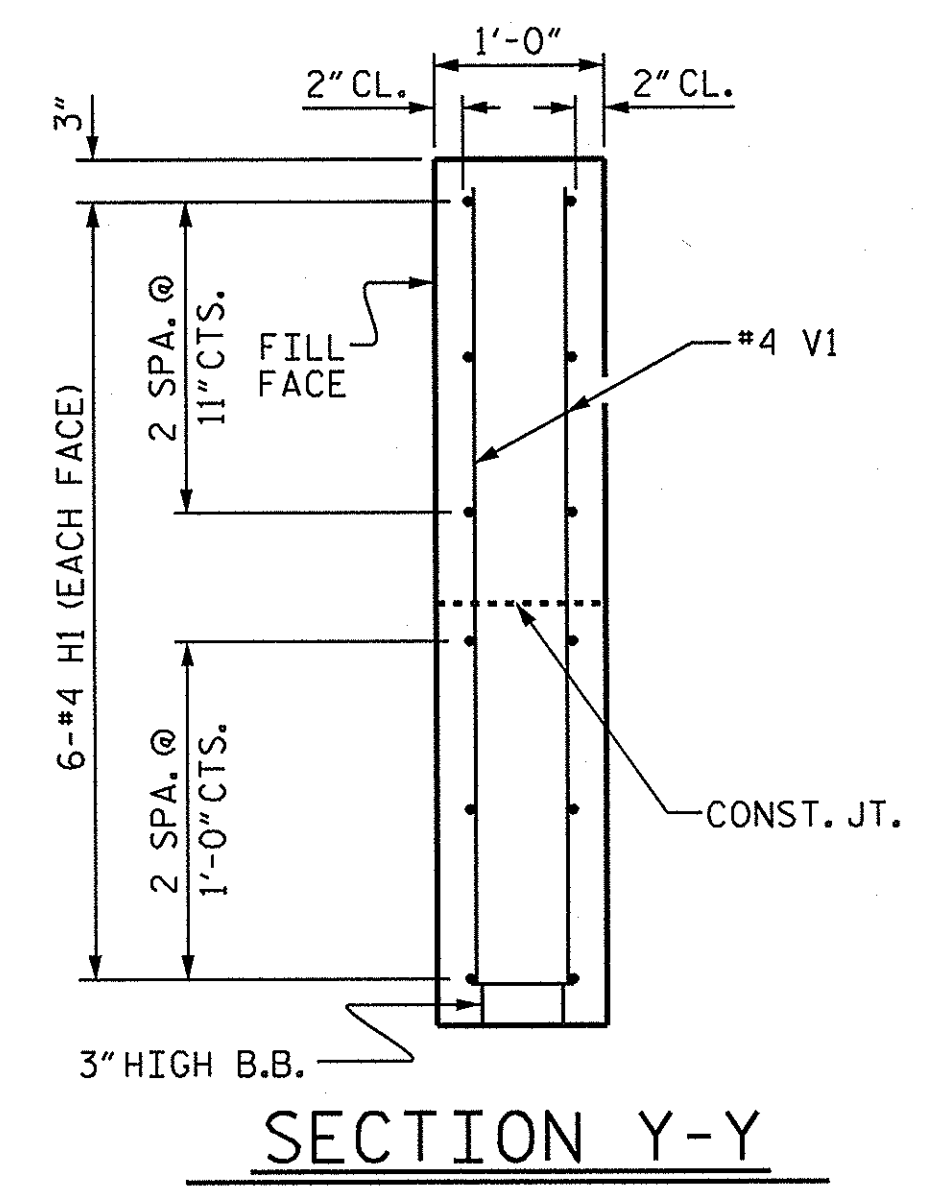


SECTION Y-Y

PROJECT NO. 17BP.2.R.51  
 GREENE COUNTY  
 STATION: 14+81.00 -L-


SHEET 3 OF 4

|  |     |       |     |     |           |
|--|-----|-------|-----|-----|-----------|
| STATE OF NORTH CAROLINA<br>DEPARTMENT OF TRANSPORTATION<br>RALEIGH |     |       |     |     |           |
| SUBSTRUCTURE<br>END BENT<br>WING DETAILS                           |     |       |     |     |           |
| REVISIONS  |     |       |     |     |           |
| NO.  | BY: | DATE: | NO. | BY: | DATE:     |
| 1  |     |       | 3   |     |           |
| 2  |     |       | 4   |     |           |
| TOTAL SHEETS   |     |       |     |     | SHEET NO. |
| 17   |     |       |     |     | S-12      |

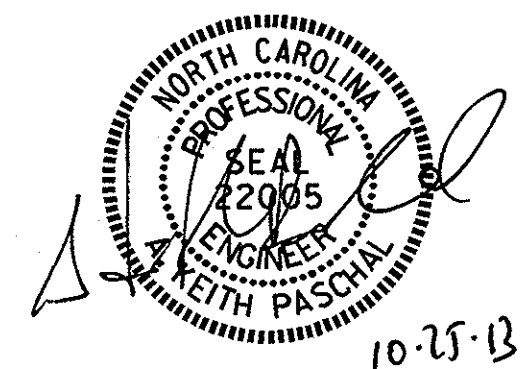

ASSEMBLED BY: A. H. SHIVELY DATE: 6/24/13  
 CHECKED BY: M. L. RORIE DATE: 8/9/13  
 DRAWN BY: DGE 02/10  
 CHECKED BY: MKT 02/10

25-OCT-2013 07:38  
 S:\DPO\Keith\17BP.2.R.51\Final Plans\17BP.2.R.51.EB...dgn  
 kpaschal

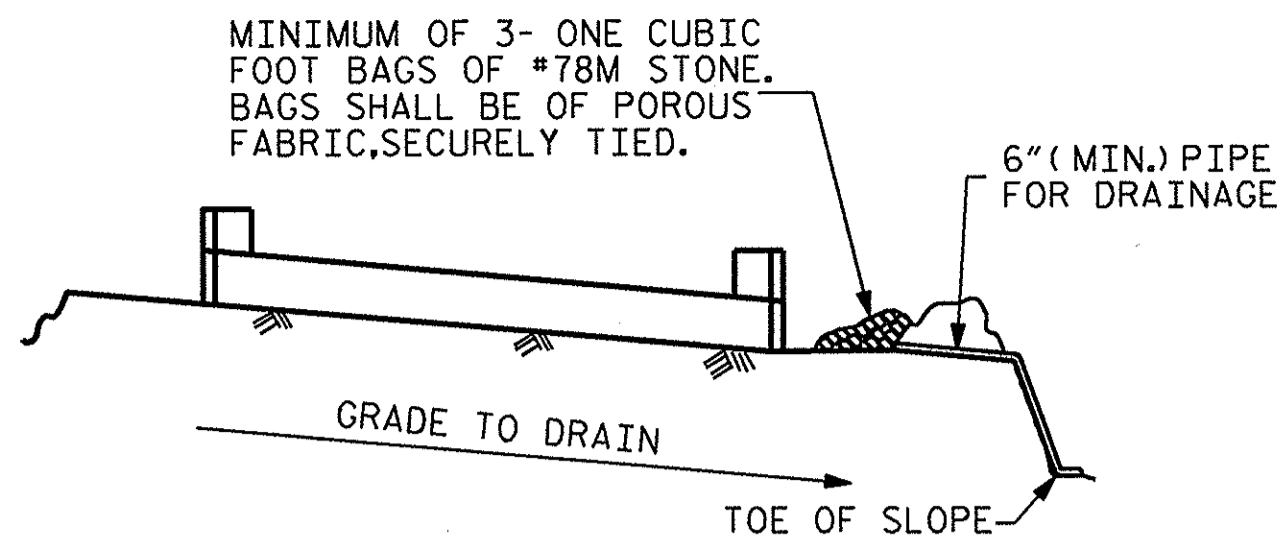


BAGGED STONE AND PIPE SHALL BE PLACED IMMEDIATELY AFTER COMPLETION OF END BENT EXCAVATION. PIPE MAY BE EITHER CONCRETE, CORRUGATED STEEL, CORRUGATED ALUMINUM ALLOY, OR CORRUGATED PLASTIC. PERFORATED PIPE WILL NOT BE ALLOWED.


BAGGED STONE SHALL REMAIN IN PLACE UNTIL THE ENGINEER DIRECTS THAT IT BE REMOVED. THE CONTRACTOR SHALL REMOVE AND DISPOSE OF SILT ACCUMULATIONS AT BAGGED STONE WHEN SO DIRECTED BY THE ENGINEER. BAGS SHALL BE REMOVED AND REPLACED WHENEVER THE ENGINEER DETERMINES THAT THEY HAVE DETERIORATED AND LOST THEIR EFFECTIVENESS.

NO SEPARATE PAYMENT WILL BE MADE FOR THIS WORK AND THE ENTIRE COST OF THIS WORK SHALL BE INCLUDED IN THE UNIT CONTRACT PRICE BID FOR THE SEVERAL PAY ITEMS.


### TEMPORARY DRAINAGE AT END BENT

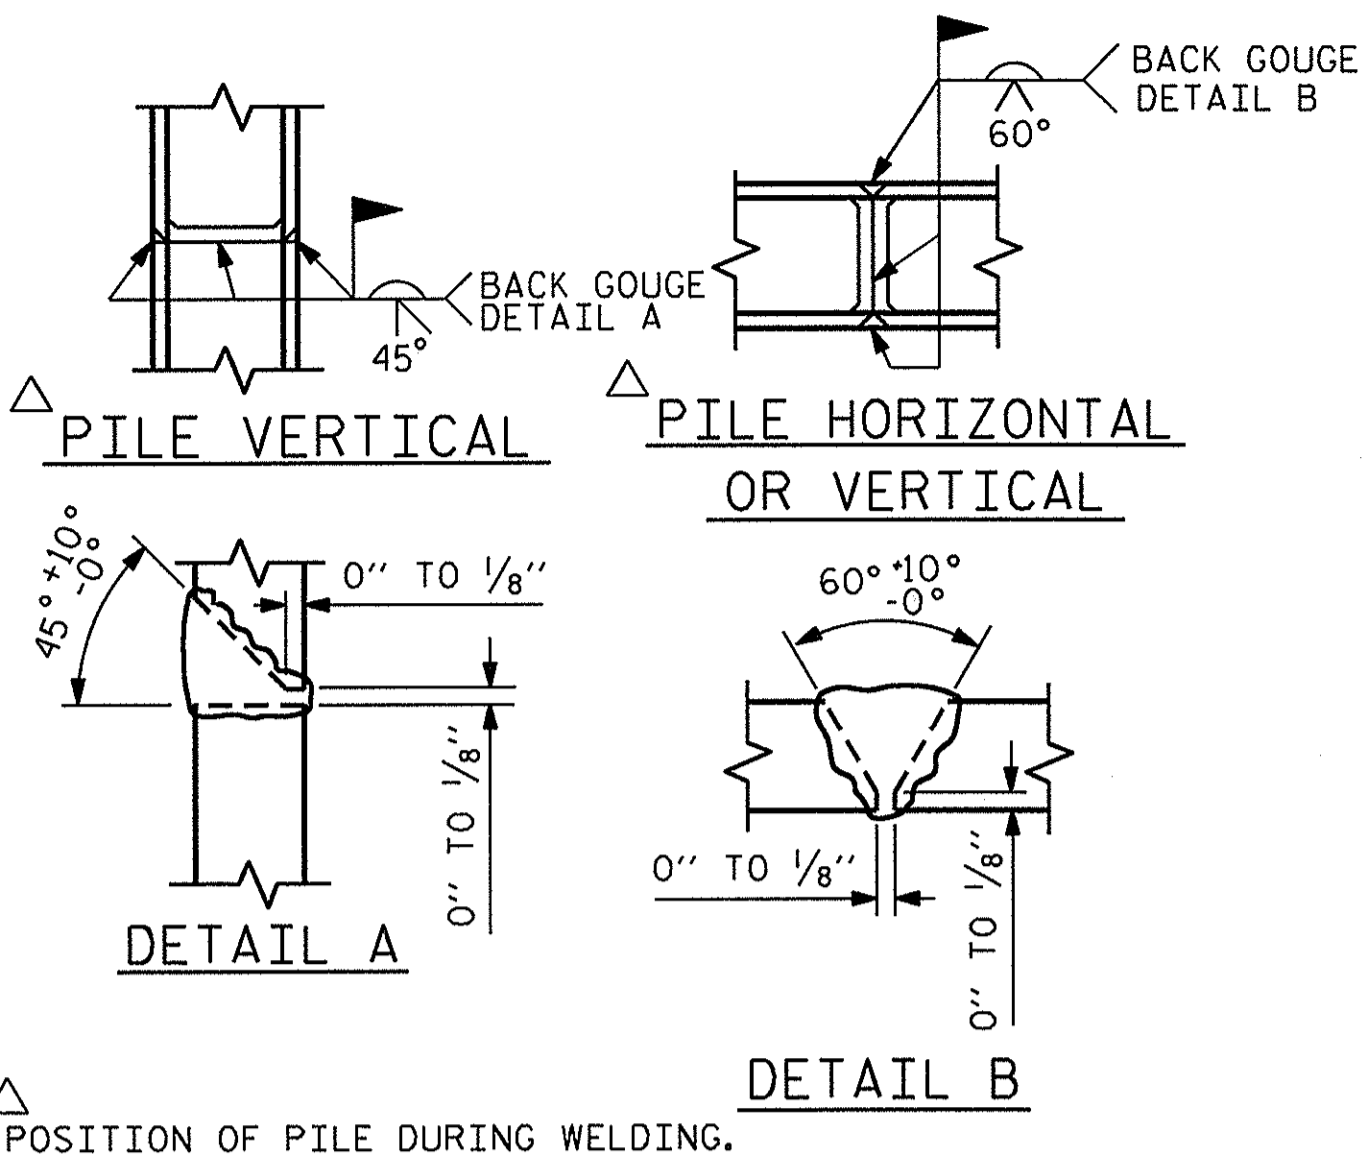





### PILE SPLICE DETAILS

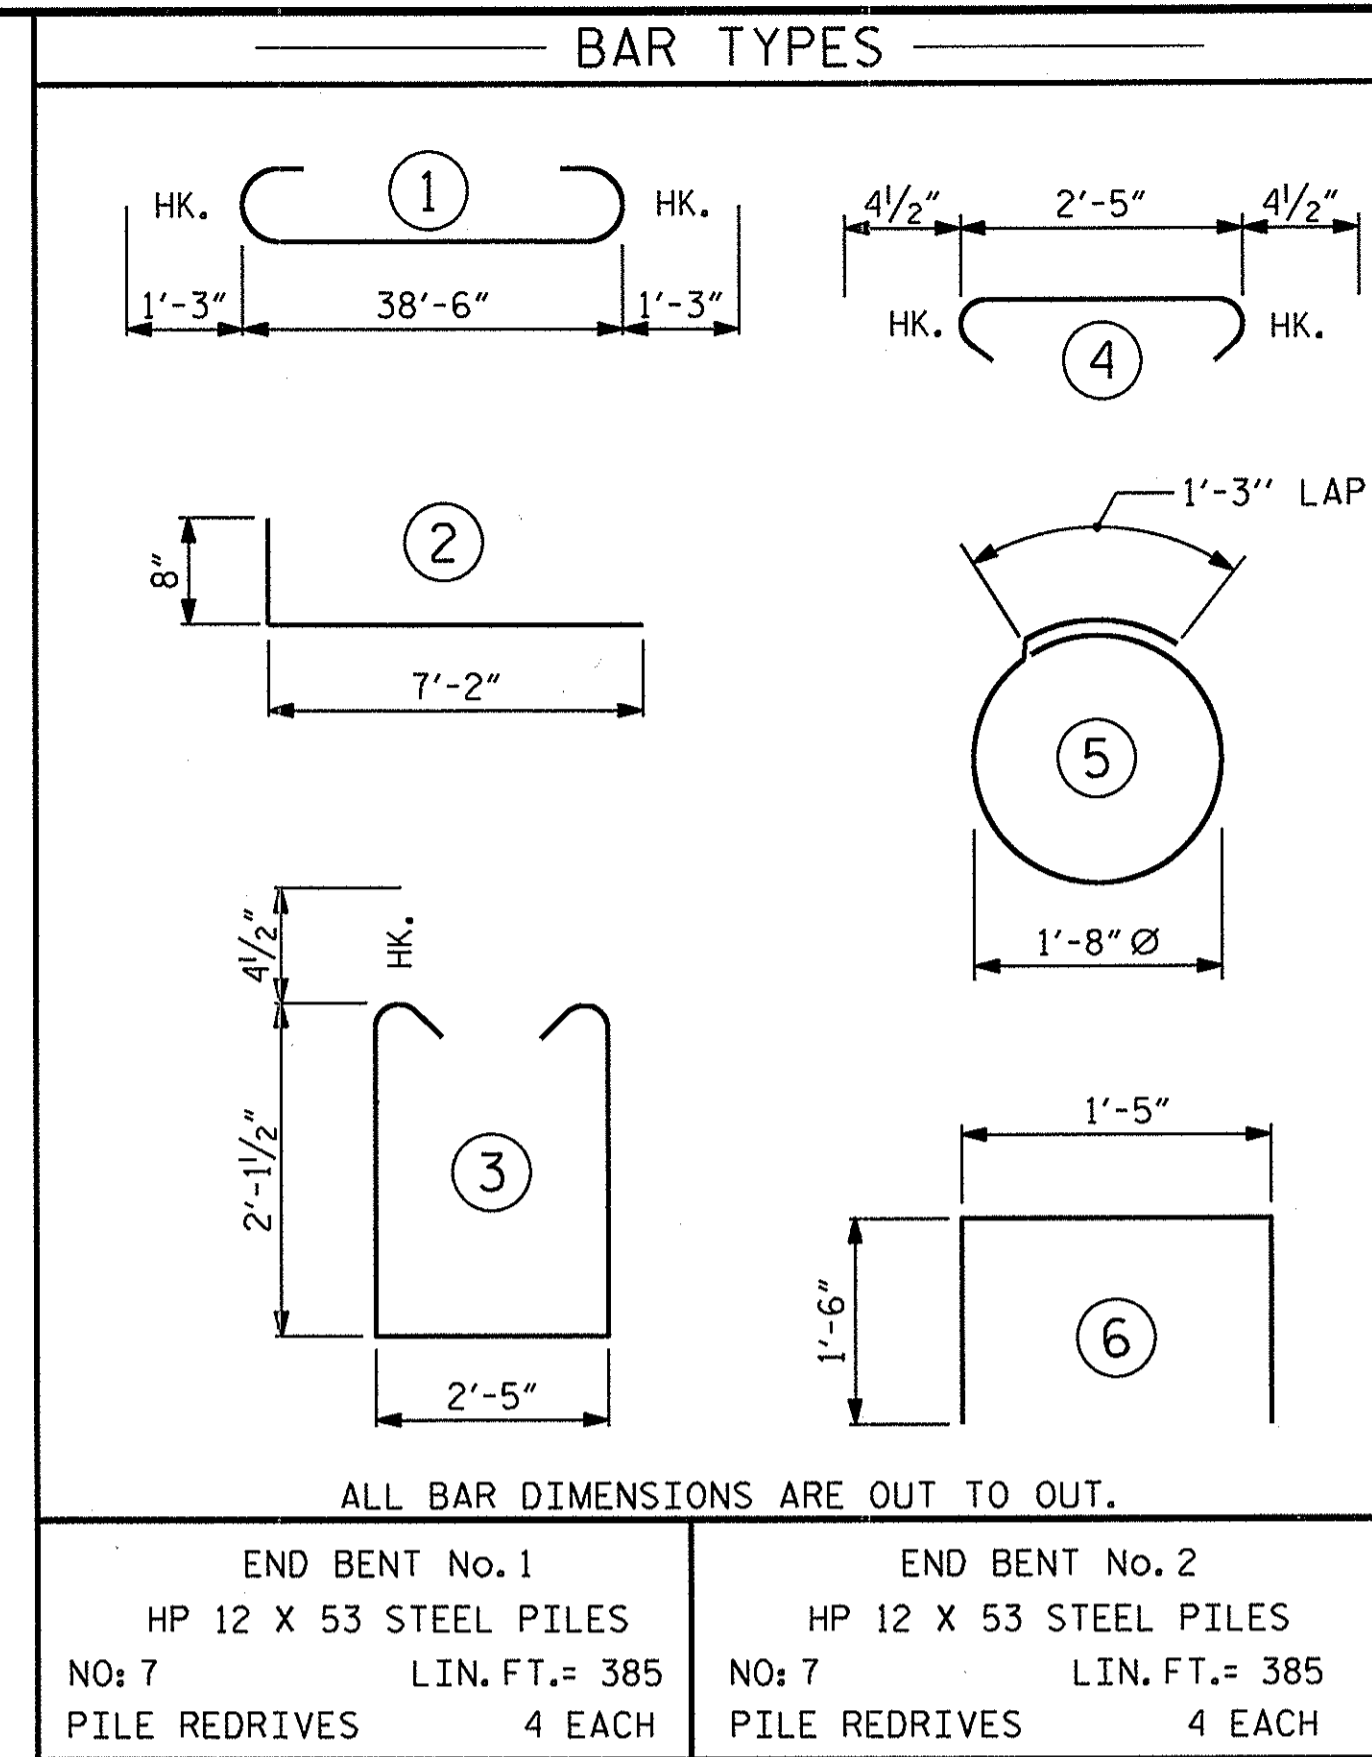

| BILL OF MATERIAL FOR ONE END BENT             |                                    |      |      |           |           |
|---|------------------------------------|------|------|-----------|-----------|
| BAR   | NO.                                | SIZE | TYPE | LENGTH    | WEIGHT    |
| B1  | 8                                  | #9   | 1    | 41'-0"    | 1115      |
| B2  | 16                                 | #4   | STR  | 20'-7"    | 220       |
| B3  | 10                                 | #4   | STR  | 2'-5"     | 16        |
| D1  | 22                                 | #6   | STR  | 1'-6"     | 50        |
| H1  | 24                                 | #4   | 2    | 7'-10"    | 126       |
| K1  | 12                                 | #4   | STR  | 2'-11"    | 23        |
| S1  | 50                                 | #4   | 3    | 7'-5"     | 248       |
| S2  | 50                                 | #4   | 4    | 3'-2"     | 106       |
| S3  | 14                                 | #4   | 5    | 6'-6"     | 61        |
| S4  | 4                                  | #4   | 6    | 4'-5"     | 12        |
| V1  | 48                                 | #4   | STR  | 4'-8"     | 150       |
| REINFORCING STEEL (FOR ONE END BENT)          |                                    |      |      |           | 2127 LBS. |
| CLASS A CONCRETE BREAKDOWN (FOR ONE END BENT) |                                    |      |      |           |           |
| POUR #1                                       | CAP, LOWER PART OF WINGS & COLLARS |      |      | 12.4 C.Y. |           |
| POUR #2                                       | UPPER PART OF WINGS                |      |      | 1.8 C.Y.  |           |
| POUR #3                                       | LATERAL GUIDES                     |      |      | 0.1 C.Y.  |           |
| TOTAL CLASS A CONCRETE                        |                                    |      |      | 14.3 C.Y. |           |

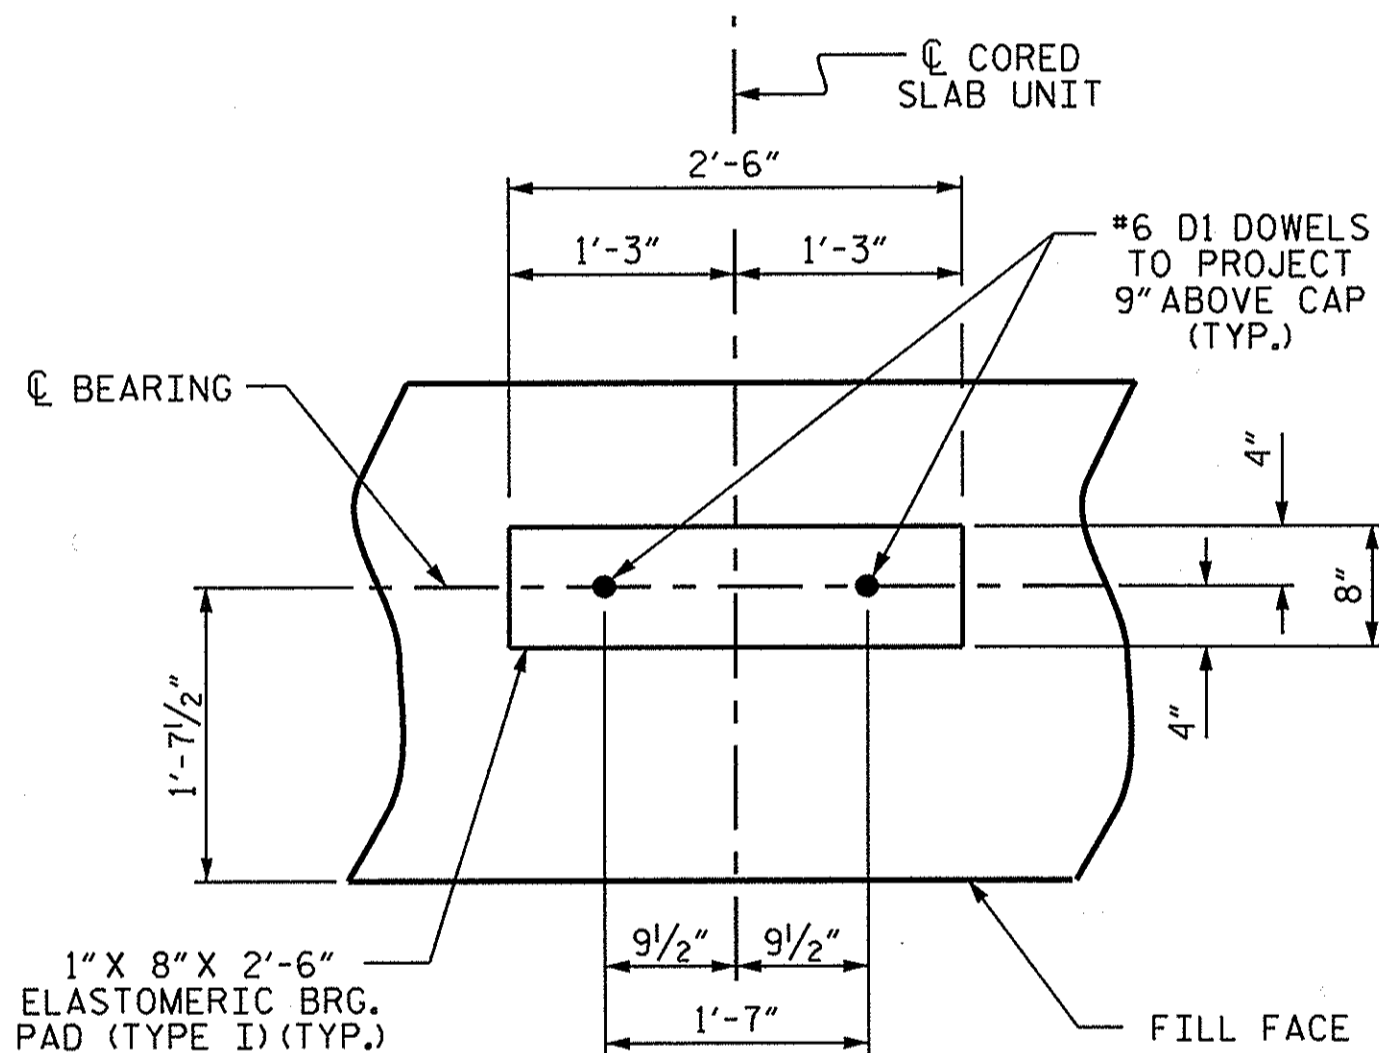

(END BENT No. 1 SHOWN, END BENT No. 2 SIMILAR BY ROTATION)

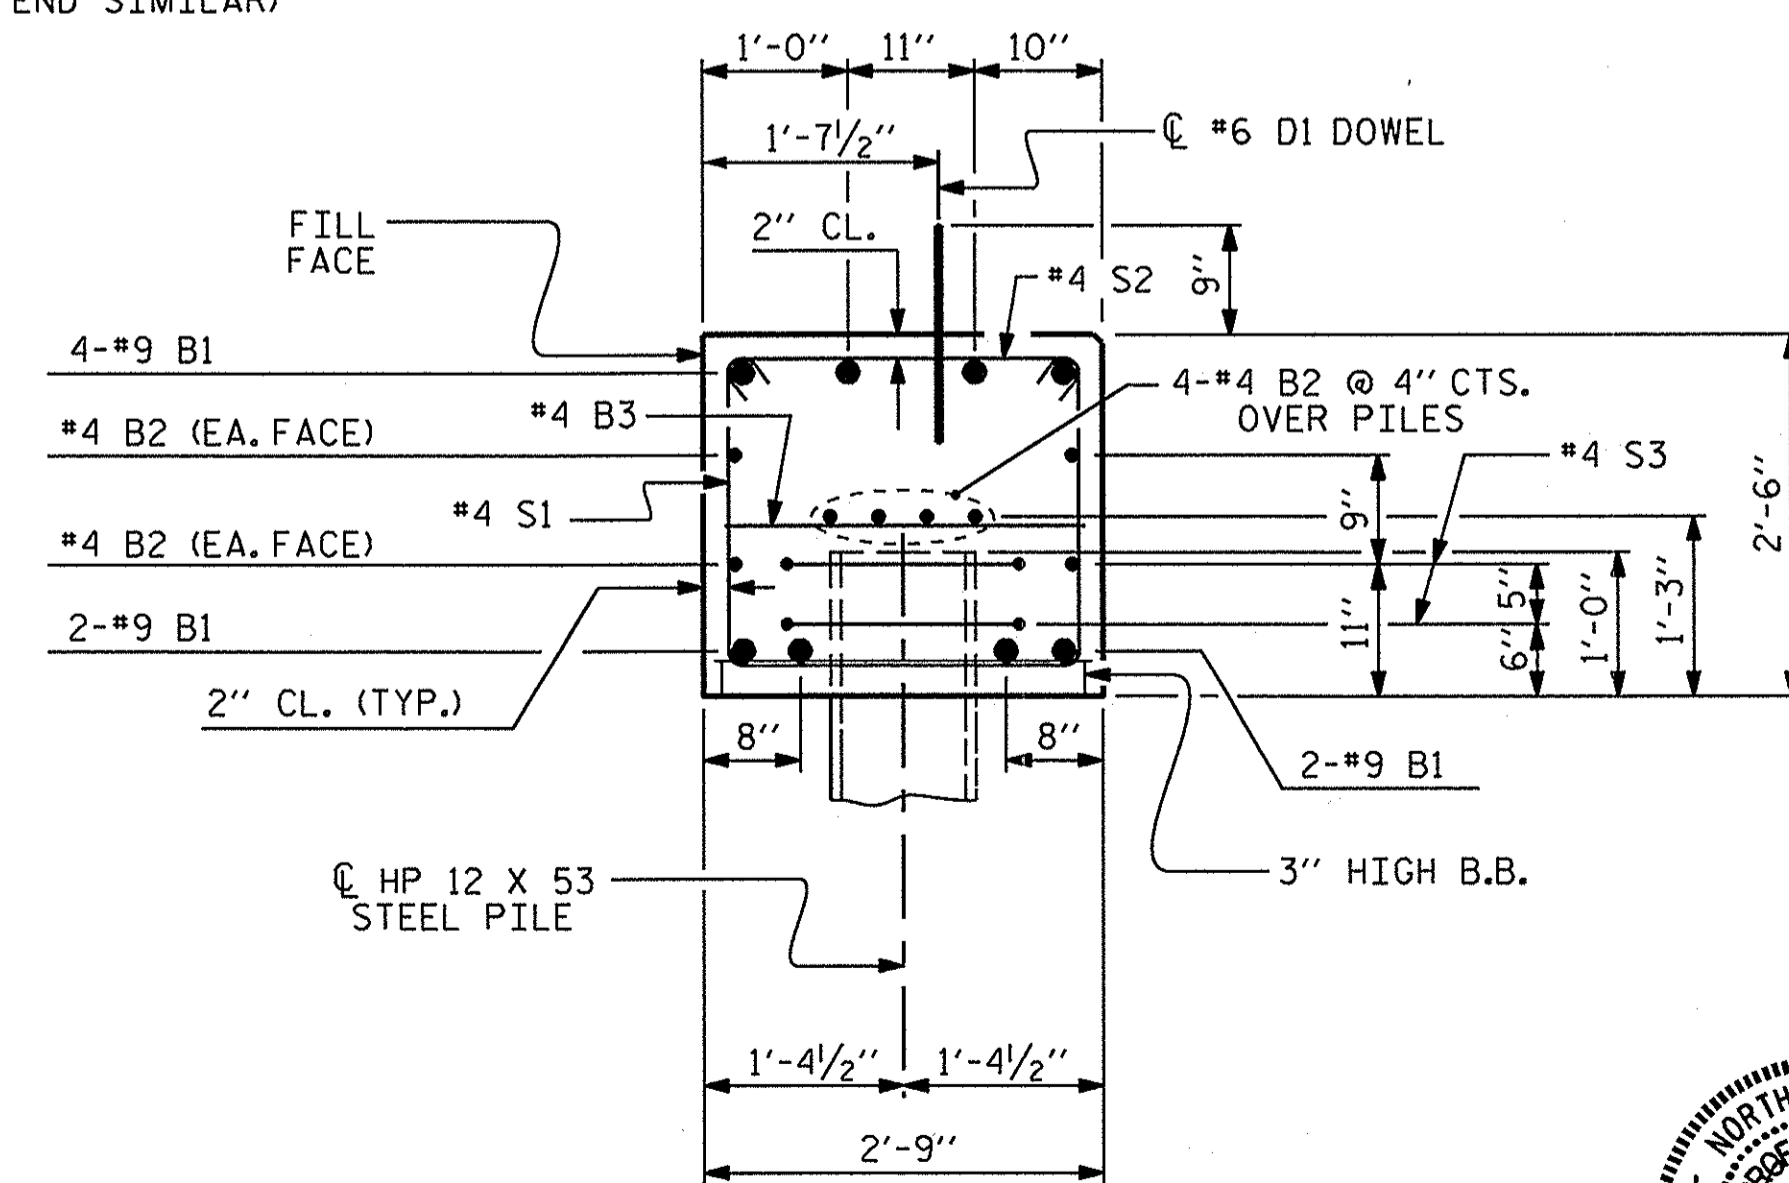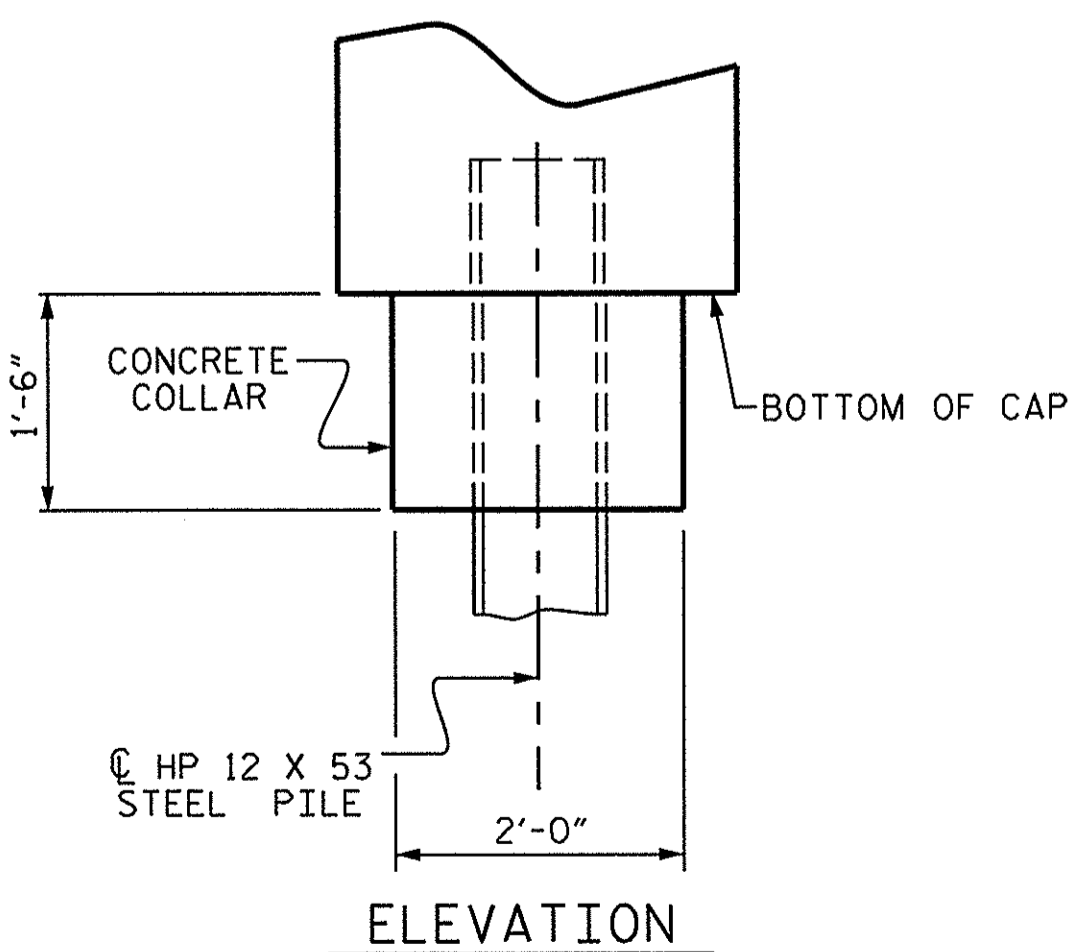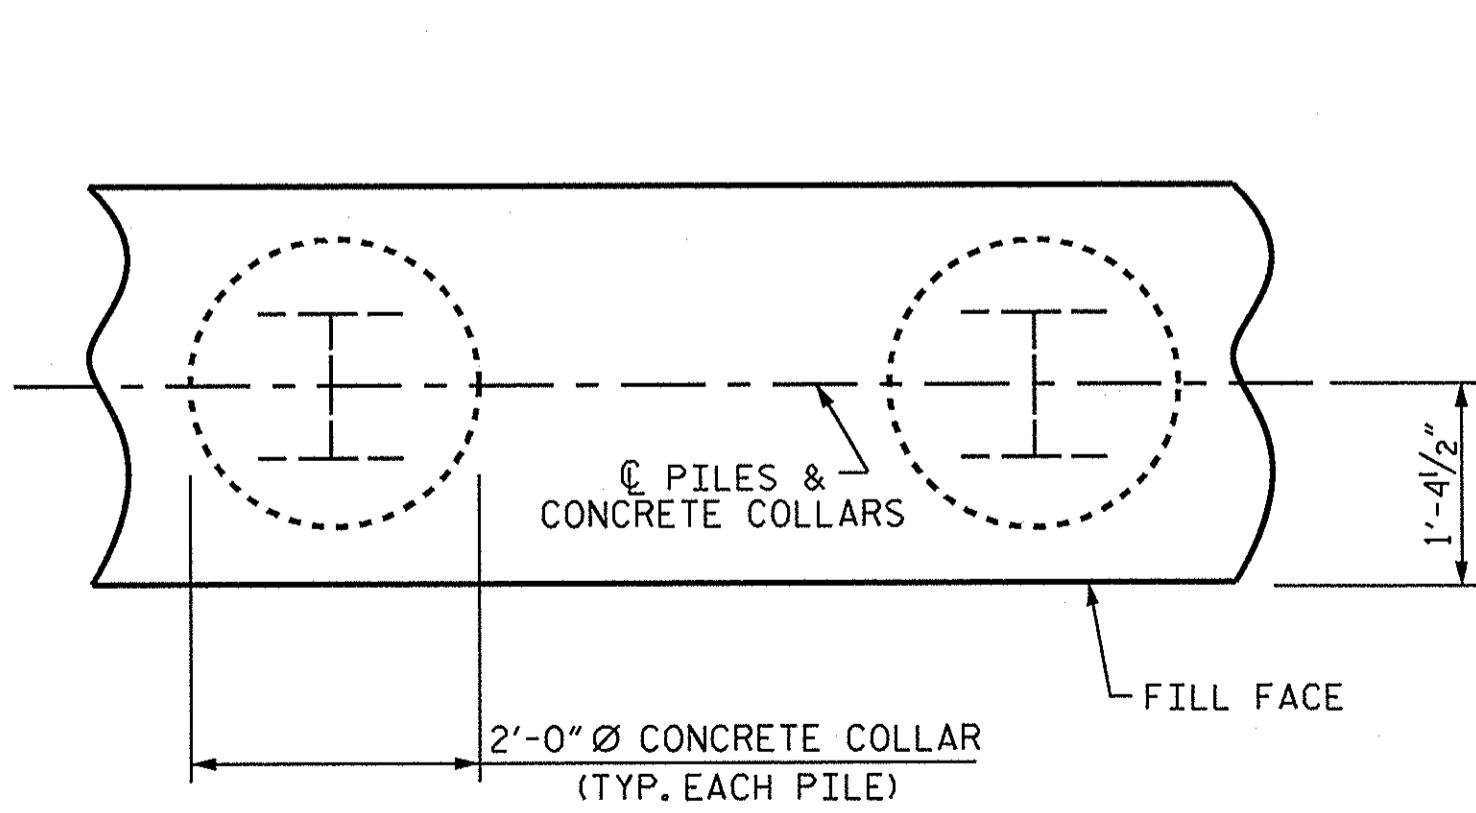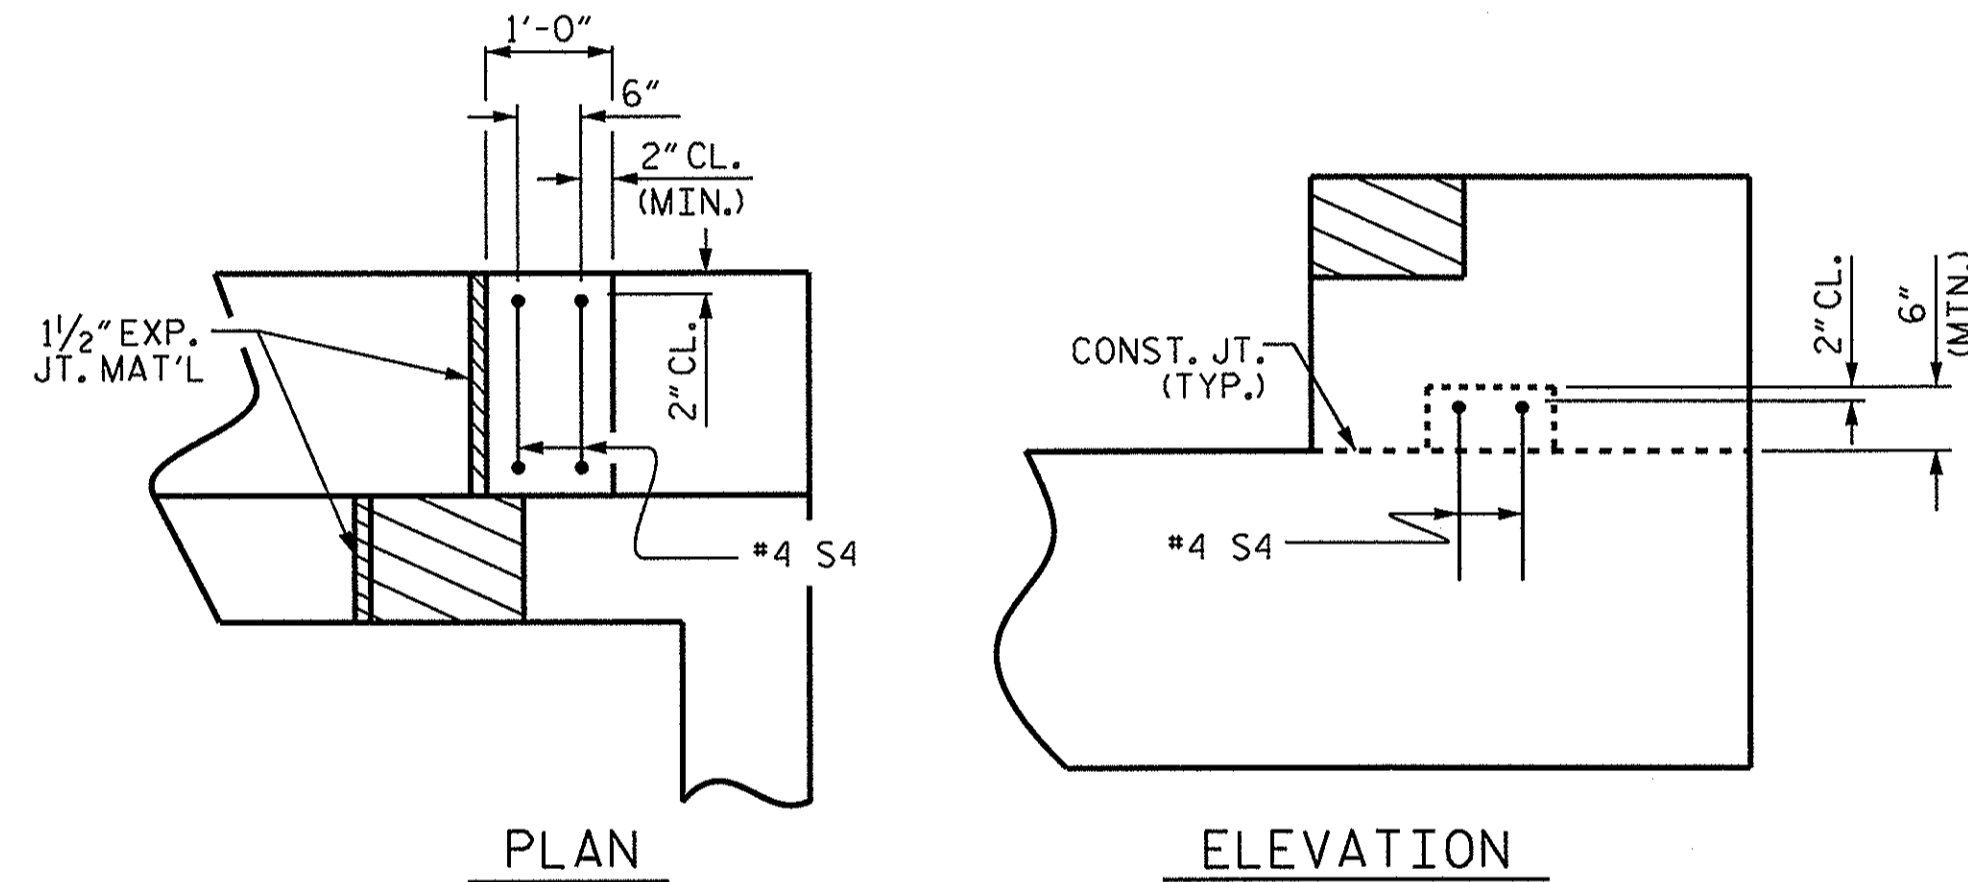


PROJECT NO. 17BP.2.R.51  
GREENE COUNTY  
STATION: 14+81.00 -L-

SHEET 4 OF 4

STATE OF NORTH CAROLINA  
DEPARTMENT OF TRANSPORTATION  
RALEIGH

SUBSTRUCTURE  
END BENT No. 1 & 2  
DETAILS



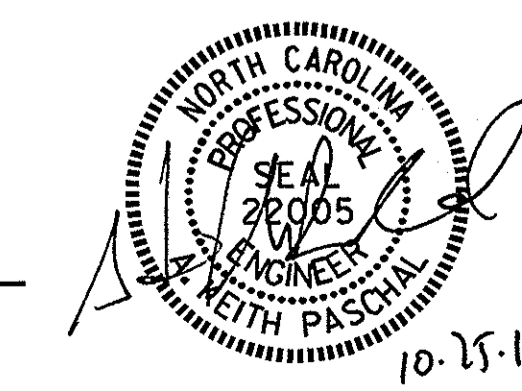


ASSEMBLED BY: A. H. SHIVELY DATE: 6/24/13  
CHECKED BY: M. L. RORIE DATE: 8/9/13  
DRAWN BY: DGE 02/10  
CHECKED BY: MKT 02/10

| REVISIONS |     |       |     |     |       | SHEET NO.    |
|-----------|-----|-------|-----|-----|-------|--------------|
| NO.       | BY: | DATE: | NO. | BY: | DATE: | S-13         |
| 1         |     |       | 3   |     |       | TOTAL SHEETS |
| 2         |     |       | 4   |     |       | 17           |

**NOTES**

- STIRRUPS IN CAP MAY BE SHIFTED AS NECESSARY TO CLEAR DOWELS.
- THE LATERAL GUIDES ARE NOT TO BE POURED UNTIL AFTER THE CORED SLAB UNITS ARE IN PLACE.
- ★ INVERT ALTERNATE STIRRUPS.
- GALVANIZE THE TOP OF EACH INTERIOR BENT PILE A MINIMUM OF 28 FEET. GALVANIZE IN ACCORDANCE WITH SECTION 1076 OF THE STANDARD SPECIFICATIONS.
- THE CONTRACTOR HAS THE OPTION TO OMIT THE LATERAL GUIDE IF APPROVED BY THE ENGINEER.

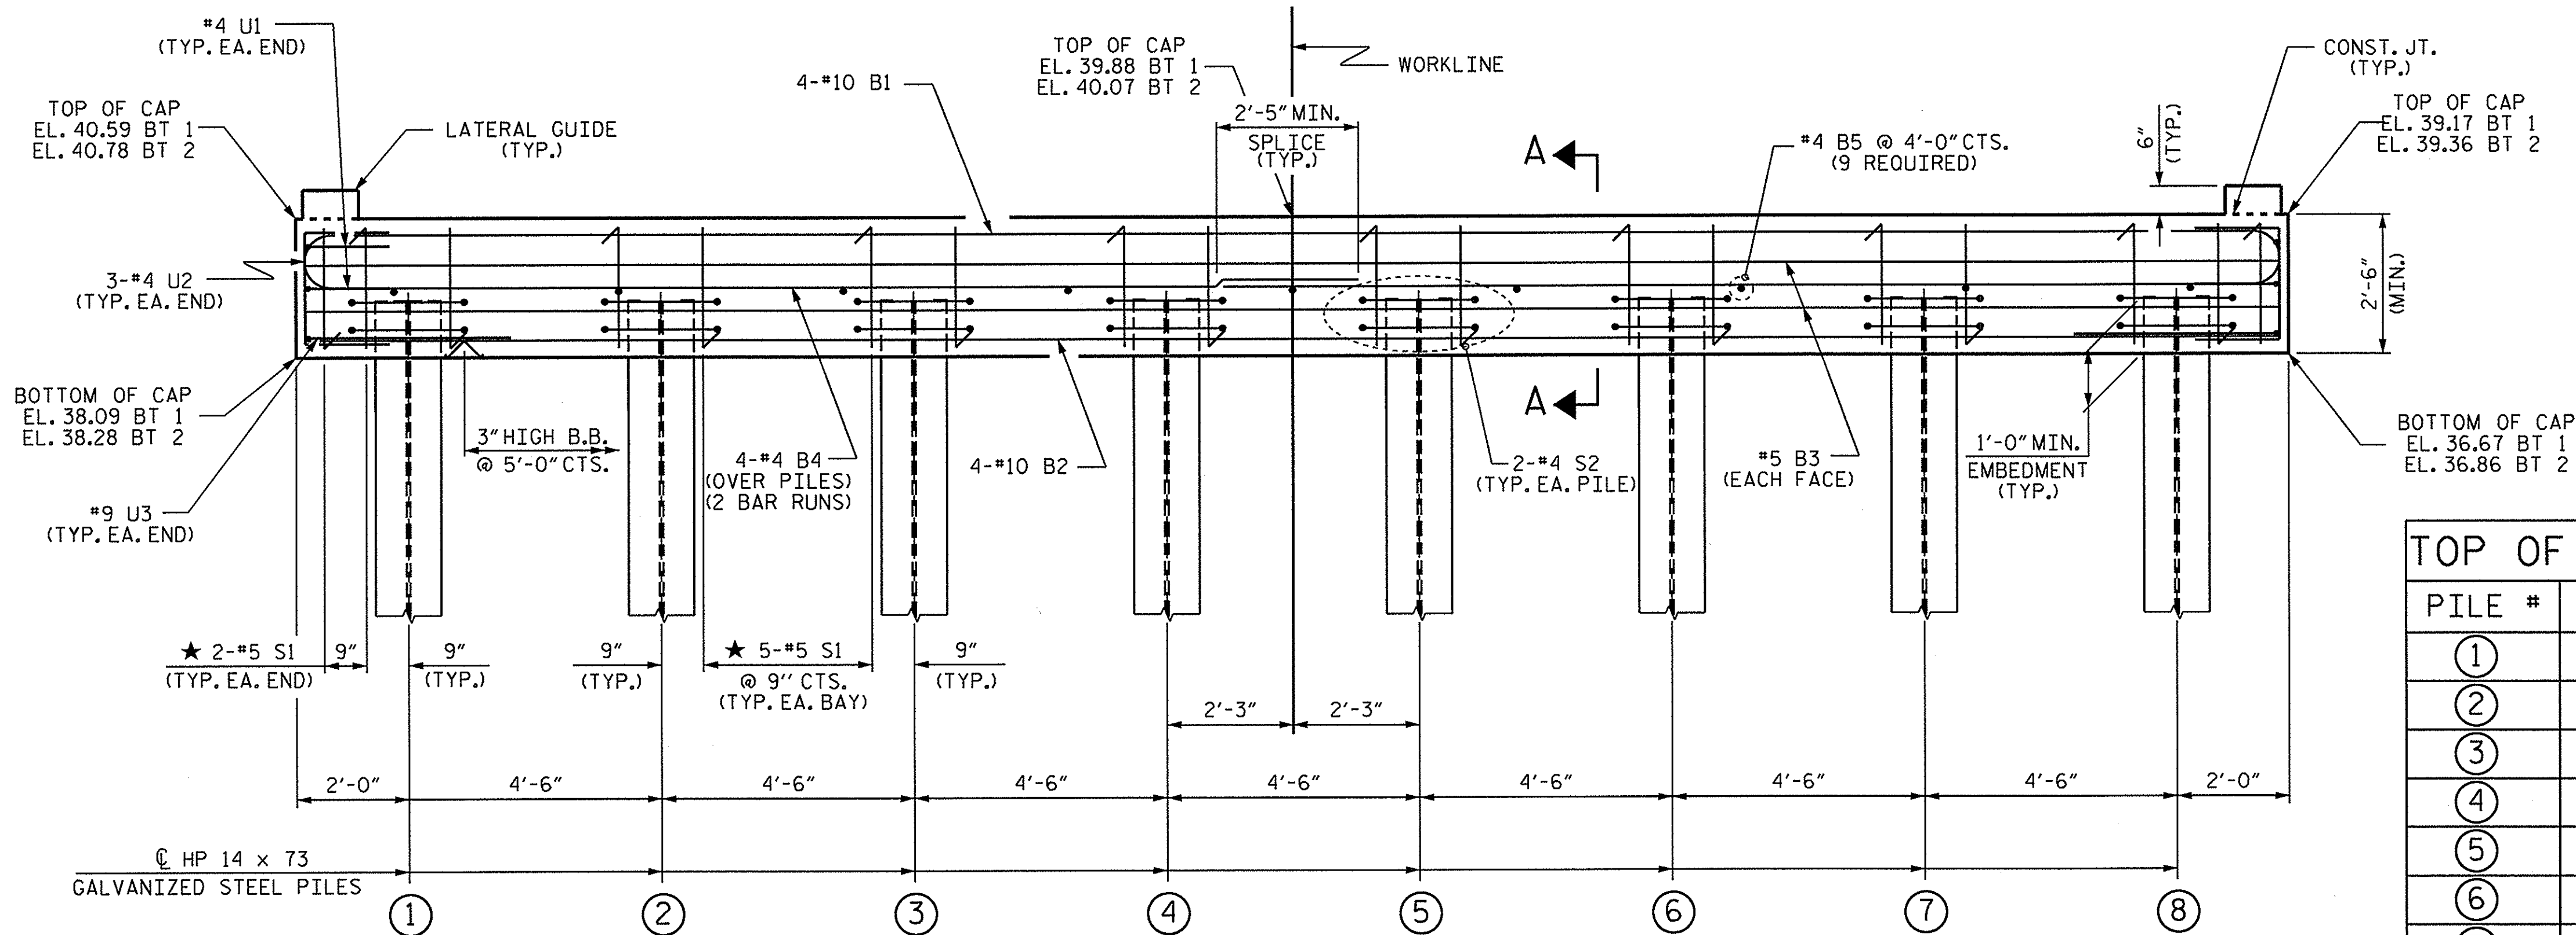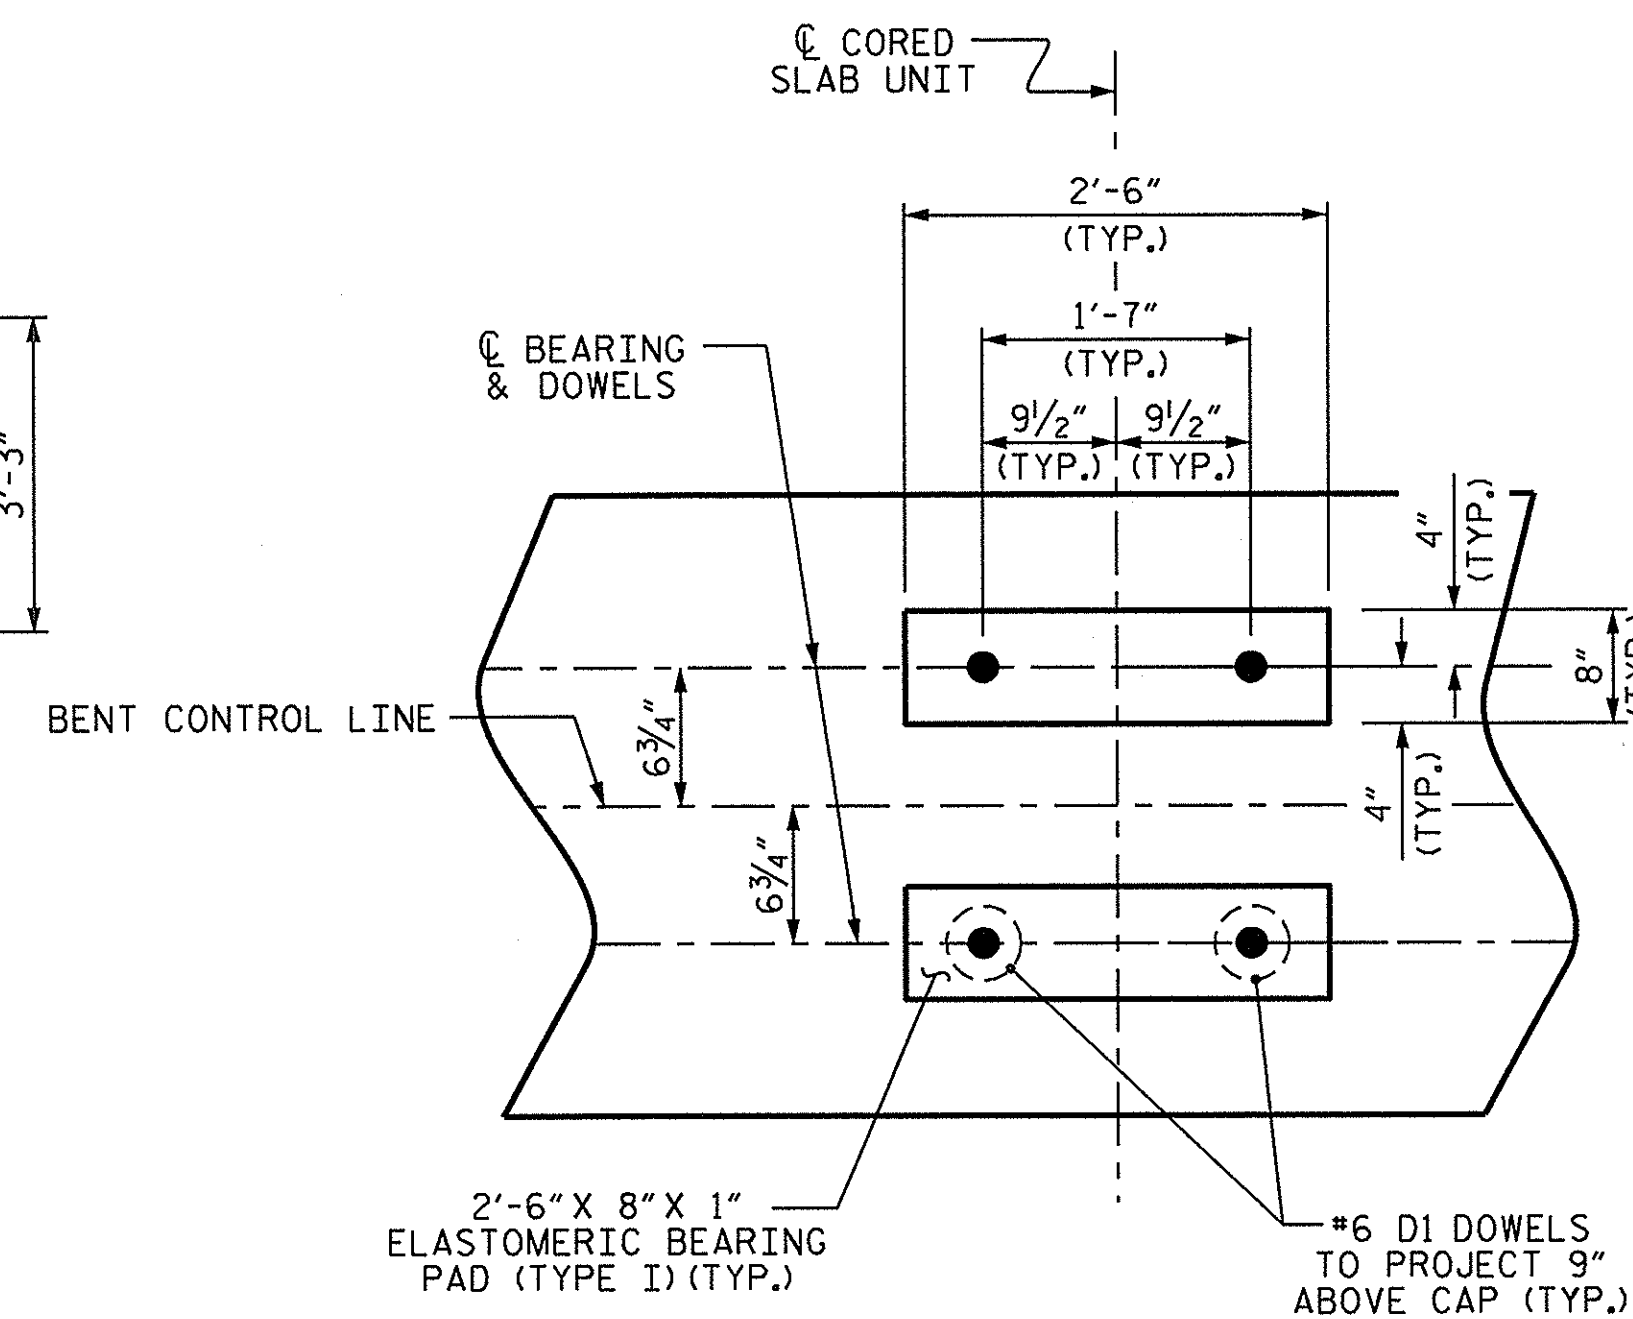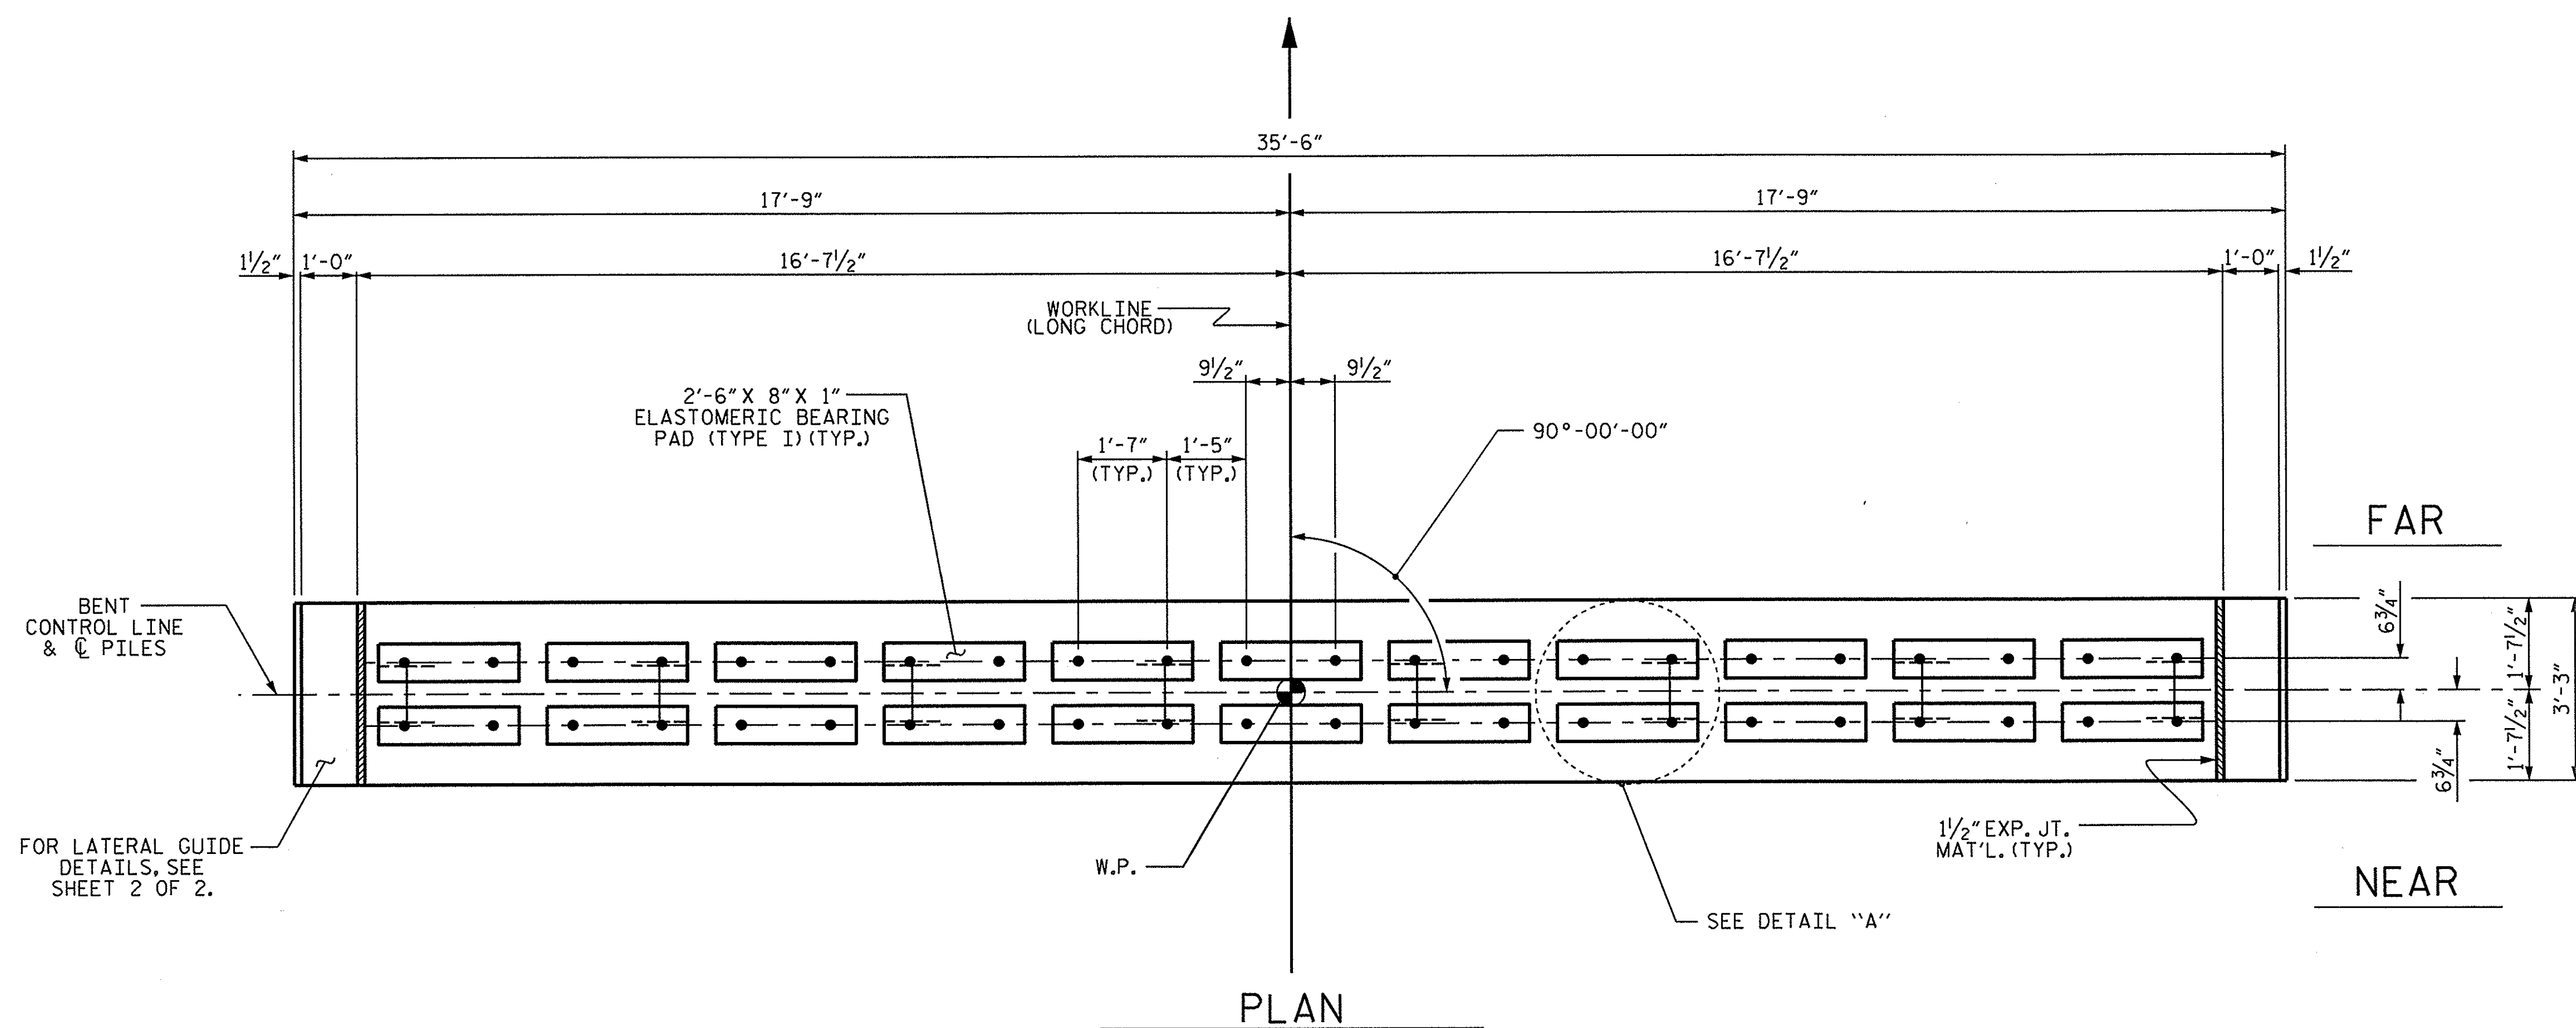

| TOP OF PILE ELEVS. |        |        |
|--------------------|--------|--------|
| PILE #             | BENT 1 | BENT 2 |
| ①                  | 39.03  | 39.22  |
| ②                  | 38.85  | 39.04  |
| ③                  | 38.67  | 38.86  |
| ④                  | 38.49  | 38.68  |
| ⑤                  | 38.31  | 38.50  |
| ⑥                  | 38.13  | 38.32  |
| ⑦                  | 37.95  | 38.14  |
| ⑧                  | 37.77  | 37.96  |

PROJECT NO. 17BP.2.R.51  
 GREENE COUNTY  
 STATION: 14+81.00 -L-

SHEET 1 OF 2


STATE OF NORTH CAROLINA  
 DEPARTMENT OF TRANSPORTATION  
 RALEIGH

SUBSTRUCTURE  
 BENT Nos. 1 & 2

| REVISIONS |     |       |     |     |       | SHEET NO.<br>S-14  |
|-----------|-----|-------|-----|-----|-------|--------------------|
| NO.       | BY: | DATE: | NO. | BY: | DATE: |                    |
| 1         |     |       | 3   |     |       | TOTAL SHEETS<br>17 |
| 2         |     |       | 4   |     |       |                    |


ASSEMBLED BY: A. K. PASCHAL DATE: 9/27/13  
 CHECKED BY: J. LAZAROVICH DATE: 10/14/13  
 DRAWN BY: DGE 05/10  
 CHECKED BY: MKT 05/10

25-OCT-2013 07:38  
 S:\DPG\k\17BP.2.R.51\FinalPlans\17BP.2.R.51.LT.dgn  
 kpaschal

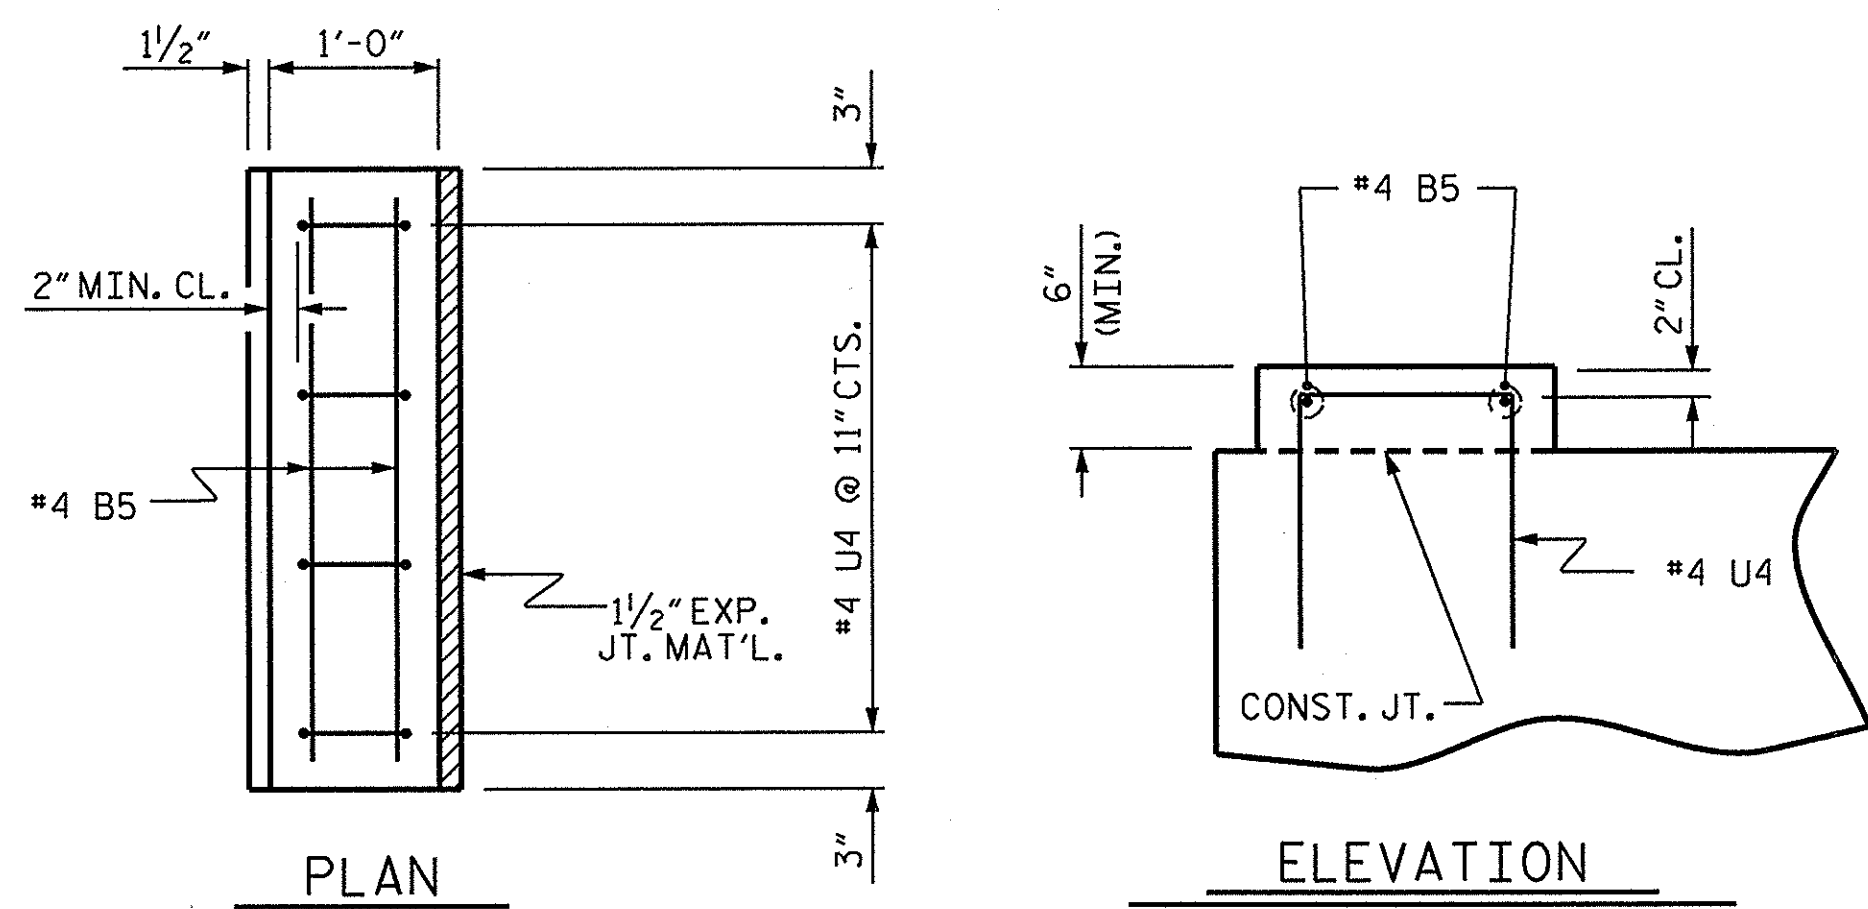


**LATERAL GUIDE DETAILS**

(LEFT LATERAL GUIDE SHOWN, RIGHT SIDE SIMILAR)

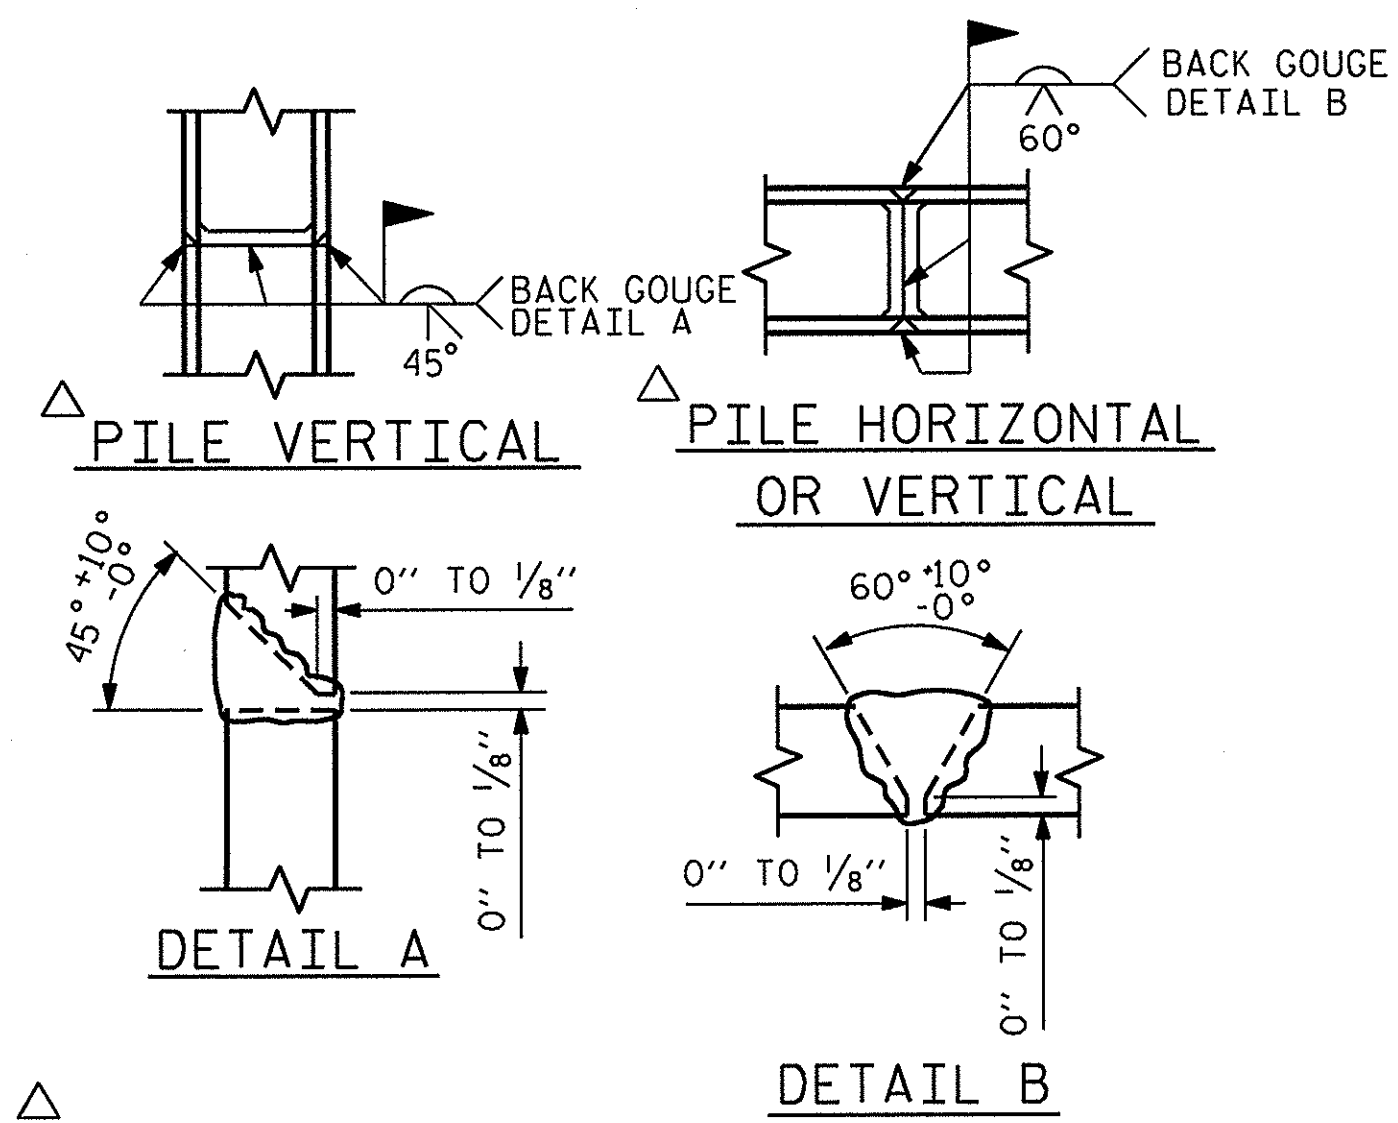


**PILE SPLICE DETAILS**

△ POSITION OF PILE DURING WELDING.

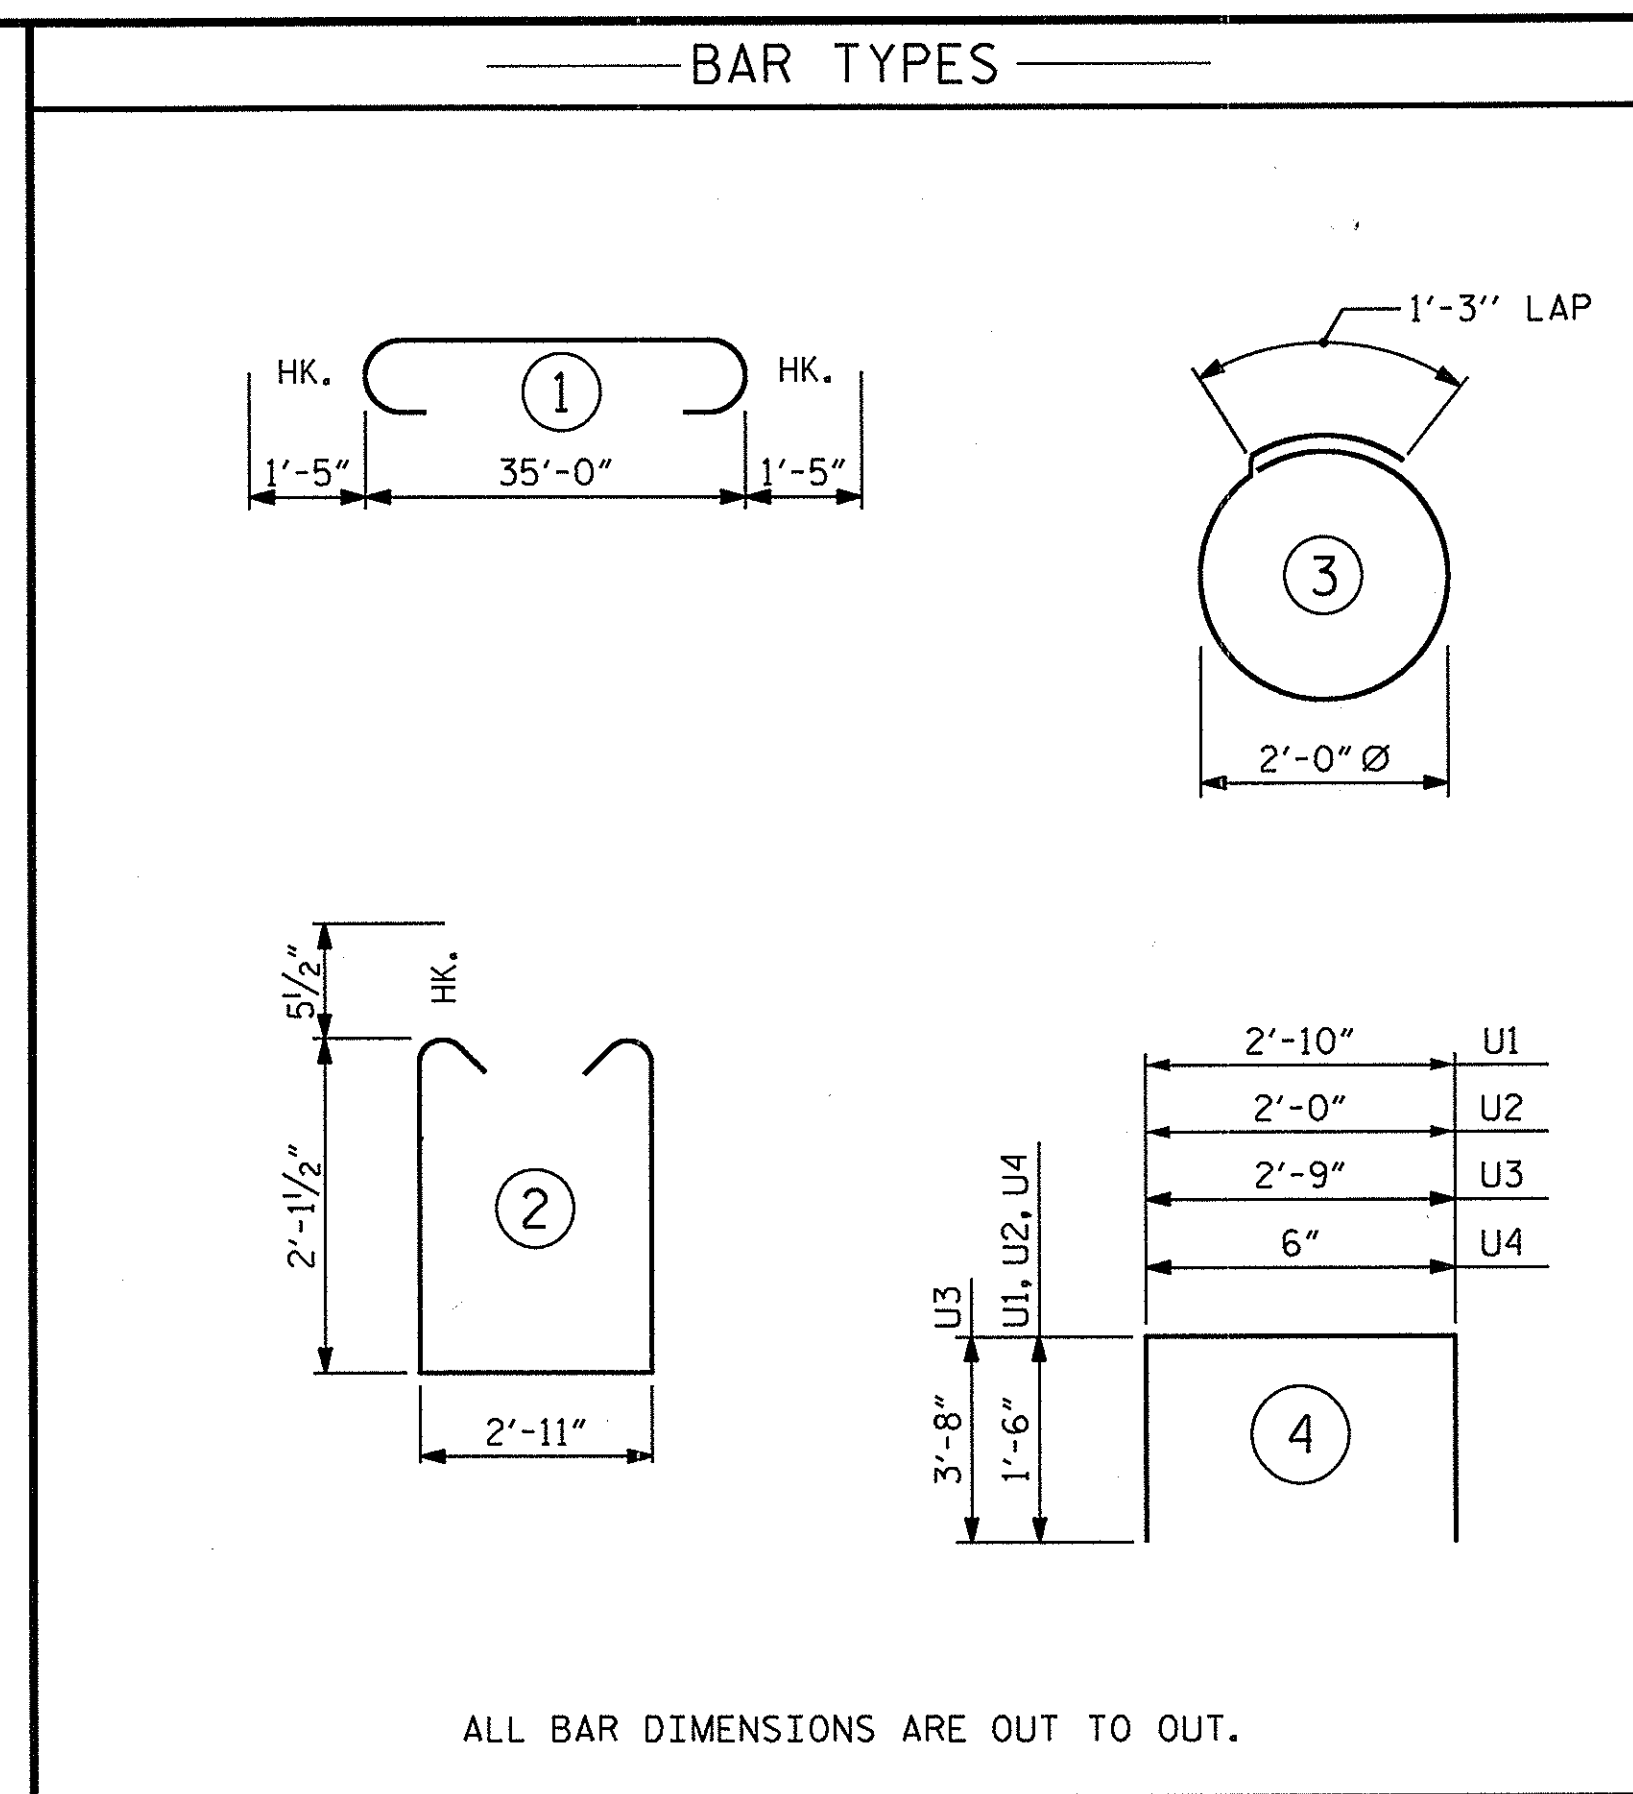


ALL BAR DIMENSIONS ARE OUT TO OUT.

| BILL OF MATERIAL                                 |     |      |      |         |              |
|--|-----|------|------|---------|--------------|
| FOR ONE BENT                                     |     |      |      |         |              |
| BAR  | NO. | SIZE | TYPE | LENGTH  | WEIGHT       |
| B1   | 4   | #10  | 1    | 37'-10" | 651          |
| B2   | 4   | #10  | STR  | 35'-2"  | 605          |
| B3   | 4   | #5   | STR  | 35'-2"  | 147          |
| B4   | 8   | #4   | STR  | 18'-10" | 101          |
| B5   | 13  | #4   | STR  | 2'-11"  | 25           |
| D1   | 44  | #6   | STR  | 1'-6"   | 99           |
| S1   | 39  | #5   | 2    | 8'-1"   | 329          |
| S2   | 16  | #4   | 3    | 7'-7"   | 81           |
| U1   | 4   | #4   | 4    | 5'-10"  | 16           |
| U2   | 6   | #4   | 4    | 5'-0"   | 20           |
| U3   | 2   | #9   | 4    | 10'-1"  | 69           |
| U4   | 8   | #4   | 4    | 3'-6"   | 19           |
| REINFORCING STEEL (FOR ONE BENT)                 |     |      |      |         | 2162 LBS     |
| CLASS A CONCRETE BREAKDOWN (FOR ONE BENT)        |     |      |      |         |              |
| POUR #1 (CAP)                                    |     |      |      |         | 10.7 C.Y.    |
| POUR #2 (LATERAL GUIDES)                         |     |      |      |         | 0.1 C.Y.     |
| TOTAL CLASS A CONCRETE                           |     |      |      |         | 10.8 C.Y.    |
| HP 14 X 73 GALVANIZED STEEL PILES (FOR ONE BENT) |     |      |      |         |              |
| No. 8  |     |      |      |         | LIN. FT. 440 |
| PILE REDRIVES                                    |     |      |      |         | 4 EACH       |

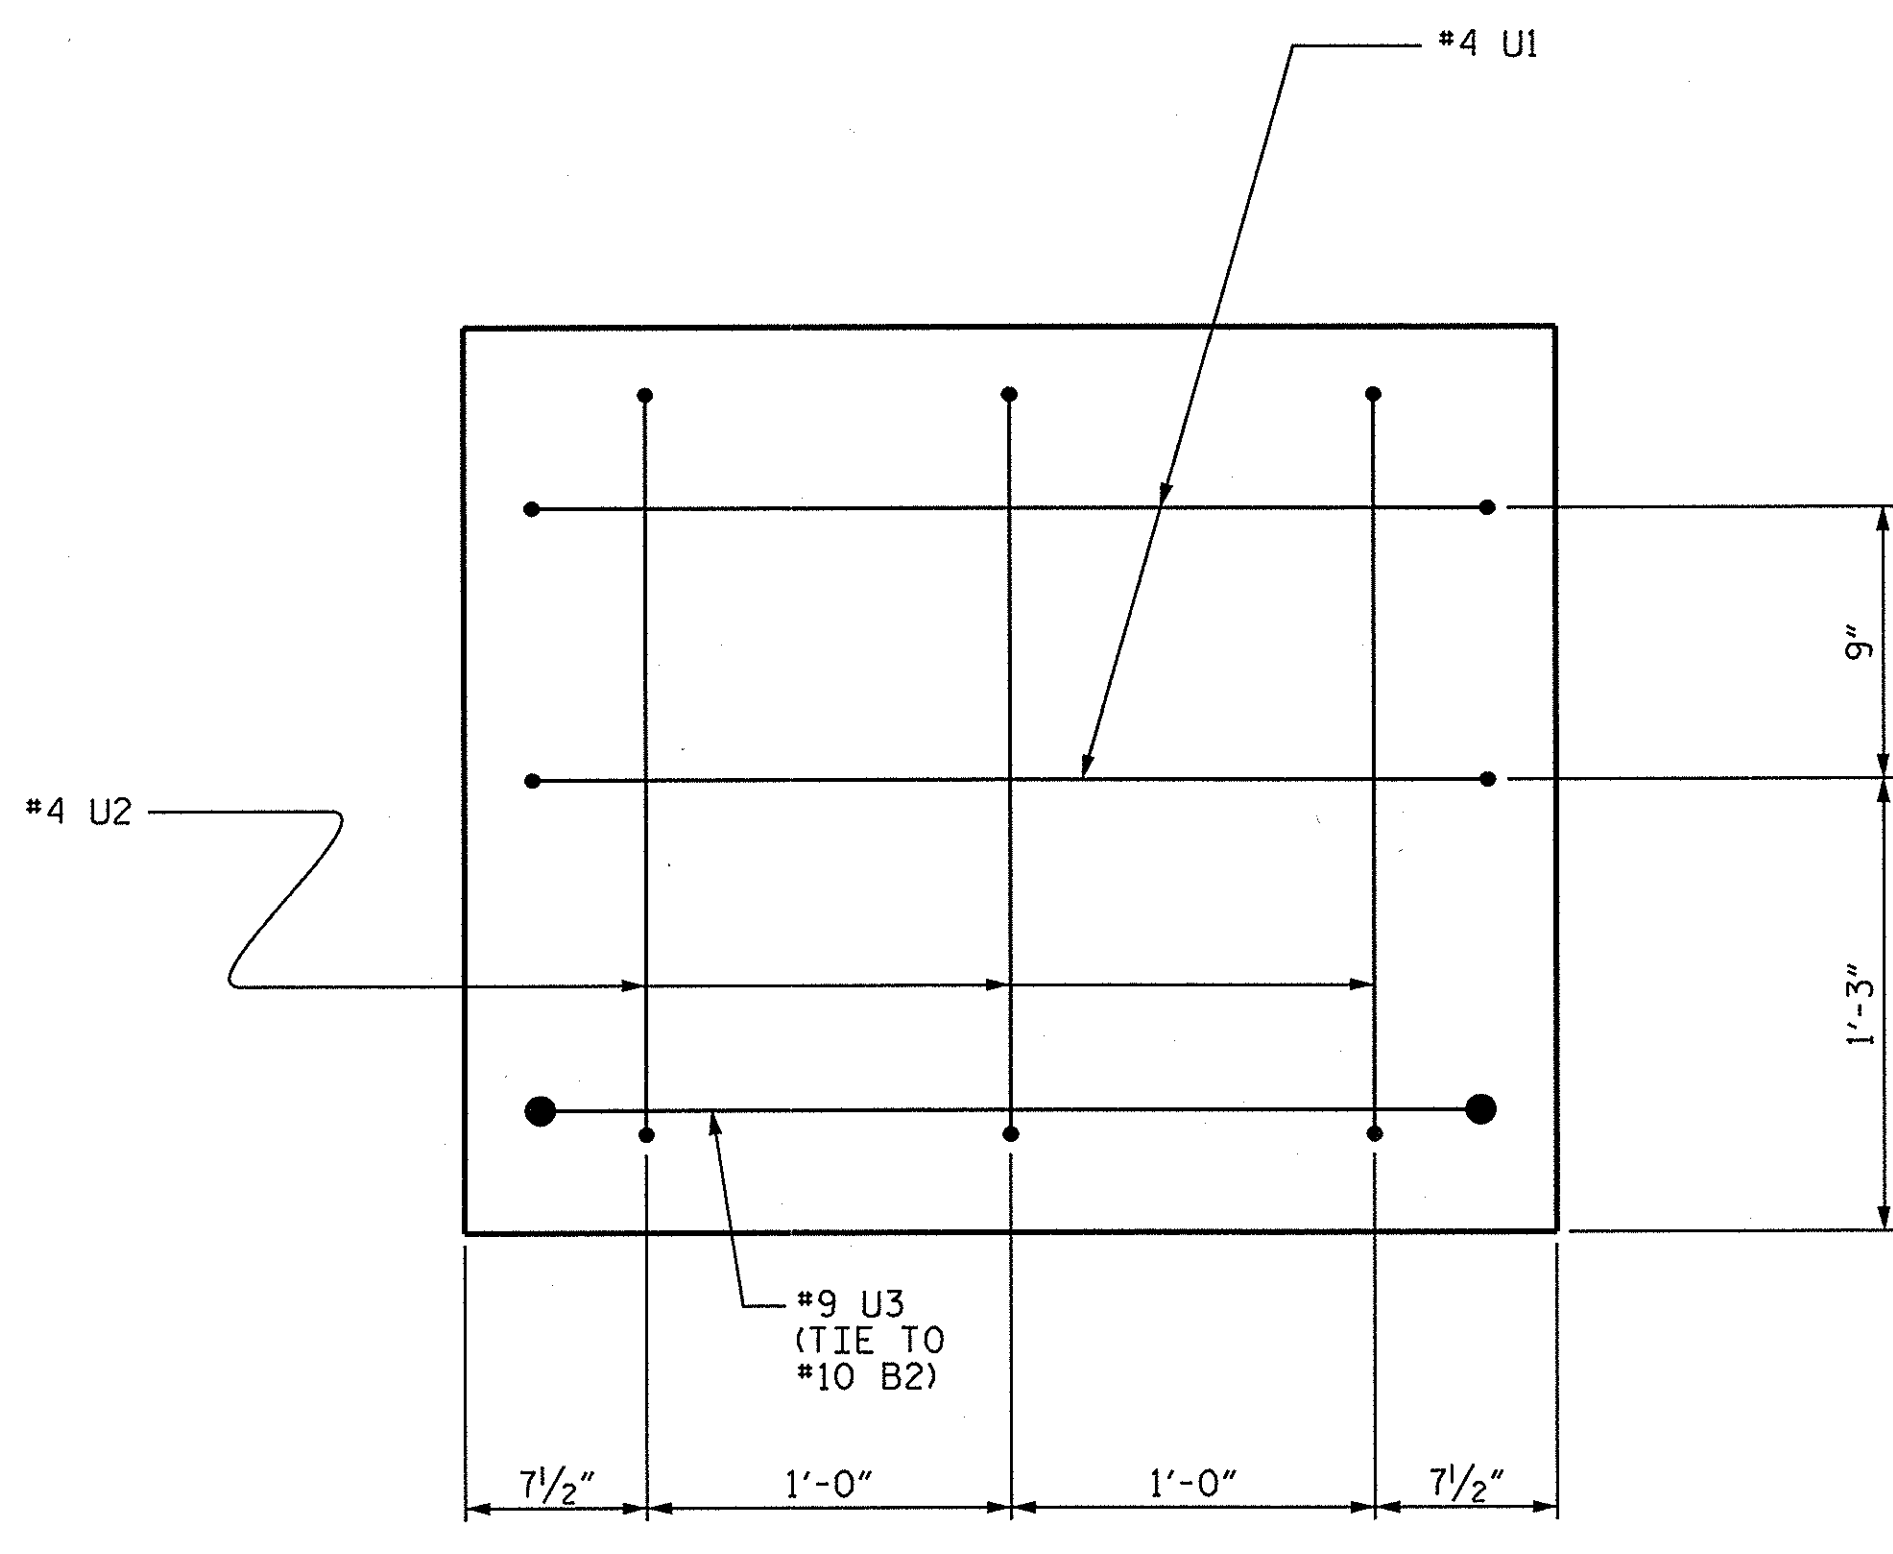

**END OF CAP VIEW**

(TYPICAL BOTH ENDS)

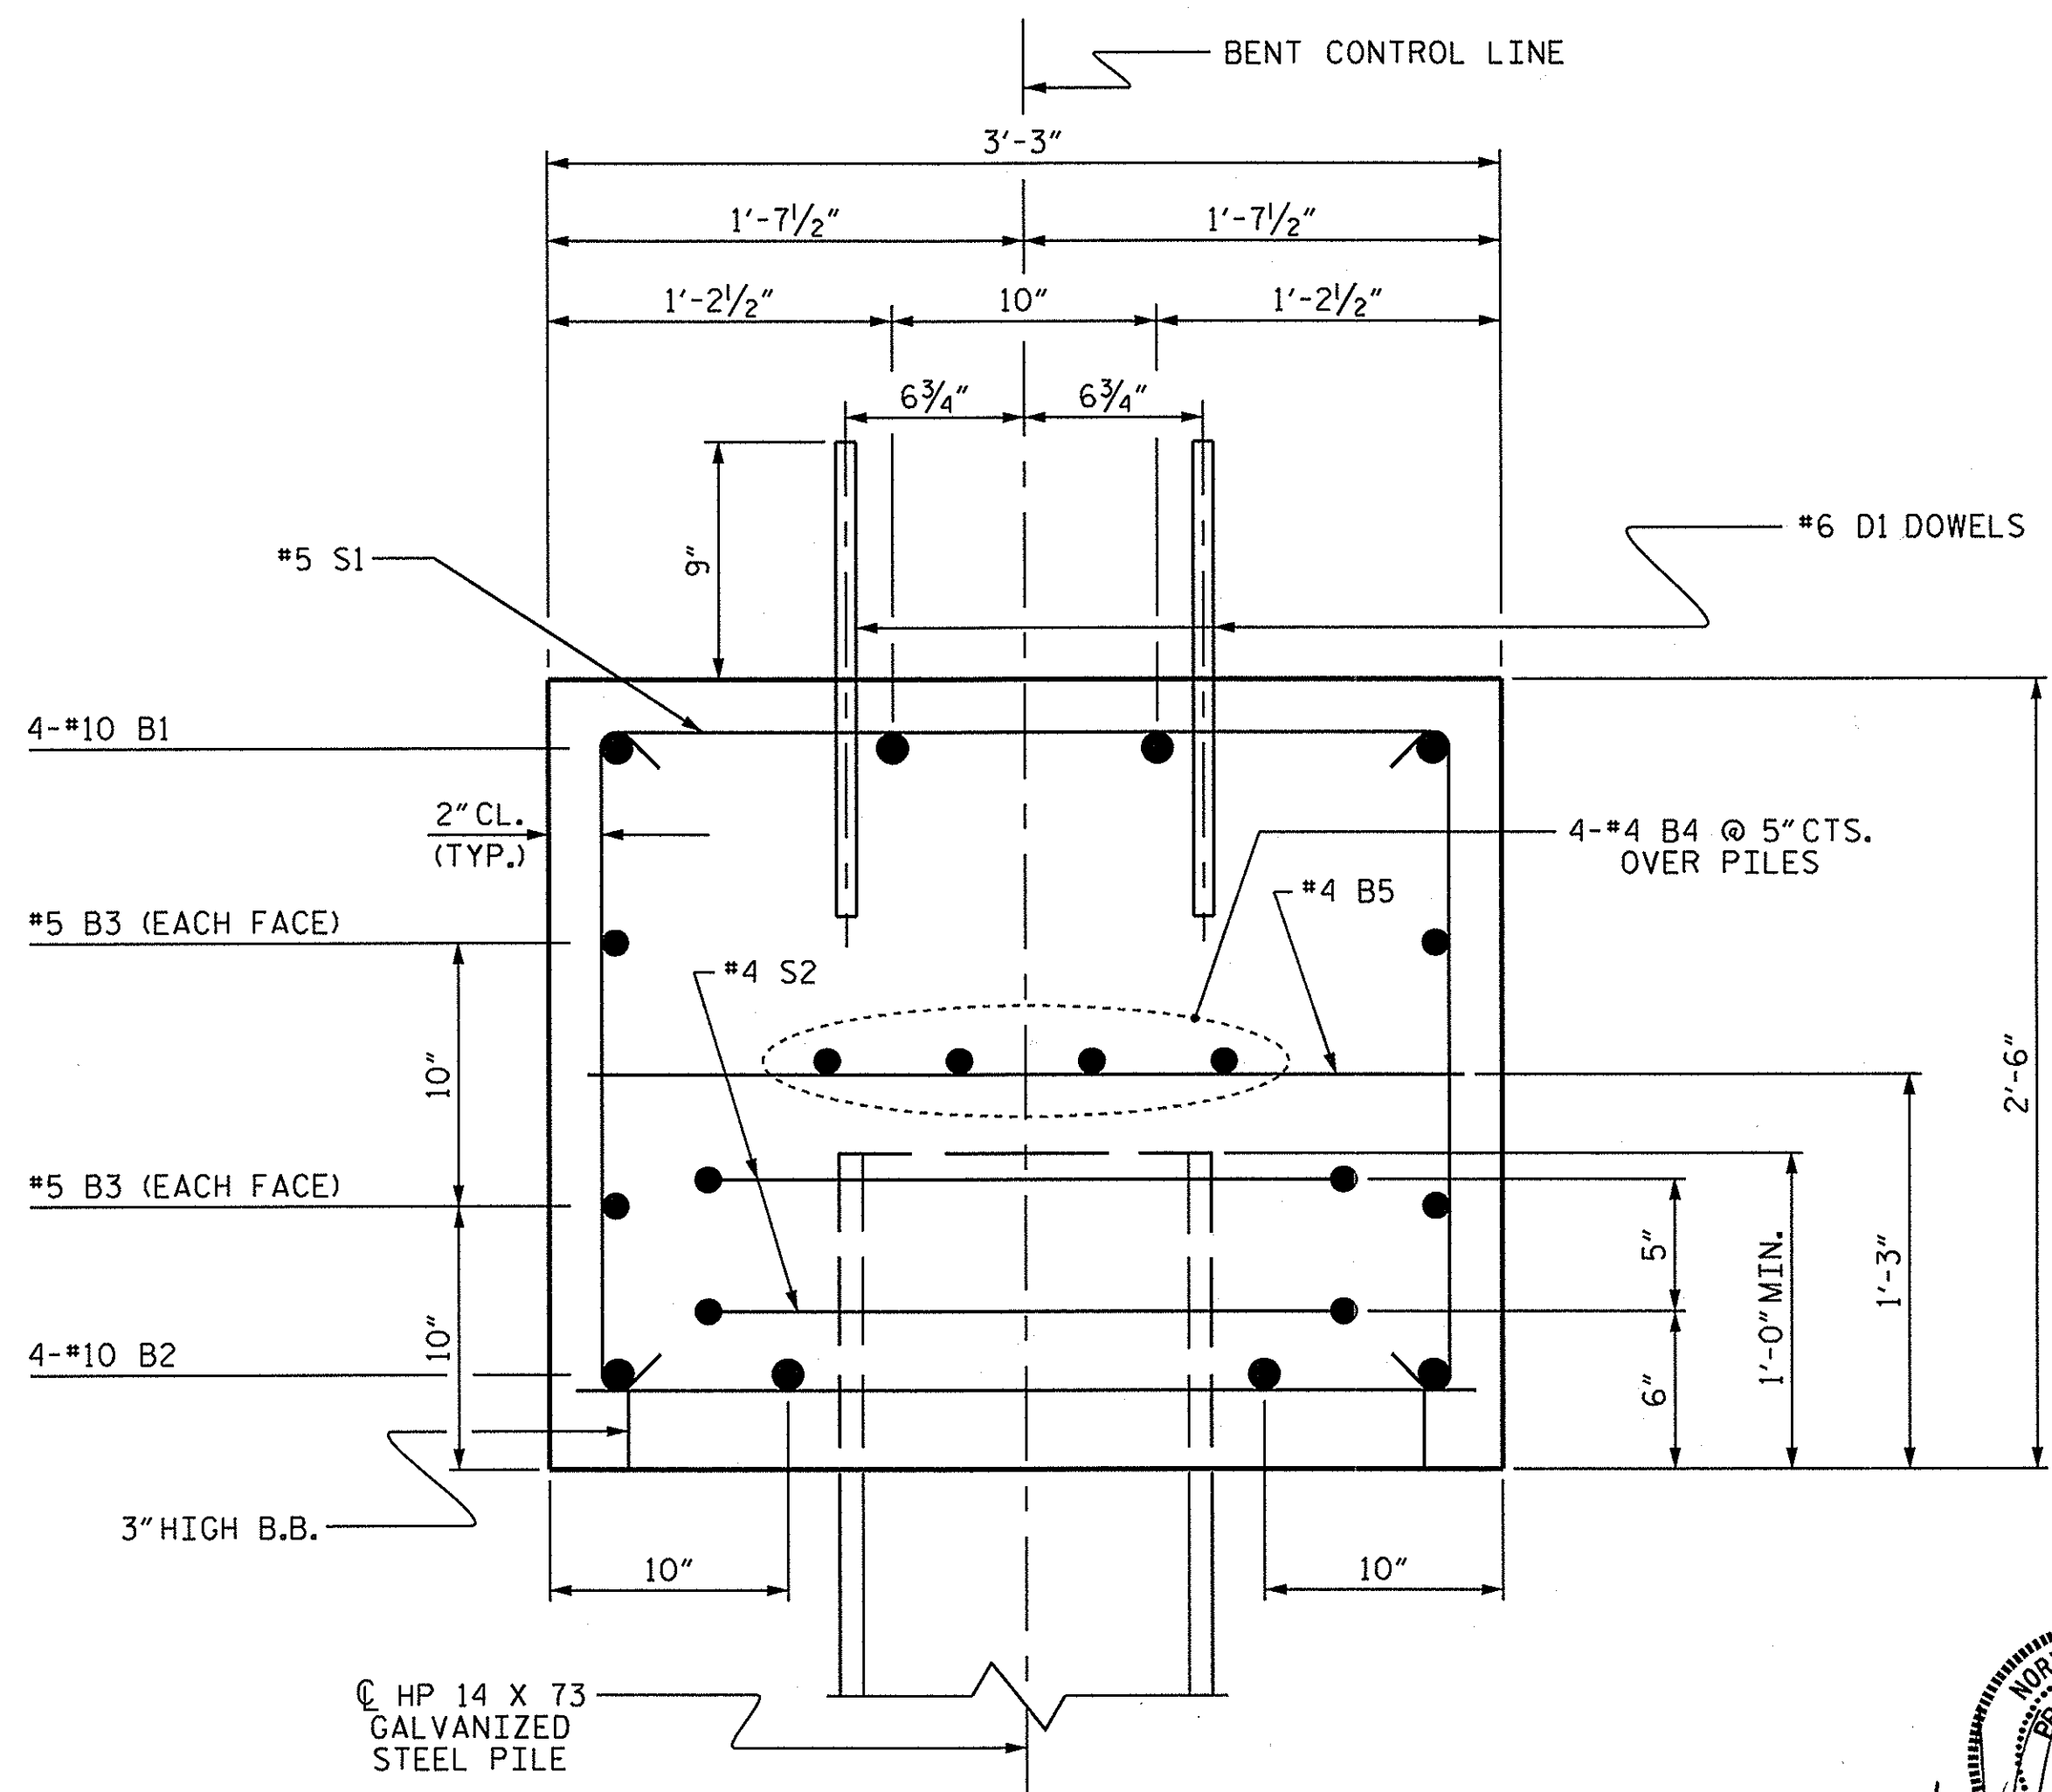


**SECTION A-A**

PROJECT NO. 17BP.2.R.51  
 GREENE COUNTY  
 STATION: 14+81.00 -L-

SHEET 2 OF 2

STATE OF NORTH CAROLINA  
 DEPARTMENT OF TRANSPORTATION  
 RALEIGH

SUBSTRUCTURE  
 BENT Nos. 1 & 2

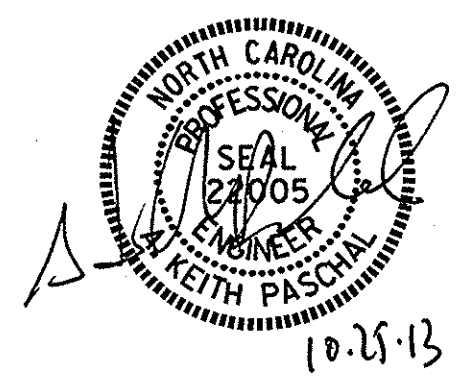


|                           |                |
|---------------------------|----------------|
| DRAWN BY: A. K. PASCHAL   | DATE: 9/27/13  |
| CHECKED BY: J. LAZAROVICH | DATE: 10/14/13 |
| DRAWN BY: DGE 05/10       |                |
| CHECKED BY: MKT 05/10     |                |



| REVISIONS |     |       |     |     |       | SHEET NO.    |
|-----------|-----|-------|-----|-----|-------|--------------|
| NO.       | BY: | DATE: | NO. | BY: | DATE: | S-15         |
| 1         |     |       | 3   |     |       | TOTAL SHEETS |
| 2         |     |       | 4   |     |       | 17           |



NOTES :  
FOR BERM WIDTH DIMENSIONS, SEE GENERAL DRAWING.

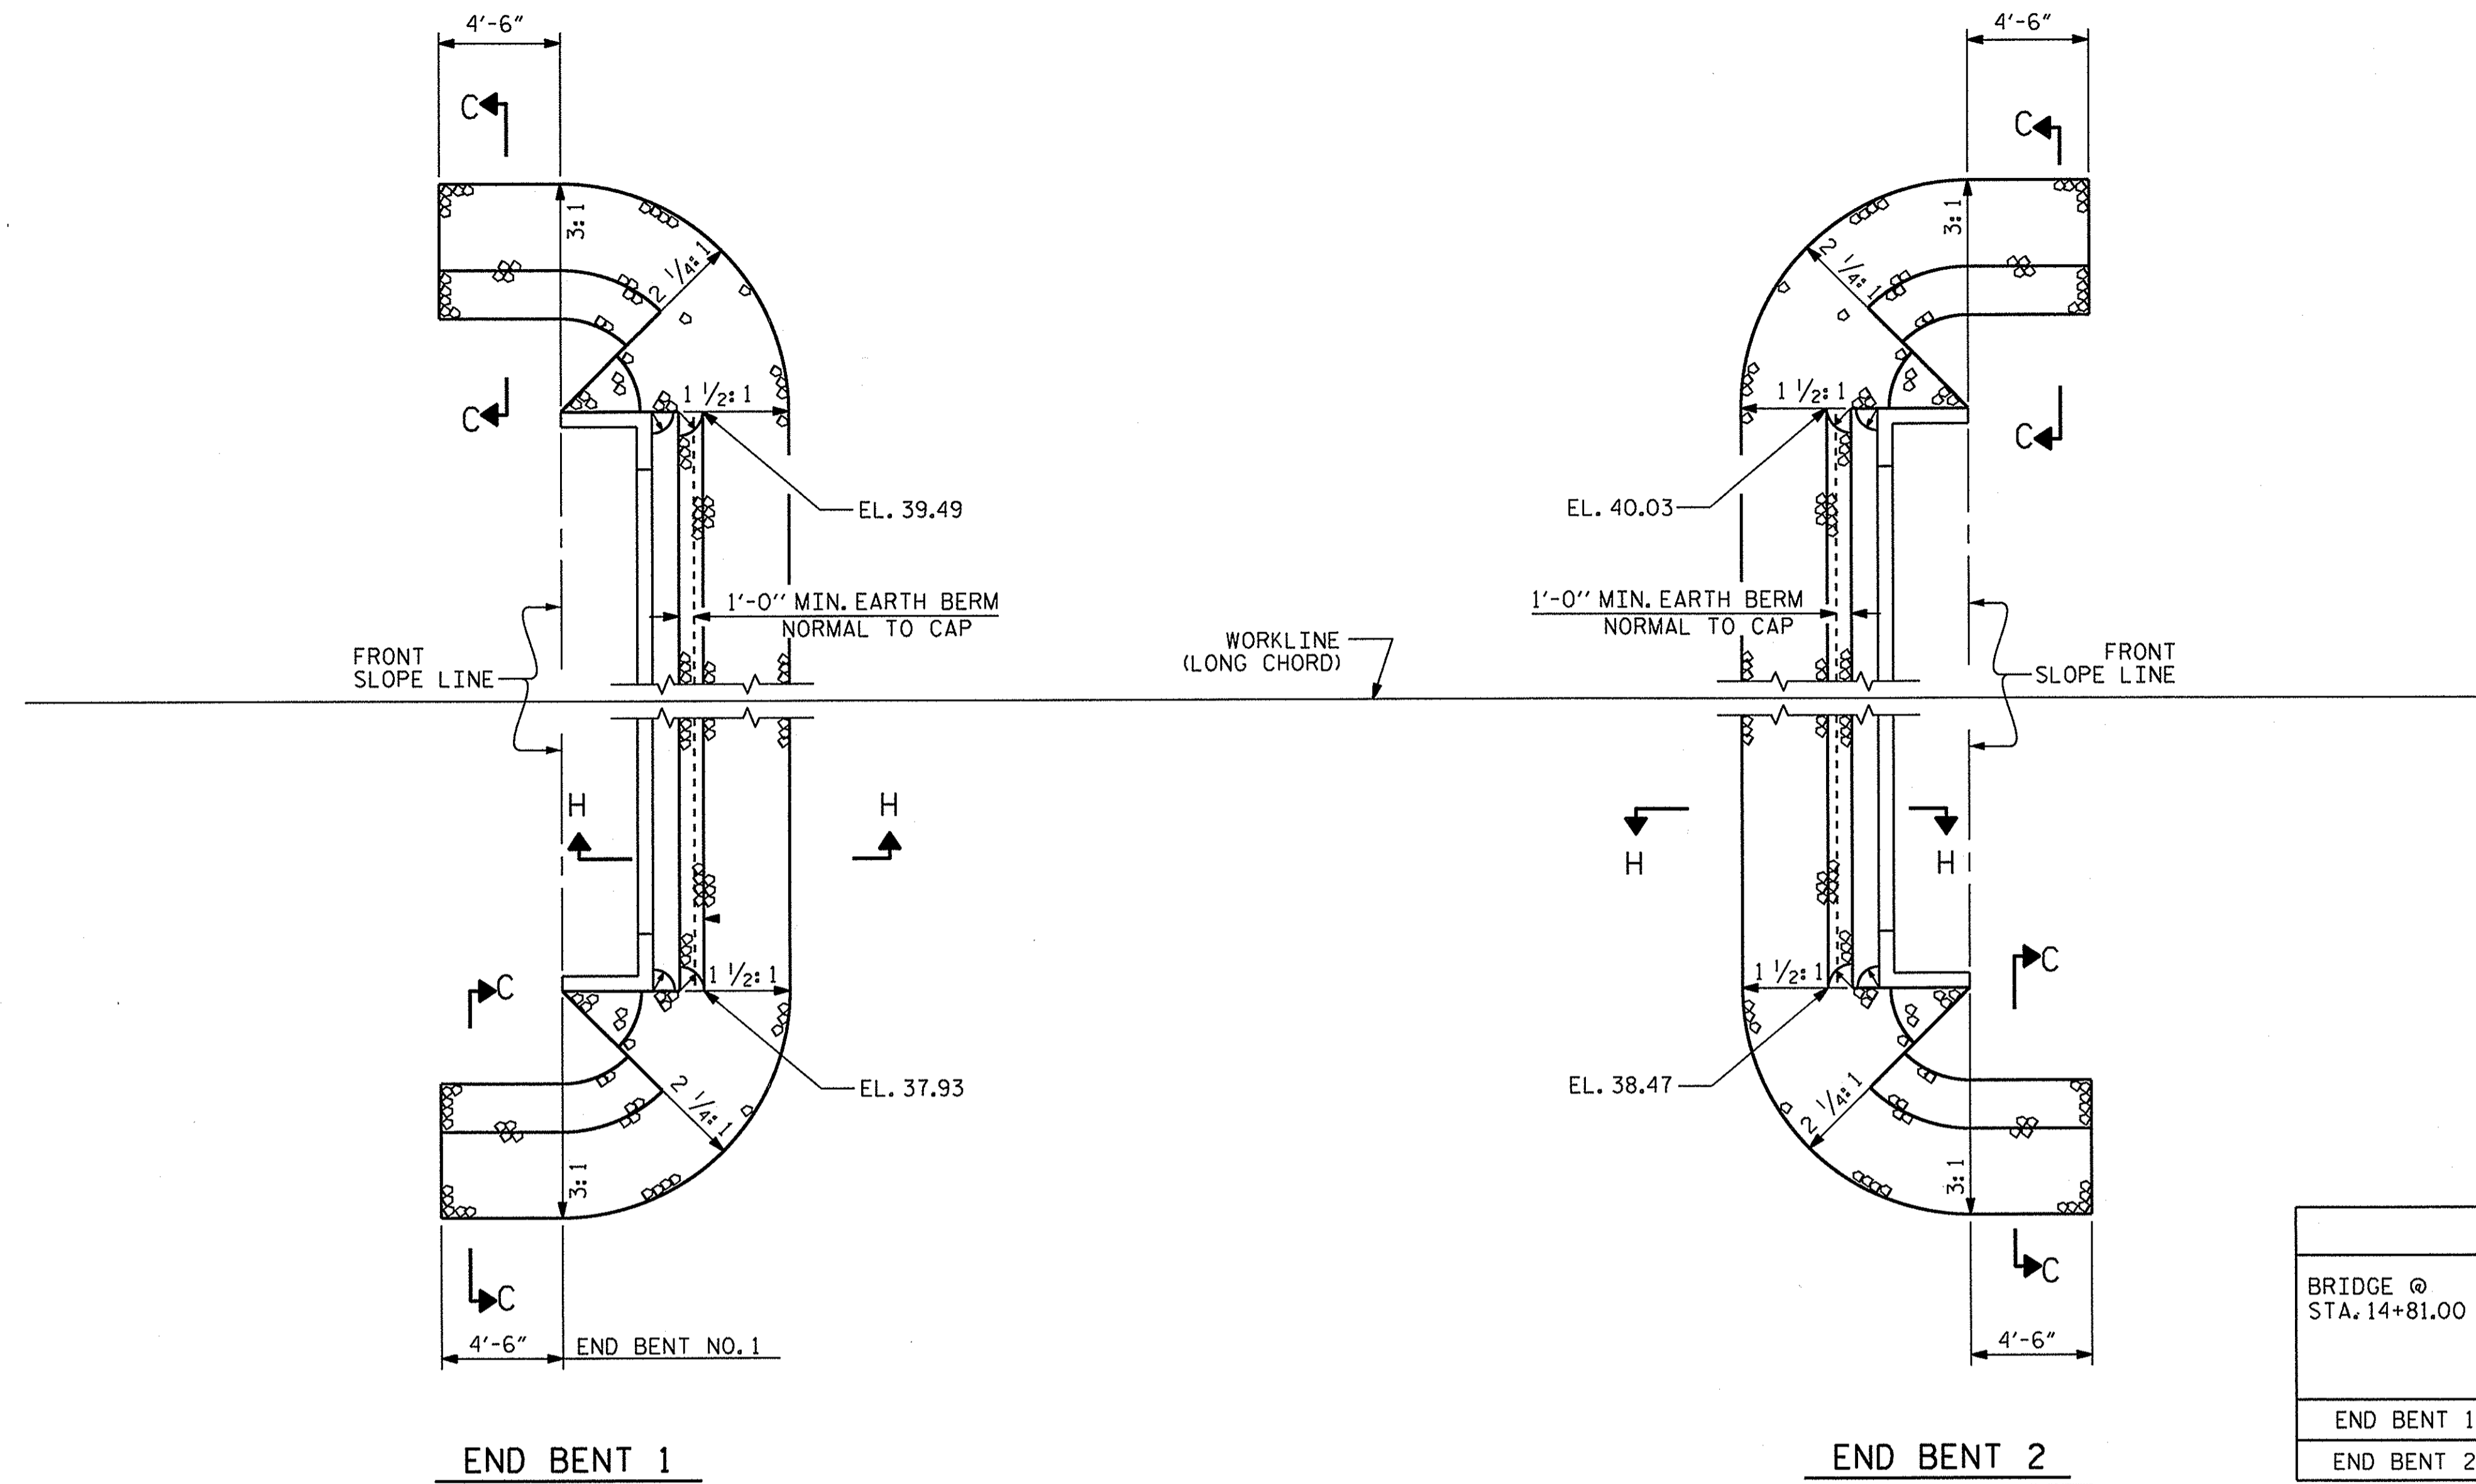

| ESTIMATED QUANTITIES          |                                      |                            |
|-------------------------------|--------------------------------------|----------------------------|
| BRIDGE @<br>STA. 14+81.00 -L- | RIP RAP<br>CLASS II<br>(2'-0" THICK) | GEOTEXTILE<br>FOR DRAINAGE |
|                               | TONS                                 | SQUARE YARDS               |
| END BENT 1                    | 98                                   | 109                        |
| END BENT 2                    | 99                                   | 110                        |

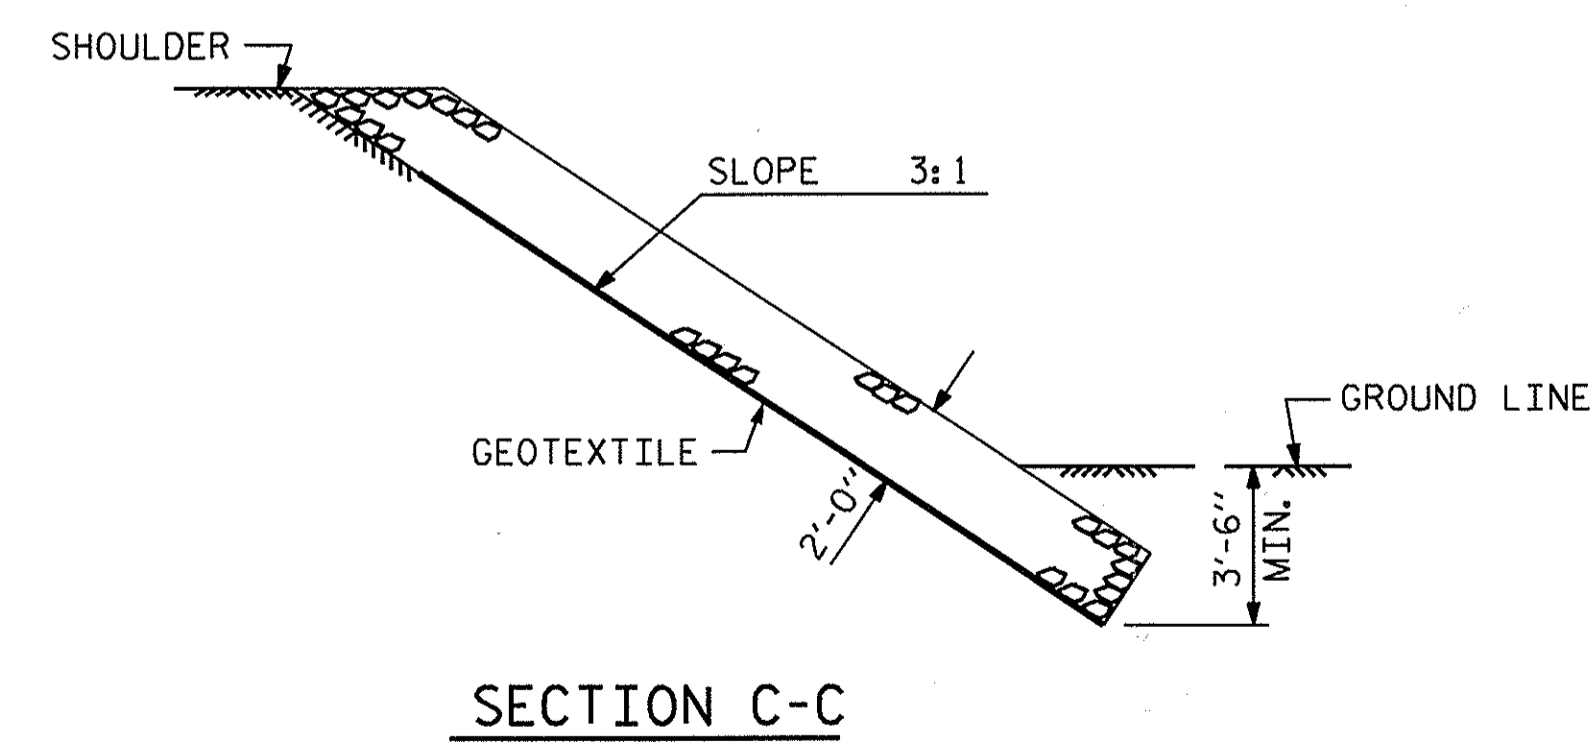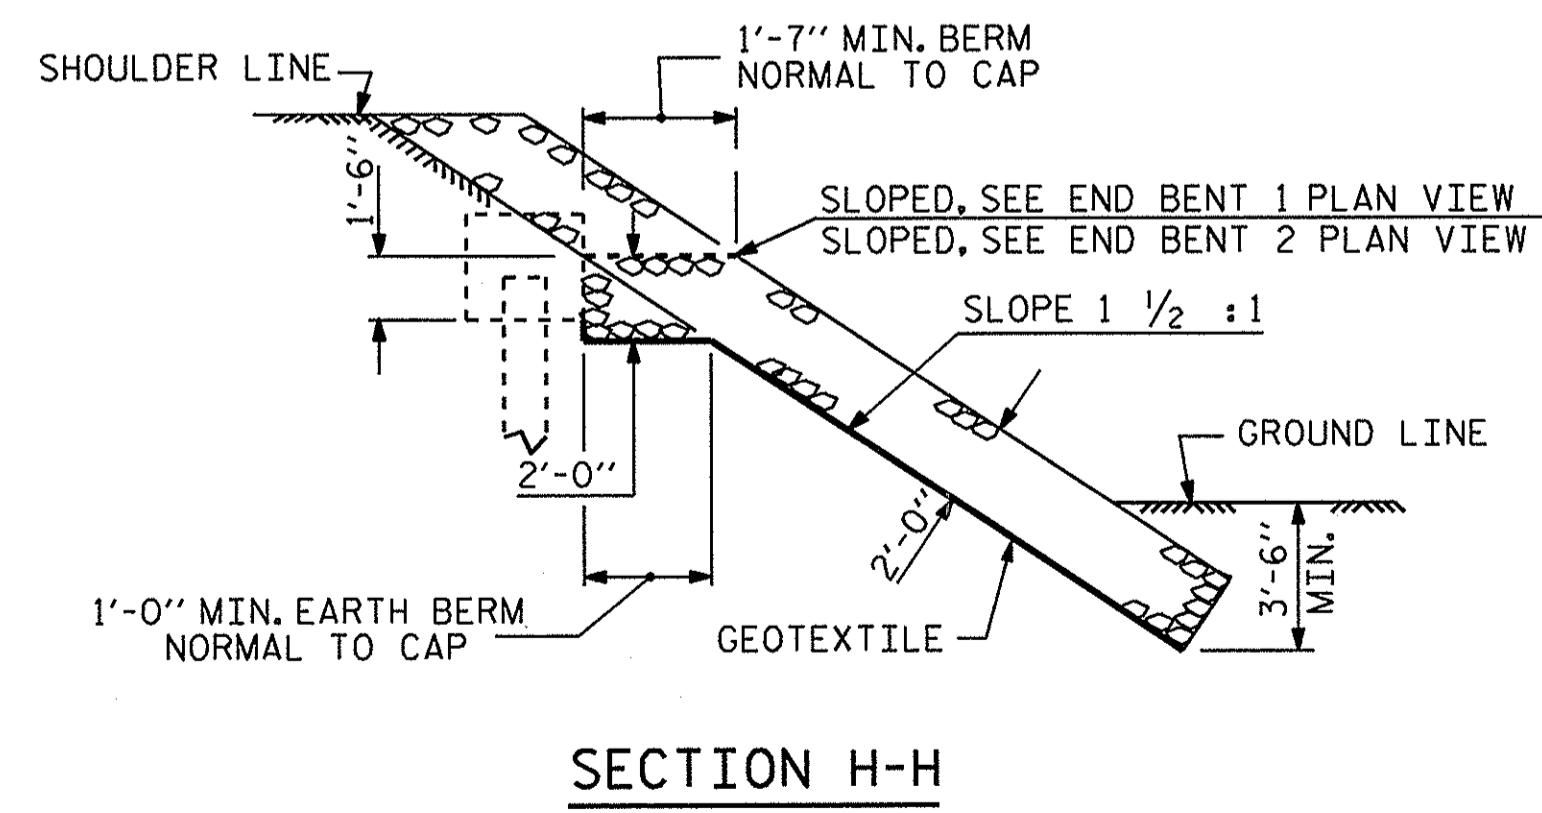


PROJECT NO. 17BP.2.R.51  
GREENE COUNTY  
STATION: 14+81.00 -L-

STATE OF NORTH CAROLINA  
DEPARTMENT OF TRANSPORTATION  
RALEIGH  
STANDARD  
= RIP RAP DETAILS =



ASSEMBLED BY : A. H. SHIVELY DATE : 6/24/13  
CHECKED BY : M. L. RORIE DATE : 7/22/13  
DRAWN BY : REK 1/84 REV. 5/1/06R TLA/GM  
CHECKED BY : ROU 1/84 REV. 10/1/11 MAA/GM  
REV. 12/21/11 MAA/GM

| REVISIONS |     |       |     |     |       | SHEET NO.    |
|-----------|-----|-------|-----|-----|-------|--------------|
| NO.       | BY: | DATE: | NO. | BY: | DATE: | S-16         |
| 1         |     |       | 3   |     |       | TOTAL SHEETS |
| 2         |     |       | 4   |     |       | 17           |

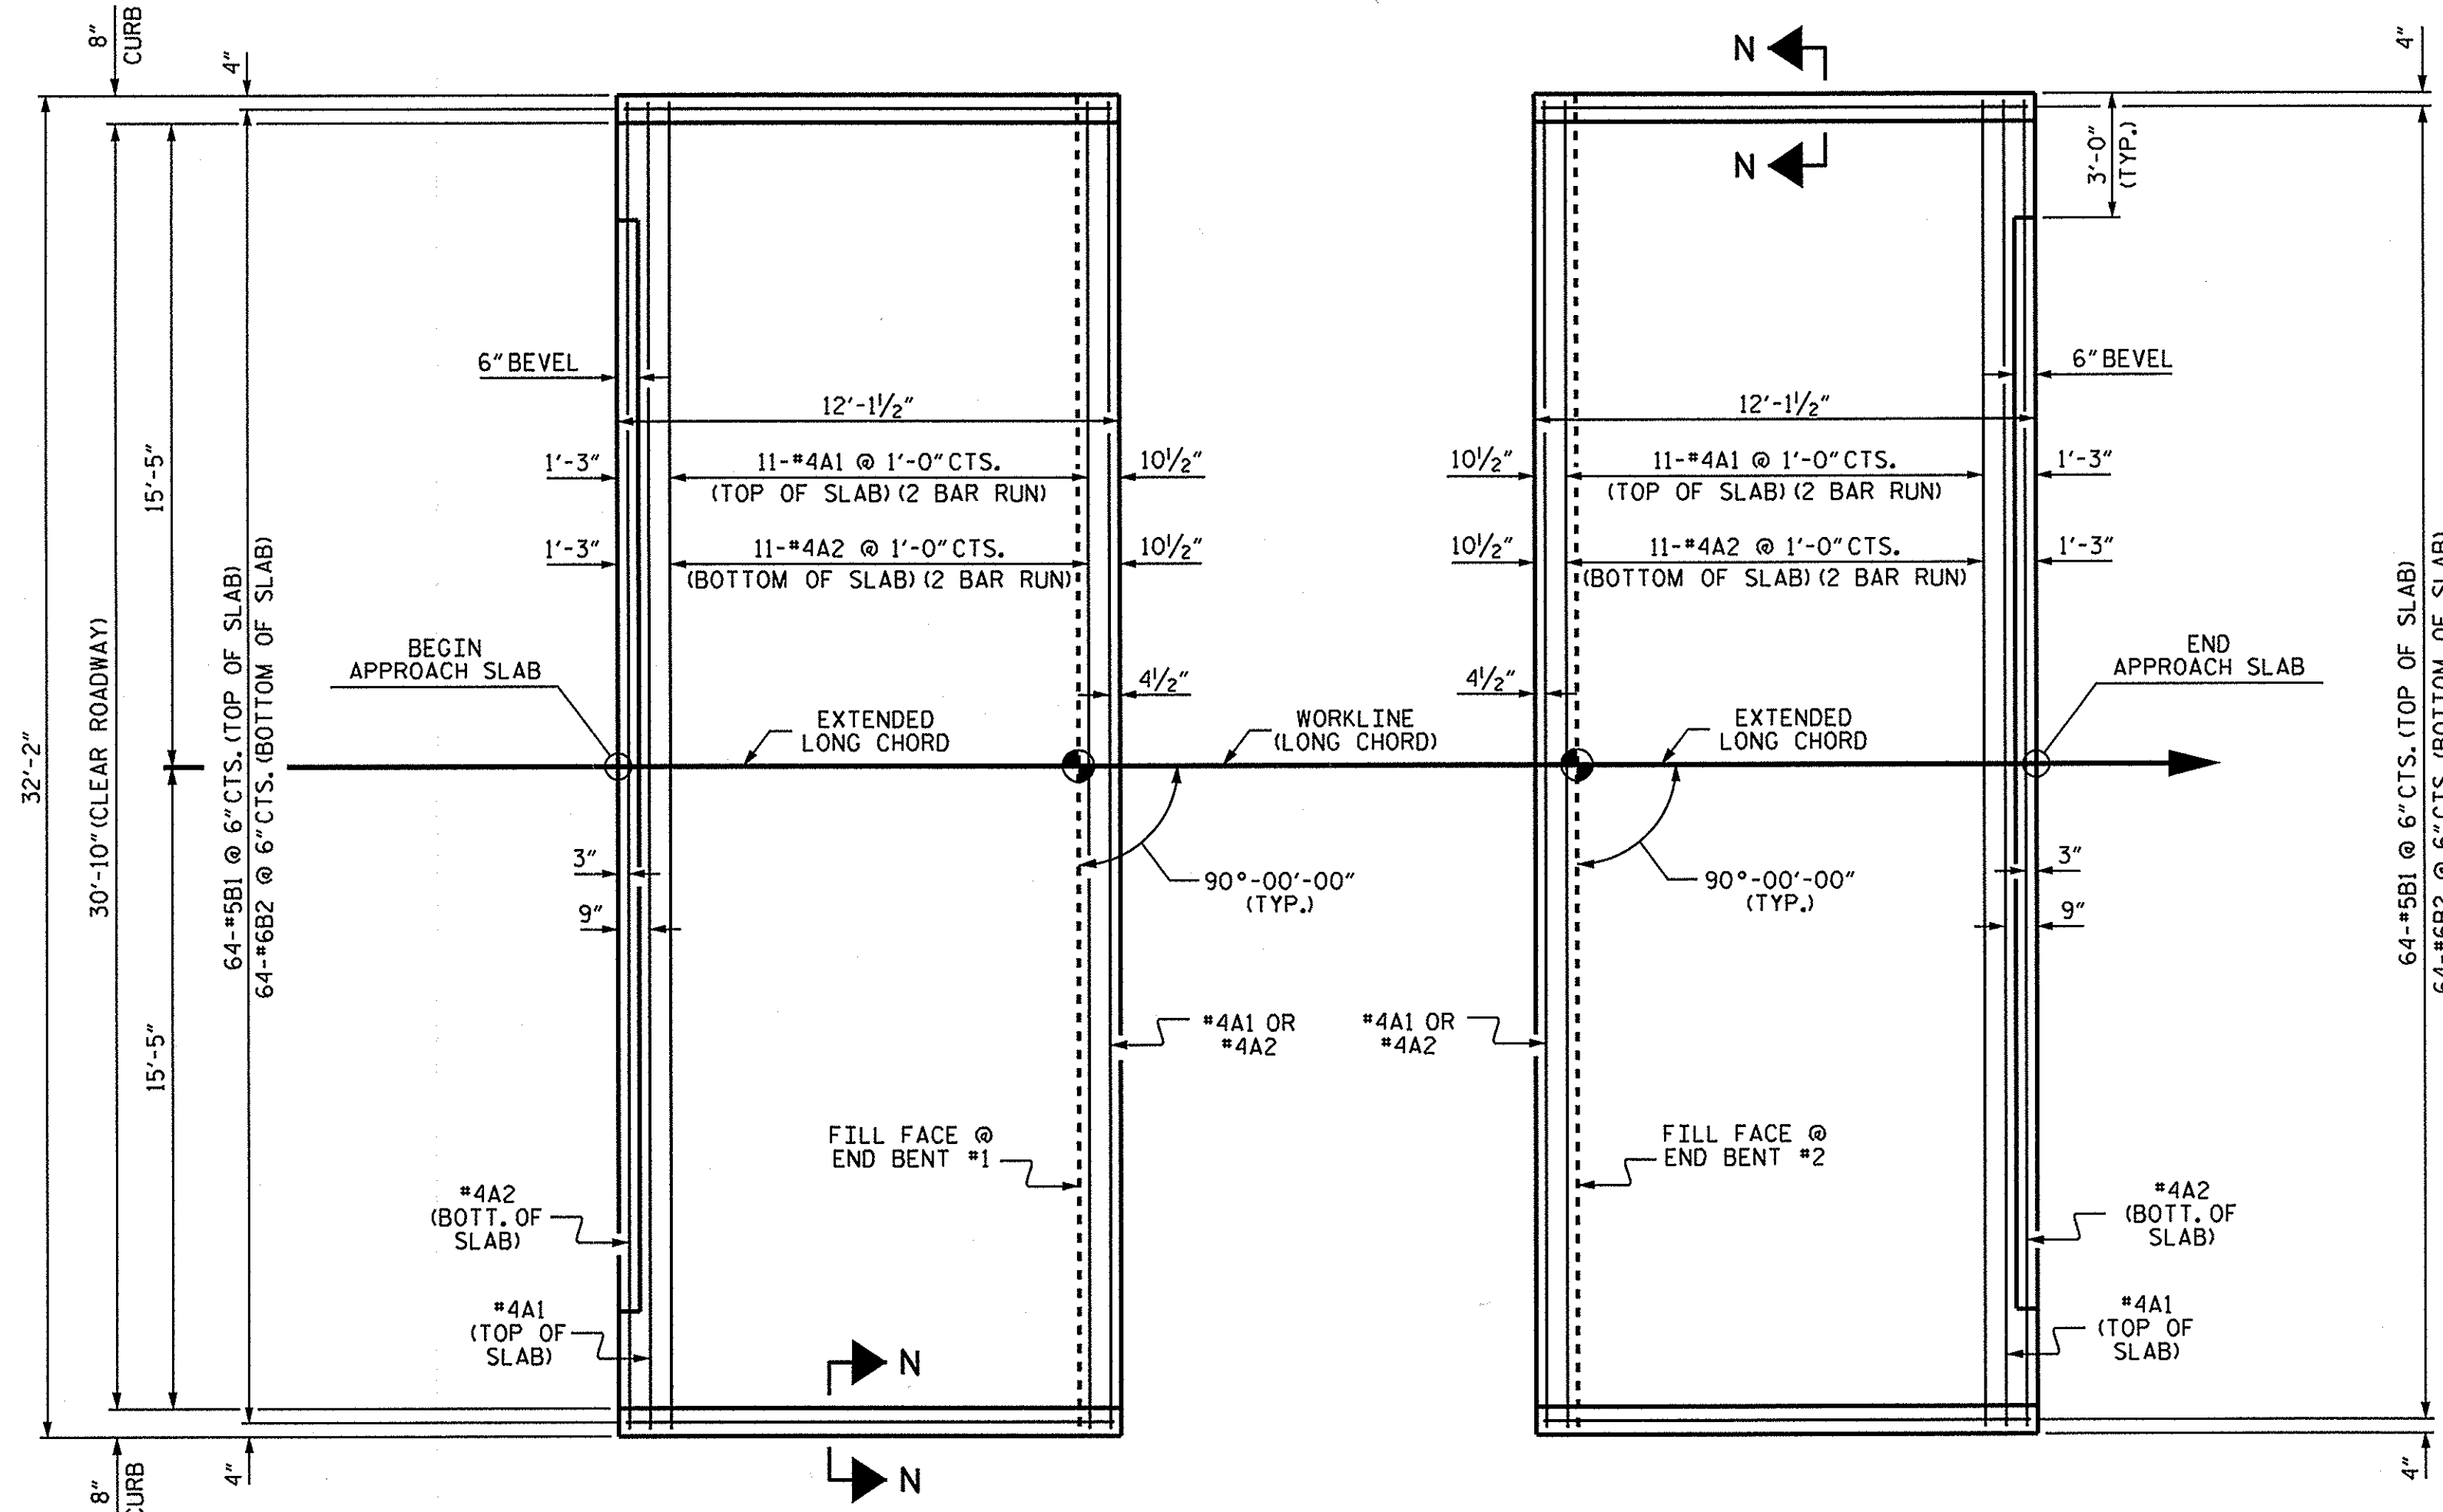


**NOTES**

FOR REINFORCED BRIDGE APPROACH FILL INCLUDING GEOTEXTILE, IMPERMEABLE GEOMEMBRANE, 4" Ø DRAINAGE PIPE, #78M STONE, AND SELECT MATERIAL, SEE ROADWAY PLANS.

AREA BETWEEN THE WINGWALL AND APPROACH SLAB SHALL BE GRADED TO DRAIN THE WATER AWAY FROM THE FILL FACE OF THE BRIDGE AND SHALL BE PAVED. SEE ROADWAY PLANS.


APPROACH SLAB GROOVING IS NOT REQUIRED.

| BILL OF MATERIAL                 |     |      |      |         |            |
|----------------------------------|-----|------|------|---------|------------|
| APPROACH SLAB AT EB #1           |     |      |      |         |            |
| BAR                              | NO. | SIZE | TYPE | LENGTH  | WEIGHT     |
| *A1                              | 26  | #4   | STR  | 16'-11" | 294        |
| A2                               | 26  | #4   | STR  | 16'-9"  | 291        |
| *B1                              | 64  | #5   | STR  | 11'-2"  | 745        |
| B2                               | 64  | #6   | STR  | 11'-8"  | 1121       |
| REINFORCING STEEL                |     |      |      |         | LBS. 1412  |
| * EPOXY COATED REINFORCING STEEL |     |      |      |         | LBS. 1039  |
| CLASS AA CONCRETE                |     |      |      |         | C. Y. 18.6 |
| APPROACH SLAB AT EB #2           |     |      |      |         |            |
| BAR                              | NO. | SIZE | TYPE | LENGTH  | WEIGHT     |
| *A1                              | 26  | #4   | STR  | 16'-11" | 294        |
| A2                               | 26  | #4   | STR  | 16'-9"  | 291        |
| *B1                              | 64  | #5   | STR  | 11'-2"  | 745        |
| B2                               | 64  | #6   | STR  | 11'-8"  | 1121       |
| REINFORCING STEEL                |     |      |      |         | LBS. 1412  |
| * EPOXY COATED REINFORCING STEEL |     |      |      |         | LBS. 1039  |
| CLASS AA CONCRETE                |     |      |      |         | C. Y. 18.6 |

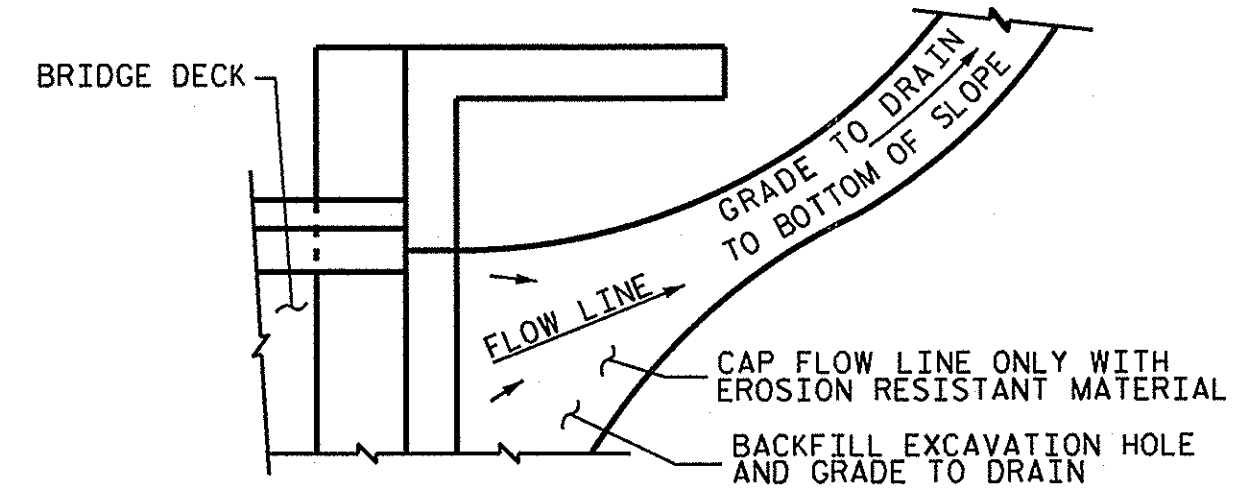


NOTE: IF THE APPROACH SLAB IS NOT CONSTRUCTED IMMEDIATELY AFTER THE BACKFILLING OF THE END BENT EXCAVATION, GRADE TO DRAIN TO THE BOTTOM OF THE SLOPE AND PROVIDE EROSION RESISTANT MATERIAL, SUCH AS FIBERGLASS ROVING OR AS DIRECTED BY THE ENGINEER TO PREVENT SOIL EROSION AND TO PROTECT THE AREA ADJACENT TO THE STRUCTURE. THE CONTRACTOR WILL BE REQUIRED TO REMOVE THESE MATERIALS PRIOR TO CONSTRUCTION OF THE APPROACH SLAB.

**TEMPORARY DRAINAGE DETAIL**

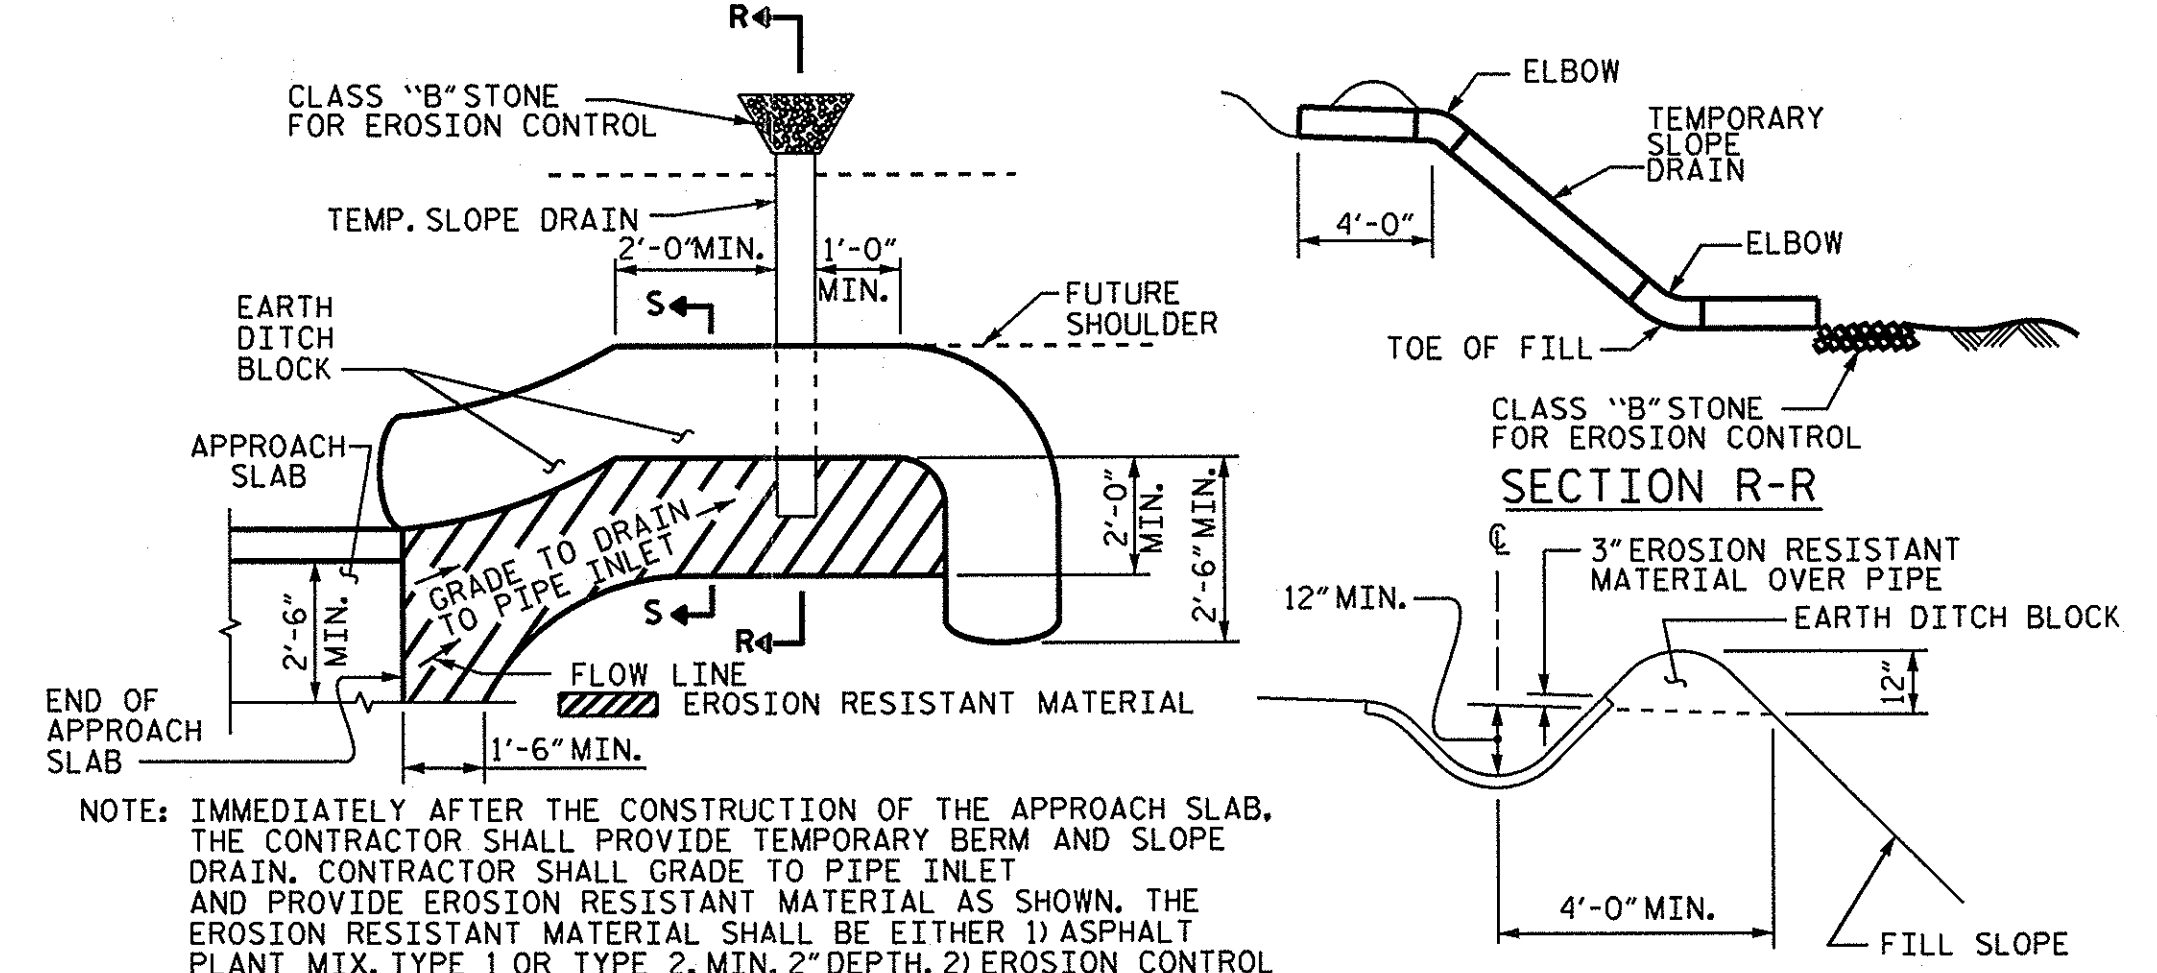



NOTE: IMMEDIATELY AFTER THE CONSTRUCTION OF THE APPROACH SLAB, THE CONTRACTOR SHALL PROVIDE TEMPORARY BERM AND SLOPE DRAIN. CONTRACTOR SHALL GRADE TO PIPE INLET AND PROVIDE EROSION RESISTANT MATERIAL AS SHOWN. THE EROSION RESISTANT MATERIAL SHALL BE EITHER 1) ASPHALT PLANT MIX, TYPE 1 OR TYPE 2, MIN. 2" DEPTH, 2) EROSION CONTROL MAT, OR 3) CONCRETE, AS DIRECTED BY THE ENGINEER. THE SLOPE DRAIN SHALL CONSIST OF A NON-PERFORATED TEMPORARY DRAINAGE PIPE, 12 INCHES IN DIAMETER.

**TEMPORARY BERM AND SLOPE DRAIN DETAILS**  
 (TO BE USED WHEN SHOULDER BERM GUTTER IS REQUIRED)

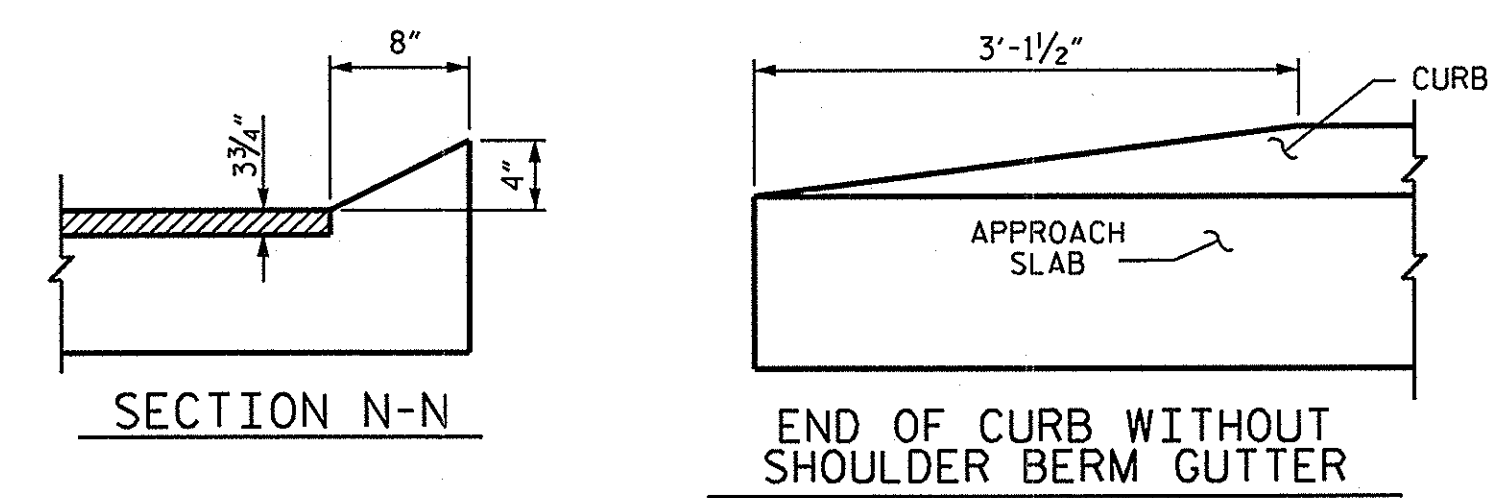

**CURB DETAILS**

| SPLICE LENGTHS |              |          |
|----------------|--------------|----------|
| BAR SIZE       | EPOXY COATED | UNCOATED |
| #4             | 2'-0"        | 1'-9"    |
| #5             | 2'-6"        | 2'-2"    |
| #6             | 3'-10"       | 2'-7"    |

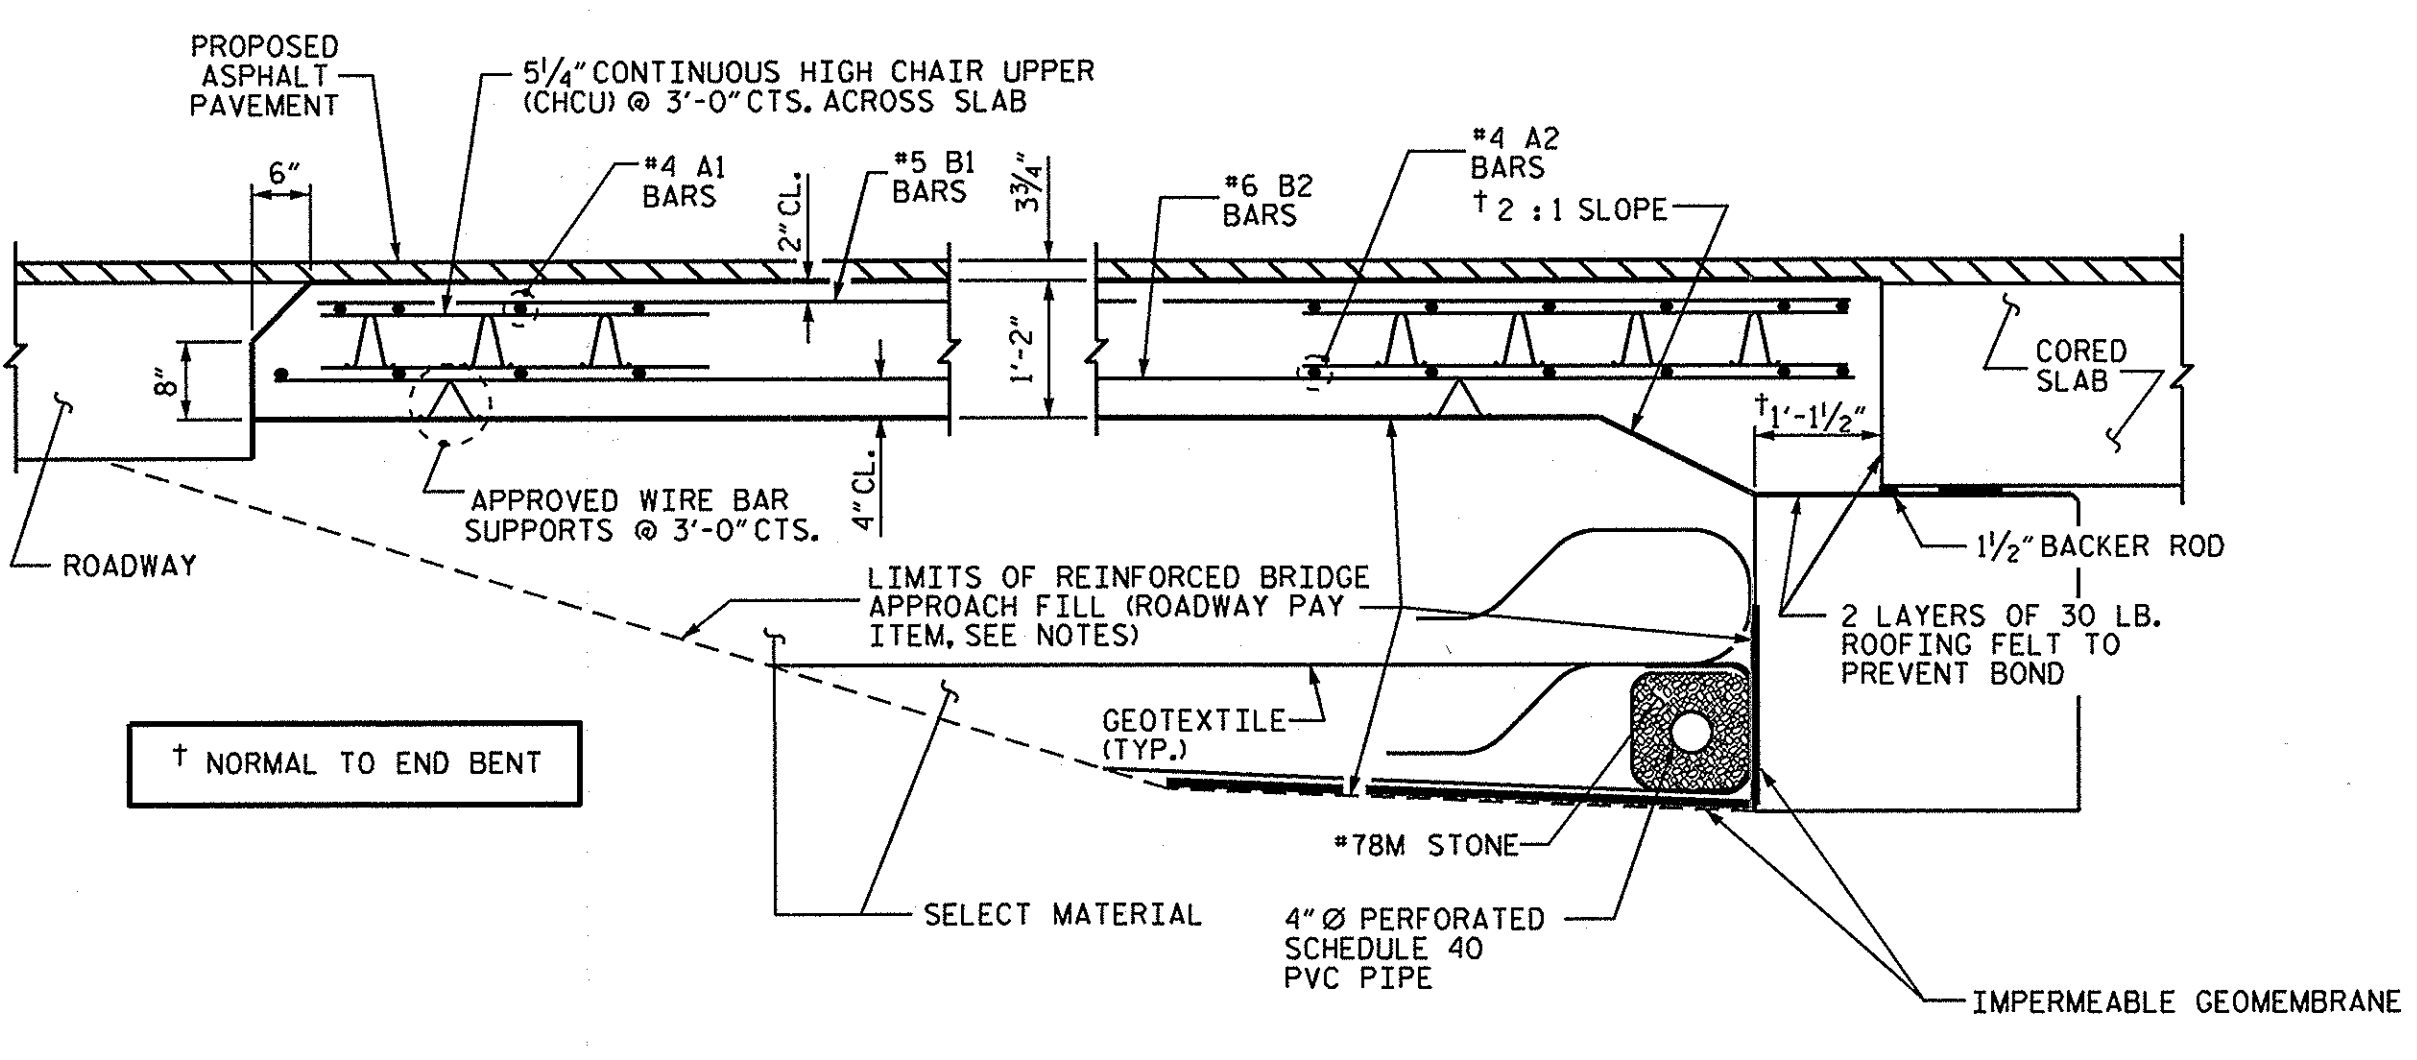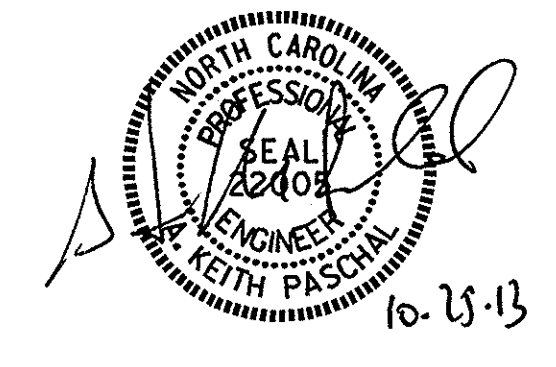

**SECTION THRU SLAB**

ASSEMBLED BY: A. H. SHIVELY DATE: 6/24/13  
 CHECKED BY: M. L. RORIE DATE: 7/22/13  
 DRAWN BY: SHS/MAA 5-09 REV. 12-11 MAA/AAC  
 CHECKED BY: BCH 5-09

PROJECT NO. 17BP.2.R.51  
 GREENE COUNTY  
 STATION: 14+81.00 -L-

STATE OF NORTH CAROLINA  
 DEPARTMENT OF TRANSPORTATION  
 RALEIGH  
 STANDARD  
 BRIDGE APPROACH SLAB  
 FOR PRESTRESSED CONCRETE  
 CORED SLAB UNIT

90° SKEW

| REVISIONS |     |       |     |     | SHEET NO.<br>S-17 |
|-----------|-----|-------|-----|-----|-------------------|
| NO.       | BY: | DATE: | NO. | BY: |                   |
| 1         |     |       | 3   |     |                   |
| 2         |     |       | 4   |     |                   |

## STANDARD NOTES

### DESIGN DATA:

|   |       |                                  |
|---|-------|----------------------------------|
| SPECIFICATIONS                                  | ----- | A.A.S.H.T.O. (CURRENT)           |
| LIVE LOAD                                       | ----- | SEE PLANS                        |
| IMPACT ALLOWANCE                                | ----- | SEE A.A.S.H.T.O.                 |
| STRESS IN EXTREME FIBER OF                      |       |                                  |
| STRUCTURAL STEEL - AASHTO M270 GRADE 36         | -     | 20,000 LBS. PER SQ. IN.          |
| - AASHTO M270 GRADE 50W                         | -     | 27,000 LBS. PER SQ. IN.          |
| - AASHTO M270 GRADE 50                          | -     | 27,000 LBS. PER SQ. IN.          |
| REINFORCING STEEL IN TENSION                    |       |                                  |
| GRADE 60  | --    | 24,000 LBS. PER SQ. IN.          |
| CONCRETE IN COMPRESSION                         | ----- | 1,200 LBS. PER SQ. IN.           |
| CONCRETE IN SHEAR                               | ----- | SEE A.A.S.H.T.O.                 |
| STRUCTURAL TIMBER - TREATED OR                  |       |                                  |
| UNTREATED - EXTREME FIBER STRESS                | ----- | 1,800 LBS. PER SQ. IN.           |
| COMPRESSION PERPENDICULAR TO GRAIN<br>OF TIMBER | ----- | 375 LBS. PER SQ. IN.             |
| EQUIVALENT FLUID PRESSURE OF EARTH              | ----- | 30 LBS. PER CU. FT.<br>(MINIMUM) |

### MATERIAL AND WORKMANSHIP:

EXCEPT AS MAY OTHERWISE BE SPECIFIED ON PLANS OR IN THE SPECIAL PROVISIONS, ALL MATERIAL AND WORKMANSHIP SHALL BE IN ACCORDANCE WITH THE 2012 "STANDARD SPECIFICATIONS FOR ROADS AND STRUCTURES" OF THE N. C. DEPARTMENT OF TRANSPORTATION.

STEEL SHEET PILING FOR PERMANENT OR TEMPORARY APPLICATIONS SHALL BE HOT ROLLED.

### CONCRETE:

UNLESS OTHERWISE REQUIRED ON PLANS, CLASS A CONCRETE SHALL BE USED FOR ALL PORTIONS OF ALL STRUCTURES WITH THE EXCEPTION THAT: CLASS AA CONCRETE SHALL BE USED IN BRIDGE SUPERSTRUCTURES, ABUTMENT BACKWALLS, AND APPROACH SLABS; AND CLASS B CONCRETE SHALL BE USED FOR SLOPE PROTECTION AND RIP RAP.

### CONCRETE CHAMFERS:

UNLESS OTHERWISE NOTED ON THE PLANS, ALL EXPOSED CORNERS ON STRUCTURES SHALL BE CHAMFERED 3/4" WITH THE FOLLOWING EXCEPTIONS: TOP CORNERS OF CURBS MAY BE ROUNDED TO 1-1/2" RADIUS WHICH IS BUILT INTO CURB FORMS; CORNERS OF TRANSVERSE FLOOR EXPANSION JOINTS SHALL BE ROUNDED WITH A 1/4" FINISHING TOOL UNLESS OTHERWISE REQUIRED ON PLANS; AND CORNERS OF EXPANSION JOINTS IN THE ROADWAY FACES AND TOPS OF CURBS AND SIDEWALKS SHALL BE ROUNDED TO A 1/4" RADIUS WITH A FINISHING STONE OR TOOL UNLESS OTHERWISE REQUIRED ON PLANS.

### DOWELS:

DOWELS WHEN INDICATED ON PLANS AS FOR CULVERT EXTENSIONS, SHALL BE EMBEDDED AT LEAST 12" INTO THE OLD CONCRETE AND GROUTED INTO PLACE WITH 1:2 CEMENT MORTAR.

### ALLOWANCE FOR DEAD LOAD DEFLECTION, SETTLEMENT, ETC. IN CASTING SUPERSTRUCTURES:

BRIDGES SHALL BE BUILT ON THE GRADE OR VERTICAL CURVE SHOWN ON PLANS. SLABS, CURBS AND PARAPETS SHALL CONFORM TO THE GRADE OR CURVE.  
ALL DIMENSIONS WHICH ARE GIVEN IN SECTION AND ARE AFFECTED BY DEAD LOAD DEFLECTIONS ARE DIMENSIONS AT CENTER LINE OF BEARING UNLESS OTHERWISE NOTED ON PLANS. IN SETTING FORMS FOR STEEL BEAM BRIDGES AND PRESTRESSED CONCRETE GIRDER BRIDGES, ADJUSTMENTS SHALL BE MADE DUE TO THE DEAD LOAD DEFLECTIONS FOR THE ELEVATIONS SHOWN. WHERE BLOCKS ARE SHOWN OVER BEAMS FOR BUILDING UP TO THE SLAB, THE VERTICAL DIMENSIONS OF THE BLOCKS SHALL BE ADJUSTED BETWEEN BEARINGS TO COMPENSATE FOR DEAD LOAD DEFLECTIONS, VERTICAL CURVE ORDINATE, AND ACTUAL BEAM CAMBER. WHERE BOTTOM OF SLAB IS IN LINE WITH BOTTOM OF TOP FLANGES, DEPTH OF SLAB BETWEEN BEARINGS SHALL BE ADJUSTED TO COMPENSATE FOR DEAD LOAD DEFLECTION, VERTICAL CURVE ORDINATE, AND ACTUAL BEAM CAMBER.  
IN SETTING FALSEWORK AND FORMS FOR REINFORCED CONCRETE SPANS, AN ALLOWANCE SHALL BE MADE FOR DEAD LOAD DEFLECTIONS, SETTLEMENT OF FALSEWORK, AND PERMANENT CAMBER WHICH SHALL BE PROVIDED FOR IN ADDITION TO THE ELEVATIONS SHOWN. AFTER REMOVAL OF THE FALSEWORK, THE FINISHED STRUCTURES SHALL CONFORM TO THE PROFILE AND ELEVATIONS SHOWN ON THE PLANS AND CONSTRUCTION ELEVATIONS FURNISHED BY THE ENGINEER.  
DETAILED DRAWINGS FOR FALSEWORK OR FORMS FOR BRIDGE SUPERSTRUCTURE AND ANY STRUCTURE OR PARTS OF A STRUCTURE AS NOTED ON THE PLANS SHALL BE SUBMITTED TO THE ENGINEER FOR APPROVAL BEFORE CONSTRUCTION OF THE FALSEWORK OR FORMS IS STARTED.

### REINFORCING STEEL:

ALL REINFORCING STEEL SHALL BE DEFORMED. DIMENSIONS RELATIVE TO PLACEMENT OF REINFORCING ARE TO CENTERS OF BARS UNLESS OTHERWISE INDICATED IN THE PLANS. DIMENSIONS ON BAR DETAILS ARE TO CENTERS OF BARS OR ARE OUT TO OUT AS INDICATED ON PLANS.  
WIRE BAR SUPPORTS SHALL BE PROVIDED FOR REINFORCING STEEL WHERE INDICATED ON THE PLANS. WHEN BAR SUPPORT PIECES ARE PLACED IN CONTINUOUS LINES, THEY SHALL BE SO PLACED THAT THE ENDS OF THE SUPPORTING WIRES SHALL BE LAPPED TO LOCK LEGS ON ADJOINING PIECES.

### STRUCTURAL STEEL:

AT THE CONTRACTOR'S OPTION, HE MAY SUBSTITUTE 7/8" Ø SHEAR STUDS FOR THE 3/4" Ø STUDS SPECIFIED ON THE PLANS. THIS SUBSTITUTION SHALL BE MADE AT THE RATE OF 3 - 7/8" Ø STUDS FOR 4 - 3/4" Ø STUDS, AND STUD SPACING CHANGES SHALL BE MADE AS NECESSARY TO PROVIDE THE SAME EQUIVALENT NUMBER OF 7/8" Ø STUDS ALONG THE BEAM AS SHOWN FOR 3/4" Ø STUDS BASED ON THE RATIO OF 3 - 7/8" Ø STUDS FOR 4 - 3/4" Ø STUDS. STUDS OF THE LENGTH SPECIFIED ON THE PLANS MUST BE PROVIDED. THE MAXIMUM SPACING SHALL BE 2'-0".  
EXCEPT AT THE INTERIOR SUPPORTS OF CONTINUOUS BEAMS WHERE THE COVER PLATE IS IN CONTACT WITH BEARING PLATE, THE CONTRACTOR MAY, AT HIS OPTION, SUBSTITUTE FOR THE COVER PLATES DESIGNATED ON THE PLANS COVER PLATES OF THE EQUIVALENT AREA PROVIDED THESE PLATES ARE AT LEAST 5/16" IN THICKNESS AND DO NOT EXCEED A WIDTH EQUAL TO THE FLANGE WIDTH LESS 2" OR A THICKNESS EQUAL TO 2 TIMES THE FLANGE THICKNESS. THE SIZE OF FILLET WELDS SHALL CONFORM TO THE REQUIREMENTS OF THE CURRENT ANSI/AASHTO/AWS "BRIDGE WELDING CODE". ELECTROSLAG WELDING WILL NOT BE PERMITTED.  
WITH THE SOLE EXCEPTION OF EDGES AT SURFACES WHICH BEAR ON OTHER SURFACES, ALL SHARP EDGES AND ENDS OF SHAPES AND PLATES SHALL BE SLIGHTLY ROUNDED BY SUITABLE MEANS TO A RADIUS OF APPROXIMATELY 1/16 INCH OR EQUIVALENT FLAT SURFACE AT A SUITABLE ANGLE PRIOR TO PAINTING, GALVANIZING, OR METALLIZING.

### HANDRAILS AND POSTS:

METAL STANDARDS AND FACES OF THE CONCRETE END POSTS FOR THE METAL RAIL SHALL BE SET NORMAL TO THE GRADE OF THE CURB, UNLESS OTHERWISE SHOWN ON PLANS. THE METAL RAIL AND TOPS OF CONCRETE POSTS USED WITH THE ALUMINUM RAIL SHALL BE BUILT PARALLEL TO THE GRADE OF THE CURB.  
METAL HANDRAILS SHALL BE IN ACCORDANCE WITH THE PLANS. RAILS SHALL BE AS MANUFACTURED FOR BRIDGE RAILING. CASTINGS SHALL BE OF A UNIFORM APPEARANCE. FINISHES AND OTHER DEFORMATIONS RESULTING FROM CASTING OR OTHERWISE SHALL BE REMOVED IN A MANNER SO THAT A UNIFORM COLORING OF THE COMPLETED CASTING SHALL BE OBTAINED. CASTINGS WITH DISCOLORATIONS OR OF NON-UNIFORM COLORING WILL NOT BE ACCEPTED. CERTIFIED MILL REPORTS ARE REQUIRED FOR METAL RAILS AND POSTS.

### SPECIAL NOTES:

GENERALLY, IN CASE OF DISCREPANCY, THIS STANDARD SHEET OF NOTES SHALL GOVERN OVER THE SPECIFICATIONS, BUT THE REMAINDER OF THE PLANS SHALL GOVERN OVER NOTES HEREON, AND SPECIAL PROVISIONS SHALL GOVERN OVER ALL. SEE SPECIFICATIONS ARTICLE 105-4.

ENGLISH

JANUARY, 1990