


TIP PROJECT: BD-5102M

CONTRACT:

See Sheet 1-A For Index of Sheets

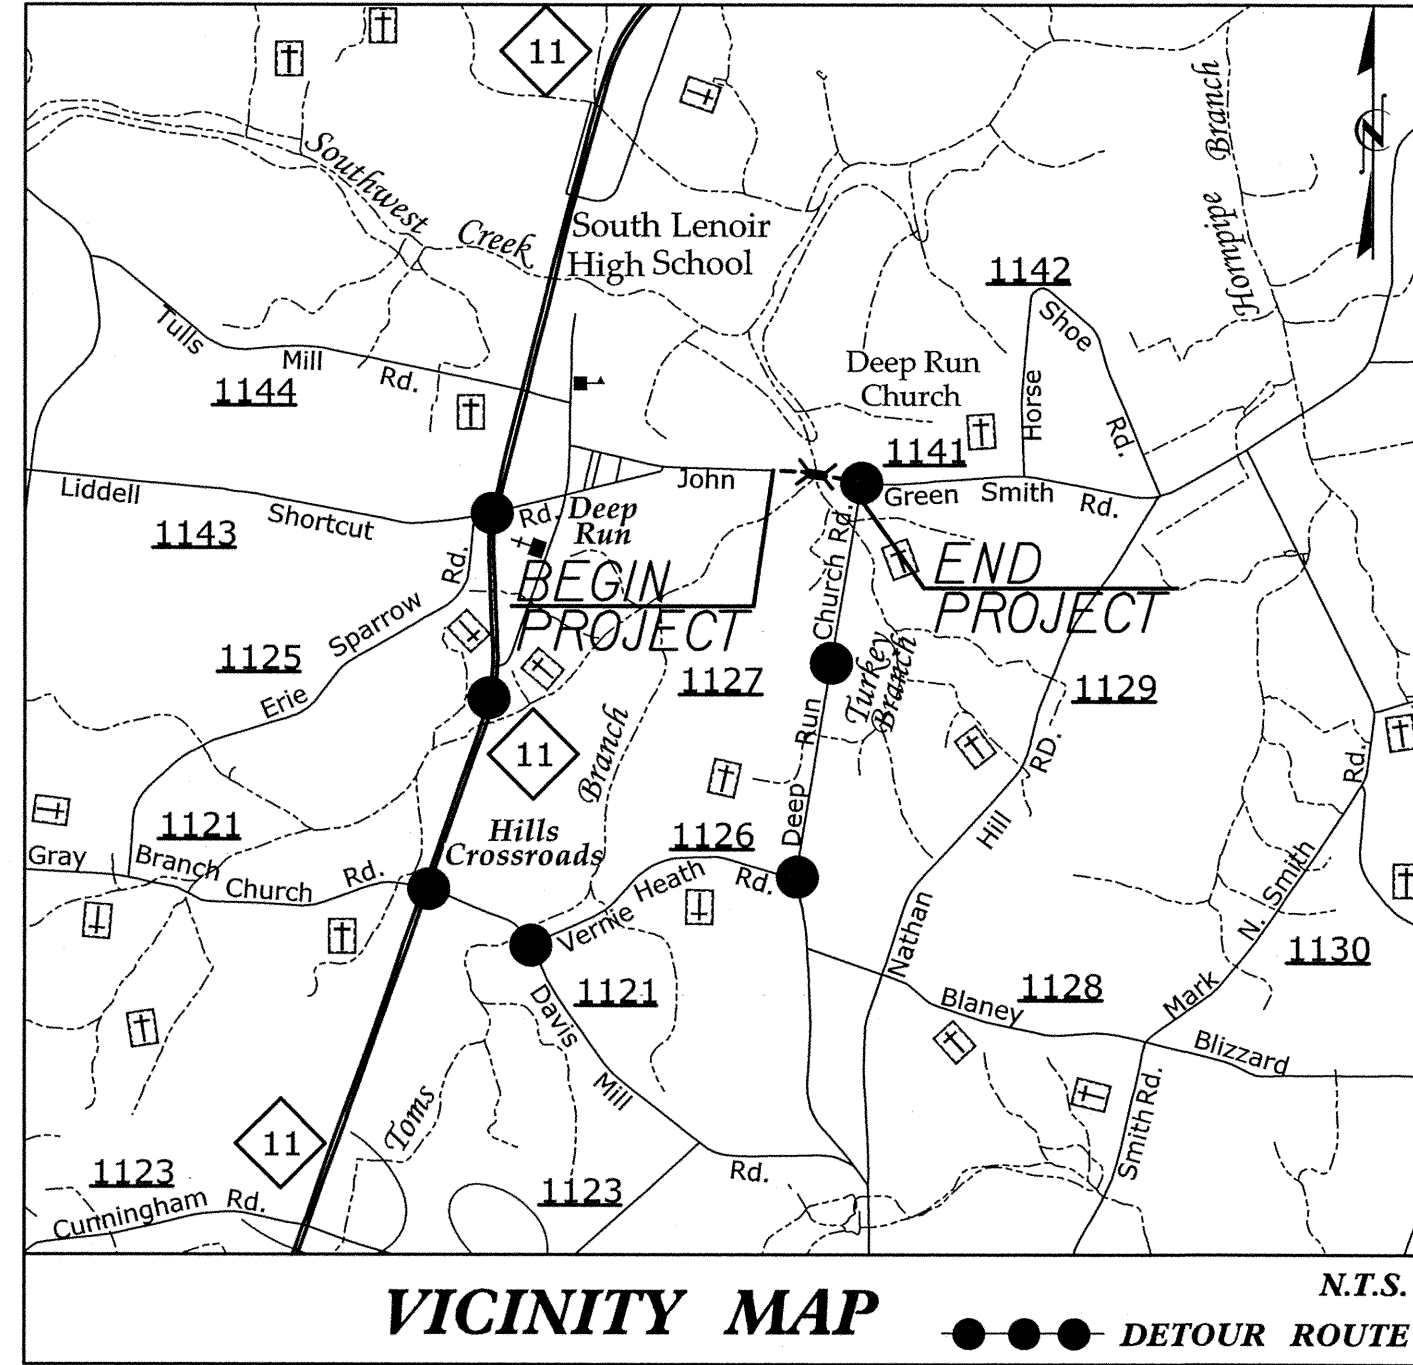


STATE OF NORTH CAROLINA
DIVISION OF HIGHWAYS

LENOIR COUNTY


**LOCATION: BRIDGE NO. 032 OVER DEEEP RUN
ON SR 1141 (JOHN GREEN SMITH ROAD)**

TYPE OF WORK: LOW IMPACT BRIDGE REPLACEMENT

STATE	PROJECT REFERENCE NO.	SHEET NO.	TOTAL SHEETS
NC	BD-5102M	1	X
STATE PROJ. NO.	F.A. PROJ. NO.	DESCRIPTION	
45348.1.13	BRZ-1141(27)	LIB REPLACEMENT	

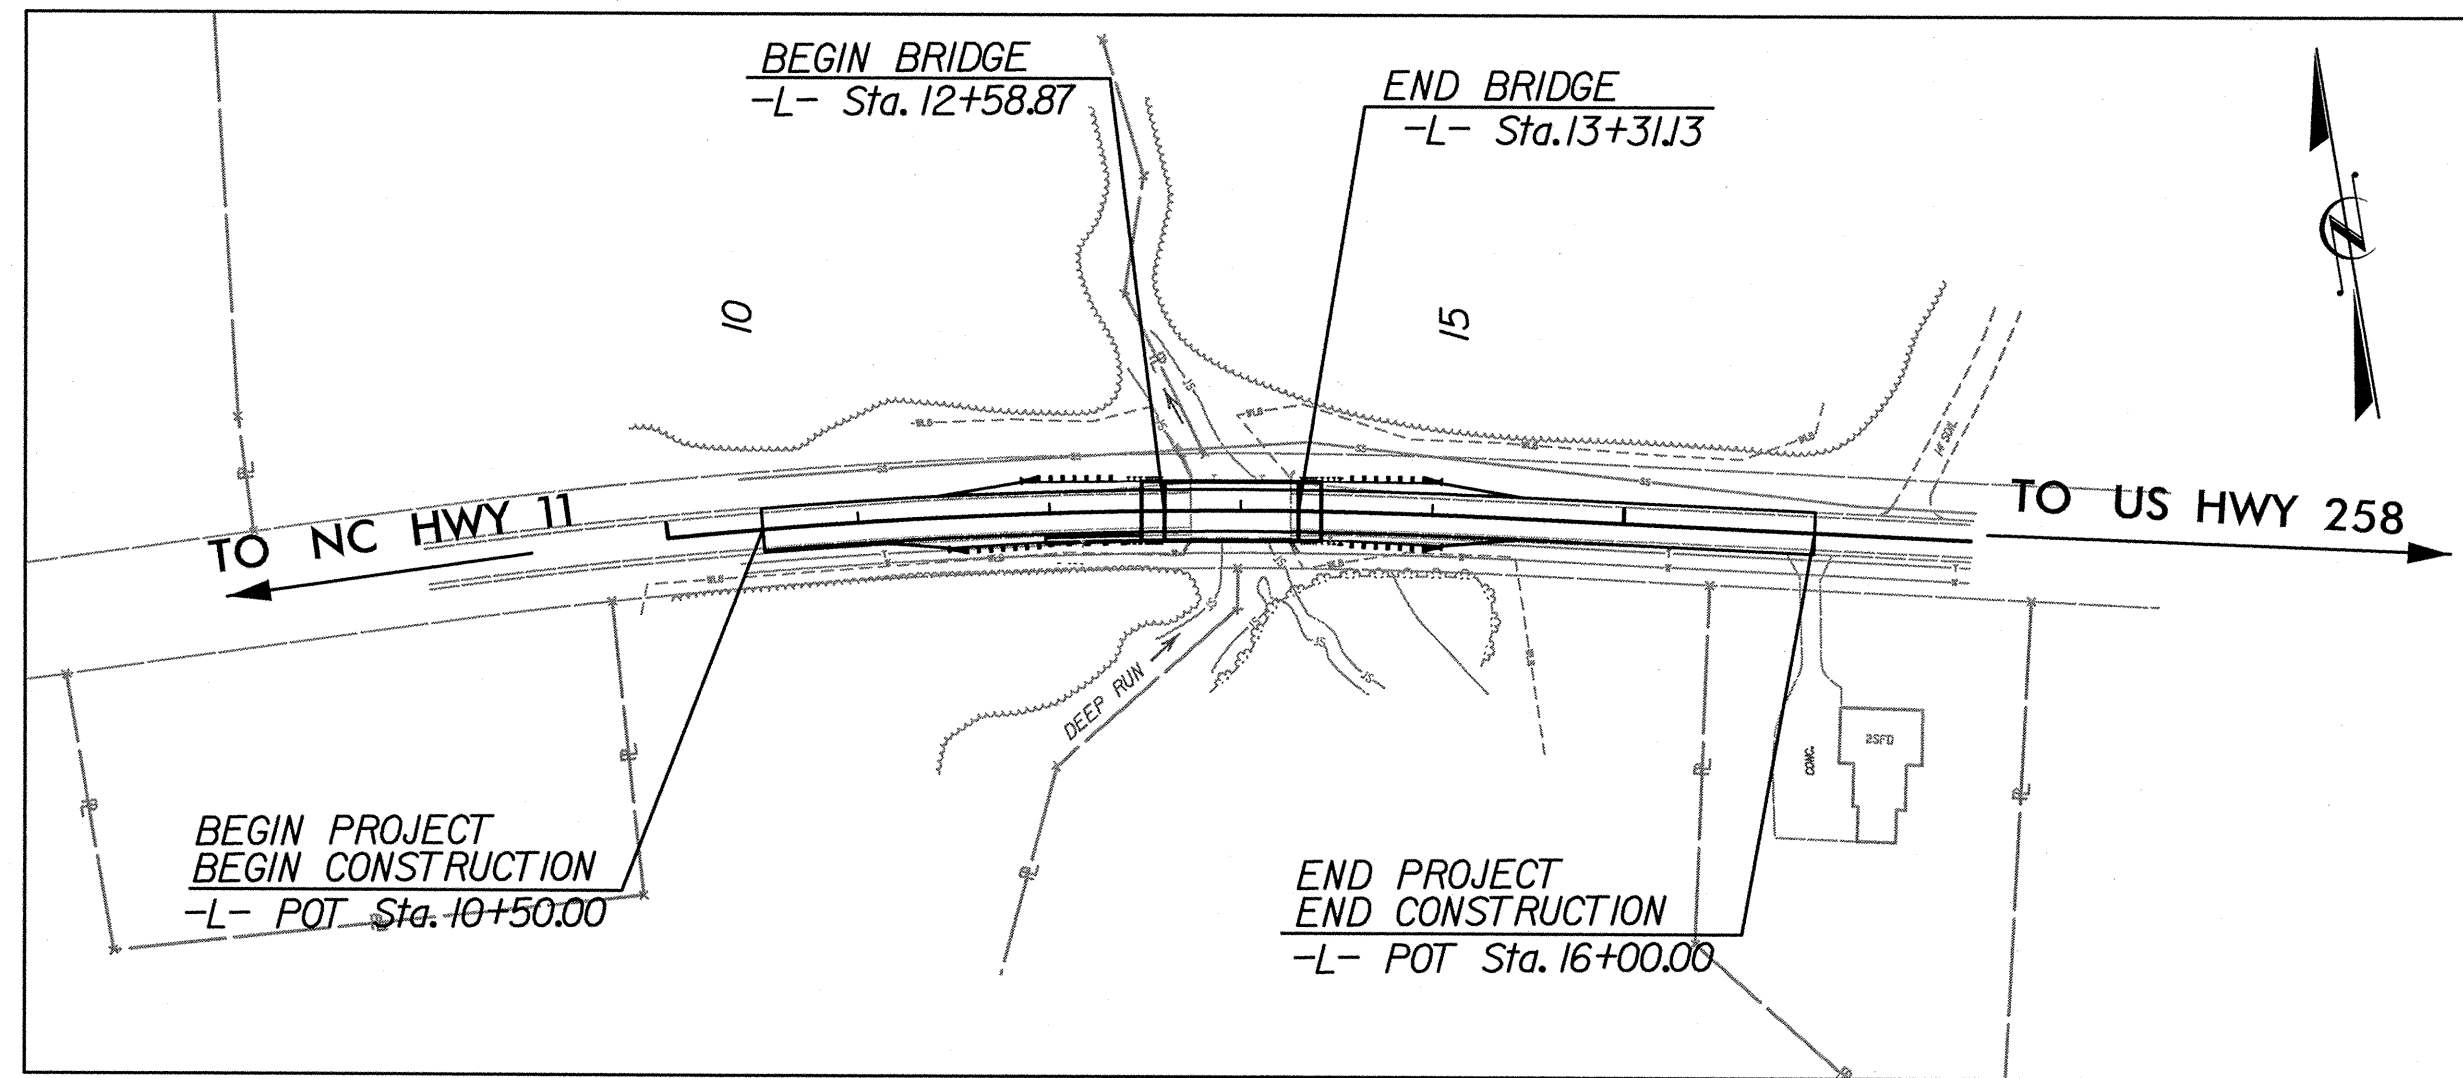

CLEARING ON THIS PROJECT SHALL BE PERFORMED TO THE LIMITS ESTABLISHED BY METHOD II.

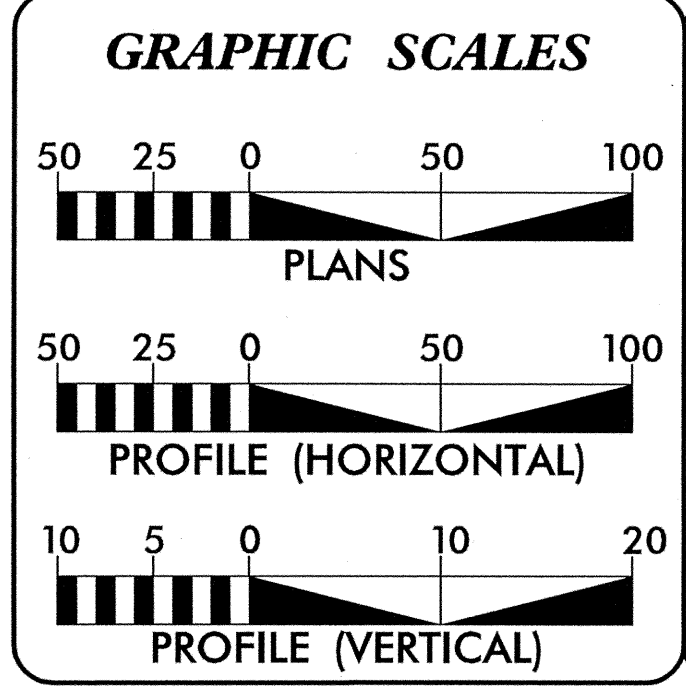

DESIGN DATA

ADT 2008 = 1200
ADT 2035 = 2400
DHV = 10%
D = 60%
T = 6% *
V = 55 MPH STATUTORY 50 MPH ADVISORY
* TTST 1% DUAL 2%

PROJECT LENGTH

LENGTH OF ROADWAY TIP PROJECT BD-5102M =	0.09 MI.
LENGTH OF STRUCTURE TIP PROJECT BD-5102M =	0.01 MI.
TOTAL LENGTH OF TIP PROJECT BD-5102M =	0.10 MI.

Prepared In the Office of:

HNTB HNTB NORTH CAROLINA, P.C.
343 E. Six Forks Road, Suite 200
Raleigh, North Carolina 27609
NC License No: C-1654

2012 STANDARD SPECIFICATIONS	ENRICO A. ROQUE, P.E. PROJECT ENGINEER
RIGHT OF WAY DATE: MAY 16, 2012	ANTHONY THOMPSON, P.E. PROJECT DESIGNER
LETTING DATE: APRIL 24, 2013	MARIA ROGERSON, P.E. NCDOT CONTACT

HYDRAULICS ENGINEER

James A. Byrd P.E.
SIGNATURE: *James A. Byrd*

ROADWAY DESIGN ENGINEER


2/11/13
Enrico A. Roque P.E.
SIGNATURE: *Enrico A. Roque*

Professional Engineer Seals for James A. Byrd (Seal 15764) and Enrico A. Roque (Seal 19824).

DIVISION OF HIGHWAYS
STATE OF NORTH CAROLINA

P.E.
STATE HIGHWAY DESIGN ENGINEER

\$\$\$\$\$DATE\$\$\$\$\$
\$\$\$\$\$SYSTEM\$\$\$\$\$
\$\$\$\$\$DRAWING\$\$\$\$\$

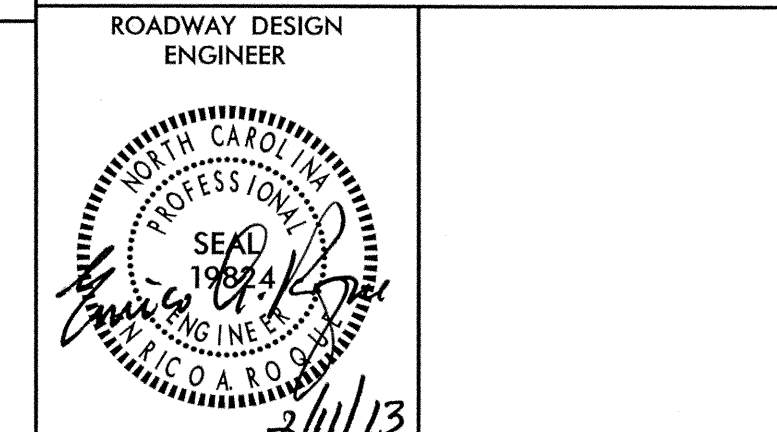

INDEX OF SHEETS

SHEET NUMBER	SHEET
1	TITLE SHEET
1-A	INDEX OF SHEETS, GENERAL NOTES & LIST OF STANDARDS
1-B	SYMBOLGY SHEET
2	TYPICAL SECTION SHEET
3	EARTHWORK, PAVEMENT REMOVAL, & GUARDRAIL SUMMARY SHEET
4	PLAN & PROFILE SHEET
TMP-1 THRU TMP-2	TRAFFIC CONTROL PLANS
EC-1	EROSION CONTROL TITLE SHEET
EC-2	EROSION CONTROL - COIR FIBER WATTLE DETAIL
EC-3	EROSION CONTROL- WATTLE / SILT FENCE BREAK DETAIL
EC-4	EROSION CONTROL - SOIL STABILIZATION TIME FRAMES
EC-5	EROSION CONTROL SHEET
P-1	PERMIT DRAWING
X-1 THRU X-4	-L- CROSS SECTION SHEETS
S-1 THRU S-13	STRUCTURE PLANS
UO-1 THRU UO-2	UTILITY PLANS BY OTHERS

GENERAL NOTES: 2012 SPECIFICATIONS
 EFFECTIVE: 01-17-12
 REVISED: 11/01/11

GRADE LINE:
 GRADING AND SURFACING:
 THE GRADE LINES SHOWN DENOTE THE FINISHED ELEVATION OF THE PROPOSED SURFACING AT GRADE POINTS SHOWN ON THE TYPICAL SECTIONS. GRADE LINES MAY BE ADJUSTED AT THEIR BEGINNING AND ENDING AND AT STRUCTURES AS DIRECTED BY THE ENGINEER IN ORDER TO SECURE A PROPER TIE-IN.

CLEARING:
 CLEARING ON THIS PROJECT SHALL BE PERFORMED TO THE LIMITS ESTABLISHED BY METHOD II.

SUPERELEVATION:
 ALL CURVES ON THIS PROJECT SHALL BE SUPERELEVATED IN ACCORDANCE WITH STD. NO. 225.04 USING THE RATE OF SUPERELEVATION AND RUNOFF SHOWN ON THE PLANS. SUPERELEVATION IS TO BE REVOLVED ABOUT THE GRADE POINTS SHOWN ON THE TYPICAL SECTIONS.

SHOULDER CONSTRUCTION:
 ASPHALT, EARTH, AND CONCRETE SHOULDER CONSTRUCTION ON THE HIGH SIDE OF SUPERELEVATED CURVES SHALL BE IN ACCORDANCE WITH STD. NO. 560.01.

GUARDRAIL:
 THE GUARDRAIL LOCATIONS SHOWN ON THE PLANS MAY BE ADJUSTED DURING CONSTRUCTION AS DIRECTED BY THE ENGINEER. THE CONTRACTOR SHOULD CONSULT WITH THE ENGINEER PRIOR TO ORDERING GUARDRAIL MATERIAL.

UTILITIES:
 UTILITY OWNERS ON THIS PROJECT ARE
 Electric - Progress Energy Co.
 Water - Deep Run Water Corp.
 Sewer - Town of Pink Hill
 Phone - Century Link
 ANY RELOCATION OF EXISTING UTILITIES WILL BE ACCOMPLISHED BY OTHERS, EXCEPT AS SHOWN ON THE PLANS.

RIGHT-OF-WAY MARKERS:
 ALL RIGHT-OF-WAY MARKERS ON THIS PROJECT SHALL BE PLACED BY OTHERS.

2012 ROADWAY ENGLISH STANDARD DRAWINGS

The following Roadway Standards as appear in "Roadway Standard Drawings" Highway Design Branch - N. C. Department of Transportation - Raleigh, N. C., Dated January, 2012 are applicable to this project and by reference hereby are considered a part of these plans:

STD.NO.	TITLE
DIVISION 2 - EARTHWORK	
200.02	Method of Clearing - Method II
225.02	Guide for Grading Subgrade - Secondary and Local
225.04	Method of Obtaining Superelevation - Two Lane Pavement
DIVISION 3 - PIPE CULVERTS	
300.01	Method of Pipe Installation
DIVISION 4 - MAJOR STRUCTURES	
422.10	Reinforced Bridge Approach Fills
DIVISION 5 - SUBGRADE, BASES AND SHOULDERS	
560.01	Method of Shoulder Construction - High Side of Superelevated Curve - Method I
DIVISION 8 - INCIDENTALS	
840.18	Concrete Grated Drop Inlet Type 'B' - 12" thru 36" Pipe
840.20	Frames and Wide Slot Flat Grates
846.01	Concrete Curb, Gutter and Curb & Gutter
846.04	Drop Inlet Installation In Shoulder Berm Gutter
862.01	Guardrail Placement
862.02	Guardrail Installation
862.03	Structure Anchor Units
876.02	Guide for Rip Rap at Pipe Outlets
876.04	Drainage Ditches with Class 'B' Rip Rap

REVISIONS

\$\$\$DATE\$\$\$\$
 \$\$\$SYTIME\$\$\$\$
 \$\$\$CDN\$\$\$\$

Note: Not to Scale

*S.U.E. = *Subsurface Utility Engineering*

STATE OF NORTH CAROLINA
DIVISION OF HIGHWAYS

CONVENTIONAL PLAN SHEET SYMBOLS

BOUNDARIES AND PROPERTY:

State Line	_____
County Line	_____
Township Line	_____
City Line	_____
Reservation Line	_____
Property Line	_____
Existing Iron Pin	_____ ○ EP _____
Property Corner	_____ × _____
Property Monument	_____ □ ECM _____
Parcel/Sequence Number	_____ (23) _____
Existing Fence Line	_____ × × × _____
Proposed Woven Wire Fence	_____ ○ _____
Proposed Chain Link Fence	_____ □ _____
Proposed Barbed Wire Fence	_____ ◆ _____
Existing Wetland Boundary	_____ - - - - - WLB _____
Proposed Wetland Boundary	_____ - - - - - WLB _____
Existing Endangered Animal Boundary	_____ - - - - - EAB _____
Existing Endangered Plant Boundary	_____ - - - - - EPB _____

BUILDINGS AND OTHER CULTURE:

Gas Pump Vent or U/G Tank Cap	_____ ○ _____
Sign	_____ ⊙ S _____
Well	_____ ⊙ W _____
Small Mine	_____ ✕ _____
Foundation	_____ □ _____
Area Outline	_____ □ _____
Cemetery	_____ ⊕ _____
Building	_____ □ _____
School	_____ □ _____
Church	_____ ⊕ _____
Dam	_____ □ _____

HYDROLOGY:

Stream or Body of Water	_____ _____
Hydro, Pool or Reservoir	_____ □ _____
Jurisdictional Stream	_____ JS _____
Buffer Zone 1	_____ BZ 1 _____
Buffer Zone 2	_____ BZ 2 _____
Flow Arrow	_____ ← _____
Disappearing Stream	_____ > _____
Spring	_____ ⊙ _____
Wetland	_____ ↓ _____
Proposed Lateral, Tail, Head Ditch	_____ > _____
False Sump	_____ □ _____

RAILROADS:

Standard Gauge	_____ [CSX TRANSPORTATION] _____
RR Signal Milepost	_____ ⊙ MILEPOST 35 _____
Switch	_____ □ SWITCH _____
RR Abandoned	_____ - - - - - _____
RR Dismantled	_____ - - - - - _____

RIGHT OF WAY:

Baseline Control Point	_____ ◆ _____
Existing Right of Way Marker	_____ △ _____
Existing Right of Way Line	_____ _____
Proposed Right of Way Line	_____ (R/W) _____
Proposed Right of Way Line with Iron Pin and Cap Marker	_____ (R/W) ▲ _____
Proposed Right of Way Line with Concrete or Granite Marker	_____ (R/W) ● _____
Existing Control of Access	_____ ⊙ _____
Proposed Control of Access	_____ ⊙ _____
Existing Easement Line	_____ - - - - - E _____
Proposed Temporary Construction Easement	_____ - - - - - E _____
Proposed Temporary Drainage Easement	_____ TDE _____
Proposed Permanent Drainage Easement	_____ PDE _____
Proposed Permanent Utility Easement	_____ PUE _____

ROADS AND RELATED FEATURES:

Existing Edge of Pavement	_____ _____
Existing Curb	_____ _____
Proposed Slope Stakes Cut	_____ C _____
Proposed Slope Stakes Fill	_____ F _____
Proposed Wheel Chair Ramp	_____ (WCR) _____
Proposed Wheel Chair Ramp Curb Cut	_____ (WCC) _____
Curb Cut for Future Wheel Chair Ramp	_____ (CCFR) _____
Existing Metal Guardrail	_____ T T T _____
Proposed Guardrail	_____ T T T _____
Existing Cable Guiderail	_____ ⊐ _____
Proposed Cable Guiderail	_____ ⊐ _____
Equality Symbol	_____ ⊕ _____
Pavement Removal	_____ ⊗ _____

VEGETATION:

Single Tree	_____ ☼ _____
Single Shrub	_____ ✻ _____
Hedge	_____ ~~~~~ _____
Woods Line	_____ ~~~~~ _____
Orchard	_____ ☼ ☼ ☼ _____
Vineyard	_____ [Vineyard] _____

EXISTING STRUCTURES:

MAJOR:	_____
Bridge, Tunnel or Box Culvert	_____ [CONC] _____
Bridge Wing Wall, Head Wall and End Wall	_____ } [CONC WW] { _____
MINOR:	_____
Head and End Wall	_____ [CONC HW] _____
Pipe Culvert	_____ _____
Footbridge	_____ > _____ < _____
Drainage Box: Catch Basin, DI or JB	_____ □ CB _____
Paved Ditch Gutter	_____ - - - - - _____
Storm Sewer Manhole	_____ ⊙ _____
Storm Sewer	_____ S _____

UTILITIES:

POWER:	_____
Existing Power Pole	_____ ● _____
Proposed Power Pole	_____ ⊙ _____
Existing Joint Use Pole	_____ ● _____
Proposed Joint Use Pole	_____ ⊙ _____
Power Manhole	_____ ⊙ _____
Power Line Tower	_____ ⊗ _____
Power Transformer	_____ ⊓ _____
U/G Power Cable Hand Hole	_____ ⊓ _____
H-Frame Pole	_____ ● ● _____
Recorded U/G Power Line	_____ P _____
Designated U/G Power Line (S.U.E.*)	_____ - - - - - P _____

TELEPHONE:

Existing Telephone Pole	_____ ● _____
Proposed Telephone Pole	_____ ⊙ _____
Telephone Manhole	_____ ⊙ _____
Telephone Booth	_____ ⊓ _____
Telephone Pedestal	_____ ⊓ _____
Telephone Cell Tower	_____ ⊓ _____
U/G Telephone Cable Hand Hole	_____ ⊓ _____
Recorded U/G Telephone Cable	_____ T _____
Designated U/G Telephone Cable (S.U.E.*)	_____ - - - - - T _____
Recorded U/G Telephone Conduit	_____ TC _____
Designated U/G Telephone Conduit (S.U.E.*)	_____ - - - - - TC _____
Recorded U/G Fiber Optics Cable	_____ T FO _____
Designated U/G Fiber Optics Cable (S.U.E.*)	_____ - - - - - T FO _____

WATER:

Water Manhole	_____ ⊙ _____
Water Meter	_____ ⊙ _____
Water Valve	_____ ⊗ _____
Water Hydrant	_____ ⊕ _____
Recorded U/G Water Line	_____ W _____
Designated U/G Water Line (S.U.E.*)	_____ - - - - - W _____
Above Ground Water Line	_____ A/G Water _____

TV:

TV Satellite Dish	_____ ↙ _____
TV Pedestal	_____ ⊓ _____
TV Tower	_____ ⊗ _____
U/G TV Cable Hand Hole	_____ ⊓ _____
Recorded U/G TV Cable	_____ TV _____
Designated U/G TV Cable (S.U.E.*)	_____ - - - - - TV _____
Recorded U/G Fiber Optic Cable	_____ TV FO _____
Designated U/G Fiber Optic Cable (S.U.E.*)	_____ - - - - - TV FO _____

GAS:

Gas Valve	_____ ◆ _____
Gas Meter	_____ ⊕ _____
Recorded U/G Gas Line	_____ G _____
Designated U/G Gas Line (S.U.E.*)	_____ - - - - - G _____
Above Ground Gas Line	_____ A/G Gas _____

SANITARY SEWER:


Sanitary Sewer Manhole	_____ ⊕ _____
Sanitary Sewer Cleanout	_____ ⊕ _____
U/G Sanitary Sewer Line	_____ SS _____
Above Ground Sanitary Sewer	_____ A/G Sanitary Sewer _____
Recorded SS Forced Main Line	_____ FSS _____
Designated SS Forced Main Line (S.U.E.*)	_____ - - - - - FSS _____

MISCELLANEOUS:


Utility Pole	_____ ● _____
Utility Pole with Base	_____ ⊓ _____
Utility Located Object	_____ ○ _____
Utility Traffic Signal Box	_____ ⊓ _____
Utility Unknown U/G Line	_____ ?U/L _____
U/G Tank; Water, Gas, Oil	_____ □ _____
A/G Tank; Water, Gas, Oil	_____ □ _____
U/G Test Hole (S.U.E.*)	_____ ⊕ _____
Abandoned According to Utility Records	_____ AATUR _____
End of Information	_____ E.O.I. _____

PAVEMENT SCHEDULE	
C1	PROP. APPROX. 3.0" ASPHALT CONCRETE SURFACE COURSE, TYPE SF9.5A, AT AN AVERAGE RATE OF 165 LBS. PER SQ. YARD IN EACH OF TWO LAYERS.
C2	PROP. APPROX. 3.75" ASPHALT CONCRETE SURFACE COURSE, TYPE SF9.5A, AT AN AVERAGE RATE OF 206.25 LBS. PER SQ. YARD IN EACH OF TWO LAYERS.
D	PROP. APPROX. 2.5" ASPHALT CONCRETE INTERMEDIATE COURSE, TYPE I19.0B, AT AN AVERAGE RATE OF 285 LBS. PER SQ. YD.
D1	PROP. VAR. DEPTH ASPHALT CONCRETE INTERMEDIATE COURSE, TYPE I19.0B, AT AN AVERAGE RATE OF 114 LBS. PER SQ. YD. PER 1" DEPTH, TO BE PLACED IN LAYERS NOT LESS THAN 2 1/2" IN DEPTH OR GREATER THAN 4" IN DEPTH.
E	PROP. APPROX. 4" ASPHALT CONCRETE BASE COURSE, TYPE B25.0B, AT AN AVERAGE RATE OF 456 LBS. PER SQ. YARD.
E1	PROP. VARIABLE DEPTH ASPHALT CONCRETE BASE COURSE, TYPE B25.0B, AT AN AVERAGE RATE OF 114 LBS. PER SQ. YARD PER INCH DEPTH, TO BE PLACED IN LAYERS NOT GREATER THAN 5.5" IN DEPTH OR LESS THAN 3" IN DEPTH.
T	EARTH MATERIAL
U	EXISTING PAVEMENT
W	WEDGING (SEE DETAIL)


ALL PAVEMENT EDGE SLOPES ARE 1:1 UNLESS SHOWN OTHERWISE

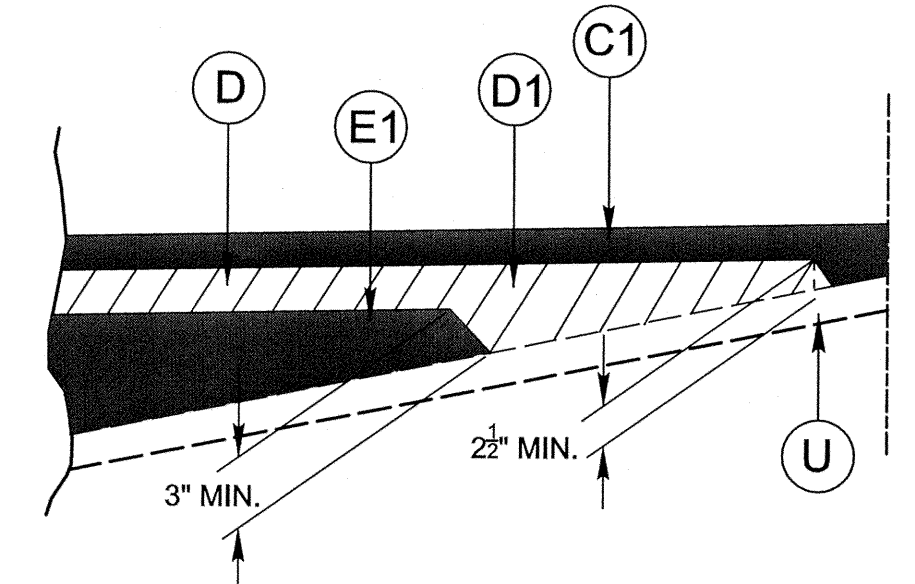

DETAIL SHOWING METHOD OF WEDGING
SEE TYPICAL SECTIONS

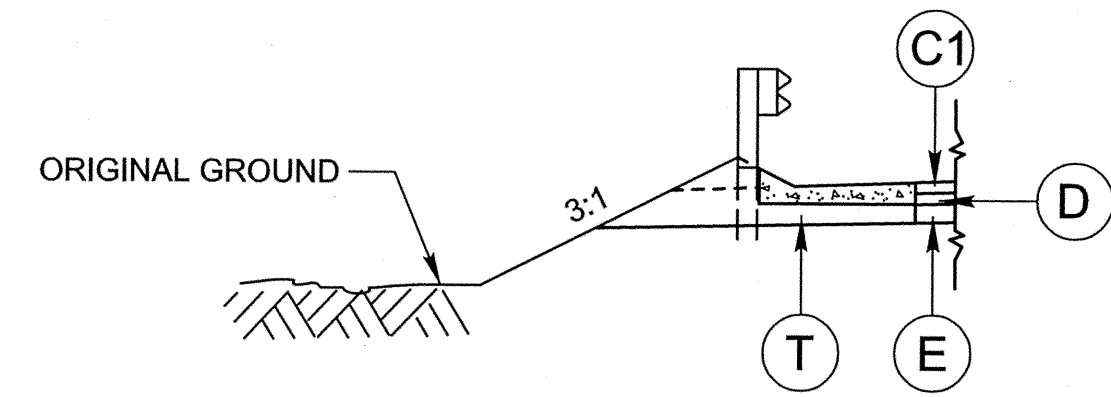


DETAIL A
SHOULDER BERM GUTTER LOCATIONS
-L- STA. 11+97.9 TO -L- STA. 12+47.9 RT

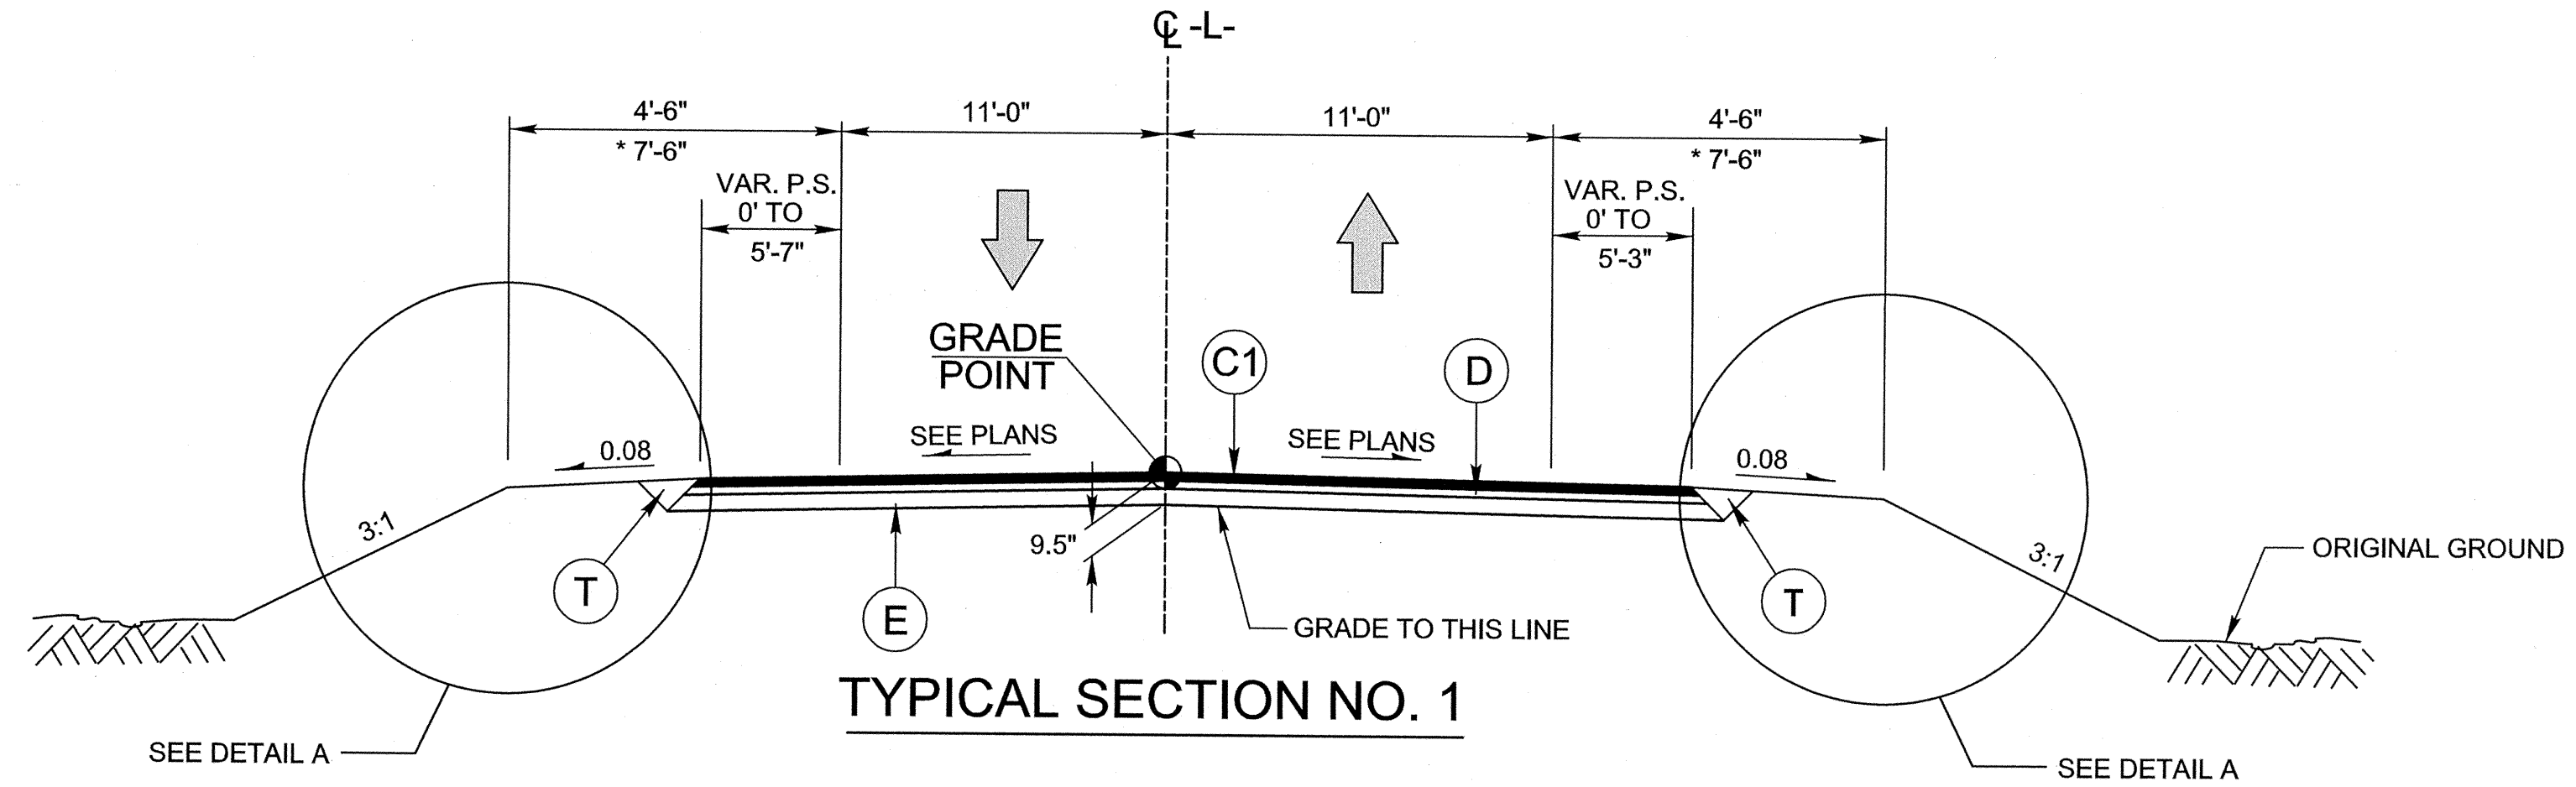


TYPICAL SECTION NO. 1

USE TYPICAL SECTION NO. 1 FROM:
 -L- STA. 11+50.00 TO -L- STA. 12+58.87 +/- (BEGIN BRIDGE)
 -L- STA. 13+31.13 +/- (END BRIDGE) TO -L- STA. 14+75.00

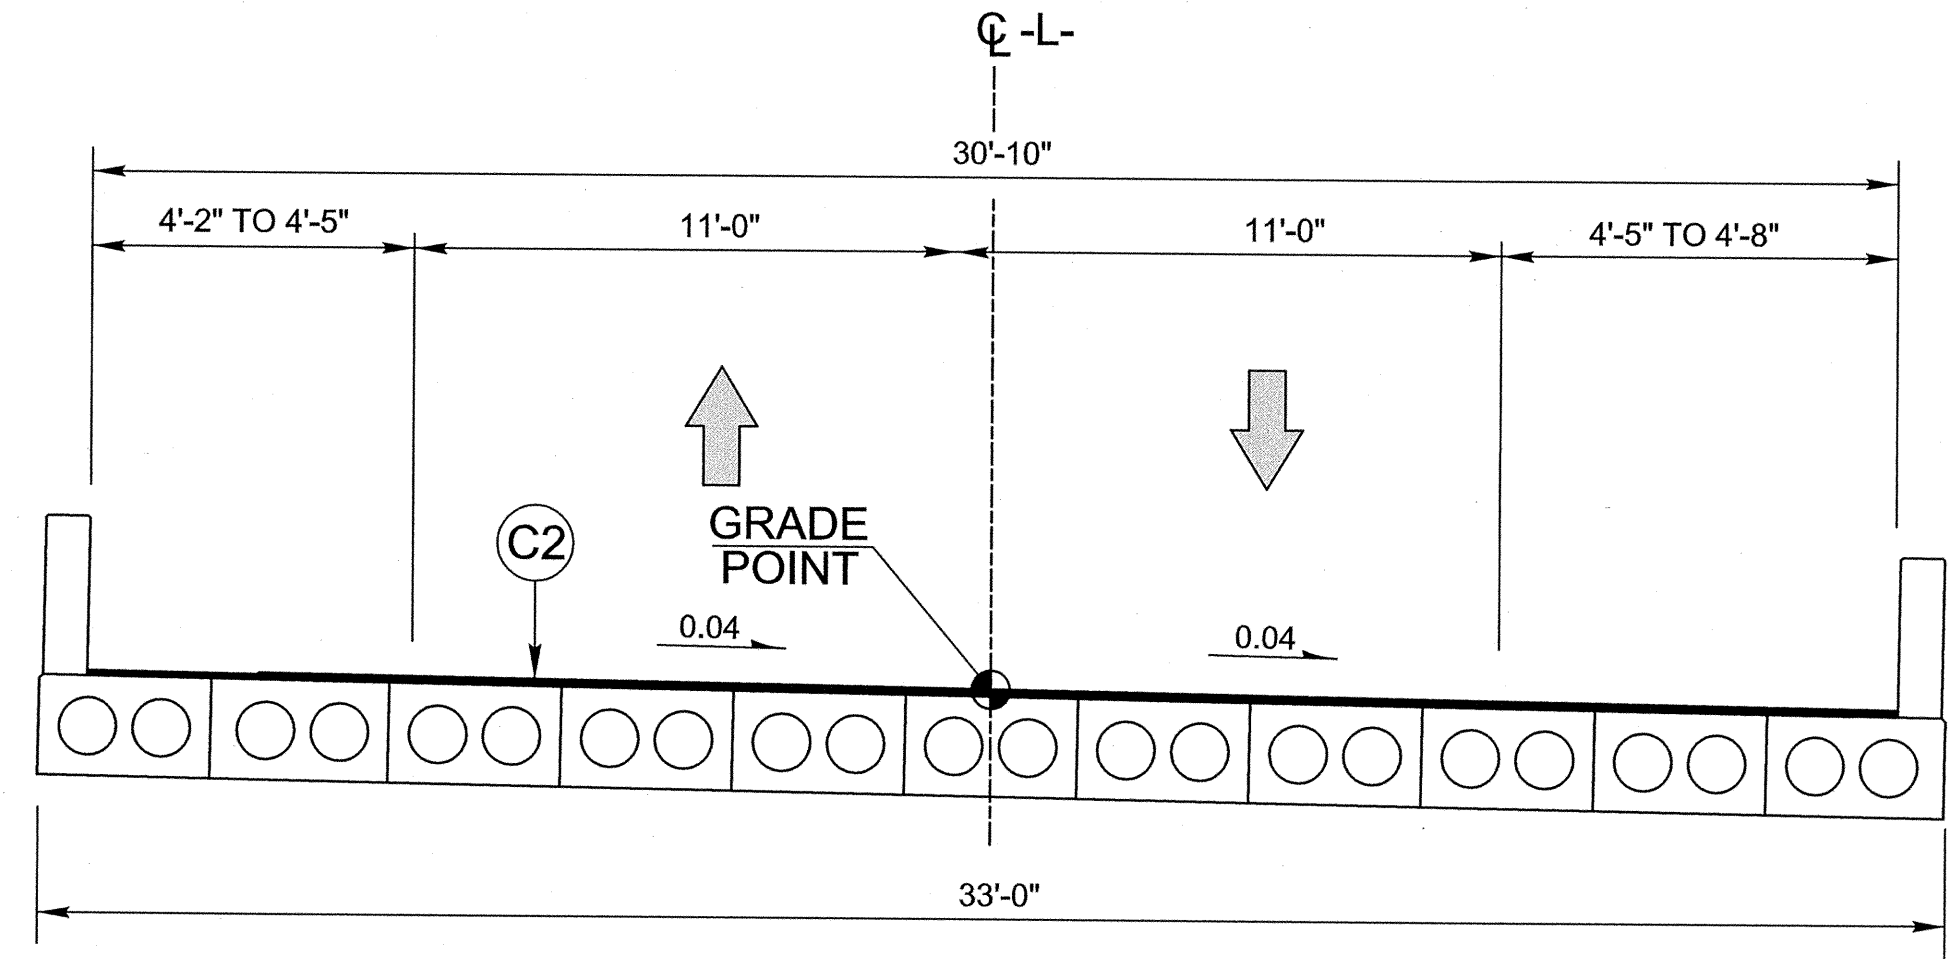

TYPICAL SECTION NO. 2
CORED SLAB BRIDGE OVERLAY

USE TYPICAL SECTION NO. 2 FROM:
 -L- STA. 12+58.87 +/- TO -L- STA. 13+31.13

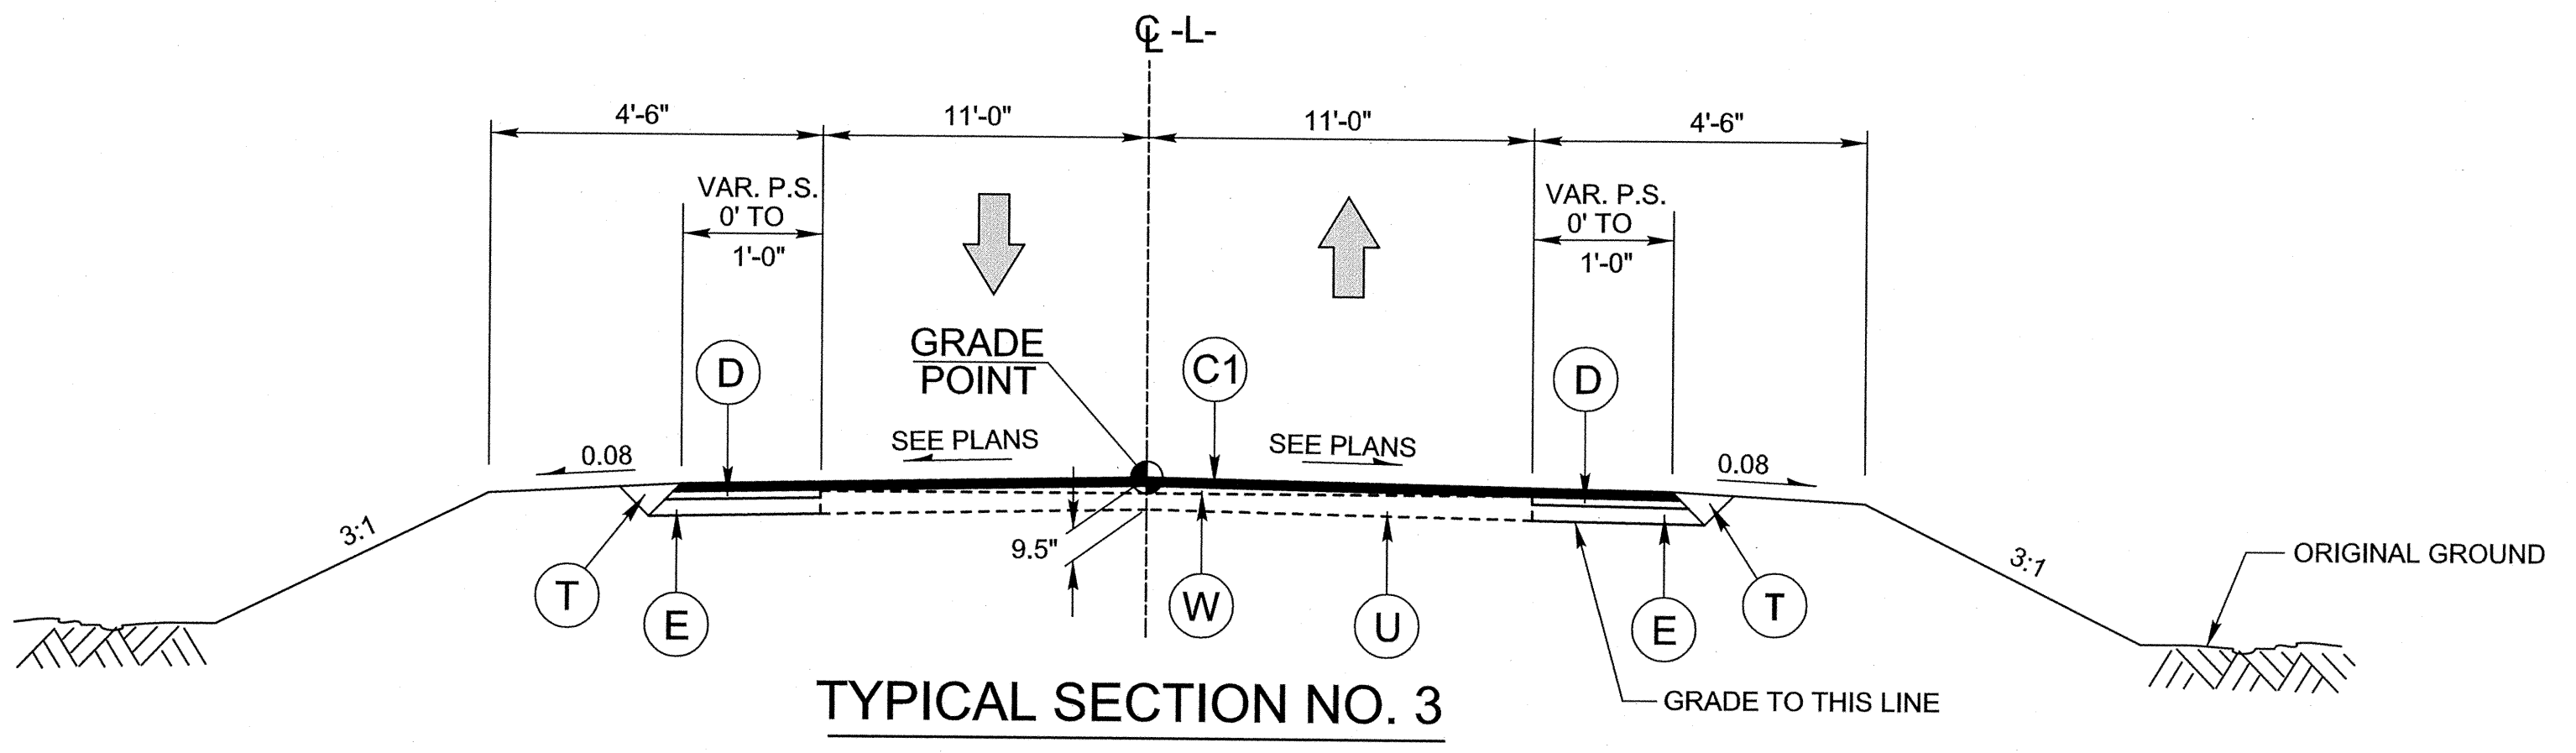

TYPICAL SECTION NO. 3

USE TYPICAL SECTION NO. 3 FROM:
 -L- STA. 10+50.00 TO -L- STA. 11+50.00
 -L- STA. 14+75.00 TO -L- STA. 16+00.00

* SHOULDER WIDTH INCREASED 3' WITH THE USE OF GUARDRAIL

REVISIONS

\$\$\$\$DATE\$\$\$\$
 \$\$\$SYTIME\$\$\$
 \$\$\$DESIGNER\$\$\$
 \$\$\$CHECKER\$\$\$
 \$\$\$APPROVER\$\$\$



ROW AREA DATA SUMMARY

PARCEL NO.	PROPERTY OWNERS NAMES	TOTAL ACREAGE	AREA TAKEN (SQFT)	AREA REMAINING RT.	AREA REMAINING LT.	CONST. EASE.	PERM. DRAIN. EASE.	TEMP. DRAIN. EASE.
1	MARY RUTH DAVIS HARPER	-	1820.6					
2	CLARENCE LEE KENNEDY	-	1134.9					

**SUMMARY OF EARTHWORK
IN CUBIC YARDS**

STATION	STATION	UNCLASSIFIED EXCAVATION	EMBANK. +%	BORROW	WASTE
-L- STA. 10+50.00	-L- STA. 12+73.00	103	282	179	
-L- STA. 13+25.00	-L- STA. 16+00.00	106	388	282	
GRAND TOTALS:		209	670	461	
SAY:		210	670	465	

DRAINAGE SUMMARY

STATION	LOCATION (LT, RT, OR CL)	STRUCTURE NO.	TOP ELEVATION	INVERT ELEVATION	INVERT ELEVATION	SLOPE CRITICAL	CLASS IV R.C. PIPE (UNLESS NOTED OTHERWISE)			QUANTITIES FOR DRAINAGE STRUCTURES			SIDE DRAIN PIPE	REMARKS			
							15"	18"	24"	PER EACH (0 THRU 5.0')	A	B			15"	18"	24"
							5.0' THRU 10.0'	10.0' AND ABOVE	5.0' THRU 10.0'								
-L- 12+37.73	RT	0401	79.53						1				1	1			
-L- 12+00.00	RT	0402	79.10						1				1	1			
-L- 12+18.87	RT	0401	0402	76.50	75.10	36											
-L- 12+00.00	RT	0402	OUT	75.10	74.66	16											
TOTAL							52			2			2	2			

**PAVEMENT REMOVAL SUMMARY
IN SQUARE YARDS**

LOCATION	REMOVAL OF ASPHALT PAVEMENT	BREAKING OF ASPHALT PAVEMENT
-L- STA. 10+50 TO 12+74	600	
-L- STA. 13+26 TO 16+00	708	
GRAND TOTAL	1308	
SAY	1310	

GUARDRAIL SUMMARY

SURVEY LINE	BEG. STA.	END STA.	LOCATION	LENGTH			WARRANT POINT		"N" DIST. FROM E.O.L.	TOTAL SHOULDER WIDTH	FLARE LENGTH		W		ANCHORS								IMPACT ATTENUATOR TYPE 350			SINGLE FACED GUARDRAIL	REMOVE EXISTING GUARDRAIL	REMOVE AND STOCKPILE EXISTING GUARDRAIL	REMARKS	
				STRAIGHT	SHOP CURVED	DOUBLE FACED	APPROACH END	TRAILING END			APPROACH END	TRAILING END	APPROACH END	TRAILING END	XI MOD	XI	GRAU 350	TYPE 350 (TL-3)	XIII	CAT-1	III	BIC	AT-1	EA	G					NG
				-L-	11+45.54	12+58.65	RT	112.5					12+58.65		3	6	50		1						1					
-L-	11+84.10	12+59.10	LT	75.0				12+59.10	3	6		50		1					1											
-L-	13+31.30	14+06.74	RT	75.0				13+31.30	3	6		50		1					1											
-L-	13+30.95	14+05.50	LT	75.0			13+30.95		3	6	50		1						1											
LESS ANCHOR DEDUCTIONS																														
				TYPE 350, TL-3	4 @ 50.00'	=	200.00																							
				TYPE III	4 @ 18.75'	=	75.00																							
TOTAL							62.5												4											
SAY							75																							
(5 ADDITIONAL GUARDRAIL POST)																														


REVISIONS

\$\$\$DATE\$\$\$
 \$\$\$SYTIME\$\$\$
 \$\$\$SDCN\$\$\$

PLAN

CENTERLINE COORDINATE LIST

POINT	STATION	NORTHING	EASTING
PC	10+00.00	508,813.6327	2,390,386.1197
BEGIN	10+50.00	508,809.9597	2,390,435.9839
PT	14+23.82	508,754.5285	2,390,805.3949
END	16+00.00	508,716.8626	2,390,977.4992
POT	16+81.50	508,699.4387	2,391,057.1128

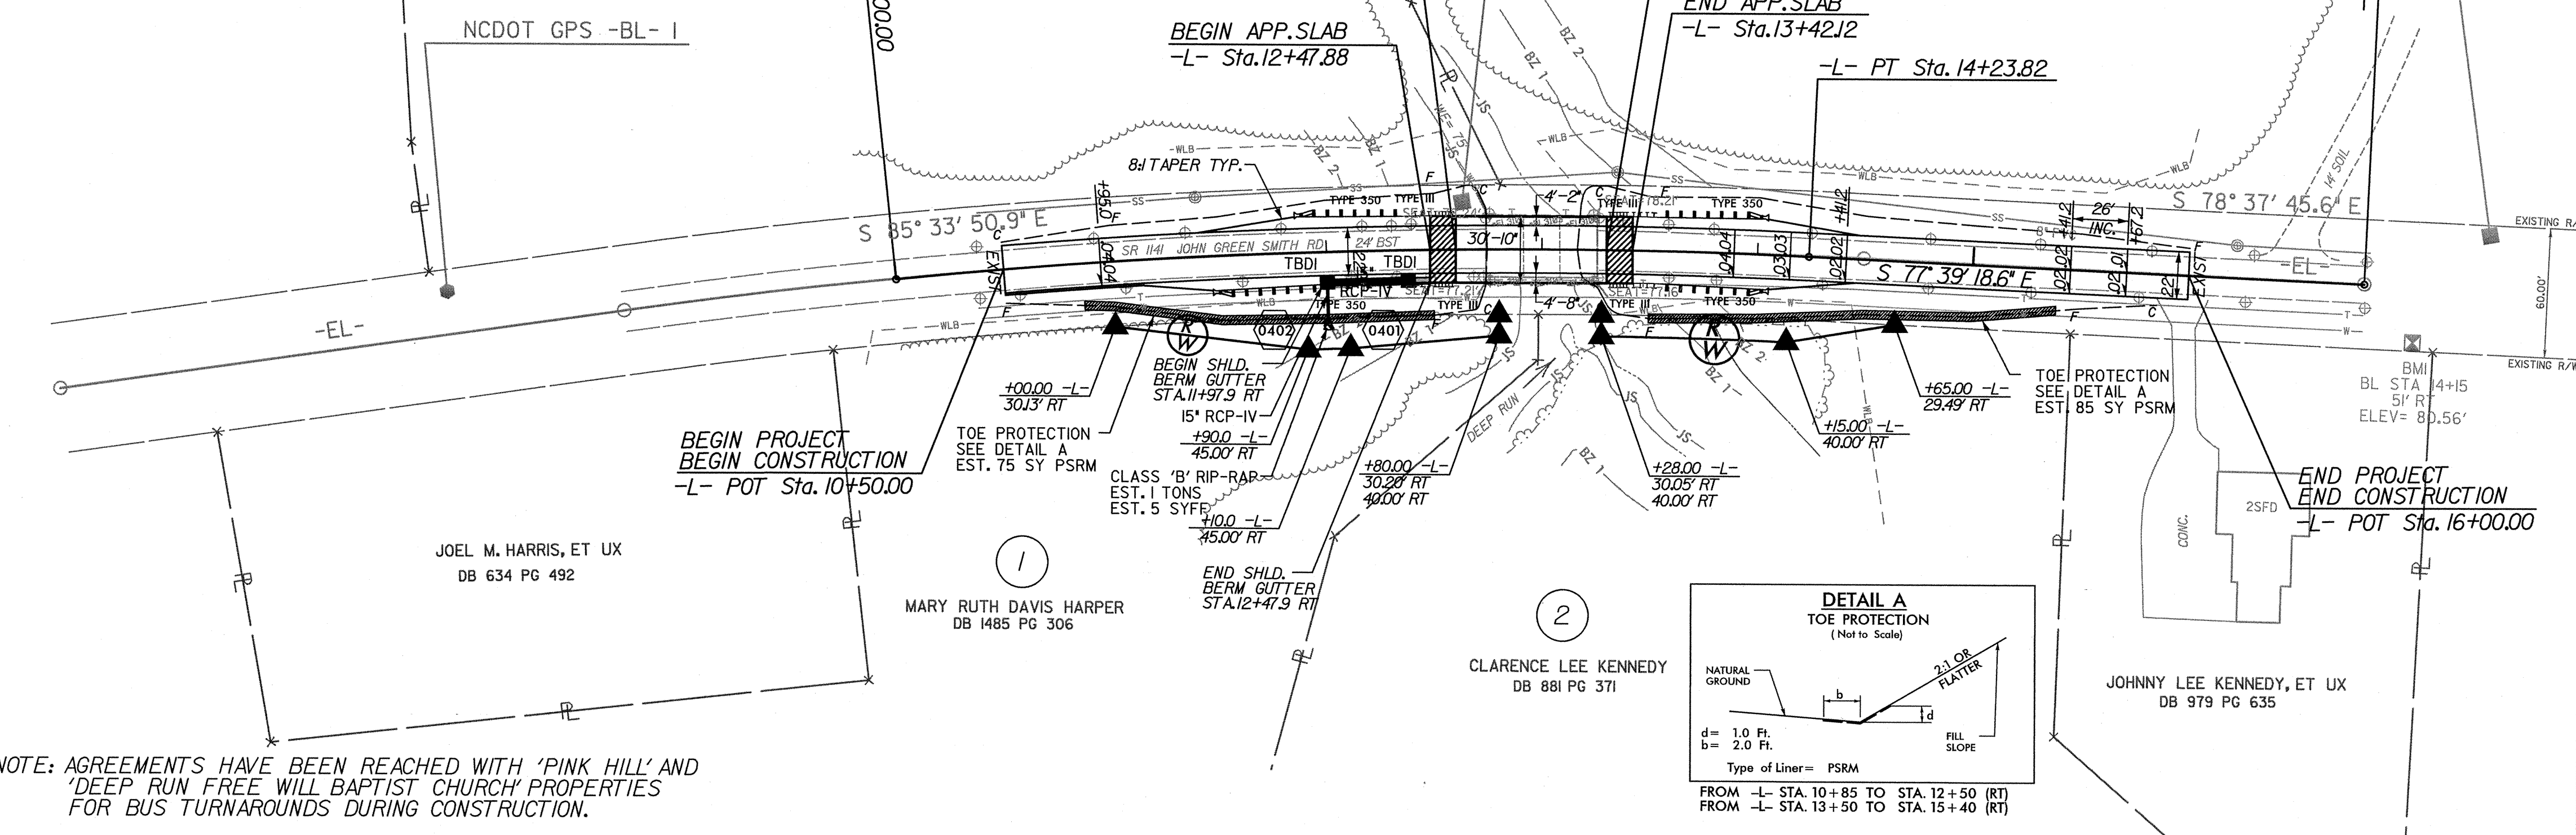

Point	North	East	Elevation
BL1	508,842.6110	2,390,180.1540	77.4300
BL2	508,806.0868	2,390,650.9745	77.7600
BL3	508,712.0880	2,391,118.3912	81.1400

DATUM DESCRIPTION

THE LOCALIZED COORDINATE SYSTEM DEVELOPED FOR THIS PROJECT IS BASED ON THE STATE PLANE COORDINATES ESTABLISHED BY NCDOT FOR MONUMENT "BL-1" WITH NAD 83/NSRS 2007 STATE PLANE GRID COORDINATES OF NORTHING: 508842.6111(FT) EASTING: 2390180.154(FT) ELEVATION: 77.430(FT)


THE AVERAGE COMBINED GRID FACTOR USED ON THIS PROJECT (GROUND TO GRID) IS: 0.999876400

THE N.C. LAMBERT GRID BEARING AND LOCALIZED HORIZONTAL GROUND DISTANCE FROM "BL-1" TO -L- 10+00.00 STATION IS S 81° 59' 29.85" W 208.0257 (FT)

ALL LINEAR DIMENSIONS ARE LOCALIZED HORIZONTAL DISTANCES

VERTICAL DATUM USED IS NAVD 88

PROFILE

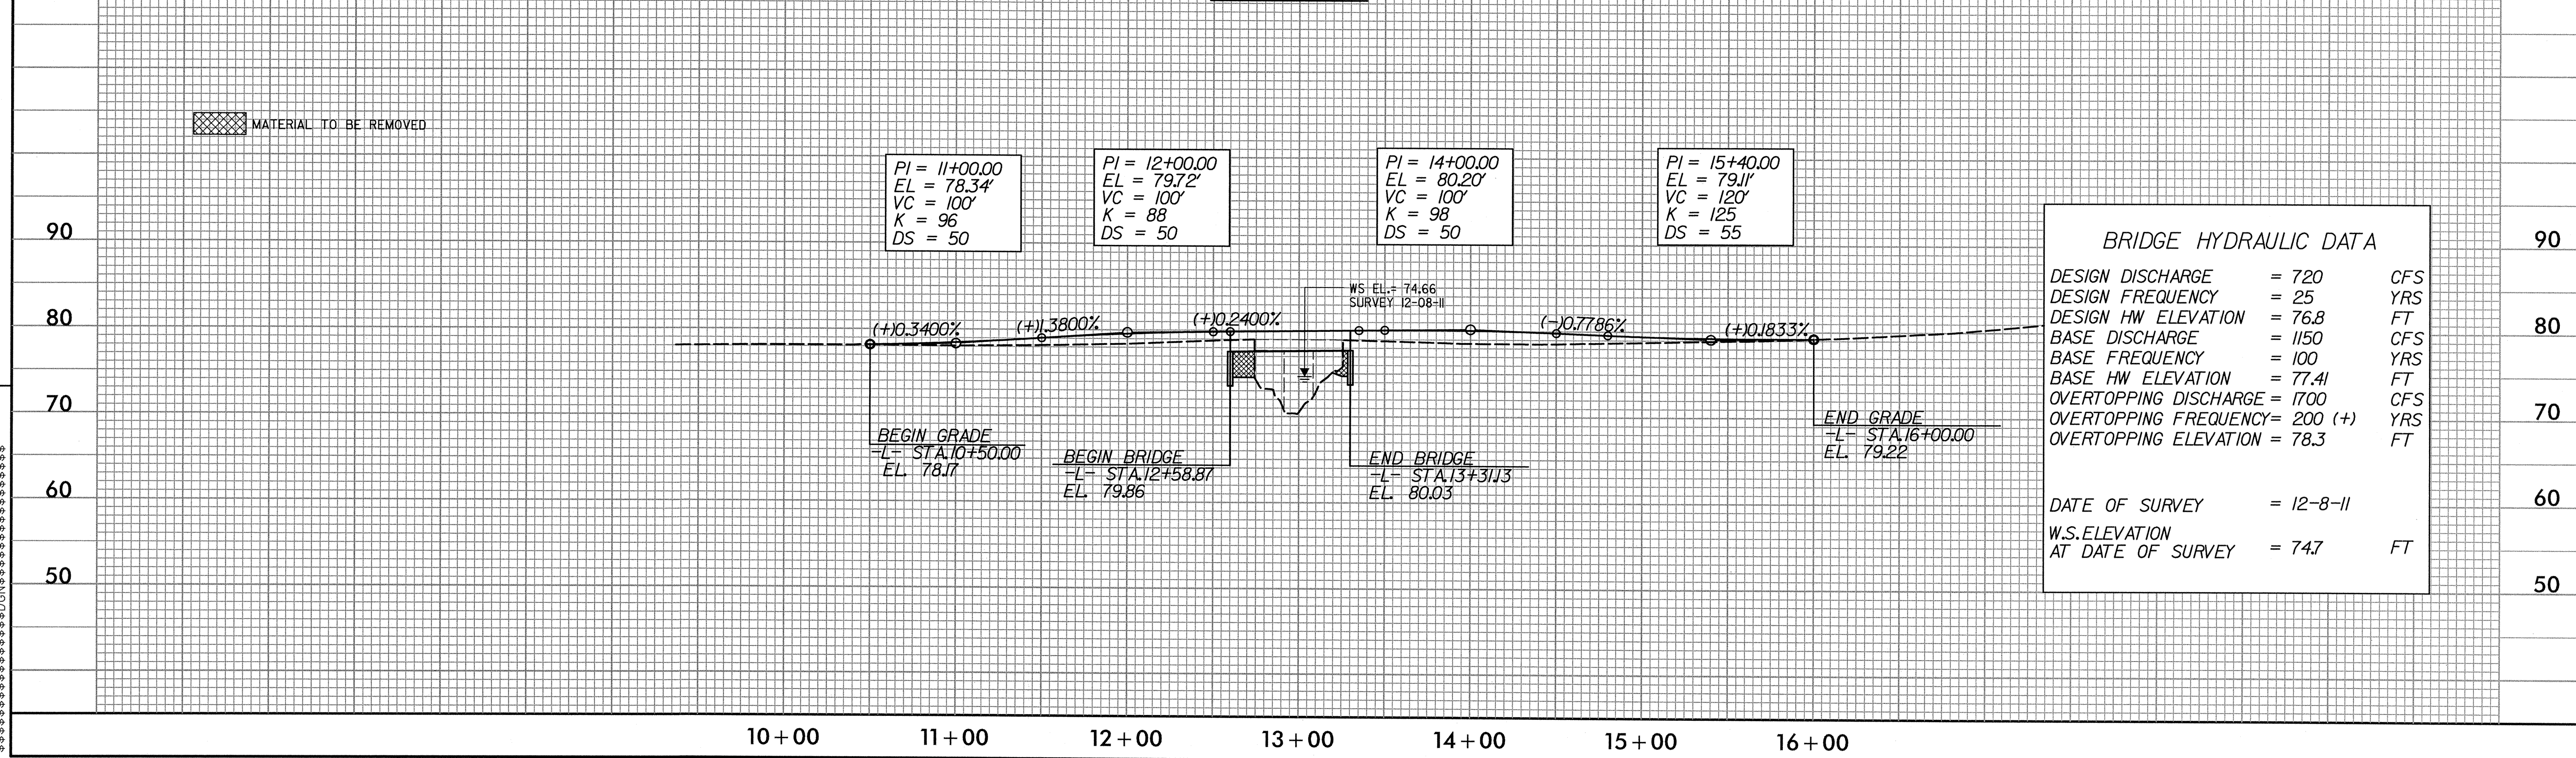


REVISIONS

DATE TIME SYSTEM

STATE OF NORTH CAROLINA
DIVISION OF HIGHWAYS

TRANSPORTATION MANAGEMENT PLAN

LENOIR COUNTY

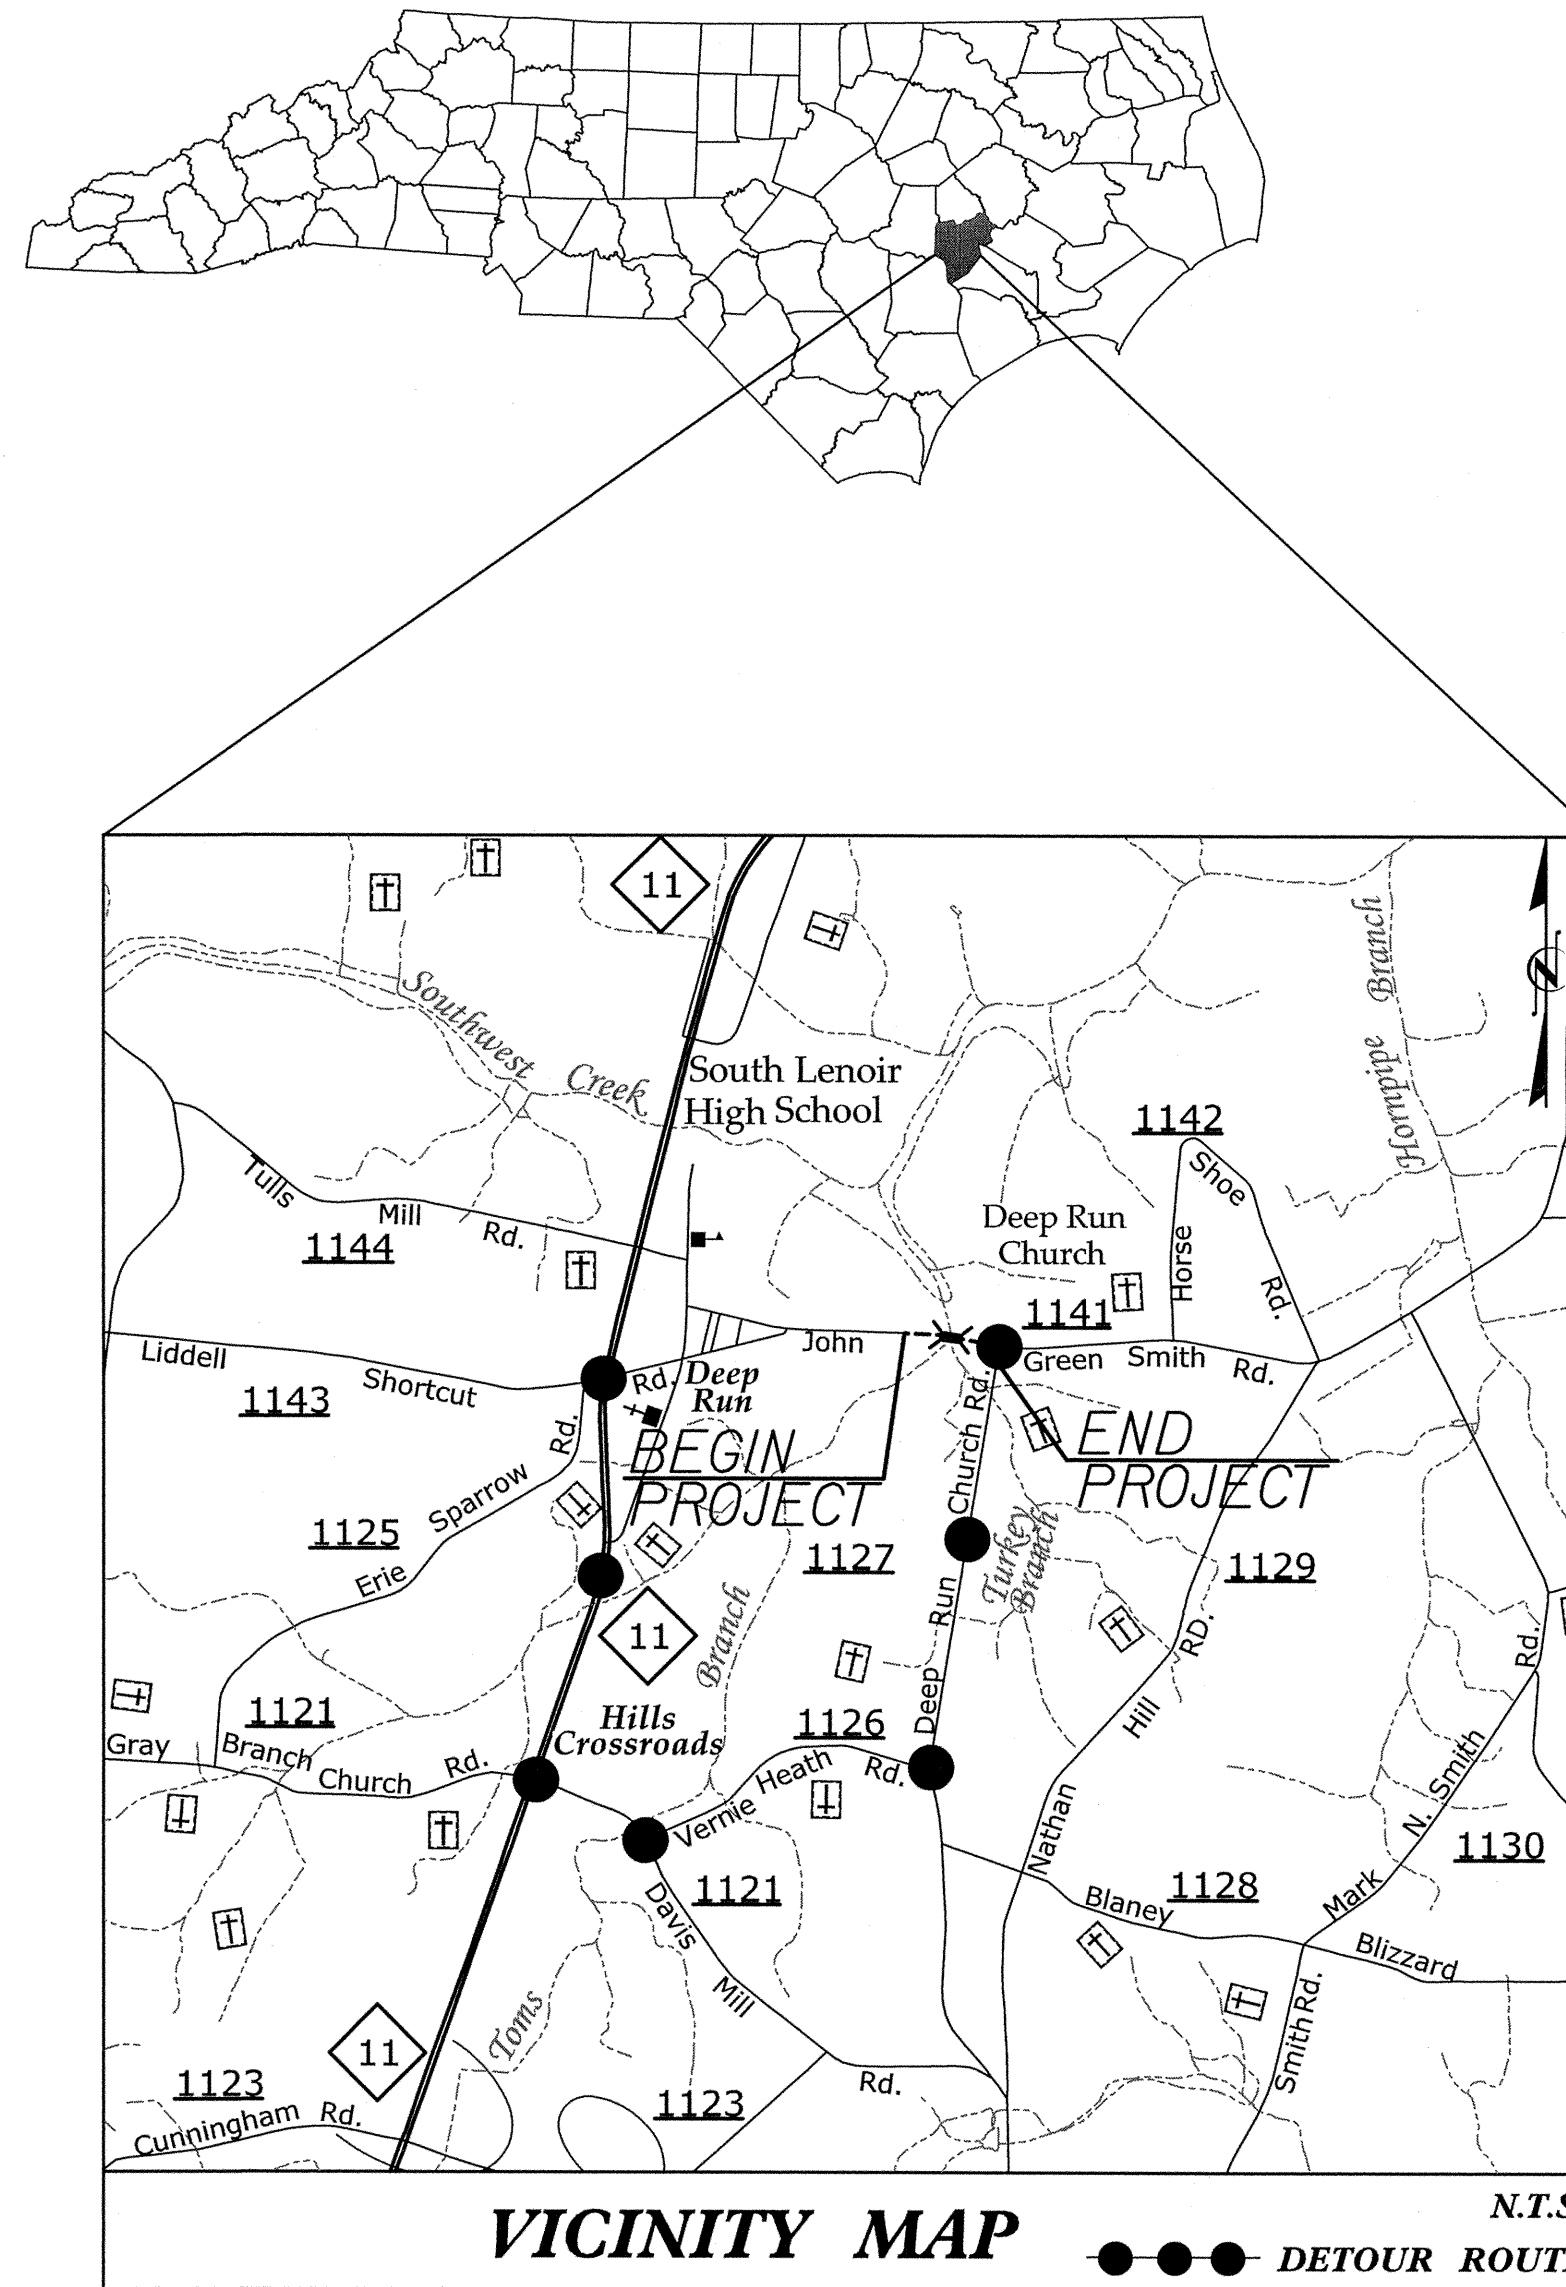

INDEX OF SHEETS

SHEET NO.	TITLE
TMP-1	TITLE SHEET WITH VICINITY MAP & INDEX OF SHEETS, LIST OF APPLICABLE ROADWAY STANDARD DRAWINGS, AND LEGEND
TMP-2	PROJECT NOTES, DETOUR AND PLANS.

ROADWAY STANDARD DRAWINGS

THE FOLLOWING ROADWAY STANDARDS AS SHOWN IN "ROADWAY STANDARD DRAWINGS" PROJECT SERVICES UNIT - N.C. DEPARTMENT OF TRANSPORTATION - RALEIGH, N.C. DATED JAN 2012 ARE APPLICABLE TO THIS PROJECT AND BY REFERENCE HEREBY ARE CONSIDERED A PART OF THESE PLANS:

STD. NO.	TITLE
1101.01	WORK ZONE ADVANCED WARNING SIGNS
1101.02	TEMPORARY LANE CLOSURES
1101.11	TRAFFIC CONTROL DESIGN TABLES
1110.11	STATIONARY WORK ZONE SIGNS
1145.01	BARRICADES
1150.01	FLAGGING DEVICES

LEGEND

GENERAL

- DIRECTION OF TRAFFIC FLOW
- DIRECTION OF PEDESTRIAN TRAFFIC FLOW
- EXIST. PVMT.
- NORTH ARROW
- PROPOSED PVMT.
- WORK AREA

TRAFFIC CONTROL DEVICES


- BARRICADE (TYPE III)

HNTB HNTB NORTH CAROLINA, P.C.
343 E. Six Forks Road, Suite 200
Raleigh, North Carolina 27609
NC License No: C-1554

R. B. EARLY, PE **TRAFFIC CONTROL PROJECT ENGINEER**
R. B. EARLY, PE **TRAFFIC CONTROL PROJECT DESIGN ENGINEER**
J. A. PHILLIPS **TRAFFIC CONTROL DESIGN ENGINEER**


APPROVED:
DATE: 8.28.12

SEAL

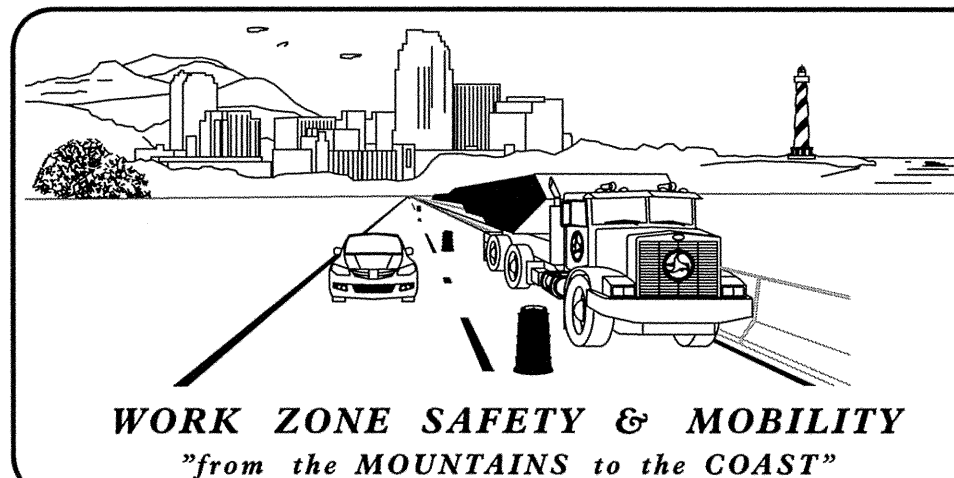

N.C.D.O.T. WORK ZONE TRAFFIC CONTROL
1561 MAIL SERVICE CENTER (MSC) RALEIGH, NC 27699-1561
750 N. GREENFIELD PARKWAY, GARNER, NC 27529 (DELIVERY)
PHONE: (919) 773-2800 FAX: (919) 771-2745

STEVEN HAMILTON, PE **DIVISION TRAFFIC ENGINEER**

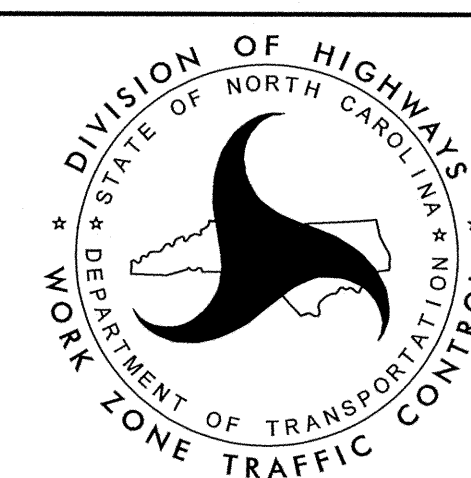

SHEET NO.

TMP-1

BD-5102M

TIP PROJECT:


SYSTEMS AND USER NAME

GENERAL NOTES


IMPLEMENT TRAFFIC CONTROL IN ACCORDANCE WITH THE ROADWAY STANDARD DRAWINGS LISTED ON TMP-1.

CHANGES MAY BE REQUIRED WHEN PHYSICAL DIMENSIONS IN THE DETAIL DRAWINGS, STANDARD DETAILS AND ROADWAY DETAILS ARE NOT ATTAINABLE TO MEET FIELD CONDITIONS, OR RESULT IN DUPLICATE, OR UNDESIRED OVERLAPPING, OF DEVICES. MODIFICATIONS MAY INCLUDE: MOVING, SUPPLEMENTING, COVERING OR REMOVAL OF DEVICES, AS DIRECTED BY THE ENGINEER.


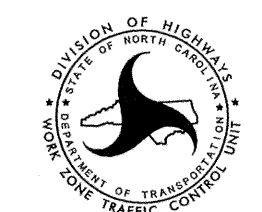
STATE FORCES WILL INSTALL AND MAINTAIN THE PROJECT DETOUR AND THE TYPE III BARRICADES AT THE PROJECT LIMITS.
 STATE FORCES WILL INSTALL PAINT AND MARKERS ON THE FINISHED PROJECT.
 CALL JIM EVANS AT 252-830-3493 FOR COORDINATION.

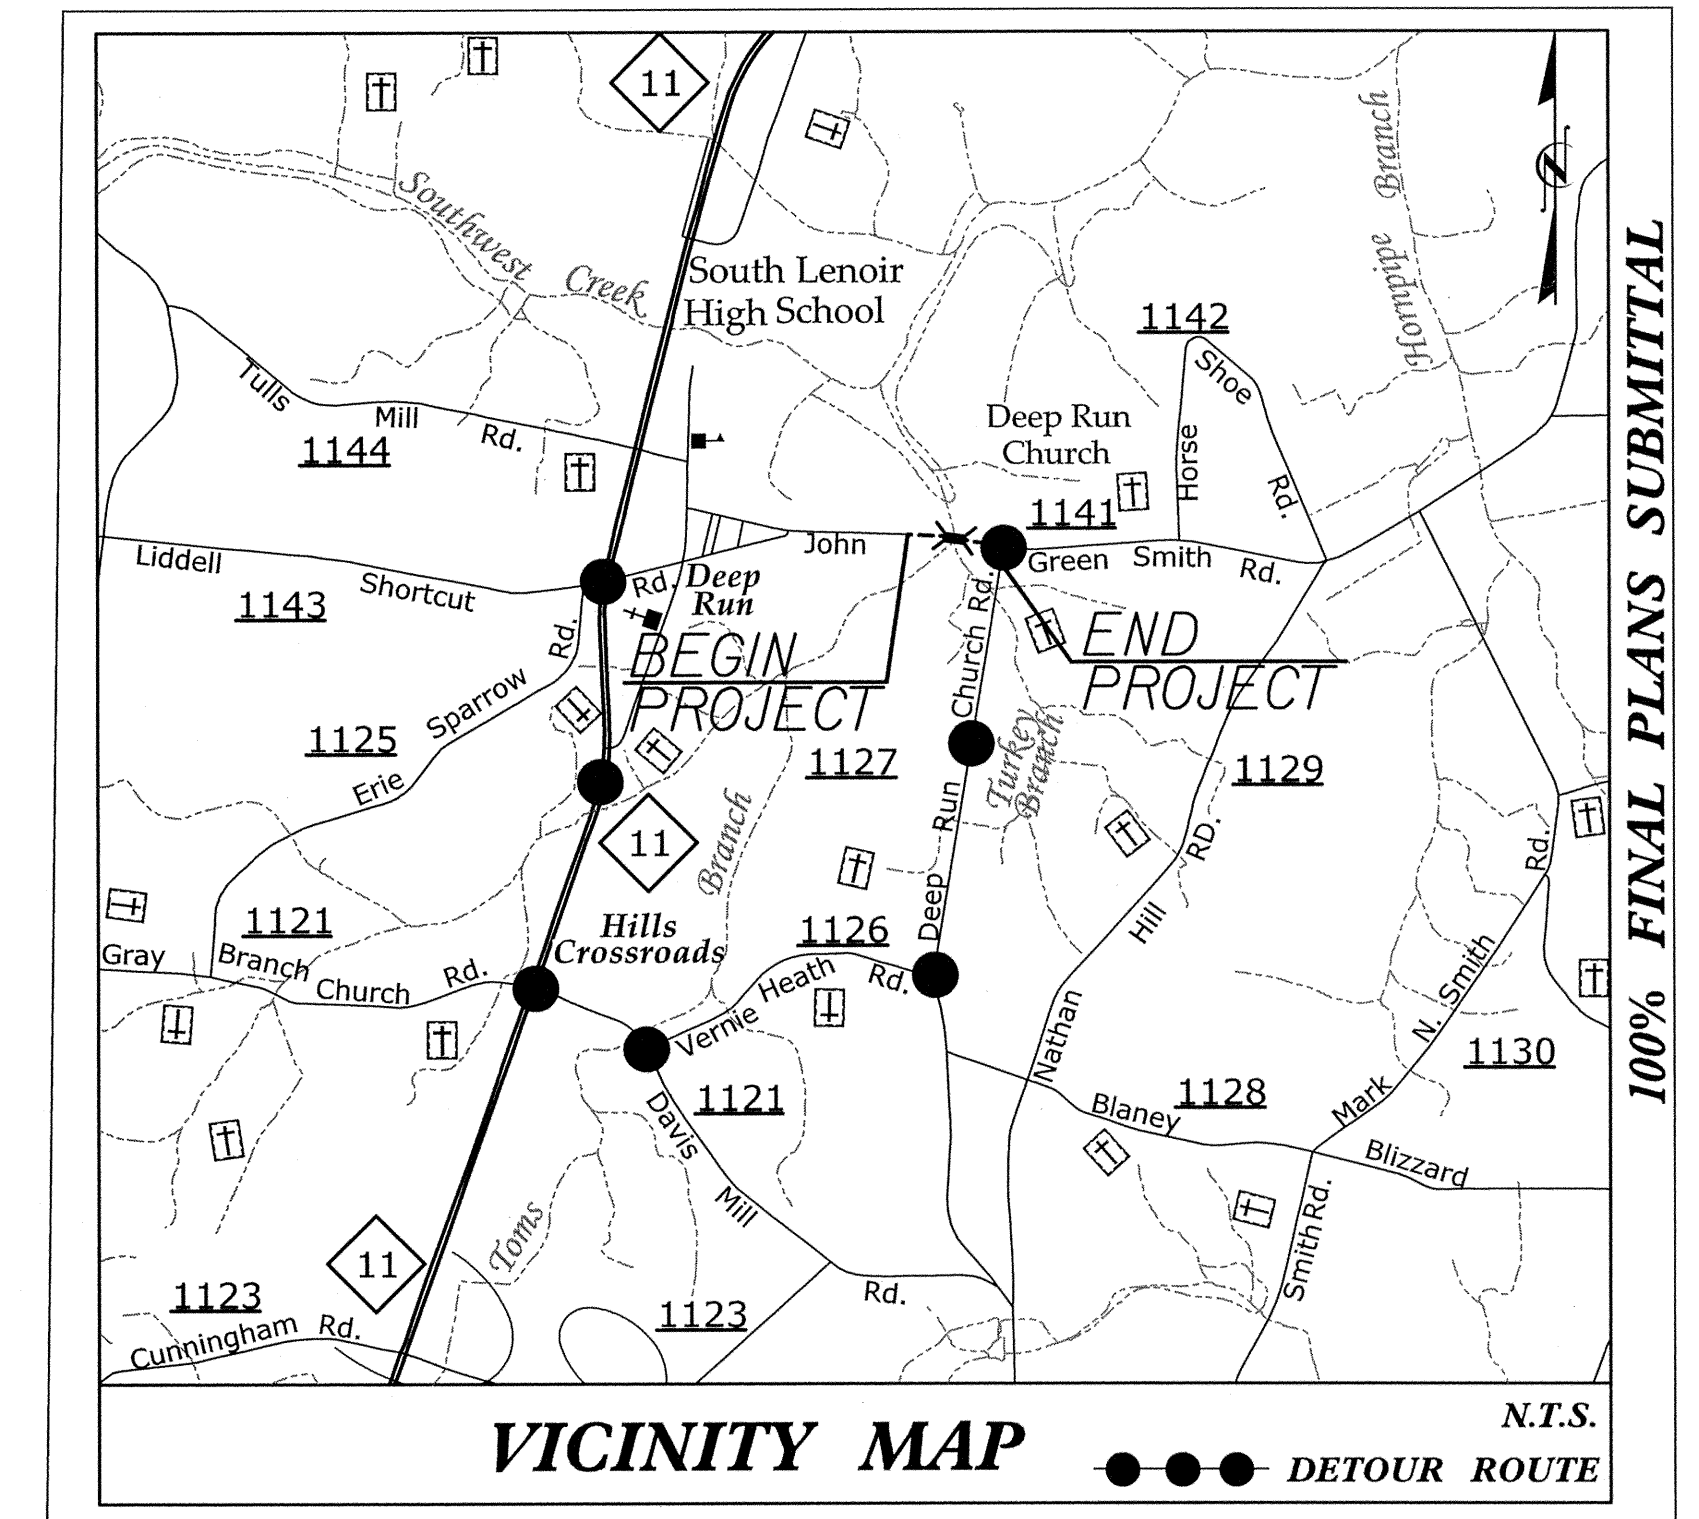

100% FINAL PLANS SUBMITTAL

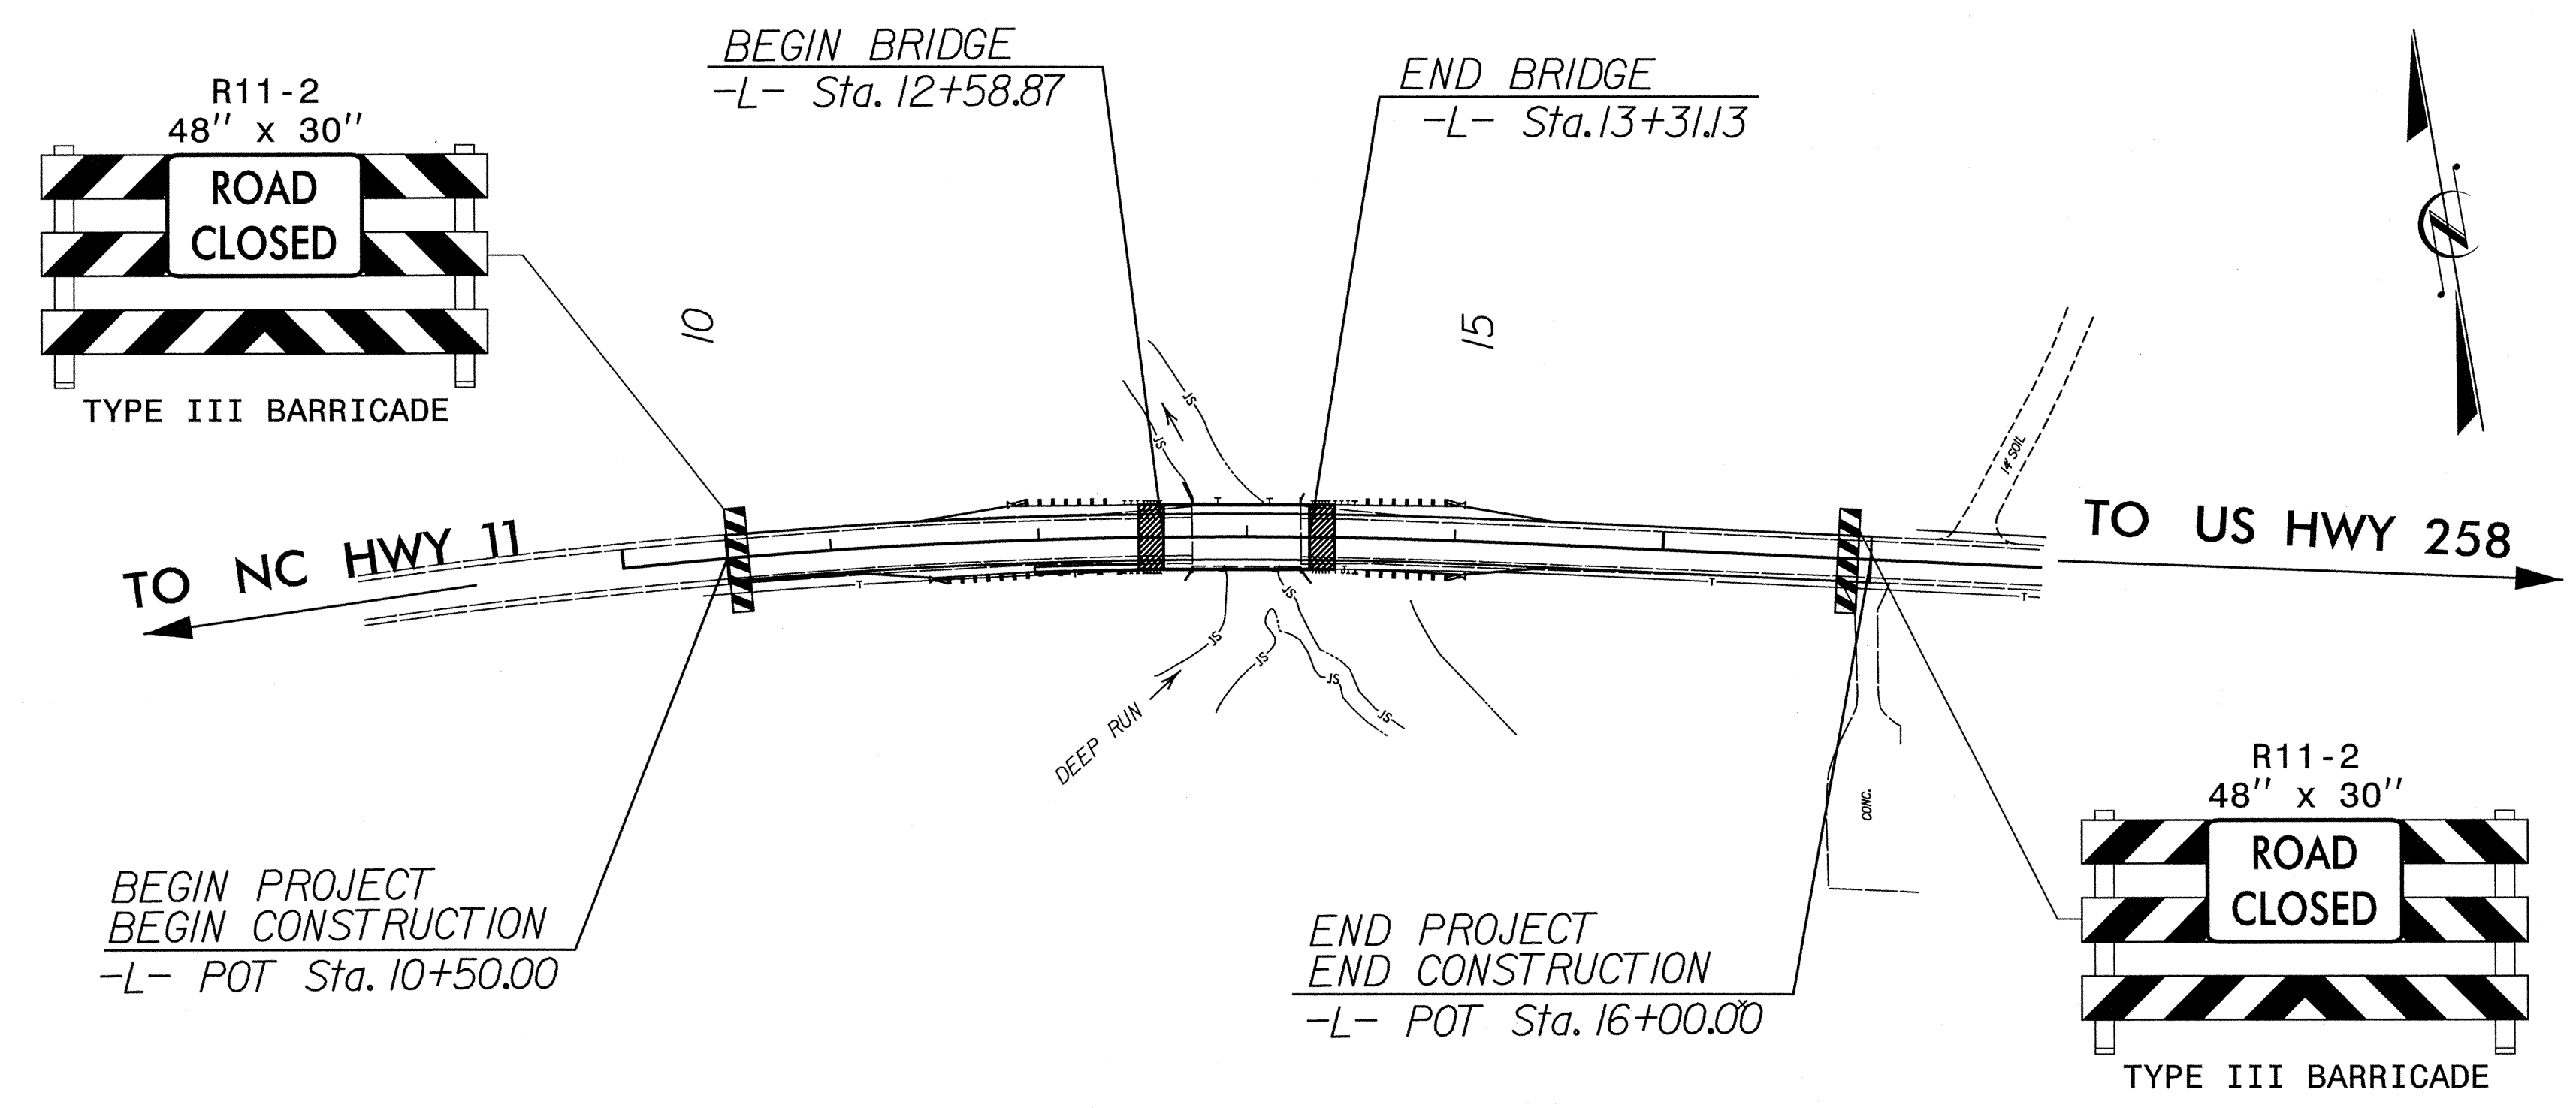

SYTIME\$\$\$\$
 >\$\$\$\$
 <\$\$\$\$
 \$\$\$USERNAME\$\$\$\$

APPROVED: <i>[Signature]</i> DATE: 8-28-12	PROJECT NOTES	
		
SCALE: NONE		REVISIONS
DATE: 7/24/12		
DWG. BY: JAP		
DESIGN BY: JAP		
REVIEWED BY: RBE		CADD FILE

STATE	STATE PROJECT REFERENCE NO.	SHEET NO.	TOTAL SHEETS
N.C.	BD-5102M	EC-1	5
STATE PROJ. NO.	F.A. PROJ. NO.	DESCRIPTION	

TIP PROJECT: BD-5102M


STATE OF NORTH CAROLINA
DIVISION OF HIGHWAYS
**PLAN FOR PROPOSED
HIGHWAY EROSION CONTROL**

**LOCATION: LENOIR COUNTY BRIDGE NO. 032 OVER DEEP RUN
ON SR 1141 (JOHN GREEN SMITH ROAD)**


TYPE OF WORK: LOW IMPACT BRIDGE REPLACEMENT

EROSION AND SEDIMENT CONTROL MEASURES

Std. #	Description	Symbol
1630.03	Temporary Silt Ditch	TD
1630.05	Temporary Diversion	TD
1605.01	Temporary Silt Fence	
1606.01	Special Sediment Control Fence	△△△
1622.01	Temporary Berms and Slope Drains	→
	Silt Basin Type B	▨
1633.01	Temporary Rock Silt Check Type-A	⊗
	Temporary Rock Silt Check Type-A with Matting and Polyacrylamide (PAM)	⊗
	Temporary Rock Silt Check Type-B	→
	Wattle/Coir Fiber Wattle	⌒
	Wattle/Coir Fiber Wattle with Polyacrylamide (PAM)	⌒
1634.01	Temporary Rock Sediment Dam Type-A	⊠
1634.02	Temporary Rock Sediment Dam Type-B	⊠
1635.01	Rock Pipe Inlet Sediment Trap Type-A	⊠
1635.02	Rock Pipe Inlet Sediment Trap Type-B	⊠
1630.04	Stilling Basin	▭
1630.06	Special Stilling Basin	▭
	Rock Inlet Sediment Trap:	
1632.01	Type A	A
1632.02	Type B	B
1632.03	Type C	C
	Skimmer Basin	▭
	Tiered Skimmer Basin	▭
	Infiltration Basin	▭

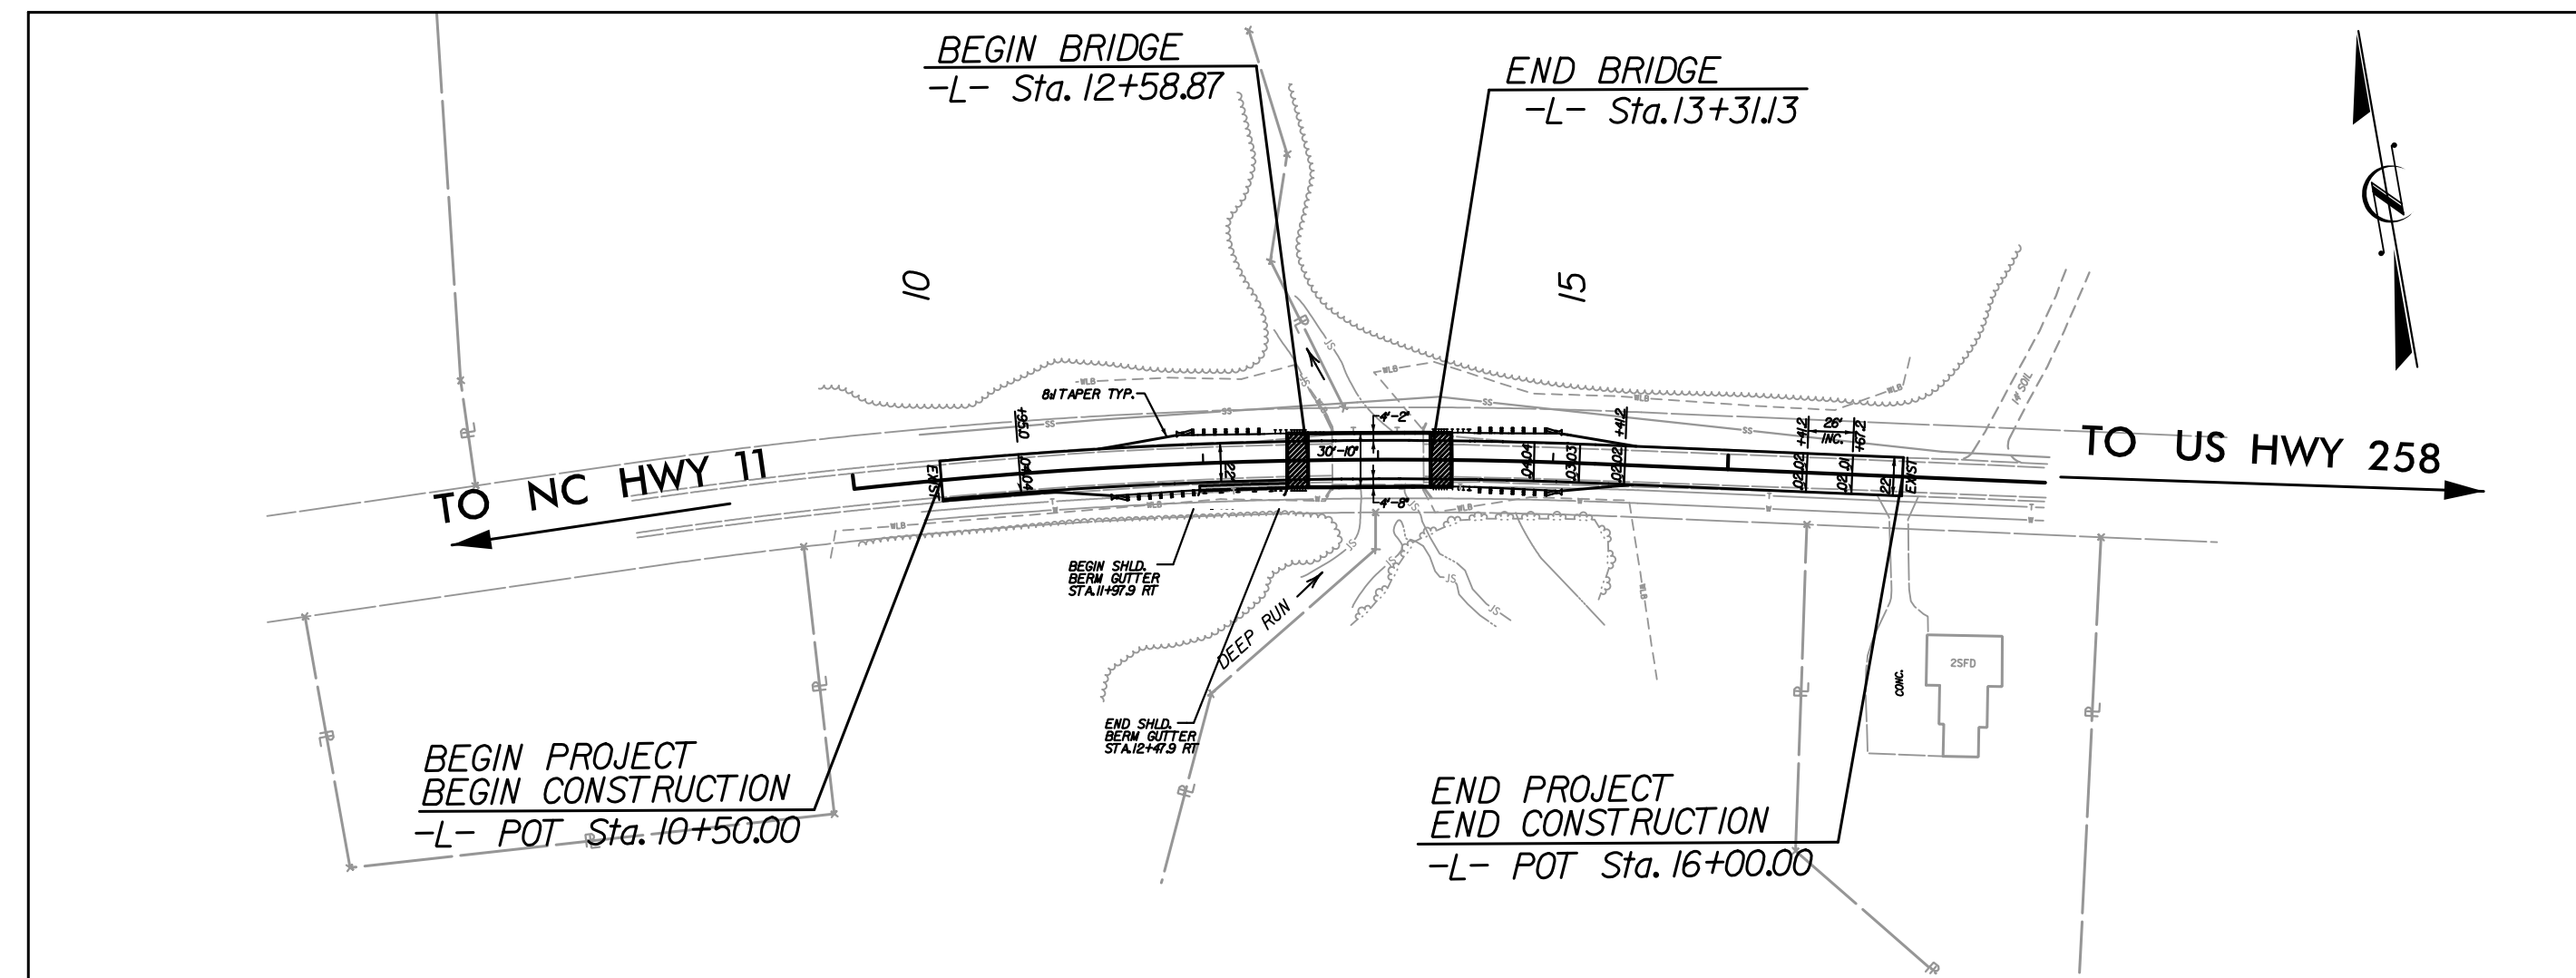

GRAPHIC SCALE

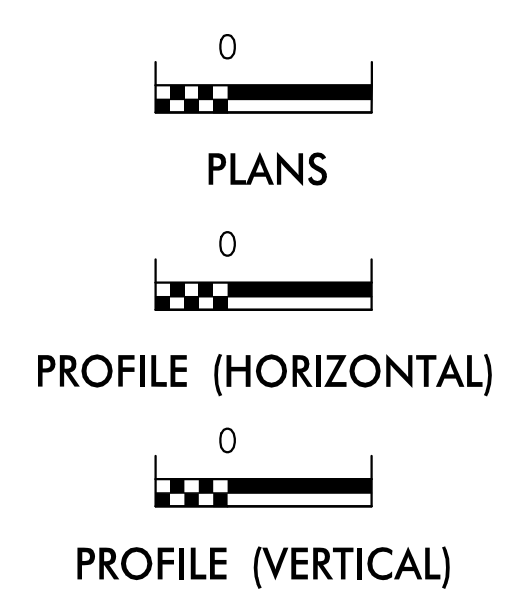

ROADSIDE ENVIRONMENTAL UNIT
DIVISION OF HIGHWAYS
STATE OF NORTH CAROLINA

THESE EROSION AND SEDIMENT CONTROL PLANS COMPLY WITH THE REGULATIONS SET FORTH BY THE NCG-010000 GENERAL CONSTRUCTION PERMIT EFFECTIVE AUGUST 3, 2011 ISSUED BY THE NORTH CAROLINA DEPARTMENT OF ENVIRONMENT AND NATURAL RESOURCES DIVISION OF WATER QUALITY.

Prepared in the Office of:

HNTB HNTB NORTH CAROLINA, P.C.
343 E. Six Forks Road, Suite 200
Raleigh, North Carolina 27609
NC License No: C-1554

2012 STANDARD SPECIFICATIONS

BENJAMIN J. HENEGAR, EI
EROSION CONTROL
LEVEL III-A
CERTIFICATION #641


Roadway Standard Drawings

The following roadway english standards as appear in "Roadway Standard Drawings"- Roadway Design Unit - N. C. Department of Transportation - Raleigh, N. C., dated January 2012 and the latest revision thereto are applicable to this project and by reference hereby are considered a part of these plans.

1604.01 Railroad Erosion Control Detail	1632.01 Rock Inlet Sediment Trap Type A
1605.01 Temporary Silt Fence	1632.02 Rock Inlet Sediment Trap Type B
1606.01 Special Sediment Control Fence	1632.03 Rock Inlet Sediment Trap Type C
1607.01 Gravel Construction Entrance	1633.01 Temporary Rock Silt Check Type A
1622.01 Temporary Berms and Slope Drains	1633.02 Temporary Rock Silt Check Type B
1630.01 Riser Basin	1634.01 Temporary Rock Sediment Dam Type A
1630.02 Silt Basin Type B	1634.02 Temporary Rock Sediment Dam Type B
1630.03 Temporary Silt Ditch	1635.01 Rock Pipe Inlet Sediment Trap Type A
1630.04 Stilling Basin	1635.02 Rock Pipe Inlet Sediment Trap Type B
1630.05 Temporary Diversion	1640.01 Coir Fiber Baffle
1630.06 Special Stilling Basin	1645.01 Temporary Stream Crossing
1631.01 Matting Installation	

2103141 [X] BD-5102M.ec.tsh.dgn
###USERNAME###

COIR FIBER WATTLE DETAIL

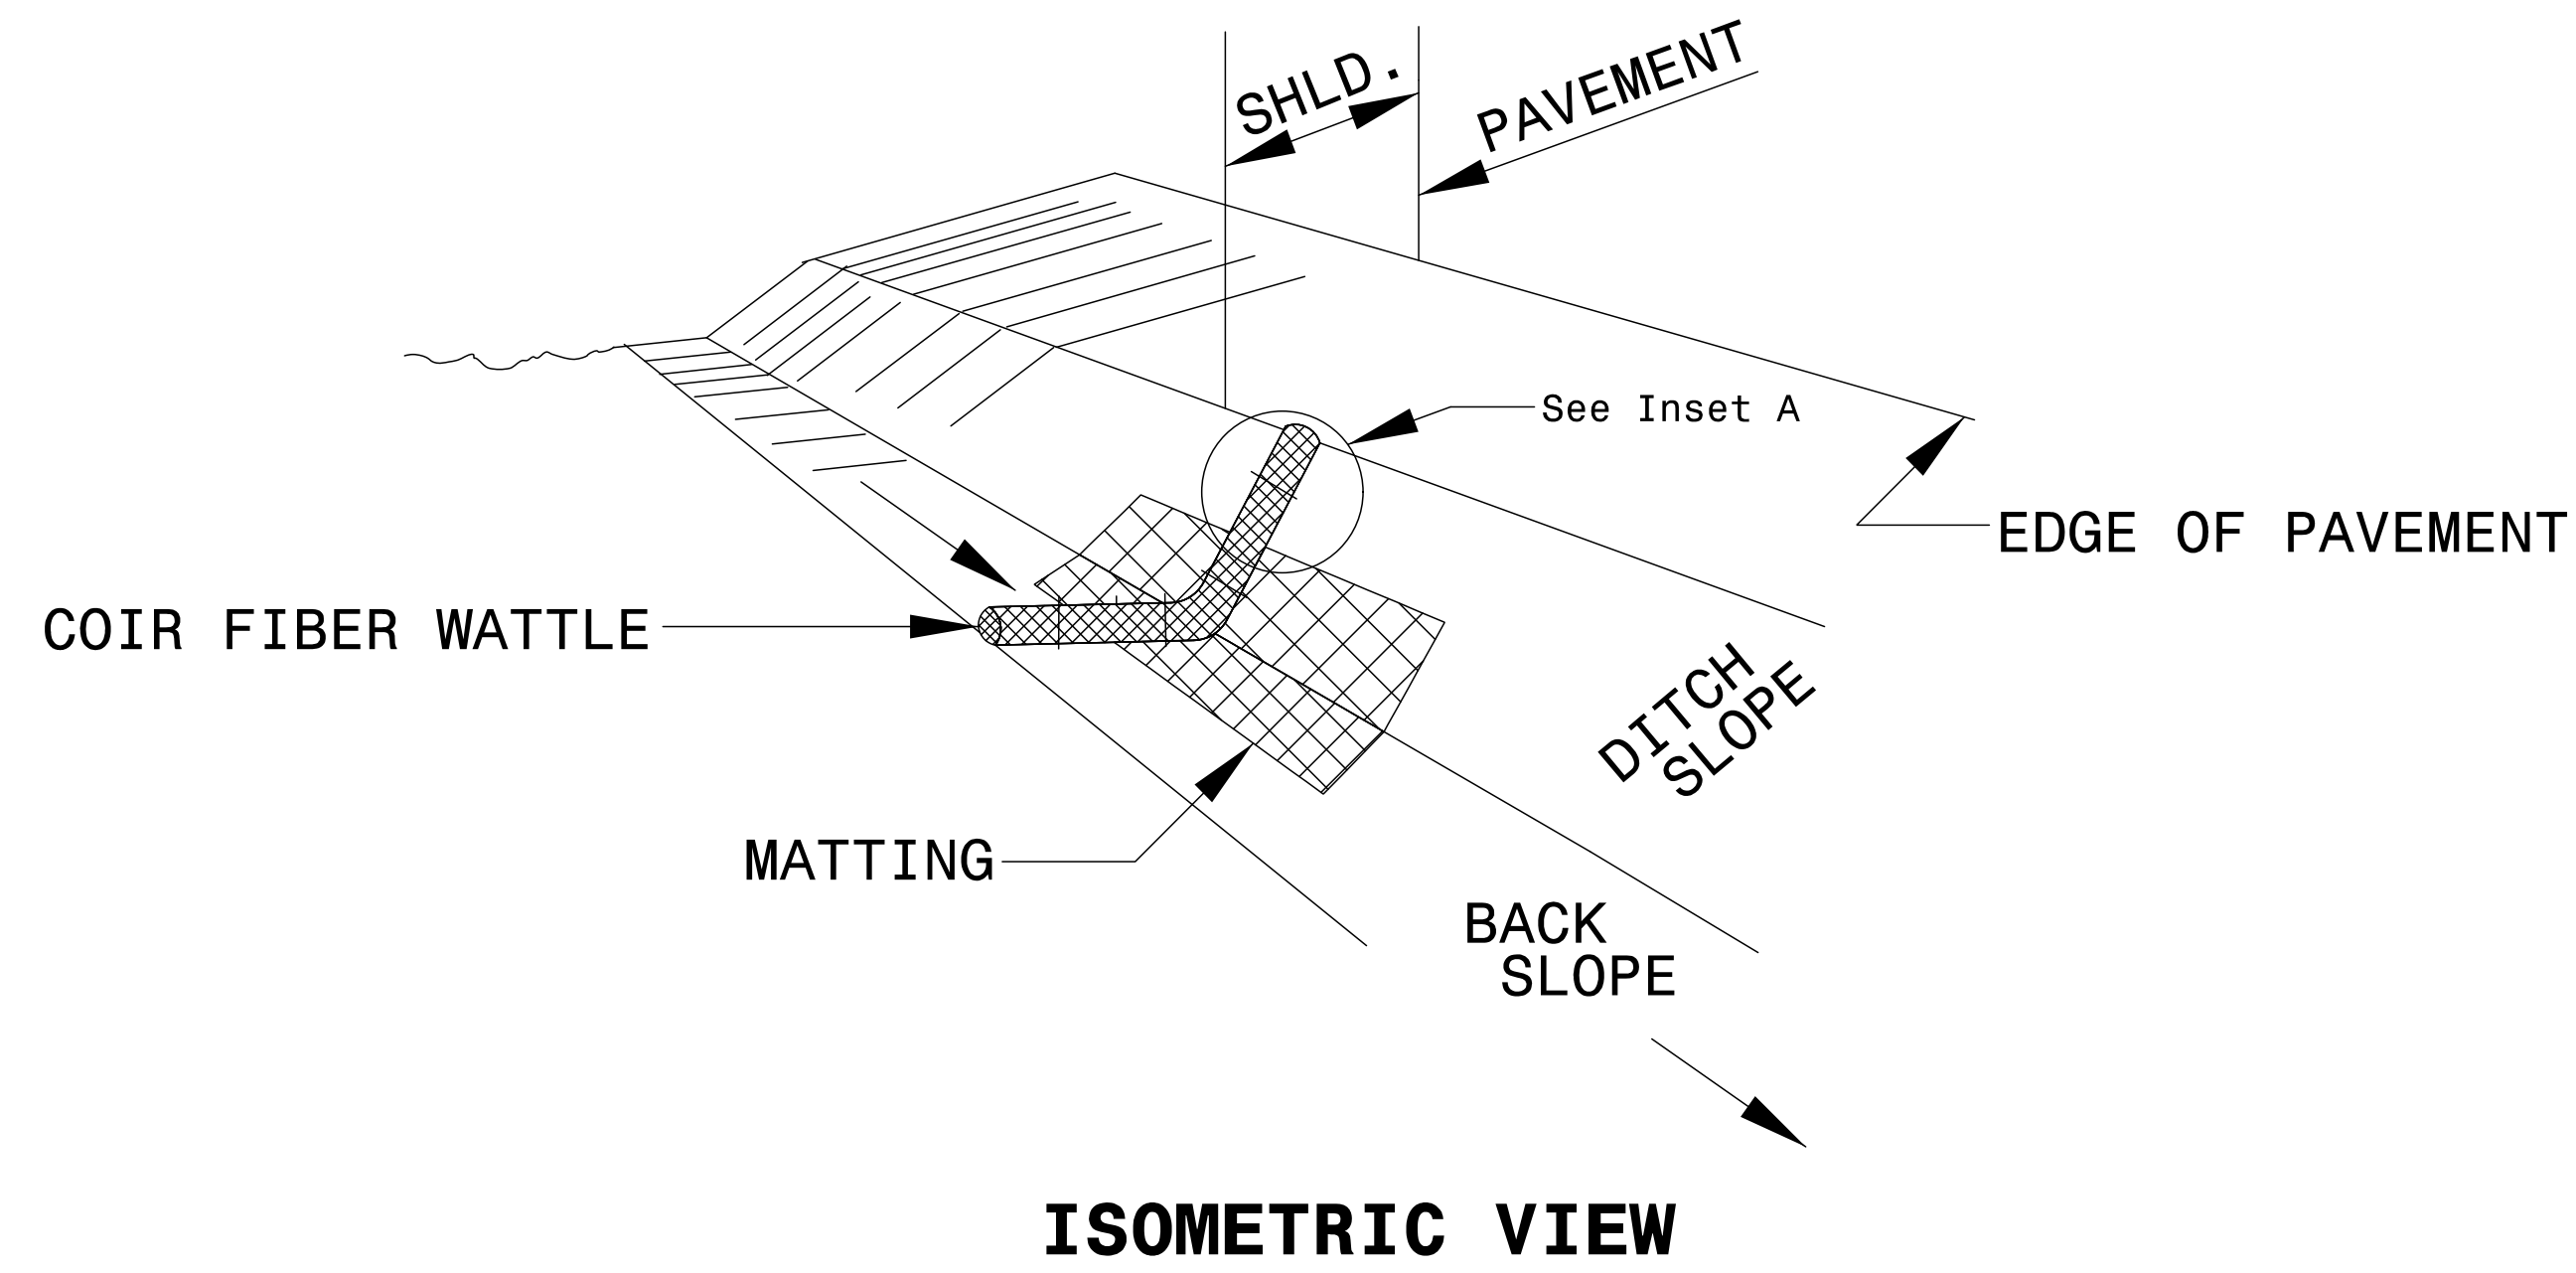

NOTES:

USE MINIMUM 12 IN. DIAMETER COIR FIBER (COCONUT FIBER) WATTLE.

USE 2 FT. WOODEN STAKES WITH A 2 IN. BY 2 IN. NOMINAL CROSS SECTION.





ONLY INSTALL WATTLE(S) TO A HEIGHT IN DITCH SO FLOW WILL NOT WASH AROUND WATTLE AND SCOUR DITCH SLOPES AND AS DIRECTED.

INSTALL A MINIMUM OF 2 UPSLOPE STAKES AND 4 DOWNSLOPE STAKES AT AN ANGLE TO WEDGE WATTLE TO BOTTOM OF DITCH.


PROVIDE STAPLES MADE OF 0.125 IN. DIAMETER STEEL WIRE FORMED INTO A U SHAPE NOT LESS THAN 12" IN LENGTH.

INSTALL STAPLES APPROXIMATELY EVERY 1 LINEAR FOOT ON BOTH SIDES OF WATTLE AND AT EACH END TO SECURE IT TO THE SOIL.


INSTALL MATTING IN ACCORDANCE WITH SECTION 1631 OF THE STANDARD SPECIFICATIONS.

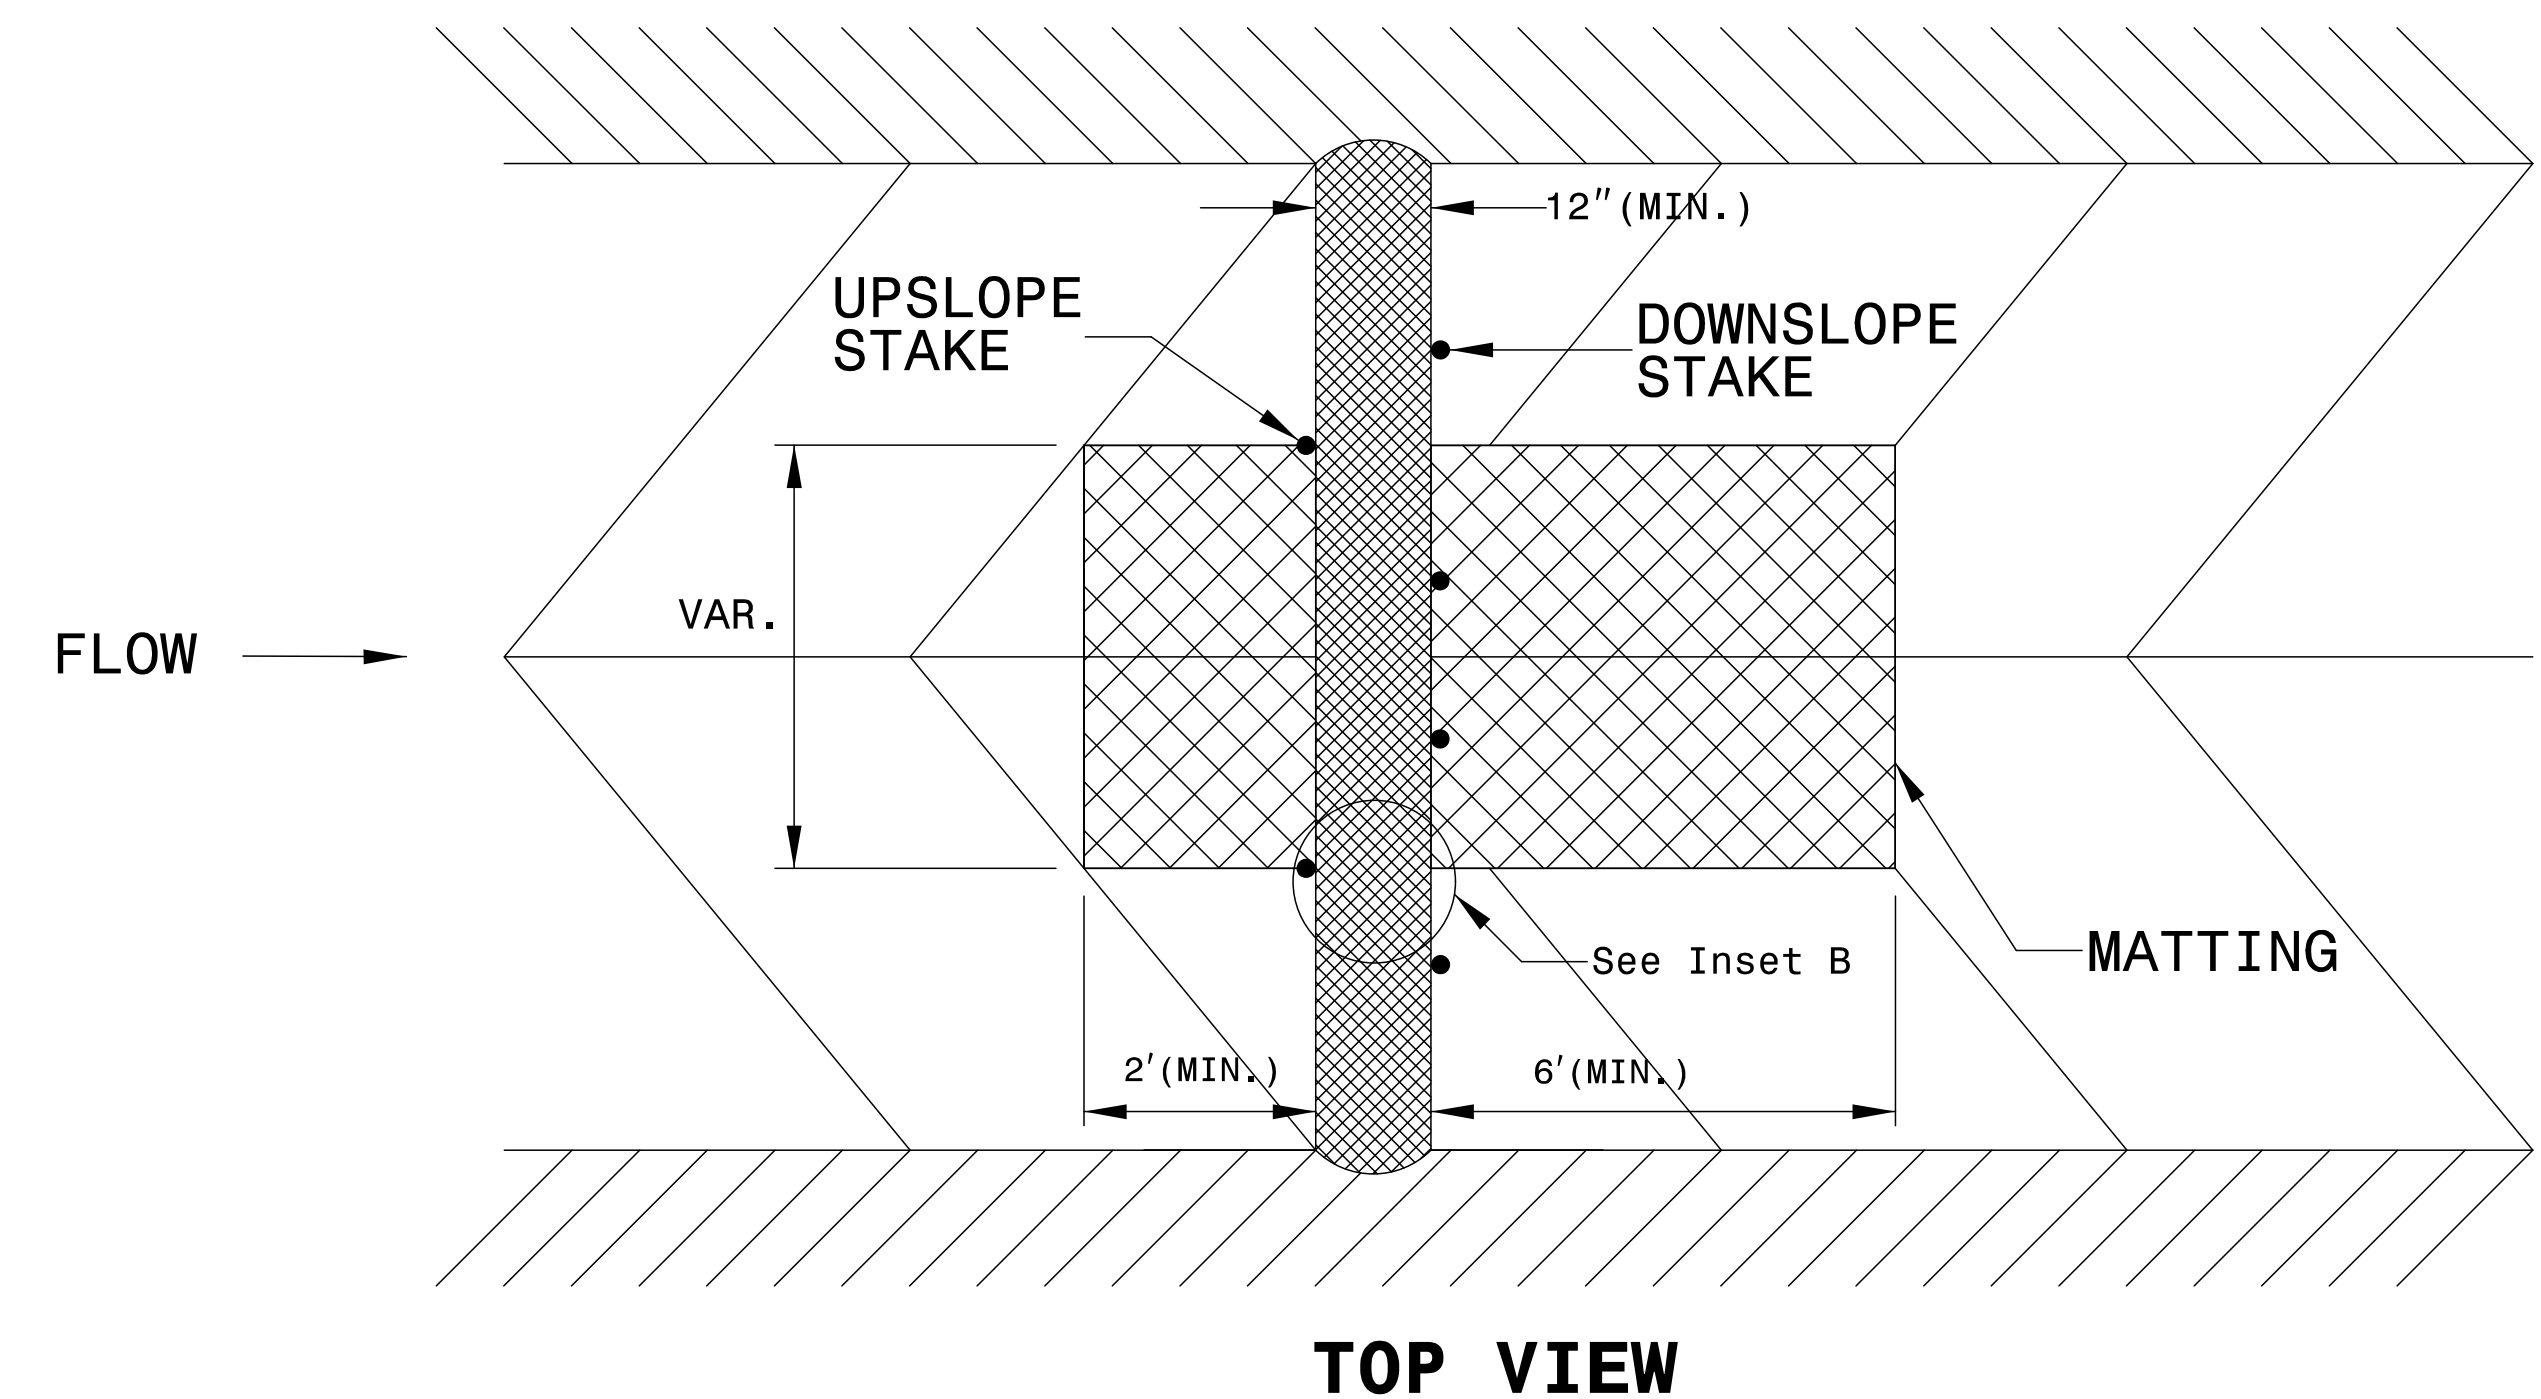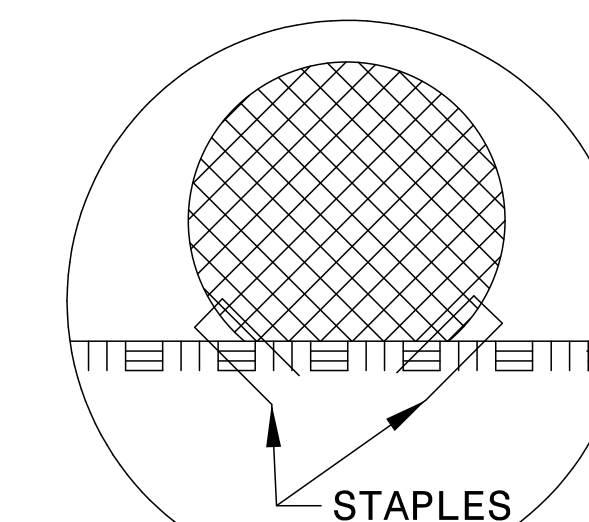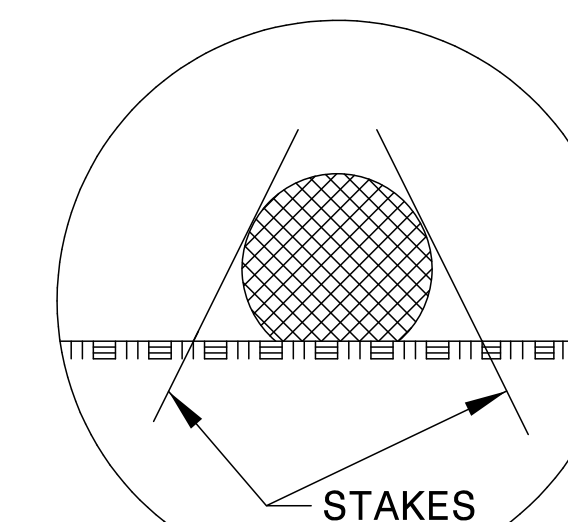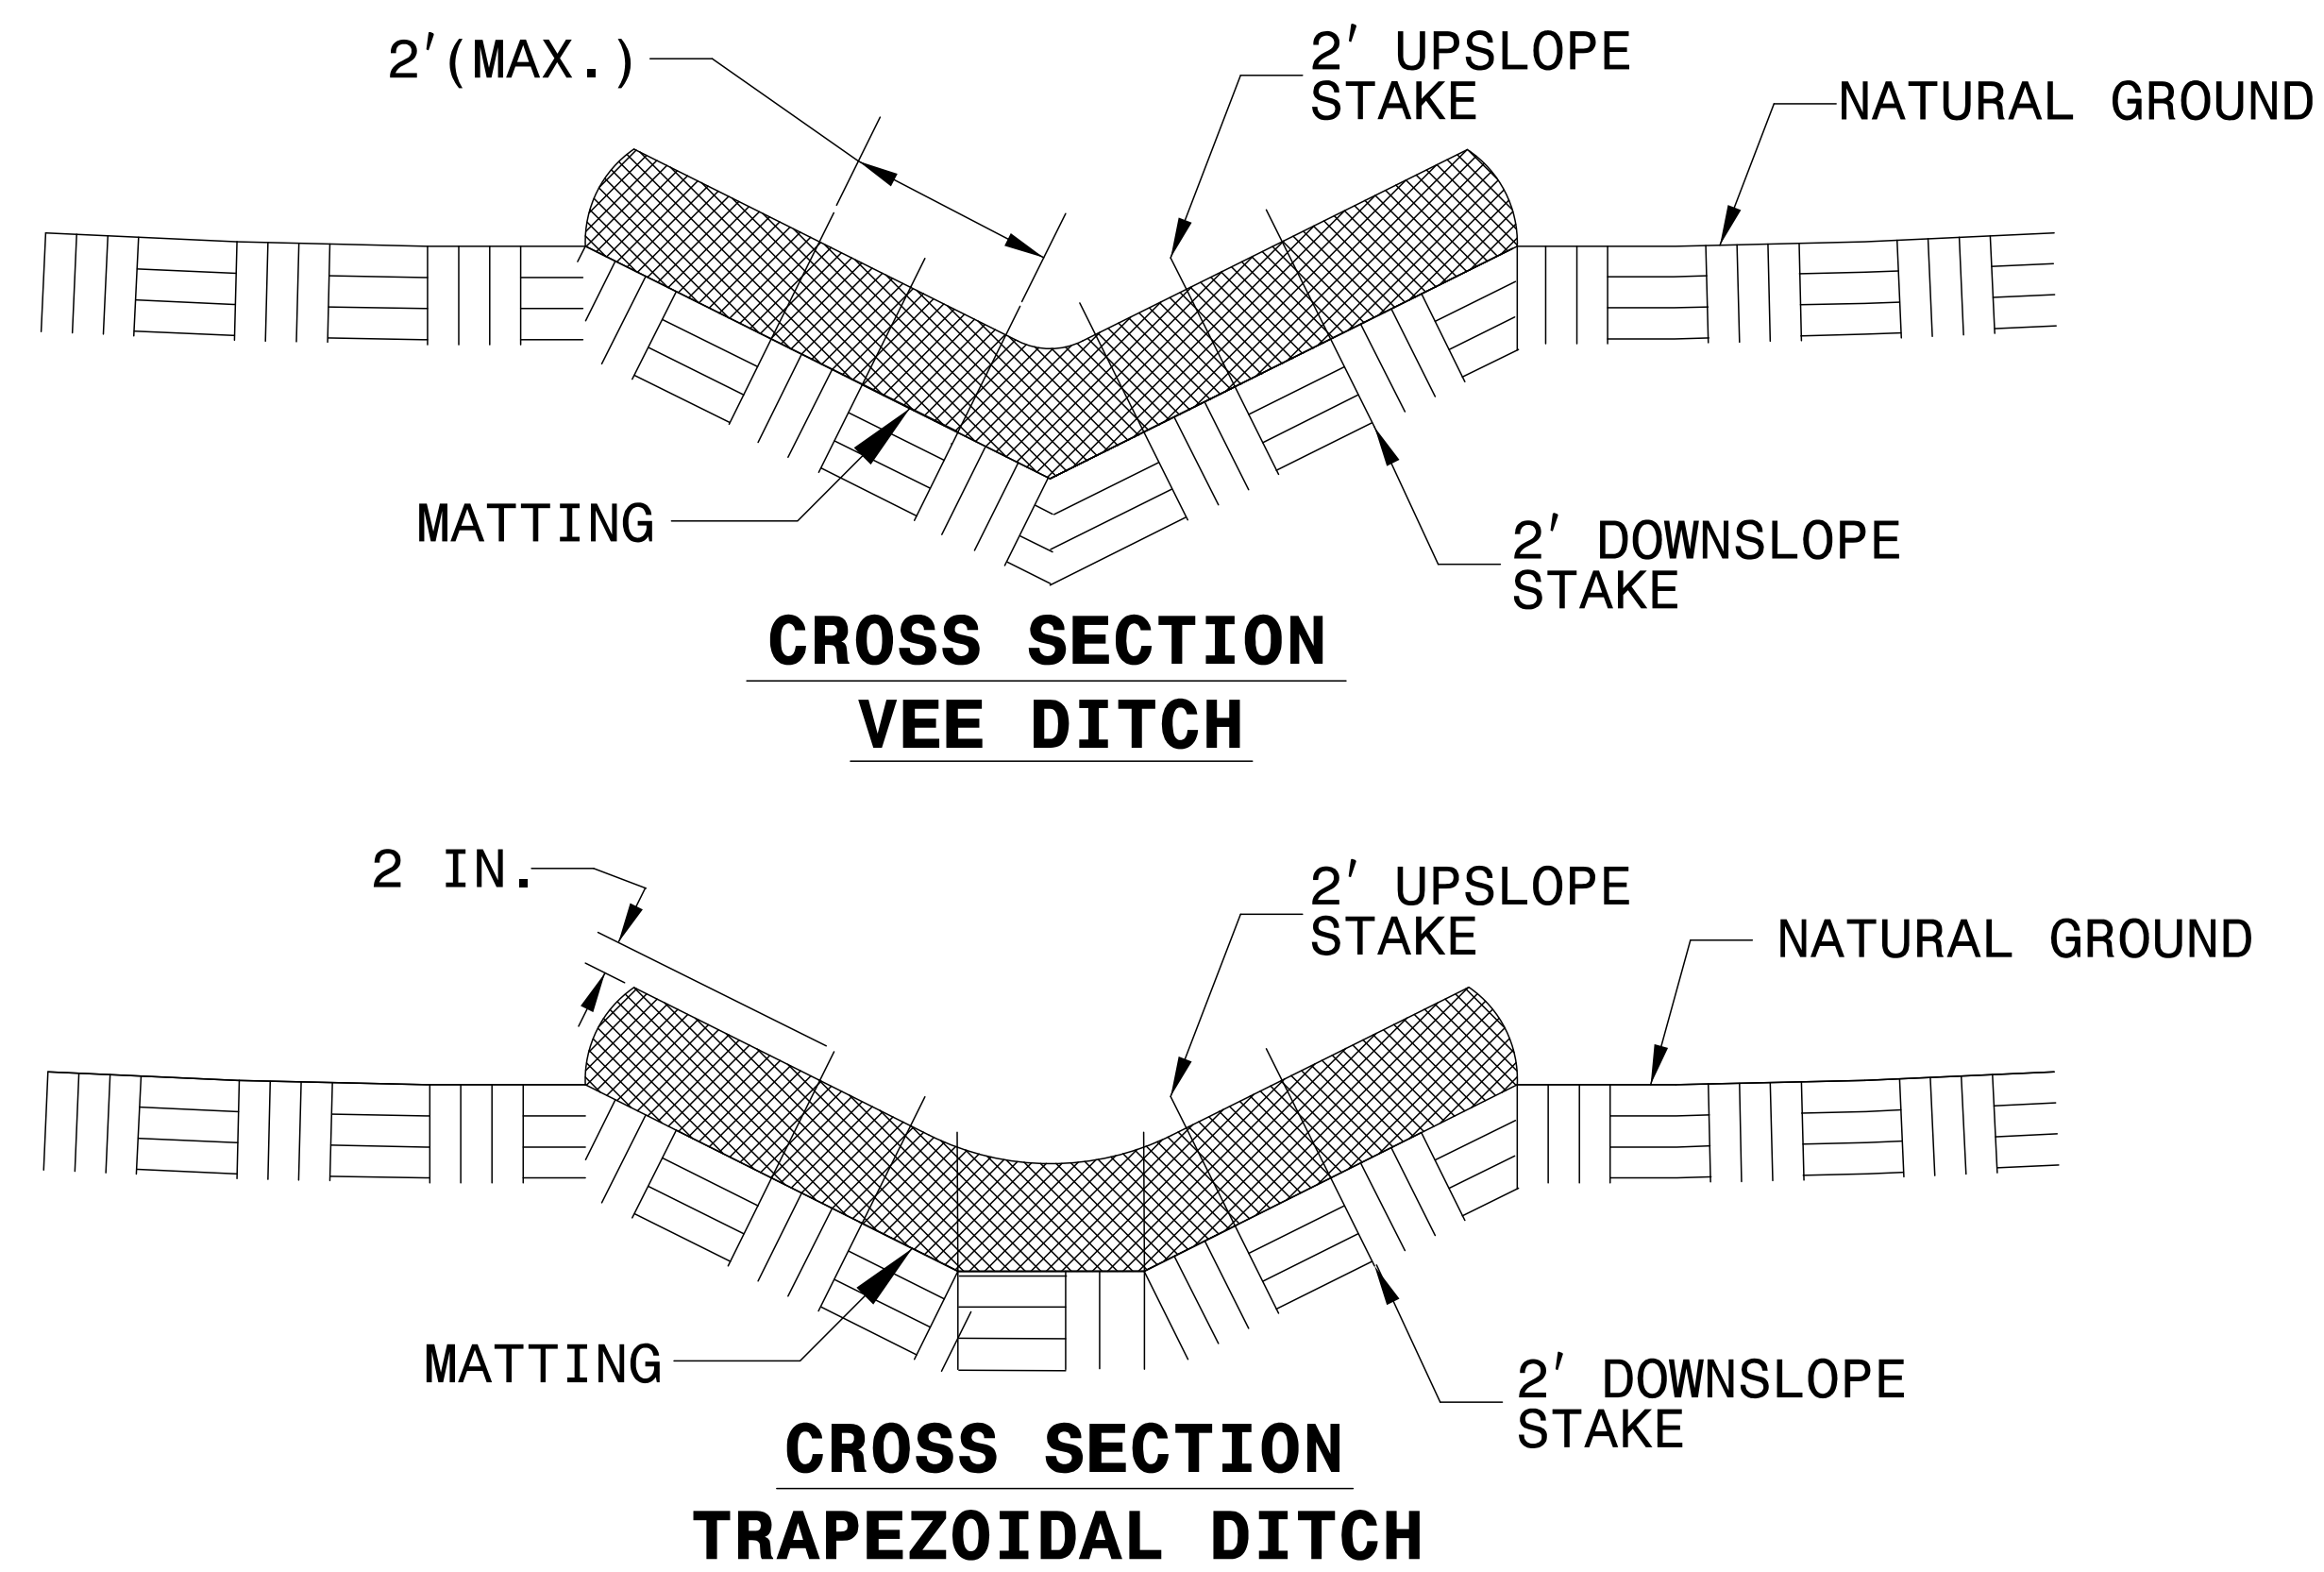

SILT FENCE COIR FIBER WATTLE BREAK DETAIL

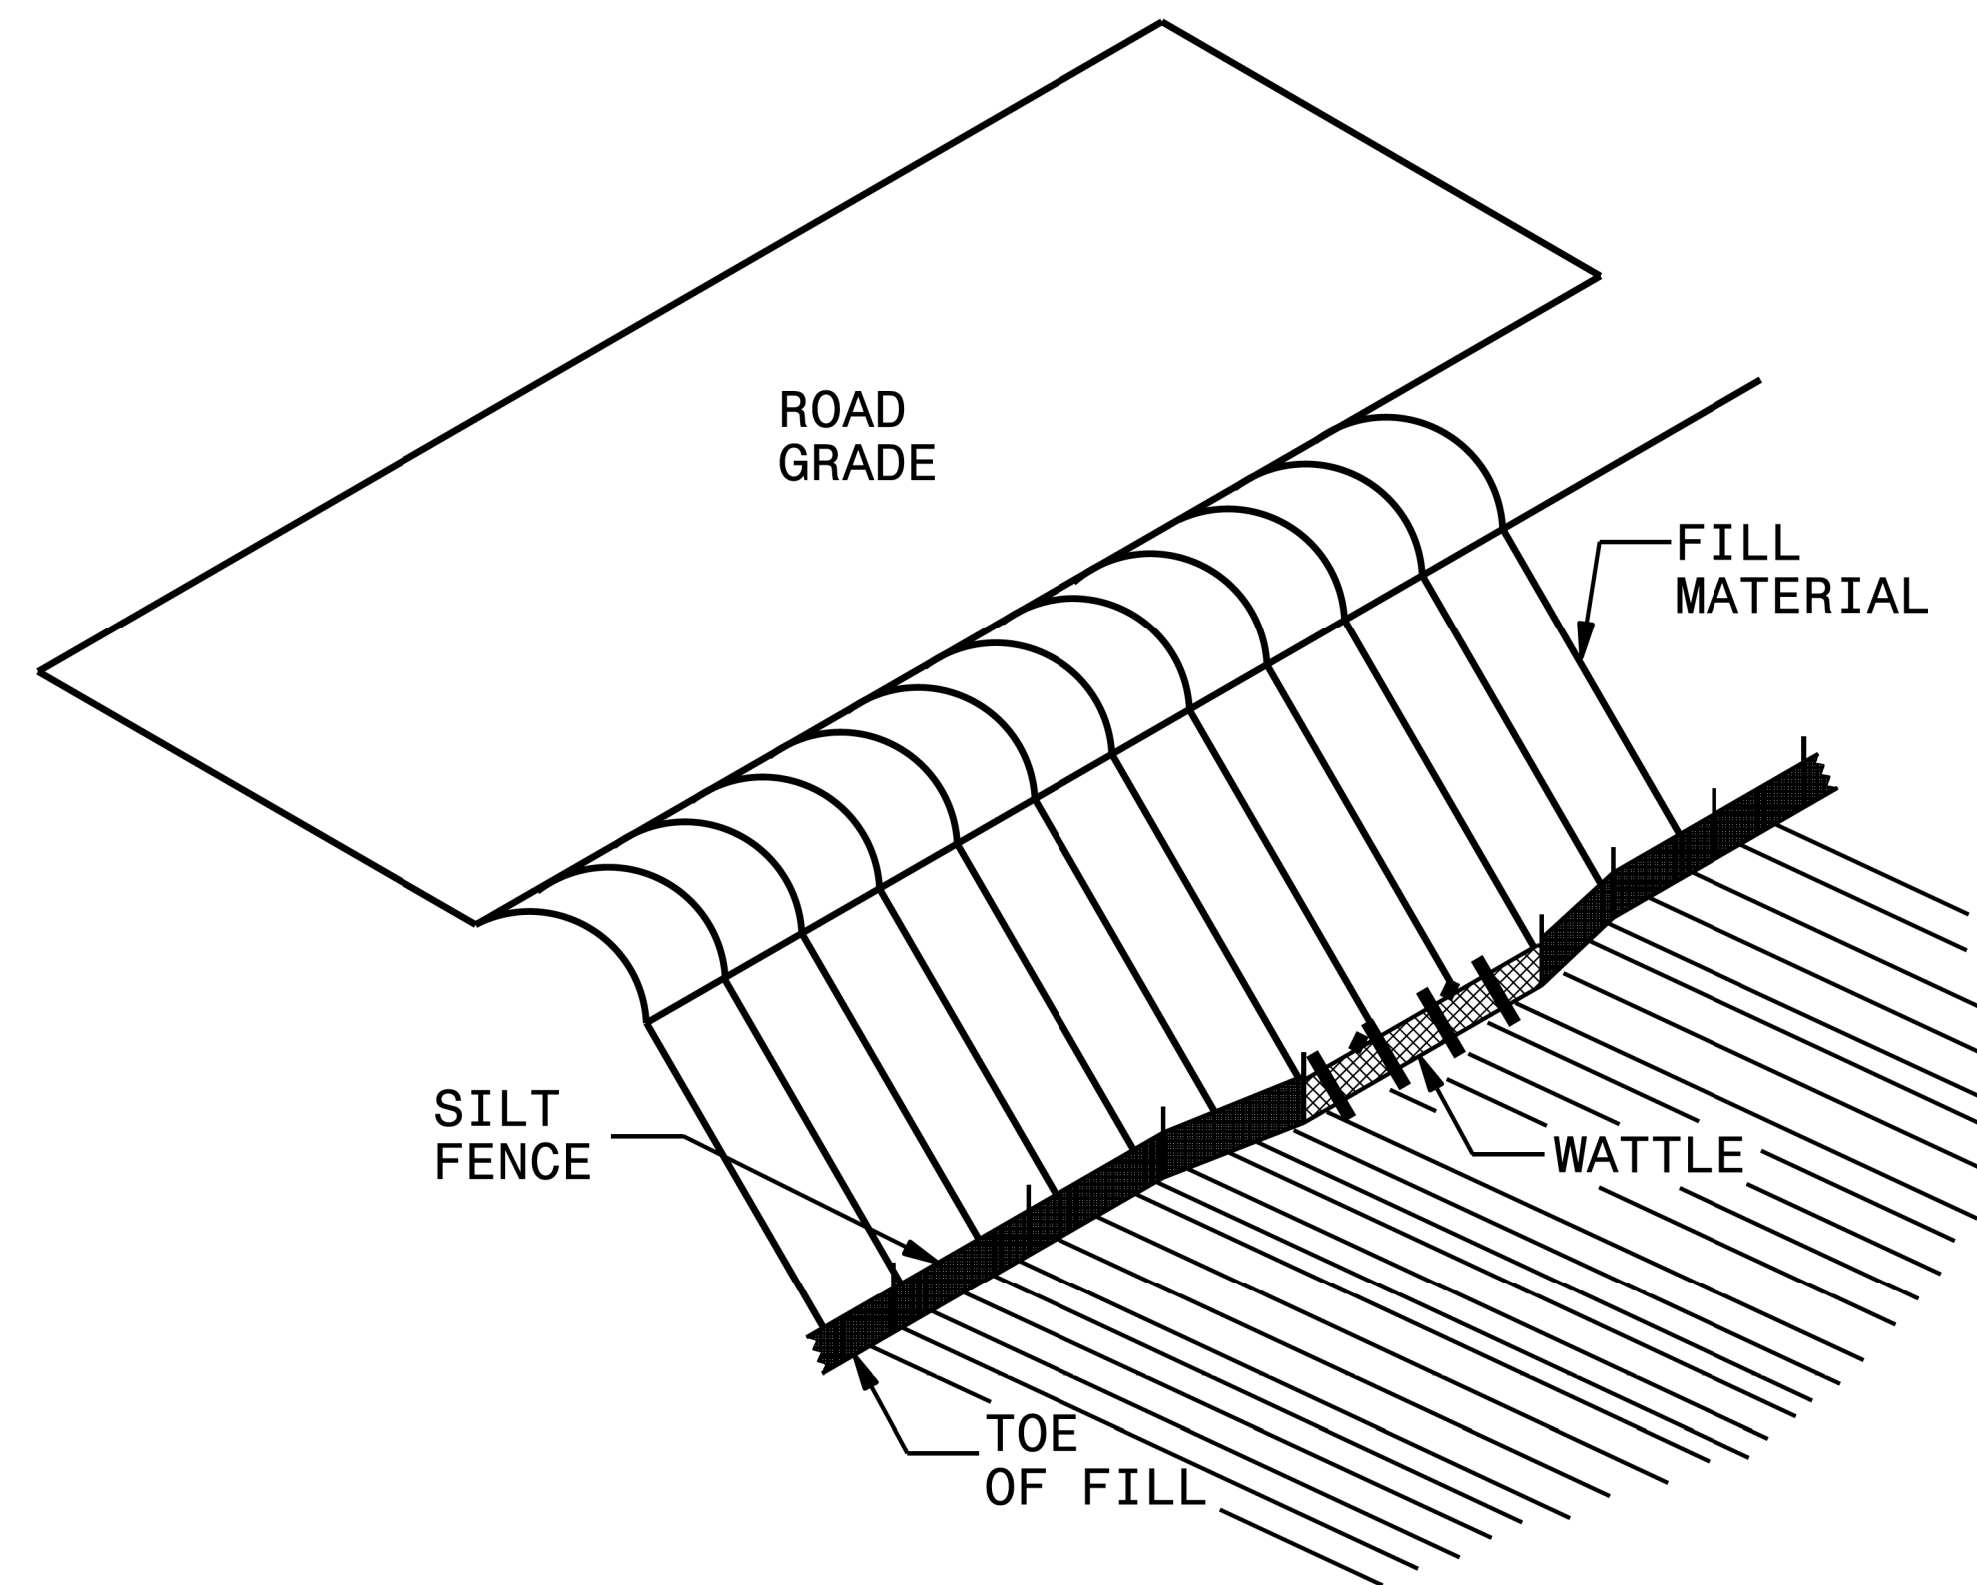

ISOMETRIC VIEW

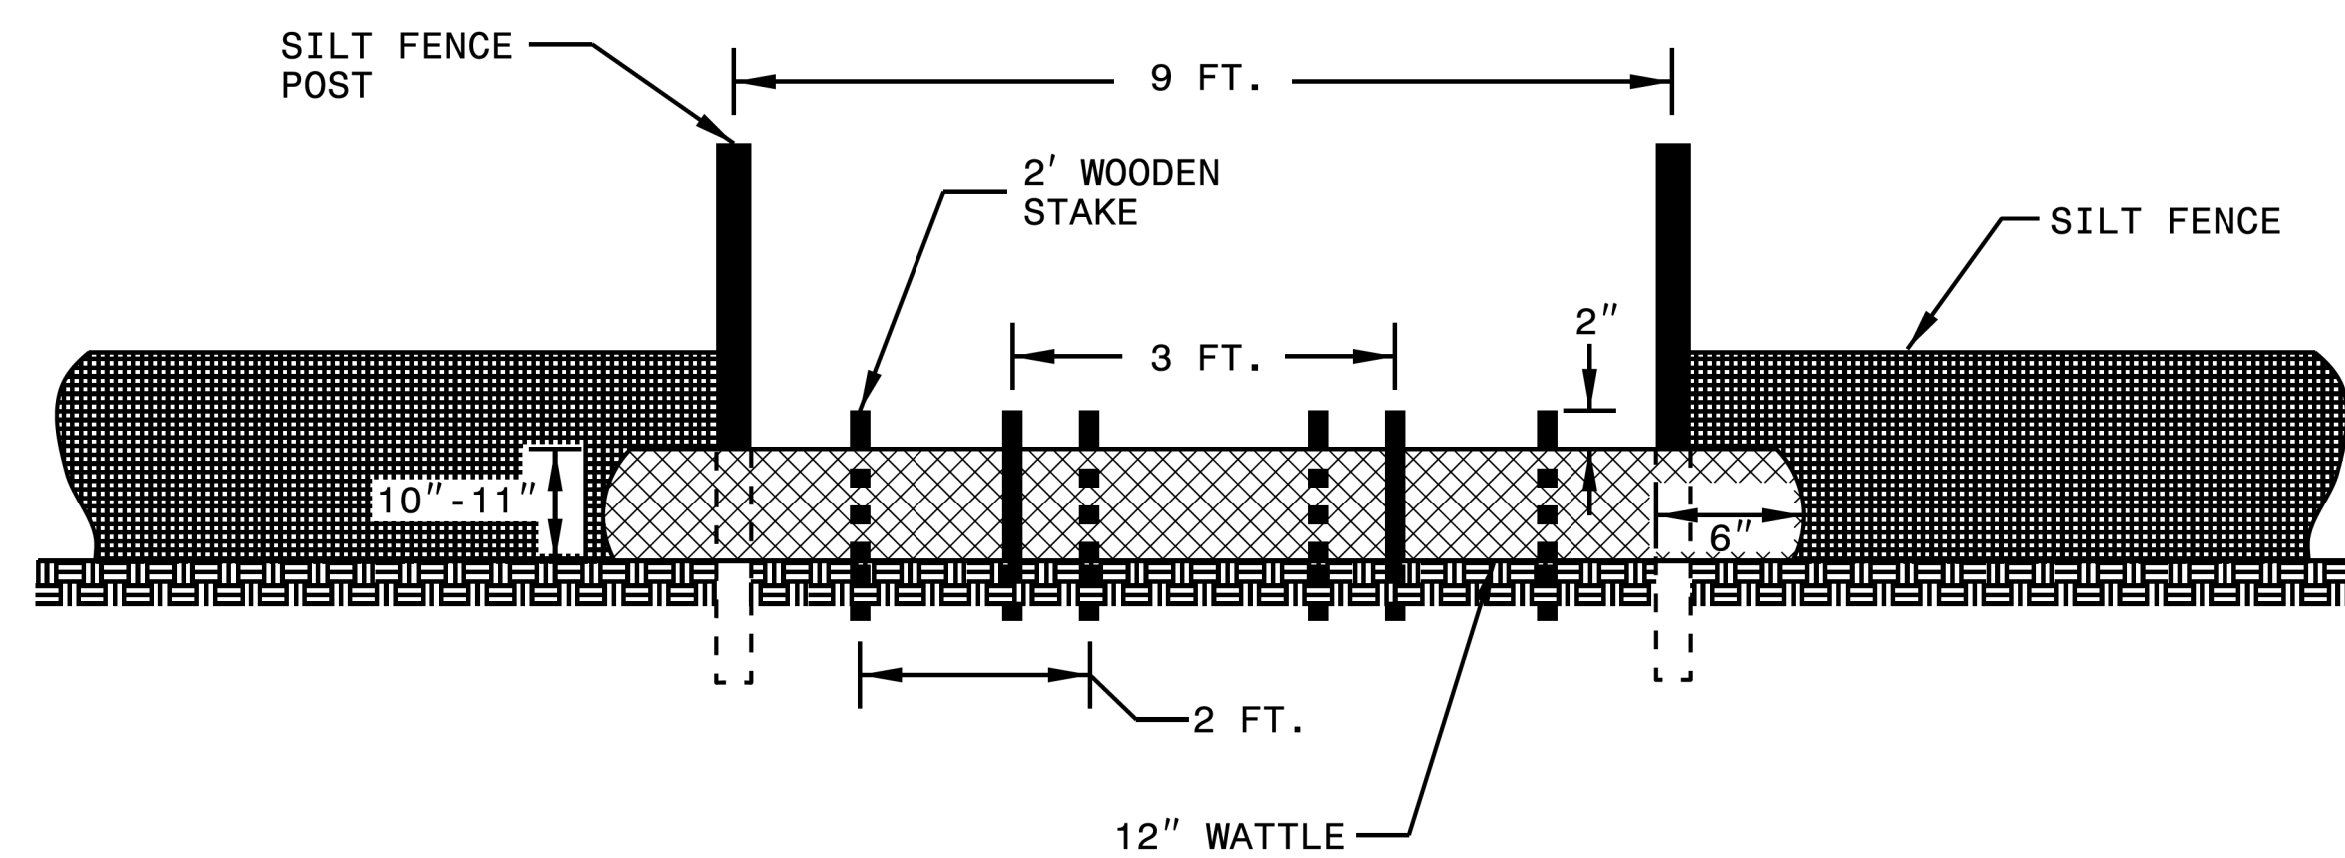

VIEW FROM SLOPE

NOTES:

USE MINIMUM 12 IN. DIAMETER COIR FIBER (COCONUT FIBER) WATTLE AND LENGTH OF 10 FT.

EXCAVATE A 1 TO 2 INCH TRENCH FOR WATTLE TO BE PLACED.

DO NOT PLACE WATTLE ON TOE OF SLOPE.

USE 2 FT. WOODEN STAKES WITH A 2 IN. BY 2 IN. NOMINAL CROSS SECTION.

INSTALL A MINIMUM OF 2 UPSLOPE STAKES AND 4 DOWNSLOPE STAKES AT AN ANGLE TO WEDGE WATTLE TO GROUND.



PROVIDE STAPLES MADE OF 0.125 IN. DIAMETER STEEL WIRE FORMED INTO A U SHAPE NOT LESS THAN 12" IN LENGTH.

INSTALL STAPLES APPROXIMATELY EVERY 1 LINEAR FOOT ON BOTH SIDES OF WATTLE AND AT EACH END TO SECURE IT TO THE SOIL.

WATTLE INSTALLATION CAN BE ON OUTSIDE OF THE SILT FENCE AS DIRECTED.

INSTALL TEMPORARY SILT FENCE IN ACCORDANCE WITH SECTION 1605 OF THE STANDARD SPECIFICATIONS.

INSET A

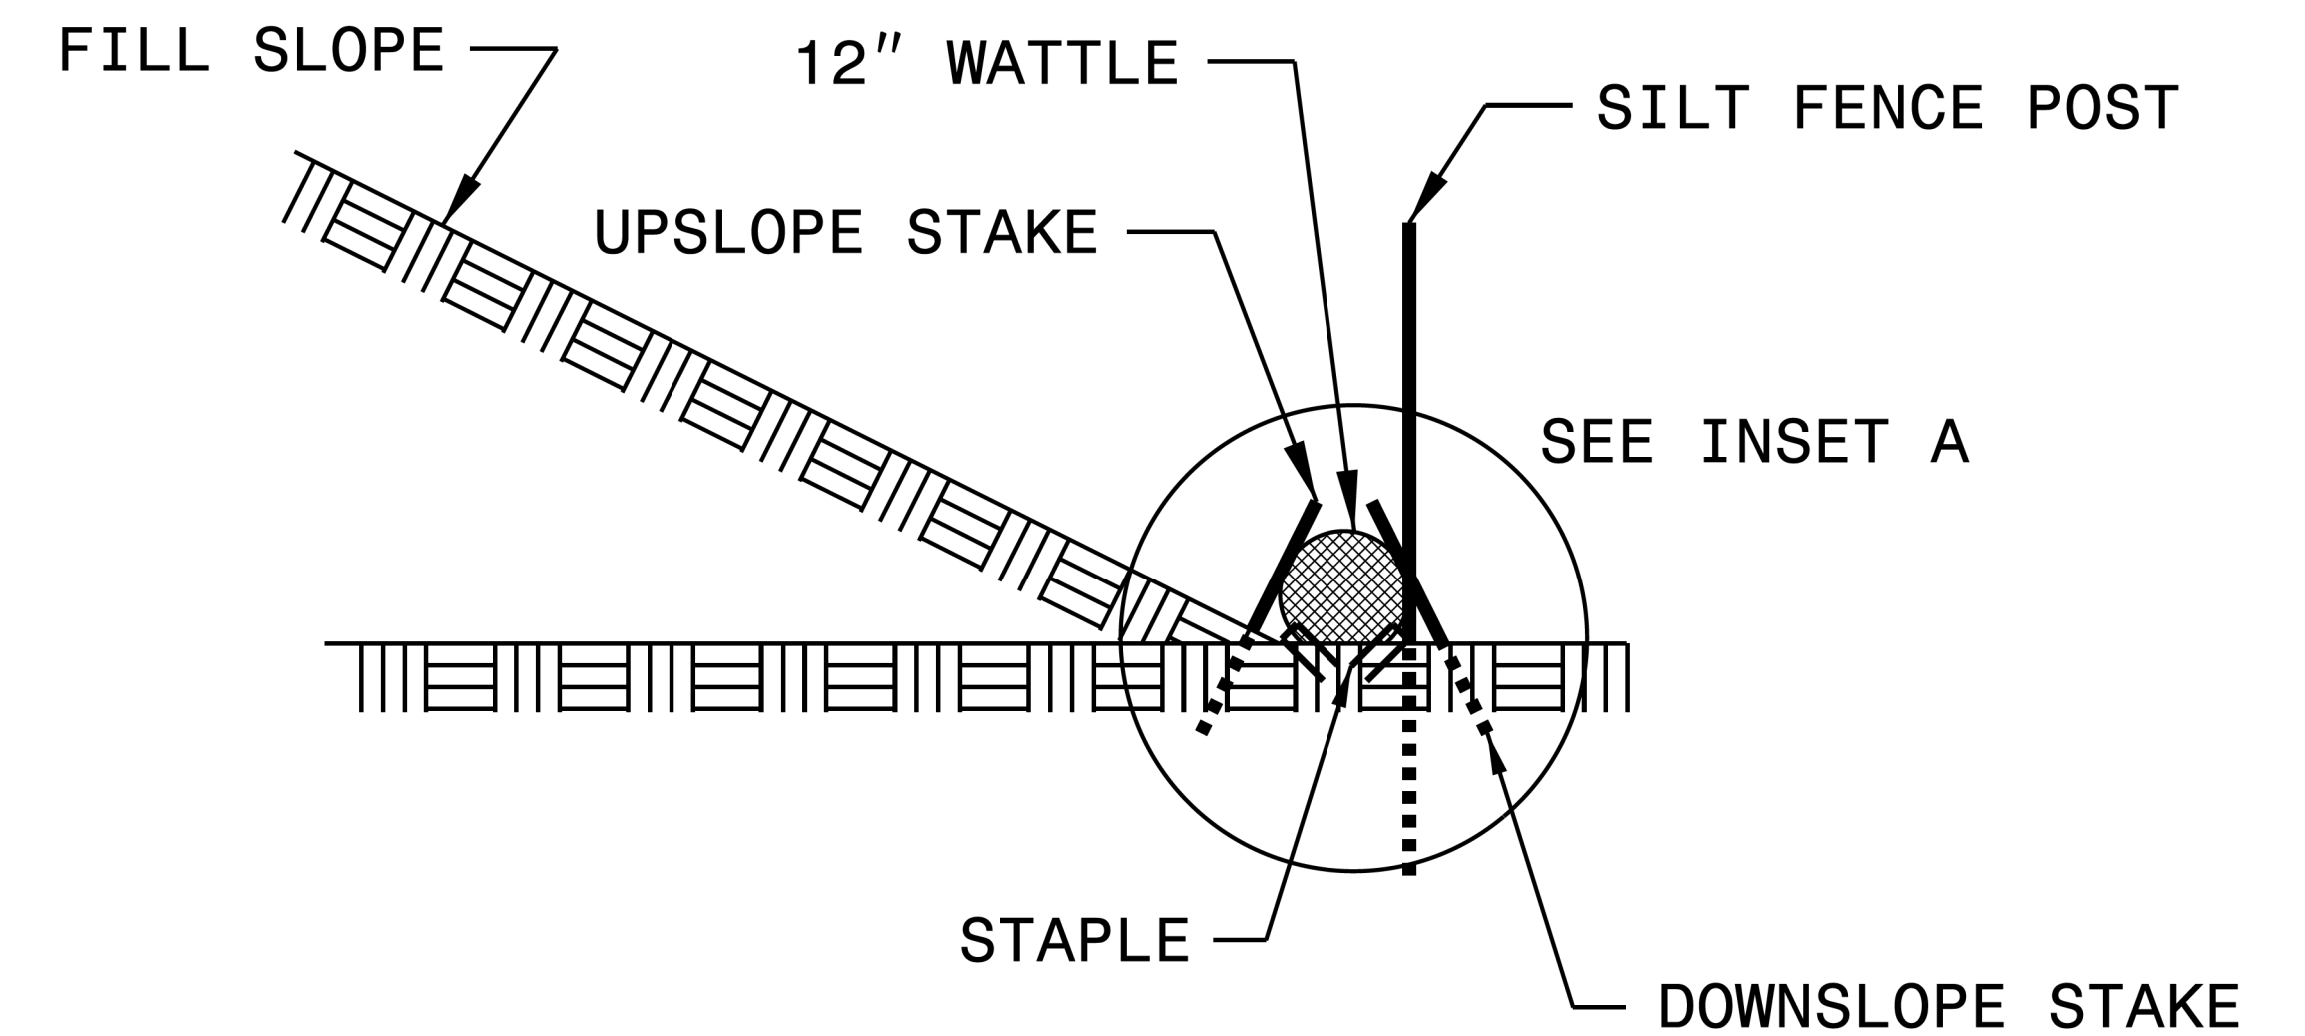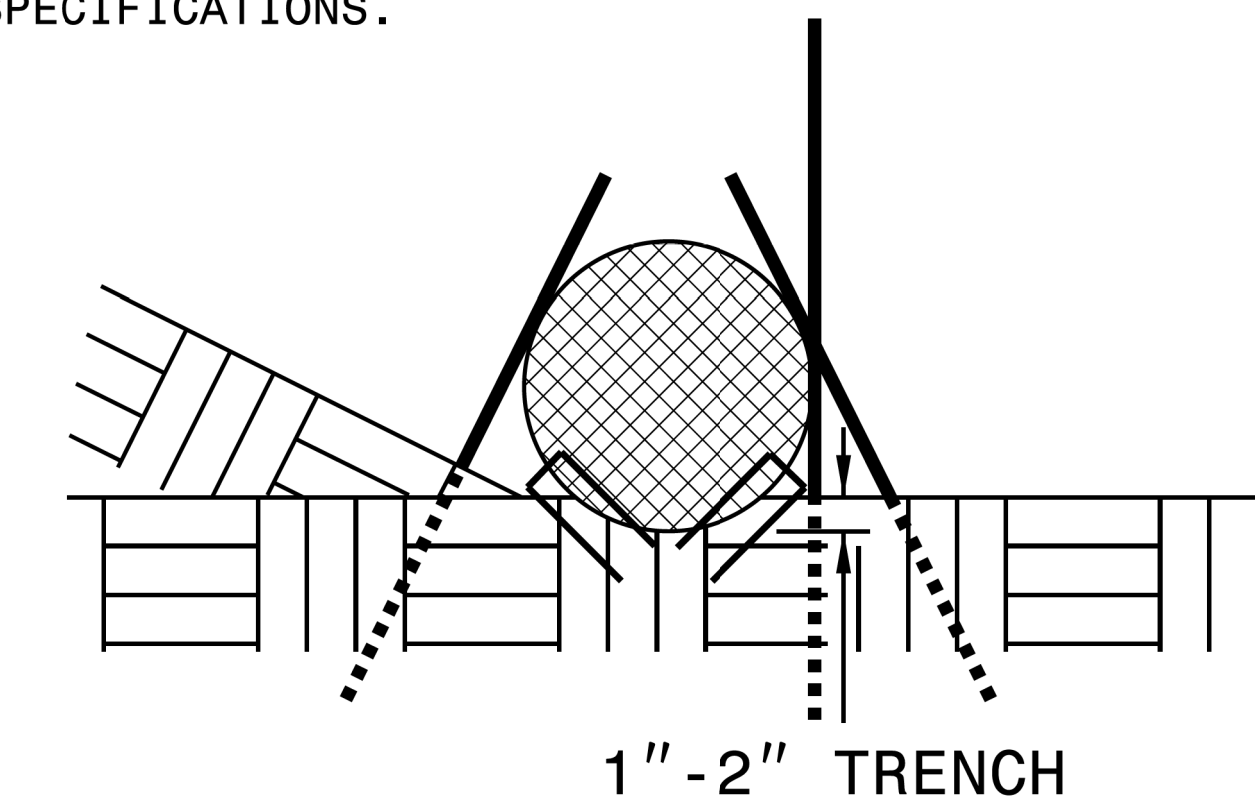

SIDE VIEW

DIVISION OF HIGHWAYS
STATE OF NORTH CAROLINA


SOIL STABILIZATION TIMEFRAMES

<i>SITE DESCRIPTION</i>	<i>STABILIZATION TIME</i>	<i>TIMEFRAME EXCEPTIONS</i>
PERIMETER DIKES, SWALES, DITCHES AND SLOPES	7 DAYS	NONE
HIGH QUALITY WATER (HQW) ZONES	7 DAYS	NONE
SLOPES STEEPER THAN 3:1	7 DAYS	IF SLOPES ARE 10' OR LESS IN LENGTH AND ARE NOT STEEPER THAN 2:1, 14 DAYS ARE ALLOWED.
SLOPES 3:1 OR FLATTER	14 DAYS	7 DAYS FOR SLOPES GREATER THAN 50' IN LENGTH.
ALL OTHER AREAS WITH SLOPES FLATTER THAN 4:1	14 DAYS	NONE, EXCEPT FOR PERIMETERS AND HQW ZONES.


PLAN

HNTB HNTB NORTH CAROLINA, P.C.
343 E. Six Forks Road, Suite 200
Raleigh, North Carolina 27609
NC License No: C-1554

PROJECT REFERENCE NO. <i>BD-5102M</i>	SHEET NO. <i>EC-5</i>
RW SHEET NO.	
ROADWAY DESIGN ENGINEER	HYDRAULICS ENGINEER
BENJAMIN J. HENEGAR, E.I. EROSION CONTROL LEVEL III-A CERTIFICATION #641	

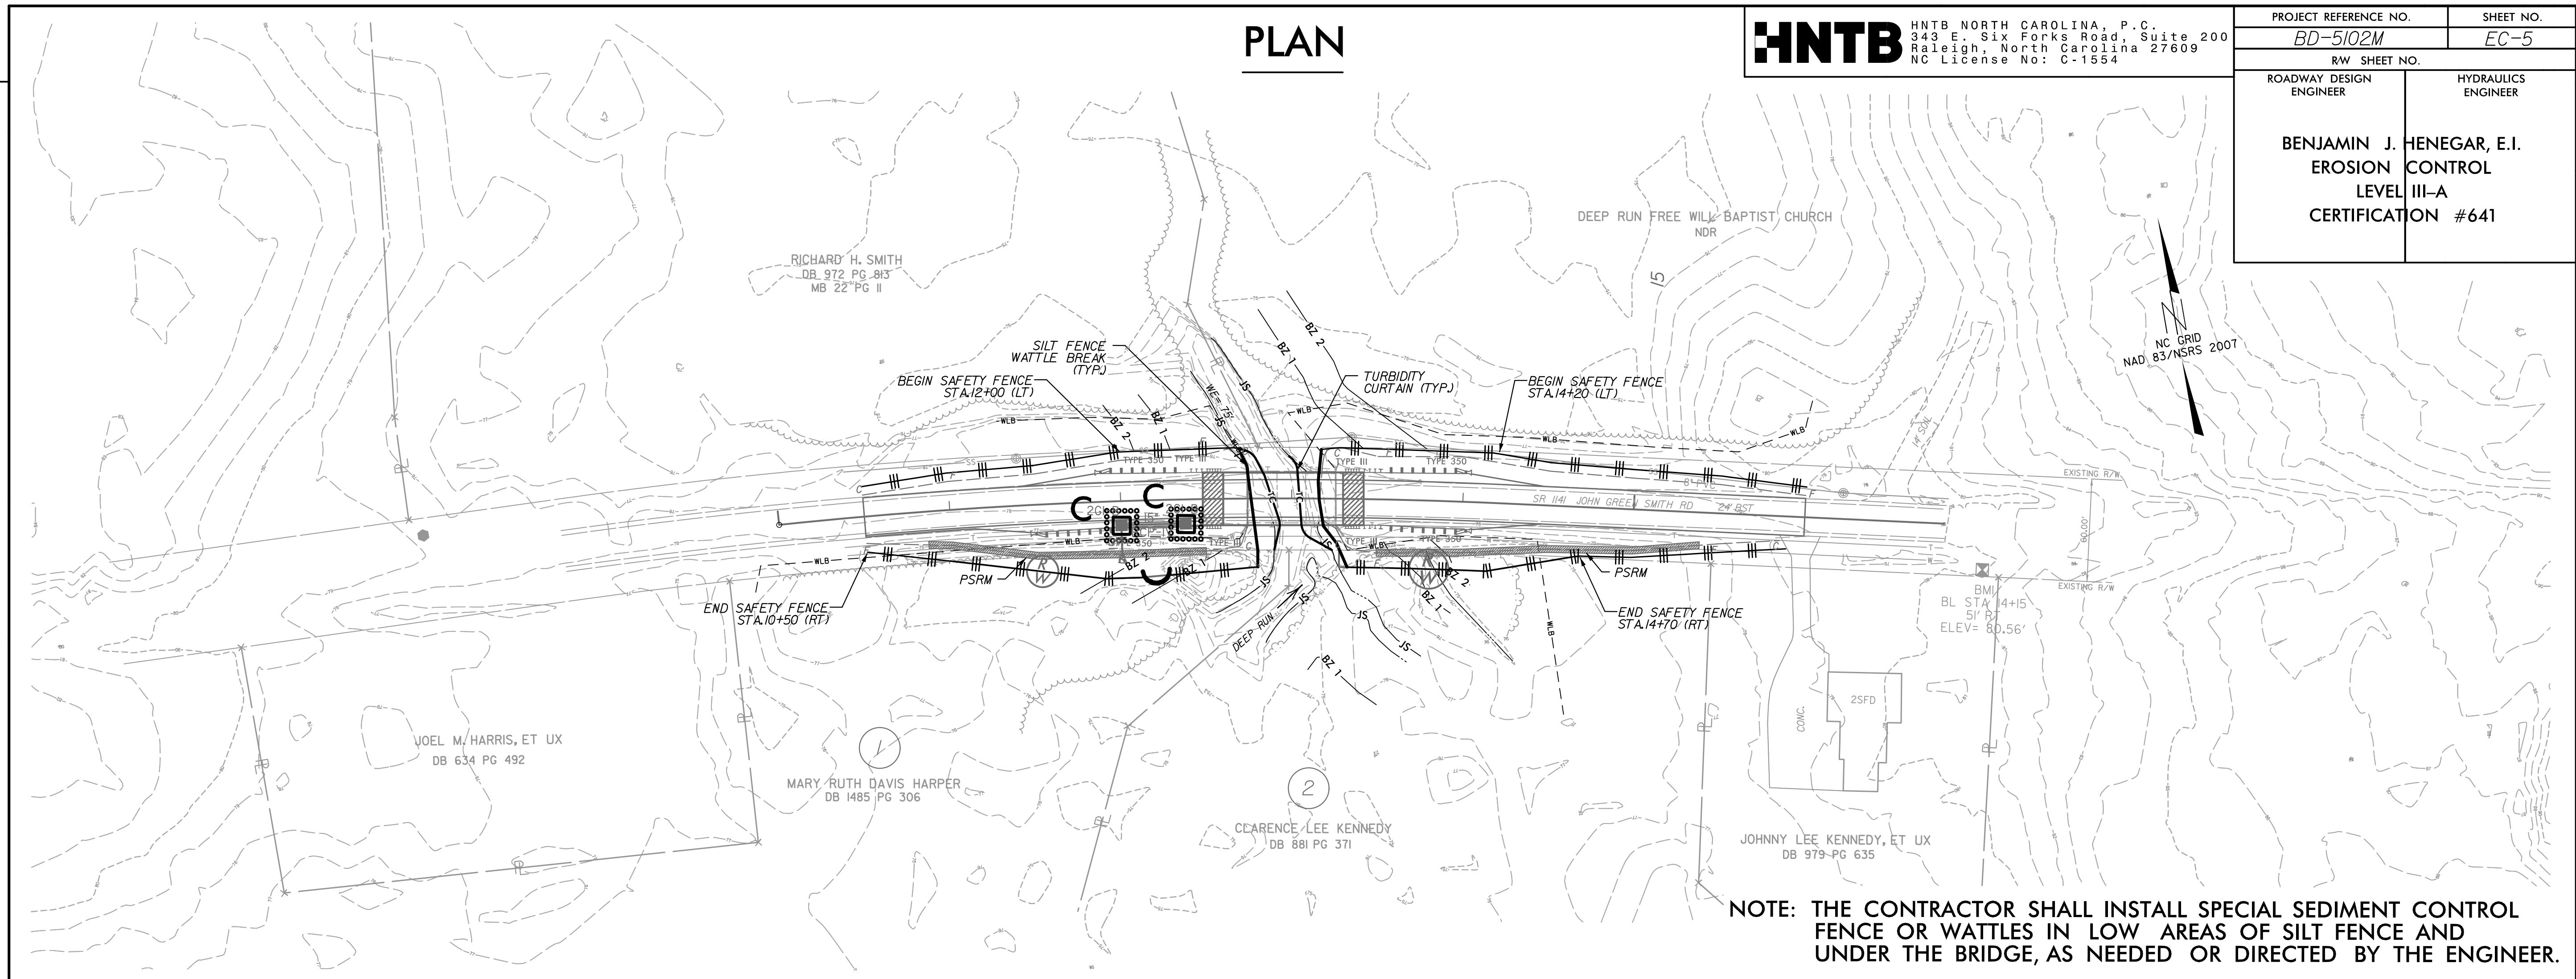


PROFILE

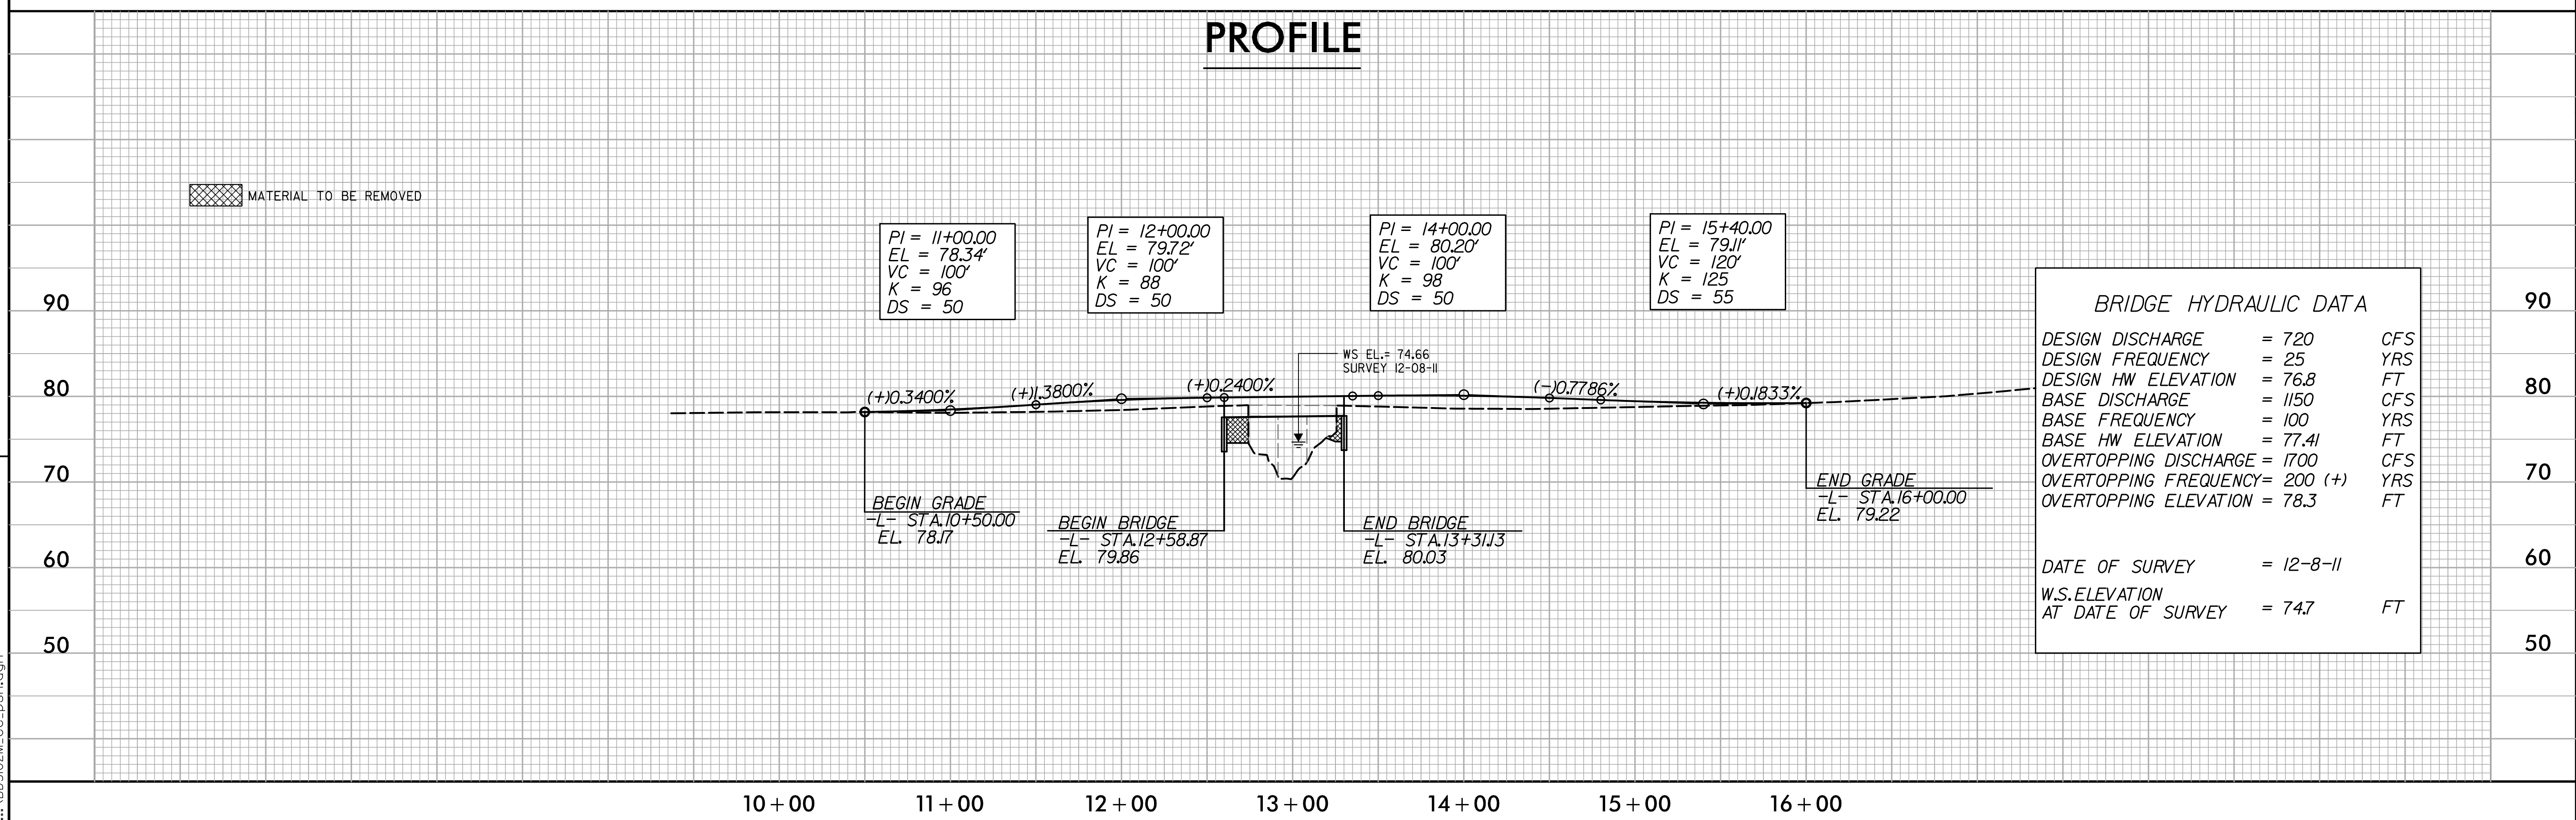

REVISIONS

7/23/2012 2:06:38 PM ...BD5102M.ec.pst.dgn

5/14/99
10:35:47 AM
I:\projects\BD-5102M\hyd\perm_P1.dgn
\$\$\$\$\$

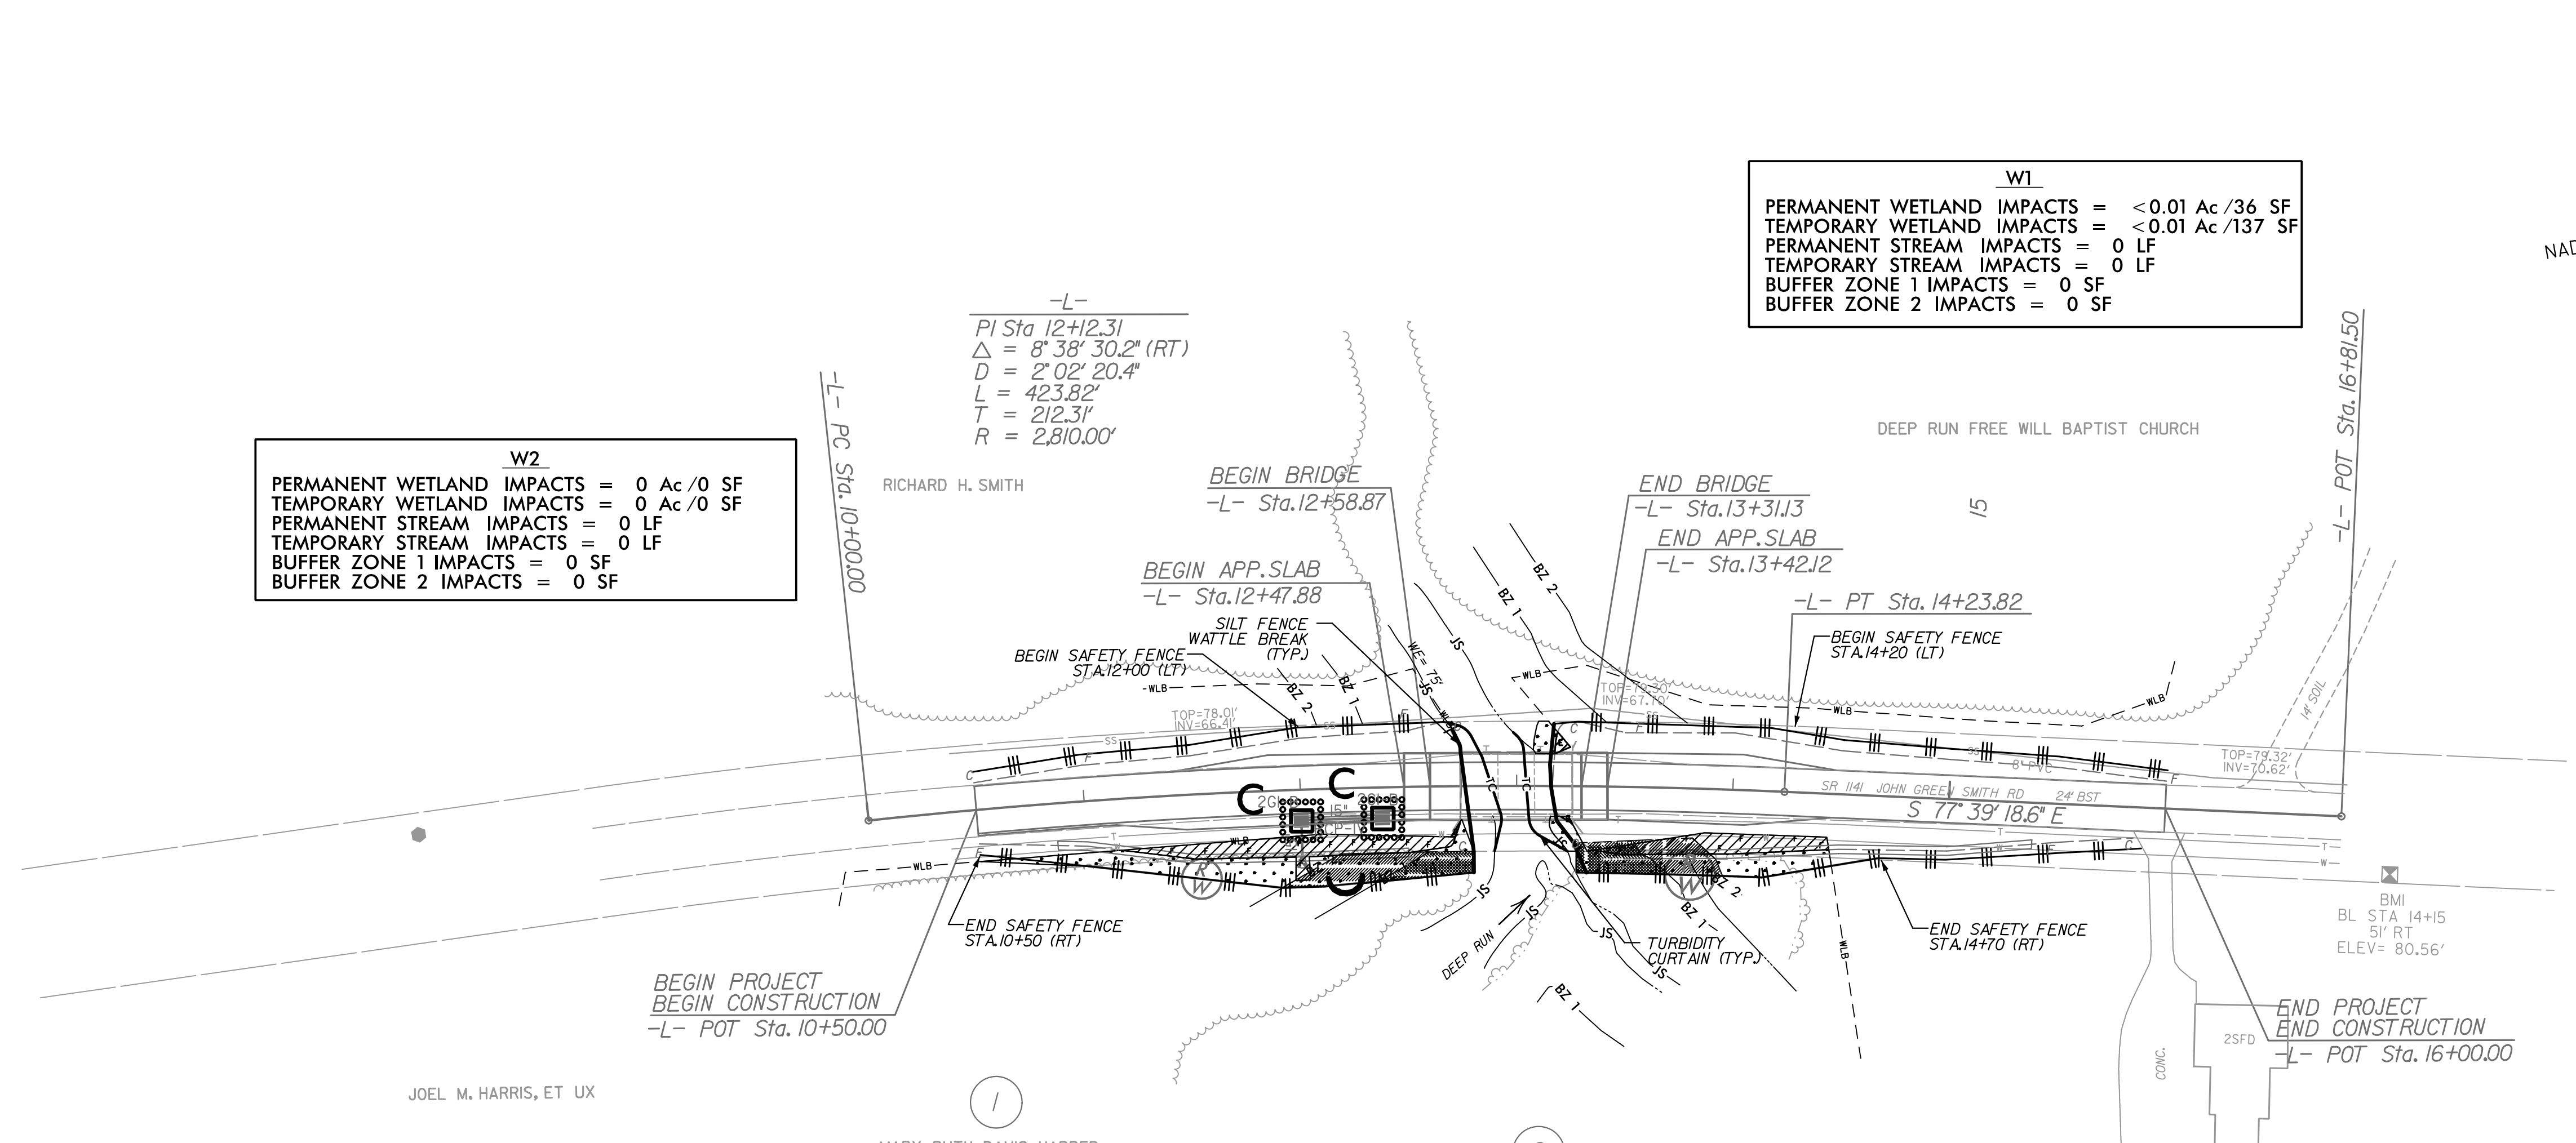

W2
 PERMANENT WETLAND IMPACTS = 0 Ac / 0 SF
 TEMPORARY WETLAND IMPACTS = 0 Ac / 0 SF
 PERMANENT STREAM IMPACTS = 0 LF
 TEMPORARY STREAM IMPACTS = 0 LF
 BUFFER ZONE 1 IMPACTS = 0 SF
 BUFFER ZONE 2 IMPACTS = 0 SF

W1
 PERMANENT WETLAND IMPACTS = <0.01 Ac / 36 SF
 TEMPORARY WETLAND IMPACTS = <0.01 Ac / 137 SF
 PERMANENT STREAM IMPACTS = 0 LF
 TEMPORARY STREAM IMPACTS = 0 LF
 BUFFER ZONE 1 IMPACTS = 0 SF
 BUFFER ZONE 2 IMPACTS = 0 SF

W3
 PERMANENT WETLAND IMPACTS = 0.03 Ac / 1173 SF
 TEMPORARY WETLAND IMPACTS = 0.05 Ac / 2180 SF
 PERMANENT STREAM IMPACTS = 0 LF
 TEMPORARY STREAM IMPACTS = 0 LF
 BUFFER ZONE 1 IMPACTS = 351 SF
 BUFFER ZONE 2 IMPACTS = 594 SF

W4
 PERMANENT WETLAND IMPACTS = 0.02 Ac / 750 SF
 TEMPORARY WETLAND IMPACTS = 0.03 Ac / 1295 SF
 PERMANENT STREAM IMPACTS = 0 LF
 TEMPORARY STREAM IMPACTS = 0 LF
 BUFFER ZONE 1 IMPACTS = 489 SF
 BUFFER ZONE 2 IMPACTS = 480 SF

IMPACT SUMMARY:
 404 WETLAND IMPACTS = 0.13 AC
 STREAM IMPACTS = 0 FT.
 BUFFER ZONE 1 IMPACT = 840 SQ FT.
 BUFFER ZONE 2 IMPACT = 1074 SQ FT.


- LEGEND**
- ALLOWABLE IMPACTS ZONE 1
 - ALLOWABLE IMPACTS ZONE 2
 - DENOTES FILL IN WETLAND
 - DENOTES MECHANIZED CLEARING
 - DENOTES EXCAVATION IN WETLAND

NCDOT
 BD-5102M LENOIR COUNTY
 REPLACE BRIDGE NO. 0032
 SR 1141 (JOHN GREEN SMITH RD.)
 OVER DEEP RUN
 BETWEEN NC HWY 11
 AND NC HWY 258

SCALE: 1" = 50'
 JULY 24, 2012
 FOR PERMITTING ONLY:
 NOT FOR CONSTRUCTION

02/03/98


PROJ. REFERENCE NO.	SHEET NO.	TOTAL SHEETS
BD-5102M	X-2	4

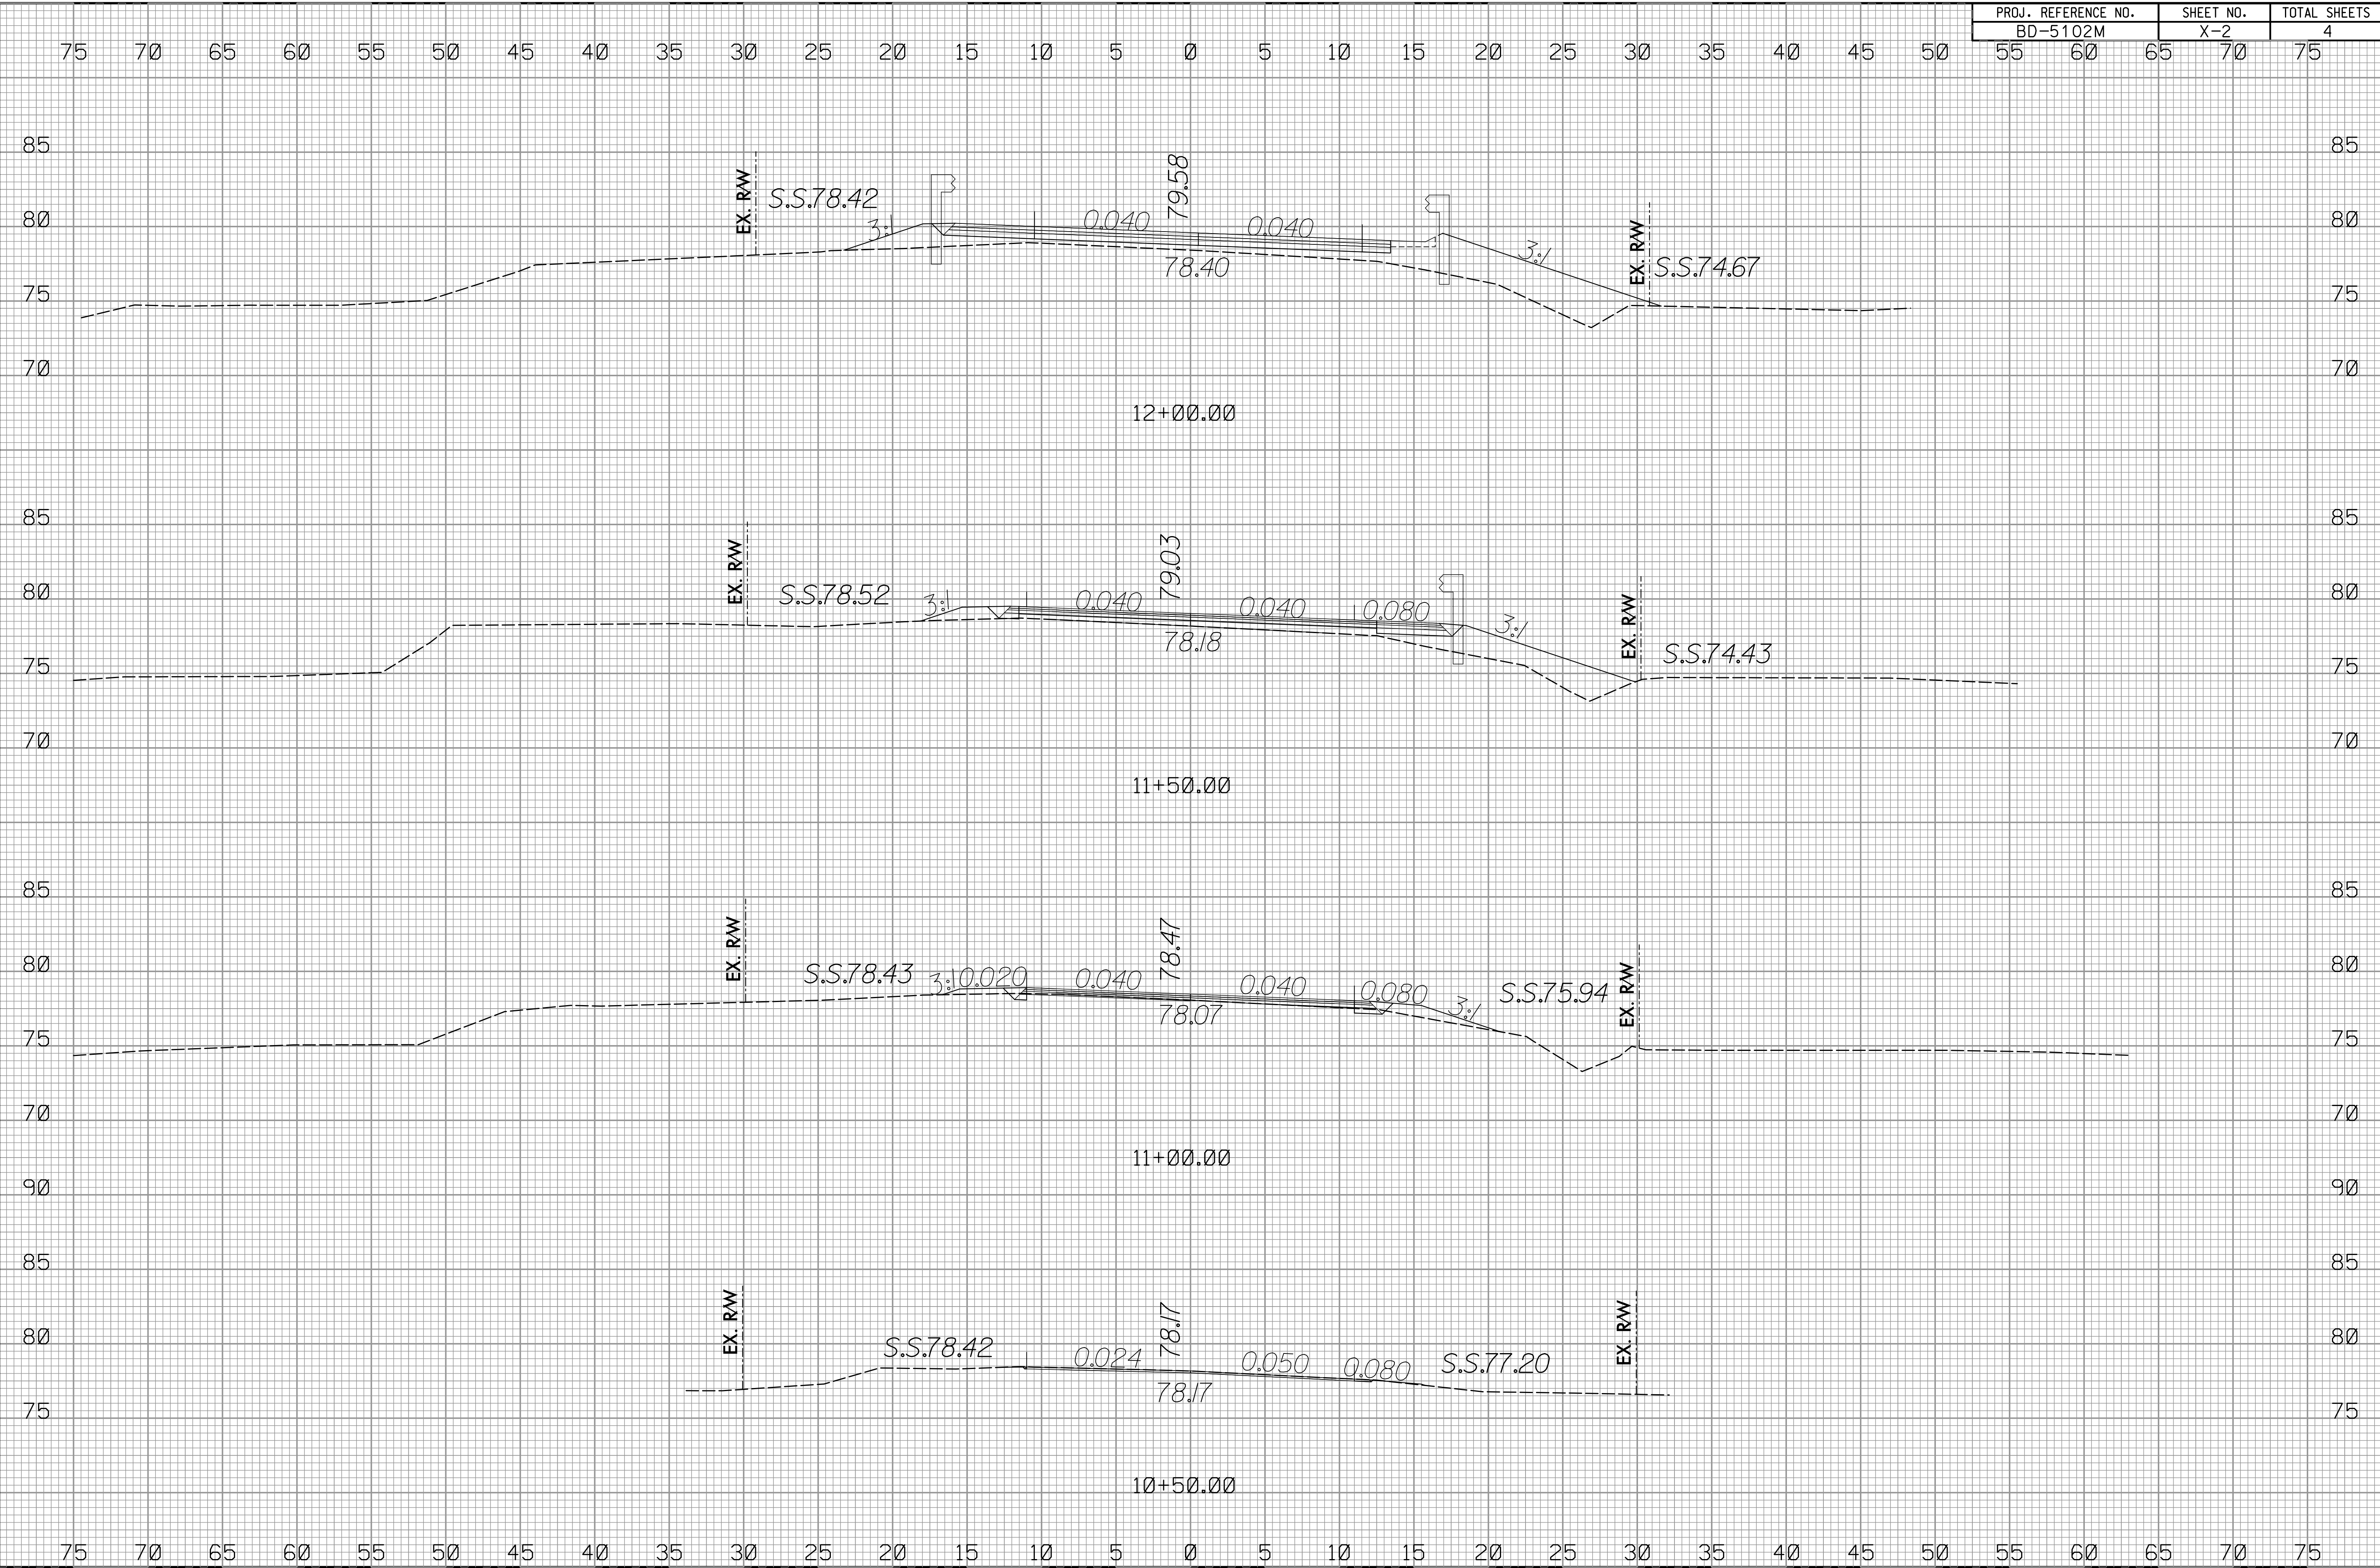

DATE: 02/03/98
DRAWN BY: [illegible]
CHECKED BY: [illegible]
SCALE: [illegible]

02/03/98


PROJ. REFERENCE NO.	SHEET NO.	TOTAL SHEETS
BD-5102M	X-3	4

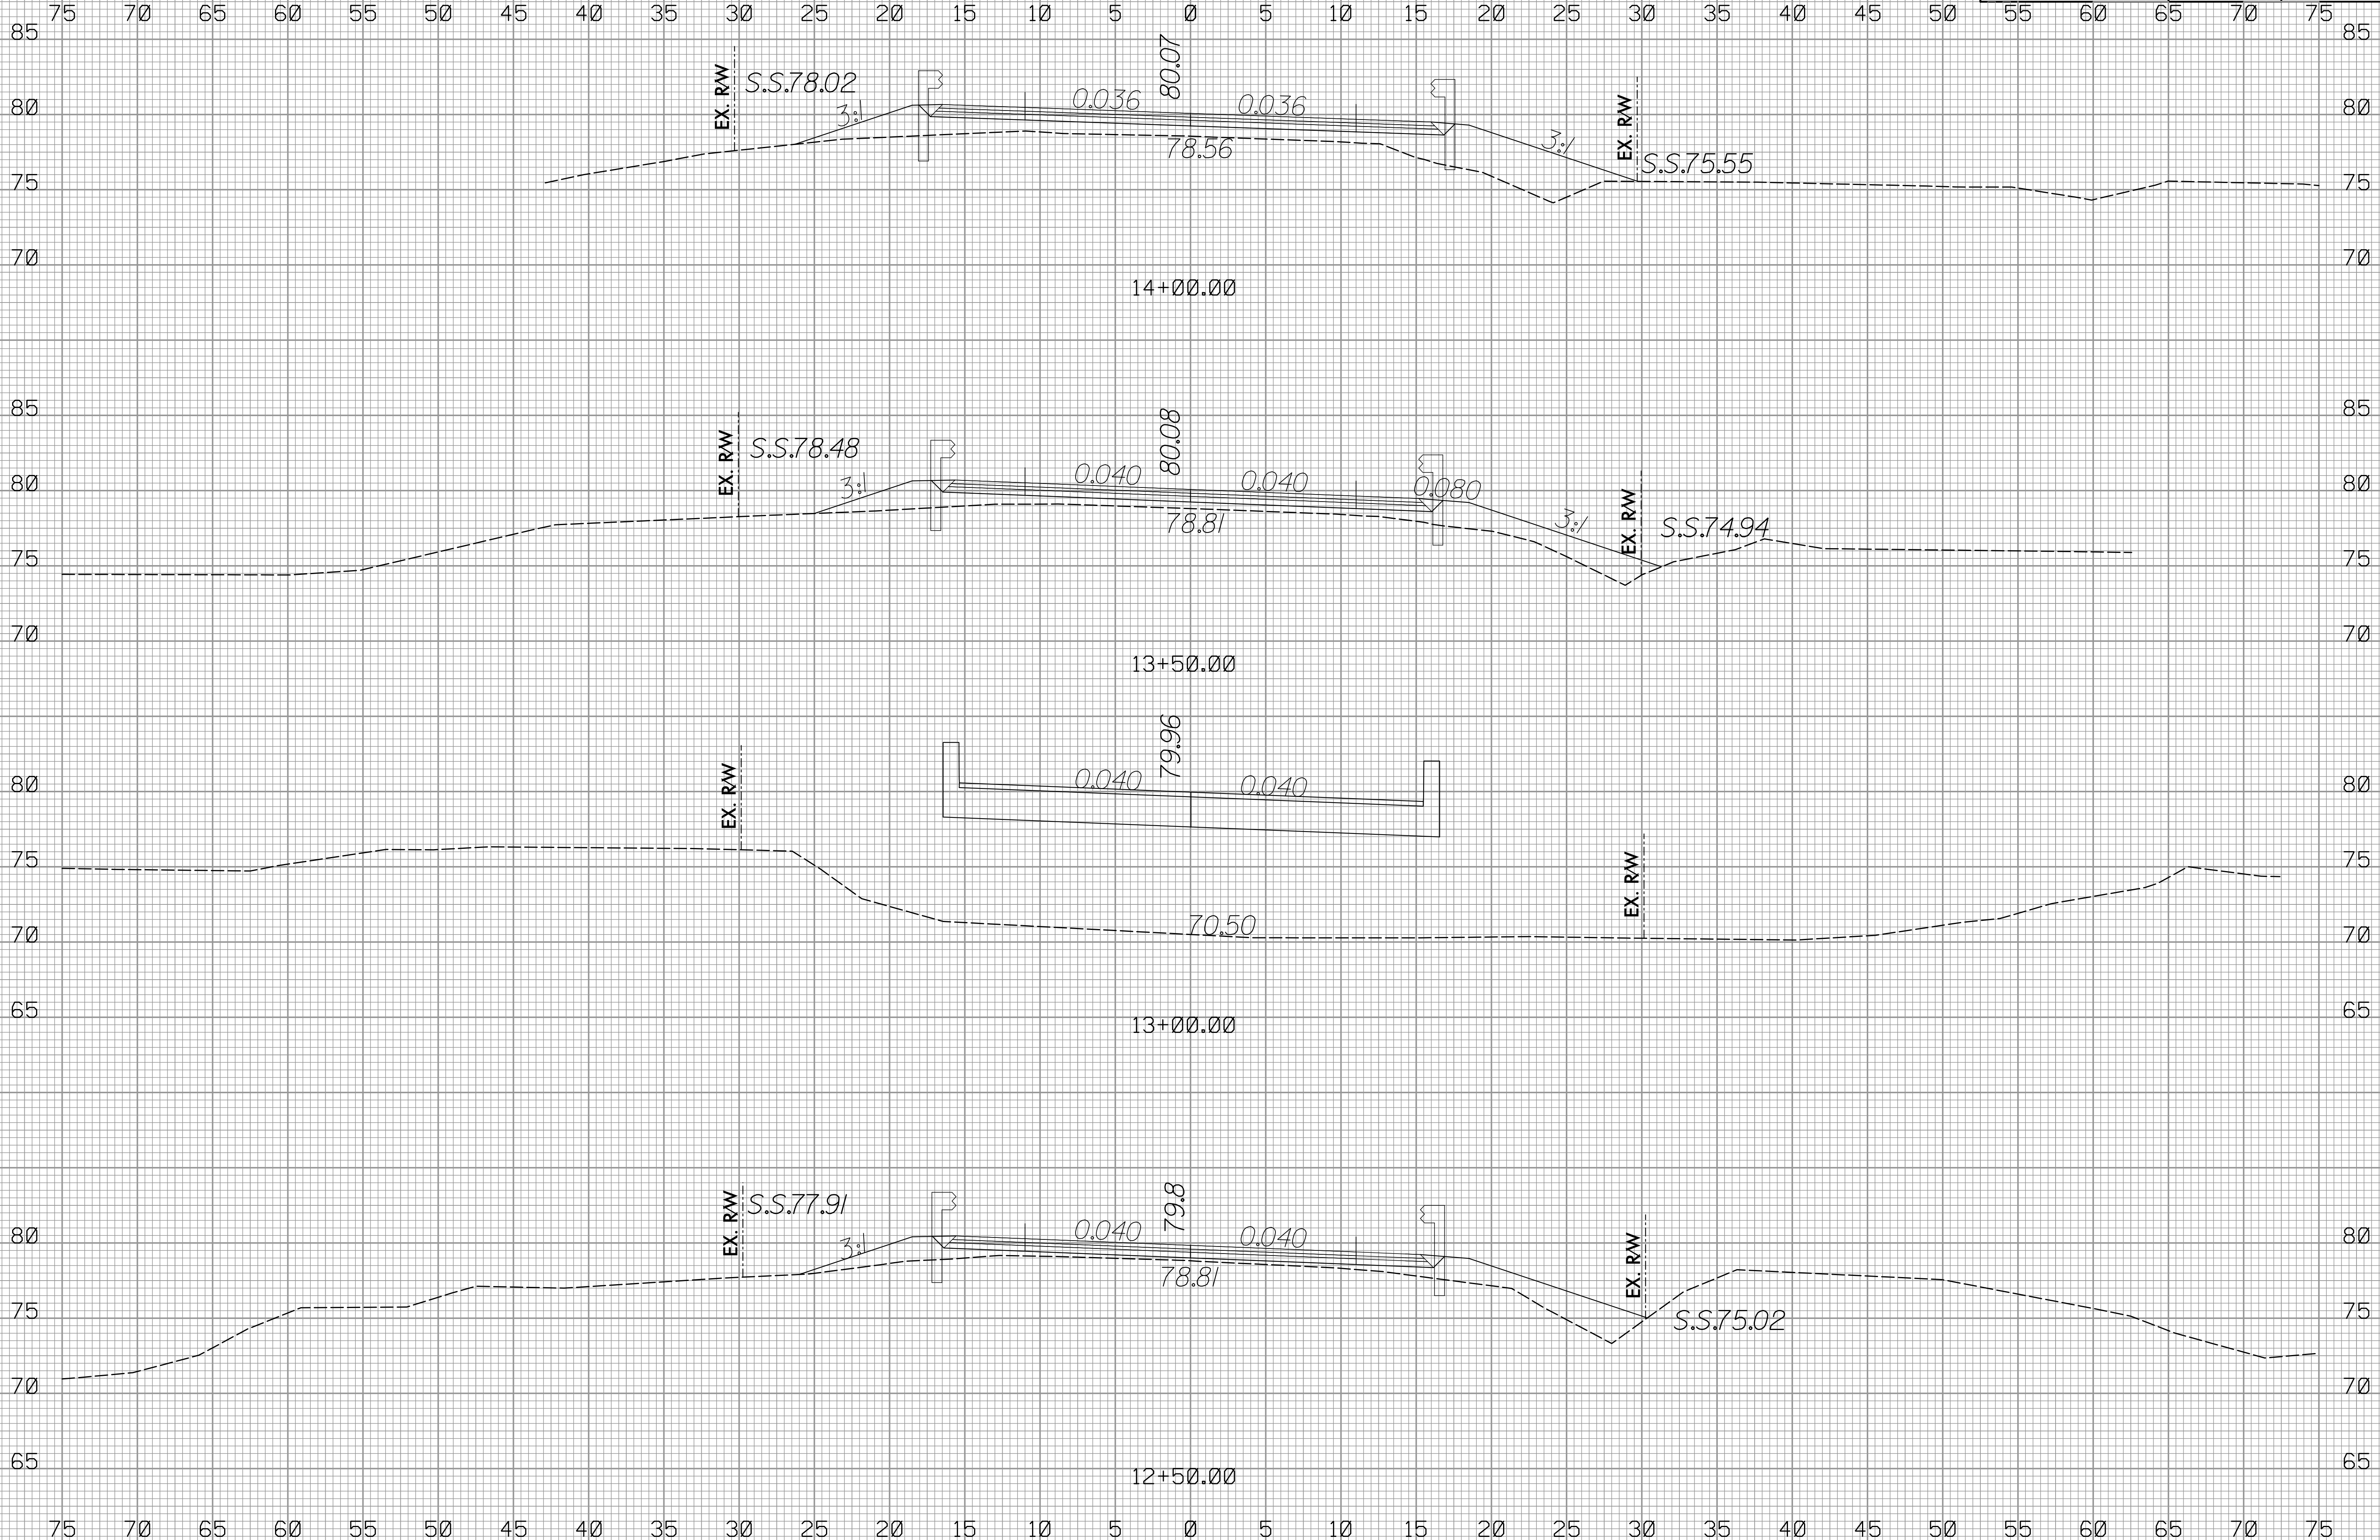


DATE: 02/03/98
DRAWN BY: [illegible]
CHECKED BY: [illegible]
SCALE: [illegible]

02/03/98

PROJ. REFERENCE NO.	SHEET NO.	TOTAL SHEETS
BD-5102M	X-4	4

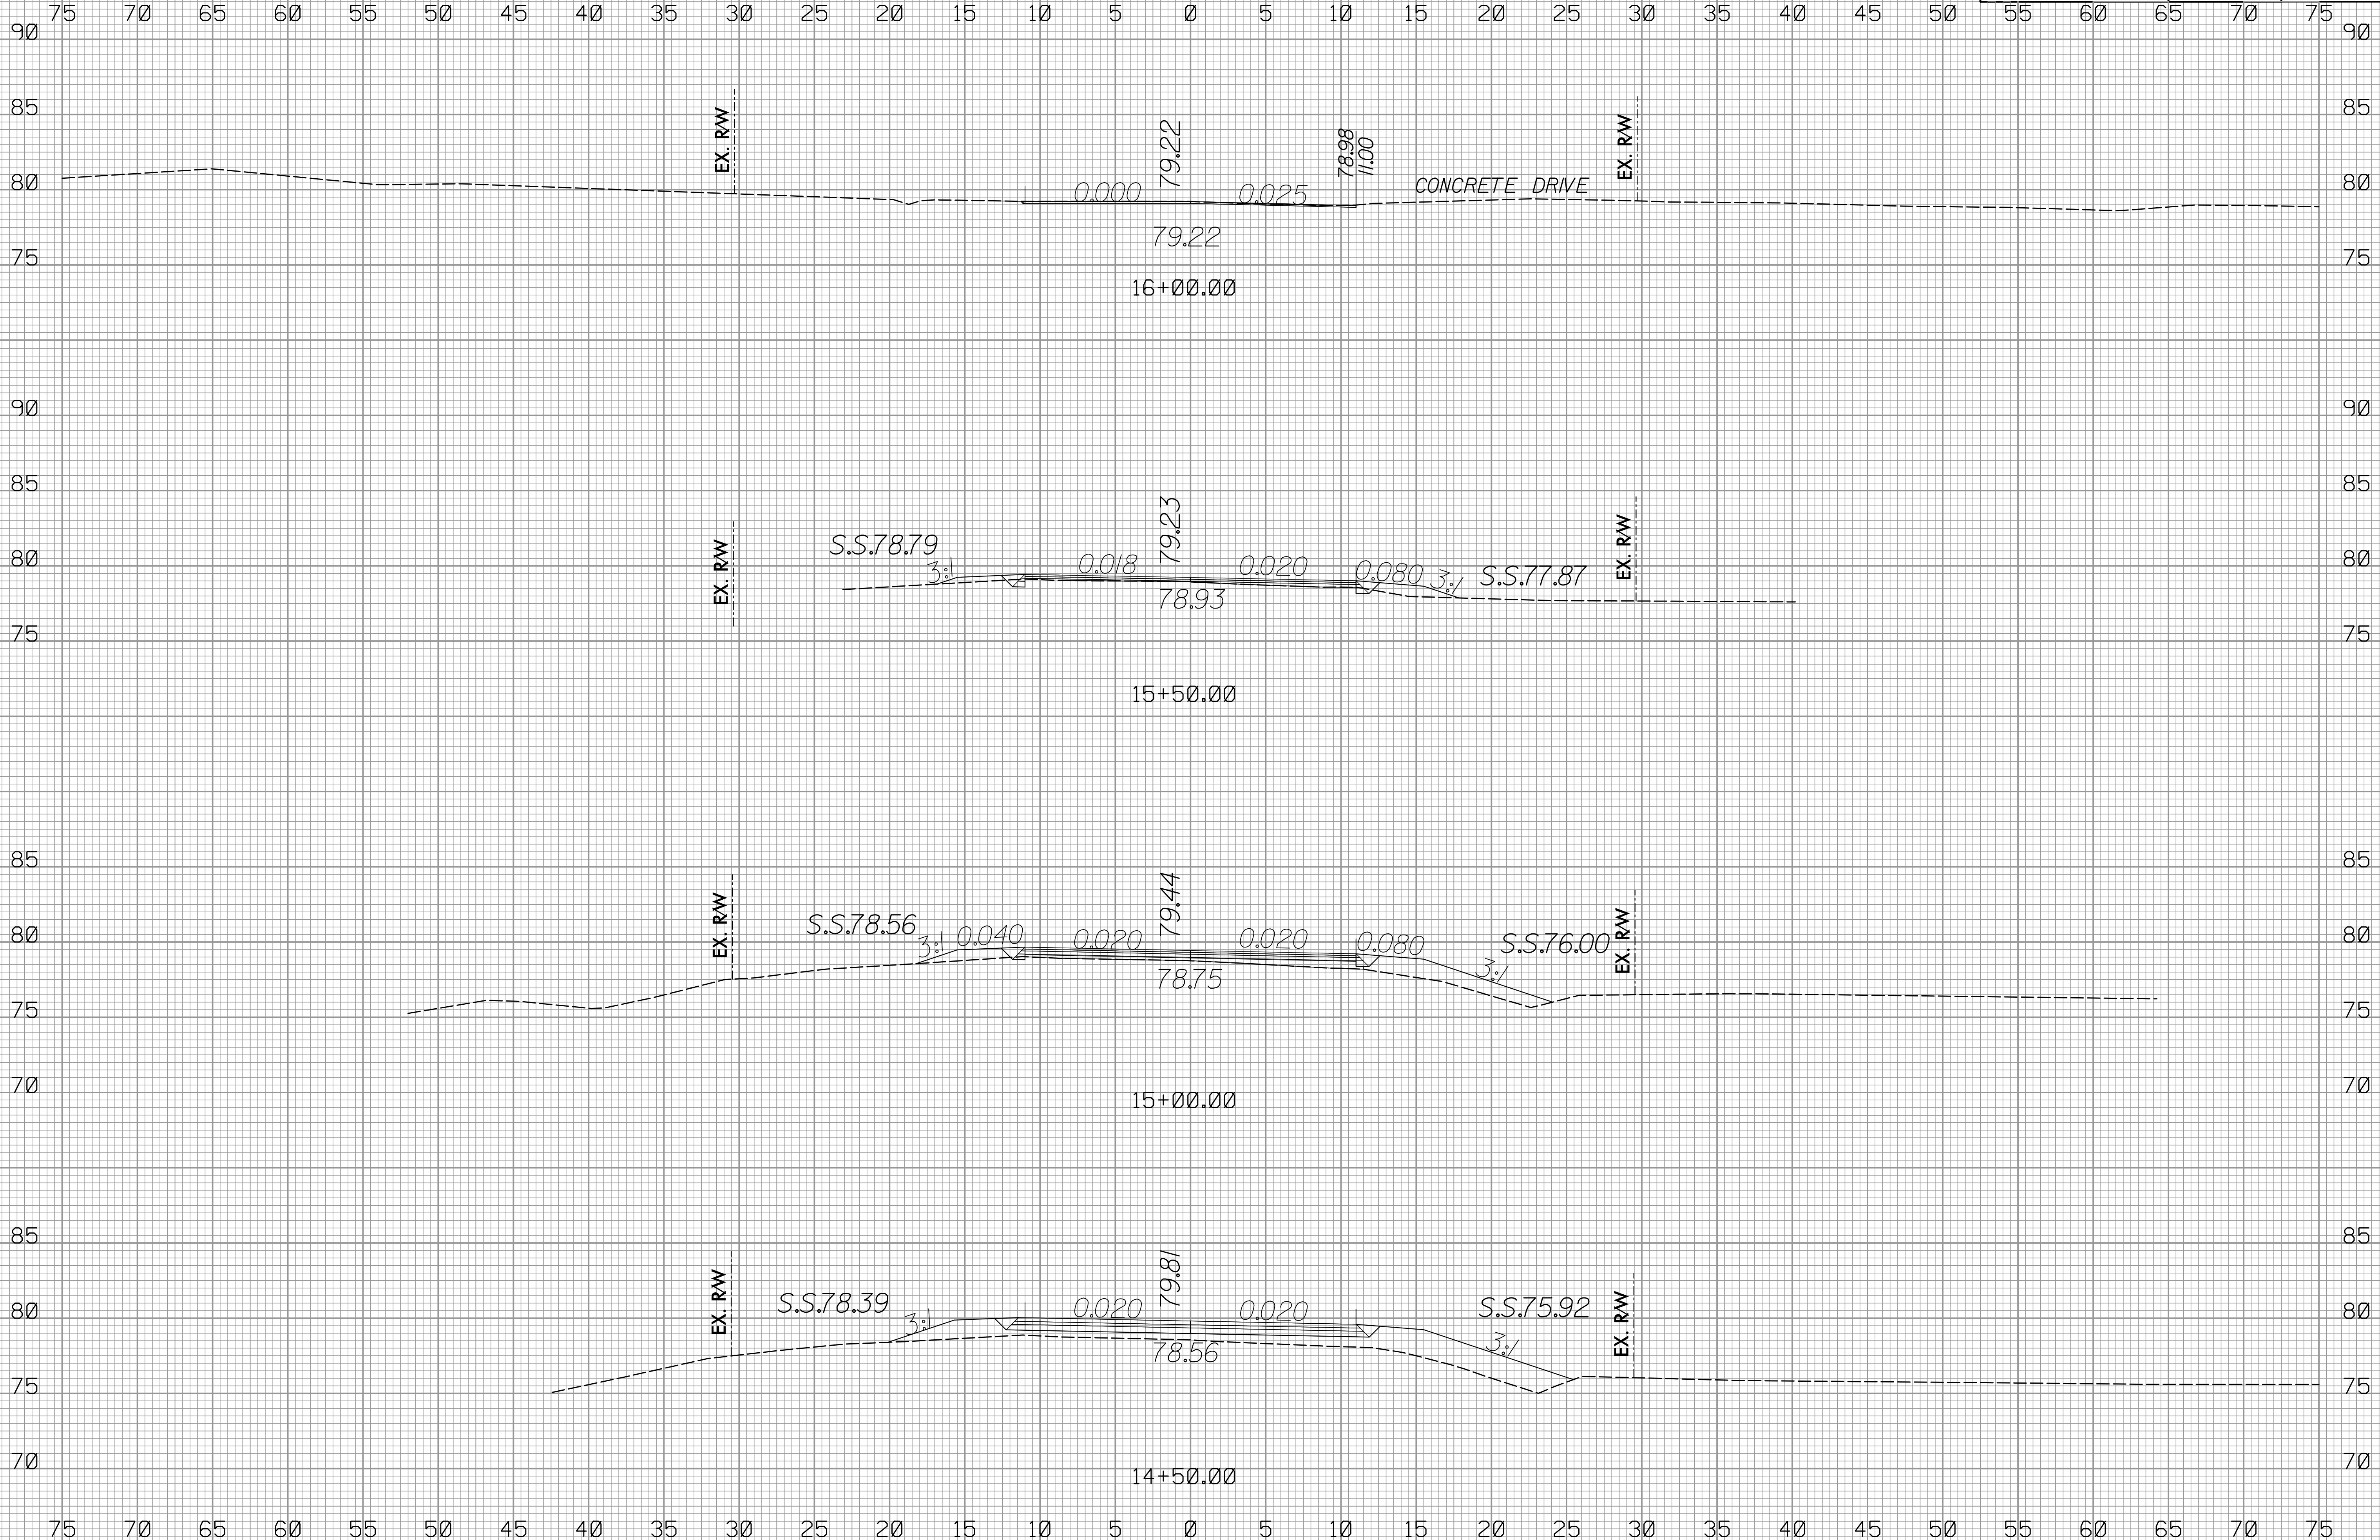

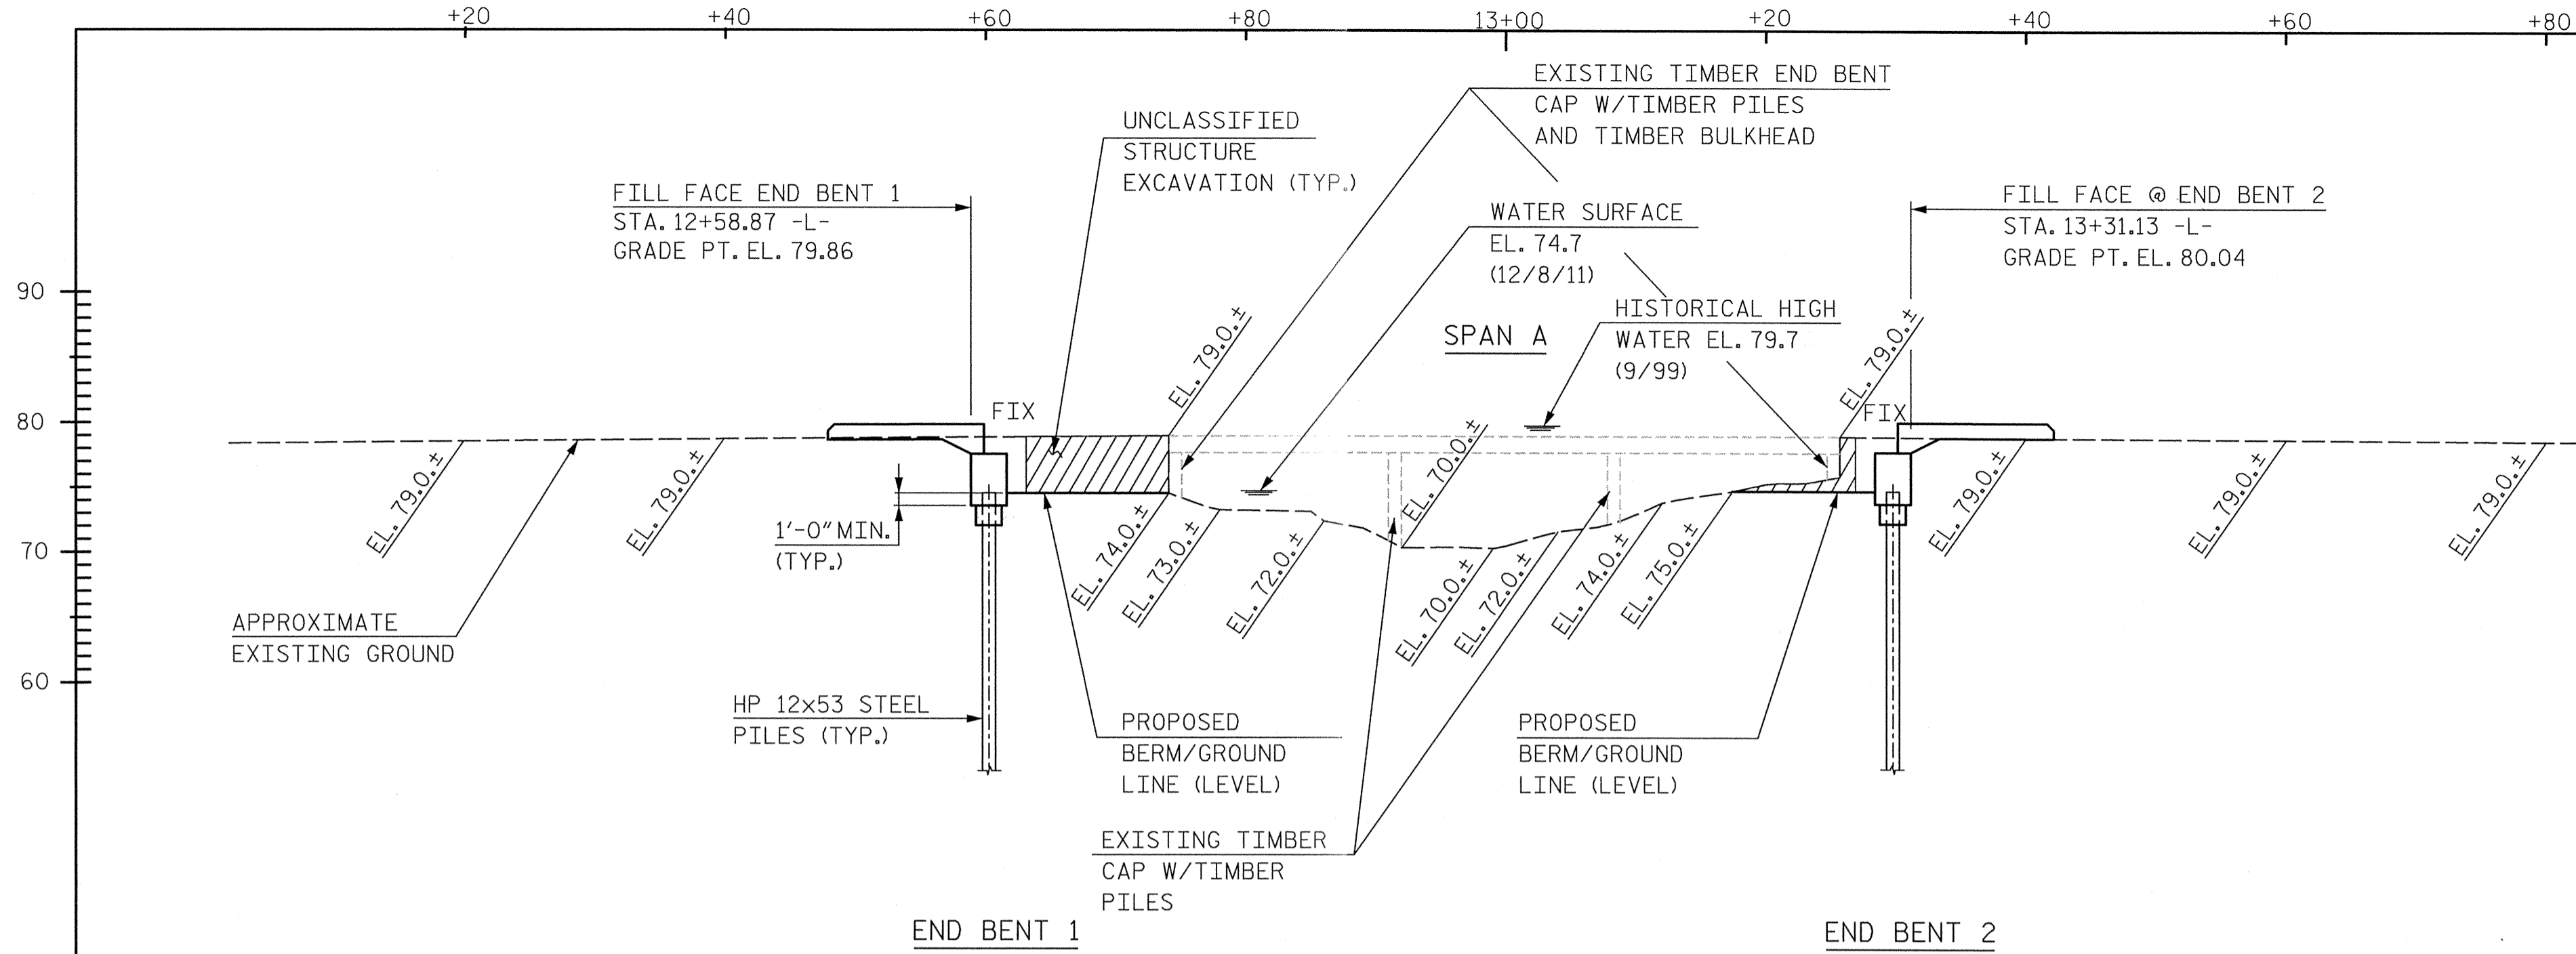

BRIDGE HYDRAULIC DATA


DESIGN DISCHARGE	=	720 CFS
FREQUENCY OF DESIGN FLOOD	=	25 YR
DESIGN HIGH WATER ELEVATION	=	76.8 FT.
DRAINAGE AREA	=	6.30 SQ. MI.
BASIC DISCHARGE (Q100)	=	1150 CFS
BASIC HIGH WATER ELEVATION	=	77.41 FT.

OVERTOPPING FLOOD DATA

OVERTOPPING DISCHARGE	=	1700 CFS
FREQUENCY OF OVERTOPPING FLOOD	=	200 YR +
OVERTOPPING FLOOD ELEVATION	=	78.3 FT.

NOTE: OVERTOPPING OCCURS AT ROADWAY STA. 9+10±.

PI STA. = 12+00.00	PI STA. = 14+00.00
ELEV = 79.72	ELEV = 80.20
V.C. = 100'	V.C. = 100'

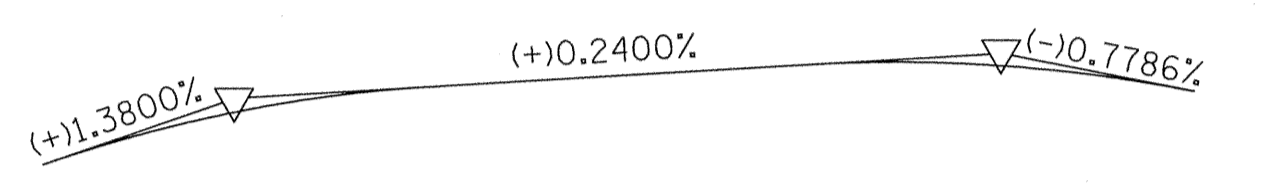

PI STA. = 12+12.31

$\Delta = 8^{\circ}38'30.2''$ (RT)

D = $2^{\circ}02'20.4''$

L = 423.82'


T = 212.31'

R = 2,810.00'

SE = .04

CURVE DATA -L-

I HEREBY CERTIFY THESE PLANS ARE AS-BUILT PLANS

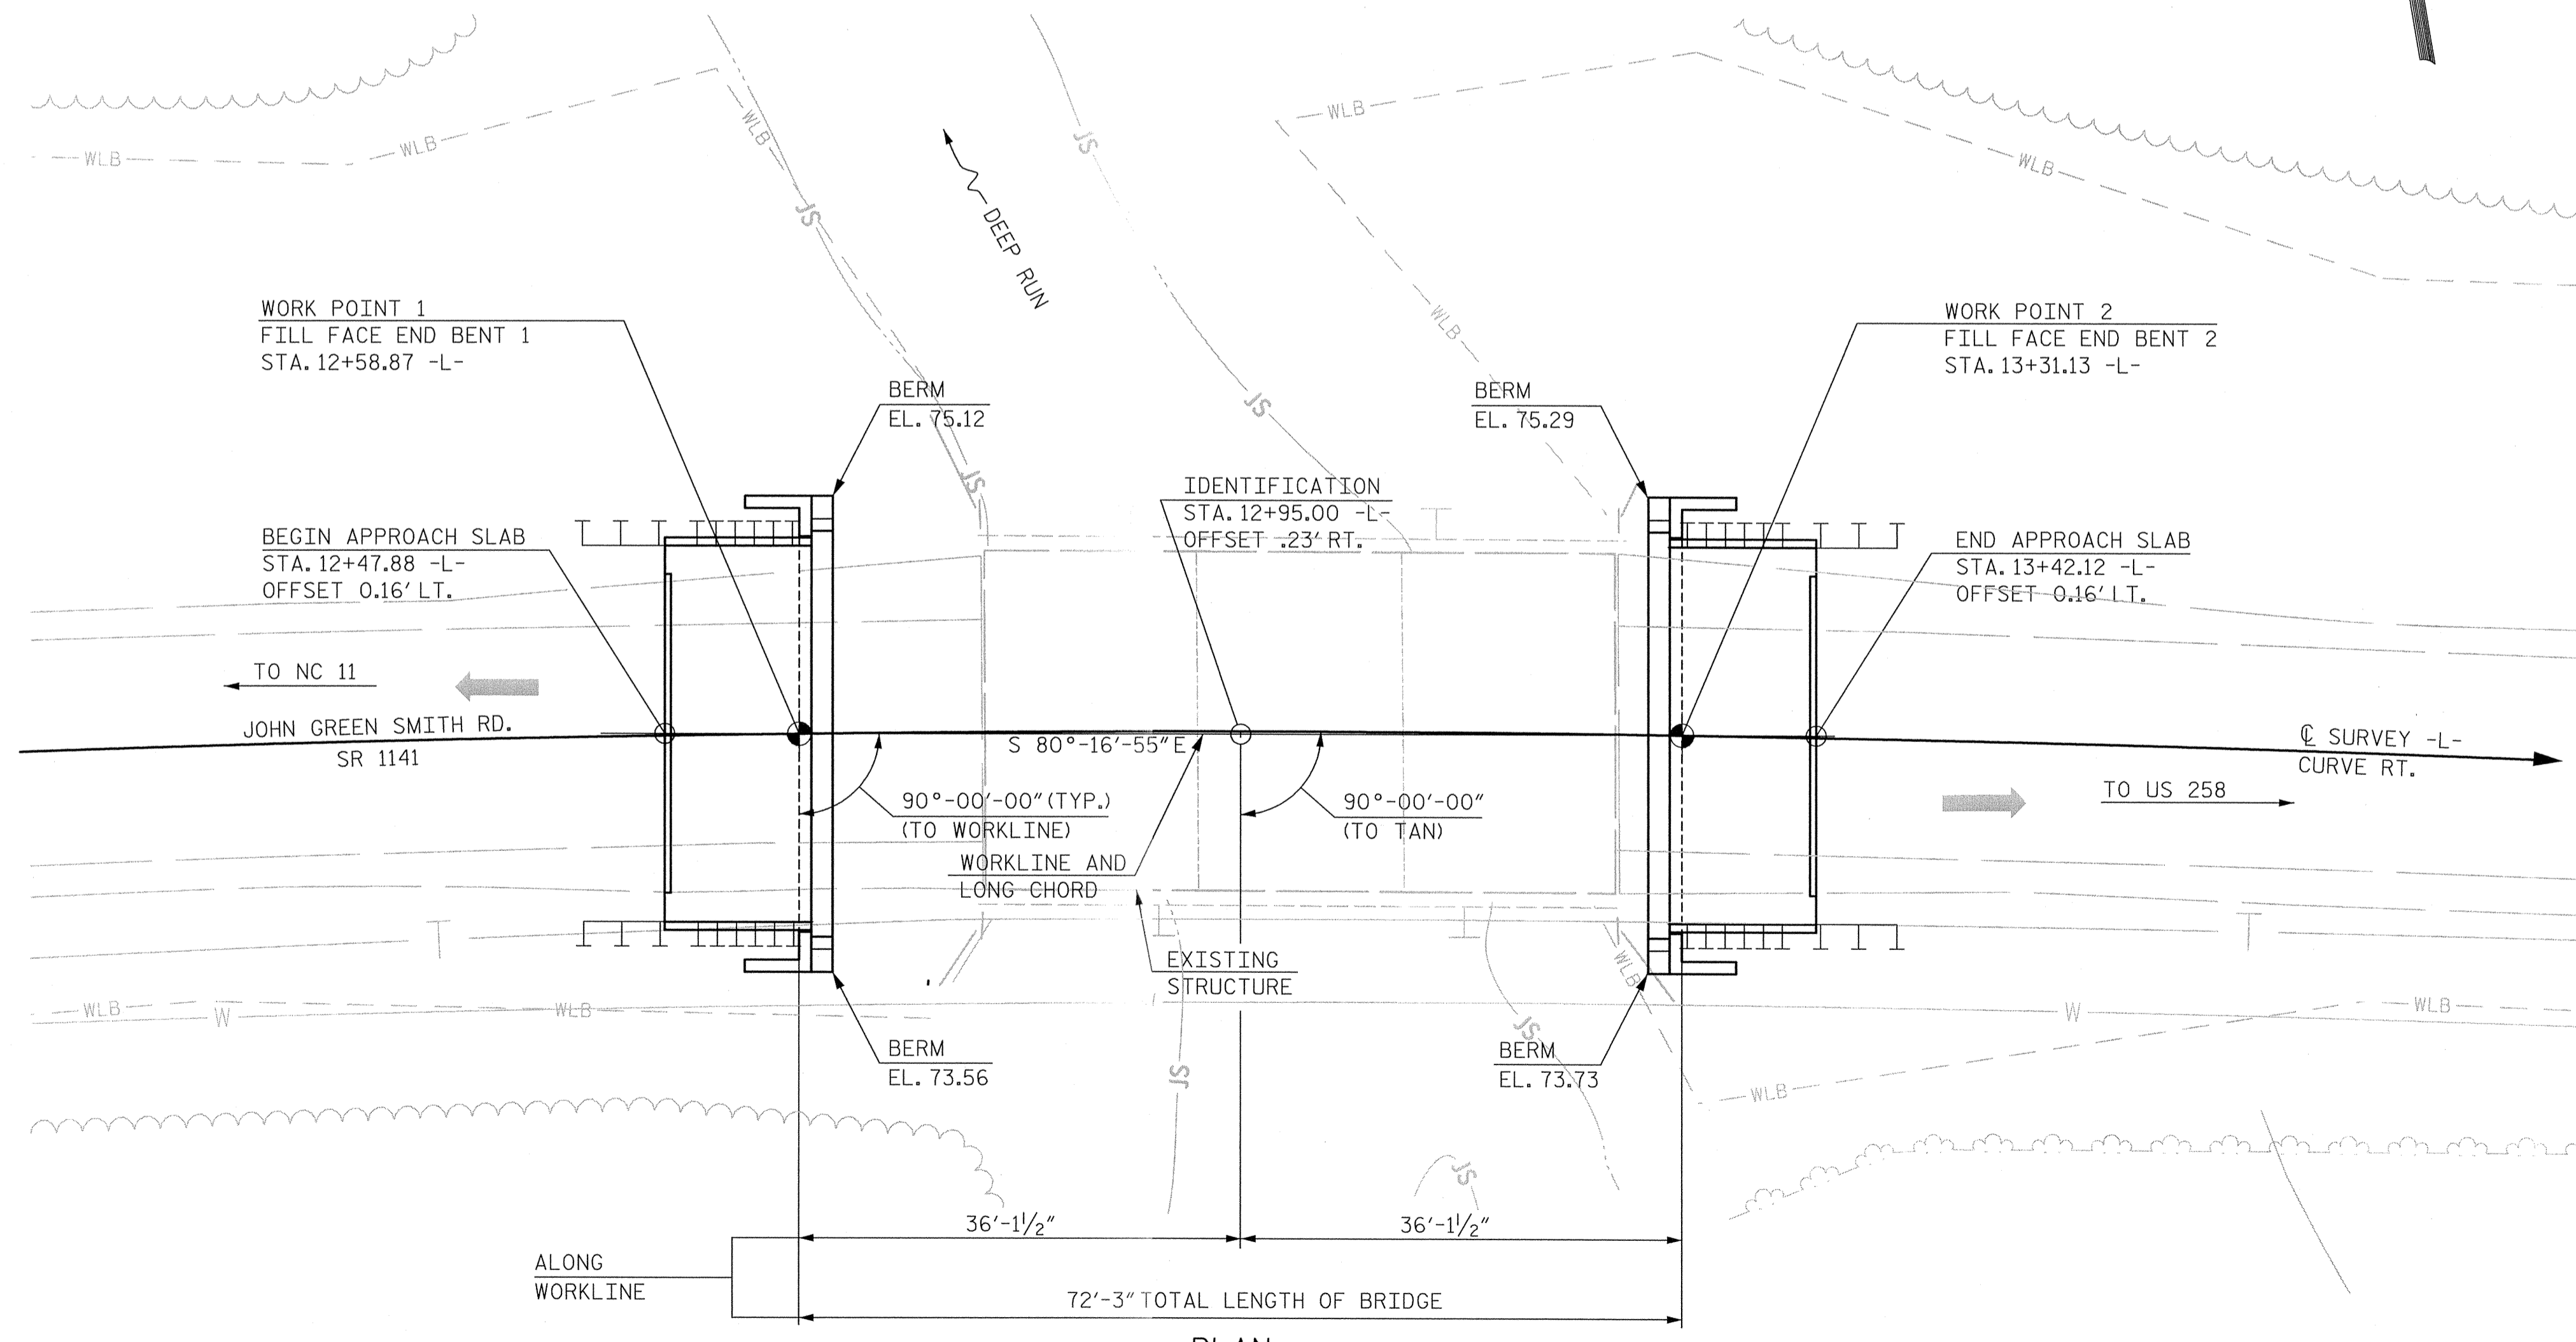

NOTES: SUBSTRUCTURE UNITS ARE PARALLEL.
 PILES NOT SHOWN FOR CLARITY.
 WORKLINE FOR BRIDGE SHALL BE THE ROADWAY LONG CHORD BETWEEN FILL FACE WORK POINTS AND ITS EXTENSION.

PROJECT NO. BD-5102M
LENOIR COUNTY
 STATION: 12+95.00 -L-

SHEET 1 OF 2 REPLACES BRIDGE NO. 32

STATE OF NORTH CAROLINA
 DEPARTMENT OF TRANSPORTATION
 RALEIGH
 GENERAL DRAWING
 FOR BRIDGE ON SR 1141
 OVER DEEP RUN
 BETWEEN NC 11
 AND US 258

HNTB HNTB NORTH CAROLINA, P.C.
 NC License No. C-1554
 343 E. Six Forks Rd., Suite 200, Raleigh, N.C. 27609


DRAWN BY: J. BAYNE DATE: 5/12
 CHECKED BY: P. BARBER DATE: 5/12

DWG. NO. 1

REVISIONS					
NO.	BY	DATE	NO.	BY	DATE
1			3		
2			4		

SHEET NO. **S-1**
 TOTAL SHEETS **12**

BM - BASELINE CAP "BL-3", STA. 14+49.01 -BL-, ELEV 81.14

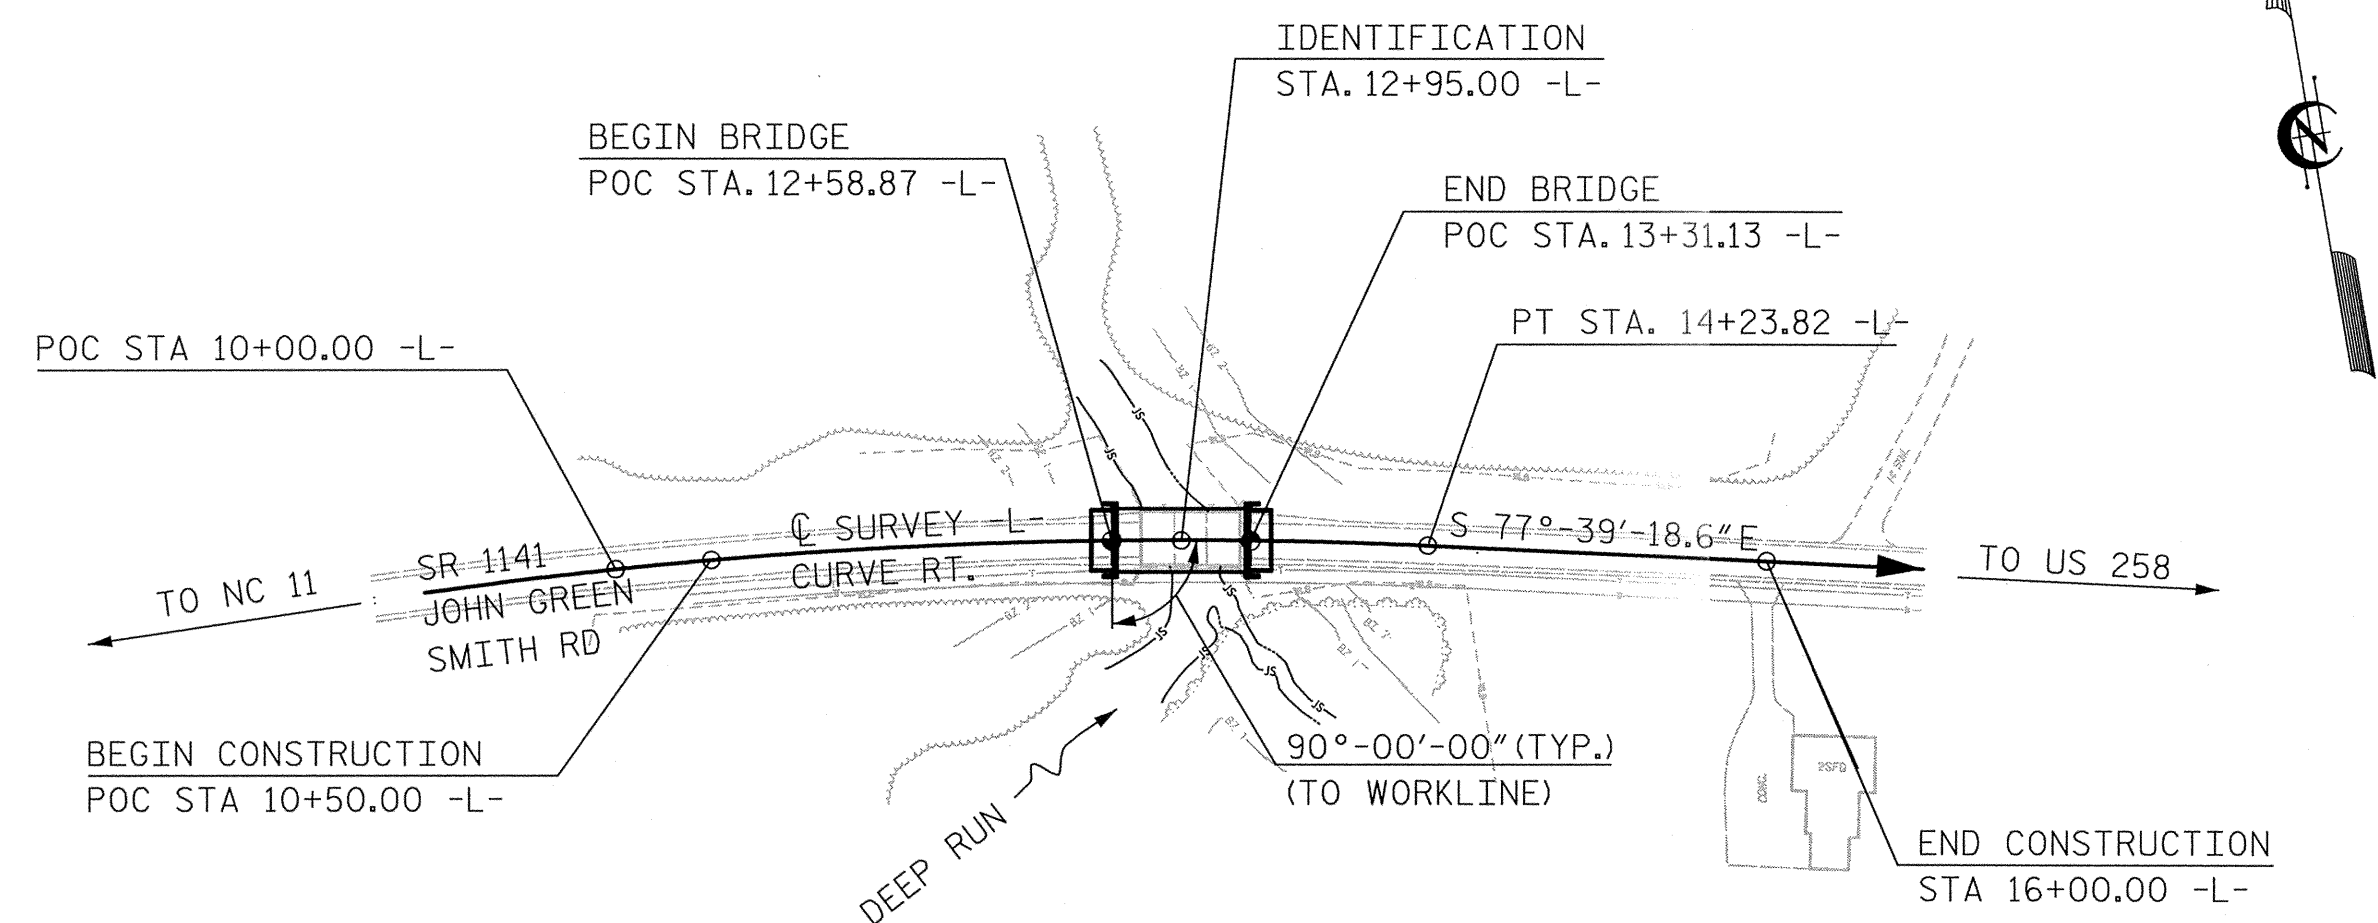

LOCATION SKETCH
FOR UTILITY INFORMATION, SEE UTILITY PLANS AND SPECIAL PROVISIONS.

FOUNDATION NOTES:

FOR PILES, SEE SECTION 450 OF THE STANDARD SPECIFICATIONS.

PILES AT END BENT NO. 1 AND END BENT NO. 2 ARE DESIGNED FOR A FACTORED RESISTANCE OF 85 TONS PER PILE.

DRIVE PILES AT END BENT NO. 1 AND END BENT NO. 2 TO A REQUIRED DRIVING RESISTANCE OF 145 TONS PER PILE.

IT HAS BEEN ESTIMATED THAT A HAMMER WITH AN EQUIVALENT RATED ENERGY IN THE RANGE OF 30 TO 50 FT-KIPS PER BLOW WILL BE REQUIRED TO DRIVE PILES AT END BENT NO. 1 AND END BENT NO. 2. THIS ESTIMATED ENERGY RANGE DOES NOT RELEASE THE CONTRACTOR FROM PROVIDING DRIVING EQUIPMENT IN ACCORDANCE WITH SUBARTICLE 450-3(D)(2) OF THE STANDARD SPECIFICATIONS.

TOTAL BILL OF MATERIAL

	REMOVAL OF EXISTING STRUCTURE AT STATION 12+95.00 -L-	UNCLASSIFIED STRUCTURE EXCAVATION AT STATION 12+95.00 -L-	CLASS A CONCRETE	BRIDGE APPROACH SLABS AT STATION 12+95.00 -L-	REINFORCING STEEL	HP 12x53 STEEL PILES		PILE REDRIVES	VERTICAL CONCRETE BARRIER RAIL	ELASTOMERIC BEARINGS	3'-0"x2'-0" PRESTRESSED CONCRETE CORED SLABS	
	LUMP SUM	LUMP SUM	CU. YDS.	LUMP SUM	LBS.	NO.	LIN. FT.	EACH	LIN. FT.	LUMP SUM	NO.	LIN. FT.
SUPERSTRUCTURE	LUMP SUM	---	---	LUMP SUM	---	---	---	---	140.25	LUMP SUM	11	770
END BENT NO. 1	---	LUMP SUM	21.8	---	2,636	7	385	4	---	---	---	---
END BENT NO. 2	---	LUMP SUM	21.8	---	2,636	7	385	4	---	---	---	---
TOTAL	LUMP SUM	LUMP SUM	43.6	LUMP SUM	5,272	14	770	8	140.25	LUMP SUM	11	770

GENERAL NOTES

ASSUMED LIVE LOAD = HL-93 OR ALTERNATE LOADING.

FOR OTHER DESIGN DATA AND GENERAL NOTES, SEE SHEET SN.

FOR EROSION CONTROL MEASURES SEE EROSION CONTROL PLANS.

THIS BRIDGE HAS BEEN DESIGNED IN ACCORDANCE WITH THE REQUIREMENTS OF THE AASHTO LRFD BRIDGE DESIGN SPECIFICATIONS.

THE EXISTING 3 SPAN STRUCTURE WITH SPAN LENGTHS OF 18'-0", 17'-0" AND 18'-0" WITH 22 LINES OF TIMBER JOISTS AT VARYING CENTERS AND A REINFORCED CONCRETE DECK WITH A 28'-0" CLEAR ROADWAY WIDTH ON TIMBER CAP AND TIMBER PILE BENTS AND END BENTS SHALL BE REMOVED. IN ADDITION, ANY PILES REMAINING FROM PREVIOUS BRIDGE CONSTRUCTION OR MAINTENANCE OPERATIONS SHALL BE REMOVED AND INCLUDED IN THE LUMP SUM PAY ITEM FOR "REMOVAL OF EXISTING STRUCTURE AT STATION 12+95.00 -L-".

REMOVAL OF THE EXISTING BRIDGE SHALL BE PERFORMED SO AS NOT TO ALLOW DEBRIS TO FALL INTO THE WATER. THE CONTRACTOR SHALL REMOVE THE BRIDGE AND SUBMIT PLANS FOR DEMOLITION IN ACCORDANCE WITH ARTICLE 402-2 OF THE STANDARD SPECIFICATIONS.

THE MATERIAL SHOWN IN THE CROSS-HATCHED AREA SHALL BE EXCAVATED FOR A DISTANCE OF 19.5 FT EACH SIDE OF CENTERLINE ROADWAY AS DIRECTED BY THE ENGINEER. THIS WORK WILL BE PAID FOR AT THE CONTRACT LUMP SUM PRICE FOR UNCLASSIFIED STRUCTURE EXCAVATION. SEE SECTION 412 OF THE STANDARD SPECIFICATIONS.

THE SUBSTRUCTURE OF THE EXISTING BRIDGE INDICATED ON THE PLANS IS FROM THE BEST INFORMATION AVAILABLE. SINCE THIS INFORMATION IS SHOWN FOR THE CONVENIENCE OF THE CONTRACTOR, THE CONTRACTOR SHALL HAVE NO CLAIM WHATSOEVER AGAINST THE DEPARTMENT OF TRANSPORTATION FOR ANY DELAYS OR ADDITIONAL COST INCURRED BASED ON DIFFERENCES BETWEEN THE EXISTING BRIDGE SUBSTRUCTURE SHOWN ON THE PLANS AND THE ACTUAL CONDITIONS AT THE PROJECT SITE.

ASPHALT WEARING SURFACE IS INCLUDED IN ROADWAY QUANTITY ON ROADWAY PLANS.

THIS STRUCTURE HAS BEEN DESIGNED IN ACCORDANCE WITH HEC 18, "EVALUATING SCOUR AT BRIDGES" MAY, 2001

THE CONTRACTOR SHALL PROVIDE INDEPENDENT ASSURANCE SAMPLES OF REINFORCING STEEL AS FOLLOWS: FOR PROJECTS REQUIRING UP TO 400 TONS OF REINFORCING STEEL, ONE 30 INCH SAMPLE OF EACH SIZE BAR USED, AND FOR PROJECTS REQUIRING OVER 400 TONS OF REINFORCING STEEL, TWO 30 INCH SAMPLES OF EACH SIZE BAR USED. THE BARS FROM WHICH THE SAMPLES ARE TAKEN MUST THEN BE SPLICED WITH REPLACEMENT BARS OF THE SIZE AND LENGTH OF THE SAMPLE PLUS A MINIMUM LAP SPLICE OF THIRTY BAR DIAMETERS. PAYMENT FOR THE SAMPLES OF REINFORCING STEEL SHALL BE CONSIDERED INCIDENTAL TO VARIOUS PAY ITEMS.

FOR SUBMITTAL OF WORKING DRAWINGS, SEE SPECIAL PROVISIONS.

FOR FALSEWORK AND FORMWORK, SEE SPECIAL PROVISIONS.

THE USE OF A TEMPORARY CAUSEWAY OR WORK BRIDGE IS NOT PERMITTED.


FOR CRANE SAFETY, SEE SPECIAL PROVISIONS.

FOR GROUT FOR STRUCTURES, SEE SPECIAL PROVISIONS.

THIS BRIDGE IS LOCATED IN SEISMIC ZONE 1.

PROJECT NO. BD-5102M
LENOIR COUNTY
STATION: 12+95.00 -L-

SHEET 2 OF 2

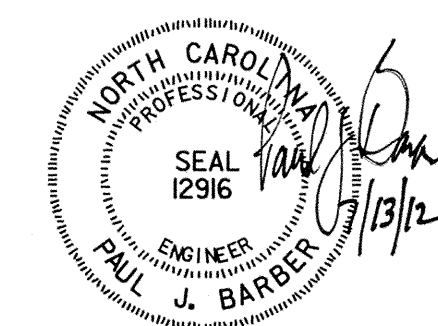

STATE OF NORTH CAROLINA
DEPARTMENT OF TRANSPORTATION
RALEIGH
GENERAL DRAWING
FOR BRIDGE ON SR 1141
OVER DEEP RUN
BETWEEN NC 11
AND US 258

HNTB HNTB NORTH CAROLINA, P.C. NC License No. C-1554 343 E. Six Forks Rd., Suite 200, Raleigh, N.C. 27609	REVISIONS						SHEET NO. S-2 TOTAL SHEETS 12
	DRAWN BY <u>J. BAYNE</u> DATE <u>5/12</u> CHECKED BY <u>P. BARBER</u> DATE <u>5/12</u>	NO.	BY	DATE	NO.	BY	
DWG. NO. 2	1			3			
	2			4			

LOAD AND RESISTANCE FACTOR RATING (LRFD) SUMMARY FOR PRESTRESSED CONCRETE GIRDERS

LEVEL	VEHICLE	WEIGHT (W) (TONS)	CONTROLLING LOAD RATING	MINIMUM RATING FACTORS (RF)	TONS = W X RF	STRENGTH I LIMIT STATE										SERVICE III LIMIT STATE					COMMENT NUMBER			
						MOMENT					SHEAR					MOMENT								
						LIVELOAD FACTORS	DISTRIBUTION FACTORS (DF)	RATING FACTOR	SPAN	GIRDER LOCATION	DISTANCE FROM LEFT END OF SPAN (ft)	DISTRIBUTION FACTORS (DF)	RATING FACTOR	SPAN	GIRDER LOCATION	DISTANCE FROM LEFT END OF SPAN (ft)	LIVELOAD FACTORS	DISTRIBUTION FACTORS (DF)	RATING FACTOR	SPAN		GIRDER LOCATION	DISTANCE FROM LEFT END OF SPAN (ft)	
DESIGN LOAD RATING	HL-93(Inv)	N/A	1	1.006	--	1.75	0.273	1.03	70'	EL	34.5	0.507	1.32	70'	EL	6.9	0.80	0.273	1.01	70'	EL	34.5		
	HL-93(0pr)	N/A	--	1.341	--	1.35	0.273	1.34	70'	EL	34.5	0.507	1.72	70'	EL	6.9	N/A	--	--	--	--	--		
	HS-20(Inv)	36.000	2	1.306	47.02	1.75	0.273	1.34	70'	EL	34.5	0.507	1.65	70'	EL	6.9	0.80	0.273	1.31	70'	EL	34.5		
	HS-20(0pr)	36.000	--	1.74	62.64	1.35	0.273	1.74	70'	EL	34.5	0.507	2.14	70'	EL	6.9	N/A	--	--	--	--	--		
LEGAL LOAD RATING	SV	SNSH	13.500	--	2.917	39.379	1.4	0.273	3.75	70'	EL	34.5	0.507	4.87	70'	EL	6.9	0.80	0.273	2.92	70'	EL	34.5	
		SNGARBS2	20.000	--	2.187	43.741	1.4	0.273	2.81	70'	EL	34.5	0.507	3.47	70'	EL	6.9	0.80	0.273	2.19	70'	EL	34.5	
		SNAGRIS2	22.000	--	2.077	45.69	1.4	0.273	2.67	70'	EL	34.5	0.507	3.23	70'	EL	6.9	0.80	0.273	2.08	70'	EL	34.5	
		SNCOTTS3	27.250	--	1.452	39.565	1.4	0.273	1.87	70'	EL	34.5	0.507	2.43	70'	EL	6.9	0.80	0.273	1.45	70'	EL	34.5	
		SNAGGRS4	34.925	--	1.218	42.554	1.4	0.273	1.57	70'	EL	34.5	0.507	2.03	70'	EL	6.9	0.80	0.273	1.22	70'	EL	34.5	
		SNS5A	35.550	--	1.191	42.346	1.4	0.273	1.53	70'	EL	34.5	0.507	2.06	70'	EL	6.9	0.80	0.273	1.19	70'	EL	34.5	
	TTST	SNS6A	39.950	--	1.095	43.747	1.4	0.273	1.41	70'	EL	34.5	0.507	1.88	70'	EL	6.9	0.80	0.273	1.10	70'	EL	34.5	
		SNS7B	42.000	--	1.043	43.801	1.4	0.273	1.34	70'	EL	34.5	0.507	1.85	70'	EL	6.9	0.80	0.273	1.04	70'	EL	34.5	
		TNAGRIT3	33.000	--	1.336	44.087	1.4	0.273	1.72	70'	EL	34.5	0.507	2.23	70'	EL	6.9	0.80	0.273	1.34	70'	EL	34.5	
		TNT4A	33.075	--	1.342	44.401	1.4	0.273	1.72	70'	EL	34.5	0.507	2.17	70'	EL	6.9	0.80	0.273	1.34	70'	EL	34.5	
		TNT6A	41.600	--	1.1	45.746	1.4	0.273	1.41	70'	EL	34.5	0.507	1.98	70'	EL	6.9	0.80	0.273	1.10	70'	EL	34.5	
		TNT7A	42.000	--	1.106	46.462	1.4	0.273	1.42	70'	EL	34.5	0.507	1.94	70'	EL	6.9	0.80	0.273	1.11	70'	EL	34.5	
	TNT7B	42.000	--	1.147	48.18	1.4	0.273	1.47	70'	EL	34.5	0.507	1.8	70'	EL	6.9	0.80	0.273	1.15	70'	EL	34.5		
	TNAGRIT4	43.000	--	1.089	46.838	1.4	0.273	1.4	70'	EL	34.5	0.507	1.74	70'	EL	6.9	0.80	0.273	1.09	70'	EL	34.5		
	TNAGT5A	45.000	--	1.026	46.175	1.4	0.273	1.32	70'	EL	34.5	0.507	1.74	70'	EL	6.9	0.80	0.273	1.03	70'	EL	34.5		
	TNAGT5B	45.000	3	1.013	45.579	1.4	0.273	1.3	70'	EL	34.5	0.507	1.66	70'	EL	6.9	0.80	0.273	1.01	70'	EL	34.5		

LOAD FACTORS:

DESIGN LOAD RATING FACTORS	LIMIT STATE	γ_{DC}	γ_{DW}
	STRENGTH I	1.25	1.50
	SERVICE III	1.00	1.00

NOTES:

MINIMUM RATING FACTORS ARE BASED ON THE STRENGTH I AND SERVICE III LIMIT STATES.

ALLOWABLE STRESSES FOR SERVICE III LIMIT STATE ARE AS REQUIRED FOR DESIGN.

COMMENTS:

- 1.
- 2.
- 3.
- 4.

CONTROLLING LOAD RATING

1 DESIGN LOAD RATING (HL-93)


2 DESIGN LOAD RATING (HS-20)

3 LEGAL LOAD RATING **

** SEE CHART FOR VEHICLE TYPE


GIRDER LOCATION

I - INTERIOR GIRDER
EL - EXTERIOR LEFT GIRDER
ER - EXTERIOR RIGHT GIRDER

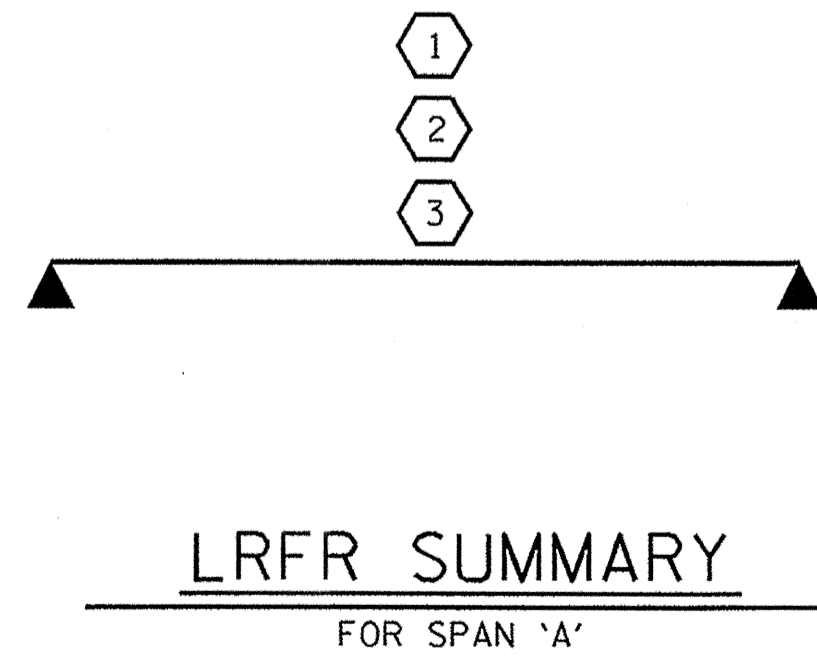

PROJECT NO. BD-5102M
LENOIR COUNTY
 STATION: 12+95.00 -L-

ASSEMBLED BY : E. K. POPE DATE : 4-11-12
 CHECKED BY : G. KOUICHEKI DATE : 5-8-12
 DRAWN BY : CVC 6/10
 CHECKED BY : DNS 6/10

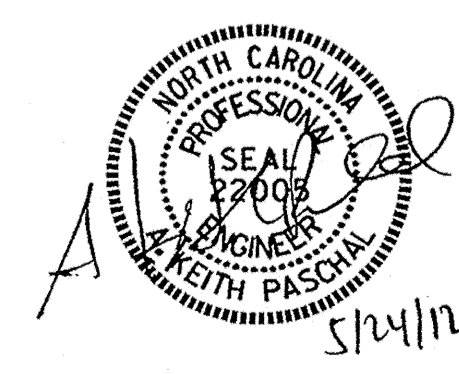


STATE OF NORTH CAROLINA
 DEPARTMENT OF TRANSPORTATION
 RALEIGH

STANDARD
 LRFR SUMMARY FOR
 70' CORED SLAB UNIT
 90° SKEW
 (NON-INTERSTATE TRAFFIC)

REVISIONS					
NO.	BY:	DATE:	NO.	BY:	DATE:
1			3		
2			4		

SHEET NO.
5-3
TOTAL SHEETS
12

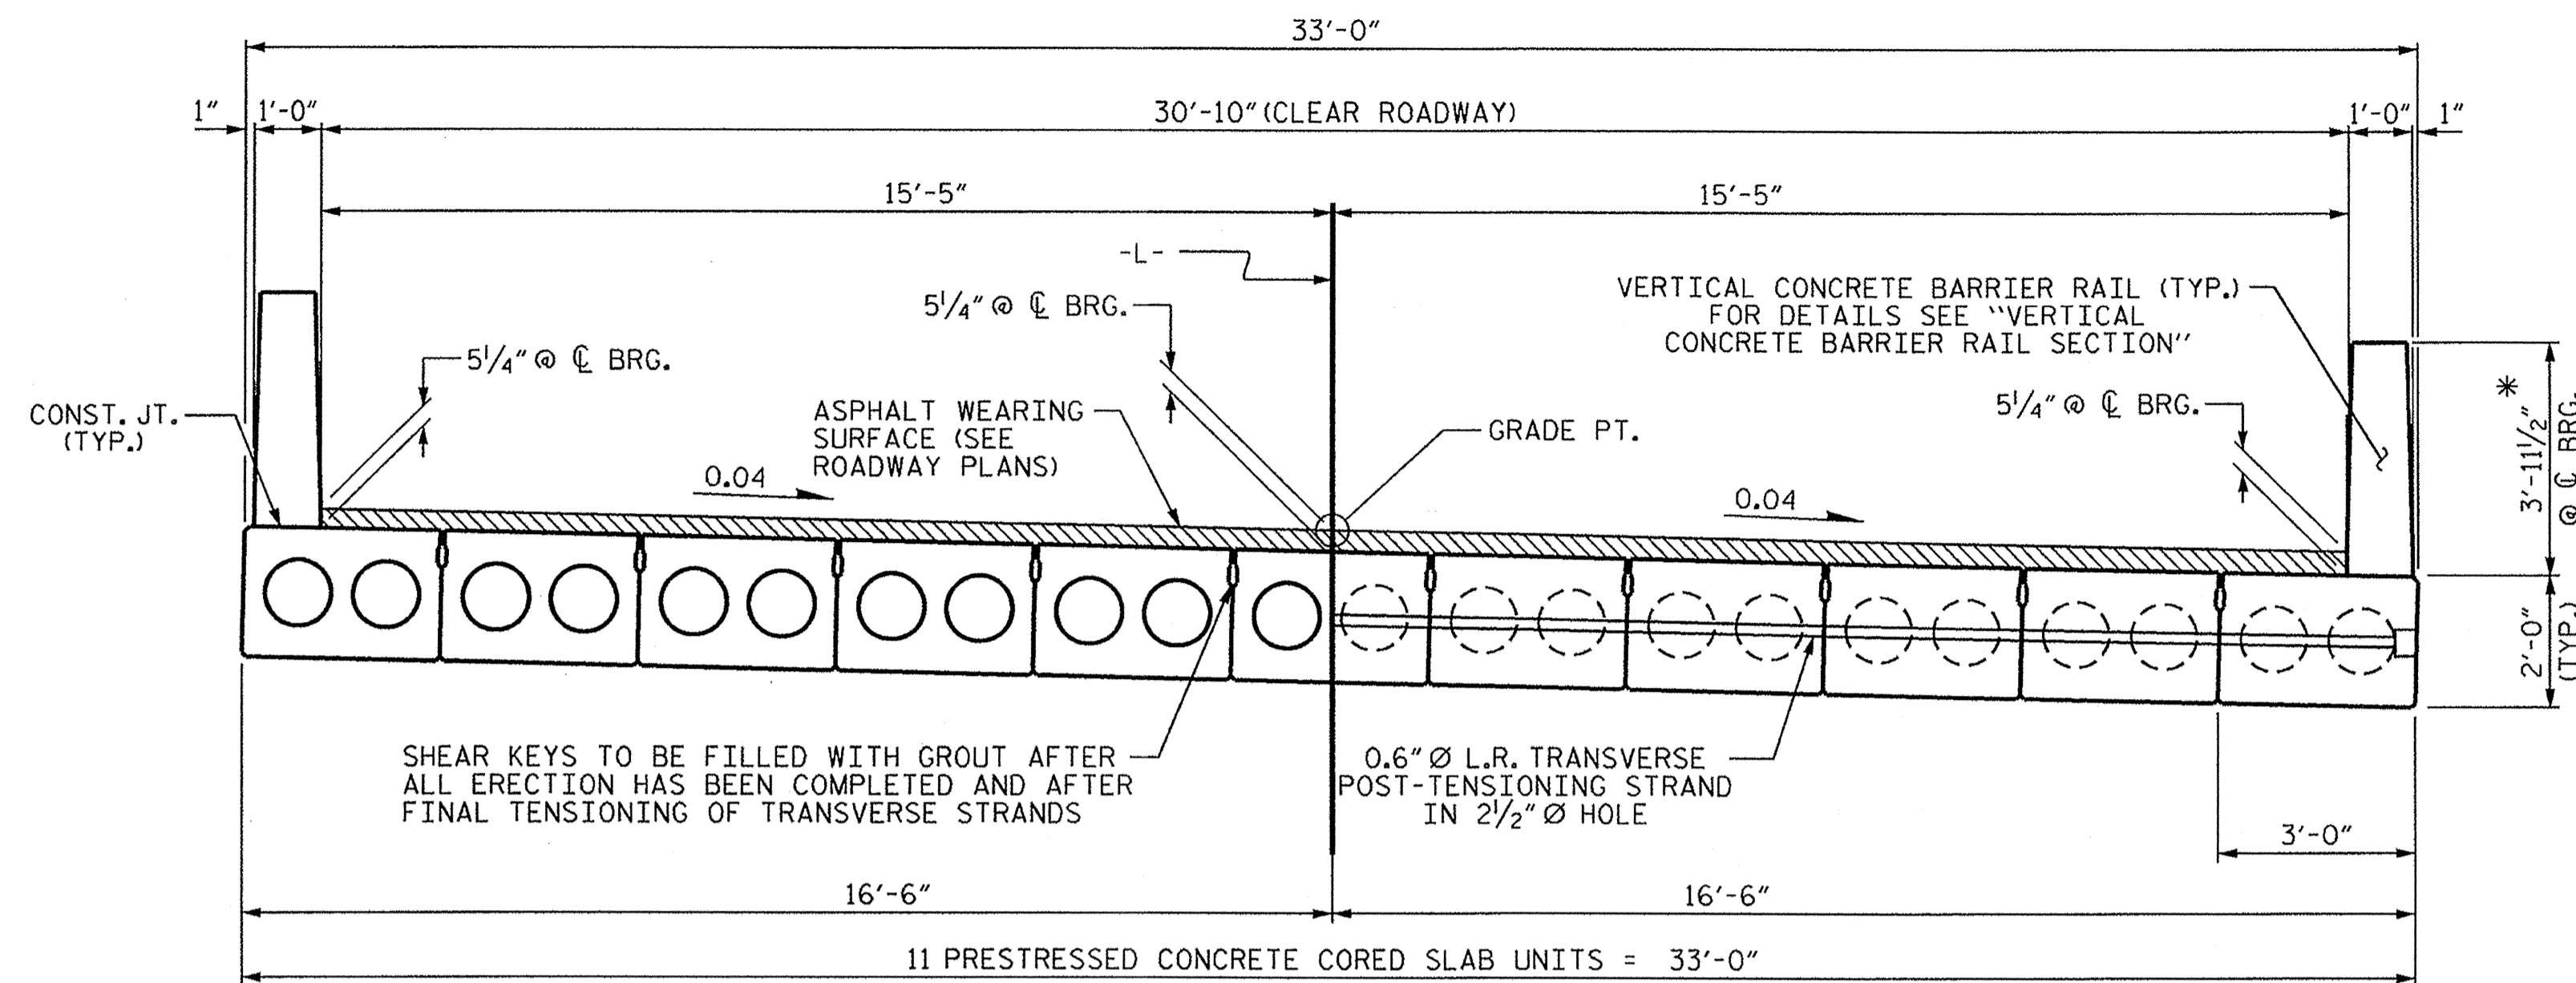


HALF SECTION
AT INTERMEDIATE DIAPHRAGMS

TYPICAL SECTION


HALF SECTION
THROUGH VOIDS

* - THE MAXIMUM BARRIER RAIL HEIGHT AND ASPHALT THICKNESS IS SHOWN. THE HEIGHT OF THE BARRIER RAIL AND ASPHALT THICKNESS VARIES WHILE THE TOP OF THE BARRIER RAIL FOLLOWS THE PROFILE OF THE GUTTERLINE. FOR RAIL HEIGHT DETAILS AND ASPHALT THICKNESS, SEE THE "VERTICAL CONCRETE BARRIER RAIL SECTION" DETAIL.

FIXED END

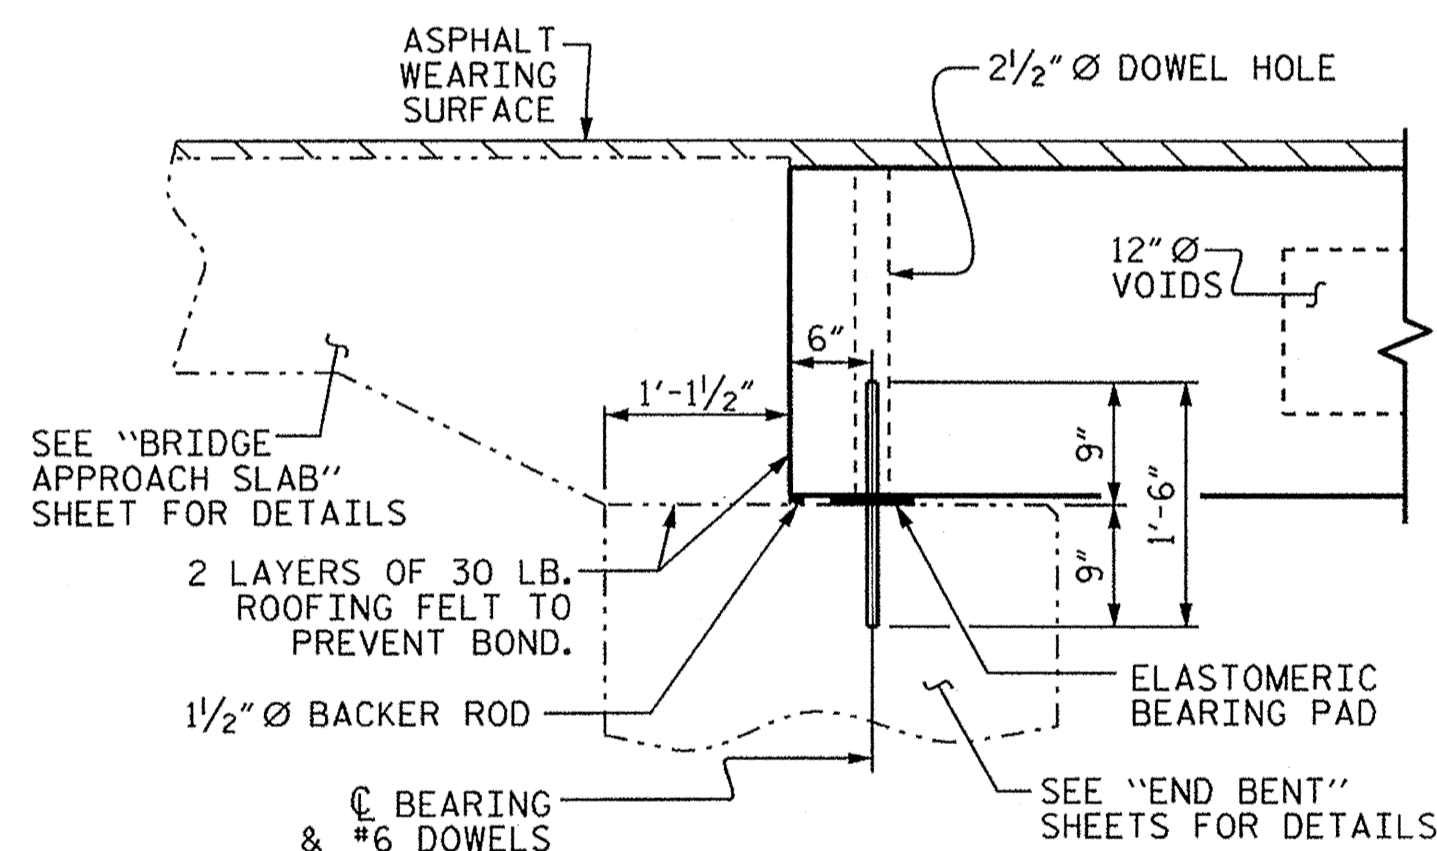


SECTION AT END BENT

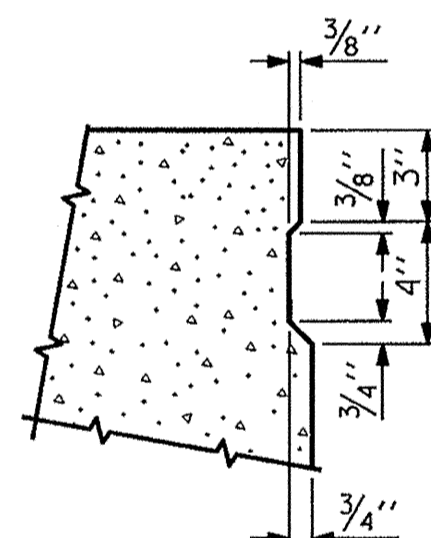


SHEAR KEY DETAIL

NOTE: OMIT SHEAR KEY ON OUTSIDE FACE OF EXTERIOR CORED SLABS.

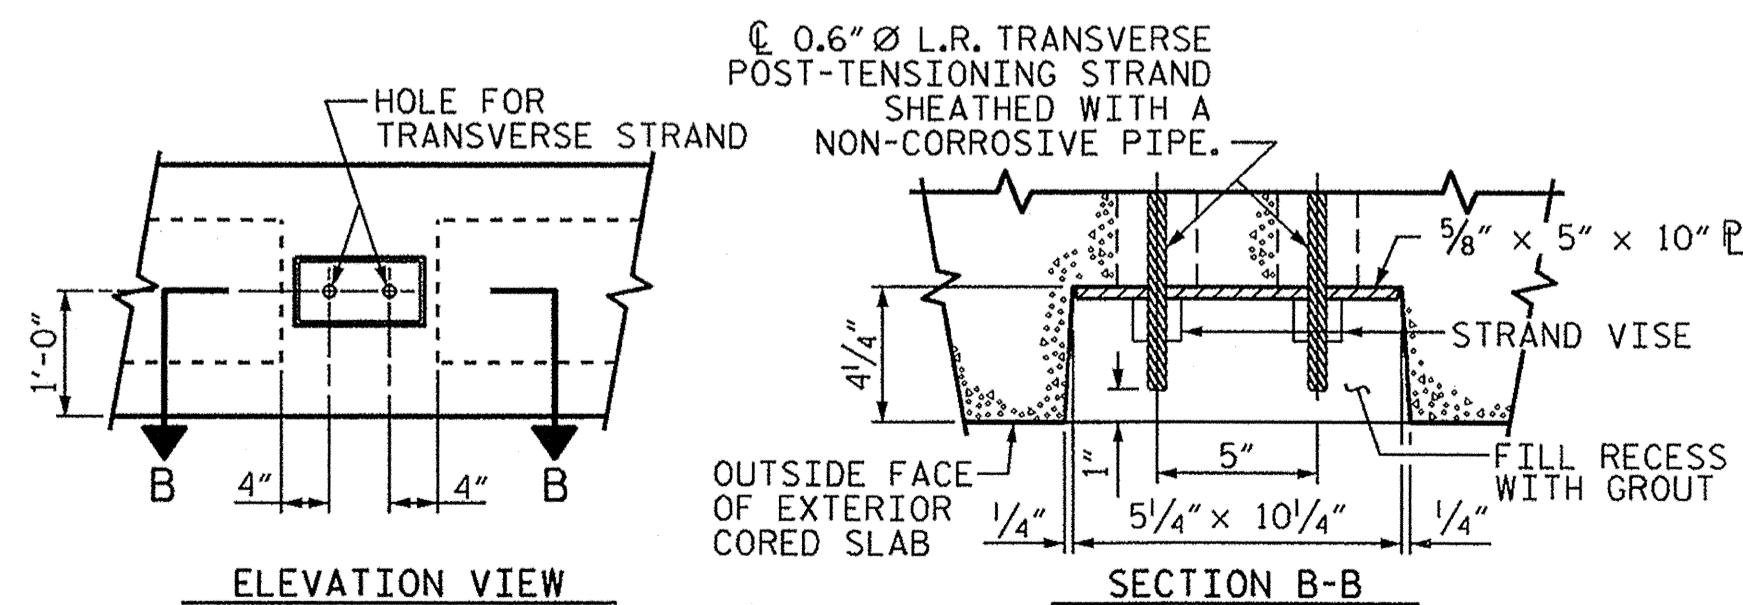


GROUTED RECESS AT END OF
POST-TENSIONED STRAND-CORED SLABS

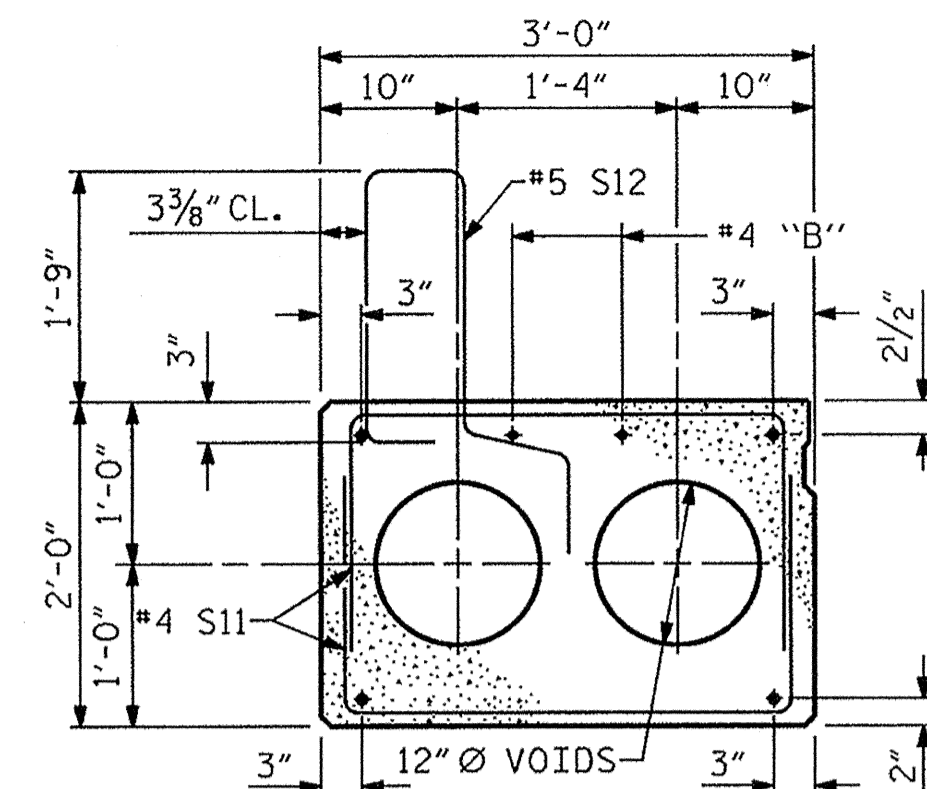

EXTERIOR SLAB SECTION

(FOR PRESTRESSED STRAND LAYOUT, SEE INTERIOR SLAB SECTION.)

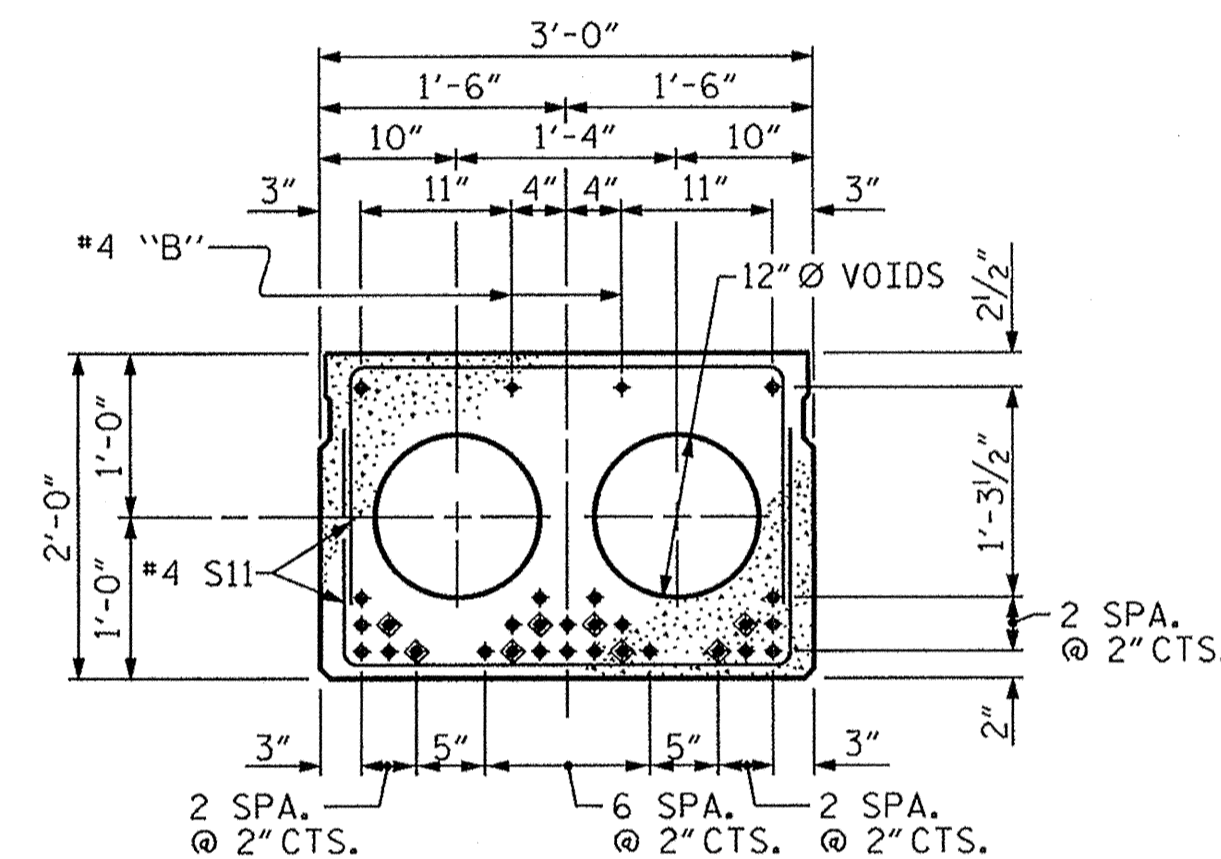


INTERIOR SLAB SECTION (70' UNIT)

(28 STRANDS REQUIRED)

0.6" Ø LOW
RELAXATION STRAND LAYOUT


◆ BOND SHALL BE BROKEN ON THESE STRANDS FOR A DISTANCE OF 12'-0" FROM END OF CORED SLAB UNIT. SEE STANDARD SPECIFICATIONS, ARTICLE 1078-7.

DEBONDING LEGEND

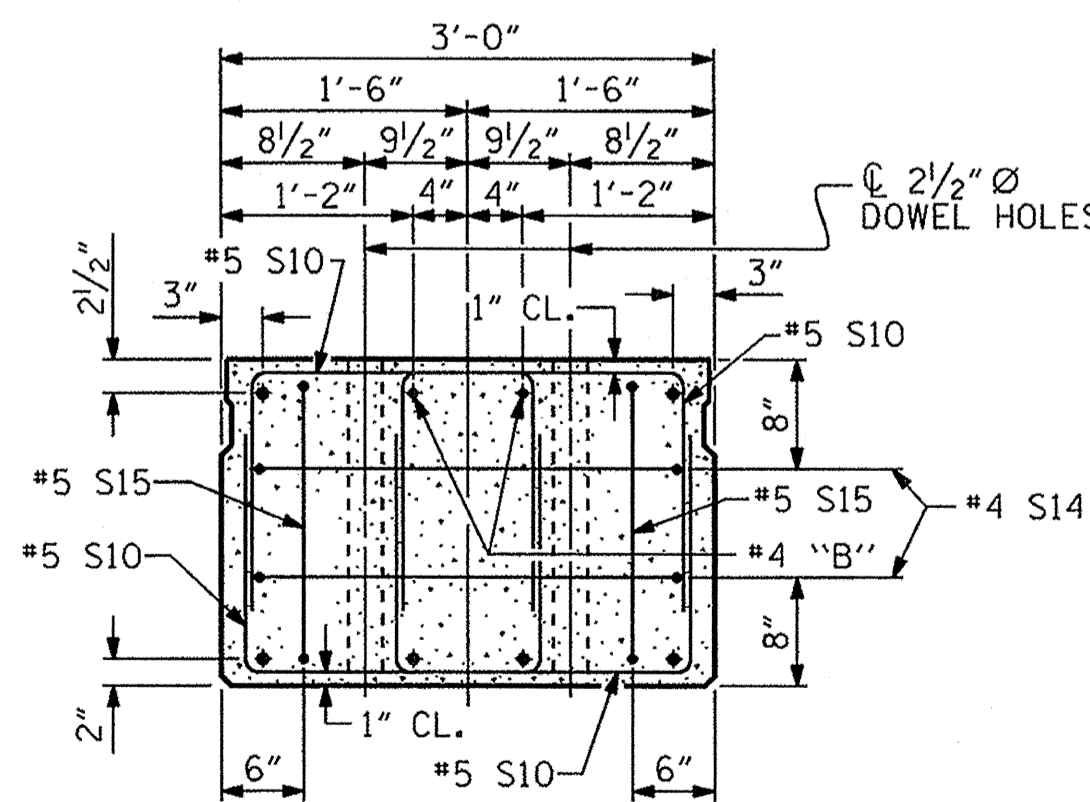

END ELEVATION

SHOWING PLACEMENT OF DOUBLE STIRRUPS AND LOCATION OF DOWEL HOLES. (STRAND LAYOUT NOT SHOWN.) INTERIOR SLAB UNIT SHOWN-EXTERIOR SLAB UNIT SIMILAR EXCEPT SHEAR KEY LOCATION.

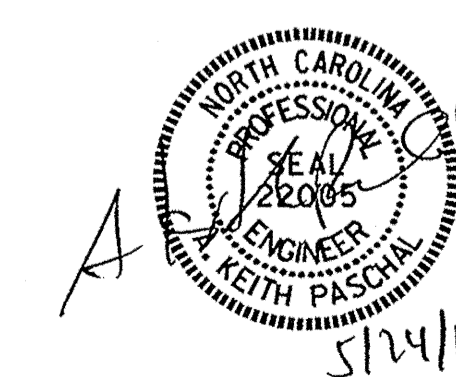


PROJECT NO. BD-5102M
LENOIR COUNTY
STATION: 12+95.00 -L-

SHEET 1 OF 3


STATE OF NORTH CAROLINA
DEPARTMENT OF TRANSPORTATION
RALEIGH
STANDARD
3'-0" X 2'-0"
PRESTRESSED CONCRETE
CORED SLAB UNIT

REVISIONS						SHEET NO.
NO.	BY:	DATE:	NO.	BY:	DATE:	5-4
1			3			TOTAL SHEETS
2			4			12


ASSEMBLED BY : E. K. POPE	DATE : 4-11-12
CHECKED BY : G. KOUCHEKI	DATE : 3-8-12
DRAWN BY : MAA 6/10	REV. 12/11 MAA/AAC
CHECKED BY : MKT 7/10	

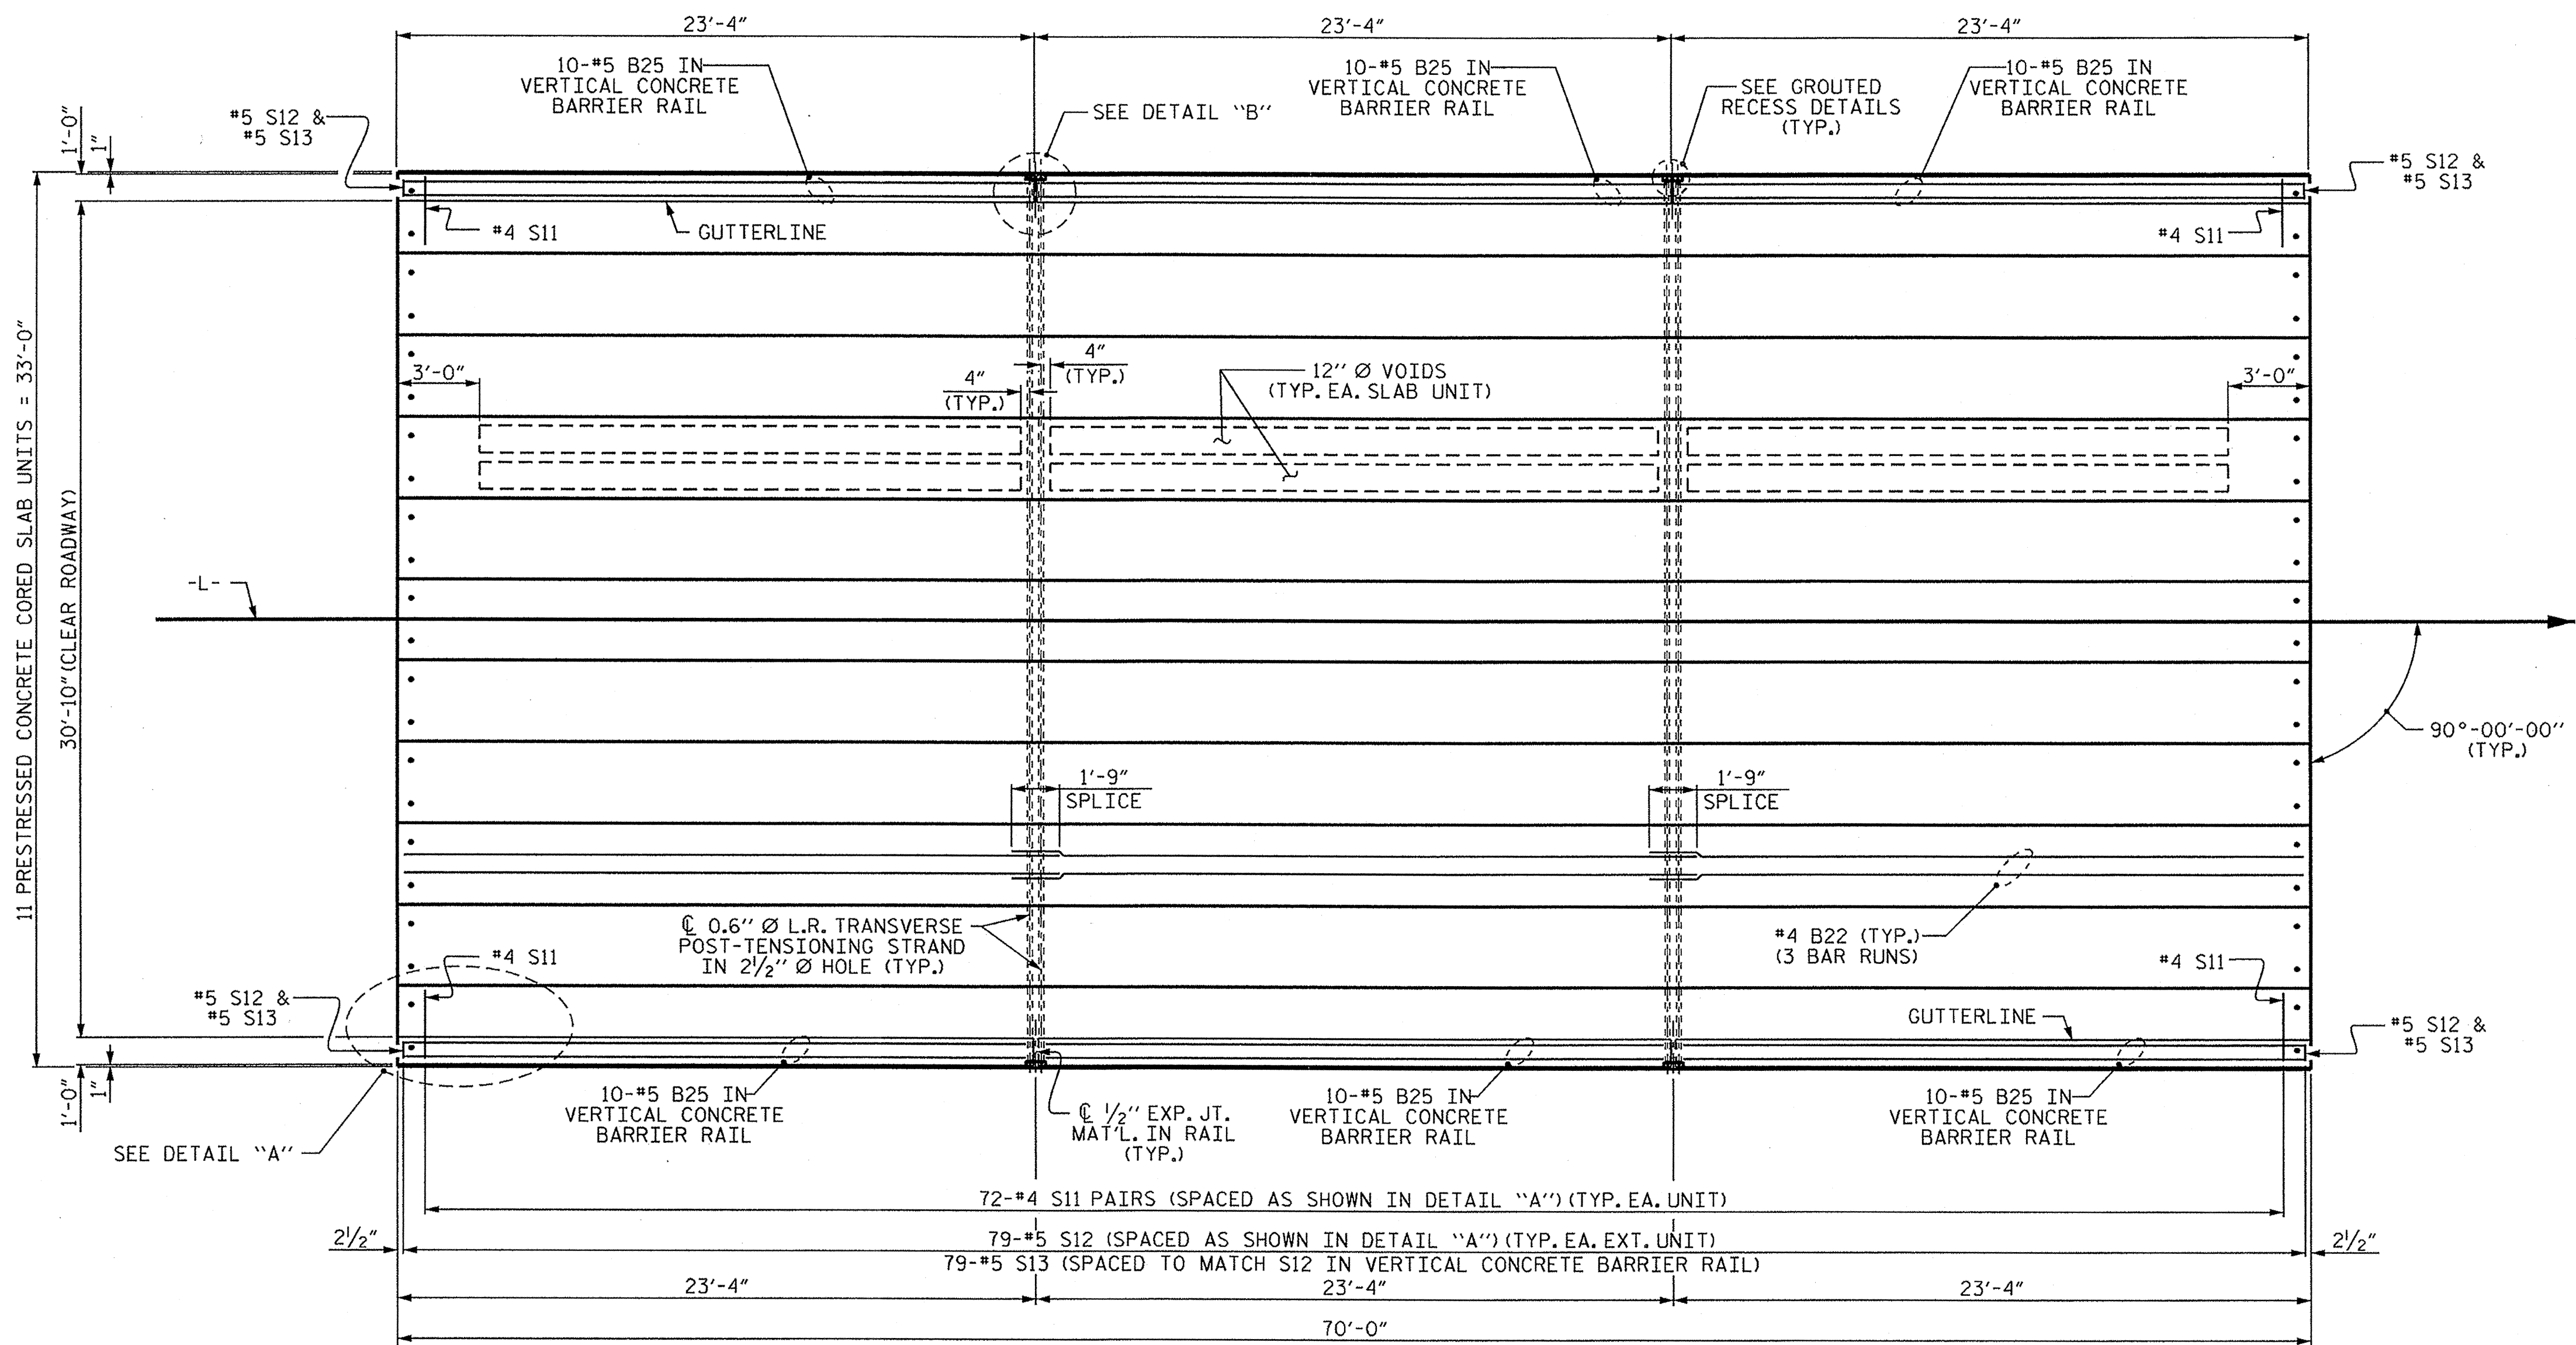

PLAN OF UNIT

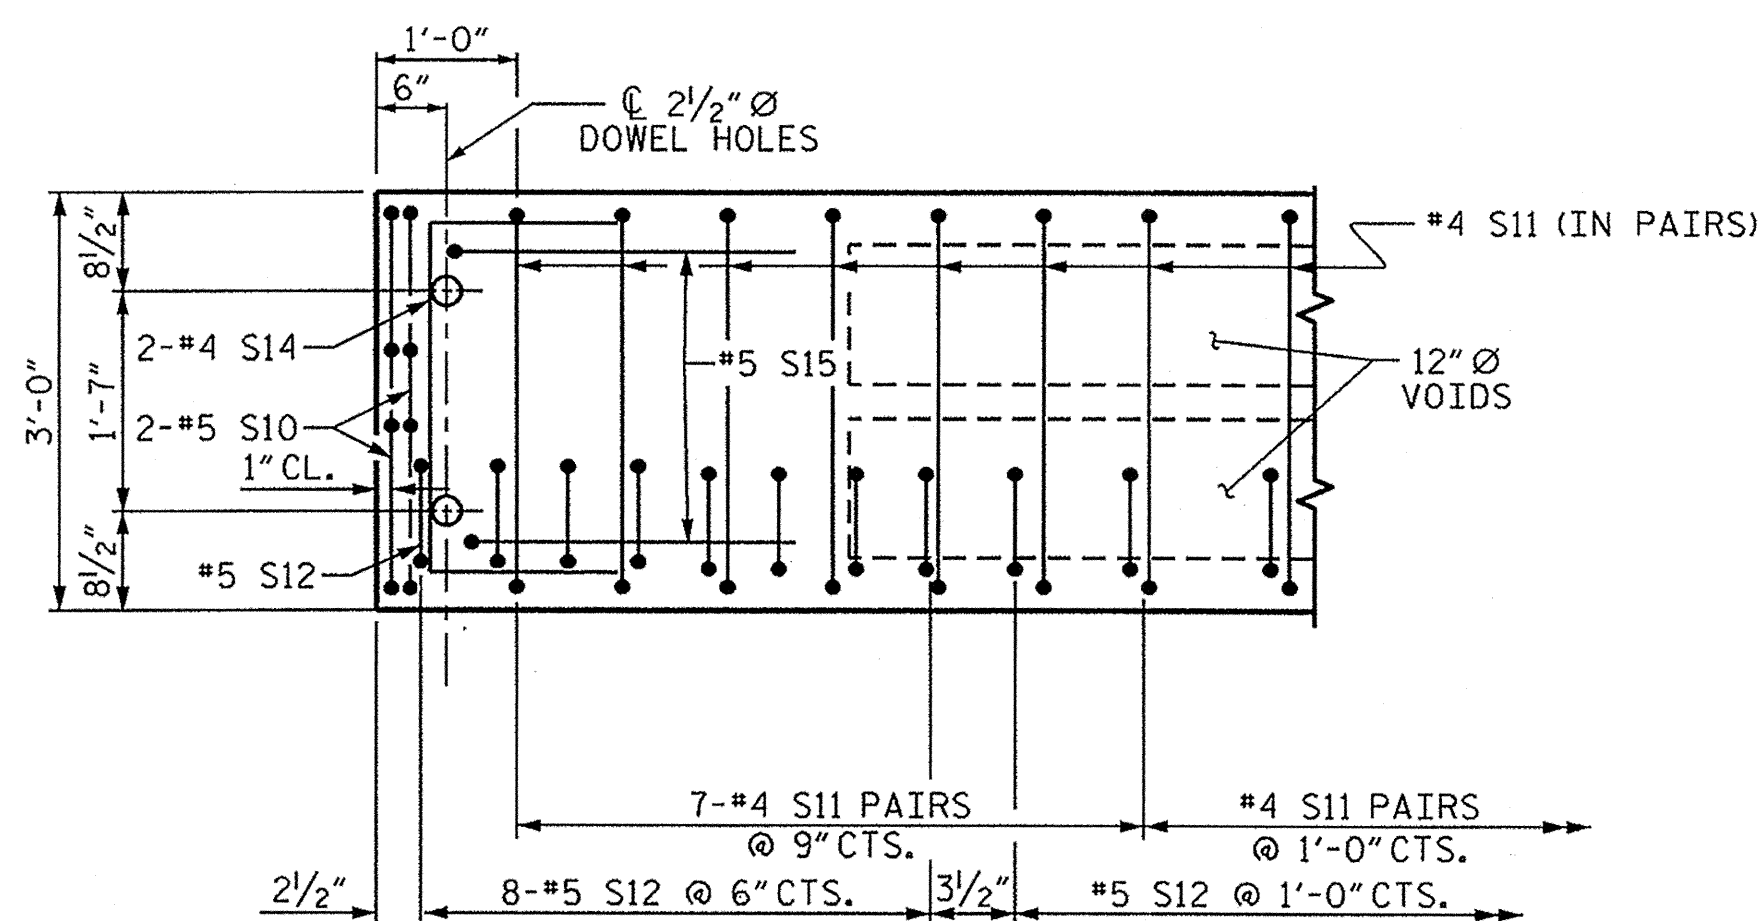

DETAIL "A"

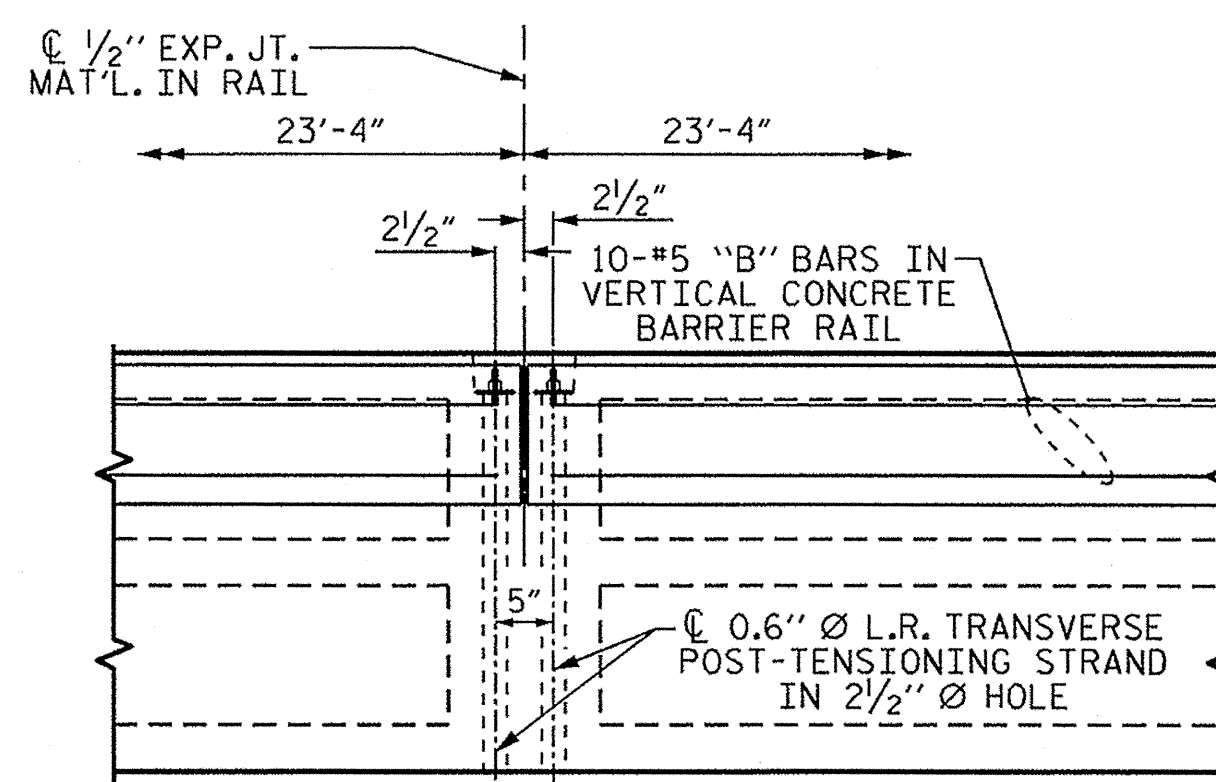

DETAIL "B"

#4 S11 BARS MAY BE SHIFTED AS NECESSARY TO MAINTAIN 1" CLEAR TO GROUDED RECESS AND 2 1/2" Ø TRANSVERSE POST-TENSIONING STRAND HOLES


NOTE: EXTERIOR UNIT SHOWN - INTERIOR UNIT SIMILAR EXCEPT OMIT #5 S12 BARS.

ASSEMBLED BY : E. K. POPE DATE : 4-11-12
 CHECKED BY : G. KOLCHEKI DATE : 3-8-12
 DRAWN BY : MAA 6/10 REV. 12/5/11 MAA/AAC
 CHECKED BY : MKT 7/10


24-MAY-2012 11:57
 S:\DPG1\Kerth\BD-5102M\ekpope\BD5102M_SD_CS.dgn
 kpaschal

PROJECT NO. BD-5102M
LENOIR COUNTY
 STATION: 12+95.00 -L-
 SHEET 2 OF 3

STATE OF NORTH CAROLINA
 DEPARTMENT OF TRANSPORTATION
 RALEIGH
 PLAN OF 70' UNIT
 30'-10" CLEAR ROADWAY
 90° SKEW

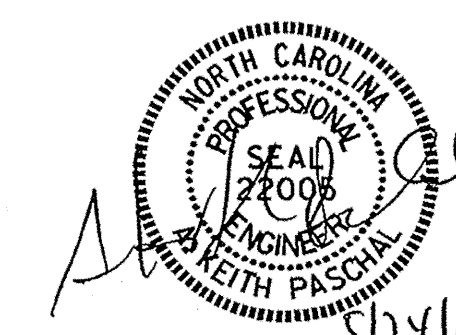

REVISIONS						SHEET NO.
NO.	BY:	DATE:	NO.	BY:	DATE:	
1			3			5-5
2			4			TOTAL SHEETS 12

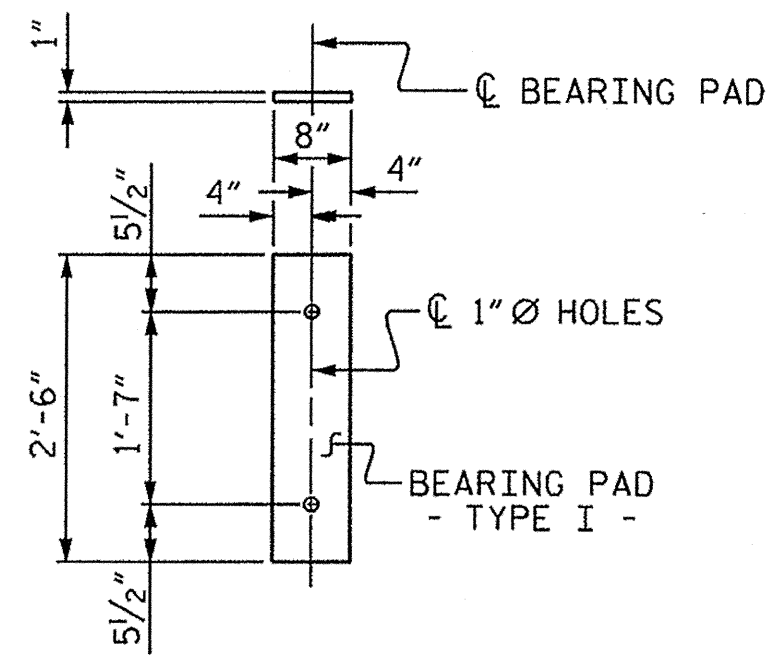

FIXED END
(TYPE I - 22 REQ'D)

ELASTOMERIC BEARING DETAILS


ELASTOMER IN ALL BEARINGS SHALL BE 60 DUROMETER HARDNESS.

GRADE 270 STRANDS	
AREA (SQUARE INCHES)	0.6" Ø L.R.
ULTIMATE STRENGTH (LBS. PER STRAND)	58,600
APPLIED PRESTRESS (LBS. PER STRAND)	43,950

CORED SLABS REQUIRED			
70' UNIT	NUMBER	LENGTH	TOTAL LENGTH
EXTERIOR C.S.	2	70'-0"	140'-0"
INTERIOR C.S.	9	70'-0"	630'-0"
TOTAL	11		770'-0"

DEAD LOAD DEFLECTION AND CAMBER	
70' CORED SLAB UNIT	3'-0" x 2'-0"
CAMBER (SLAB ALONE IN PLACE)	0.6" Ø L.R. STRAND 4 5/16" ↑
DEFLECTION DUE TO SUPERIMPOSED DEAD LOAD**	1 3/16" ↓
FINAL CAMBER	3 1/2" ↑


** INCLUDES FUTURE WEARING SURFACE

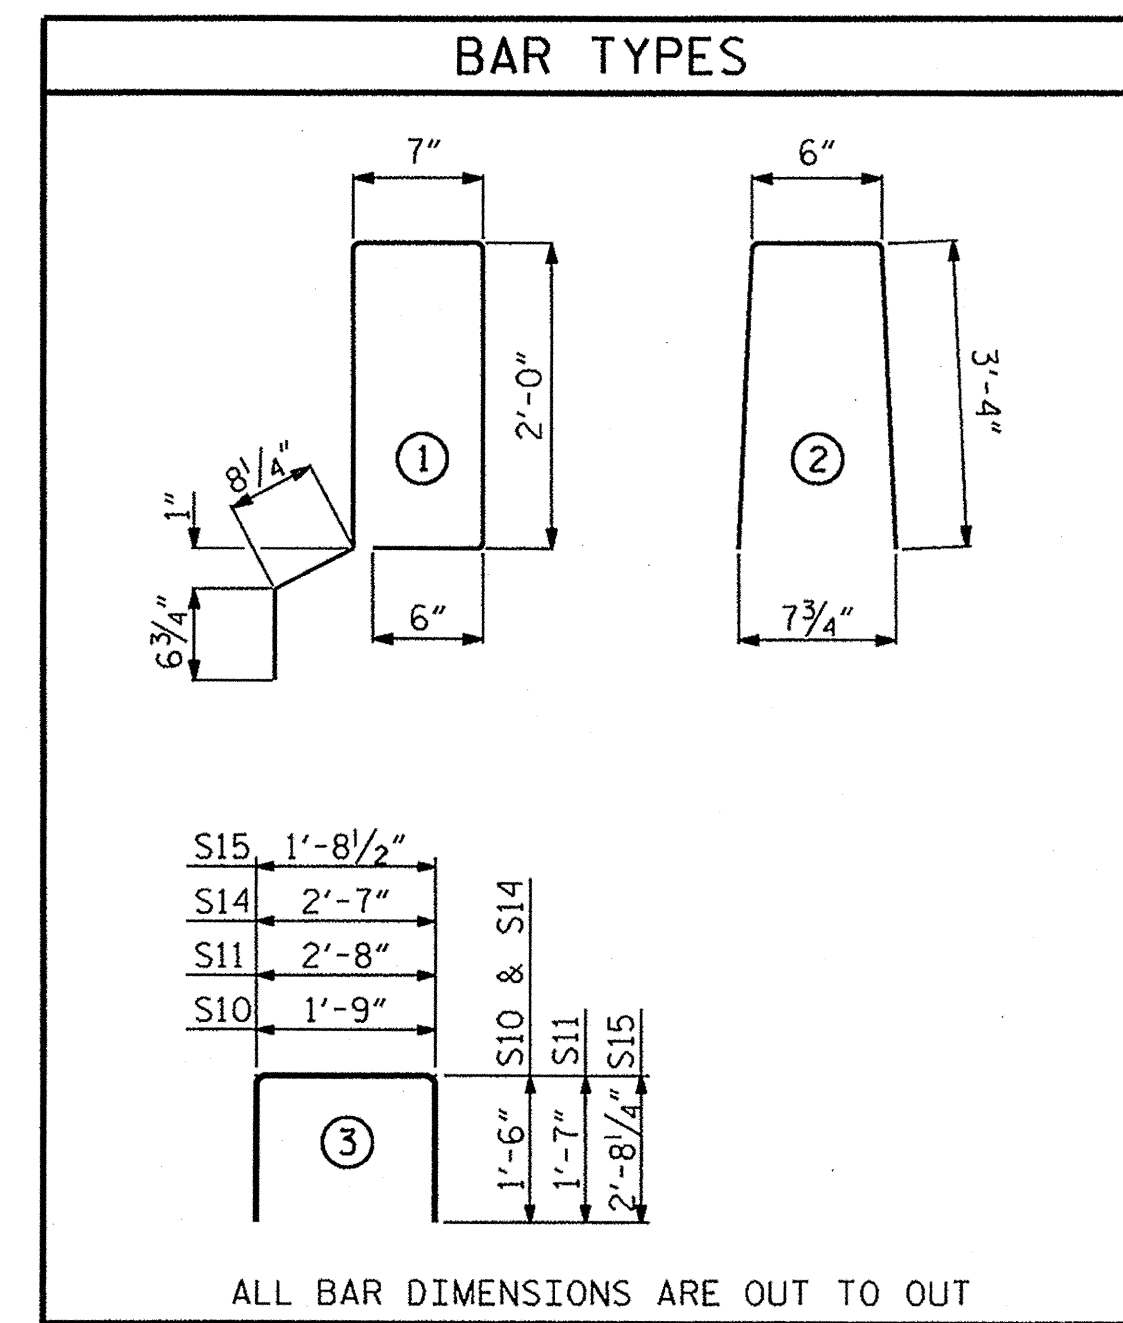


BILL OF MATERIAL FOR VERTICAL CONCRETE BARRIER RAIL						
BAR	BARS PER PAIR OF EXTERIOR UNITS	TOTAL NO.	SIZE	TYPE	LENGTH	WEIGHT
70' UNIT						
*B25	60	60	#5	STR	22'-11"	1434
*S13	158	158	#5	2	7'-2"	1181
* EPOXY COATED REINFORCING STEEL					LBS.	2615
CLASS AA CONCRETE					CU. YDS.	18.9
TOTAL VERTICAL CONCRETE BARRIER RAIL					LN. FT.	140.25

BILL OF MATERIAL FOR ONE 70' CORED SLAB UNIT							
BAR	NUMBER	SIZE	TYPE	EXTERIOR UNIT LENGTH	EXTERIOR UNIT WEIGHT	INTERIOR UNIT LENGTH	INTERIOR UNIT WEIGHT
B22	6	#4	STR	24'-6"	98	24'-6"	98
S10	8	#5	3	4'-9"	40	4'-9"	40
S11	144	#4	3	5'-10"	561	5'-10"	561
*S12	79	#5	1	6'-4"	522		
S14	4	#4	3	5'-7"	15	5'-7"	15
S15	4	#5	3	7'-1"	30	7'-1"	30
REINFORCING STEEL					LBS.	744	744
* EPOXY COATED REINFORCING STEEL					LBS.	522	
7000 P.S.I. CONCRETE					CU. YDS.	11.8	11.8
0.6" Ø L.R. STRANDS					No.	28	28

GUTTERLINE ASPHALT THICKNESS & RAIL HEIGHT		
	ASPHALT OVERLAY THICKNESS @ MID-SPAN	RAIL HEIGHT @ MID-SPAN
70' UNITS	1 3/4"	3'-8"

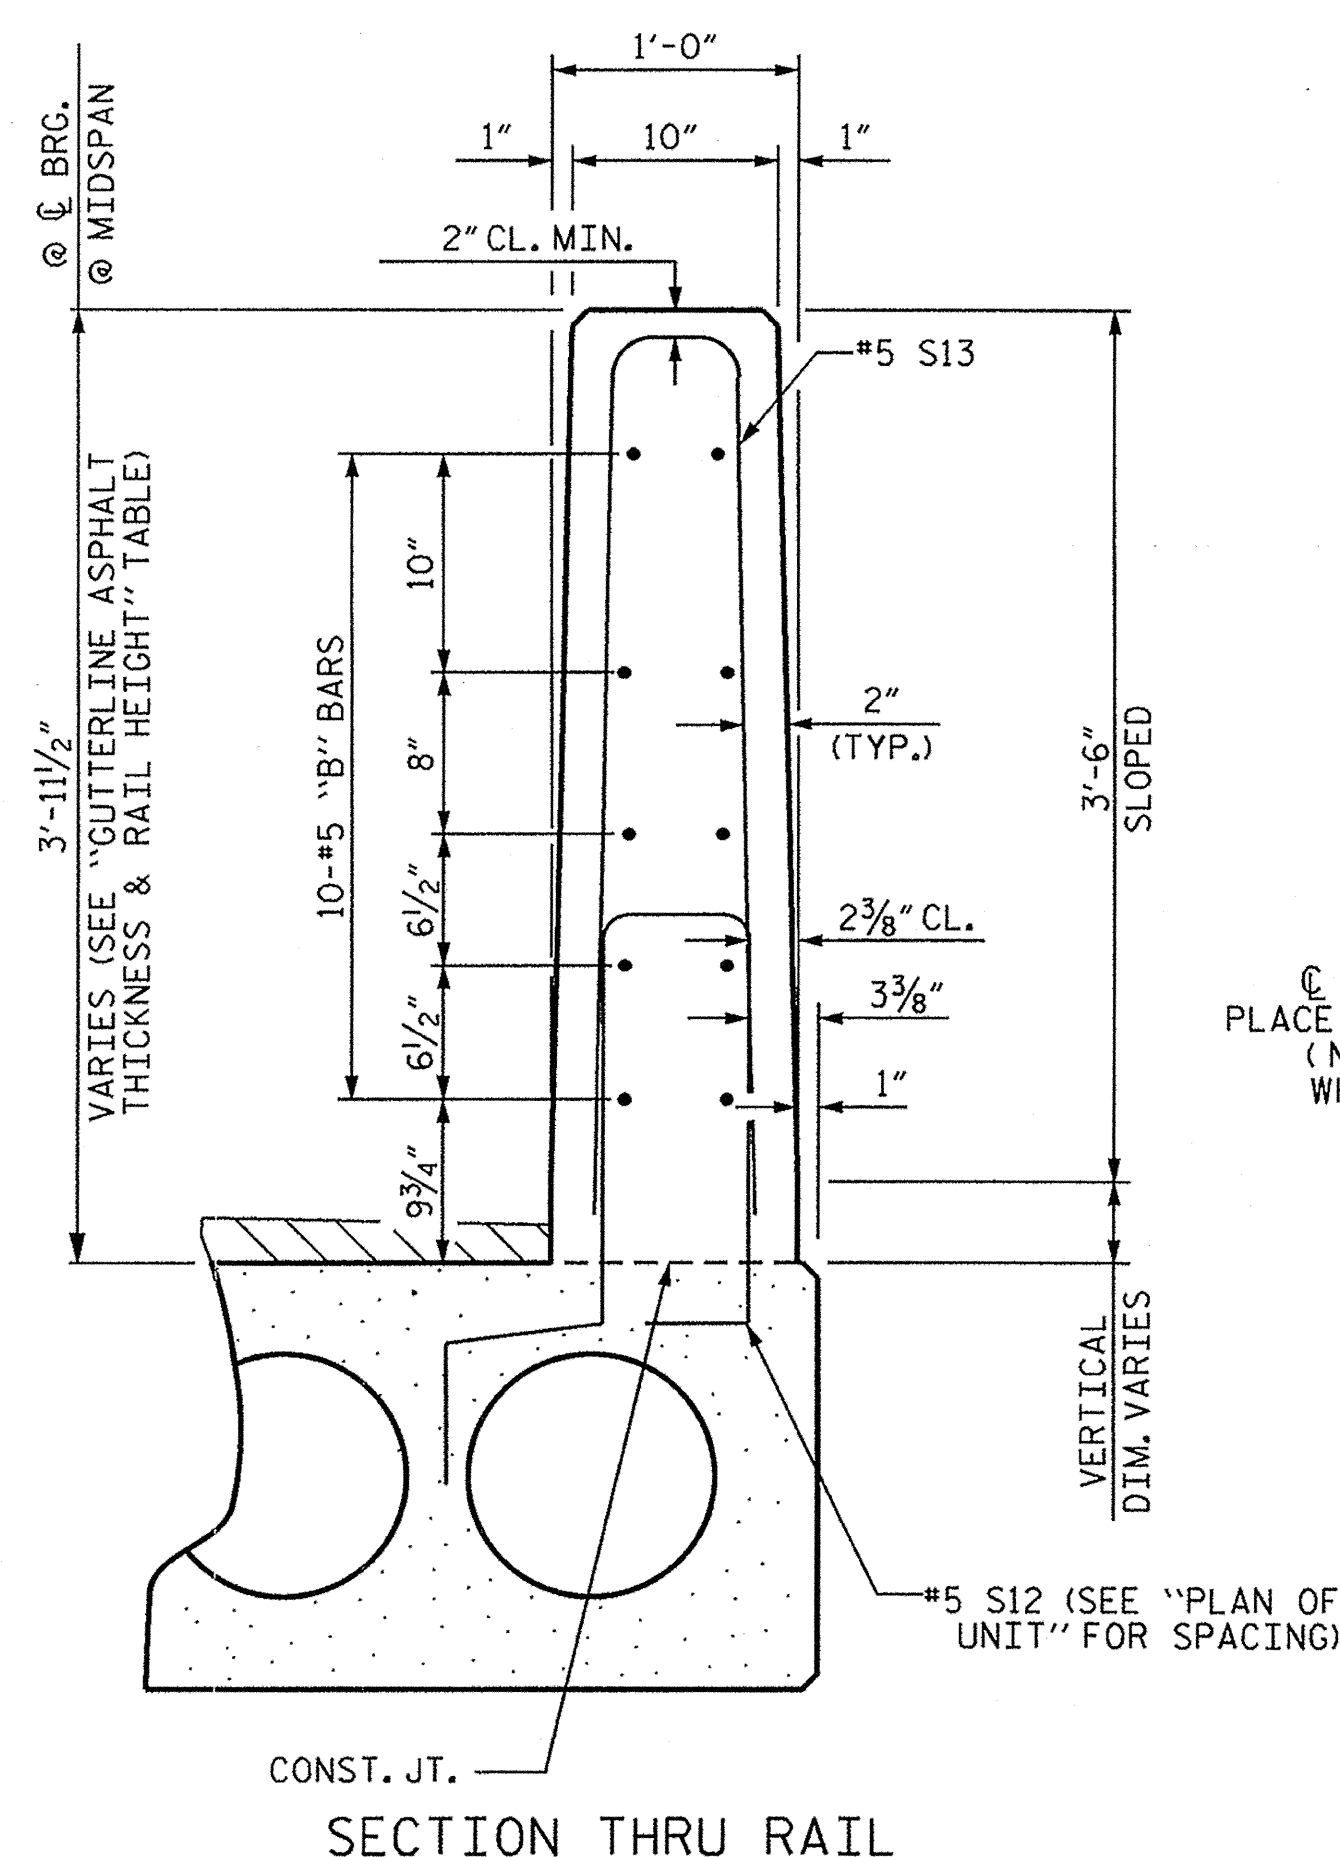


SECTION THRU RAIL

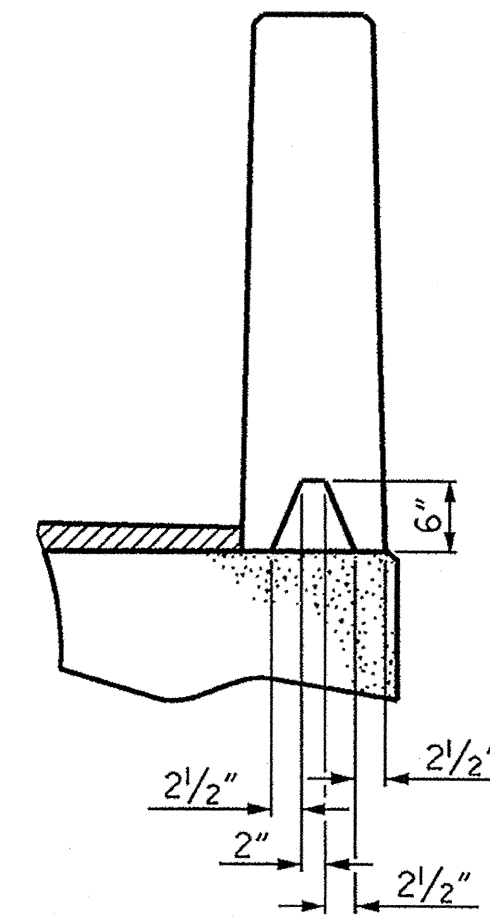

SECTION S-S
AT DAM IN OPEN JOINT
(THIS IS TO BE USED ONLY WHEN SLIP FORM IS USED)

1/2" EXP. JT. MAT'L HELD IN PLACE WITH GALVANIZED NAILS. (NOTE: OMIT EXP. JT. MAT'L. WHEN SLIP FORM IS USED.)

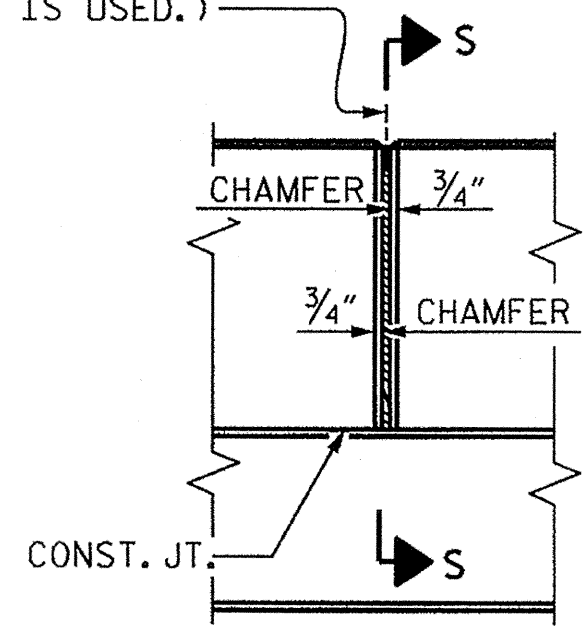

ELEVATION AT EXPANSION JOINTS

VERTICAL CONCRETE BARRIER RAIL DETAILS

ASSEMBLED BY : E. K. POPE	DATE : 4-11-12
CHECKED BY : G. KOUCHEKI	DATE : 3-8-12
DRAWN BY : MAA 6/10	REV. 12/11 MAA/AAC
CHECKED BY : MKT 7/10	

24-MAY-2012 11:57
S:\DPO\kai\B0-5102M\ekpoppe\B05102M.SD_CS.dgn
kposchd

NOTES

- ALL PRESTRESSING STRANDS SHALL BE 7-WIRE LOW RELAXATION GRADE 270 STRANDS AND SHALL CONFORM TO AASHTO M203 EXCEPT FOR SAMPLING REQUIREMENTS WHICH SHALL BE IN ACCORDANCE WITH THE STANDARD SPECIFICATIONS.
- ALL REINFORCING STEEL CAST WITH THE CORED SLAB SECTIONS SHALL BE GRADE 60 AND SHALL BE INCLUDED IN THE UNIT PRICE BID FOR PRESTRESSED CONCRETE CORED SLABS.
- RECESSES FOR TRANSVERSE STRANDS SHALL BE GROUTED AFTER THE TENSIONING OF THE STRANDS.
- THE 2 1/2" Ø DOWEL HOLES AT FIXED ENDS OF SLAB SECTIONS SHALL BE FILLED WITH NON-SHRINK GROUT.
- THE BACKER RODS SHALL CONFORM TO THE REQUIREMENTS OF TYPE M BOND BREAKER. SEE SECTION 1028 OF THE STANDARD SPECIFICATIONS.
- WHEN CORED SLABS ARE CAST, AN INTERNAL HOLD-DOWN SYSTEM SHALL BE EMPLOYED TO PREVENT VOIDS FROM RISING OR MOVING SIDEWAYS. AT LEAST SIX WEEKS PRIOR TO CASTING CORED SLABS, THE CONTRACTOR SHALL SUBMIT TO THE ENGINEER FOR REVIEW AND COMMENT, DETAILED DRAWINGS OF THE PROPOSED HOLD-DOWN SYSTEM. IN ADDITION TO STRUCTURAL DETAILS, LOCATION AND SPACING OF THE HOLD-DOWNS SHALL BE INDICATED.
- THE TRANSFER OF LOAD FROM THE ANCHORAGES TO THE CORED SLAB UNIT SHALL BE DONE WHEN THE CONCRETE HAS REACHED A COMPRESSIVE STRENGTH OF NOT LESS THAN THE REQUIRED STRENGTH SHOWN IN THE "CONCRETE RELEASE STRENGTH" TABLE.
- ALL REINFORCING STEEL IN VERTICAL CONCRETE BARRIER RAILS SHALL BE EPOXY COATED.
- PRESTRESSING STRANDS SHALL BE CUT FLUSH WITH THE CORED SLAB UNIT ENDS.
- APPLY EPOXY PROTECTIVE COATING TO CORED SLAB UNIT ENDS.
- GROOVED CONTRACTION JOINTS, 1/2" IN DEPTH, SHALL BE TOOLED IN ALL EXPOSED FACES OF THE BARRIER RAIL AND IN ACCORDANCE WITH ARTICLE 825-10(B) OF THE STANDARD SPECIFICATIONS. A CONTRACTION JOINT SHALL BE LOCATED AT EACH THIRD POINT BETWEEN BARRIER RAIL EXPANSION JOINTS. ONLY ONE CONTRACTION JOINT IS REQUIRED AT MIDPOINT OF BARRIER RAIL SEGMENTS LESS THAN 20 FEET IN LENGTH AND NO CONTRACTION JOINTS ARE REQUIRED FOR THOSE SEGMENTS LESS THAN 10 FEET IN LENGTH.
- TRANSVERSE POST TENSIONING OF THE CORED SLAB UNITS SHALL BE DONE IN ACCORDANCE WITH THE STANDARD SPECIFICATIONS.
- MAINTAIN A SYMMETRIC TENSION FORCE BETWEEN EACH PAIR OF TRANSVERSE POST TENSIONING STRANDS IN THE DIAPHRAGM.
- THE #4 S11 STIRRUPS MAY BE SHIFTED AS NECESSARY TO MAINTAIN 1" CLEAR TO THE GROUTED RECESS.
- FOR GROUT FOR STRUCTURES, SEE SPECIAL PROVISIONS.

CONCRETE RELEASE STRENGTH	
UNIT	PSI
70' UNITS	5500


PROJECT NO. BD-5102M
LENOIR COUNTY
STATION: 12+95.00 -L-

SHEET 3 OF 3

STATE OF NORTH CAROLINA
DEPARTMENT OF TRANSPORTATION
RALEIGH
STANDARD
3'-0" X 2'-0"
PRESTRESSED CONCRETE
CORED SLAB UNIT

REVISIONS				SHEET NO.
NO.	BY:	DATE:	NO.	DATE:
1			3	
2			4	

TOTAL SHEETS: 12

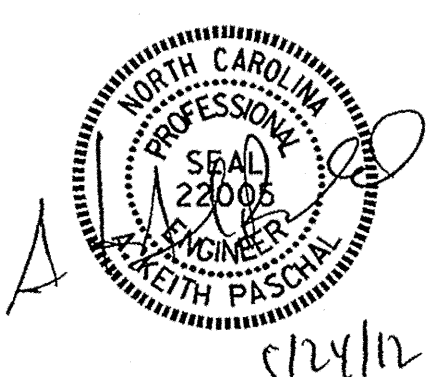

NOTES

THE GUARDRAIL ANCHOR ASSEMBLY SHALL CONSIST OF A 1/4" HOLD DOWN PLATE AND 7 - 7/8" Ø BOLTS WITH NUTS AND WASHERS.

THE HOLD-DOWN PLATE SHALL CONFORM TO AASHTO M270 GRADE 36. AFTER FABRICATION, THE HOLD-DOWN PLATE SHALL BE HOT-DIP GALVANIZED IN ACCORDANCE WITH AASHTO M111.

BOLTS SHALL CONFORM TO THE REQUIREMENTS OF ASTM A307 AND NUTS SHALL CONFORM TO THE REQUIREMENTS OF AASHTO M291. BOLTS, NUTS AND WASHERS SHALL BE GALVANIZED. (AT THE CONTRACTOR'S OPTION, STAINLESS STEEL BOLTS, NUTS AND WASHERS MAY BE USED AS AN ALTERNATE FOR THE 7/8" Ø GALVANIZED BOLTS, NUTS AND WASHERS. THEY SHALL CONFORM TO OR EXCEED THE MECHANICAL REQUIREMENTS OF ASTM A307. THE USE OF THIS ALTERNATE SHALL BE APPROVED BY THE ENGINEER.)





THE GUARDRAIL ANCHOR ASSEMBLY IS REQUIRED AT ALL POINTS WHERE APPROACH GUARDRAIL IS TO BE ATTACHED TO THE END OF BARRIER RAIL. FOR POINTS OF ATTACHMENT, SEE SKETCH.

AFTER INSTALLATION, THE EXPOSED THREAD OF THE BOLT SHALL BE BURRED WITH A SHARP POINTED TOOL.

THE COST OF THE GUARDRAIL ANCHOR ASSEMBLY SHALL BE INCLUDED IN THE UNIT CONTRACT PRICE BID FOR VERTICAL CONCRETE BARRIER RAIL.

THE VERTICAL REINFORCING BARS MAY BE SHIFTED SLIGHTLY IN THE VERTICAL CONCRETE BARRIER RAIL TO CLEAR ASSEMBLY BOLTS.

THE 1 1/4" Ø HOLES SHALL BE FORMED OR DRILLED WITH A CORE BIT. IMPACT TOOLS WILL NOT BE PERMITTED. ANY CONCRETE DAMAGED BY THIS WORK SHALL BE REPAIRED TO THE SATISFACTION OF THE ENGINEER.

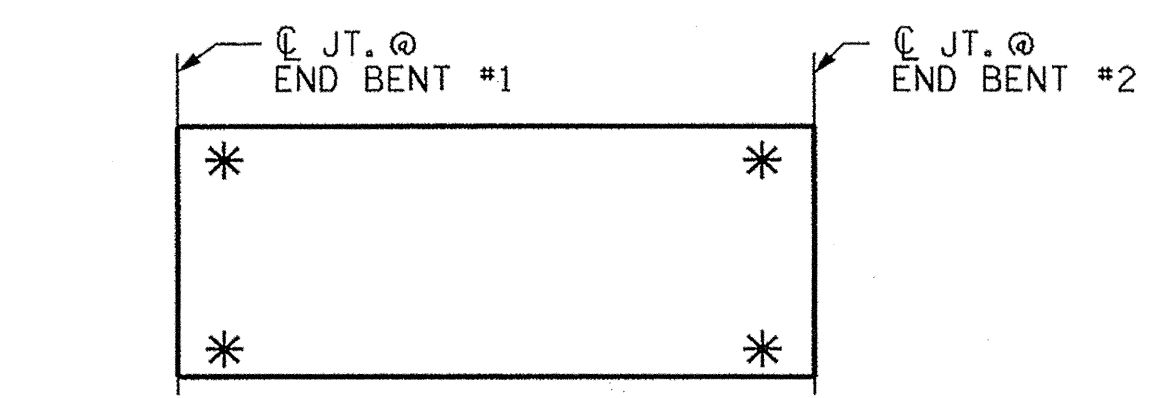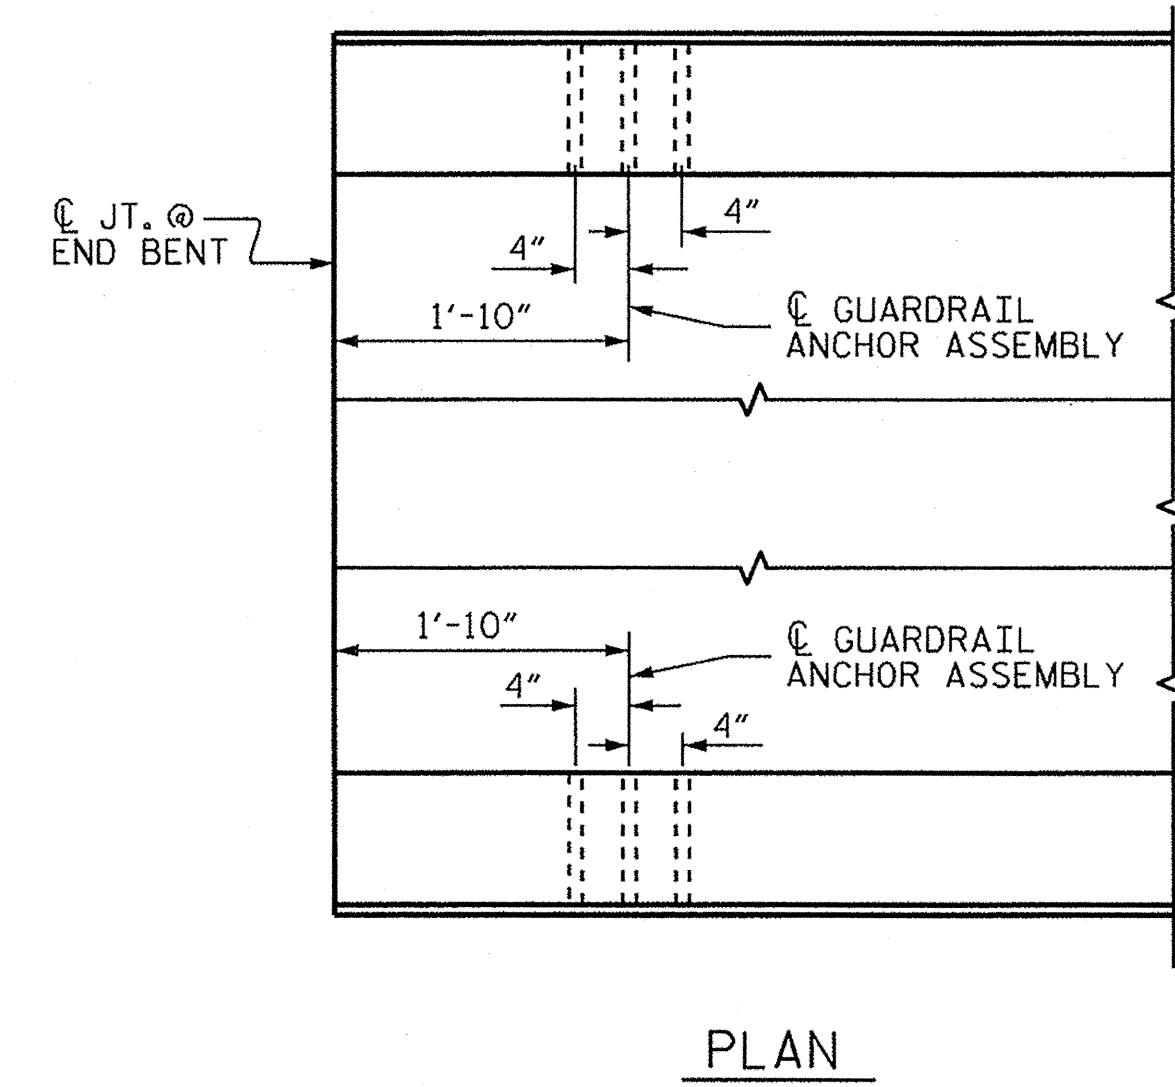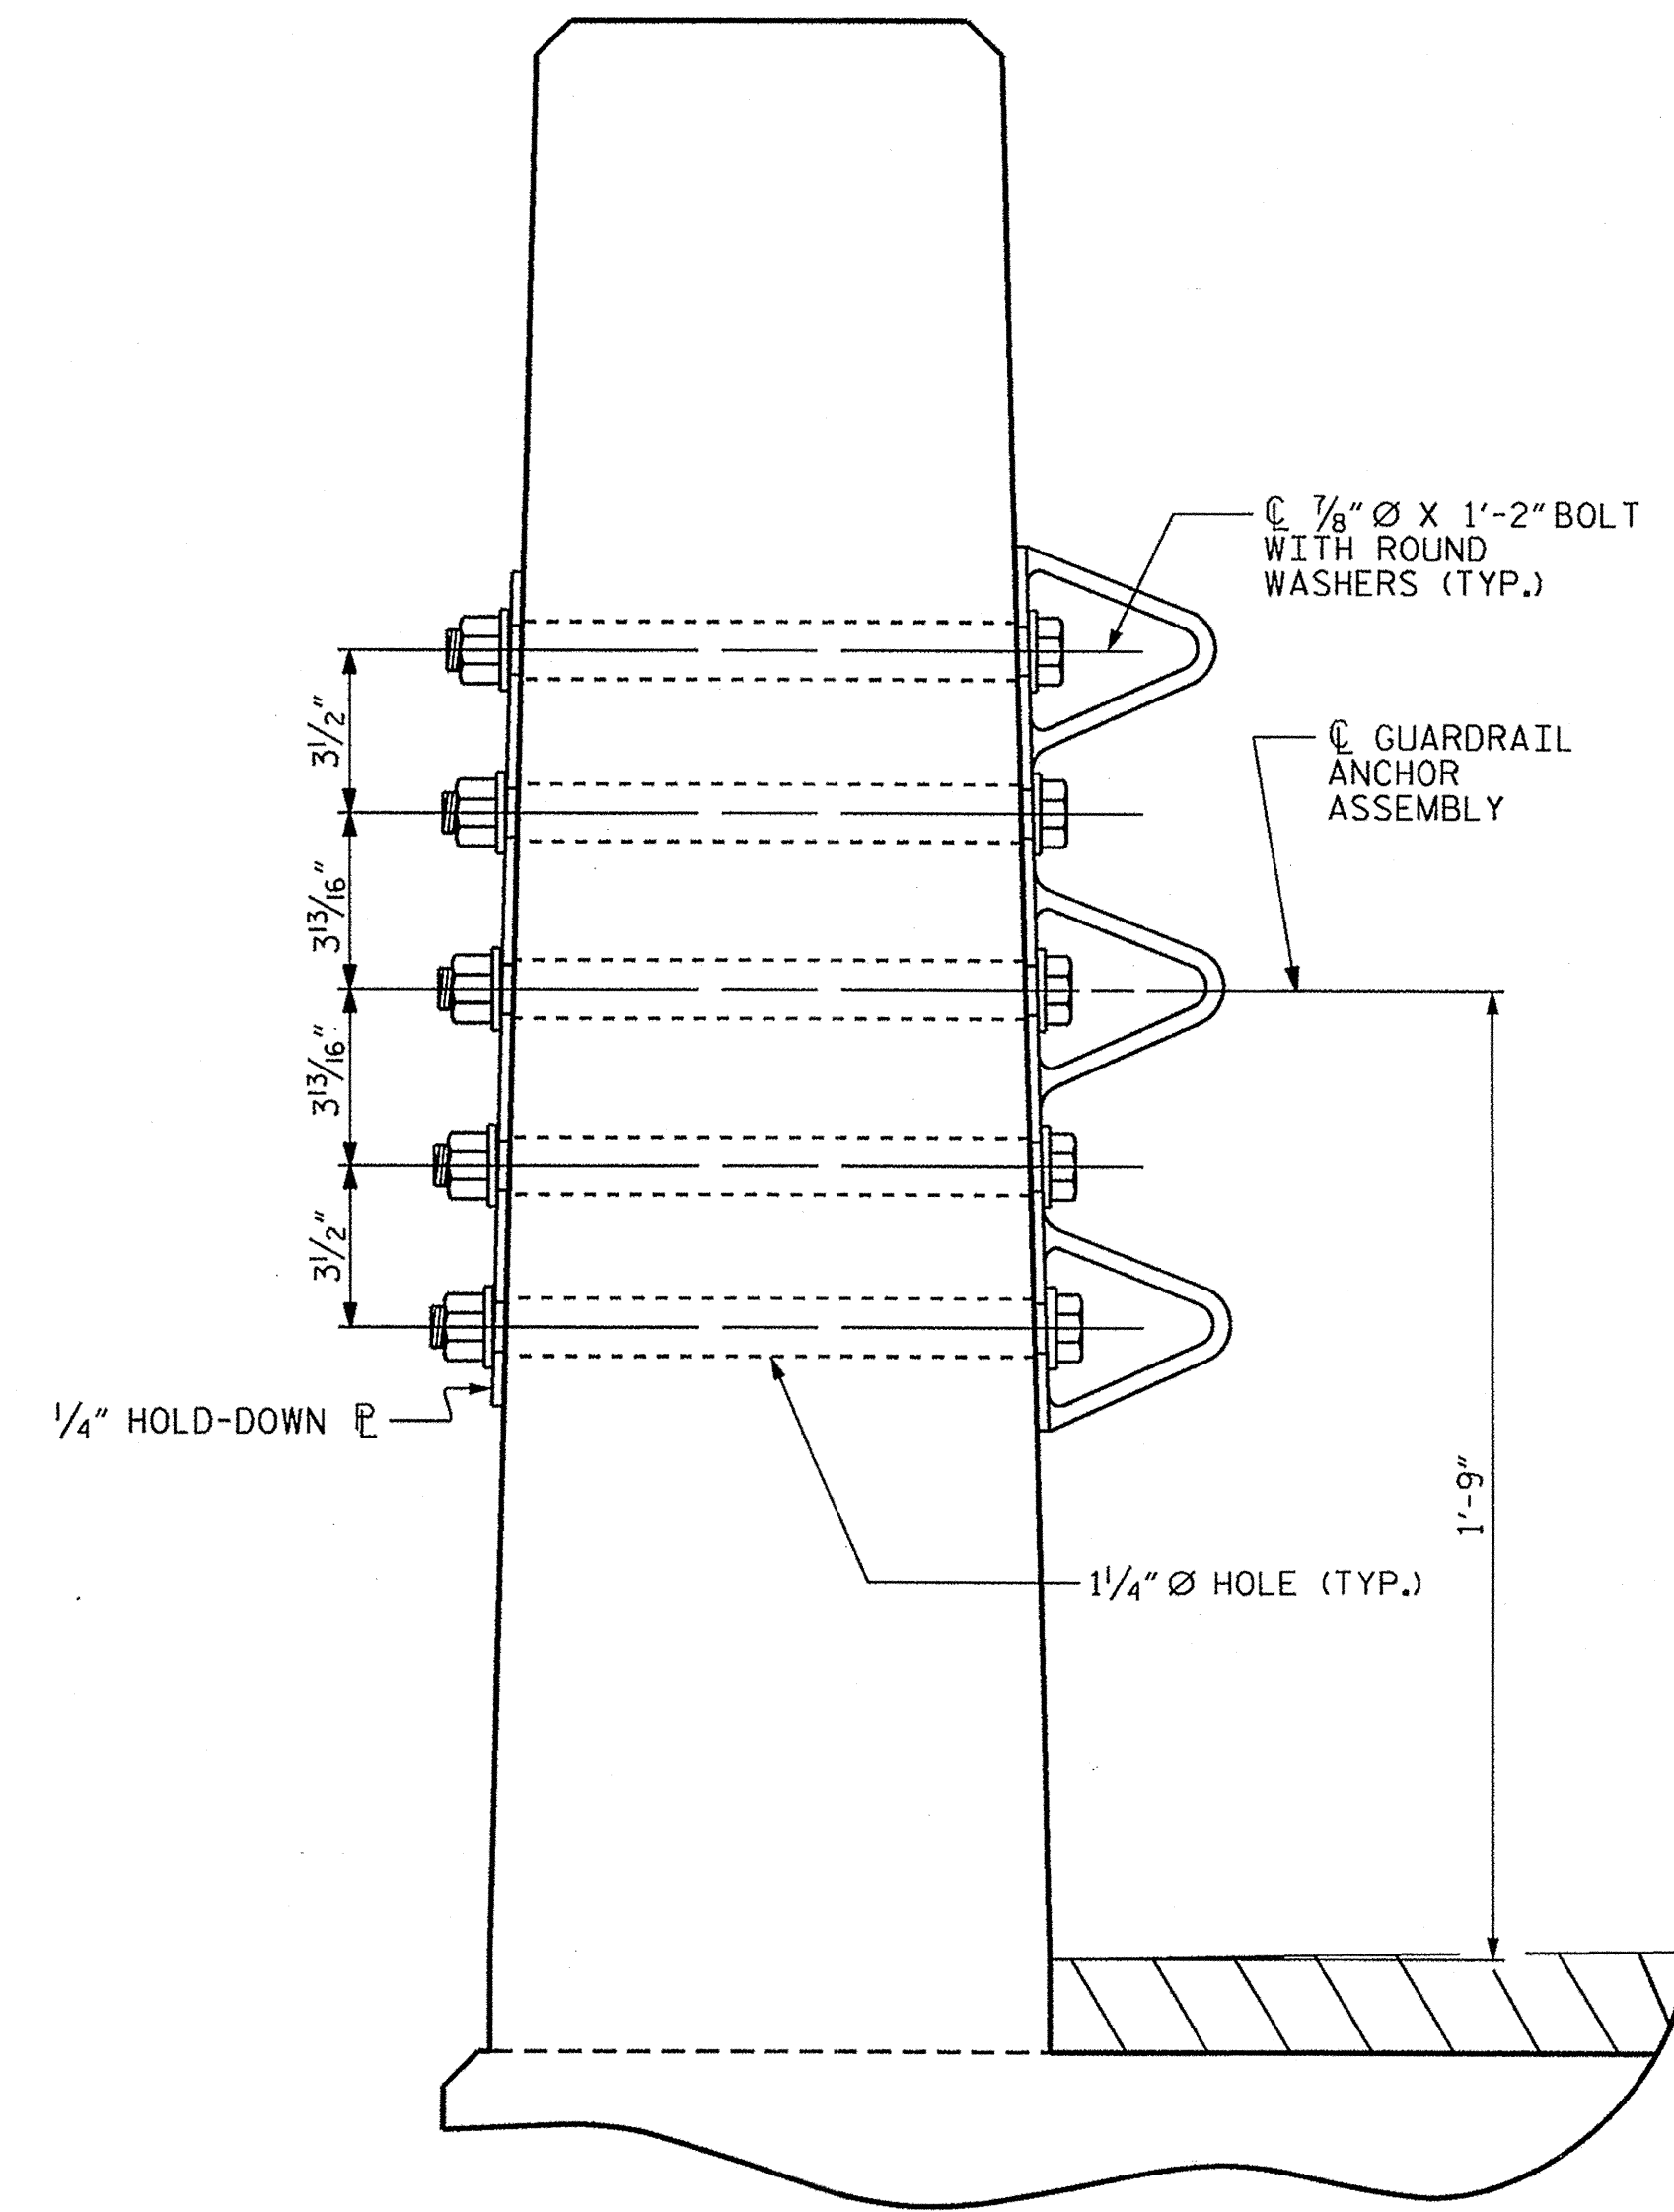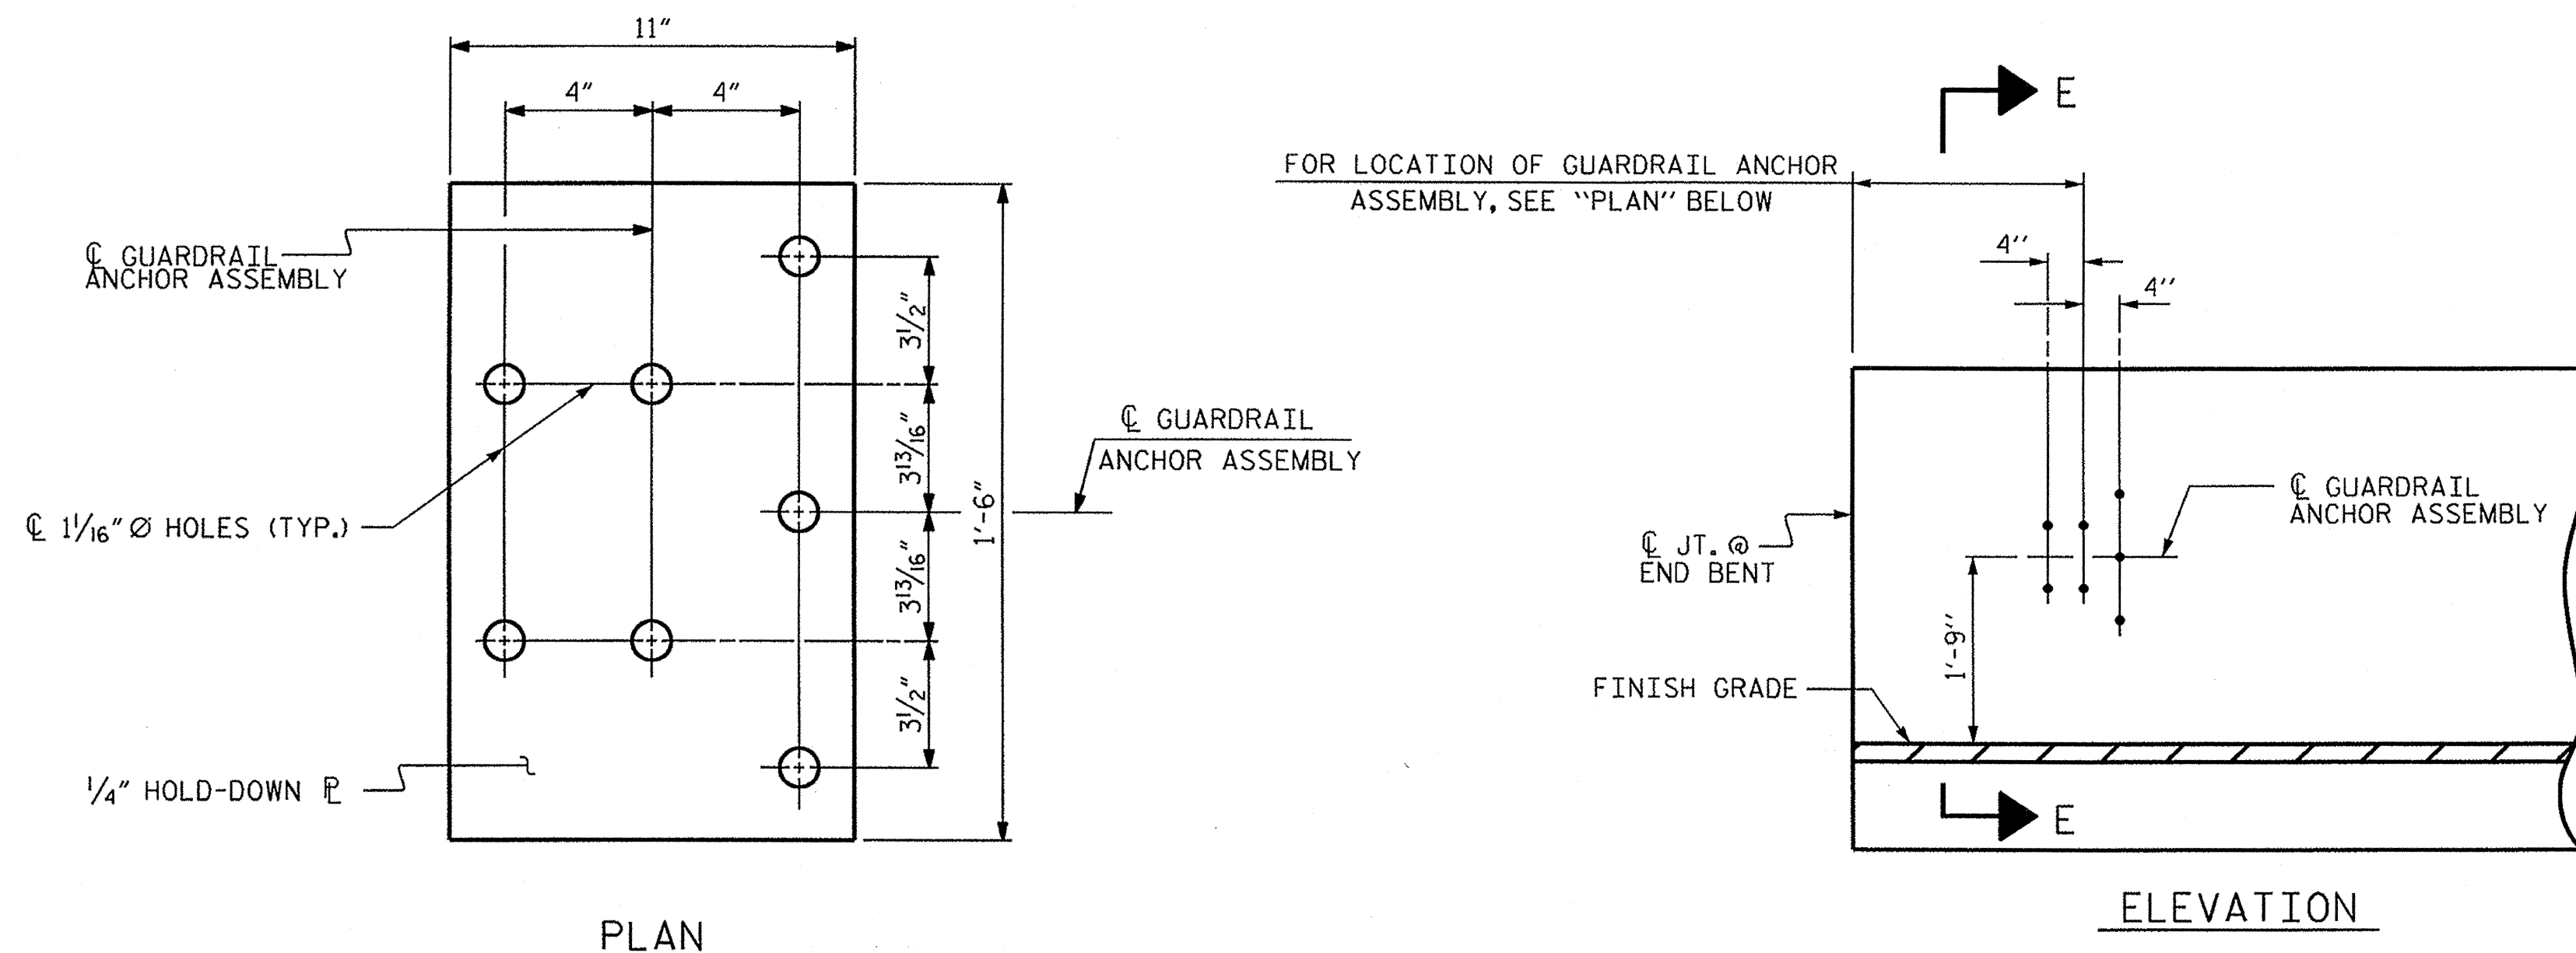

LOCATION OF ANCHORS FOR GUARDRAIL


END BENT #1 SHOWN, END BENT #2 SIMILAR.

SKETCH SHOWING POINTS OF ATTACHMENT

* DENOTES GUARDRAIL ANCHOR ASSEMBLY

PROJECT NO. BD-5102M
LENOIR COUNTY
 STATION: 12+95.00 -L-

STATE OF NORTH CAROLINA
 DEPARTMENT OF TRANSPORTATION
 RALEIGH
 STANDARD
 GUARDRAIL ANCHORAGE
 FOR VERTICAL CONCRETE
 BARRIER RAIL

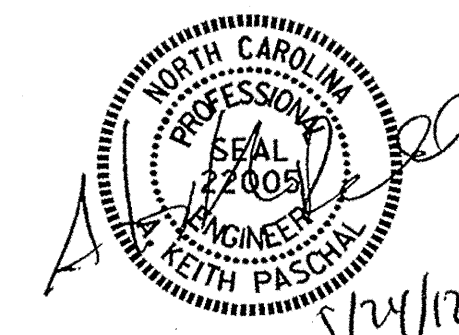

ASSEMBLED BY : E. K. POPE	DATE : 4-11-12
CHECKED BY : G. KOUCHEKI	DATE : 5-8-12
DRAWN BY : MAA 5/10	ADDED 5/6/10
CHECKED BY : GM 5/10	REV. 10/1/11
	REV. 12/5/11
	MAA/GM
	MAA/GM

24-MAY-2012 11:57
 S:\DPL\kath\BD-5102M\ekpopo\BD5102M_SD_CS.dgn
 kpaschal

REVISIONS						SHEET NO.
NO.	BY:	DATE:	NO.	BY:	DATE:	
1			3			5-7
2			4			TOTAL SHEETS 12


NOTES

STIRRUPS IN CAP MAY BE SHIFTED AS NECESSARY TO CLEAR DOWELS.


THE CONCRETE IN THE SHADED AREA OF THE WING SHALL BE POURED AFTER THE VERTICAL CONCRETE BARRIER RAIL IS CAST IF SLIP FORMING IS USED.

INSTALL THE 4"Ø DRAIN PIPE THROUGH THE WING WALL AS REQUIRED FOR REINFORCED BRIDGE APPROACH FILLS, SEE THE ROADWAY PLANS. REINFORCING STEEL IN THE WING WALL MAY BE SHIFTED AS NECESSARY TO CLEAR THE DRAIN PIPE.

FOR PILE SPLICE DETAILS, SEE SHEET 4 OF 4.
FOR WING DETAILS, SEE SHEET 3 OF 4.

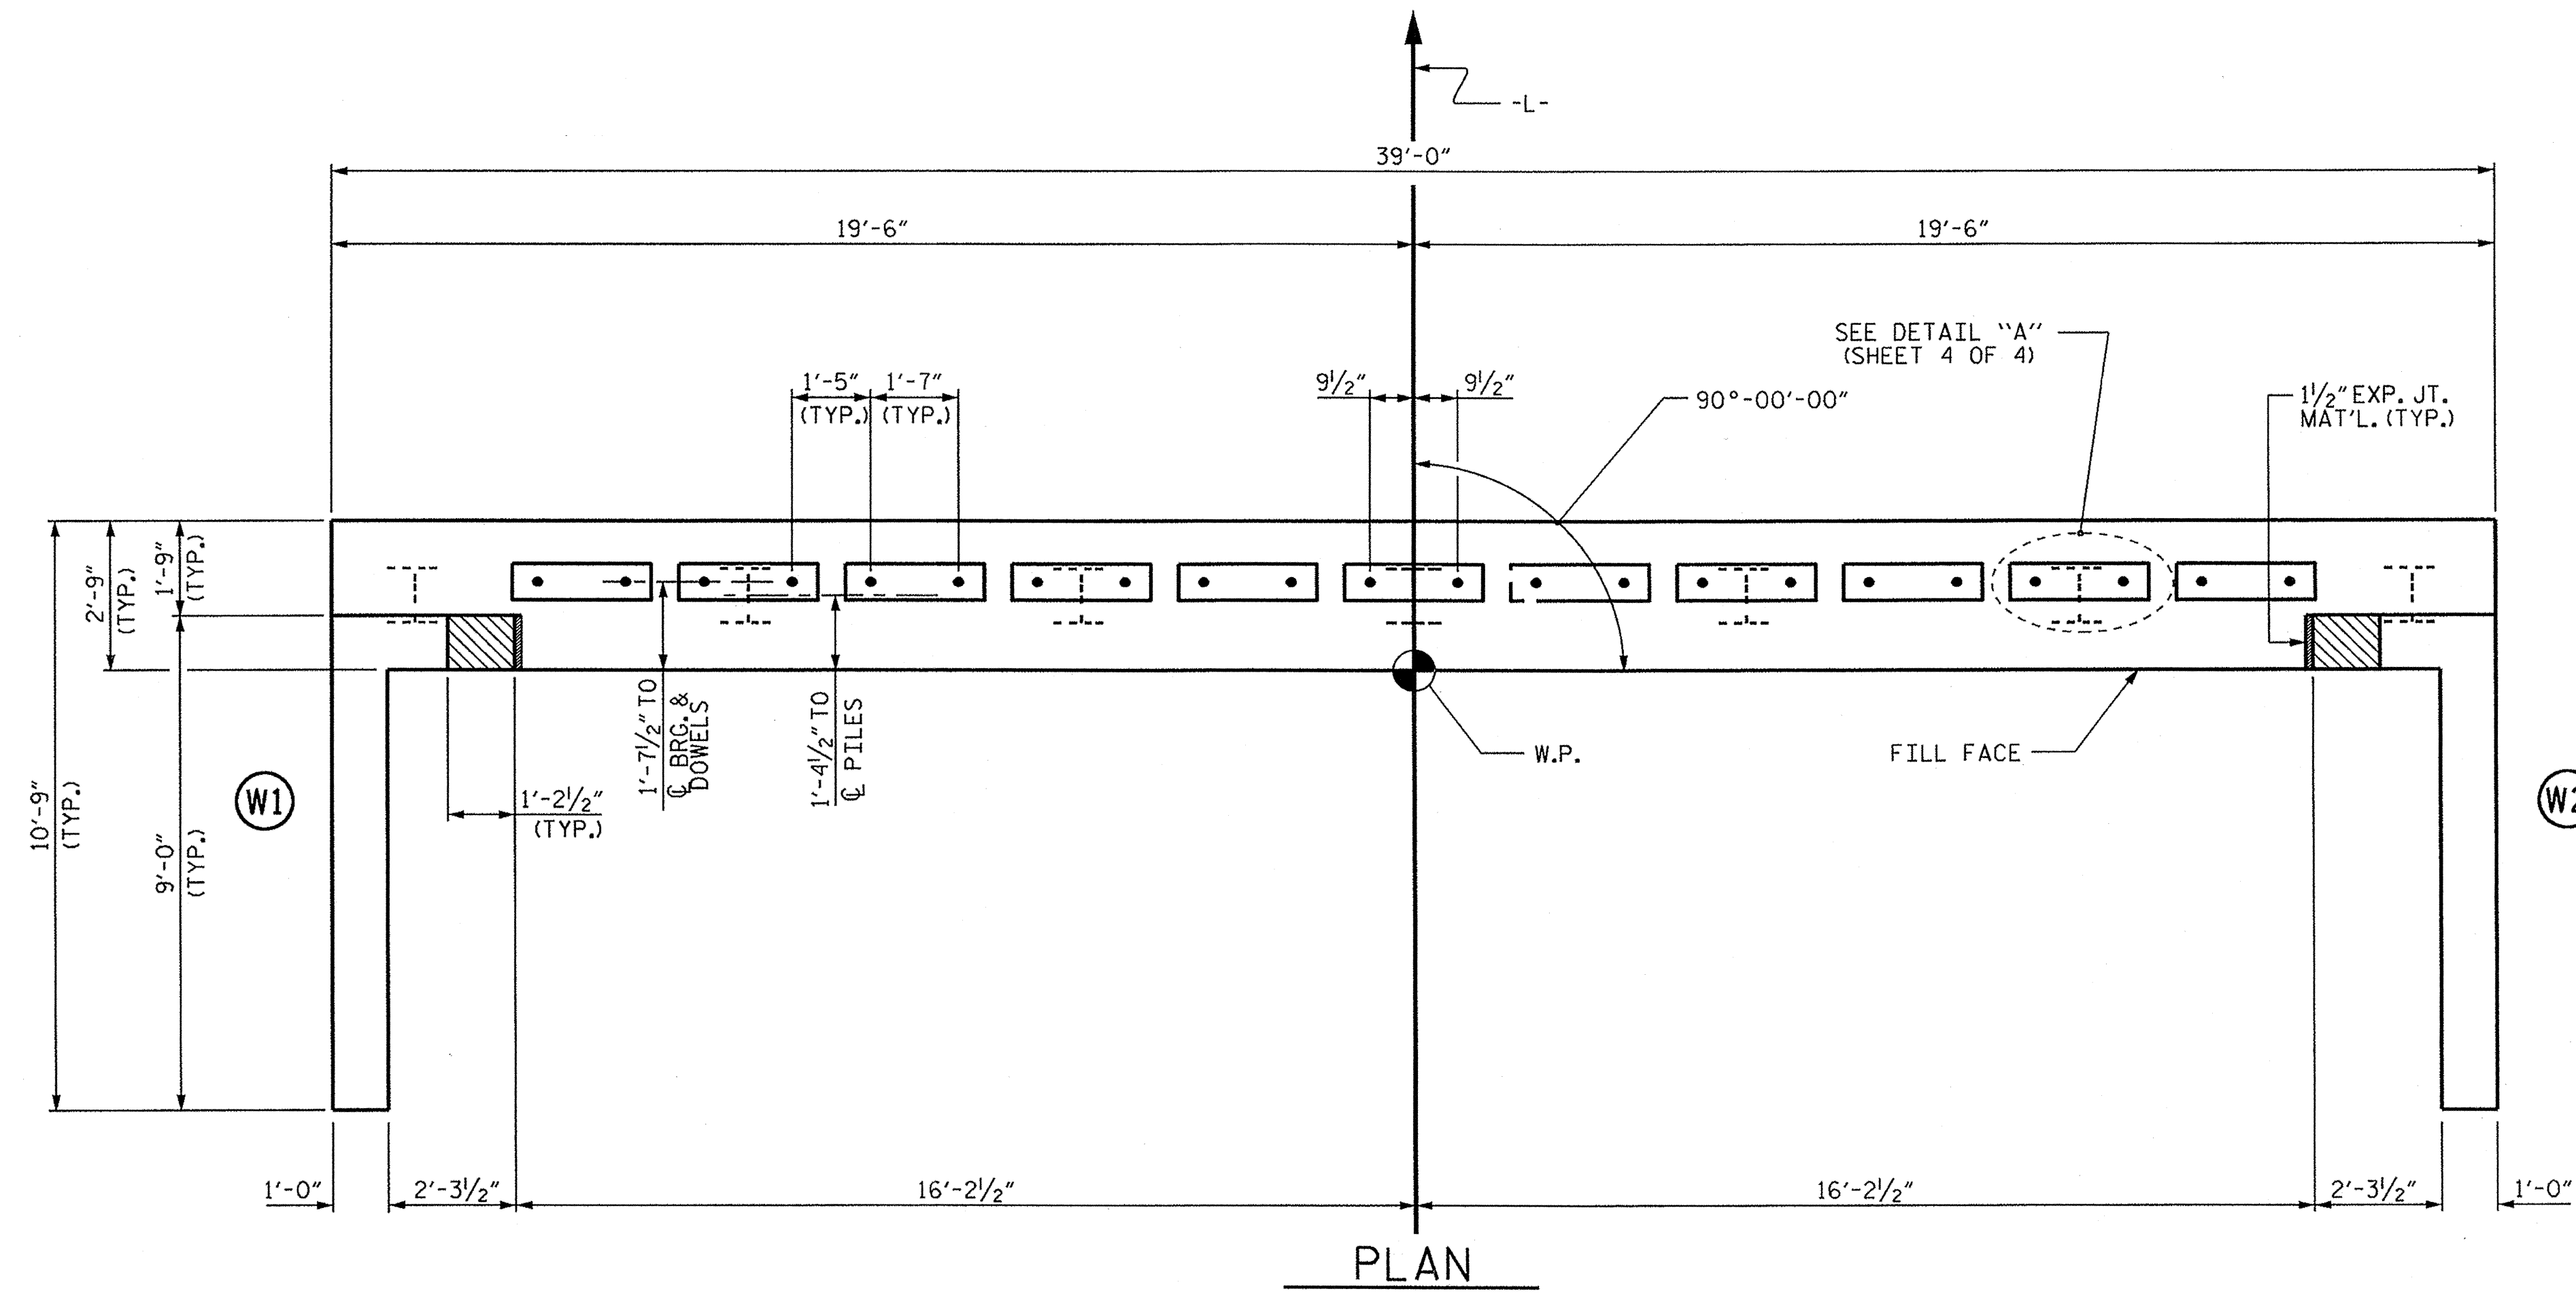

PLAN

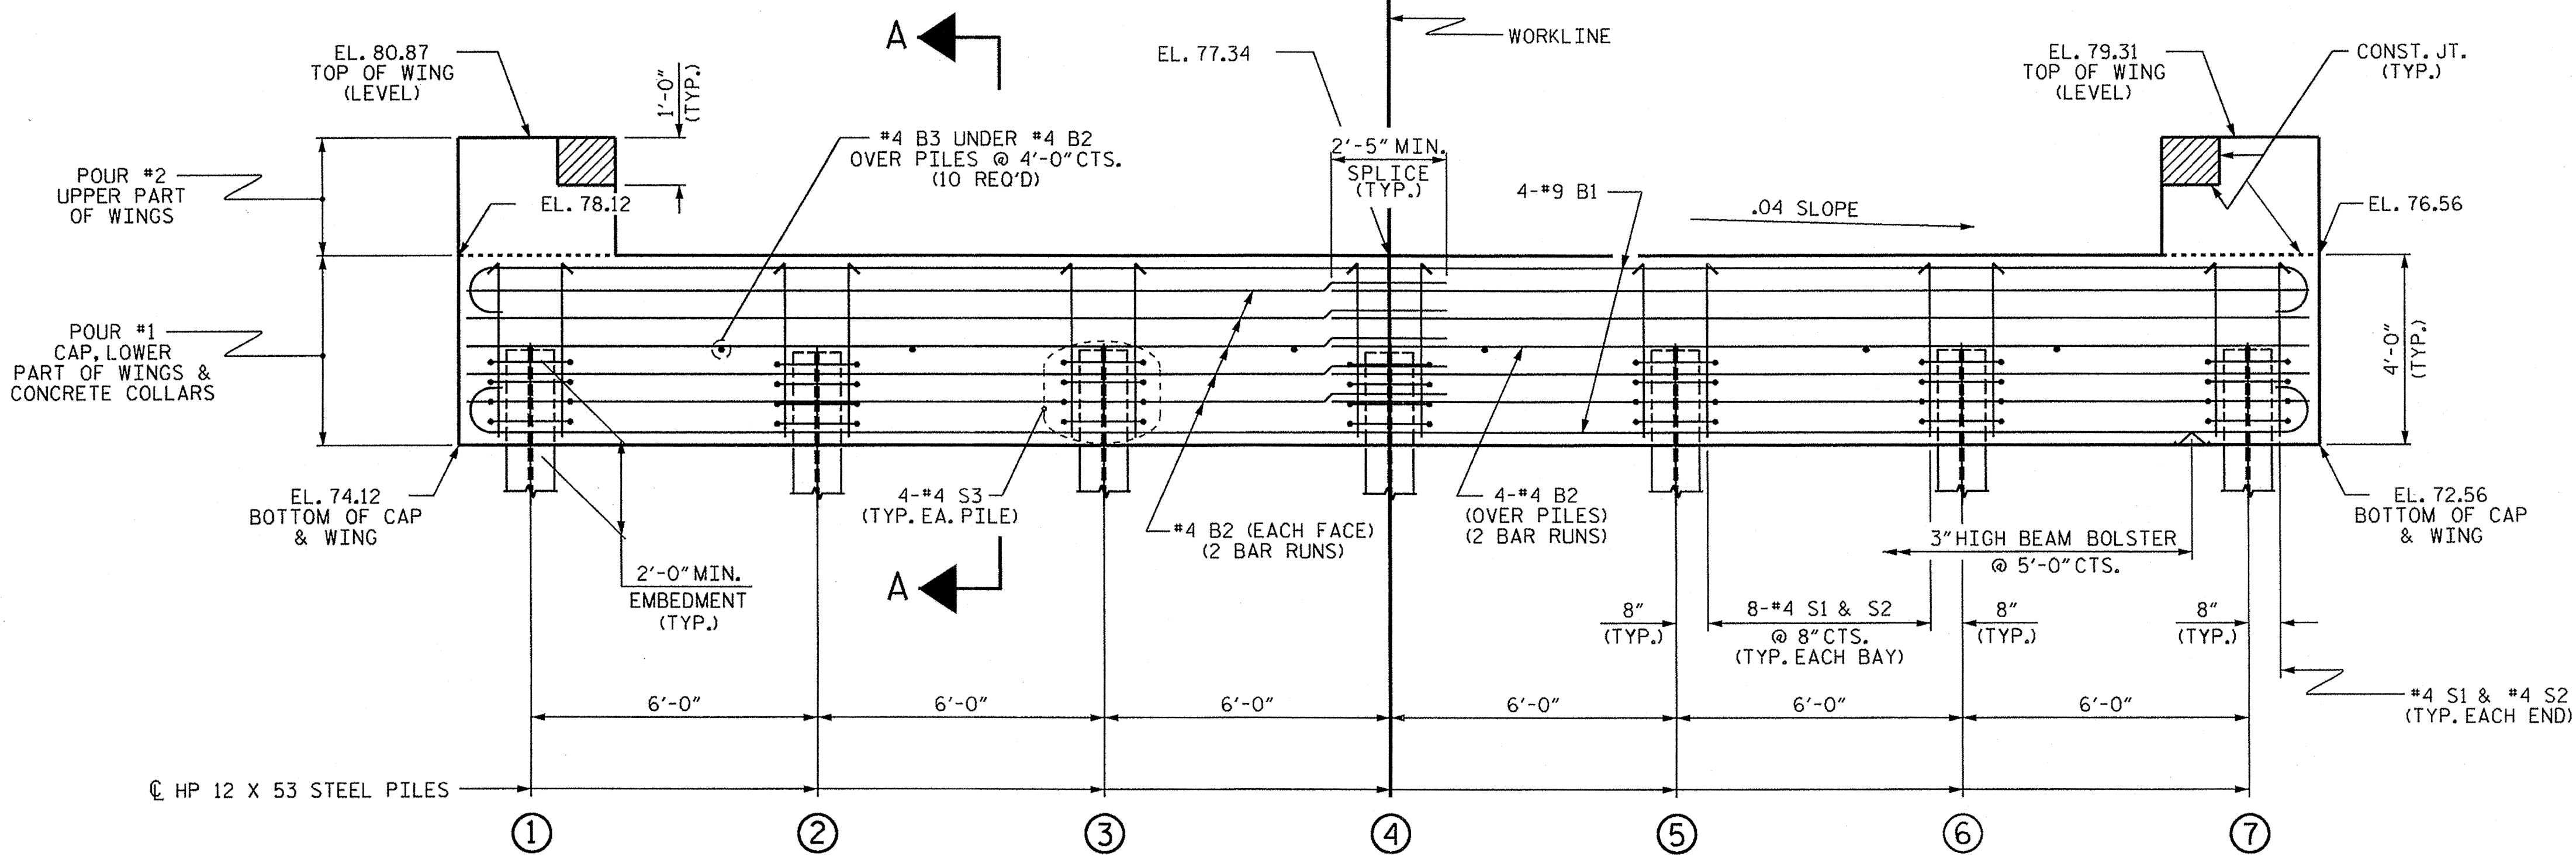


ELEVATION

TOP OF PILE ELEVATIONS	
①	75.06
②	74.82
③	74.58
④	74.34
⑤	74.10
⑥	73.86
⑦	73.62

PROJECT NO. BD-5102M
LENOIR COUNTY
 STATION: 12+95.00 -L-

SHEET 1 OF 4

STATE OF NORTH CAROLINA DEPARTMENT OF TRANSPORTATION RALEIGH						SHEET NO. 5-8
SUBSTRUCTURE						TOTAL SHEETS 12
END BENT No. 1						
REVISIONS						
NO.	BY:	DATE:	NO.	BY:	DATE:	
1			3			
2			4			

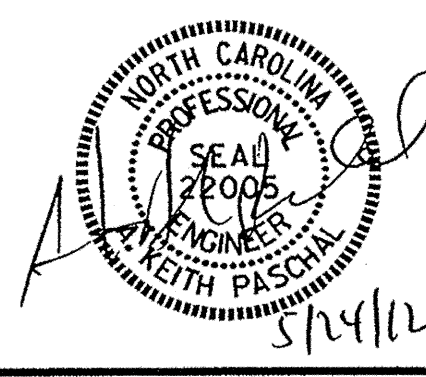

ASSEMBLED BY : E. K. POPE DATE : 4-11-12
 CHECKED BY : G. KOUCHEKI DATE : 3-8-12
 DRAWN BY : WJH 12/11
 CHECKED BY : AAC 12/11

WINGS NOT SHOWN FOR CLARITY.
 FOR SECTION A-A, SEE SHEET 4 OF 4.
 CONCRETE COLLARS FOR STEEL PILES NOT SHOWN IN PLAN AND ELEVATION VIEWS FOR CLARITY.
 SEE "CORROSION PROTECTION FOR STEEL PILES DETAIL", SHEET 4 OF 4.

NOTES


STIRRUPS IN CAP MAY BE SHIFTED AS NECESSARY TO CLEAR DOWELS.

THE CONCRETE IN THE SHADED AREA OF THE WING SHALL BE POURED AFTER THE VERTICAL CONCRETE BARRIER RAIL IS CAST IF SLIP FORMING IS USED.

INSTALL THE 4" Ø DRAIN PIPE THROUGH THE WING WALL AS REQUIRED FOR REINFORCED BRIDGE APPROACH FILLS, SEE THE ROADWAY PLANS. REINFORCING STEEL IN THE WING WALL MAY BE SHIFTED AS NECESSARY TO CLEAR THE DRAIN PIPE.


FOR PILE SPLICE DETAILS, SEE SHEET 4 OF 4.

FOR WING DETAILS, SEE SHEET 3 OF 4.

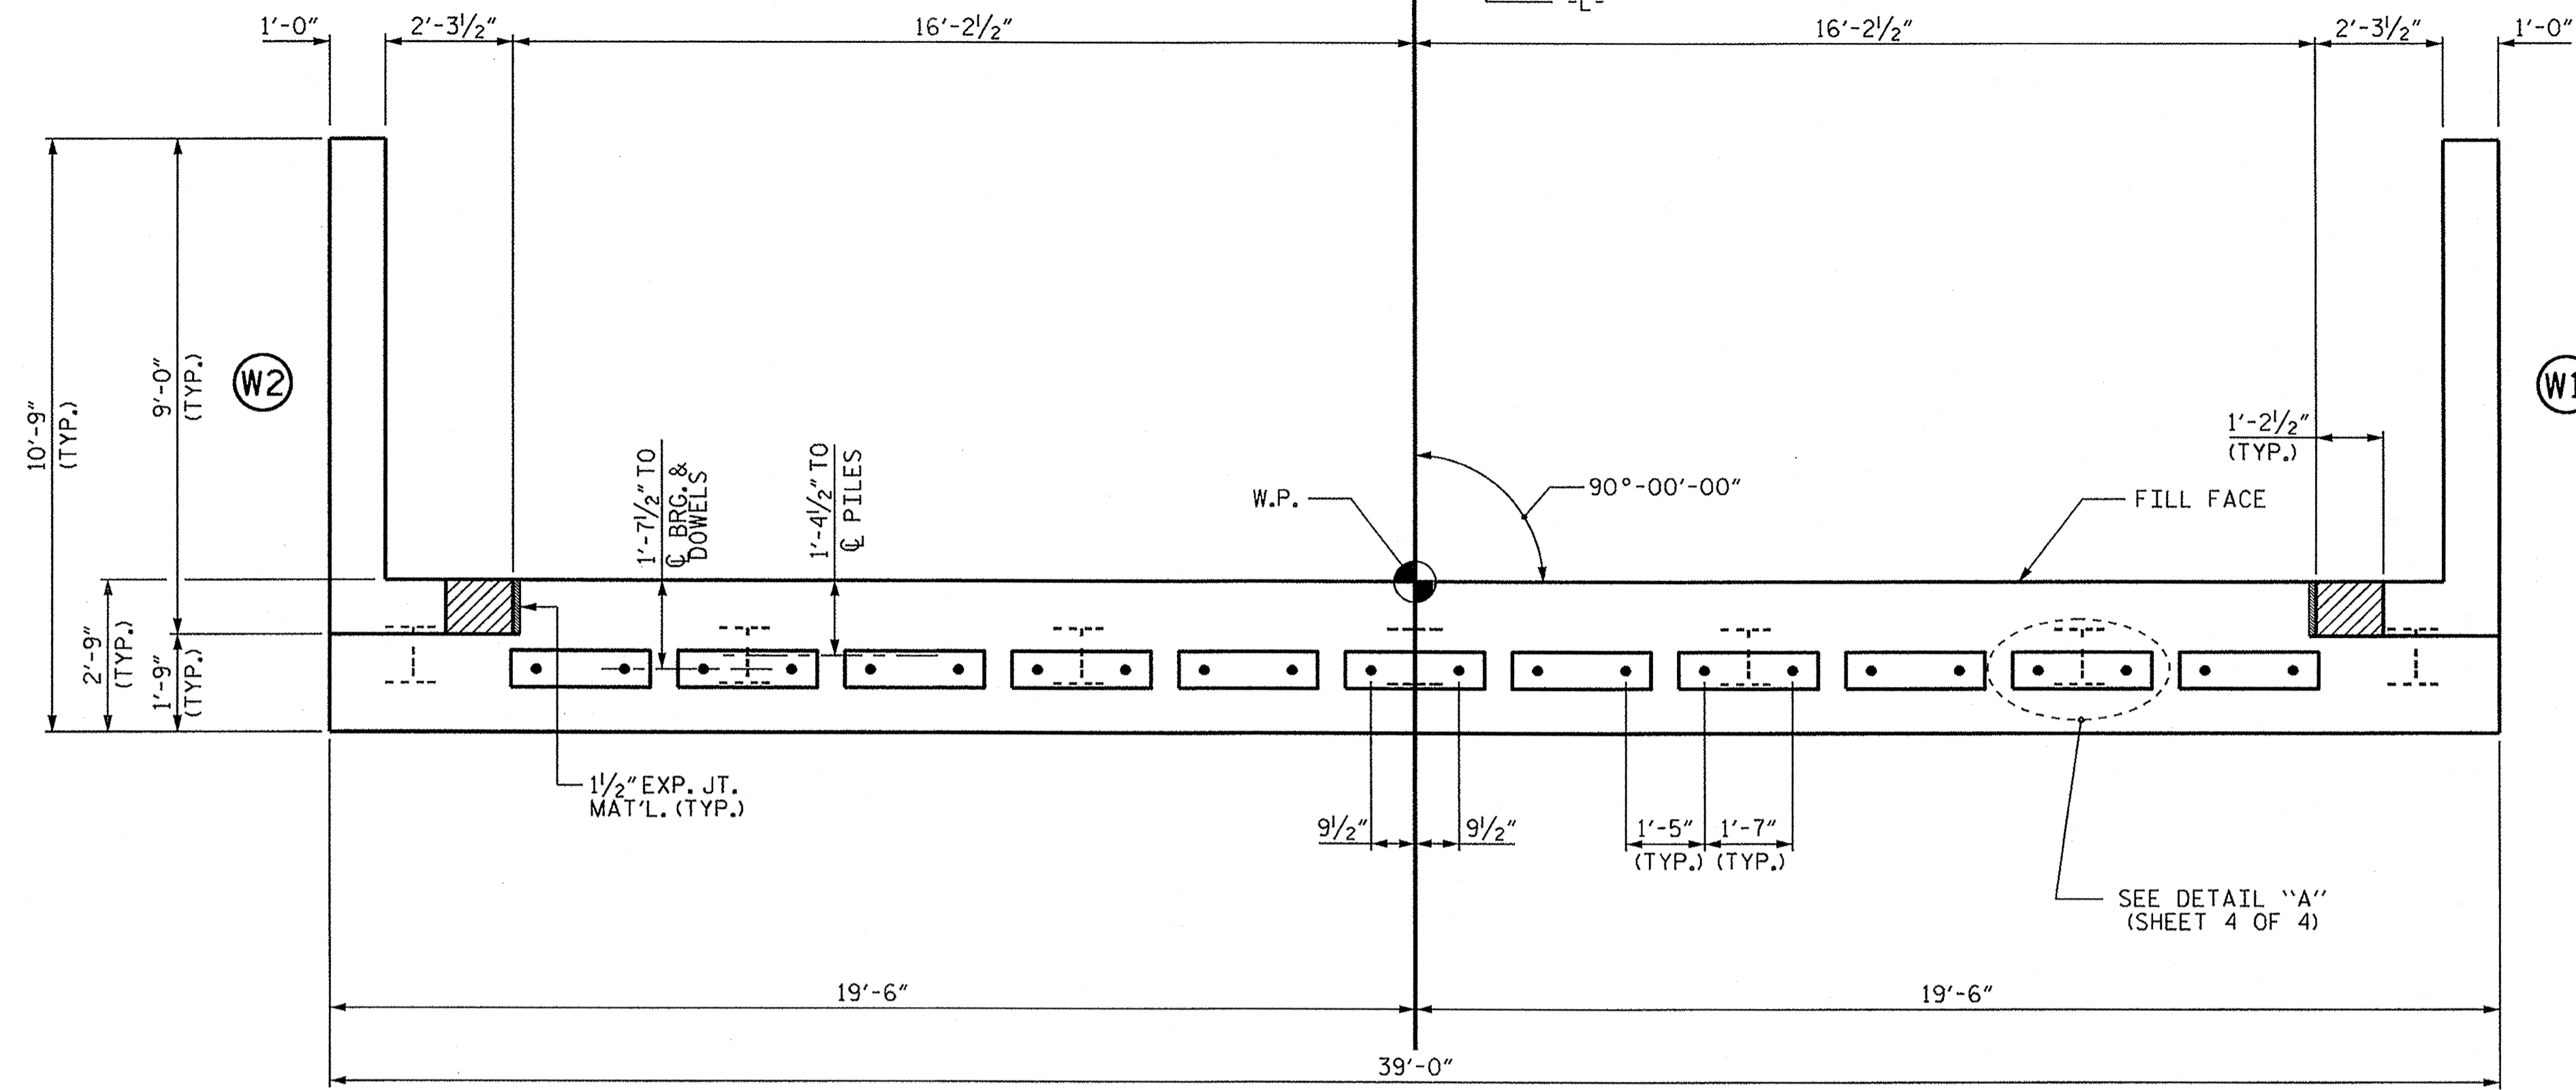

PLAN

TOP OF PILE ELEVATIONS	
①	75.23
②	74.99
③	74.75
④	74.51
⑤	74.27
⑥	74.03
⑦	73.79

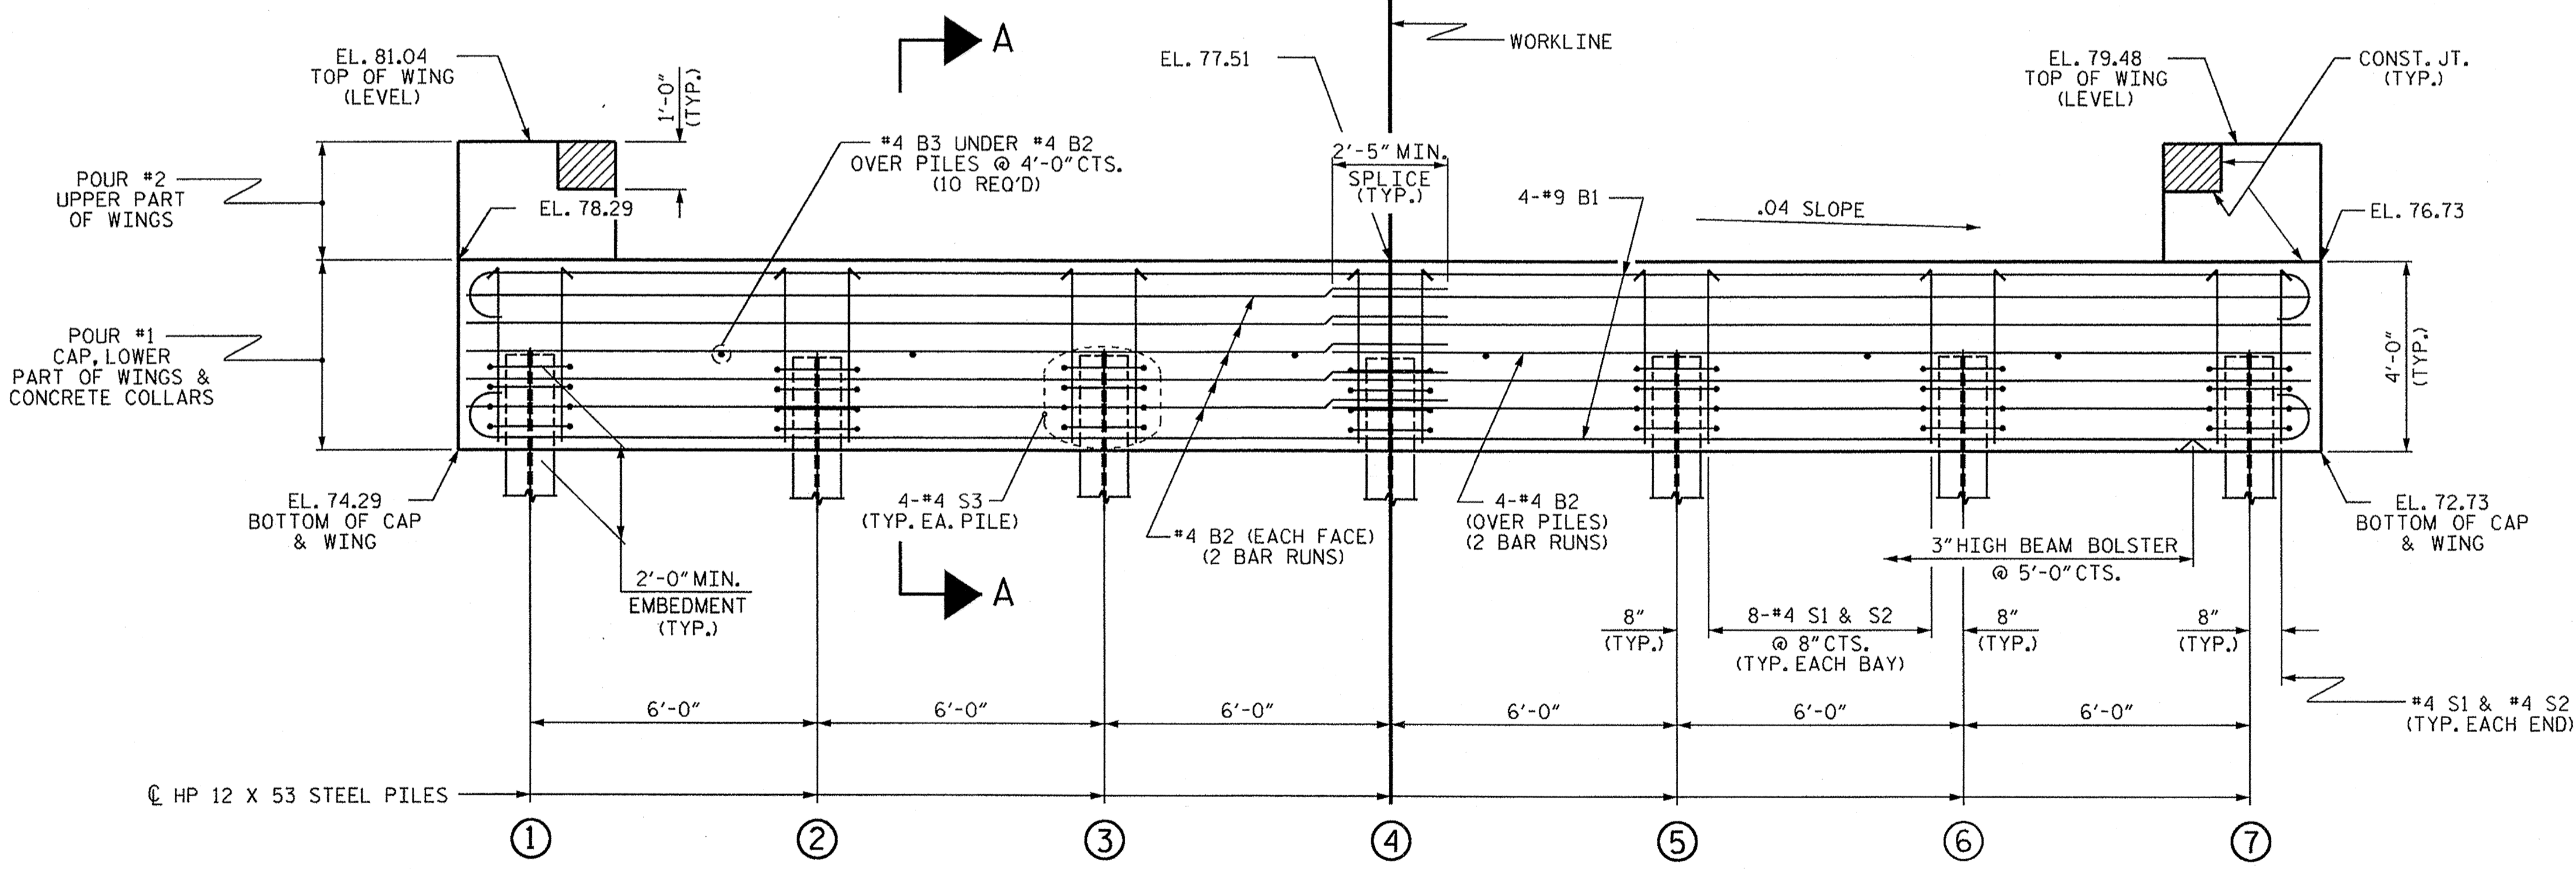


ELEVATION

WINGS NOT SHOWN FOR CLARITY.
 FOR SECTION A-A, SEE SHEET 4 OF 4.
 CONCRETE COLLARS FOR STEEL PILES NOT SHOWN IN PLAN AND ELEVATION VIEWS FOR CLARITY.
 SEE "CORROSION PROTECTION FOR STEEL PILES DETAIL", SHEET 4 OF 4.

PROJECT NO. BD-5102M
LENOIR COUNTY
 STATION: 12+95.00 -L-


SHEET 2 OF 4

STATE OF NORTH CAROLINA DEPARTMENT OF TRANSPORTATION RALEIGH					
SUBSTRUCTURE					
END BENT No. 2					
REVISIONS					
NO.	BY:	DATE:	NO.	BY:	DATE:
1			3		
2			4		

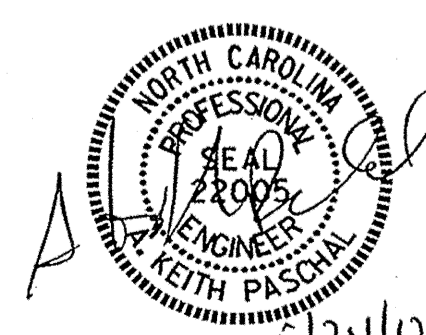


ASSEMBLED BY : E. K. POPE DATE : 4-11-12
 CHECKED BY : G. KOUCHEKI DATE : 3-8-12
 DRAWN BY : WJH 12/11
 CHECKED BY : AAC 12/11


24-MAY-2012 11:57
 S:\DPO1\kath\BD-5102M\ekpoppe\BD5102M_SD_CS.dgn
 Kpaschal

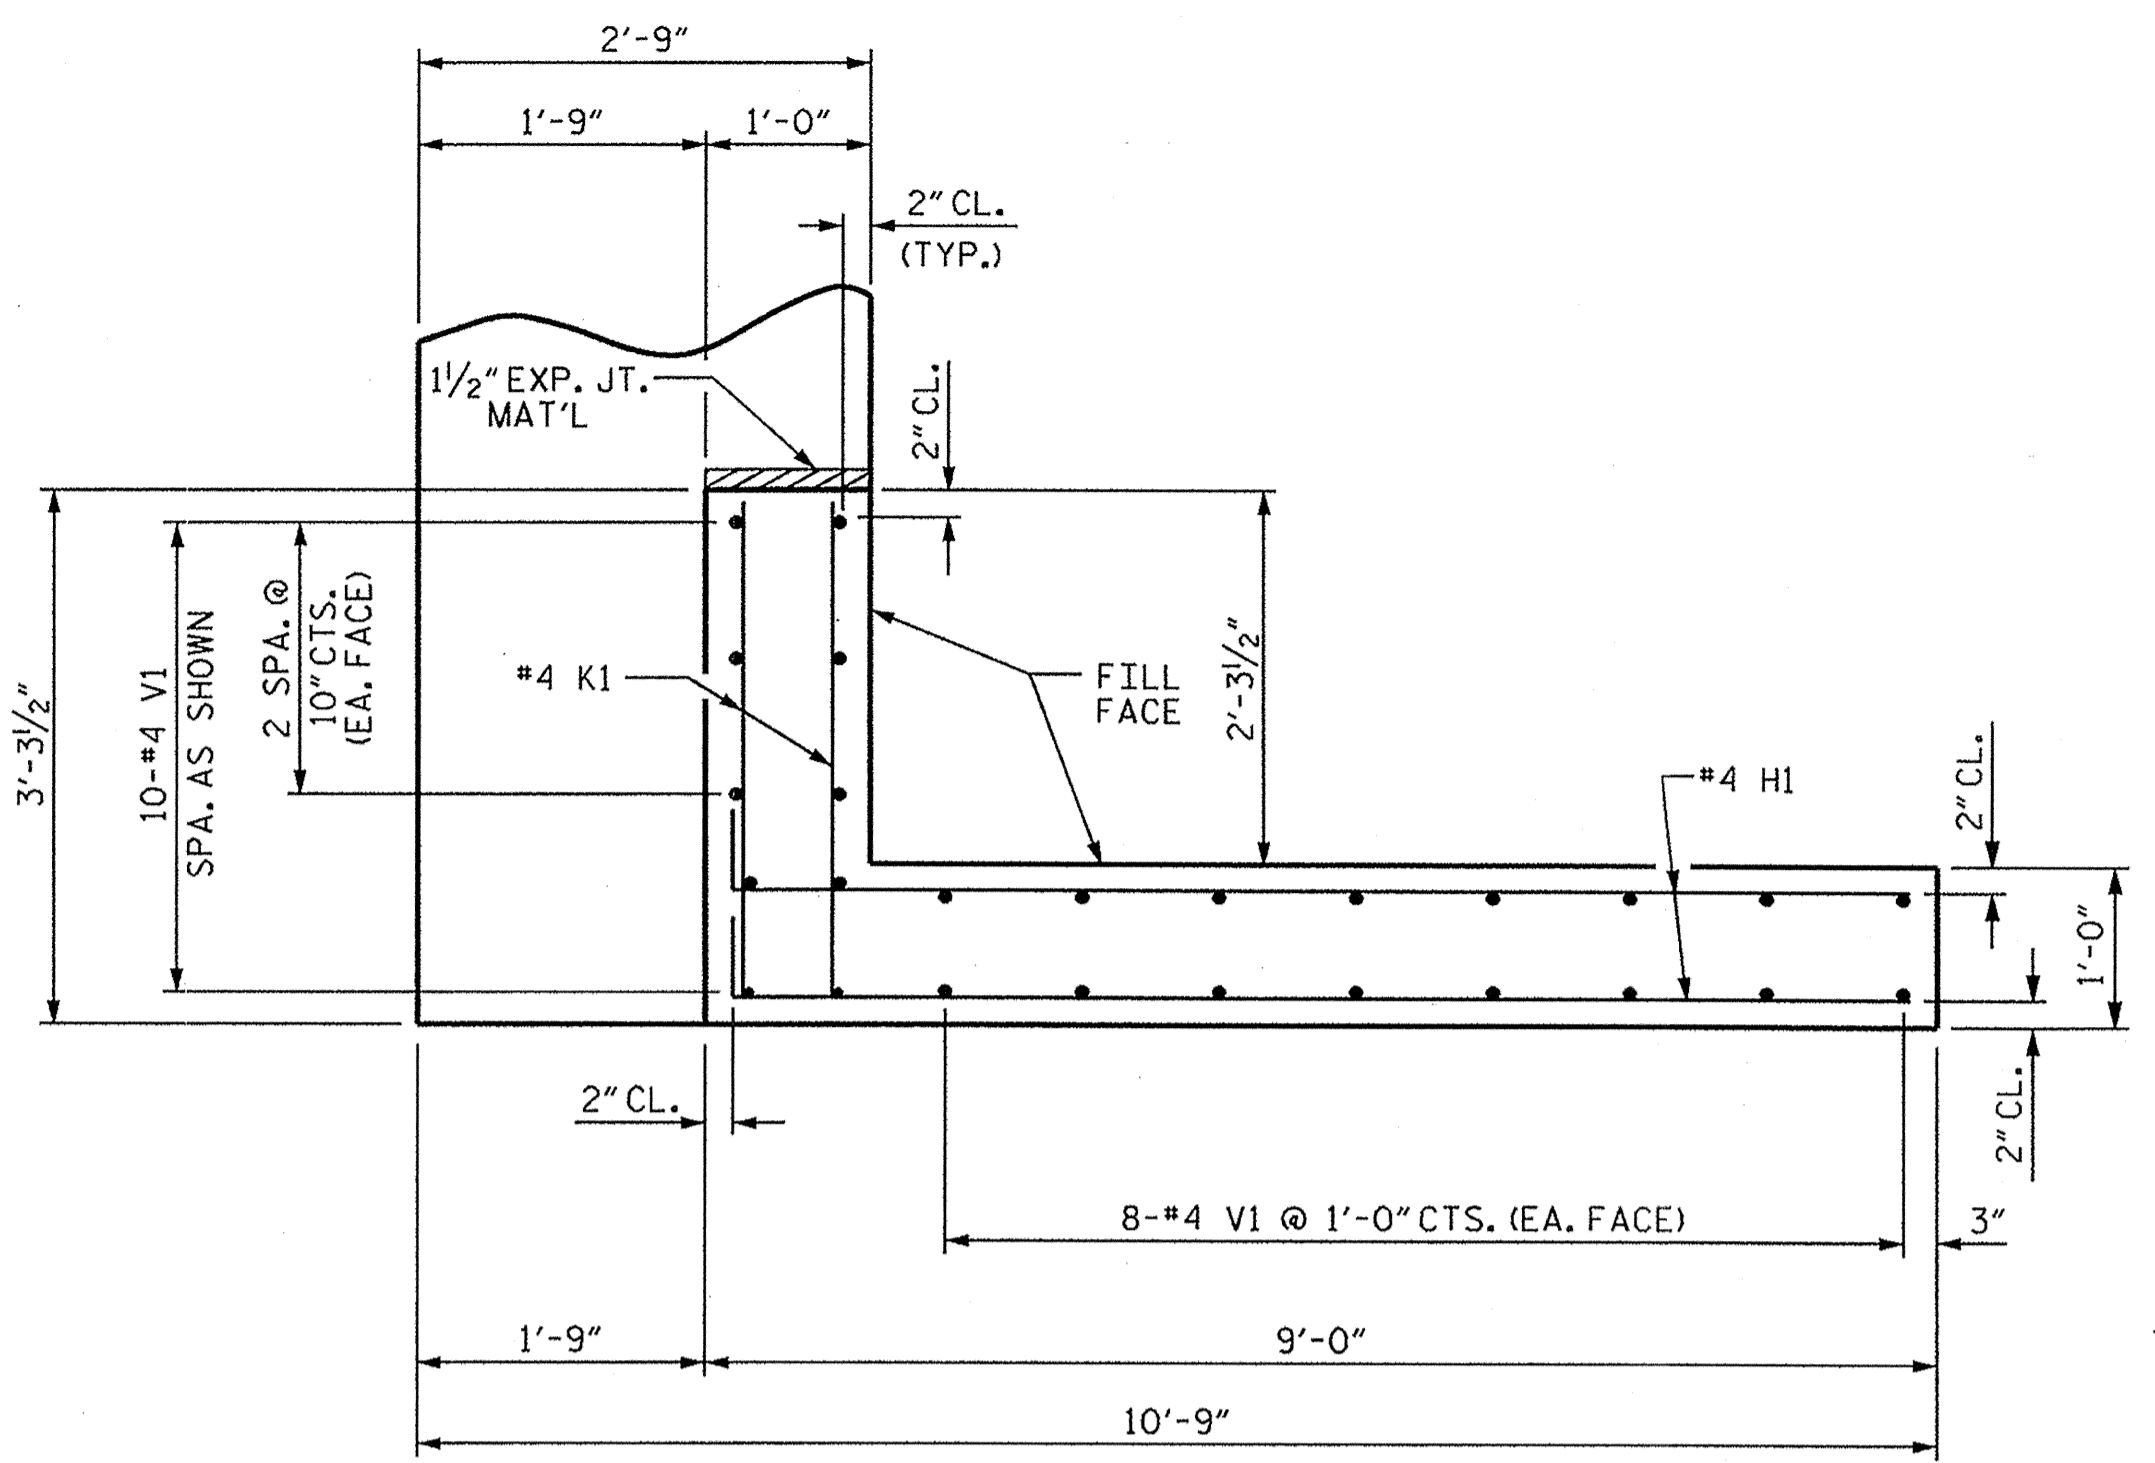


PLAN OF WING (W1)

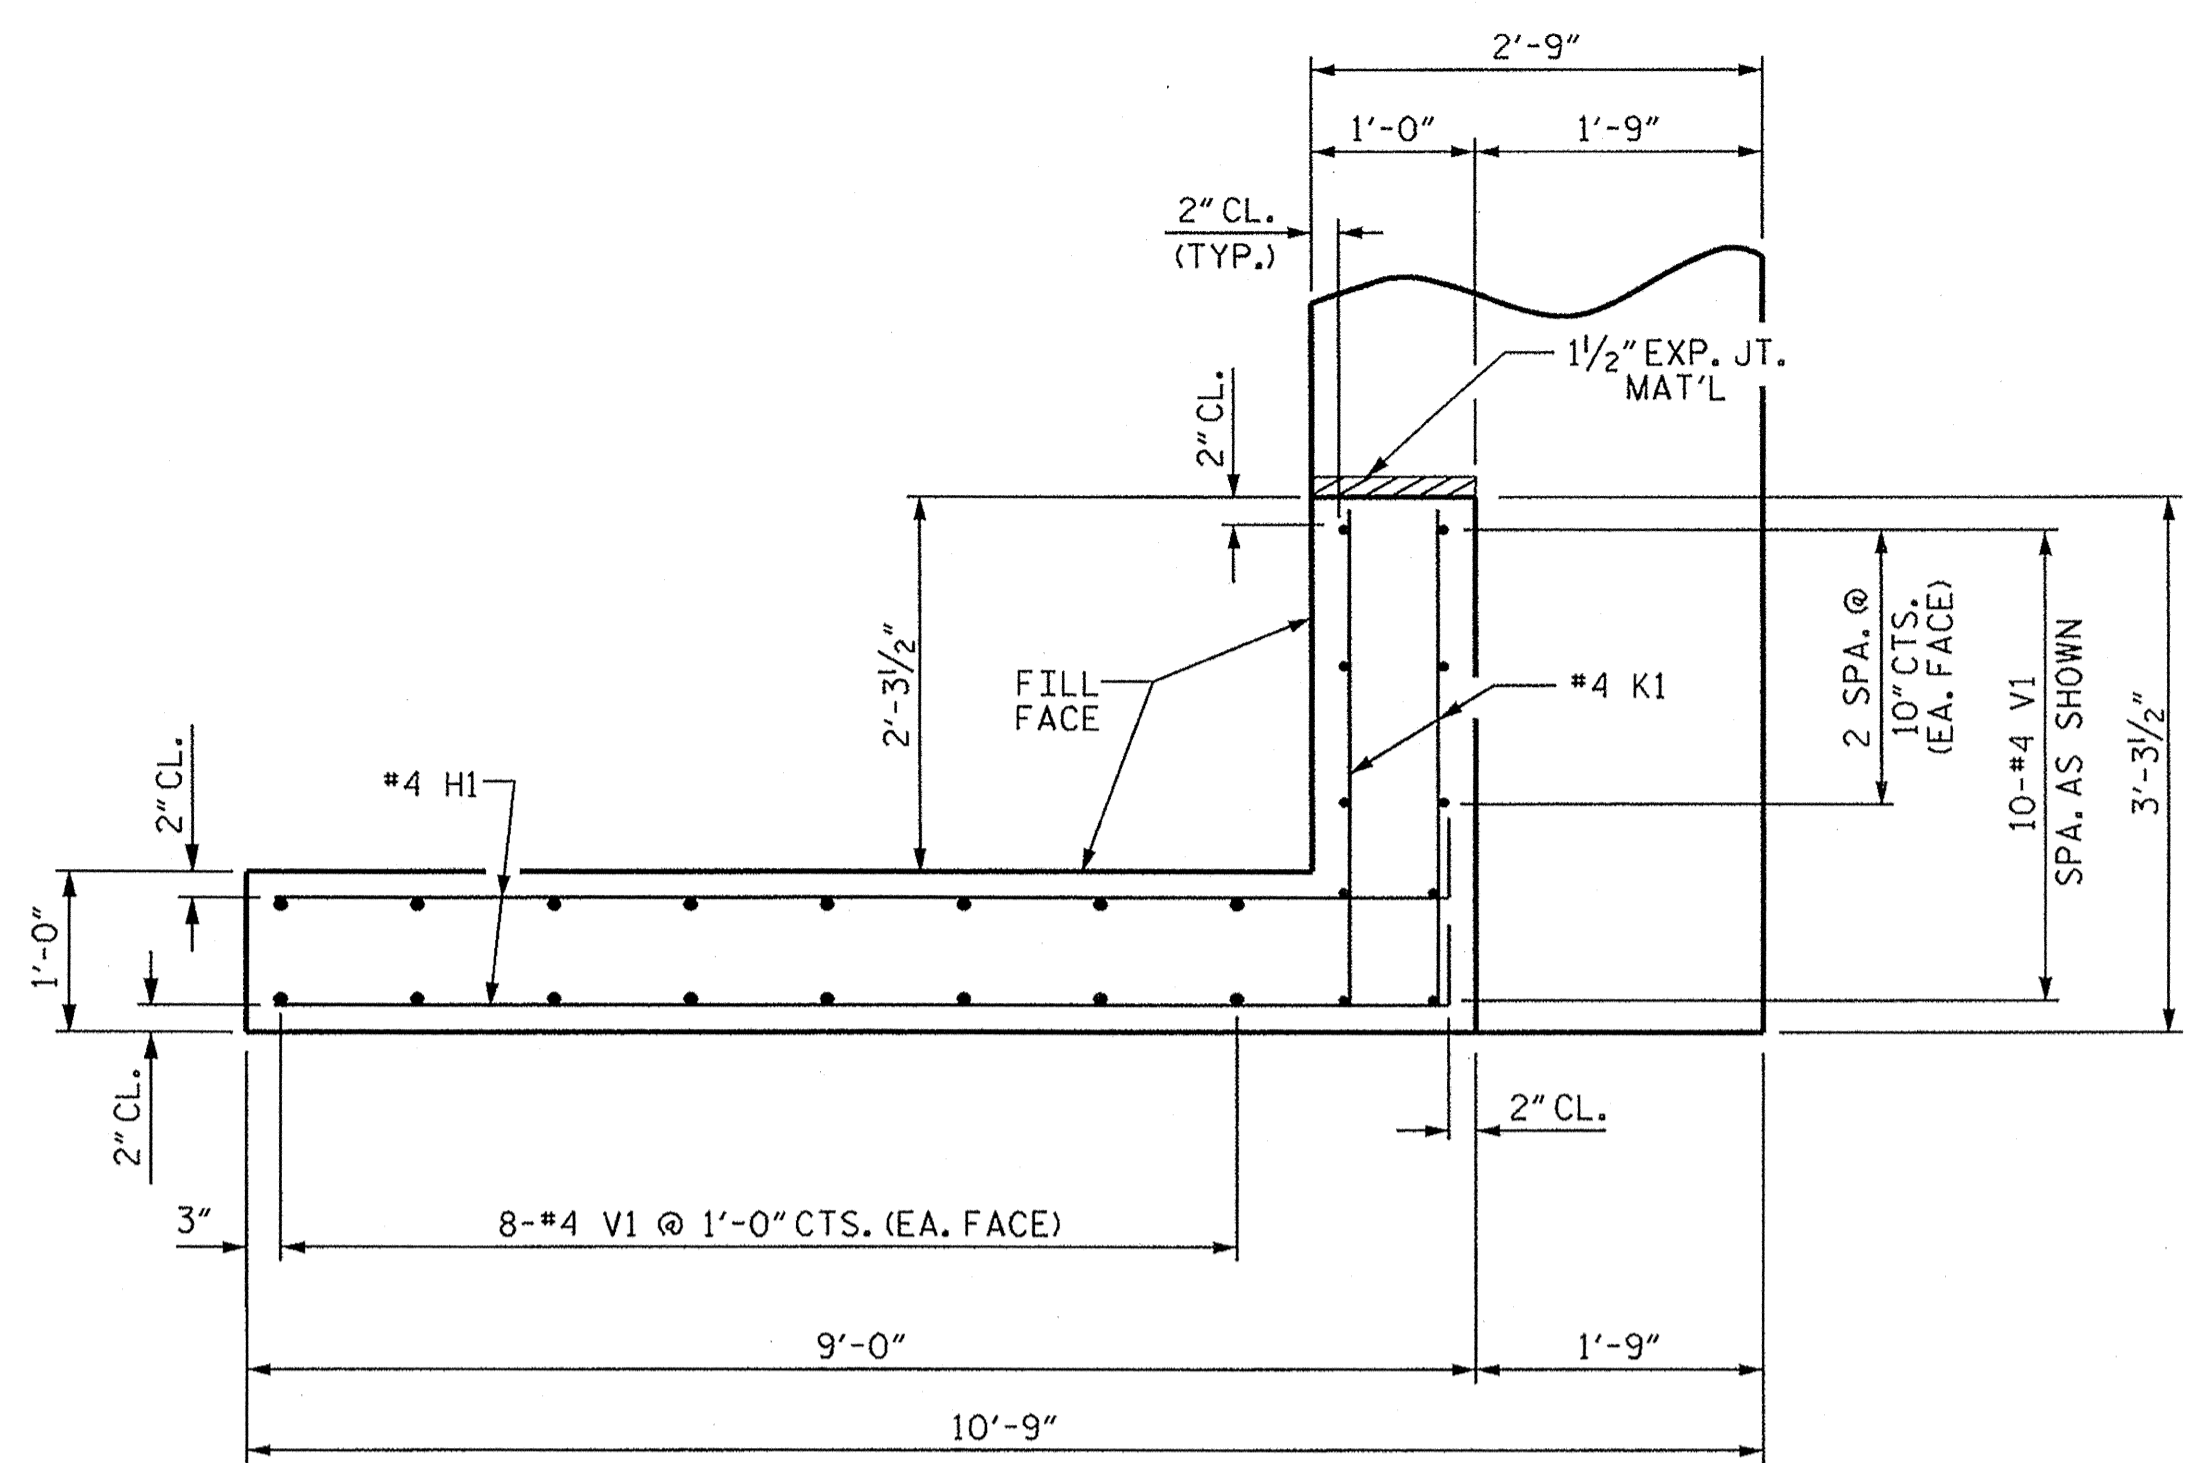


PLAN OF WING (W2)

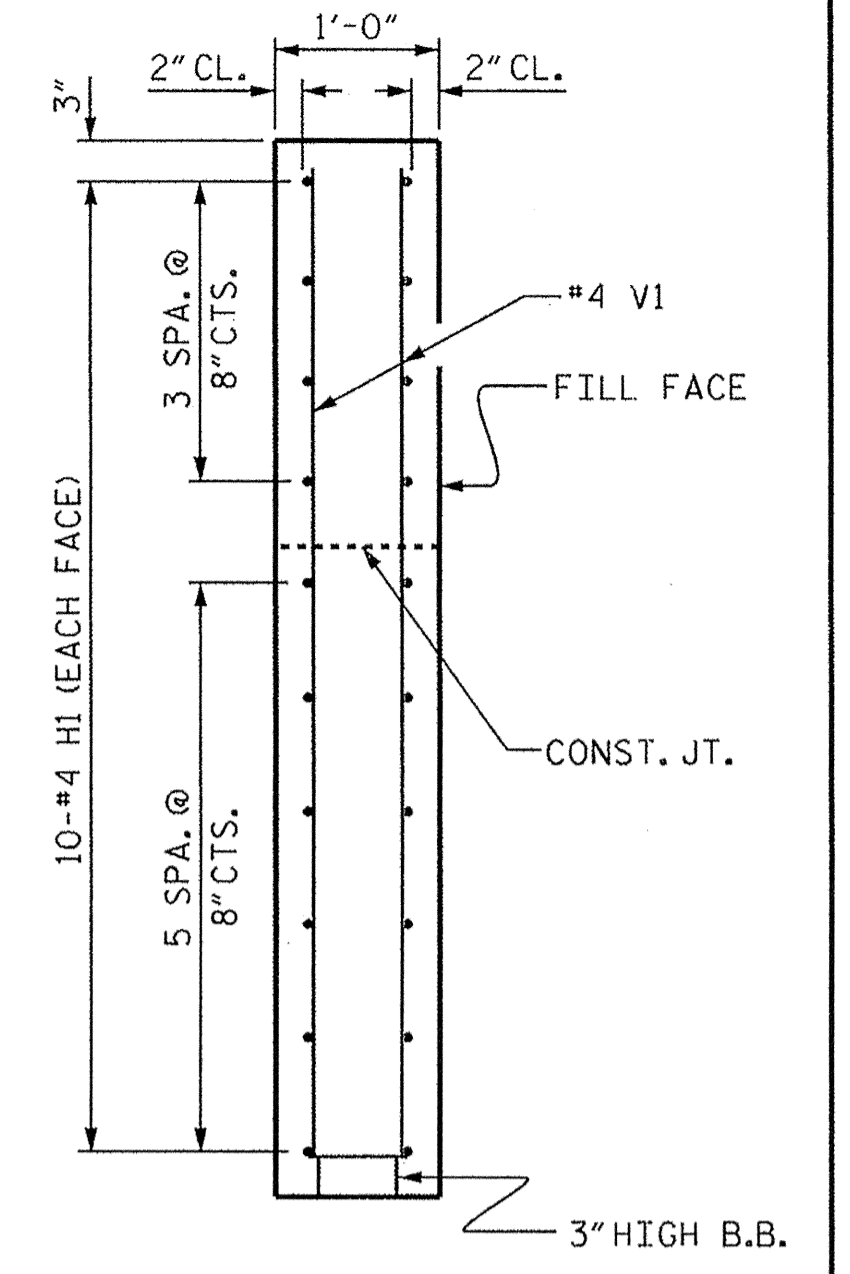


SECTION X-X

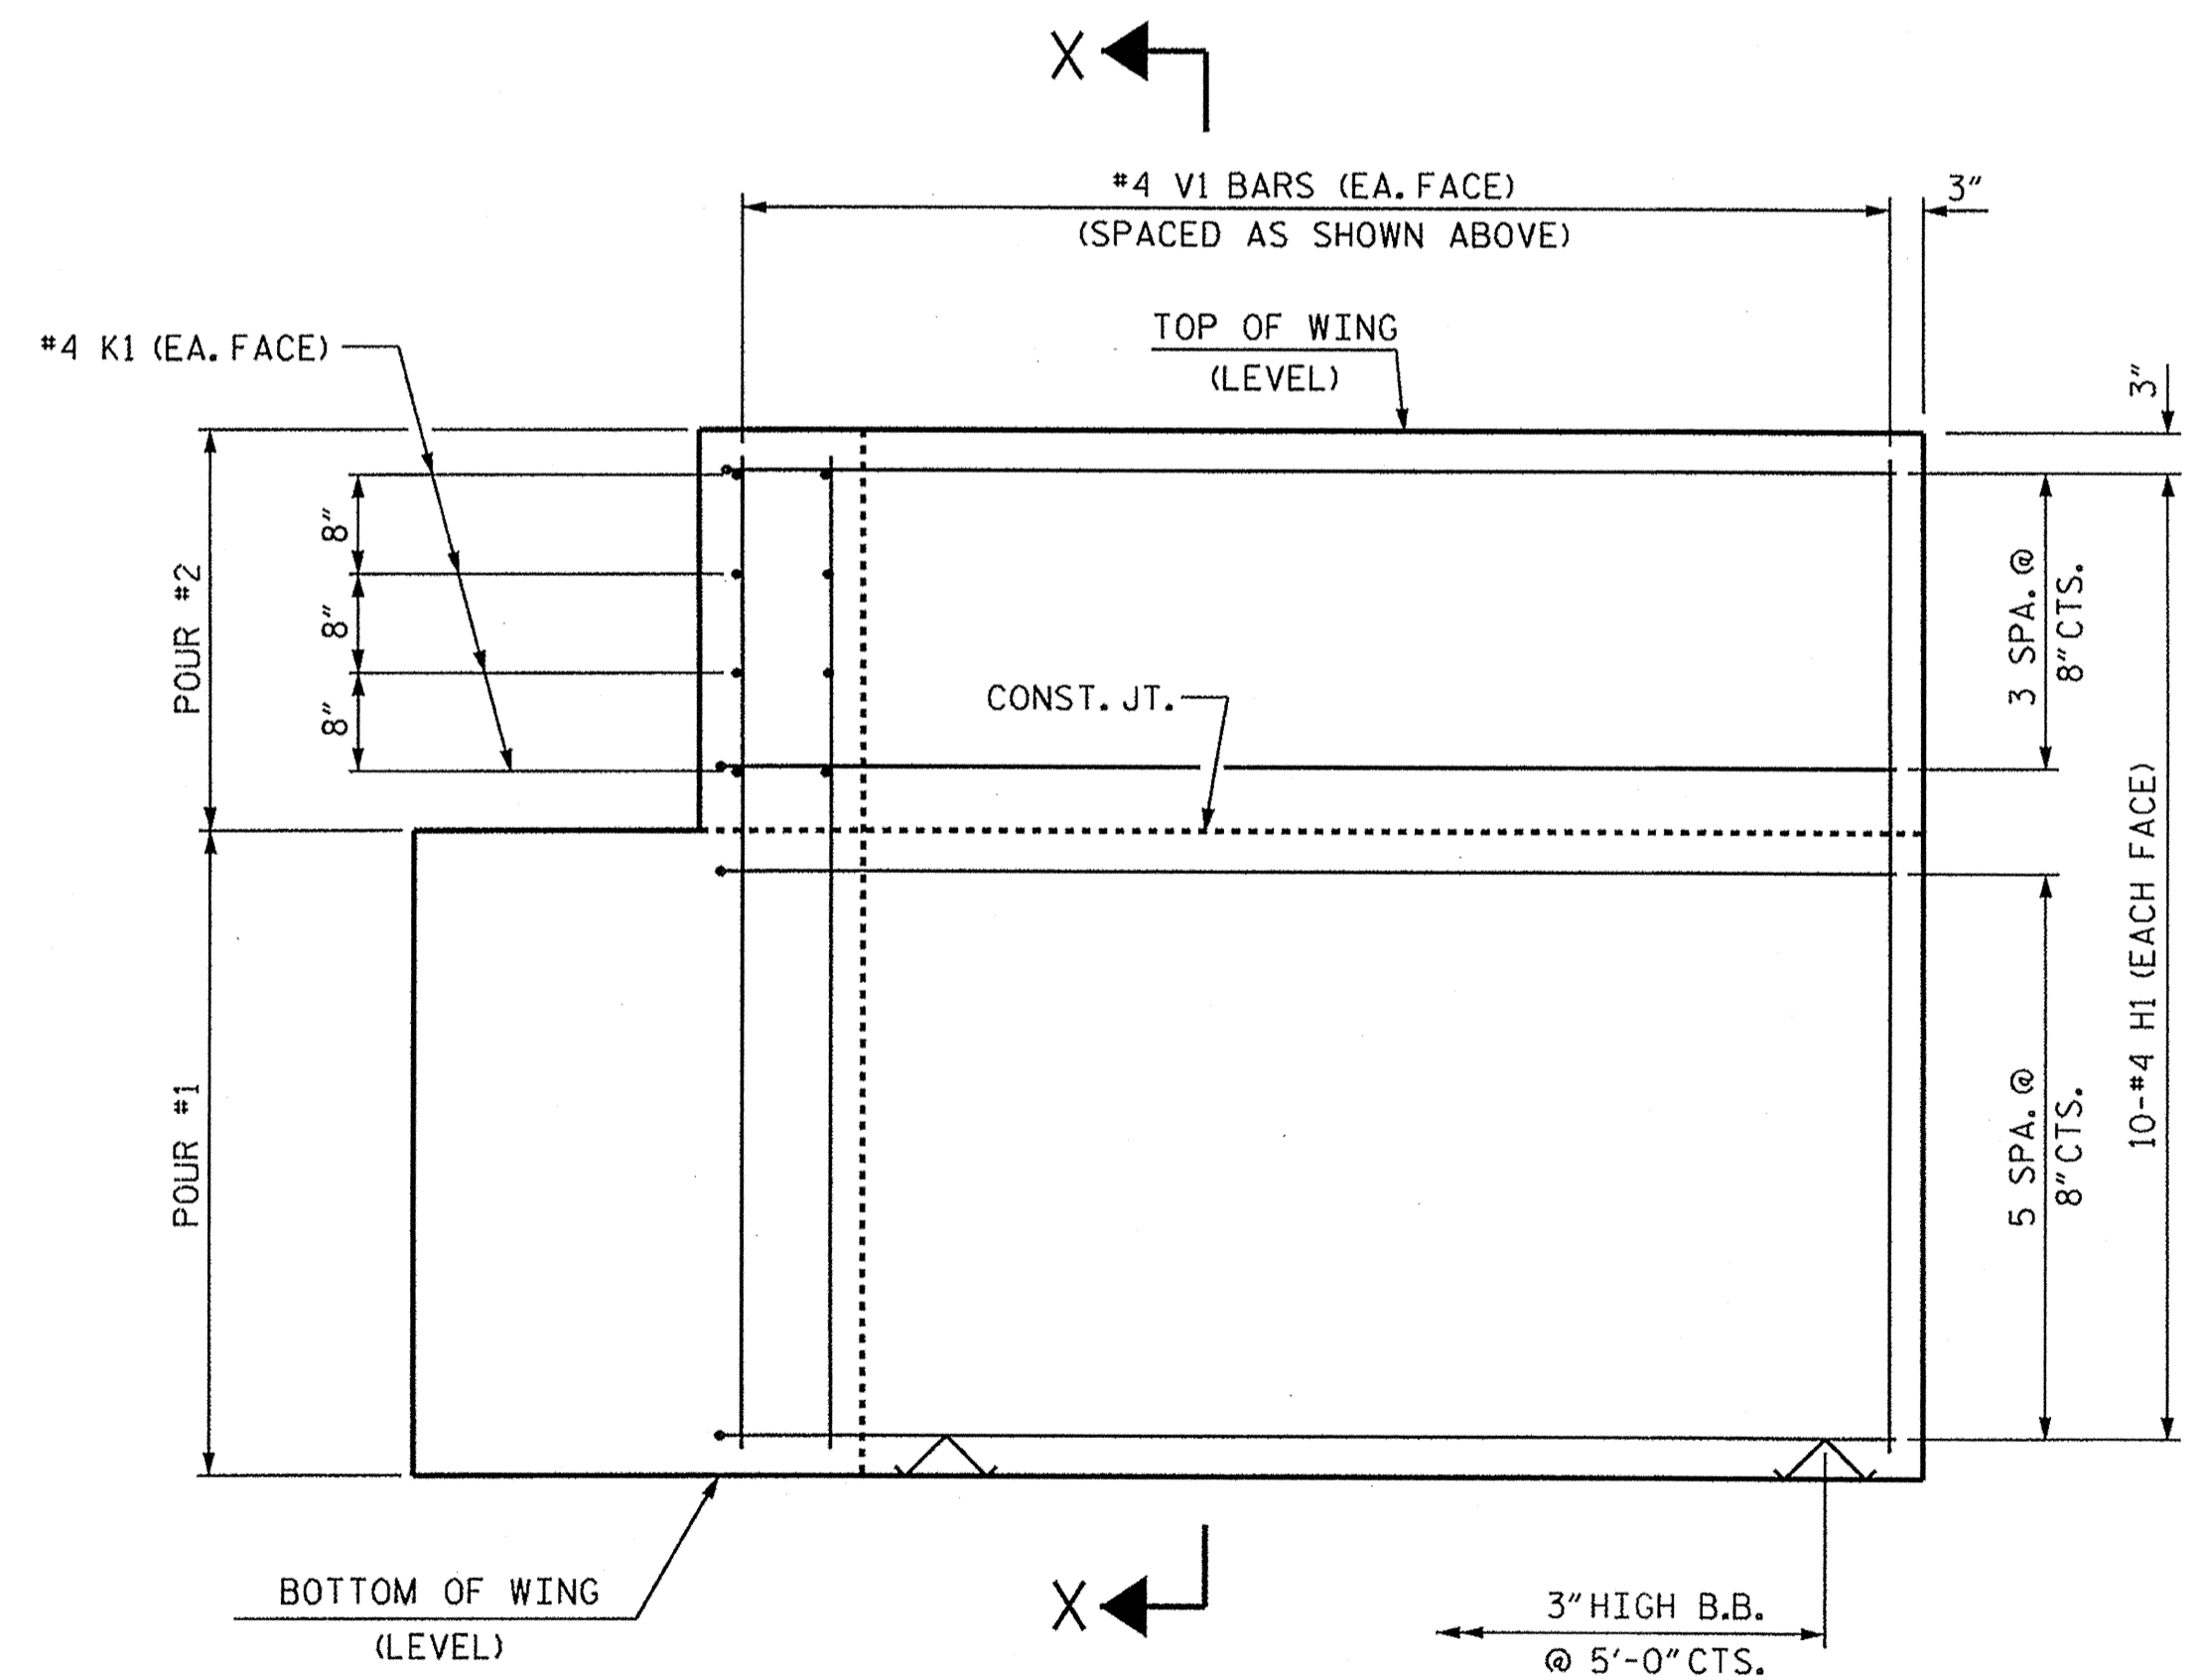

ELEVATION OF WING (W1)

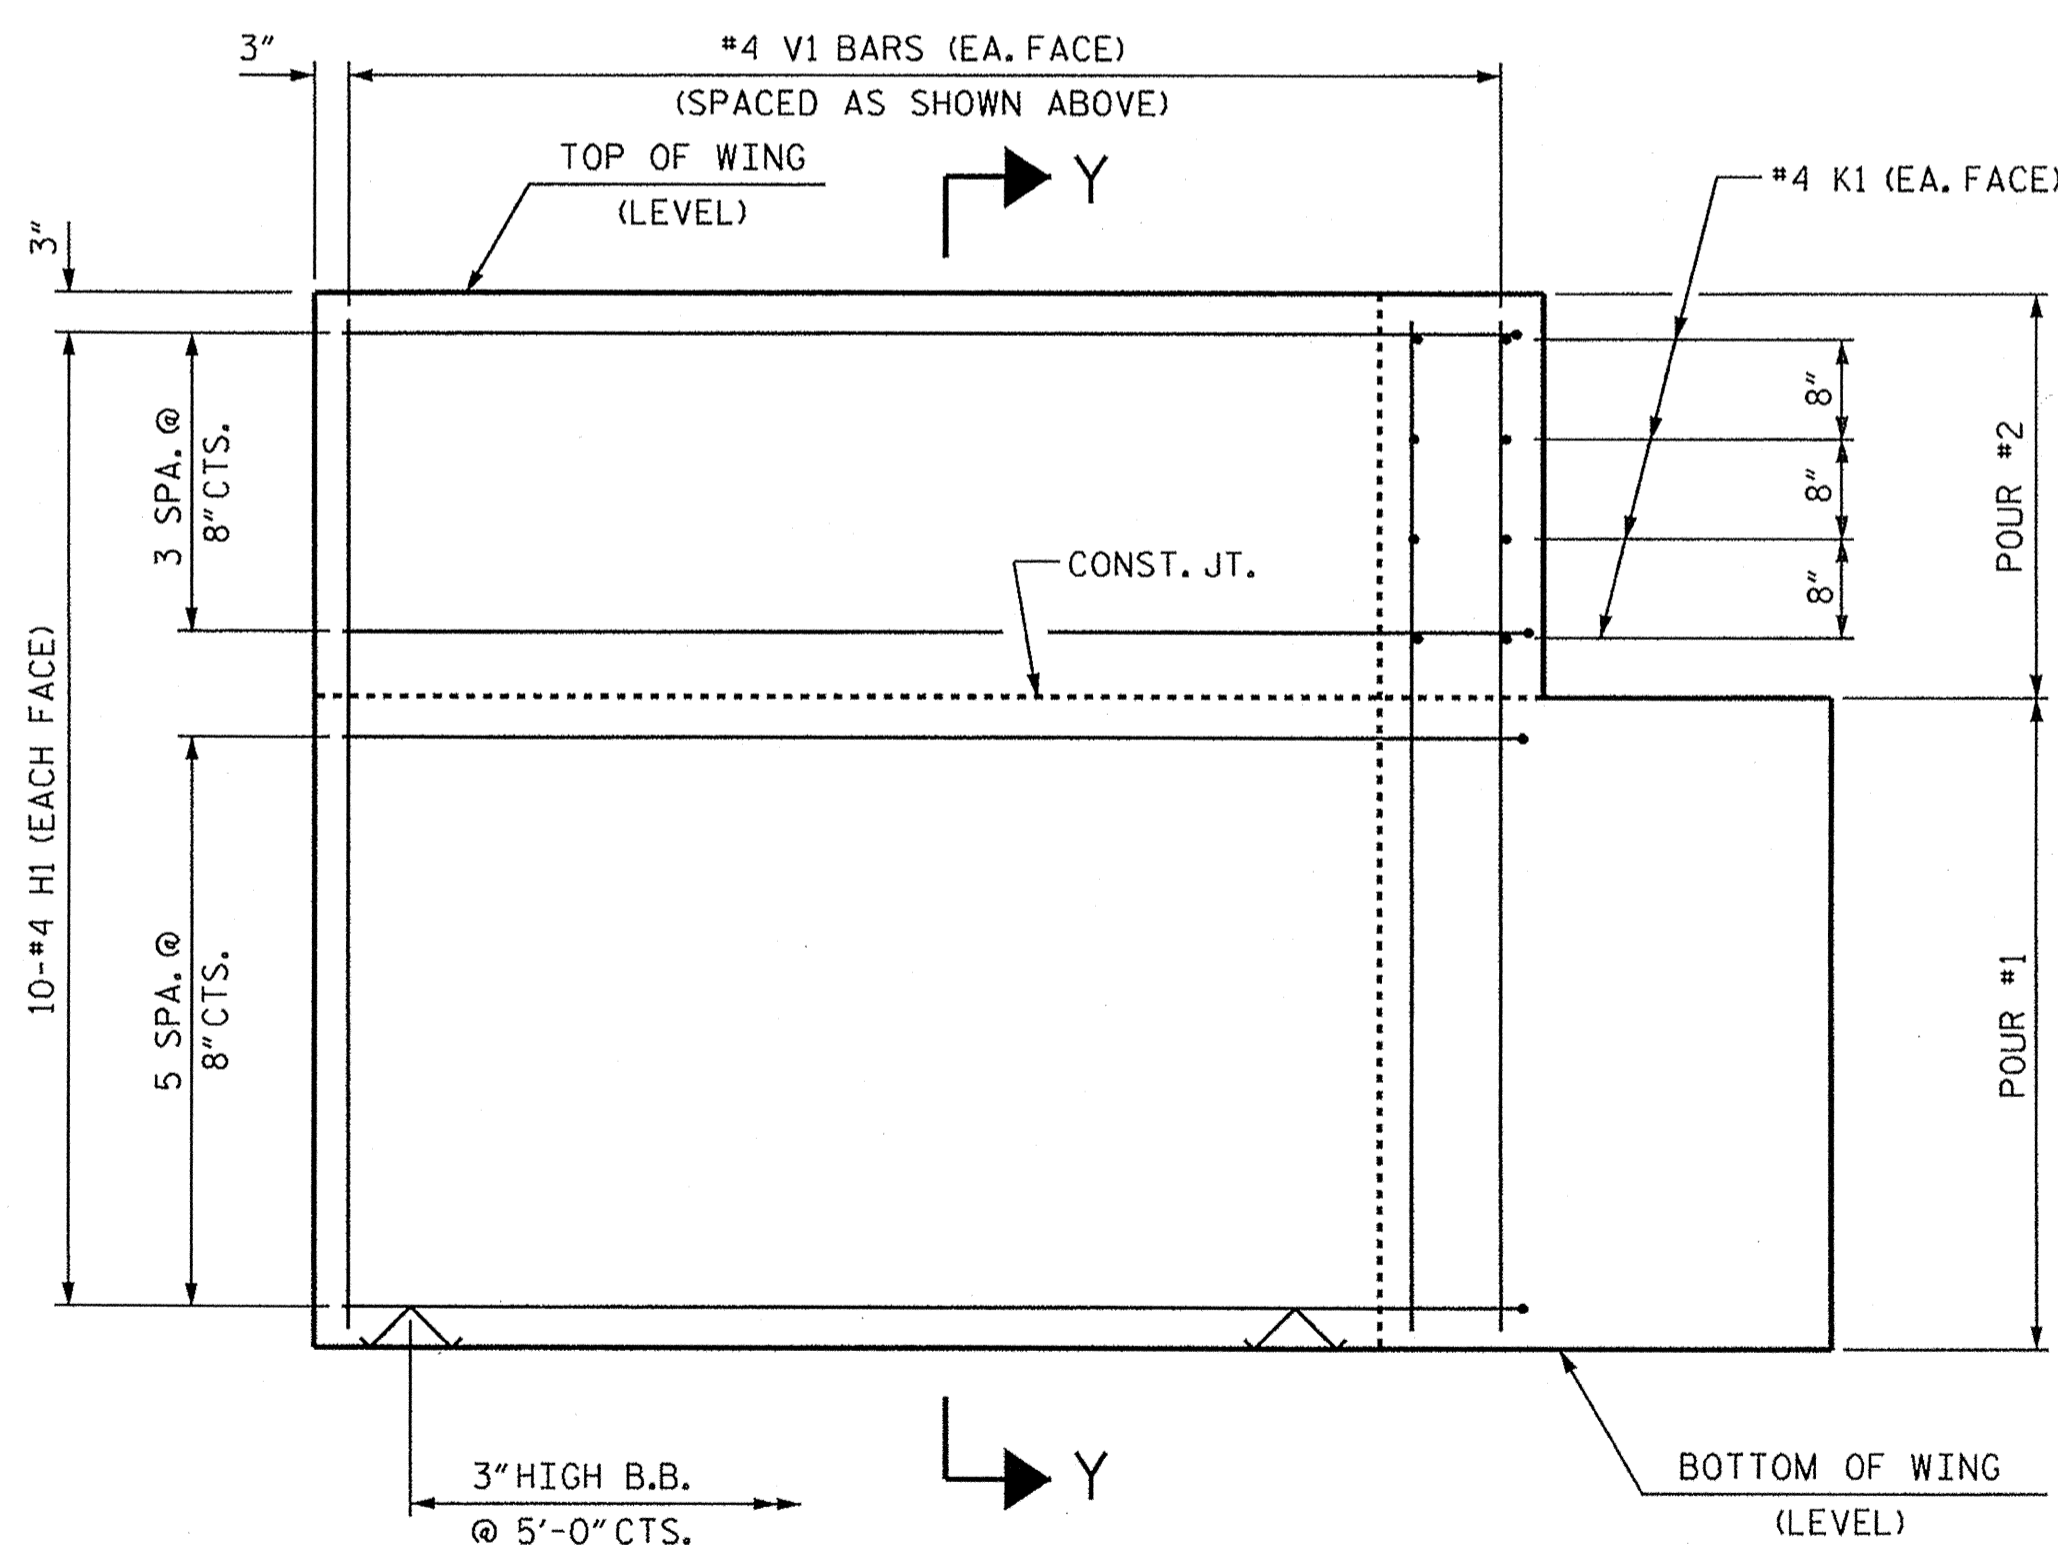

ELEVATION OF WING (W2)

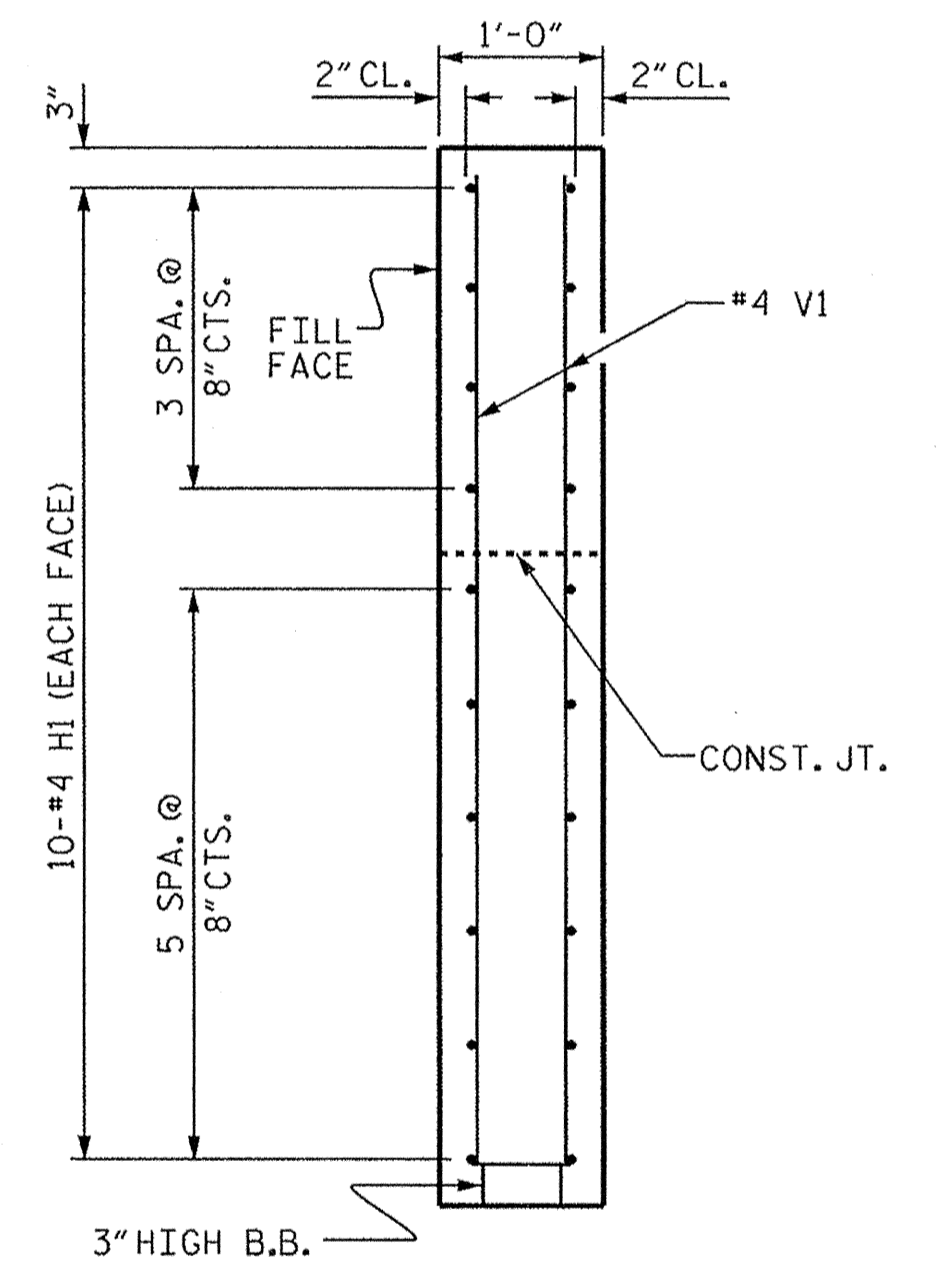


SECTION Y-Y

WING DETAILS

ASSEMBLED BY : E. K. POPE DATE : 4-11-12
 CHECKED BY : G. KOUCHEKI DATE : 5-8-12
 DRAWN BY : WJH 12/11
 CHECKED BY : AAC 12/11

24-MAY-2012 11:57
 S:\DPG\Kefrh\BD-5102M\ekpope\BD5102M_SD_CS.dgn
 kpschd

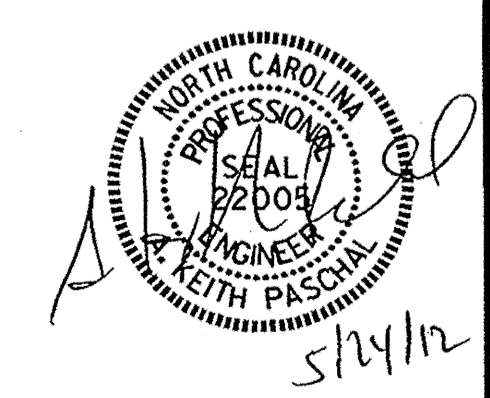


PROJECT NO. BD-5102M
LENOIR COUNTY
 STATION: 12+95.00 -L-

SHEET 3 OF 4

STATE OF NORTH CAROLINA DEPARTMENT OF TRANSPORTATION RALEIGH					
SUBSTRUCTURE END BENT WING DETAILS					
REVISIONS					
NO.	BY:	DATE:	NO.	BY:	DATE:
1			3		
2			4		

SHEET NO. 3-10
TOTAL SHEETS 12

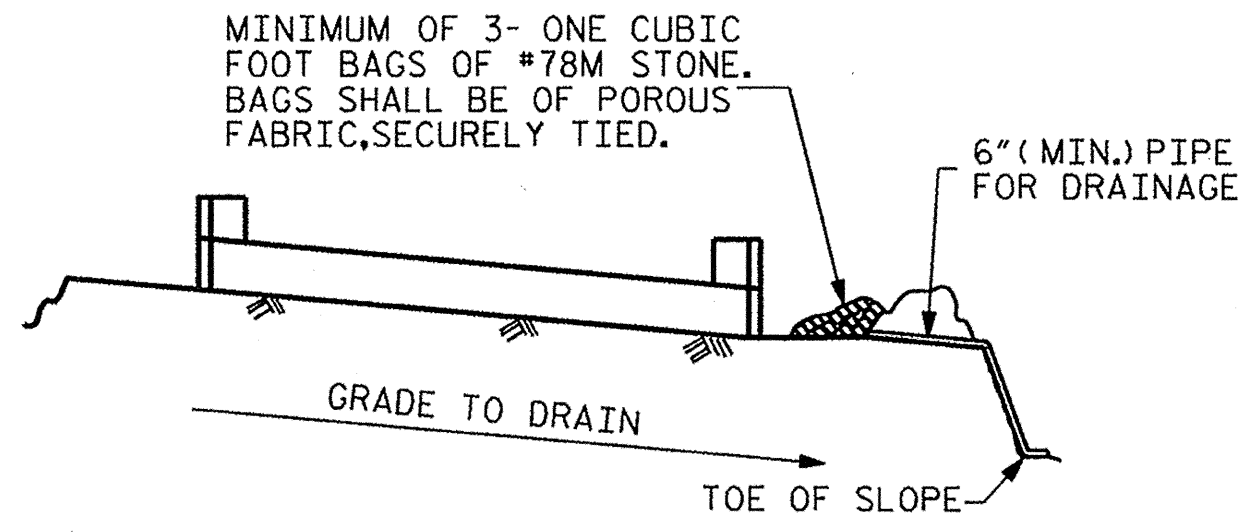

MINIMUM OF 3- ONE CUBIC FOOT BAGS OF #78M STONE. BAGS SHALL BE OF POROUS FABRIC, SECURELY TIED.

6" (MIN.) PIPE FOR DRAINAGE

GRADE TO DRAIN


TOE OF SLOPE

BAGGED STONE AND PIPE SHALL BE PLACED IMMEDIATELY AFTER COMPLETION OF END BENT EXCAVATION. PIPE MAY BE EITHER CONCRETE, CORRUGATED STEEL, CORRUGATED ALUMINUM ALLOY, OR CORRUGATED PLASTIC. PERFORATED PIPE WILL NOT BE ALLOWED.


BAGGED STONE SHALL REMAIN IN PLACE UNTIL THE ENGINEER DIRECTS THAT IT BE REMOVED. THE CONTRACTOR SHALL REMOVE AND DISPOSE OF SILT ACCUMULATIONS AT BAGGED STONE WHEN SO DIRECTED BY THE ENGINEER. BAGS SHALL BE REMOVED AND REPLACED WHENEVER THE ENGINEER DETERMINES THAT THEY HAVE DETERIORATED AND LOST THEIR EFFECTIVENESS.

NO SEPARATE PAYMENT WILL BE MADE FOR THIS WORK AND THE ENTIRE COST OF THIS WORK SHALL BE INCLUDED IN THE UNIT CONTRACT PRICE BID FOR THE SEVERAL PAY ITEMS.


TEMPORARY DRAINAGE AT END BENT

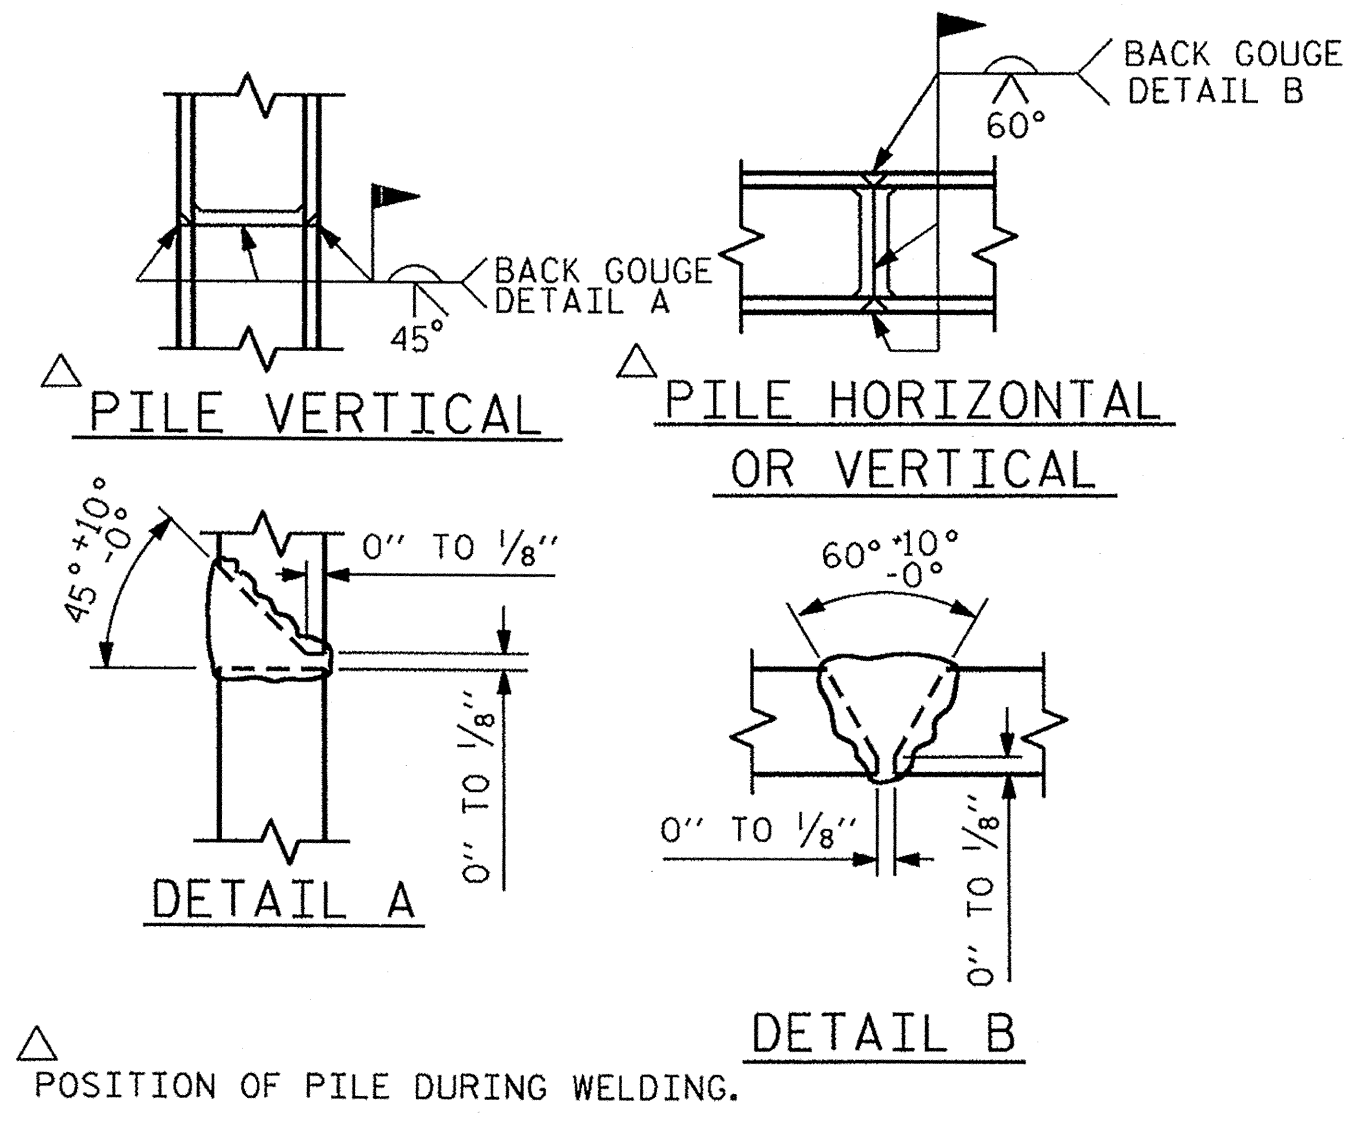

PILE SPLICE DETAILS

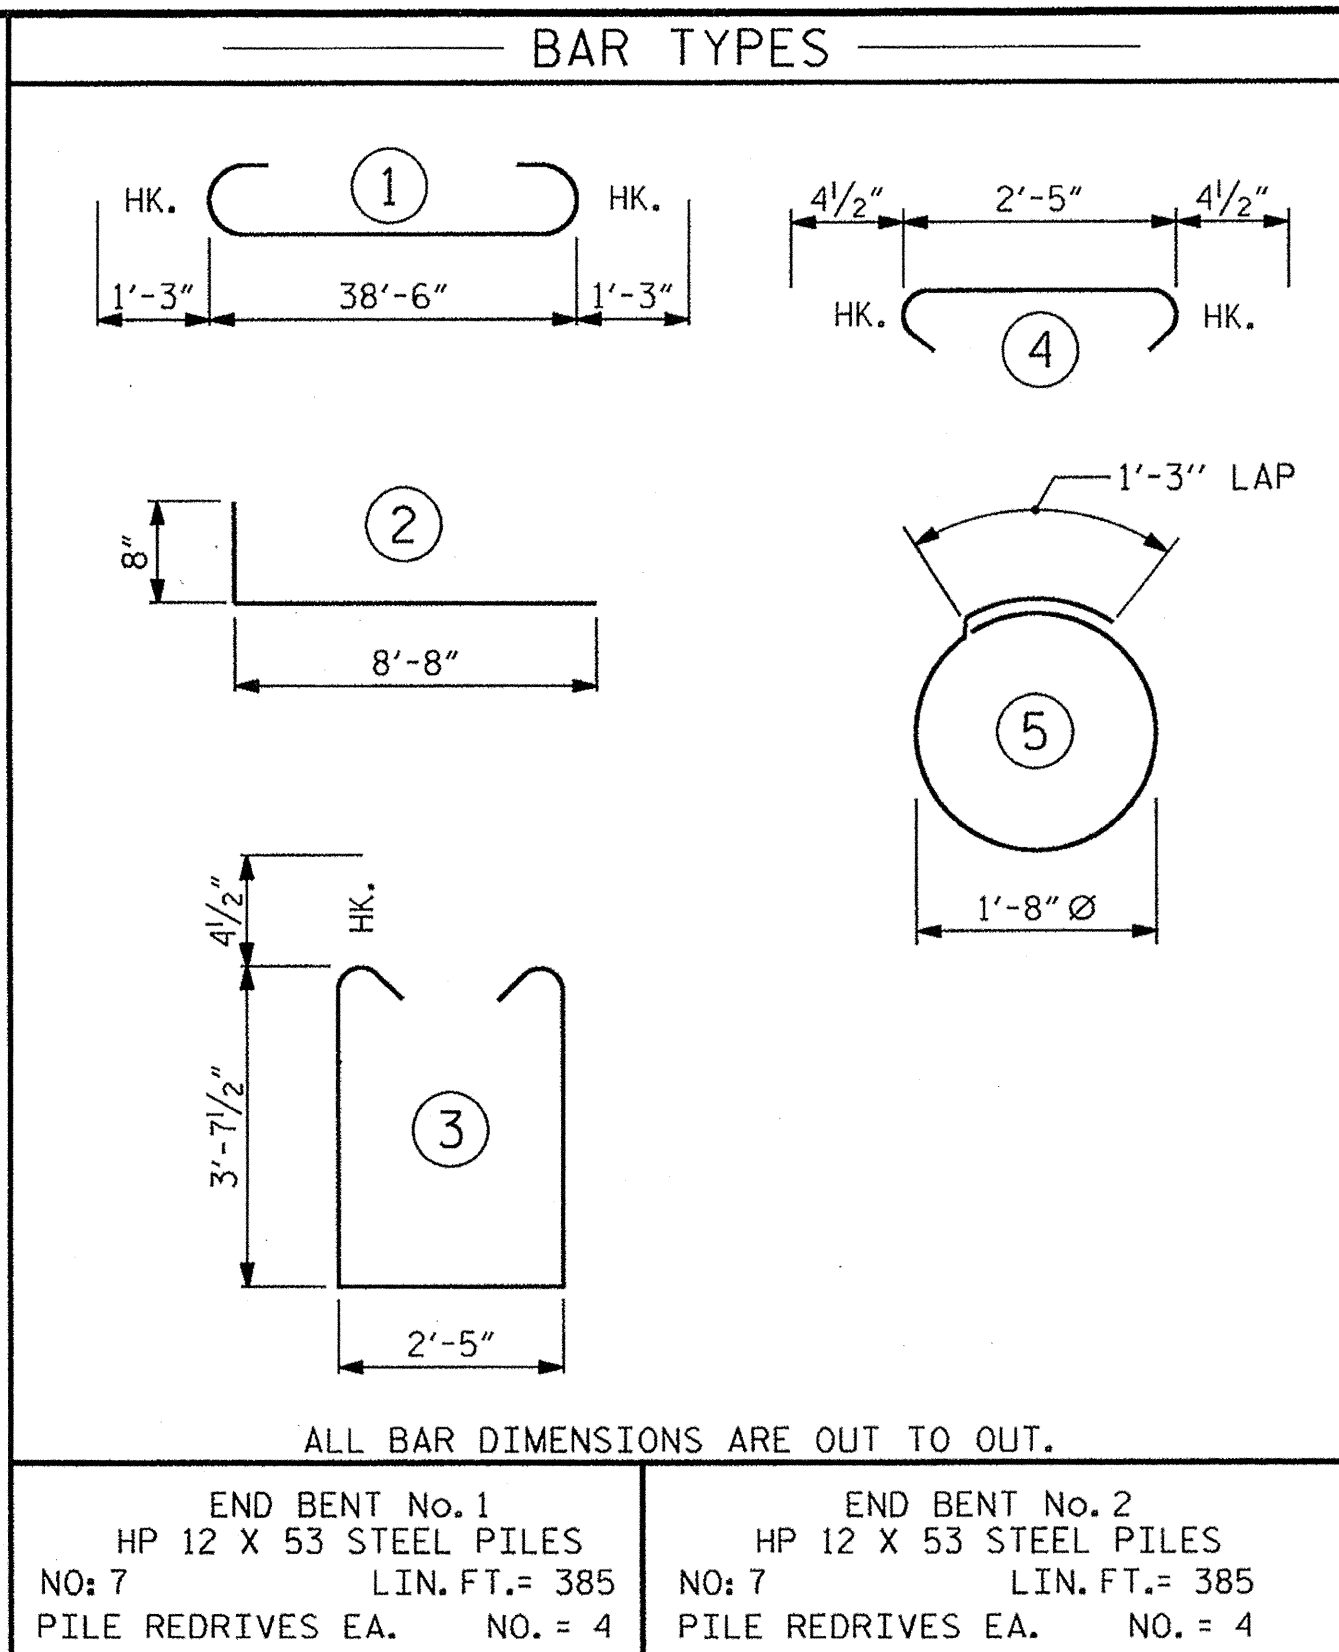


BILL OF MATERIAL					
FOR ONE END BENT					
BAR	NO.	SIZE	TYPE	LENGTH	WEIGHT
B1	8	#9	1	41'-0"	1115
B2	28	#4	STR	20'-7"	385
B3	10	#4	STR	2'-5"	16
D1	22	#6	STR	1'-6"	50
H1	40	#4	2	9'-4"	249
K1	16	#4	STR	2'-11"	31
S1	50	#4	3	10'-5"	348
S2	50	#4	4	3'-2"	106
S3	28	#4	5	6'-6"	122
V1	52	#4	STR	6'-2"	214
REINFORCING STEEL (FOR ONE END BENT)					2636 LBS.
CLASS A CONCRETE BREAKDOWN (FOR ONE END BENT)					
POUR #1 CAP, LOWER PART OF WINGS & COLLARS					19.5 C.Y.
POUR #2 UPPER PART OF WINGS					2.3 C.Y.
TOTAL CLASS A CONCRETE					21.8 C.Y.

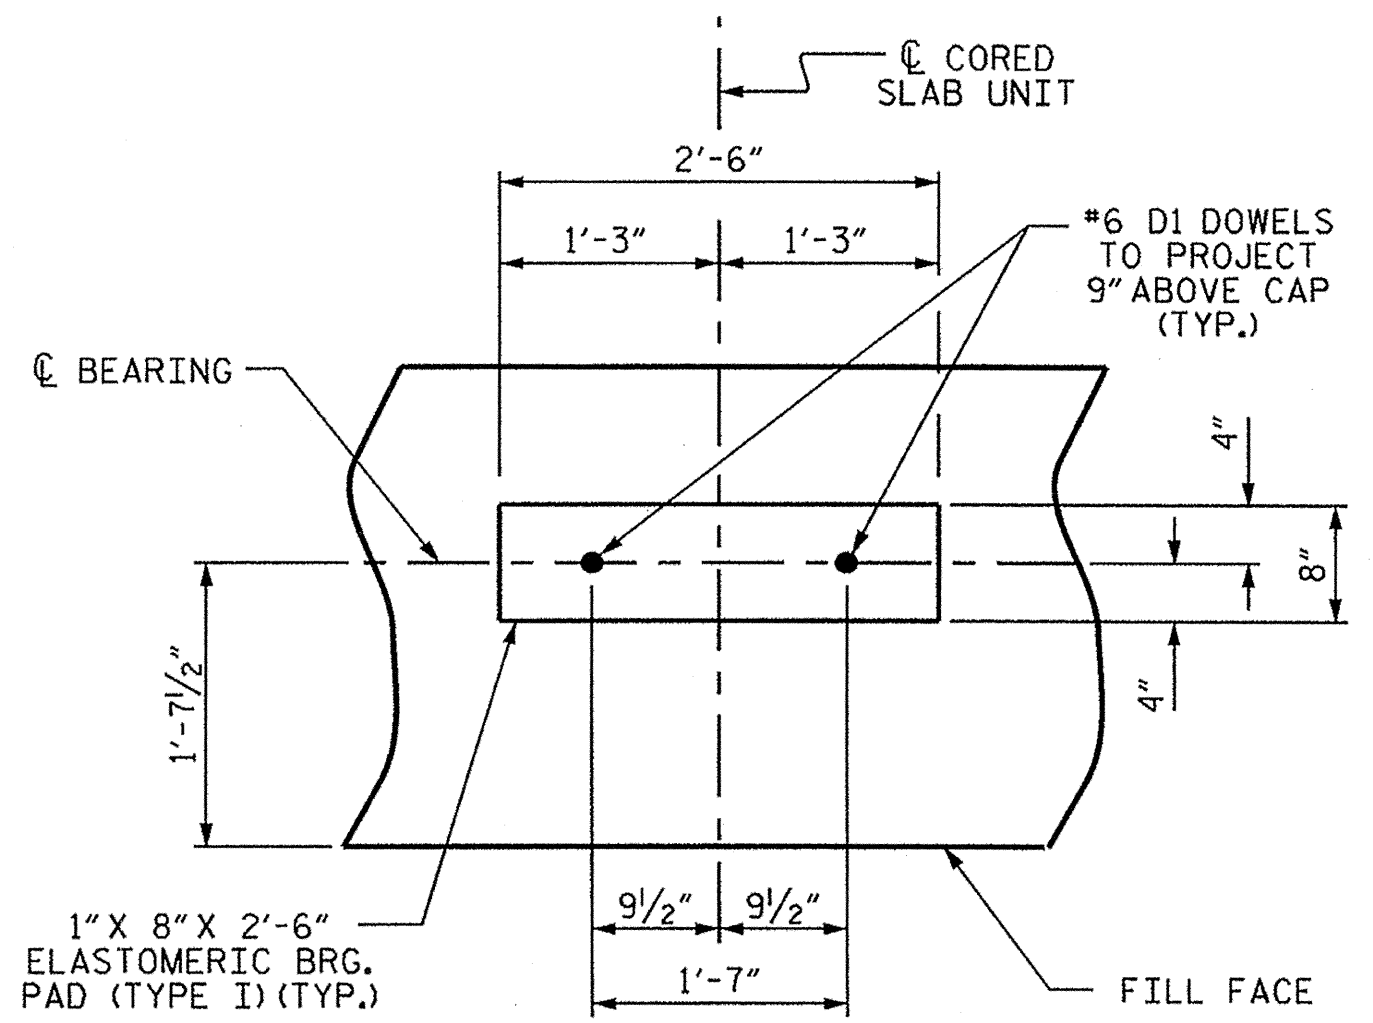

DETAIL "A"


(END BENT No. 1 SHOWN, END BENT No. 2 SIMILAR BY ROTATION)

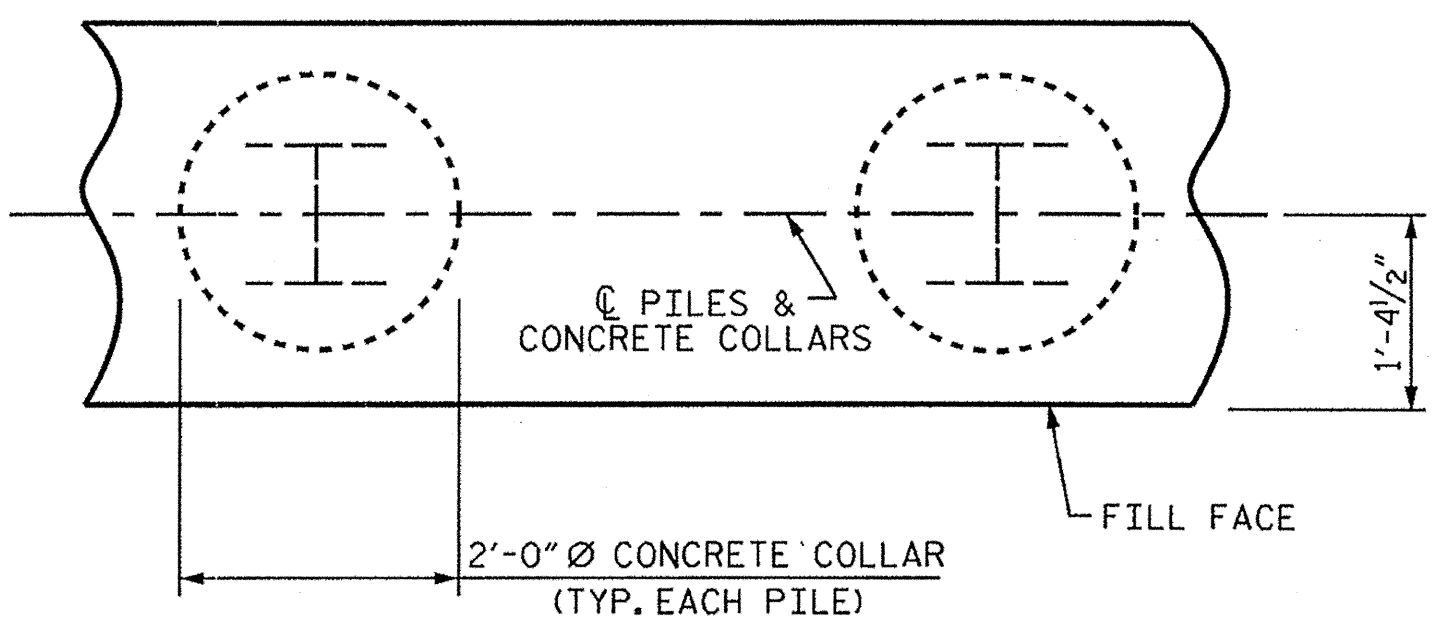


PLAN

CORROSION PROTECTION FOR STEEL PILES DETAIL

(END BENT No. 1 SHOWN, END BENT No. 2 SIMILAR BY ROTATION)

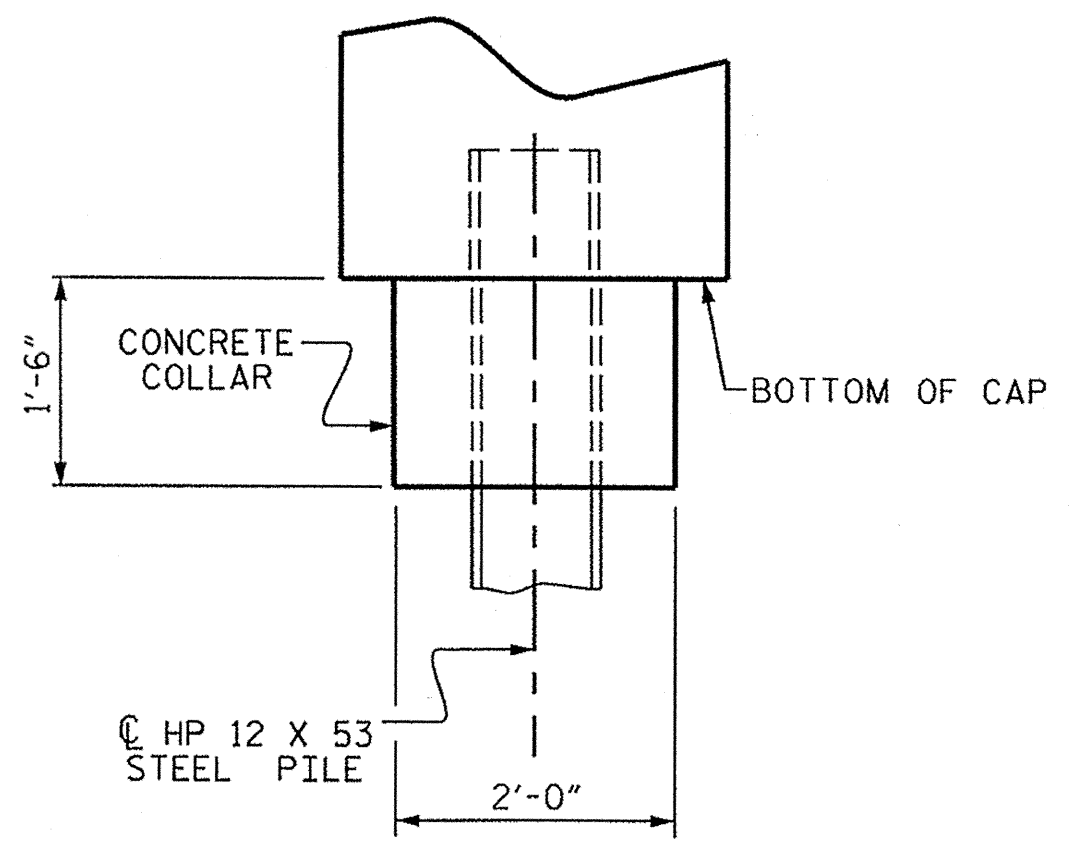


ELEVATION

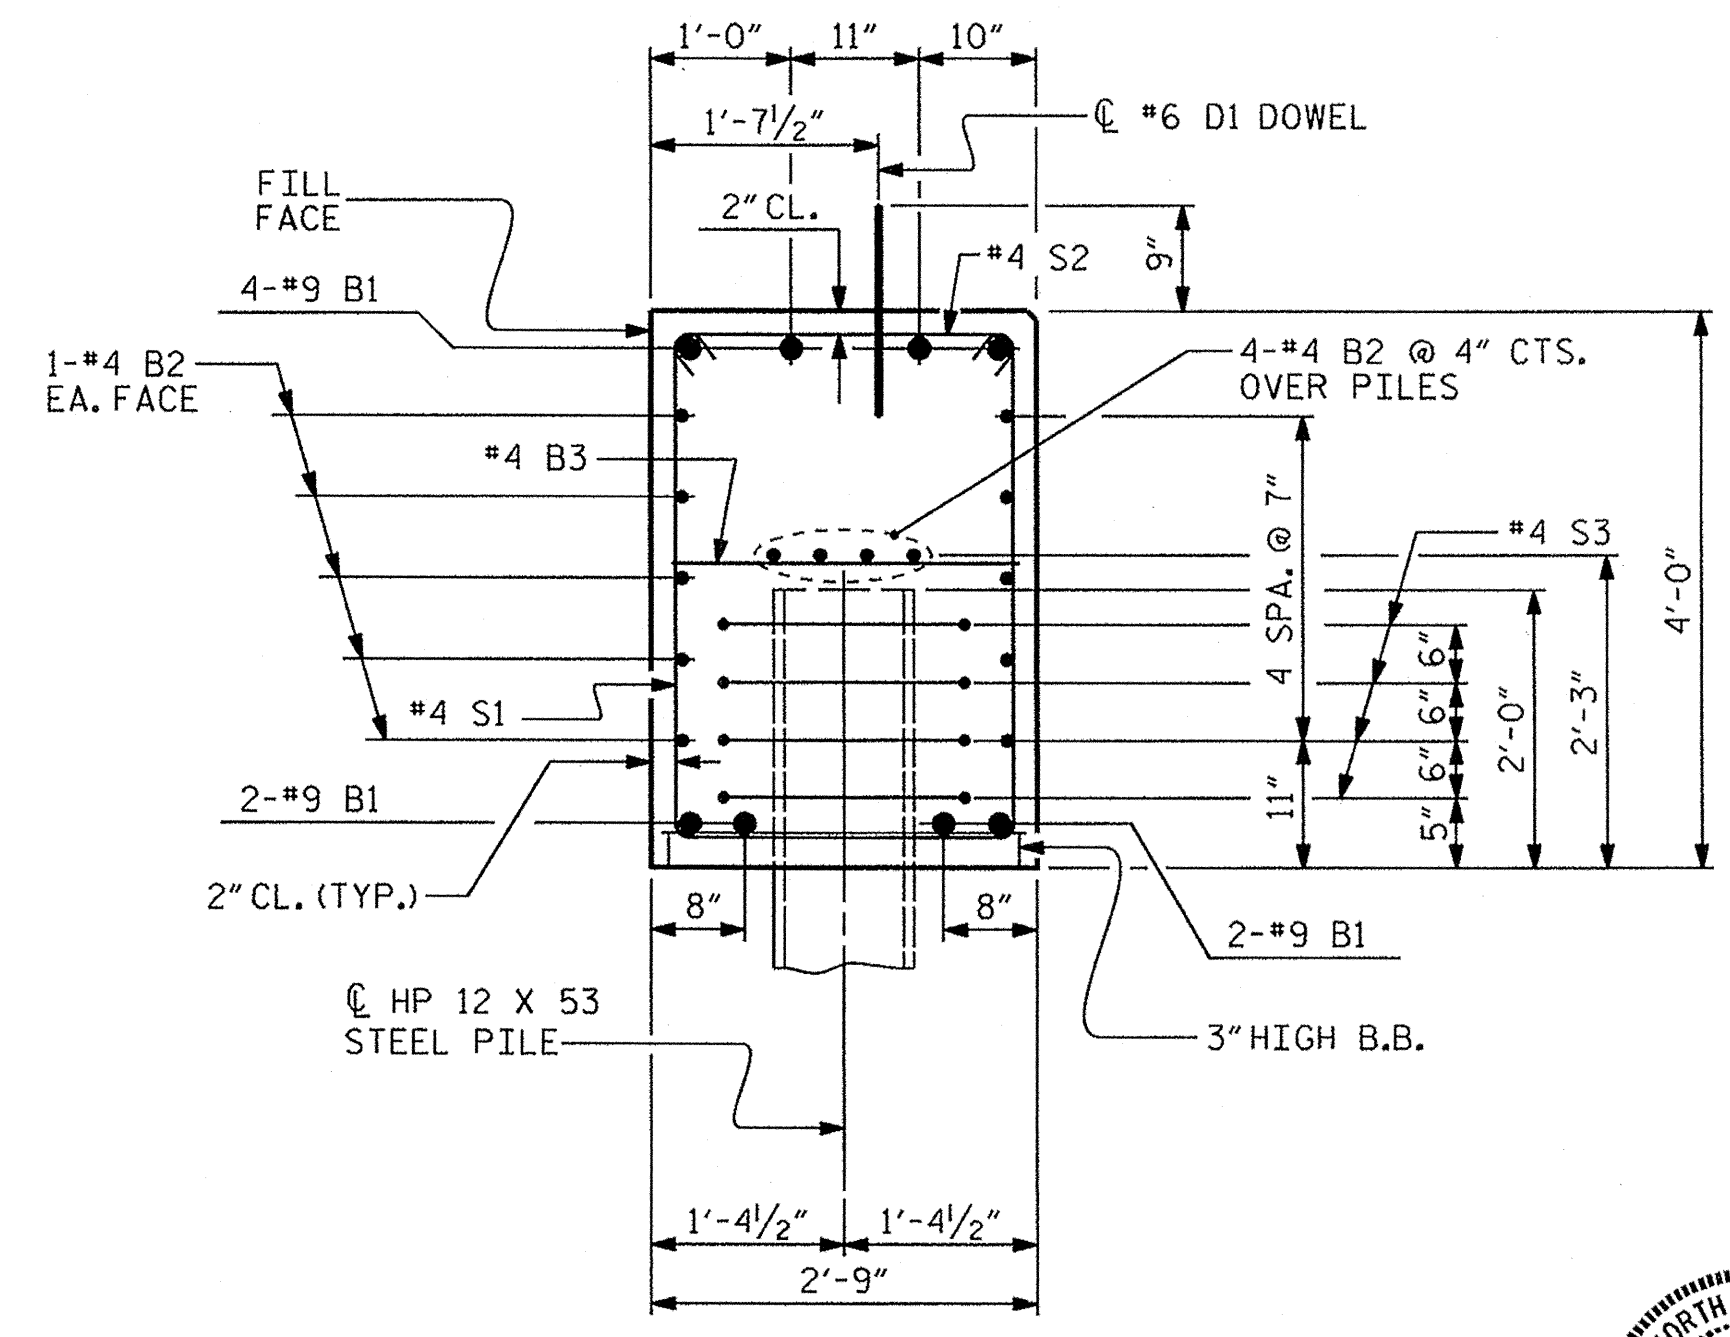

SECTION A-A

(CONCRETE COLLAR NOT SHOWN FOR CLARITY. SEE "CORROSION PROTECTION FOR STEEL PILES DETAIL.")

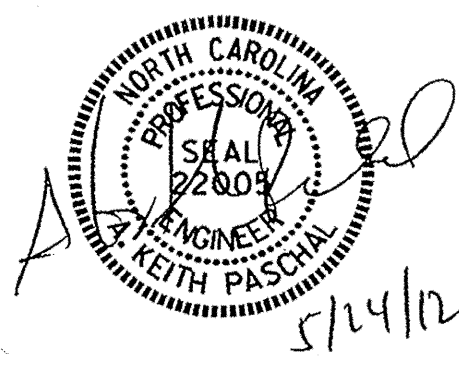

PROJECT NO. BD-5102M

LENOIR COUNTY

STATION: 12+95.00 -L-

SHEET 4 OF 4

STATE OF NORTH CAROLINA
DEPARTMENT OF TRANSPORTATION
RALEIGH


SUBSTRUCTURE

END BENT No. 1 & 2
DETAILS


REVISIONS						SHEET NO.
NO.	BY:	DATE:	NO.	BY:	DATE:	5-11
1			3			TOTAL SHEETS
2			4			12

ASSEMBLED BY: E. K. POPE	DATE: 4-11-12
CHECKED BY: G. KOUCHEKI	DATE: 5-21-12
DRAWN BY: WJH 12/11	
CHECKED BY: AAC 12/11	

24-MAY-2012 11:57
S:\DPG1\Kefth\BD-5102M\ekpope\BD5102M_SD_CS.dgn
kpaschal

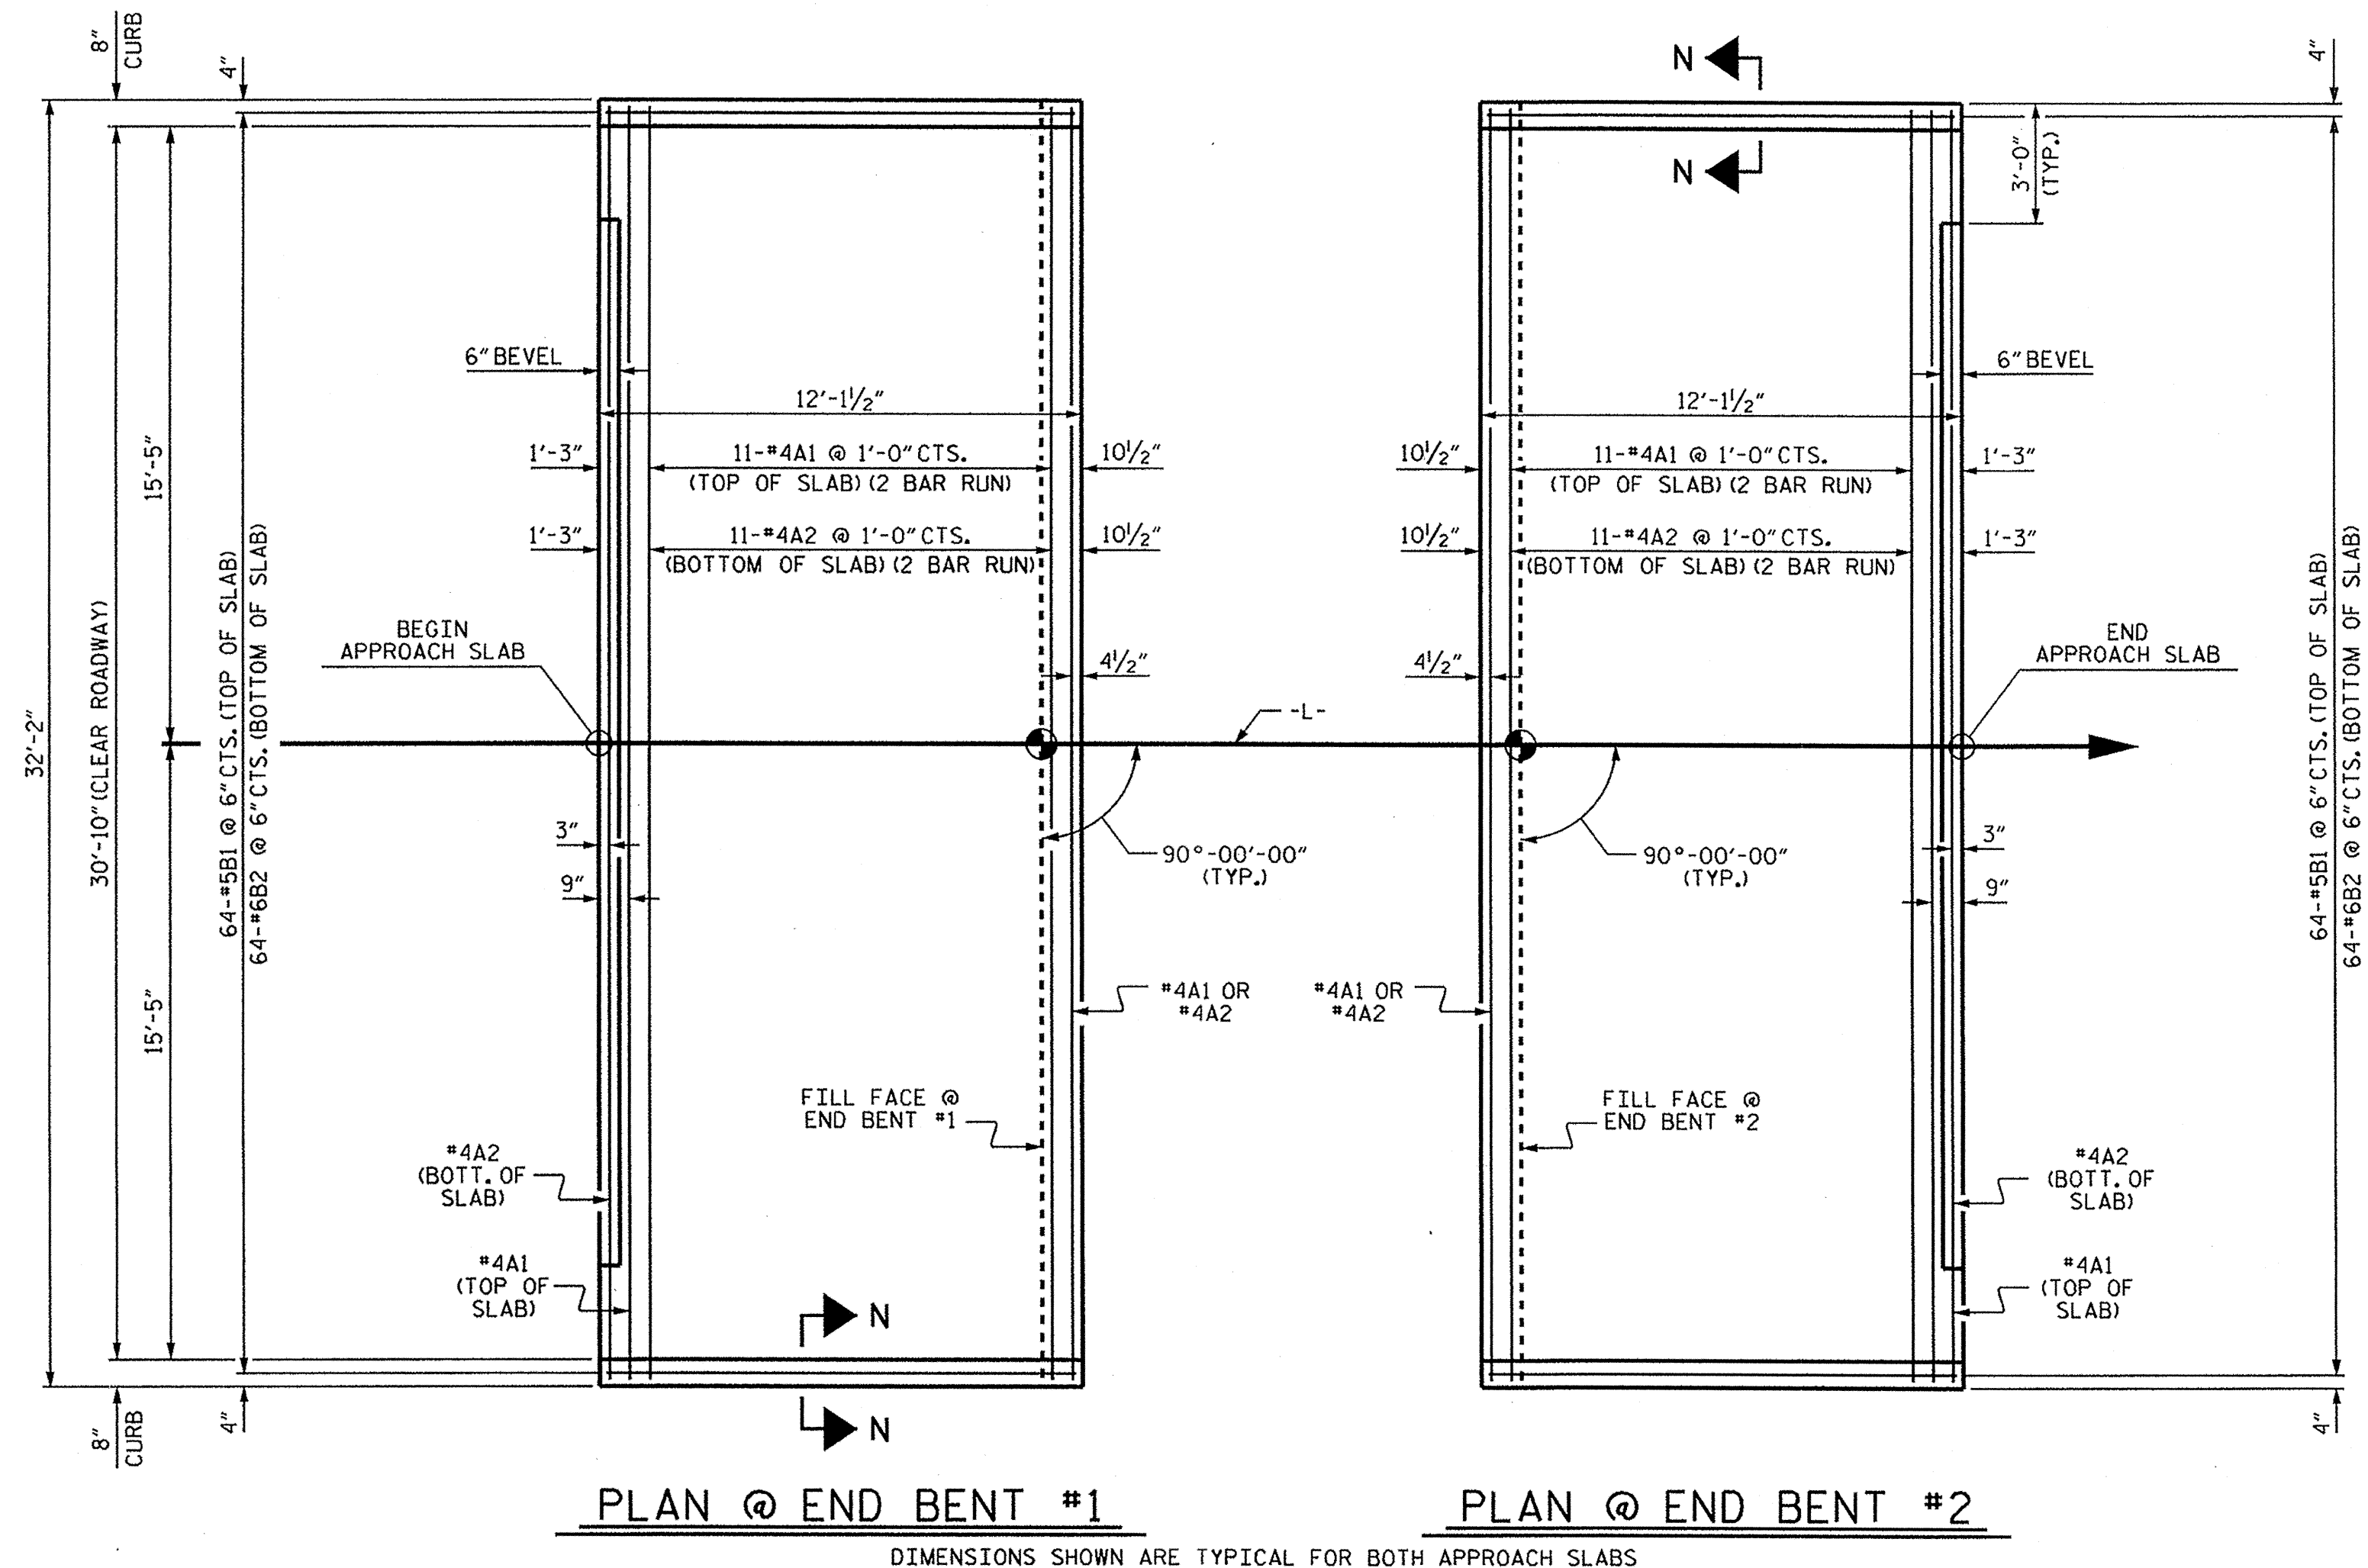


PLAN @ END BENT #1
 PLAN @ END BENT #2
 DIMENSIONS SHOWN ARE TYPICAL FOR BOTH APPROACH SLABS

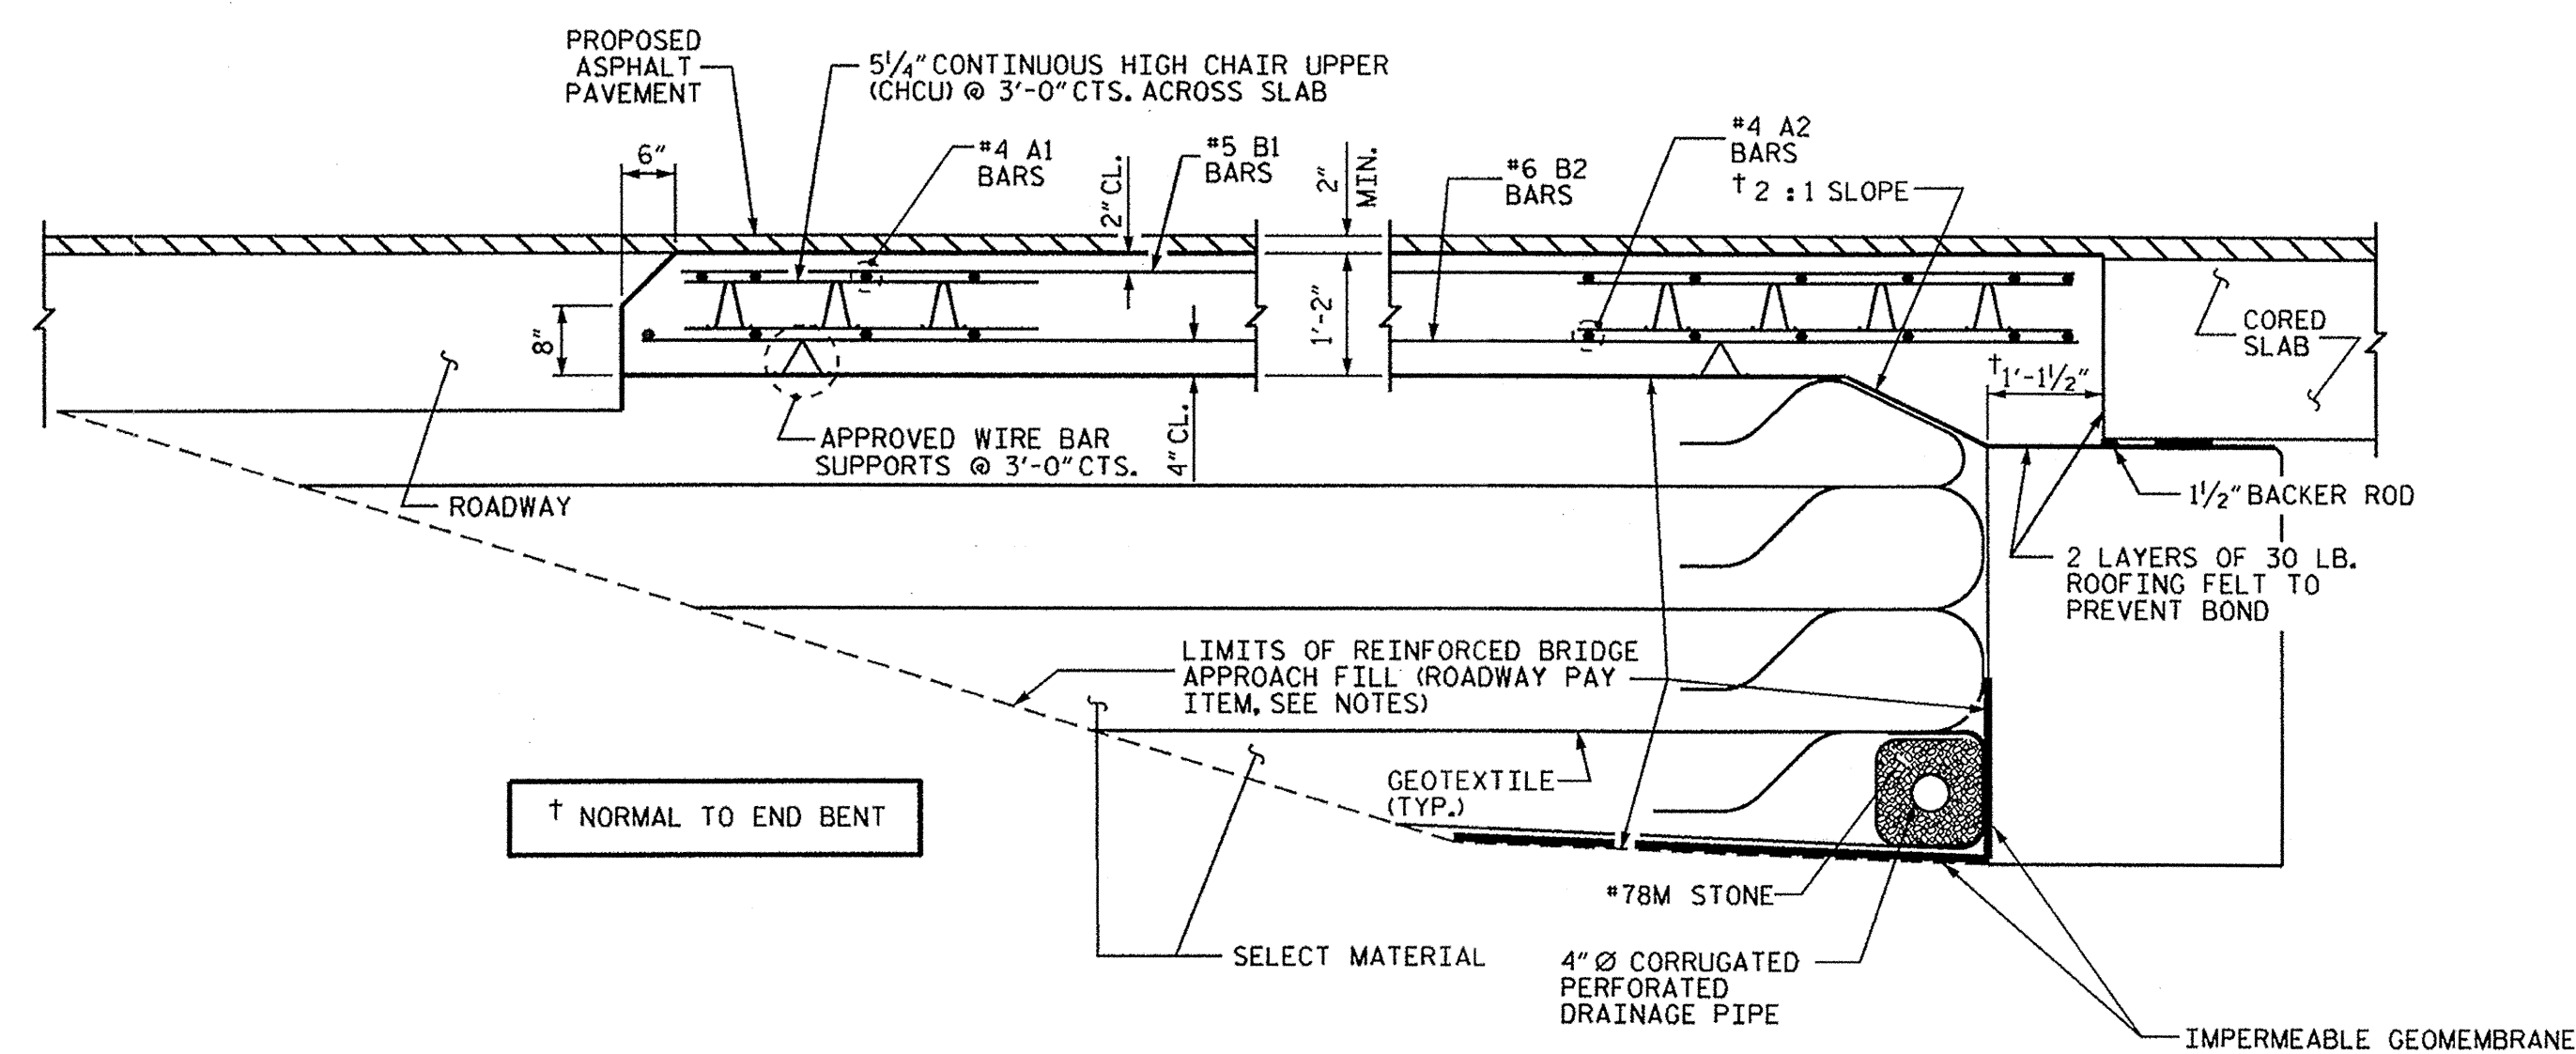


SECTION THRU SLAB

NOTES
 FOR REINFORCED BRIDGE APPROACH FILL INCLUDING GEOTEXTILE, IMPERMEABLE GEOMEMBRANE, 4" Ø DRAINAGE PIPE, #78M STONE, AND SELECT MATERIAL, SEE ROADWAY PLANS.
 AREA BETWEEN THE WINGWALL AND APPROACH SLAB SHALL BE GRADED TO DRAIN THE WATER AWAY FROM THE FILL FACE OF THE BRIDGE AND SHALL BE PAVED. SEE ROADWAY PLANS.
 APPROACH SLAB GROOVING IS NOT REQUIRED.

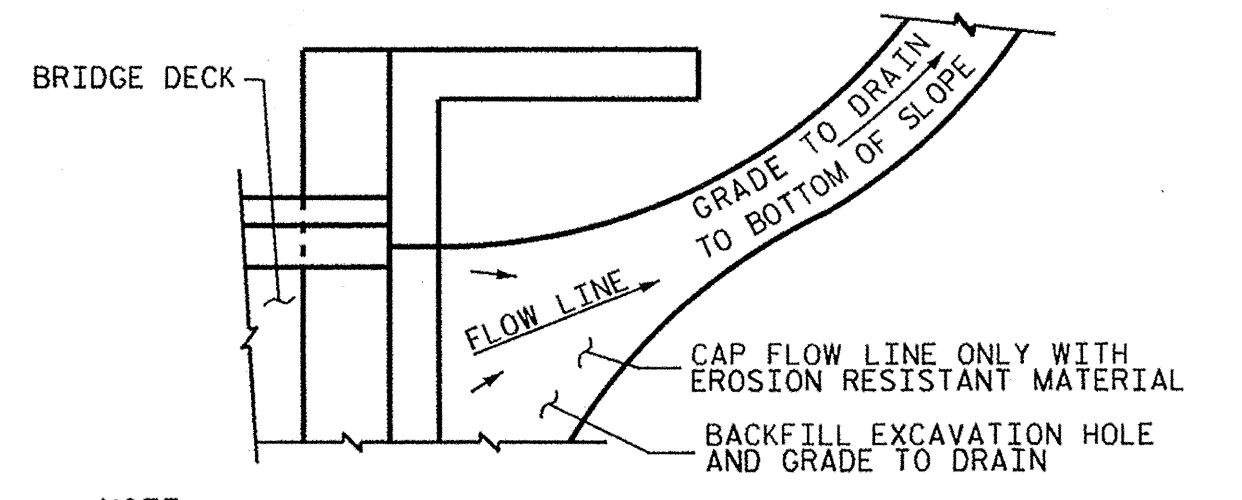


NOTE: IF THE APPROACH SLAB IS NOT CONSTRUCTED IMMEDIATELY AFTER THE BACKFILLING OF THE END BENT EXCAVATION, GRADE TO DRAIN TO THE BOTTOM OF THE SLOPE AND PROVIDE EROSION RESISTANT MATERIAL, SUCH AS FIBERGLASS ROVING OR AS DIRECTED BY THE ENGINEER TO PREVENT SOIL EROSION AND TO PROTECT THE AREA ADJACENT TO THE STRUCTURE. THE CONTRACTOR WILL BE REQUIRED TO REMOVE THESE MATERIALS PRIOR TO CONSTRUCTION OF THE APPROACH SLAB.

TEMPORARY DRAINAGE DETAIL

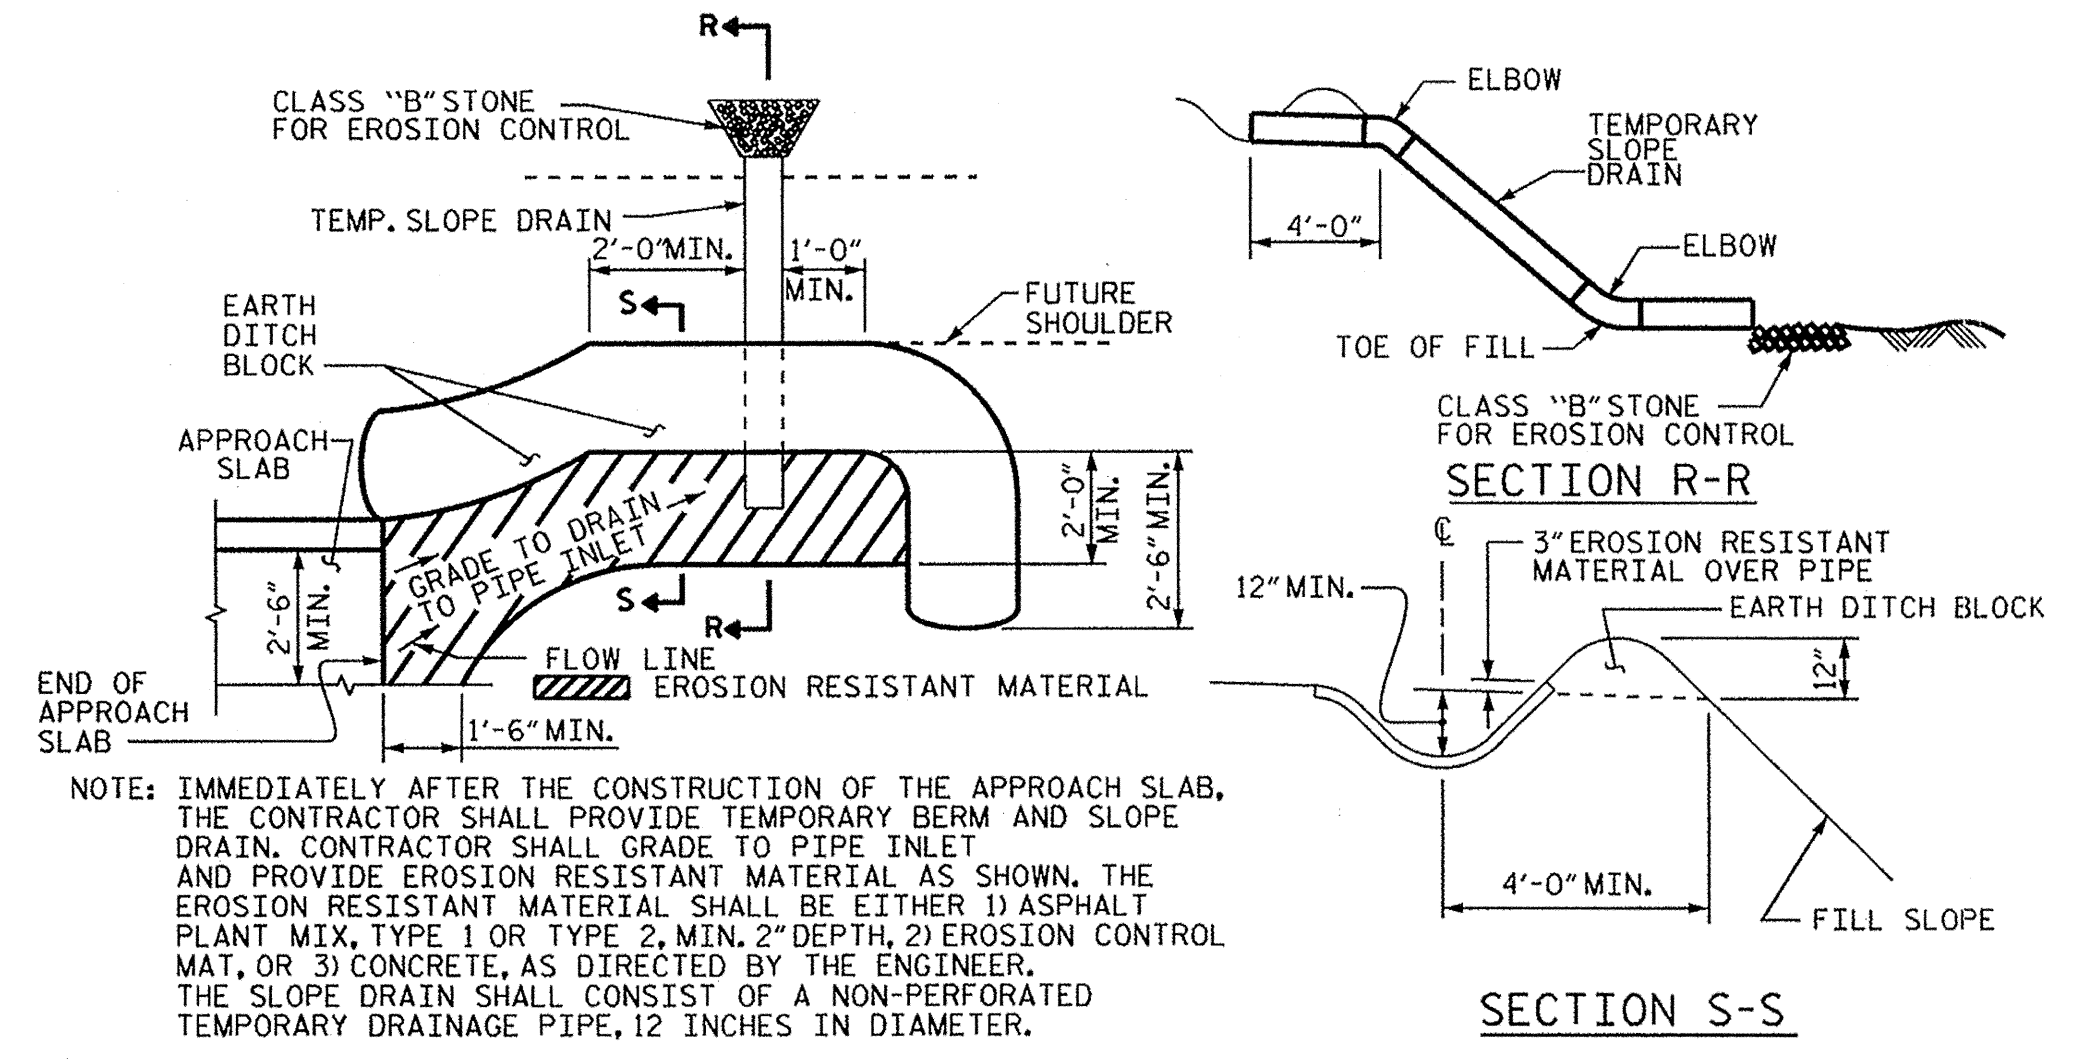


NOTE: IMMEDIATELY AFTER THE CONSTRUCTION OF THE APPROACH SLAB, THE CONTRACTOR SHALL PROVIDE TEMPORARY BERM AND SLOPE DRAIN. CONTRACTOR SHALL GRADE TO PIPE INLET AND PROVIDE EROSION RESISTANT MATERIAL AS SHOWN. THE EROSION RESISTANT MATERIAL SHALL BE EITHER 1) ASPHALT PLANT MIX, TYPE 1 OR TYPE 2, MIN. 2" DEPTH, 2) EROSION CONTROL MAT, OR 3) CONCRETE, AS DIRECTED BY THE ENGINEER. THE SLOPE DRAIN SHALL CONSIST OF A NON-PERFORATED TEMPORARY DRAINAGE PIPE, 12 INCHES IN DIAMETER.

PLAN VIEW
 SECTION S-S
TEMPORARY BERM AND SLOPE DRAIN DETAILS
 (TO BE USED WHEN SHOULDER BERM GUTTER IS REQUIRED)

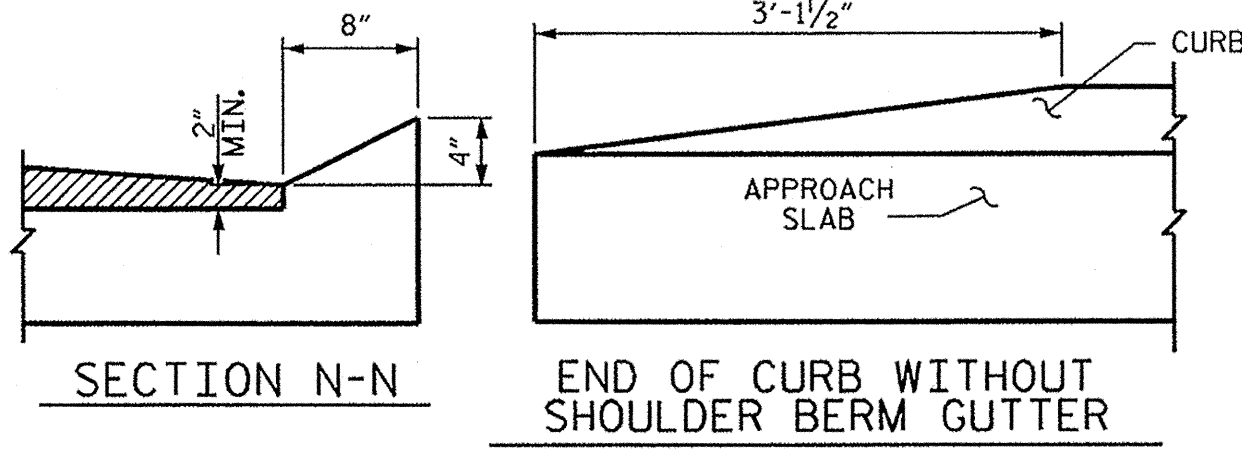

CURB DETAILS

SPlice LENGTHS		
BAR SIZE	EPOXY COATED	UNCOATED
#4	2'-0"	1'-9"
#5	2'-6"	2'-2"
#6	3'-10"	2'-7"

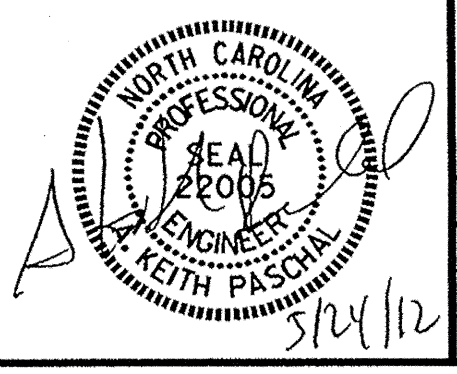

BILL OF MATERIAL						
APPROACH SLAB AT EB #1						
BAR	NO.	SIZE	TYPE	LENGTH	WEIGHT	
* A1	26	#4	STR	16'-11"	294	
A2	26	#4	STR	16'-9"	291	
* B1	64	#5	STR	11'-2"	745	
B2	64	#6	STR	11'-8"	1121	
REINFORCING STEEL					LBS.	1412
* EPOXY COATED REINFORCING STEEL					LBS.	1039
CLASS AA CONCRETE					C. Y.	19.9

APPROACH SLAB AT EB #2						
BAR	NO.	SIZE	TYPE	LENGTH	WEIGHT	
* A1	26	#4	STR	16'-11"	294	
A2	26	#4	STR	16'-9"	291	
* B1	64	#5	STR	11'-2"	745	
B2	64	#6	STR	11'-8"	1121	
REINFORCING STEEL					LBS.	1412
* EPOXY COATED REINFORCING STEEL					LBS.	1039
CLASS AA CONCRETE					C. Y.	19.9

ASSEMBLED BY : E. K. POPE DATE : 4-11-12
 CHECKED BY : G. KOUCHEK DATE : 5-8-12
 DRAWN BY : SHS/MAA 5-09 REV. 12-11 MAA/AAC
 CHECKED BY : BCH 5-09

24-MAY-2012 11:56
 S:\DPG\Keith\BD-5102M\ekpoppe\BD5102M_SD_CS.dgn
 kposchal

PROJECT NO. BD-5102M
LENOIR COUNTY
 STATION: 12+95.00 -L-

STATE OF NORTH CAROLINA DEPARTMENT OF TRANSPORTATION RALEIGH					
STANDARD BRIDGE APPROACH SLAB FOR PRESTRESSED CONCRETE CORED SLAB UNIT (SUB-REGIONAL TIER) 90° SKEW					
REVISIONS					SHEET NO.
NO.	BY:	DATE:	NO.	BY:	DATE:
1			3		
2			4		
					TOTAL SHEETS 12

STANDARD NOTES

DESIGN DATA:

SPECIFICATIONS	-----	A.A.S.H.T.O. (CURRENT)
LIVE LOAD	-----	SEE PLANS
IMPACT ALLOWANCE	-----	SEE A.A.S.H.T.O.
STRESS IN EXTREME FIBER OF		
STRUCTURAL STEEL - AASHTO M270 GRADE 36	-	20,000 LBS. PER SQ. IN.
- AASHTO M270 GRADE 50W	-	27,000 LBS. PER SQ. IN.
- AASHTO M270 GRADE 50	-	27,000 LBS. PER SQ. IN.
REINFORCING STEEL IN TENSION		
GRADE 60	--	24,000 LBS. PER SQ. IN.
CONCRETE IN COMPRESSION	-----	1,200 LBS. PER SQ. IN.
CONCRETE IN SHEAR	-----	SEE A.A.S.H.T.O.
STRUCTURAL TIMBER - TREATED OR		
UNTREATED - EXTREME FIBER STRESS	-----	1,800 LBS. PER SQ. IN.
COMPRESSION PERPENDICULAR TO GRAIN OF TIMBER		
	-----	375 LBS. PER SQ. IN.
EQUIVALENT FLUID PRESSURE OF EARTH	-----	30 LBS. PER CU. FT.
		(MINIMUM)

MATERIAL AND WORKMANSHIP:

EXCEPT AS MAY OTHERWISE BE SPECIFIED ON PLANS OR IN THE SPECIAL PROVISIONS, ALL MATERIAL AND WORKMANSHIP SHALL BE IN ACCORDANCE WITH THE 2012 "STANDARD SPECIFICATIONS FOR ROADS AND STRUCTURES" OF THE N. C. DEPARTMENT OF TRANSPORTATION.

STEEL SHEET PILING FOR PERMANENT OR TEMPORARY APPLICATIONS SHALL BE HOT ROLLED.

CONCRETE:

UNLESS OTHERWISE REQUIRED ON PLANS, CLASS A CONCRETE SHALL BE USED FOR ALL PORTIONS OF ALL STRUCTURES WITH THE EXCEPTION THAT: CLASS AA CONCRETE SHALL BE USED IN BRIDGE SUPERSTRUCTURES, ABUTMENT BACKWALLS, AND APPROACH SLABS; AND CLASS B CONCRETE SHALL BE USED FOR SLOPE PROTECTION AND RIP RAP.

CONCRETE CHAMFERS:

UNLESS OTHERWISE NOTED ON THE PLANS, ALL EXPOSED CORNERS ON STRUCTURES SHALL BE CHAMFERED 3/4" WITH THE FOLLOWING EXCEPTIONS: TOP CORNERS OF CURBS MAY BE ROUNDED TO 1-1/2" RADIUS WHICH IS BUILT INTO CURB FORMS; CORNERS OF TRANSVERSE FLOOR EXPANSION JOINTS SHALL BE ROUNDED WITH A 1/4" FINISHING TOOL UNLESS OTHERWISE REQUIRED ON PLANS; AND CORNERS OF EXPANSION JOINTS IN THE ROADWAY FACES AND TOPS OF CURBS AND SIDEWALKS SHALL BE ROUNDED TO A 1/4" RADIUS WITH A FINISHING STONE OR TOOL UNLESS OTHERWISE REQUIRED ON PLANS.

DOWELS:

DOWELS WHEN INDICATED ON PLANS AS FOR CULVERT EXTENSIONS, SHALL BE EMBEDDED AT LEAST 12" INTO THE OLD CONCRETE AND GROUTED INTO PLACE WITH 1:2 CEMENT MORTAR.

ALLOWANCE FOR DEAD LOAD DEFLECTION, SETTLEMENT, ETC. IN CASTING SUPERSTRUCTURES:

BRIDGES SHALL BE BUILT ON THE GRADE OR VERTICAL CURVE SHOWN ON PLANS. SLABS, CURBS AND PARAPETS SHALL CONFORM TO THE GRADE OR CURVE.
 ALL DIMENSIONS WHICH ARE GIVEN IN SECTION AND ARE AFFECTED BY DEAD LOAD DEFLECTIONS ARE DIMENSIONS AT CENTER LINE OF BEARING UNLESS OTHERWISE NOTED ON PLANS. IN SETTING FORMS FOR STEEL BEAM BRIDGES AND PRESTRESSED CONCRETE GIRDER BRIDGES, ADJUSTMENTS SHALL BE MADE DUE TO THE DEAD LOAD DEFLECTIONS FOR THE ELEVATIONS SHOWN. WHERE BLOCKS ARE SHOWN OVER BEAMS FOR BUILDING UP TO THE SLAB, THE VERTICAL DIMENSIONS OF THE BLOCKS SHALL BE ADJUSTED BETWEEN BEARINGS TO COMPENSATE FOR DEAD LOAD DEFLECTIONS, VERTICAL CURVE ORDINATE, AND ACTUAL BEAM CAMBER. WHERE BOTTOM OF SLAB IS IN LINE WITH BOTTOM OF TOP FLANGES, DEPTH OF SLAB BETWEEN BEARINGS SHALL BE ADJUSTED TO COMPENSATE FOR DEAD LOAD DEFLECTION, VERTICAL CURVE ORDINATE, AND ACTUAL BEAM CAMBER.
 IN SETTING FALSEWORK AND FORMS FOR REINFORCED CONCRETE SPANS, AN ALLOWANCE SHALL BE MADE FOR DEAD LOAD DEFLECTIONS, SETTLEMENT OF FALSEWORK, AND PERMANENT CAMBER WHICH SHALL BE PROVIDED FOR IN ADDITION TO THE ELEVATIONS SHOWN. AFTER REMOVAL OF THE FALSEWORK, THE FINISHED STRUCTURES SHALL CONFORM TO THE PROFILE AND ELEVATIONS SHOWN ON THE PLANS AND CONSTRUCTION ELEVATIONS FURNISHED BY THE ENGINEER.
 DETAILED DRAWINGS FOR FALSEWORK OR FORMS FOR BRIDGE SUPERSTRUCTURE AND ANY STRUCTURE OR PARTS OF A STRUCTURE AS NOTED ON THE PLANS SHALL BE SUBMITTED TO THE ENGINEER FOR APPROVAL BEFORE CONSTRUCTION OF THE FALSEWORK OR FORMS IS STARTED.

REINFORCING STEEL:

ALL REINFORCING STEEL SHALL BE DEFORMED. DIMENSIONS RELATIVE TO PLACEMENT OF REINFORCING ARE TO CENTERS OF BARS UNLESS OTHERWISE INDICATED IN THE PLANS. DIMENSIONS ON BAR DETAILS ARE TO CENTERS OF BARS OR ARE OUT TO OUT AS INDICATED ON PLANS.
 WIRE BAR SUPPORTS SHALL BE PROVIDED FOR REINFORCING STEEL WHERE INDICATED ON THE PLANS. WHEN BAR SUPPORT PIECES ARE PLACED IN CONTINUOUS LINES, THEY SHALL BE SO PLACED THAT THE ENDS OF THE SUPPORTING WIRES SHALL BE LAPPED TO LOCK LEGS ON ADJOINING PIECES.

STRUCTURAL STEEL:

AT THE CONTRACTOR'S OPTION, HE MAY SUBSTITUTE 7/8" Ø SHEAR STUDS FOR THE 3/4" Ø STUDS SPECIFIED ON THE PLANS. THIS SUBSTITUTION SHALL BE MADE AT THE RATE OF 3 - 7/8" Ø STUDS FOR 4 - 3/4" Ø STUDS, AND STUD SPACING CHANGES SHALL BE MADE AS NECESSARY TO PROVIDE THE SAME EQUIVALENT NUMBER OF 7/8" Ø STUDS ALONG THE BEAM AS SHOWN FOR 3/4" Ø STUDS BASED ON THE RATIO OF 3 - 7/8" Ø STUDS FOR 4 - 3/4" Ø STUDS. STUDS OF THE LENGTH SPECIFIED ON THE PLANS MUST BE PROVIDED. THE MAXIMUM SPACING SHALL BE 2'-0".
 EXCEPT AT THE INTERIOR SUPPORTS OF CONTINUOUS BEAMS WHERE THE COVER PLATE IS IN CONTACT WITH BEARING PLATE, THE CONTRACTOR MAY, AT HIS OPTION, SUBSTITUTE FOR THE COVER PLATES DESIGNATED ON THE PLANS COVER PLATES OF THE EQUIVALENT AREA PROVIDED THESE PLATES ARE AT LEAST 5/16" IN THICKNESS AND DO NOT EXCEED A WIDTH EQUAL TO THE FLANGE WIDTH LESS 2" OR A THICKNESS EQUAL TO 2 TIMES THE FLANGE THICKNESS. THE SIZE OF FILLET WELDS SHALL CONFORM TO THE REQUIREMENTS OF THE CURRENT ANSI/AASHTO/AWS "BRIDGE WELDING CODE". ELECTROSLAG WELDING WILL NOT BE PERMITTED.
 WITH THE SOLE EXCEPTION OF EDGES AT SURFACES WHICH BEAR ON OTHER SURFACES, ALL SHARP EDGES AND ENDS OF SHAPES AND PLATES SHALL BE SLIGHTLY ROUNDED BY SUITABLE MEANS TO A RADIUS OF APPROXIMATELY 1/16 INCH OR EQUIVALENT FLAT SURFACE AT A SUITABLE ANGLE PRIOR TO PAINTING, GALVANIZING, OR METALLIZING.

HANDRAILS AND POSTS:

METAL STANDARDS AND FACES OF THE CONCRETE END POSTS FOR THE METAL RAIL SHALL BE SET NORMAL TO THE GRADE OF THE CURB, UNLESS OTHERWISE SHOWN ON PLANS. THE METAL RAIL AND TOPS OF CONCRETE POSTS USED WITH THE ALUMINUM RAIL SHALL BE BUILT PARALLEL TO THE GRADE OF THE CURB.
 METAL HANDRAILS SHALL BE IN ACCORDANCE WITH THE PLANS. RAILS SHALL BE AS MANUFACTURED FOR BRIDGE RAILING. CASTINGS SHALL BE OF A UNIFORM APPEARANCE. FINISH AND OTHER DEFORMATIONS RESULTING FROM CASTING OR OTHERWISE SHALL BE REMOVED IN A MANNER SO THAT A UNIFORM COLORING OF THE COMPLETED CASTING SHALL BE OBTAINED. CASTINGS WITH DISCOLORATIONS OR OF NON-UNIFORM COLORING WILL NOT BE ACCEPTED. CERTIFIED MILL REPORTS ARE REQUIRED FOR METAL RAILS AND POSTS.

SPECIAL NOTES:

GENERALLY, IN CASE OF DISCREPANCY, THIS STANDARD SHEET OF NOTES SHALL GOVERN OVER THE SPECIFICATIONS, BUT THE REMAINDER OF THE PLANS SHALL GOVERN OVER NOTES HEREON, AND SPECIAL PROVISIONS SHALL GOVERN OVER ALL. SEE SPECIFICATIONS ARTICLE 105-4.

ENGLISH

JANUARY, 1990

09/28/09

TIP PROJECT: BD-5102M

CONTRACT:




7/25/2012 10:05:30 AM I:\0326-AM\696\014\0900\LENOIR_BR32\Utilities\Rdy_Ut\Proj\BD5102M_UBO-fsh.dgn

STATE OF NORTH CAROLINA
DIVISION OF HIGHWAYS

T.I.P. NO.	SHEET NO.
BD-5102M	UO-1

**UTILITIES BY OTHERS PLANS
LENOIR COUNTY**

**LOCATION: BRIDGE NO. 032 OVER DEEP RUN
ON SR 1141 (JOHN GREEN SMITH ROAD)
TYPE OF WORK: UTILITY BY OTHERS RELOCATION**

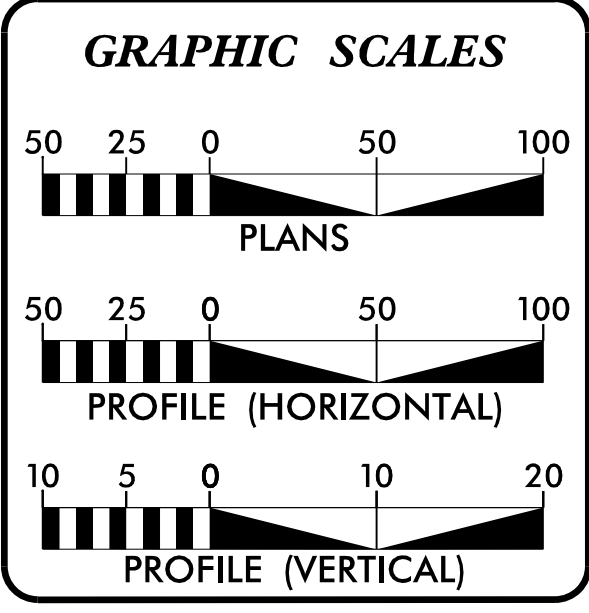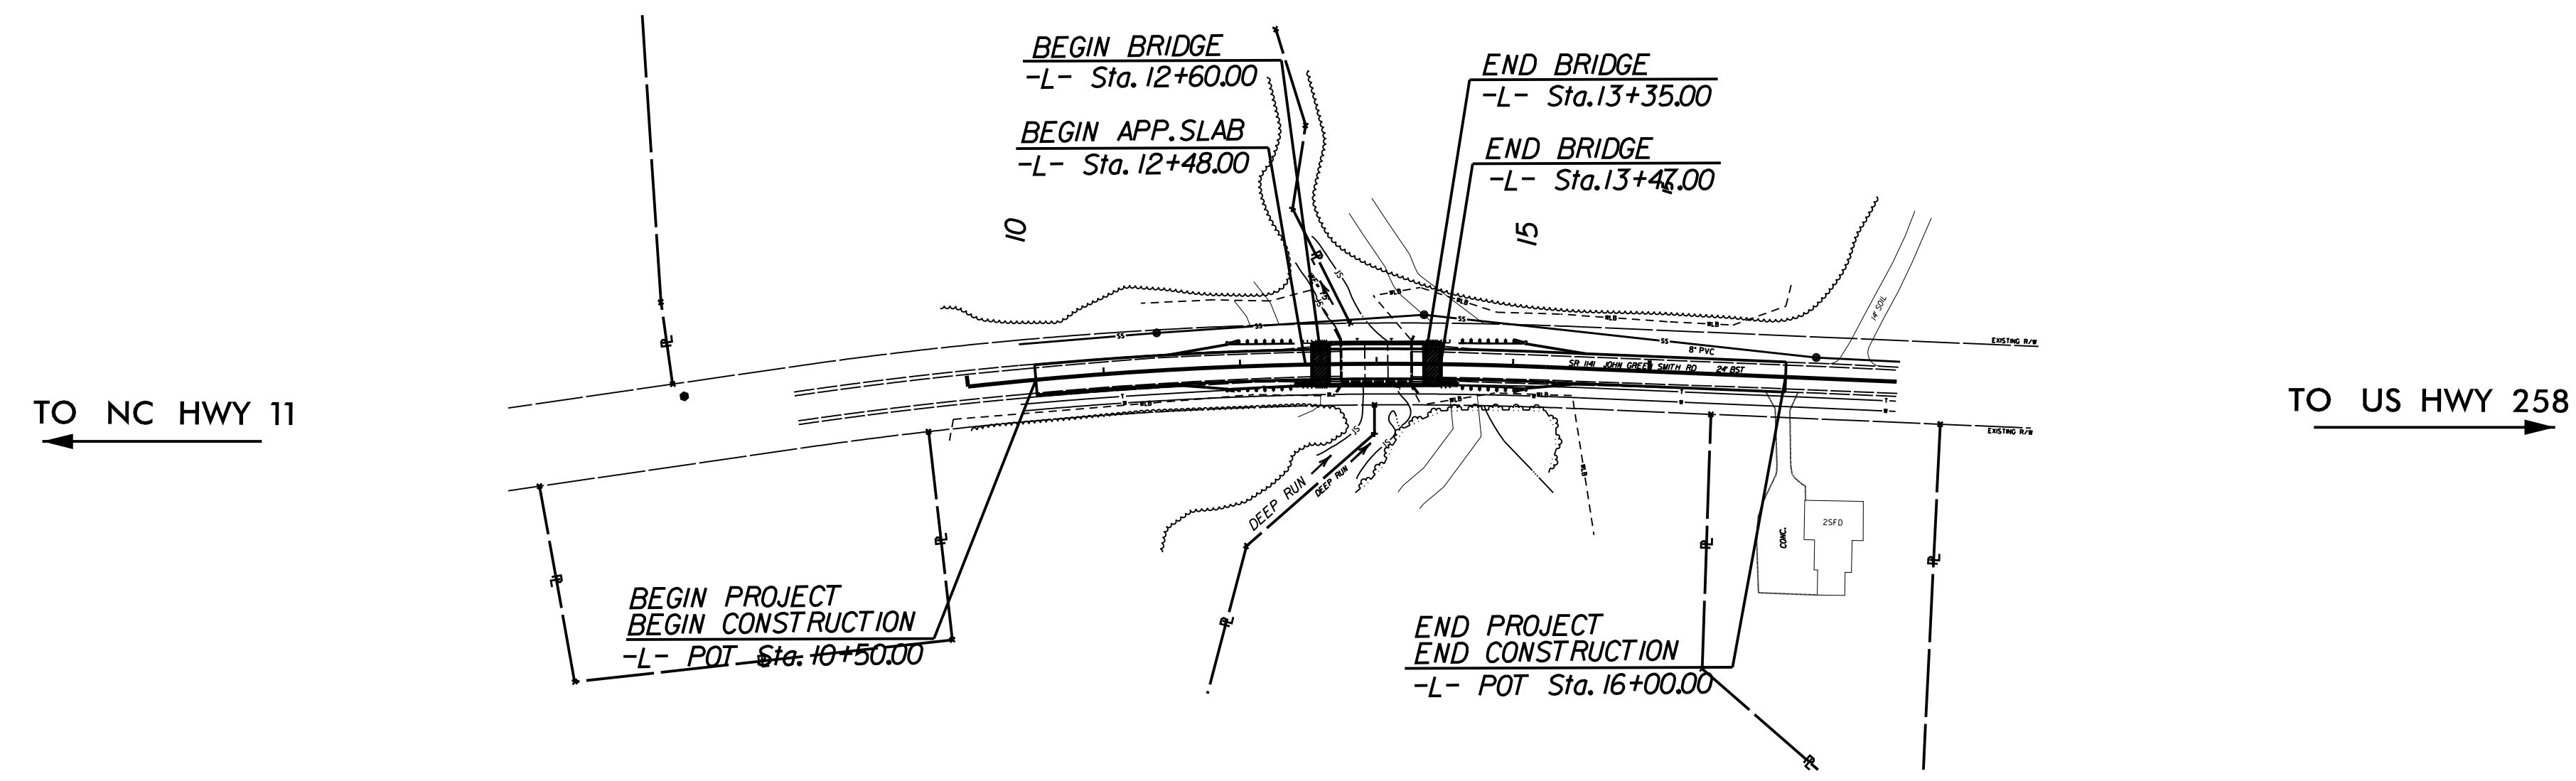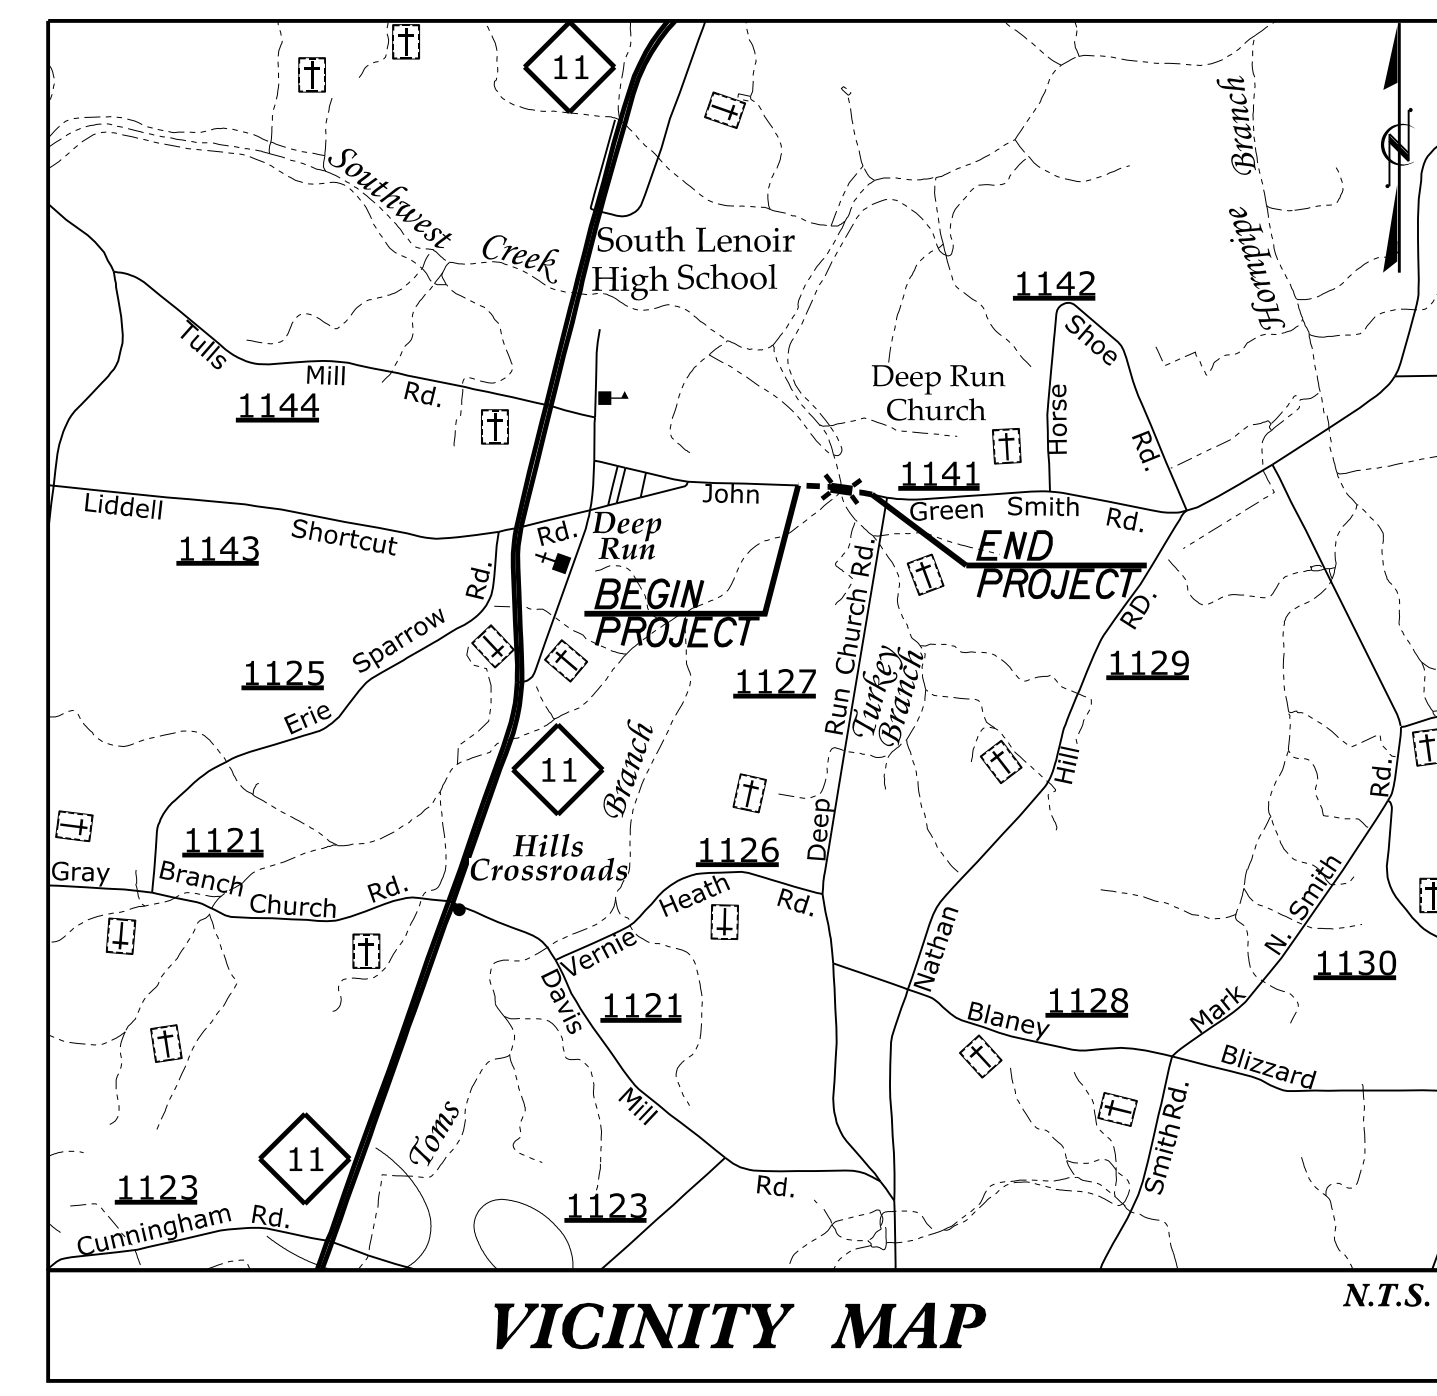

INDEX OF SHEETS

SHEET NO.	DESCRIPTION
UO-1	TITLE SHEET
UO-2	PLAN SHEET

UTILITY OWNERS ON PROJECT

- TELEPHONE - CENTURY LINK - DENNIS STRICKLAND - (252) 571-1748
- WATER - DEEP RUN WATER - JAMIE CANNON - (252) 939-6270
- SEWER - TOWN OF PINK HILL - TIMMY KENNEDY - (252) 568-3181



UTILITY DESIGN BY:
MA Engineering
 CONSULTANTS, INC.
 598 East Chatham Street Suite 137 Cary, NC 27511
 Phone: 919 297 0220 Fax: 919 297 0221

NCDOT PROJECT ENGINEER:
 MARIA ROGERSON, P.E.
PREPARED FOR:
 NORTH CAROLINA
 DEPARTMENT OF TRANSPORTATION
 DIVISION 2 BRIDGE PROGRAM
 GREENVILLE, NC

UTILITIES BY OTHERS

NOTE:
ALL PROPOSED UTILITY WORK
SHOWN ON THIS SHEET WILL
BE DONE BY OTHERS

MA Engineering
CONSULTANTS, INC.
598 East Chatham Street Suite 137 Cary, NC 27511
Phone: 919.297.0220 Fax: 919.297.0221

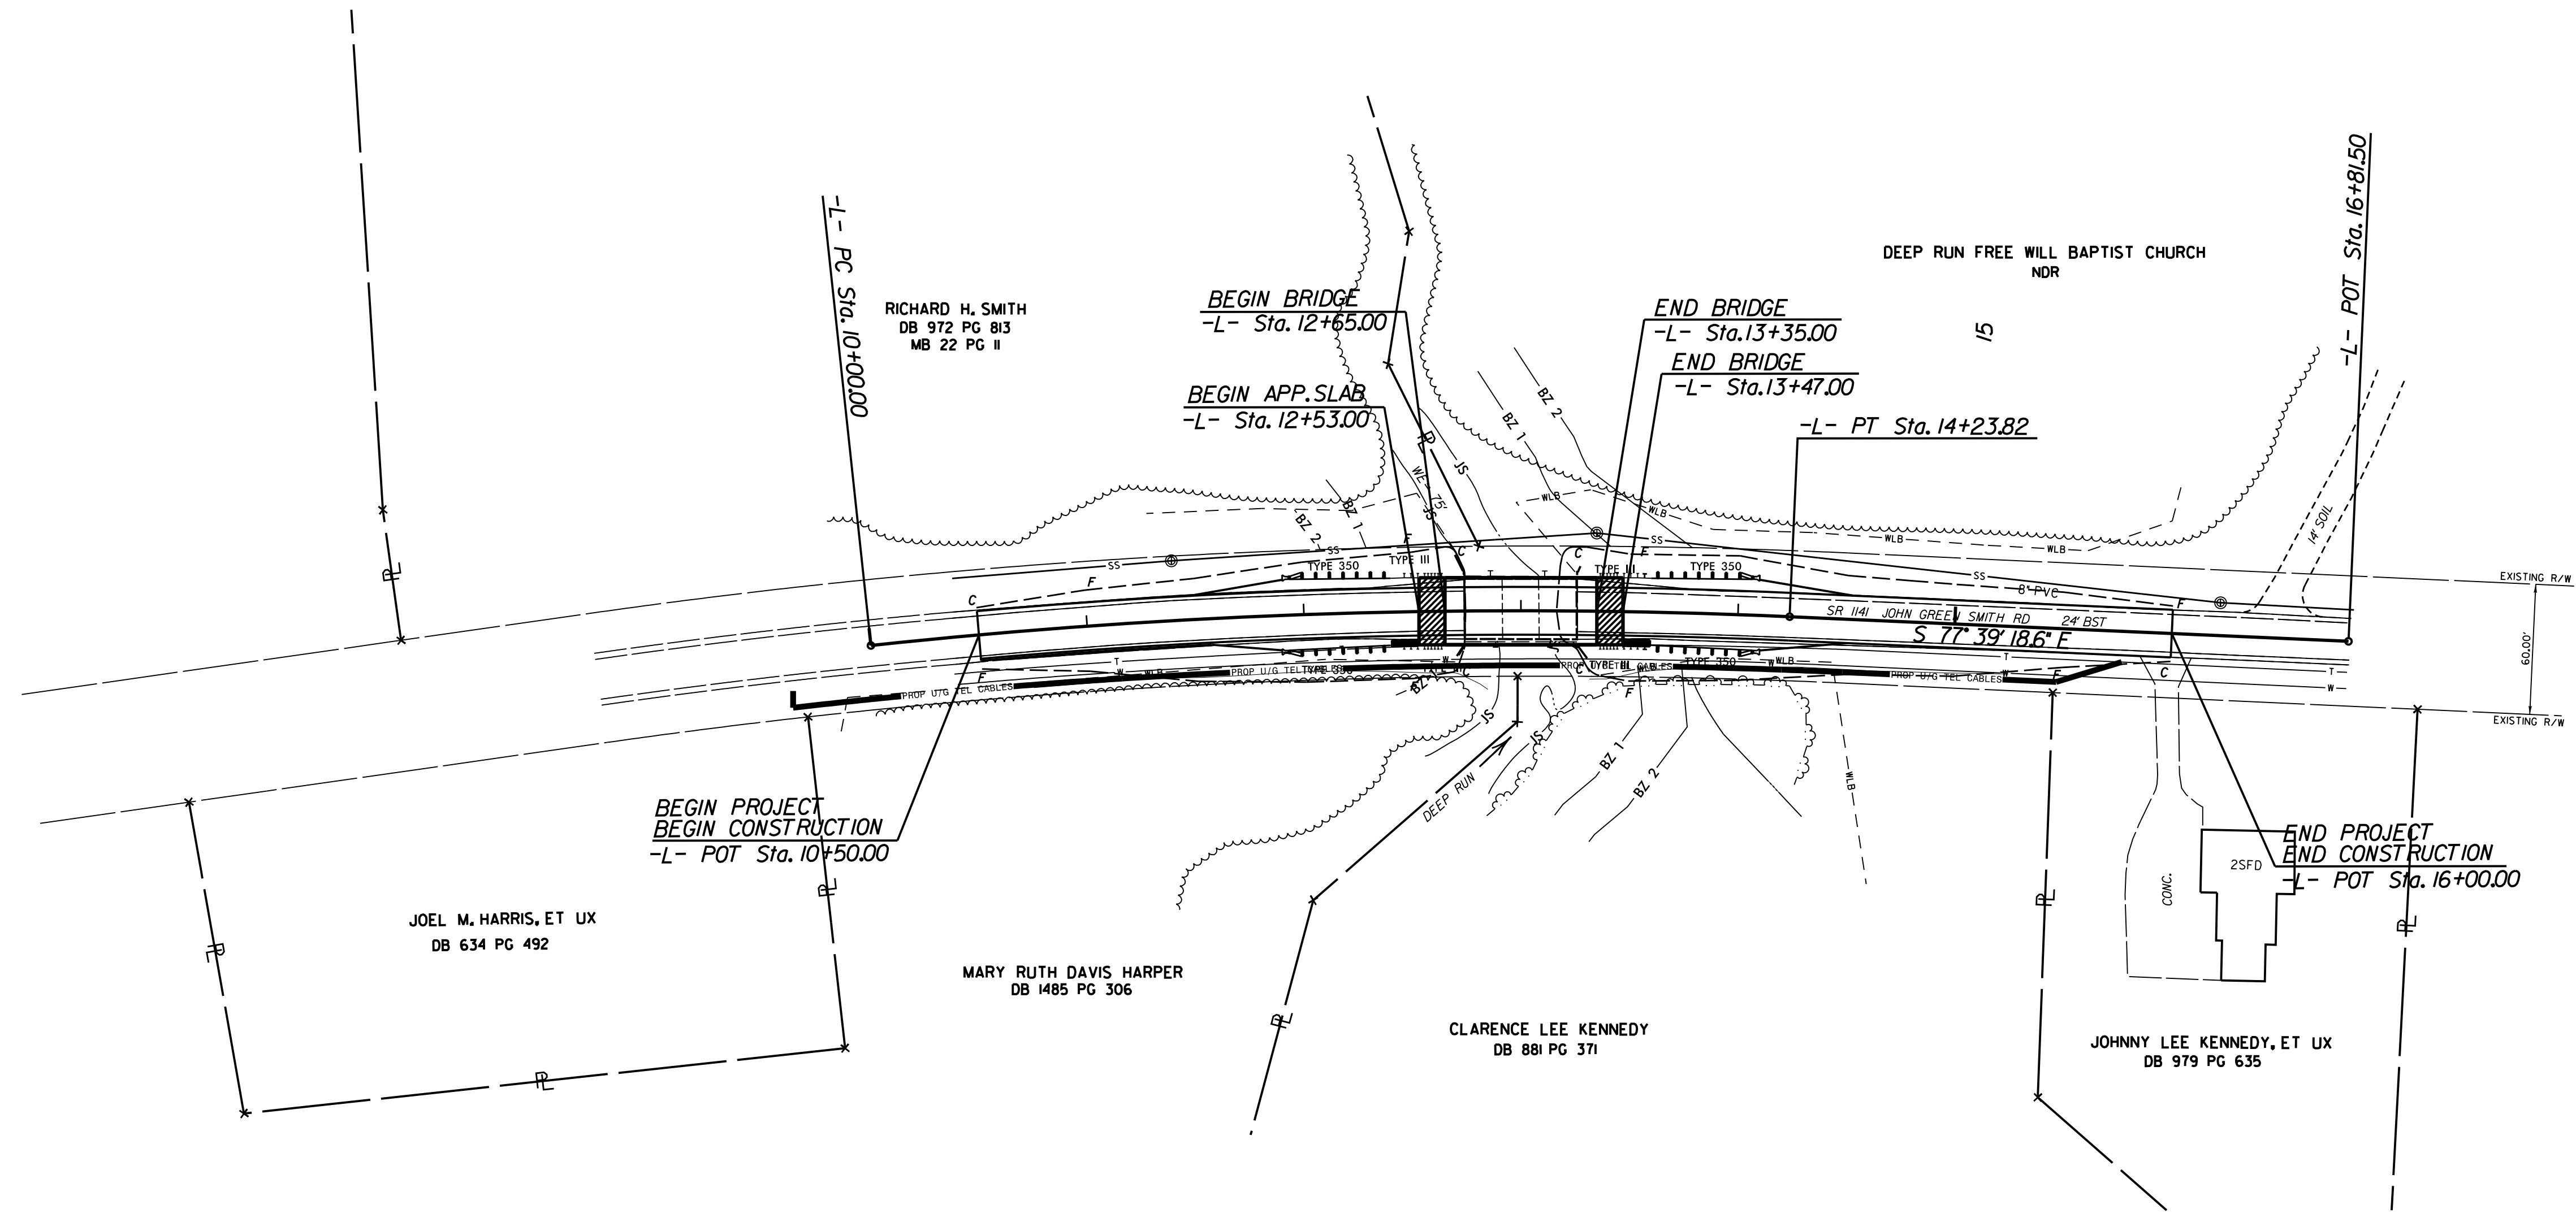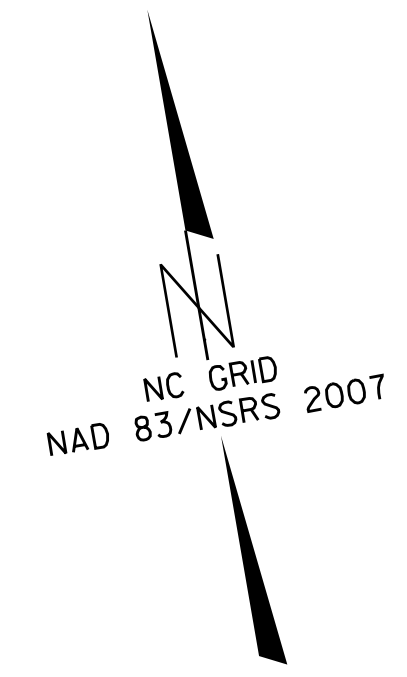

7/25/2012
 P:\05\0696\014\10900\LEND\IFL_BR32\Utr11\tr11\res\Rd1_Utr11\Pro\NBD5102M_UBO_U0-2.dgn
 9:15:26 AM