
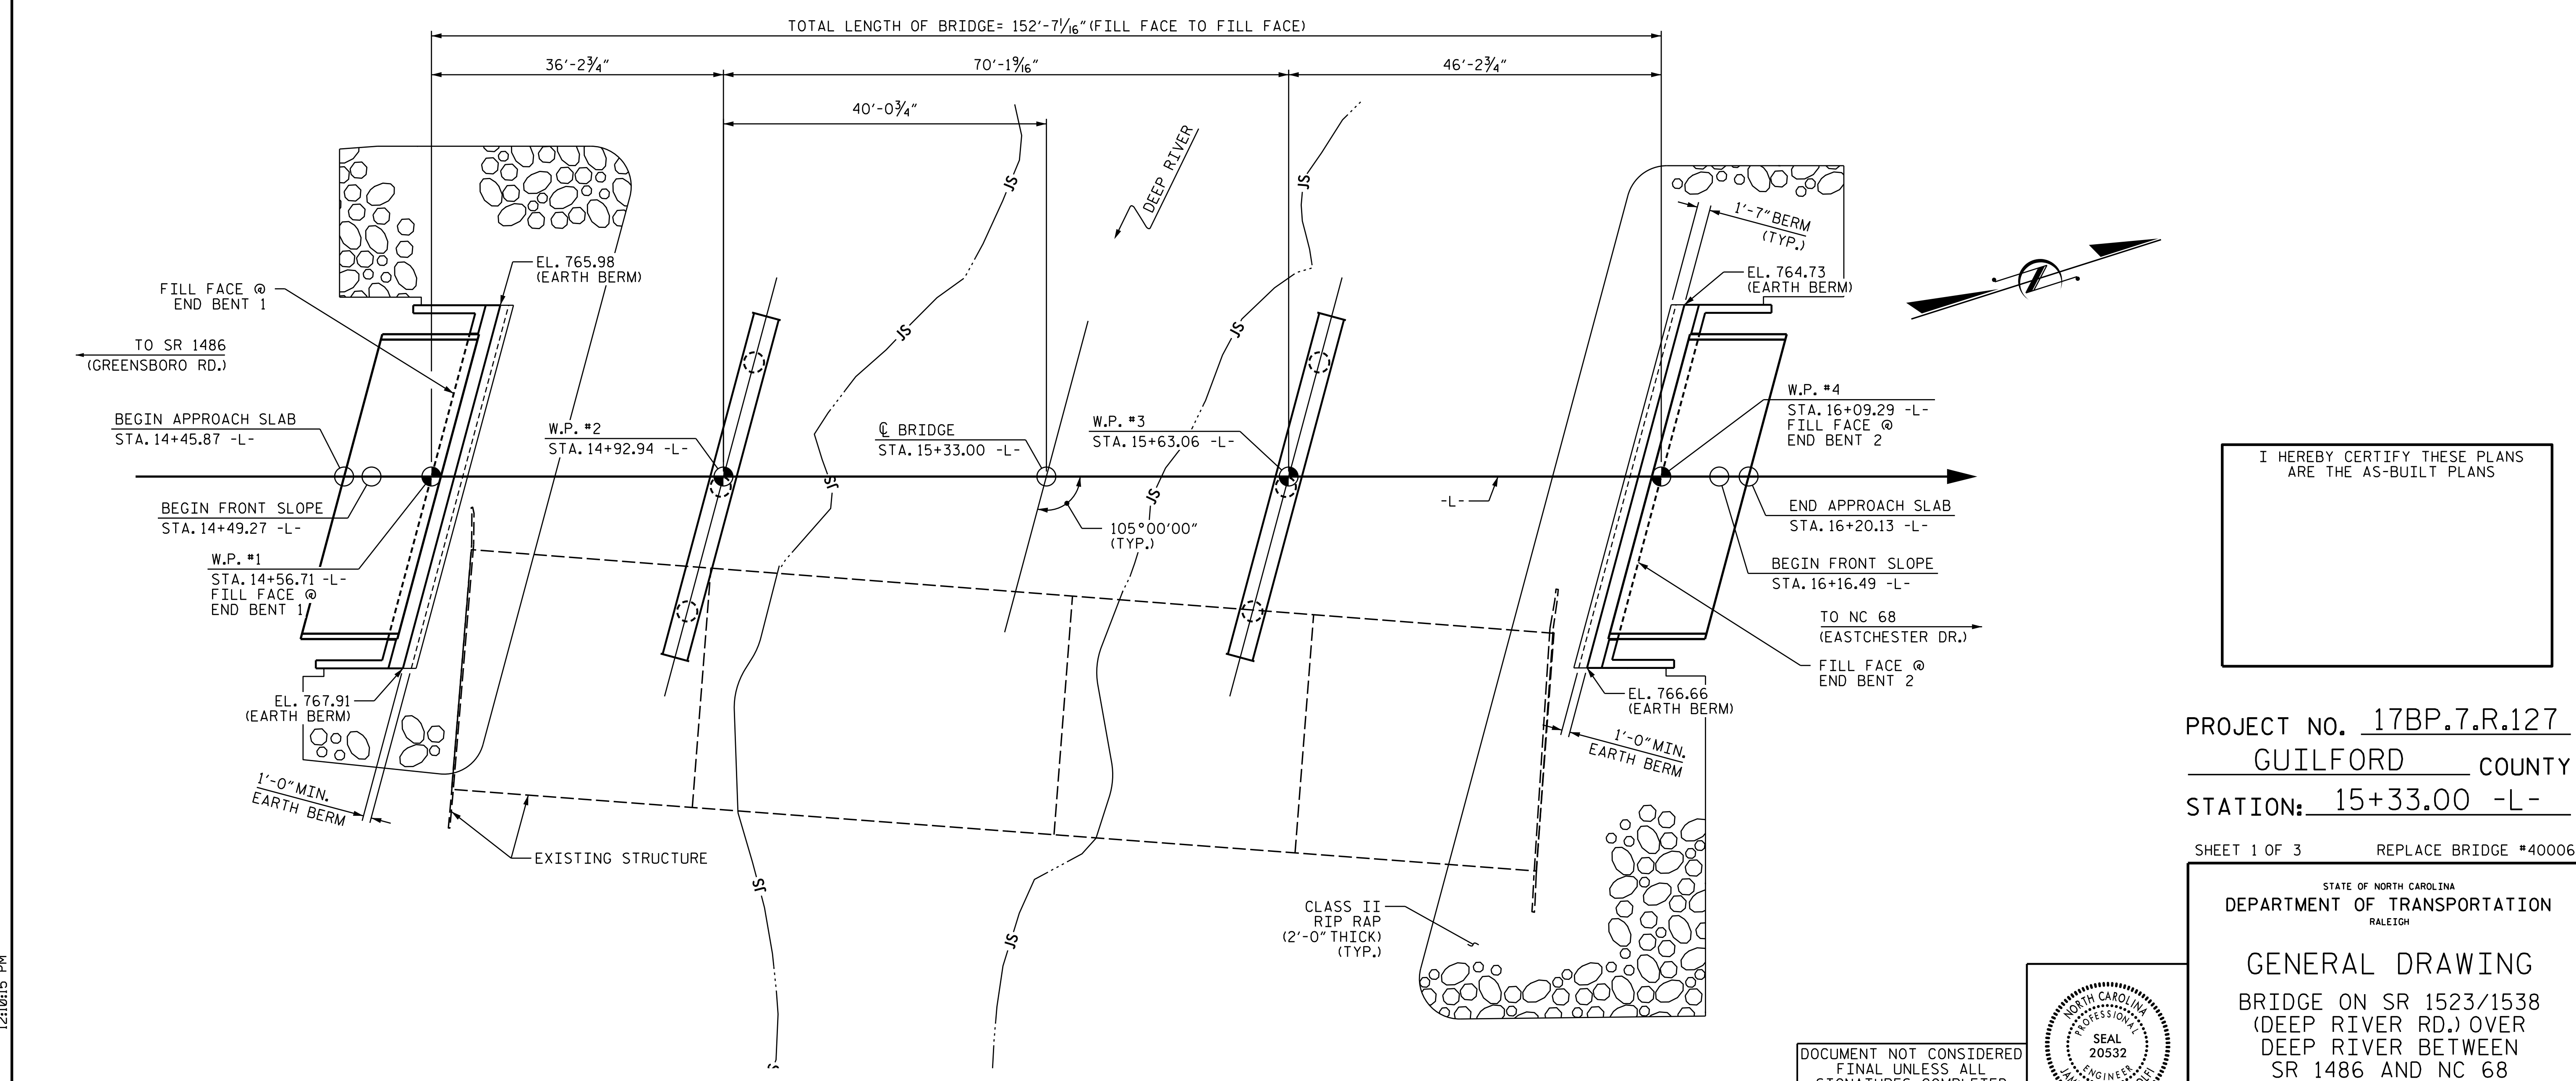


**This electronic collection of documents is provided
for the convenience of the user
and is Not a Certified Document –**

**The documents contained herein were originally issued
and sealed by the individuals whose names and license
numbers appear on each page, on the dates appearing
with their signature on that page.**

**This file or an individual page
shall not be considered a certified document.**

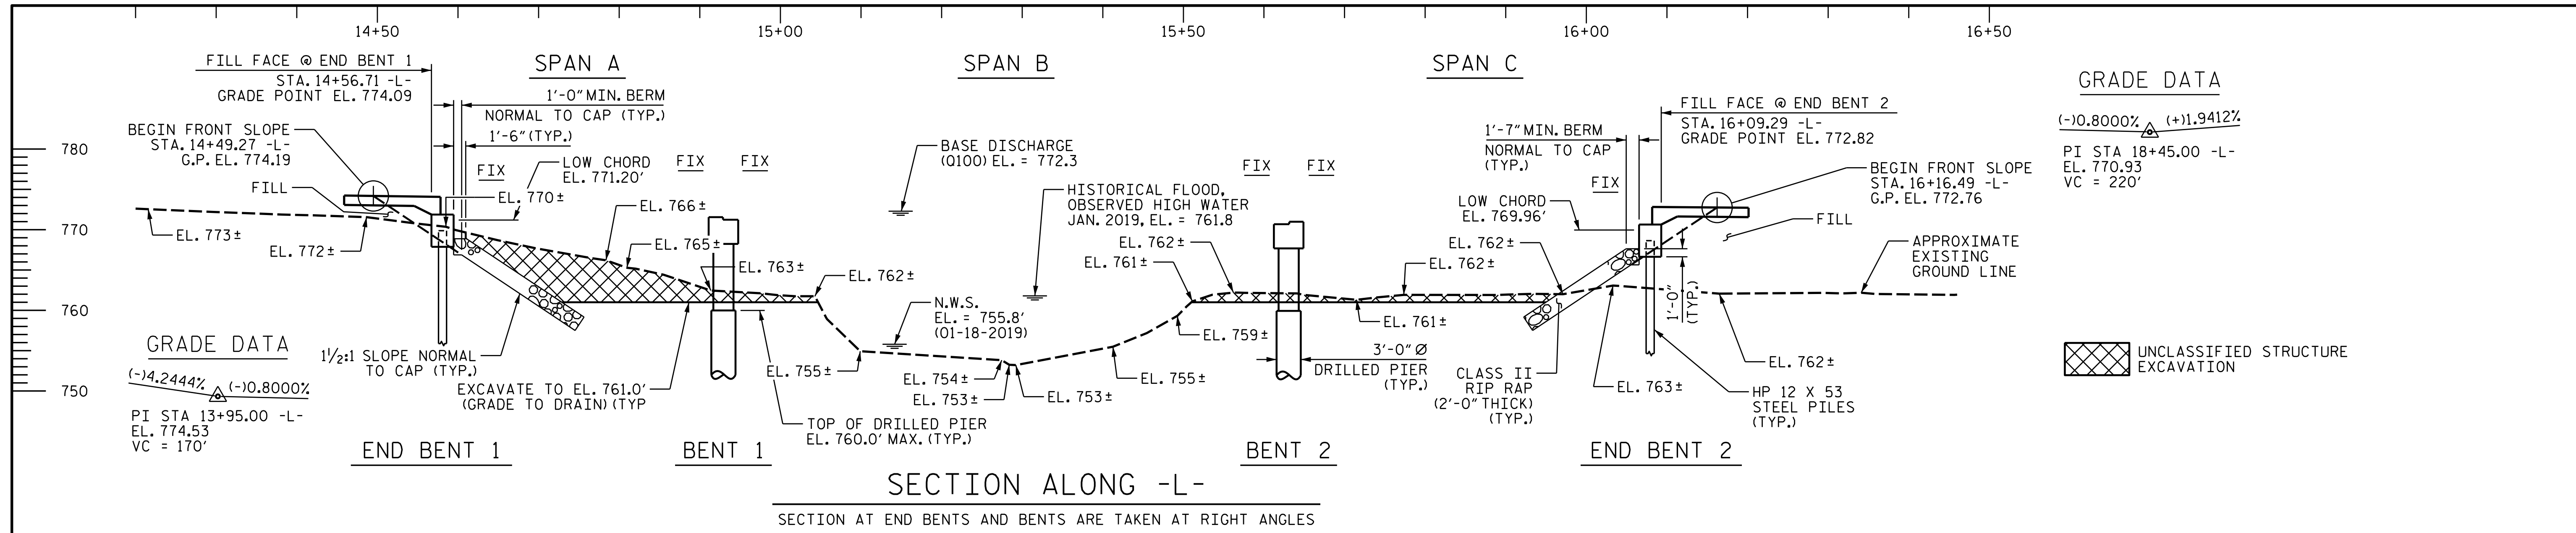


I HEREBY CERTIFY THESE PLANS ARE THE AS-BUILT PLANS

PROJECT NO. 17BP.7.R.127
GUILFORD COUNTY
STATION: 15+33.00 -L-

SHEET 1 OF 3 REPLACE BRIDGE #400067

STATE OF NORTH CAROLINA
DEPARTMENT OF TRANSPORTATION
RALEIGH

GENERAL DRAWING
BRIDGE ON SR 1523/1538
(DEEP RIVER RD.) OVER
DEEP RIVER BETWEEN
SR 1486 AND NC 68

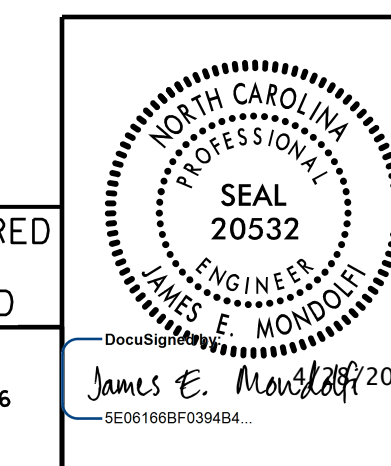

DOCUMENT NOT CONSIDERED FINAL UNLESS ALL SIGNATURES COMPLETED


PLANS PREPARED BY:
MOTT MACDONALD
PO Box 700
Fuquay-Varina, NC 27526
(919) 552-2253
www.mottmac.com
LICENSE NO. F-0669

REVISIONS						SHEET NO.
NO.	BY:	DATE:	NO.	BY:	DATE:	S-1
1			3			TOTAL SHEETS
2			4			30

157077
 \\s1c\server\plans\17BP.7.R.127-SMU_GDI_400067.dgn
 4/27/2021 12:10:15 PM

DRAWN BY: J. T. WILLIAMS DATE: 1-2021
 CHECKED BY: J. E. MONDOLFI DATE: 2-2021
 DESIGN ENGINEER OF RECORD: J. E. MONDOLFI DATE: 2-2021

B5714-2: NCDOT GPS MONUMENT, -L- STA. 11+10.95, 28.76' RT., ELEV. = 783.67'

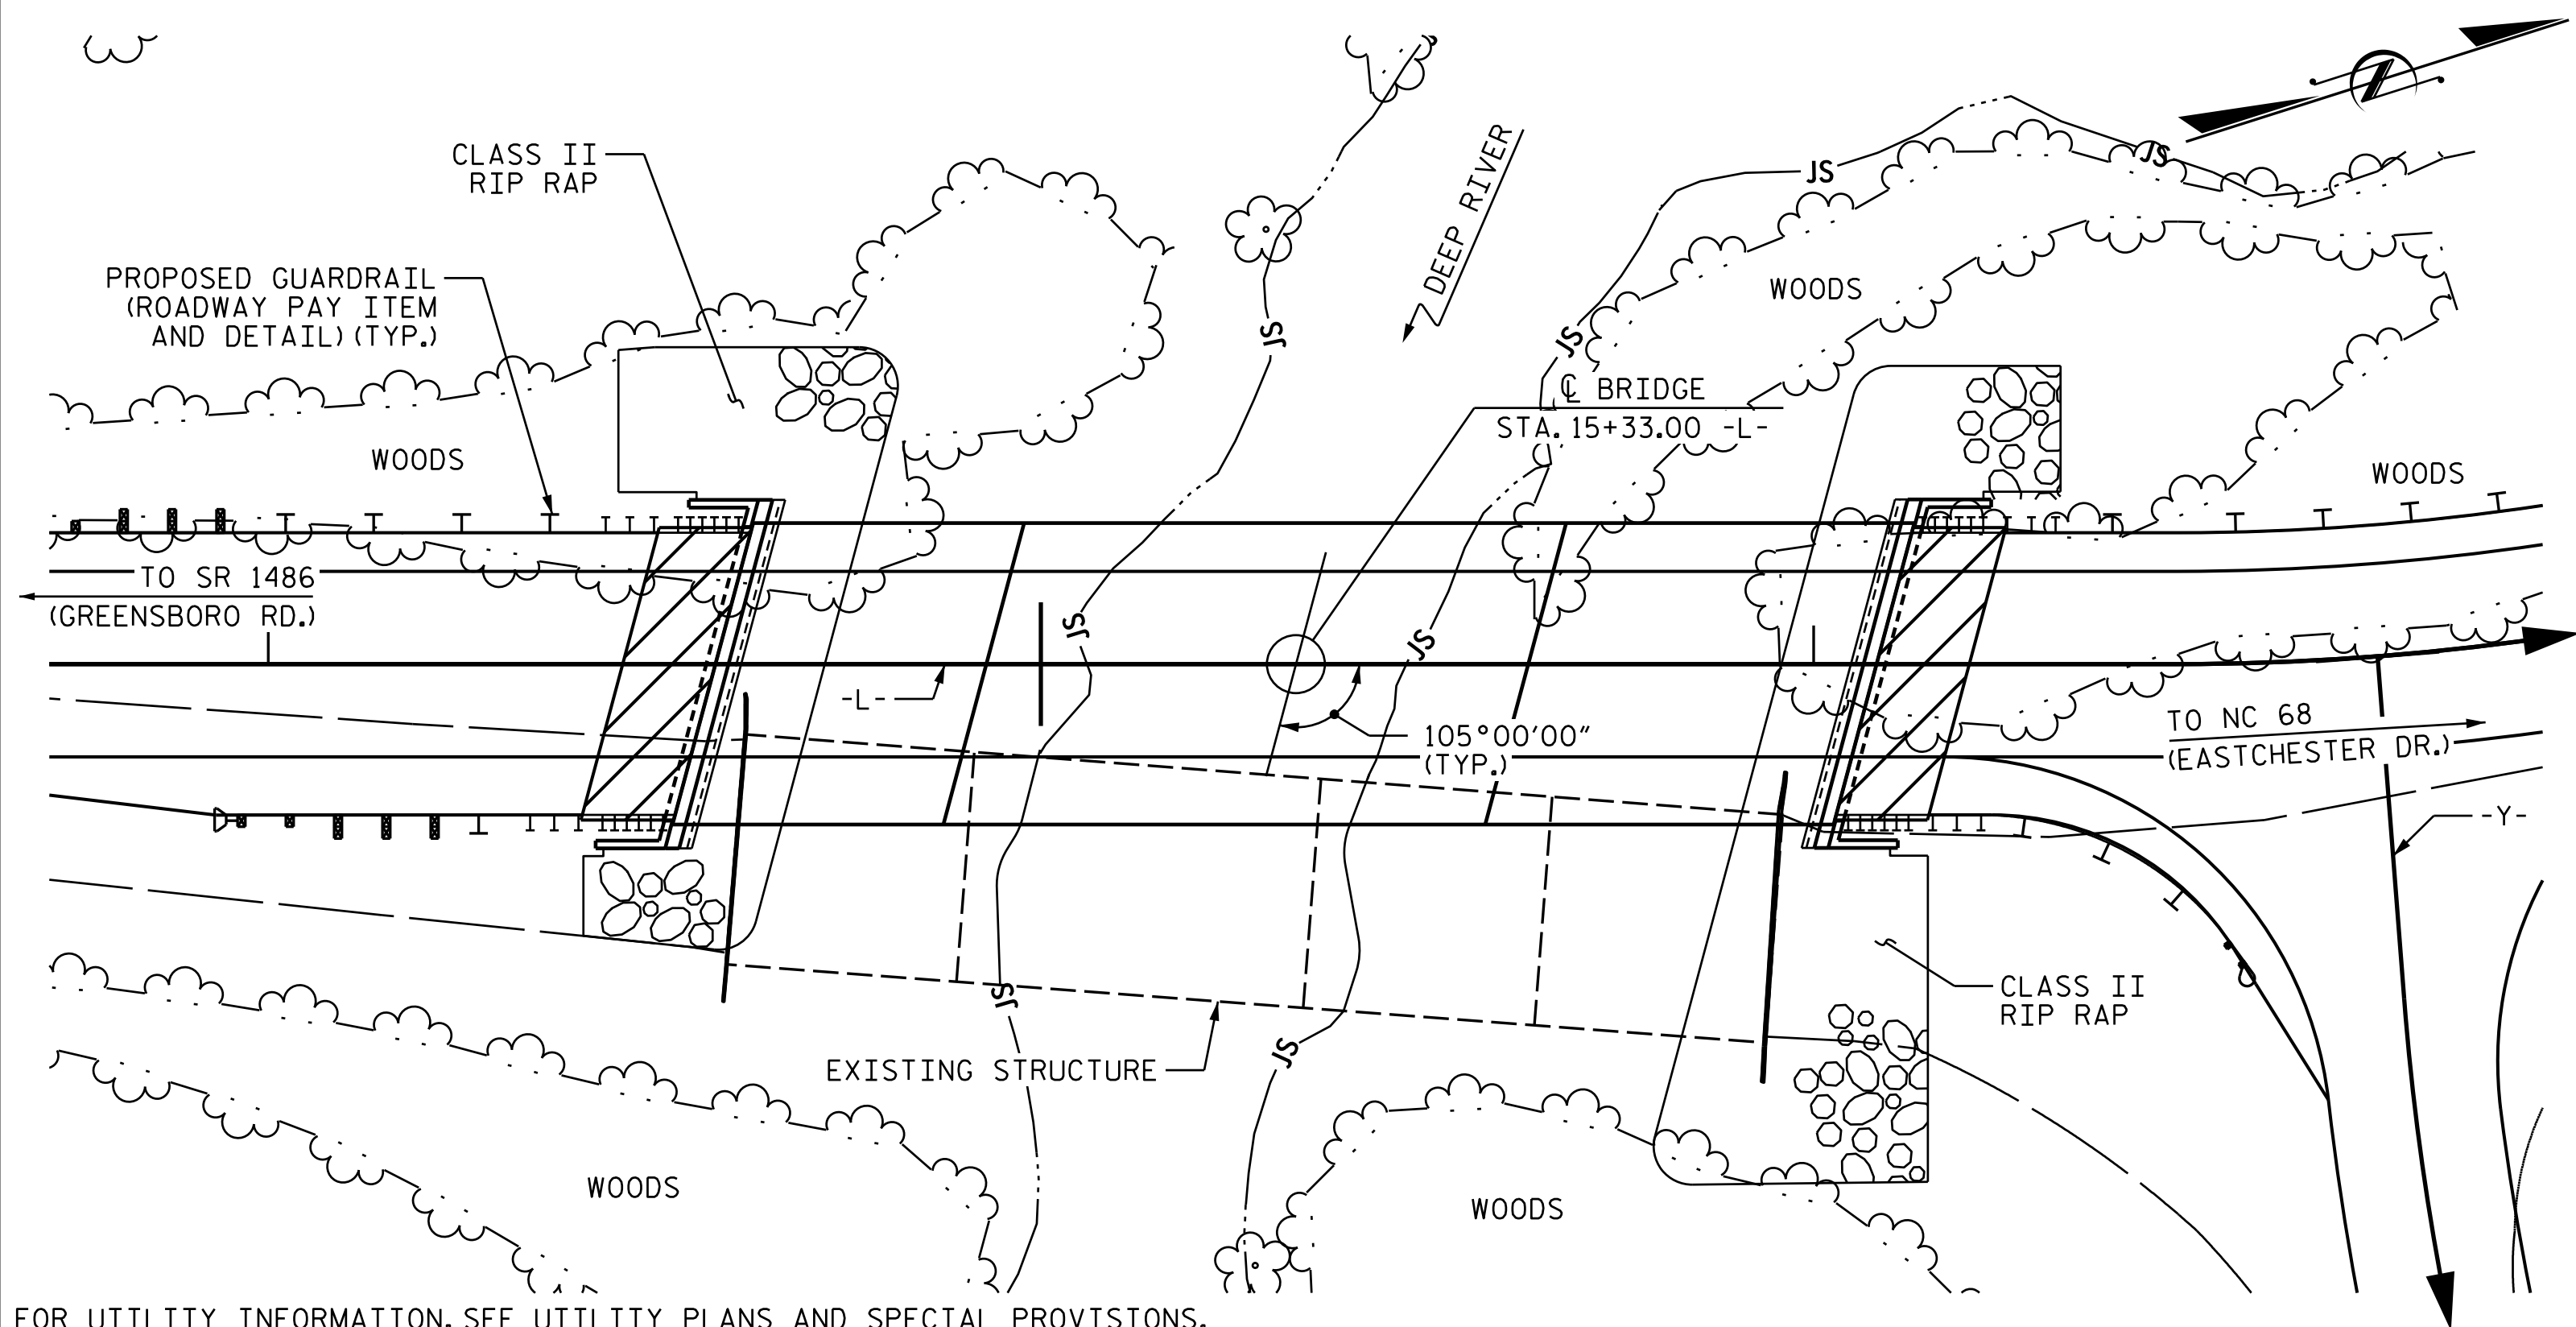

FOR UTILITY INFORMATION, SEE UTILITY PLANS AND SPECIAL PROVISIONS.

LOCATION SKETCH

HYDRAULIC DATA:

DESIGN DISCHARGE	= 5,435 CFS
FREQUENCY OF DESIGN FLOOD	= 25 YEAR
DESIGN HIGH WATER ELEVATION	= 770.7
DRAINAGE AREA	= 32.8 SQ. MI.
BASE DISCHARGE (Q 100)	= 6,930 CFS
BASE HIGH WATER ELEVATION	= 772.3

OVERTOPPING FLOOD DATA:

OVERTOPPING DISCHARGE	= 8,500 CFS
FREQUENCY OF OVERTOPPING FLOOD	= 500± YEAR
OVERTOPPING FLOOD ELEVATION	= 772.5 *

*OT OCCURS AT SAG AT -L- STA. 17+99 RT.

TOTAL BILL OF MATERIAL

	REMOVAL OF EXISTING STRUCTURE	ASBESTOS ASSESSMENT	3'-0" Ø DRILLED PIERS IN SOIL	3'-0" Ø DRILLED PIERS NOT IN SOIL	PERMANENT STEEL CASING FOR 3'-0" Ø DRILLED PIER	PDA TESTING	SID INSPECTIONS	CSL TESTING	UNCLASSIFIED STRUCTURE EXCAVATION	CONCRETE WEARING SURFACE	GROOVING BRIDGE FLOORS	CLASS A CONCRETE (BRIDGE)	BRIDGE APPROACH SLABS
	LUMP SUM	LUMP SUM	LIN. FT.	LIN. FT.	LIN. FT.	EA.	EA.	EA.	LUMP SUM	SQ. FT.	SQ. FT.	CU. YDS.	LUMP SUM
SUPERSTRUCTURE										5,485	5,805		LUMP SUM
END BENT 1												25.1	
BENT 1			29	31	33.6							20.8	
BENT 2			46	26	30.3							20.5	
END BENT 2												25.1	
TOTAL	LUMP SUM	LUMP SUM	75	57	63.9	1	2	2	LUMP SUM	5,485	5,805	91.5	LUMP SUM

TOTAL BILL OF MATERIAL CONT'D

	REINFORCING STEEL (BRIDGE)	SPIRAL COLUMN REINFORCING STEEL (BRIDGE)	PILE DRIVING EQUIPMENT SETUP FOR HP 12 X 53 STEEL PILES	HP 12 X 53 STEEL PILES	STEEL PILE POINTS	TWO BAR METAL RAIL	1'-2" X 2'-11 1/8" CONCRETE PARAPET *	RIP RAP CLASS II (2'-0" THICK)	GEOTEXTILE FOR DRAINAGE	ELASTOMERIC BEARINGS	3'-0" X 1'-9" PRESTRESSED CONCRETE CORED SLABS	3'-0" X 2'-0" PRESTRESSED CONCRETE CORED SLABS		
	LBS.	LBS.	EA.	NO.	LIN. FT.	EA.	LIN. FT.	TONS	SQ. YDS.	LUMP SUM	NO.	LIN. FT.	NO.	LIN. FT.
SUPERSTRUCTURE										LUMP SUM	26	1040	13	910
END BENT 1	3,012		7	7	140	7		176	195					
BENT 1	10,494	1,490												
BENT 2	11,044	1,658												
END BENT 2	3,013		7	7	140	7		264	293					
TOTAL	27,563	3,148	14	14	280	14	284.89	300.52	488	LUMP SUM	26	1040	13	910


* NOTE: 1'-2" X 2'-11 1/8" CONCRETE PARAPET IS MAXIMUM HEIGHT OF PARAPET. ACTUAL HEIGHT OF CONCRETE PARAPET VARIES; SEE "CONCRETE PARAPET AND END POST DETAILS" SHEET.

PROJECT NO. 17BP.7.R.127
 GUILFORD COUNTY
 STATION: 15+33.00 -L-

SHEET 2 OF 3

STATE OF NORTH CAROLINA
 DEPARTMENT OF TRANSPORTATION
 RALEIGH

GENERAL DRAWING
 BRIDGE ON SR 1523/1538
 (DEEP RIVER RD.) OVER
 DEEP RIVER BETWEEN
 SR 1486 AND NC 68

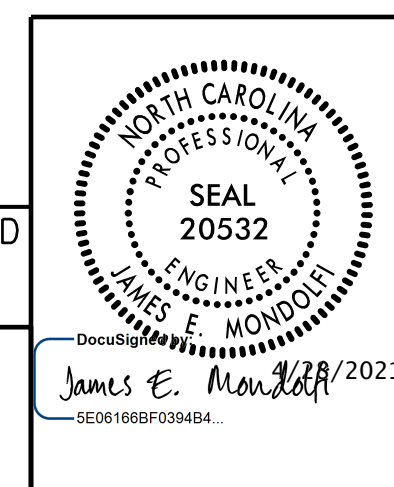

DOCUMENT NOT CONSIDERED FINAL UNLESS ALL SIGNATURES COMPLETED

PLANS PREPARED BY:
M MOTT MACDONALD
 PO Box 700
 Fuquay-Varina, NC 27526
 (919) 552-2253
 www.mottmac.com
 LICENSE NO. F-0669

REVISIONS						SHEET NO.
NO.	BY:	DATE:	NO.	BY:	DATE:	S-2
1			3			TOTAL SHEETS
2			4			30

W:\157077\157077.dwg
 12/10/17 PM
 4/27/2021

DRAWN BY: J. T. WILLIAMS DATE: 1-2021
 CHECKED BY: J. E. MONDOLFI DATE: 2-2021
 DESIGN ENGINEER OF RECORD: J. E. MONDOLFI DATE: 2-2021

LOAD AND RESISTANCE FACTOR RATING (LRFD) SUMMARY FOR PRESTRESSED CONCRETE GIRDERS

LEVEL	VEHICLE	WEIGHT (W) (TONS)	CONTROLLING LOAD RATING	MINIMUM RATING FACTORS (RF)	TONS = W X RF	STRENGTH I LIMIT STATE										SERVICE III LIMIT STATE					COMMENT NUMBER			
						MOMENT					SHEAR					MOMENT								
						LIVELOAD FACTORS	DISTRIBUTION FACTORS (DF)	RATING FACTOR	SPAN	GIRDER LOCATION	DISTANCE FROM LEFT END OF SPAN (ft)	DISTRIBUTION FACTORS (DF)	RATING FACTOR	SPAN	GIRDER LOCATION	DISTANCE FROM LEFT END OF SPAN (ft)	LIVELOAD FACTORS	DISTRIBUTION FACTORS (DF)	RATING FACTOR	SPAN		GIRDER LOCATION	DISTANCE FROM LEFT END OF SPAN (ft)	
DESIGN LOAD RATING	HL-93(Inv)	N/A	1	1.098	--	1.75	0.272	1.36	45'	EL	21.982	0.617	1.46	45'	EL	35.172	0.80	0.272	1.10	45'	EL	21.982		
	HL-93(Opr)	N/A	--	1.764	--	1.35	0.272	1.76	45'	EL	21.982	0.617	1.89	45'	EL	35.172	N/A	--	--	--	--	--		
	HS-20(Inv)	36.000	2	1.347	48.507	1.75	0.272	1.67	45'	EL	21.982	0.617	1.68	45'	EL	8.793	0.80	0.272	1.35	45'	EL	21.982		
	HS-20(Opr)	36.000	--	2.165	77.938	1.35	0.272	2.16	45'	EL	21.982	0.617	2.17	45'	EL	8.793	N/A	--	--	--	--	--		
LEGAL LOAD RATING	SV	SNSH	13.500	--	2.632	35.536	1.4	0.272	4.08	45'	EL	21.982	0.617	4.43	45'	EL	35.172	0.80	0.272	2.63	45'	EL	21.982	
		SNGARBS2	20.000	--	2.126	42.513	1.4	0.272	3.29	45'	EL	21.982	0.617	3.32	45'	EL	35.172	0.80	0.272	2.13	45'	EL	21.982	
		SNAGRIS2	22.000	--	2.085	45.877	1.4	0.272	3.19	45'	EL	17.586	0.617	3.15	45'	EL	35.172	0.80	0.272	2.09	45'	EL	21.982	
		SNCOTTS3	27.250	--	1.314	35.814	1.4	0.272	2.04	45'	EL	21.982	0.617	2.23	45'	EL	8.793	0.80	0.272	1.31	45'	EL	21.982	
		SNAGGRS4	34.925	--	1.16	40.51	1.4	0.272	1.8	45'	EL	21.982	0.617	1.97	45'	EL	35.172	0.80	0.272	1.16	45'	EL	21.982	
		SNS5A	35.550	--	1.13	40.167	1.4	0.272	1.75	45'	EL	21.982	0.617	2.06	45'	EL	8.793	0.80	0.272	1.13	45'	EL	21.982	
		SNS6A	39.950	--	1.064	42.522	1.4	0.272	1.65	45'	EL	21.982	0.617	1.94	45'	EL	35.172	0.80	0.272	1.06	45'	EL	21.982	
	SNS7B	42.000	3	1.015	42.617	1.4	0.272	1.57	45'	EL	21.982	0.617	1.98	45'	EL	35.172	0.80	0.272	1.01	45'	EL	21.982		
	TTST	TNAGRIT3	33.000	--	1.306	43.112	1.4	0.272	2.02	45'	EL	21.982	0.617	2.26	45'	EL	8.793	0.80	0.272	1.31	45'	EL	21.982	
		TNT4A	33.075	--	1.32	43.663	1.4	0.272	2.05	45'	EL	21.982	0.617	2.14	45'	EL	35.172	0.80	0.272	1.32	45'	EL	21.982	
		TNT6A	41.600	--	1.108	46.093	1.4	0.272	1.72	45'	EL	21.982	0.617	2.11	45'	EL	35.172	0.80	0.272	1.11	45'	EL	21.982	
		TNT7A	42.000	--	1.129	47.436	1.4	0.272	1.75	45'	EL	21.982	0.617	1.96	45'	EL	35.172	0.80	0.272	1.13	45'	EL	21.982	
		TNT7B	42.000	--	1.176	49.384	1.4	0.272	1.82	45'	EL	21.982	0.617	1.88	45'	EL	35.172	0.80	0.272	1.18	45'	EL	21.982	
		TNAGRIT4	43.000	--	1.12	48.157	1.4	0.272	1.74	45'	EL	21.982	0.617	1.8	45'	EL	35.172	0.80	0.272	1.12	45'	EL	21.982	
TNAGT5A		45.000	--	1.042	46.893	1.4	0.272	1.61	45'	EL	21.982	0.617	1.88	45'	EL	35.172	0.80	0.272	1.04	45'	EL	21.982		
TNAGT5B	45.000	--	1.017	45.785	1.4	0.272	1.58	45'	EL	21.982	0.617	1.7	45'	EL	35.172	0.80	0.272	1.02	45'	EL	21.982			

LOAD FACTORS:

DESIGN LOAD RATING FACTORS	LIMIT STATE	γ_{DC}	γ_{DW}
	STRENGTH I	1.25	1.50
	SERVICE III	1.00	1.00

NOTES:

MINIMUM RATING FACTORS ARE BASED ON THE STRENGTH I AND SERVICE III LIMIT STATES.
ALLOWABLE STRESSES FOR SERVICE III LIMIT STATE ARE AS REQUIRED FOR DESIGN.

COMMENTS:

- 1.
- 2.
- 3.
- 4.

CONTROLLING LOAD RATING

1 DESIGN LOAD RATING (HL-93)


2 DESIGN LOAD RATING (HS-20)

3 LEGAL LOAD RATING **

** SEE CHART FOR VEHICLE TYPE

GIRDER LOCATION

I - INTERIOR GIRDER
EL - EXTERIOR LEFT GIRDER
ER - EXTERIOR RIGHT GIRDER

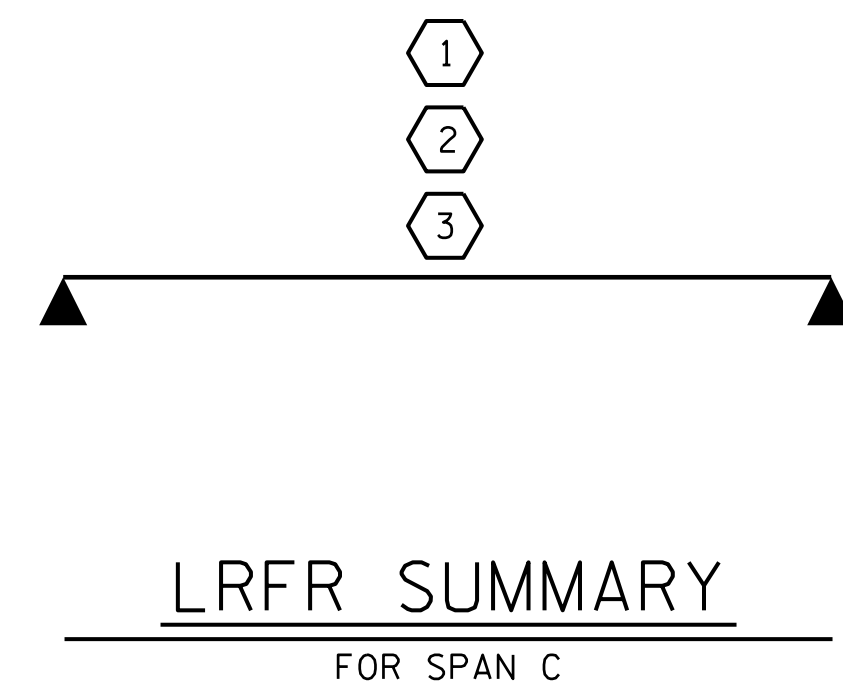

PROJECT NO. 17BP.7.R.127
GUILFORD COUNTY
STATION: 15+33.00 -L-


STATE OF NORTH CAROLINA
DEPARTMENT OF TRANSPORTATION
RALEIGH

LRFR SUMMARY FOR
45' CORED SLAB UNIT
105° SKEW
(NON-INTERSTATE TRAFFIC)

REVISIONS						SHEET NO.
NO.	BY:	DATE:	NO.	BY:	DATE:	S-6
1			3			TOTAL SHEETS
2			4			30


DOCUMENT NOT CONSIDERED FINAL UNLESS ALL SIGNATURES COMPLETED

PLANS PREPARED BY:
M MOTT MACDONALD
PO Box 700
Fuquay-Varina, NC 27526
(919) 552-2253
www.mottmac.com
LICENSE NO. F-0669

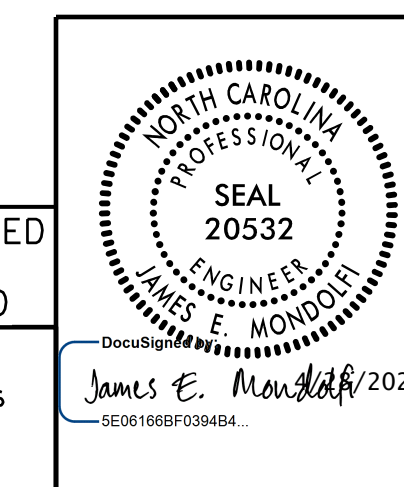


H:\157077\Drawings\17BP.7.R.127-SMU.LRFR_40006.dgn
 4/27/2021 12:10:21 PM

DRAWN BY: M. L. MARLEY DATE: 2-2021
 CHECKED BY: J. E. MONDOLFI DATE: 2-2021
 DESIGN ENGINEER OF RECORD: J. E. MONDOLFI DATE: 2-2021

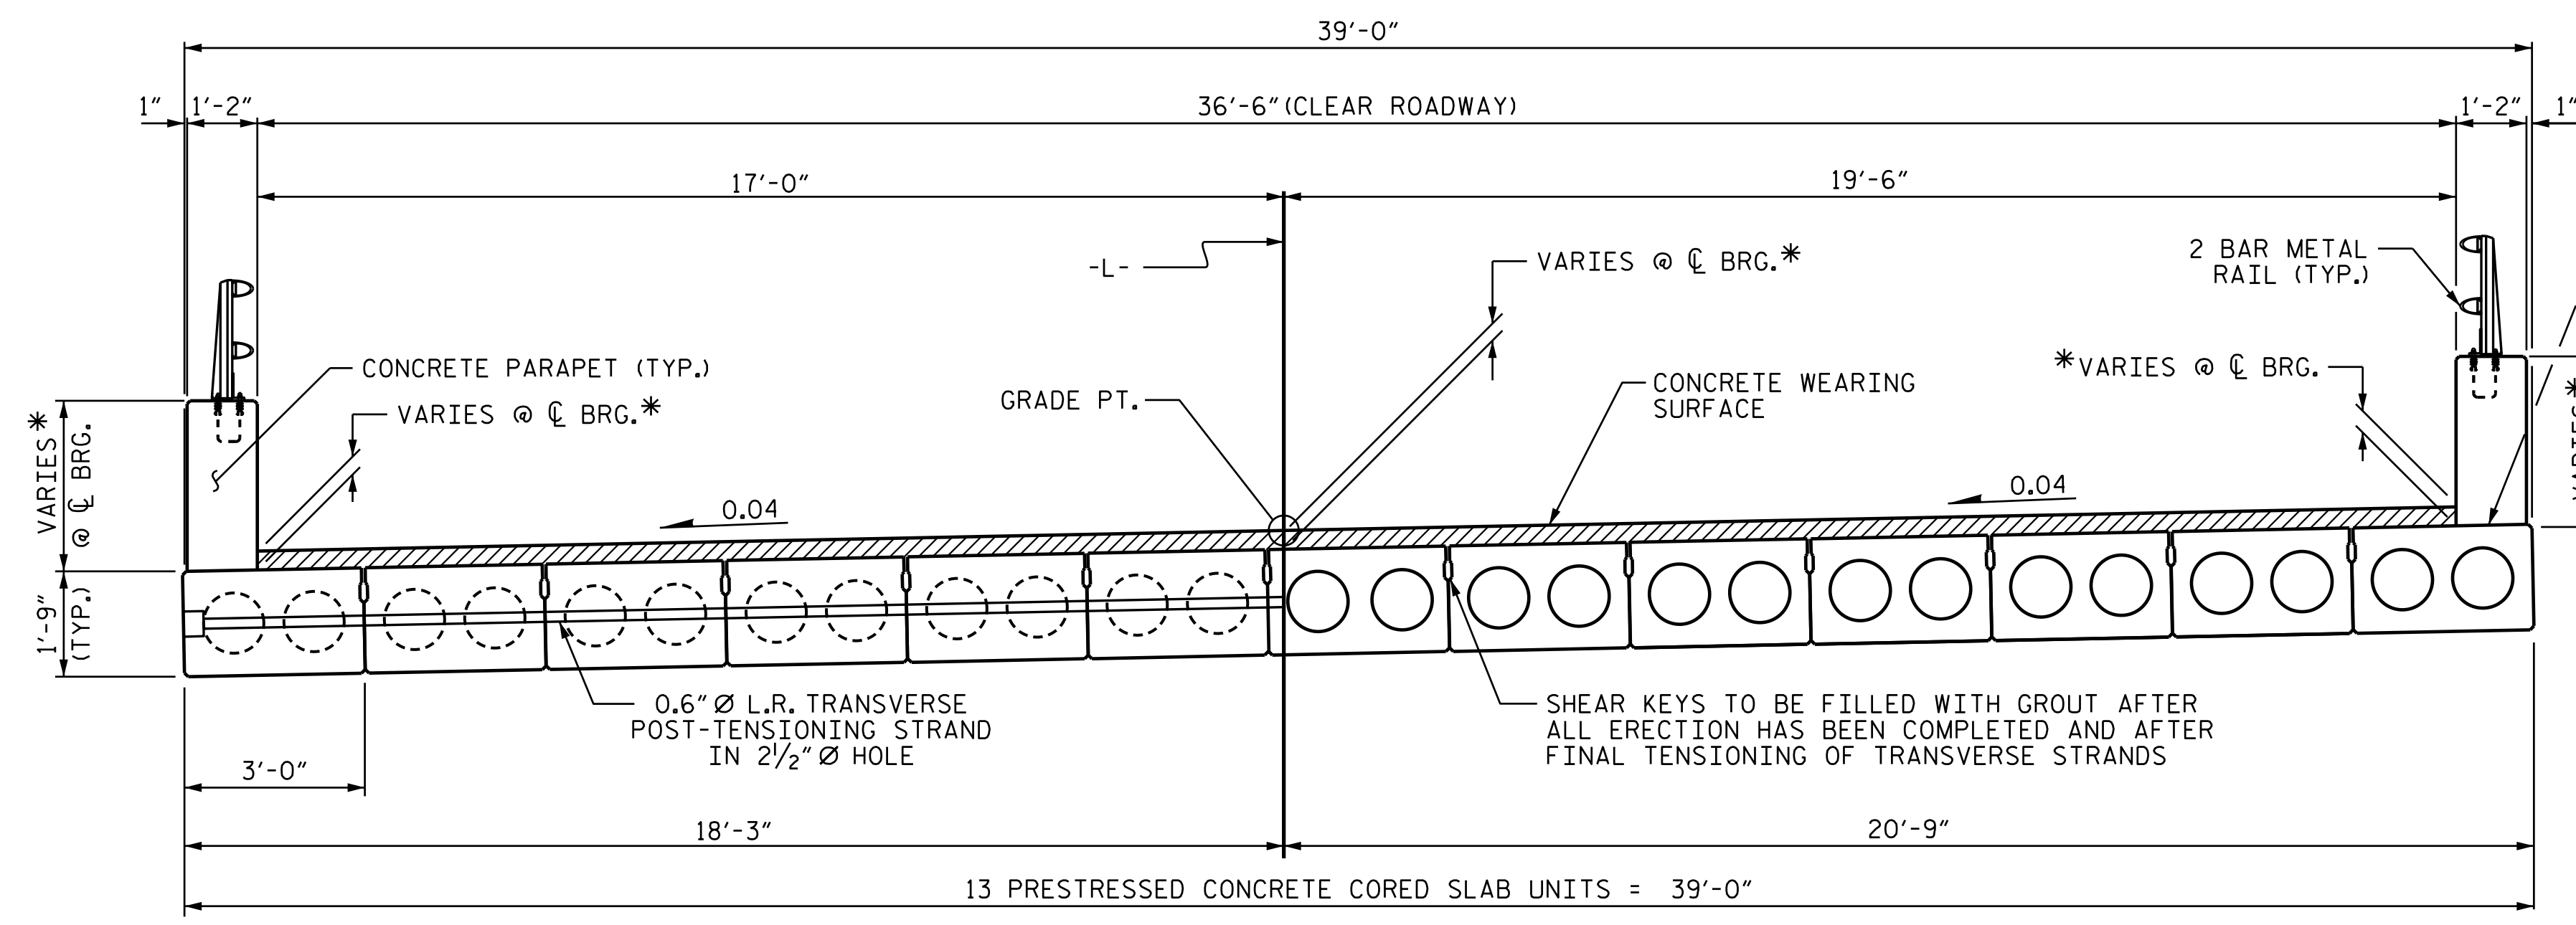


HALF SECTION AT INTERMEDIATE DIAPHRAGMS
TYPICAL SECTION - SPANS A & C
 HALF SECTION THROUGH VOIDS


* - THE HEIGHT OF THE PARAPET AND CONCRETE WEARING SURFACE THICKNESS VARIES WHILE THE TOP OF THE PARAPET FOLLOWS THE PROFILE OF THE GUTTERLINE. FOR PARAPET HEIGHT DETAILS AND CONCRETE WEARING SURFACE THICKNESS, SEE THE "CONCRETE PARAPET AND END POST DETAILS" AND "CONCRETE WEARING SURFACE DETAILS" SHEETS.

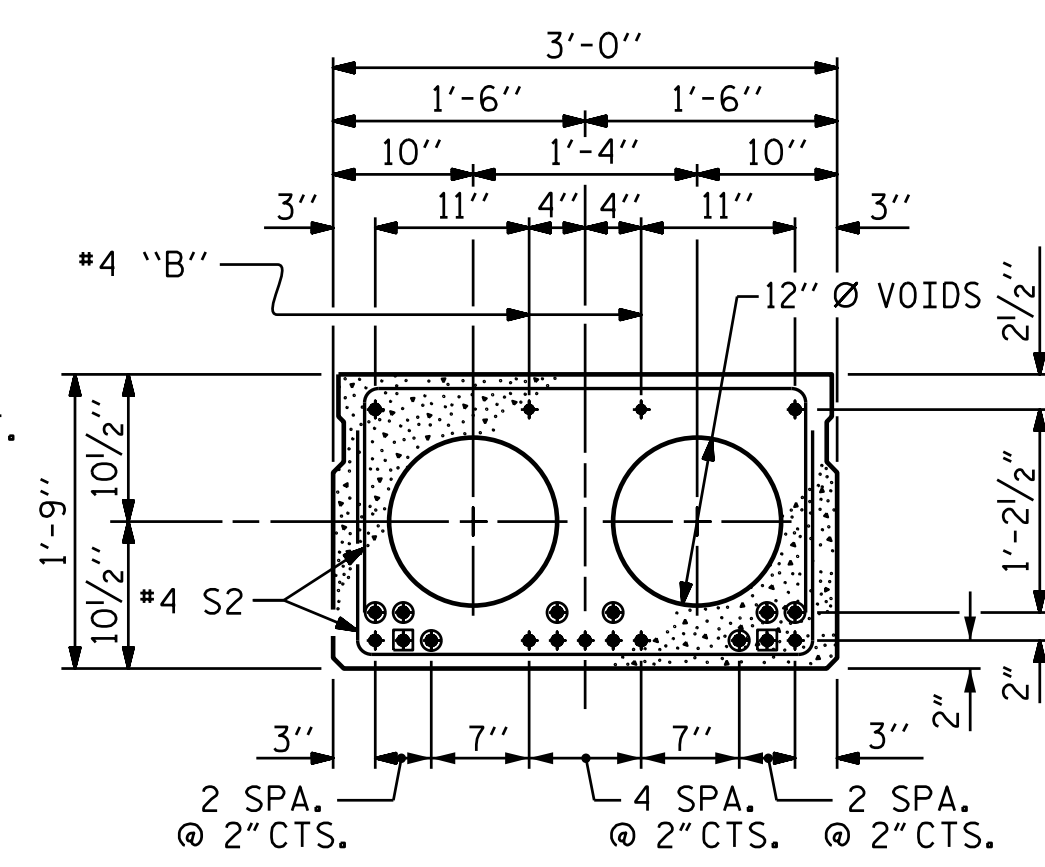

INTERIOR SLAB SECTION (35' UNIT)
 (11 STRANDS REQUIRED)

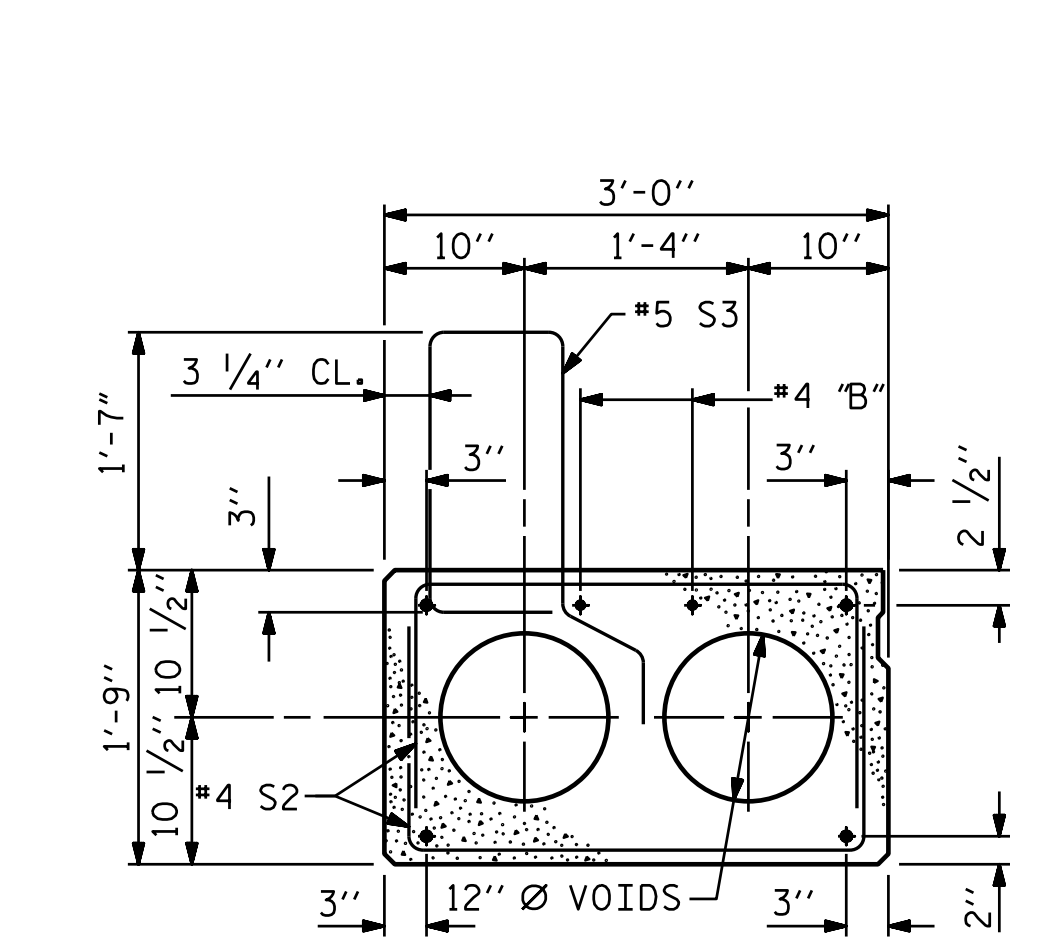

EXT. SLAB SECTION
 (FOR PRESTRESSED STRAND LAYOUT, SEE INTERIOR SLAB SECTION.)

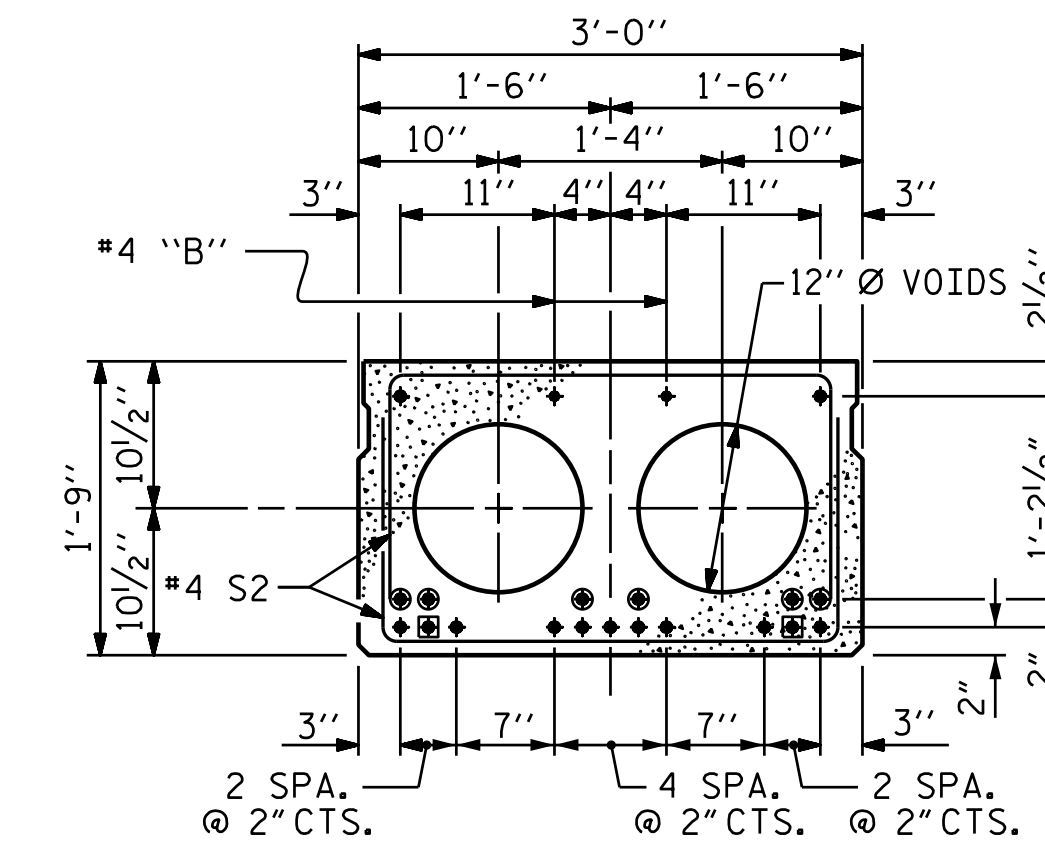


INTERIOR SLAB SECTION (45' UNIT)
 (13 STRANDS REQUIRED)

- BOND SHALL BE BROKEN ON THESE STRANDS FOR A DISTANCE OF 2'-0" FROM END OF CORED SLAB UNIT. SEE STANDARD SPECIFICATIONS, ARTICLE 1078-7.
- OPTIONAL FULL LENGTH DEBONDED STRANDS. THESE STRANDS ARE NOT REQUIRED. IF THE FABRICATOR CHOOSES TO INCLUDE THESE STRANDS IN THE CORED SLAB UNIT, THE STRANDS SHALL BE DEBONDED FOR THE FULL LENGTH OF THE UNIT AT NO ADDITIONAL COST. SEE STANDARD SPECIFICATIONS, ARTICLE 1078-7.


DEBONDING LEGEND

PERMITTED THREADED INSERT CAST IN OUTSIDE FACE OF EXTERIOR UNIT AND RECESSED 3/8" SIZE TO BE DETERMINED BY CONTRACTOR.

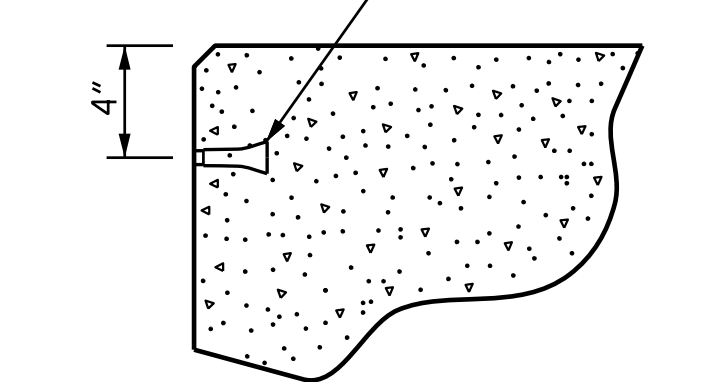


THREADED INSERT DETAIL


0.6" Ø LOW RELAXATION STRAND LAYOUT

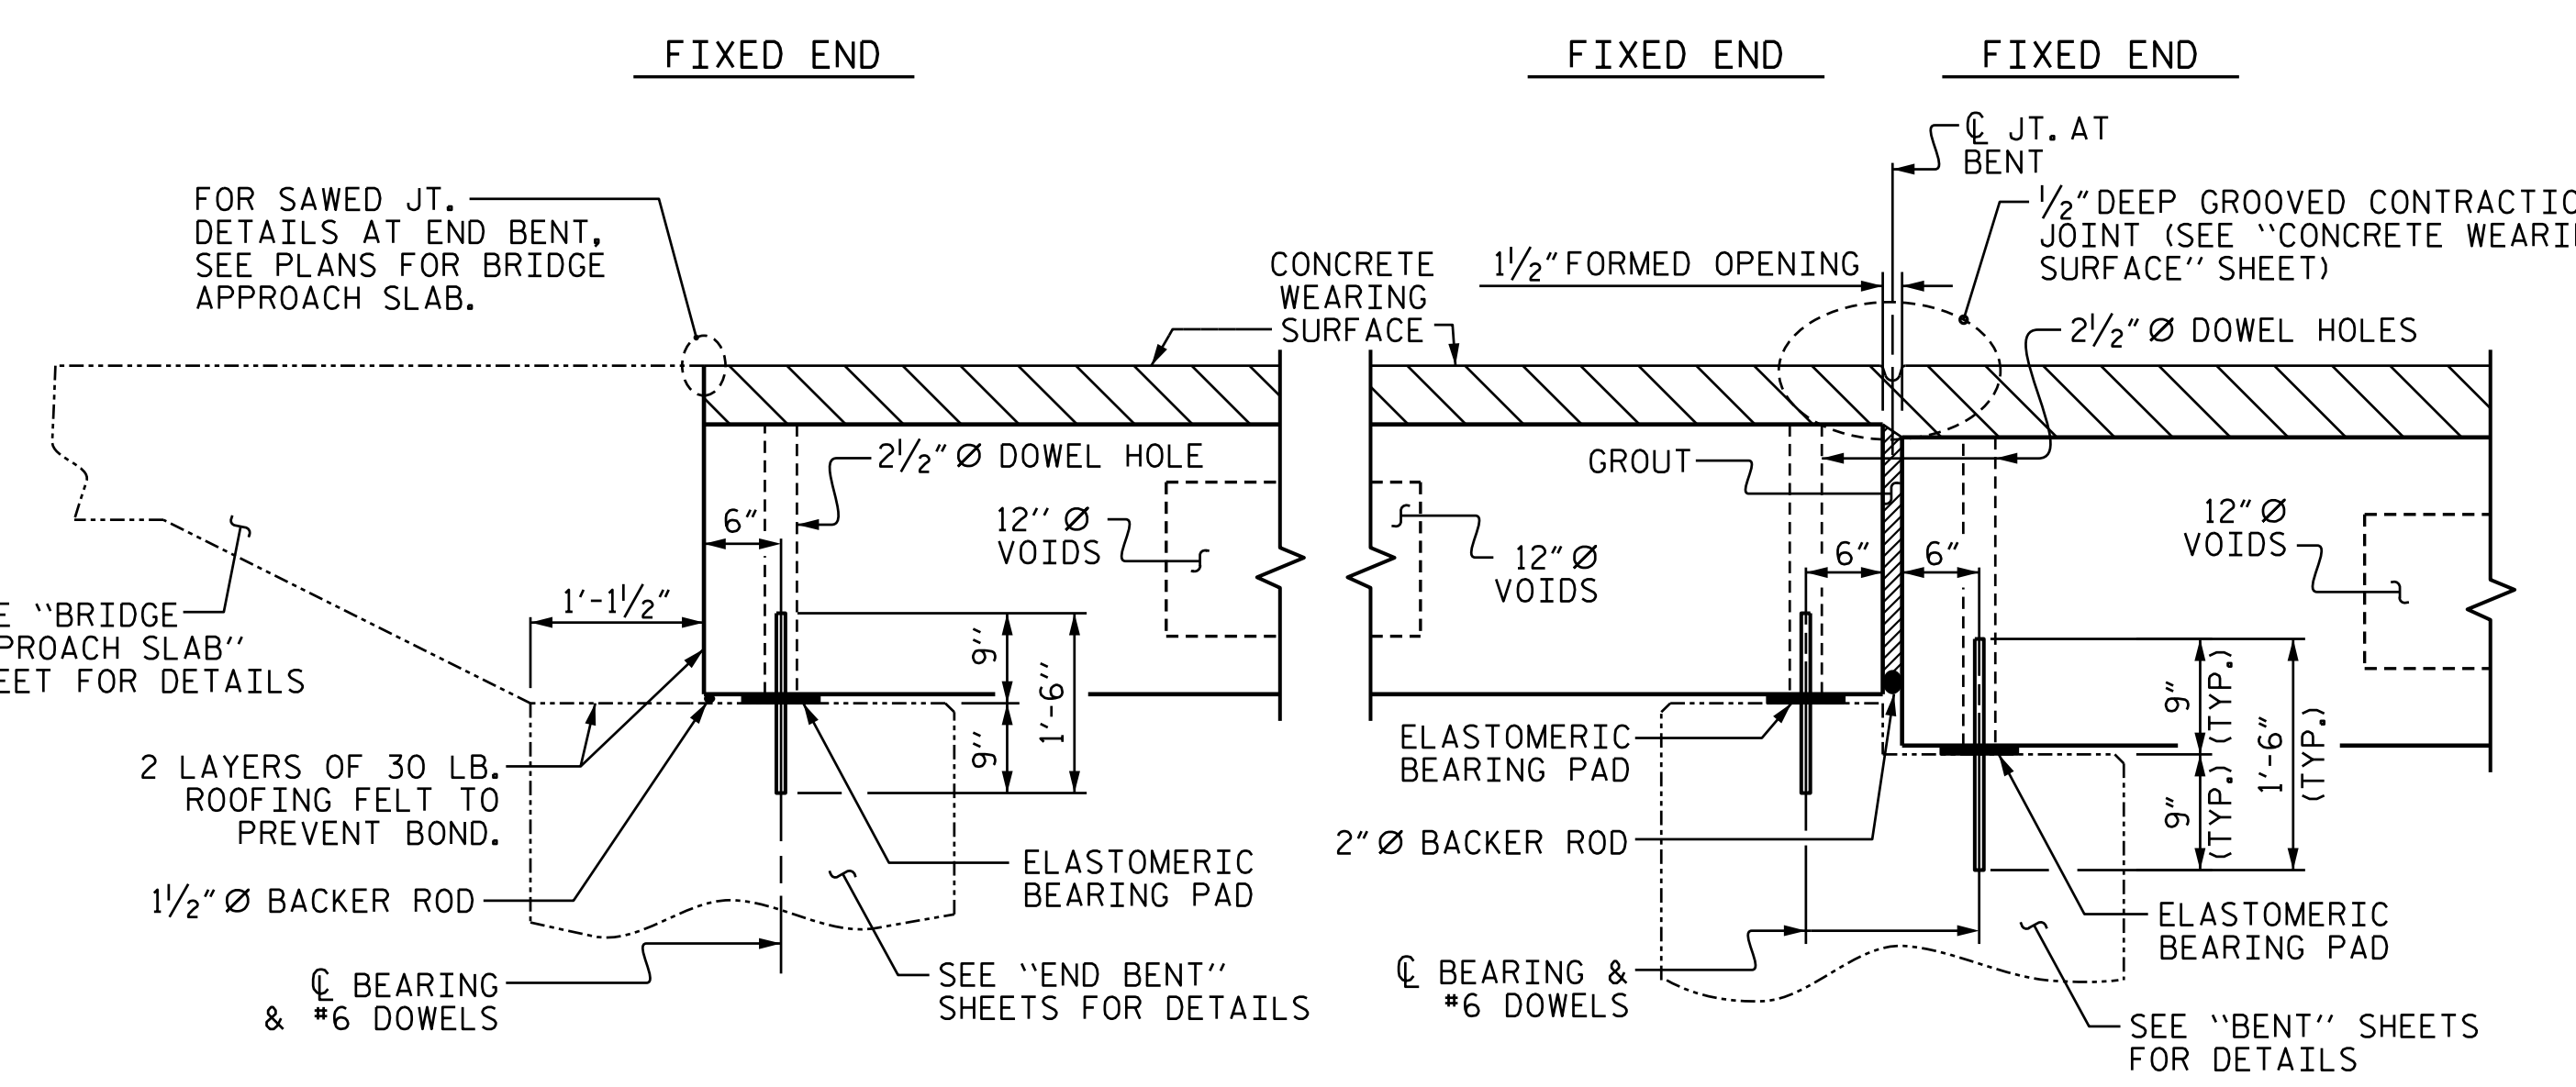

SECTION AT END BENT **SECTION AT BENT NO. 1**
 (BENT NO. 2 SIM.)

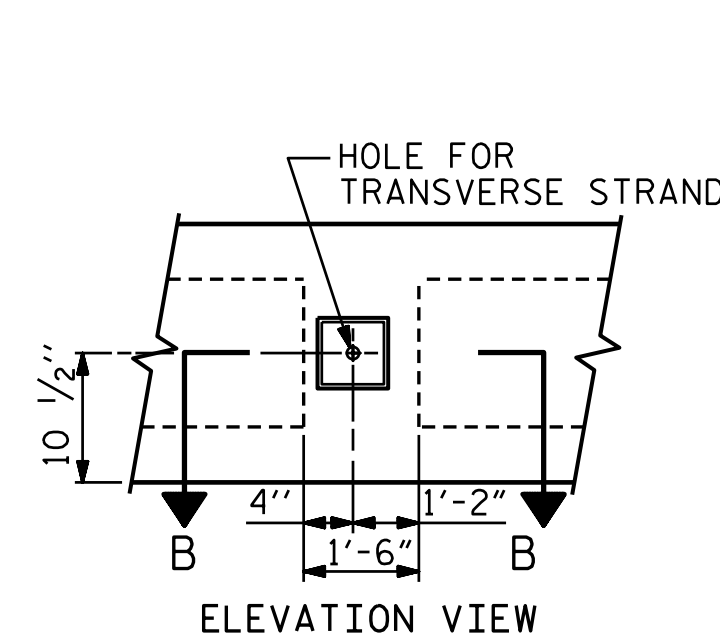


ELEVATION VIEW

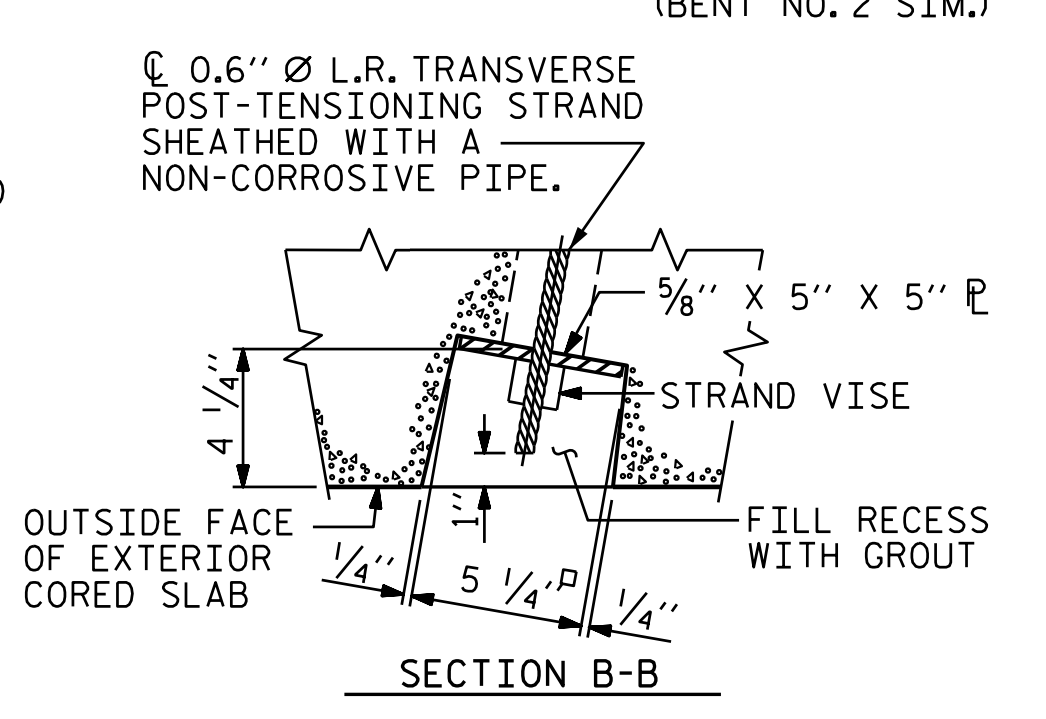


SECTION B-B

GROUTED RECESS AT END OF POST-TENSIONED STRAND-CORED SLABS

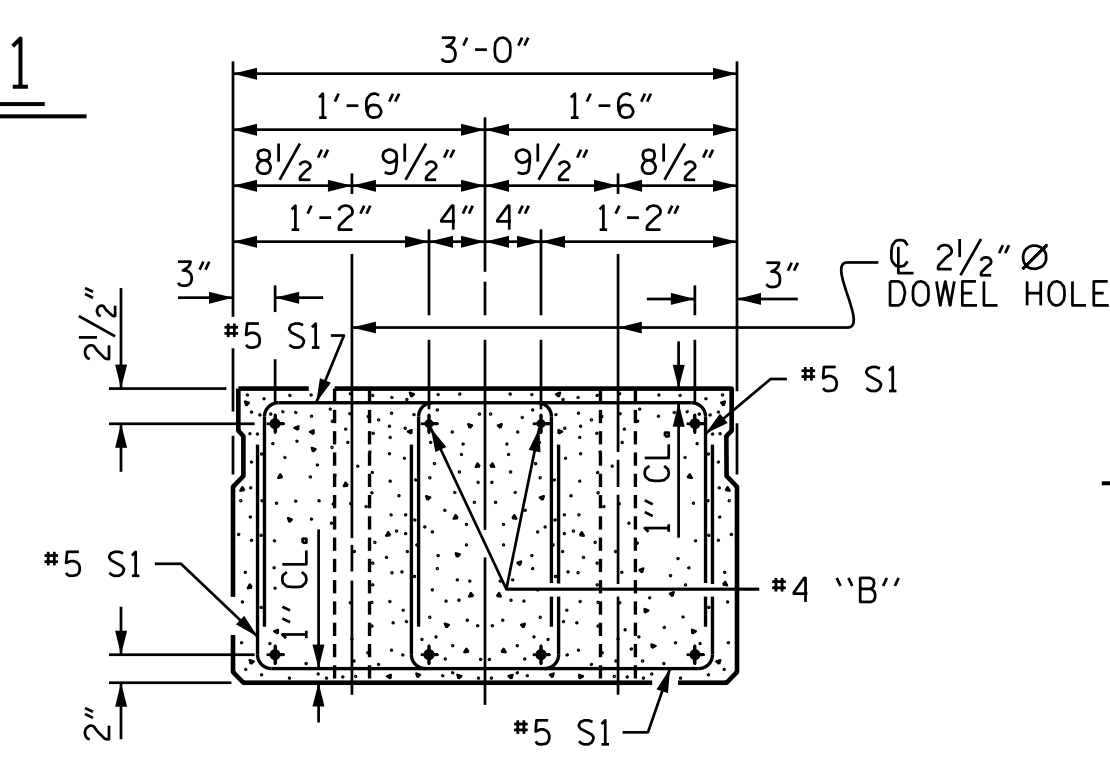


END ELEVATION

SHOWING PLACEMENT OF DOUBLE STIRRUPS AND LOCATION OF DOWEL HOLES. (STRAND LAYOUT NOT SHOWN.) INTERIOR SLAB UNIT SHOWN-EXTERIOR SLAB UNIT SIMILAR EXCEPT SHEAR KEY LOCATION.

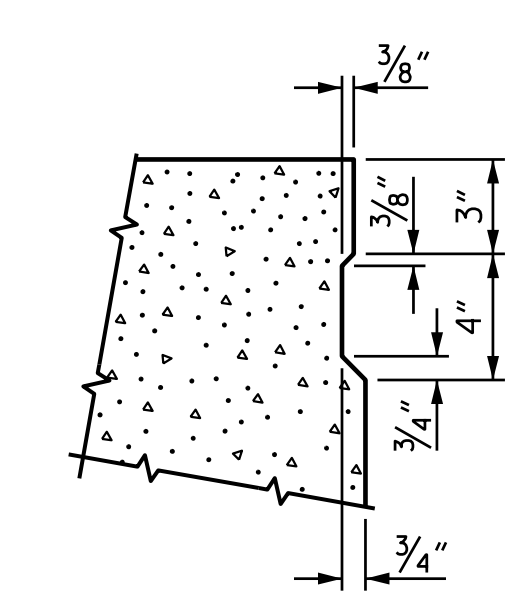

SHEAR KEY DETAIL
 NOTE: OMIT SHEAR KEY ON OUTSIDE FACE OF EXTERIOR CORED SLABS.

DOCUMENT NOT CONSIDERED FINAL UNLESS ALL SIGNATURES COMPLETED
 PLANS PREPARED BY:
M MOTT MACDONALD
 PO Box 700
 Fuquay-Varina, NC 27526
 (919) 552-2253
 www.mottmac.com
 LICENSE NO. F-0669

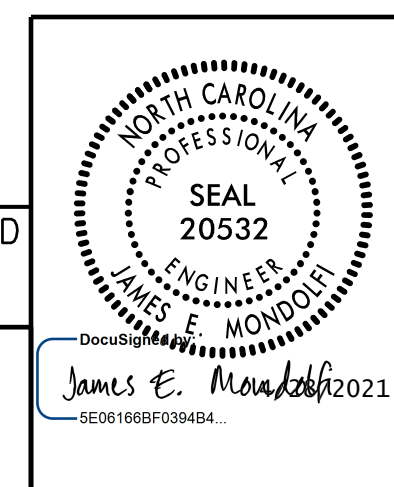


PROJECT NO. 17BP.7.R.127
 GUILFORD COUNTY
 STATION: 15+33.00 -L-

SHEET 1 OF 6

STATE OF NORTH CAROLINA DEPARTMENT OF TRANSPORTATION RALEIGH					
SUPERSTRUCTURE					
3'-0" X 1'-9" PRESTRESSED CONCRETE CORED SLAB UNIT					
REVISIONS					
NO.	BY:	DATE:	NO.	BY:	DATE:
1			3		
2			4		
SHEET NO.					S-7
TOTAL SHEETS					30


157077
 W:\157077\Drawings\17BP.7.R.127-SMU-CS-400067.dgn
 4/27/2021 12:10:22 PM

DRAWN BY: J. T. WILLIAMS DATE: 1-2021
 CHECKED BY: J. E. MONDOLFI DATE: 2-2021
 DESIGN ENGINEER OF RECORD: J. E. MONDOLFI DATE: 2-2021

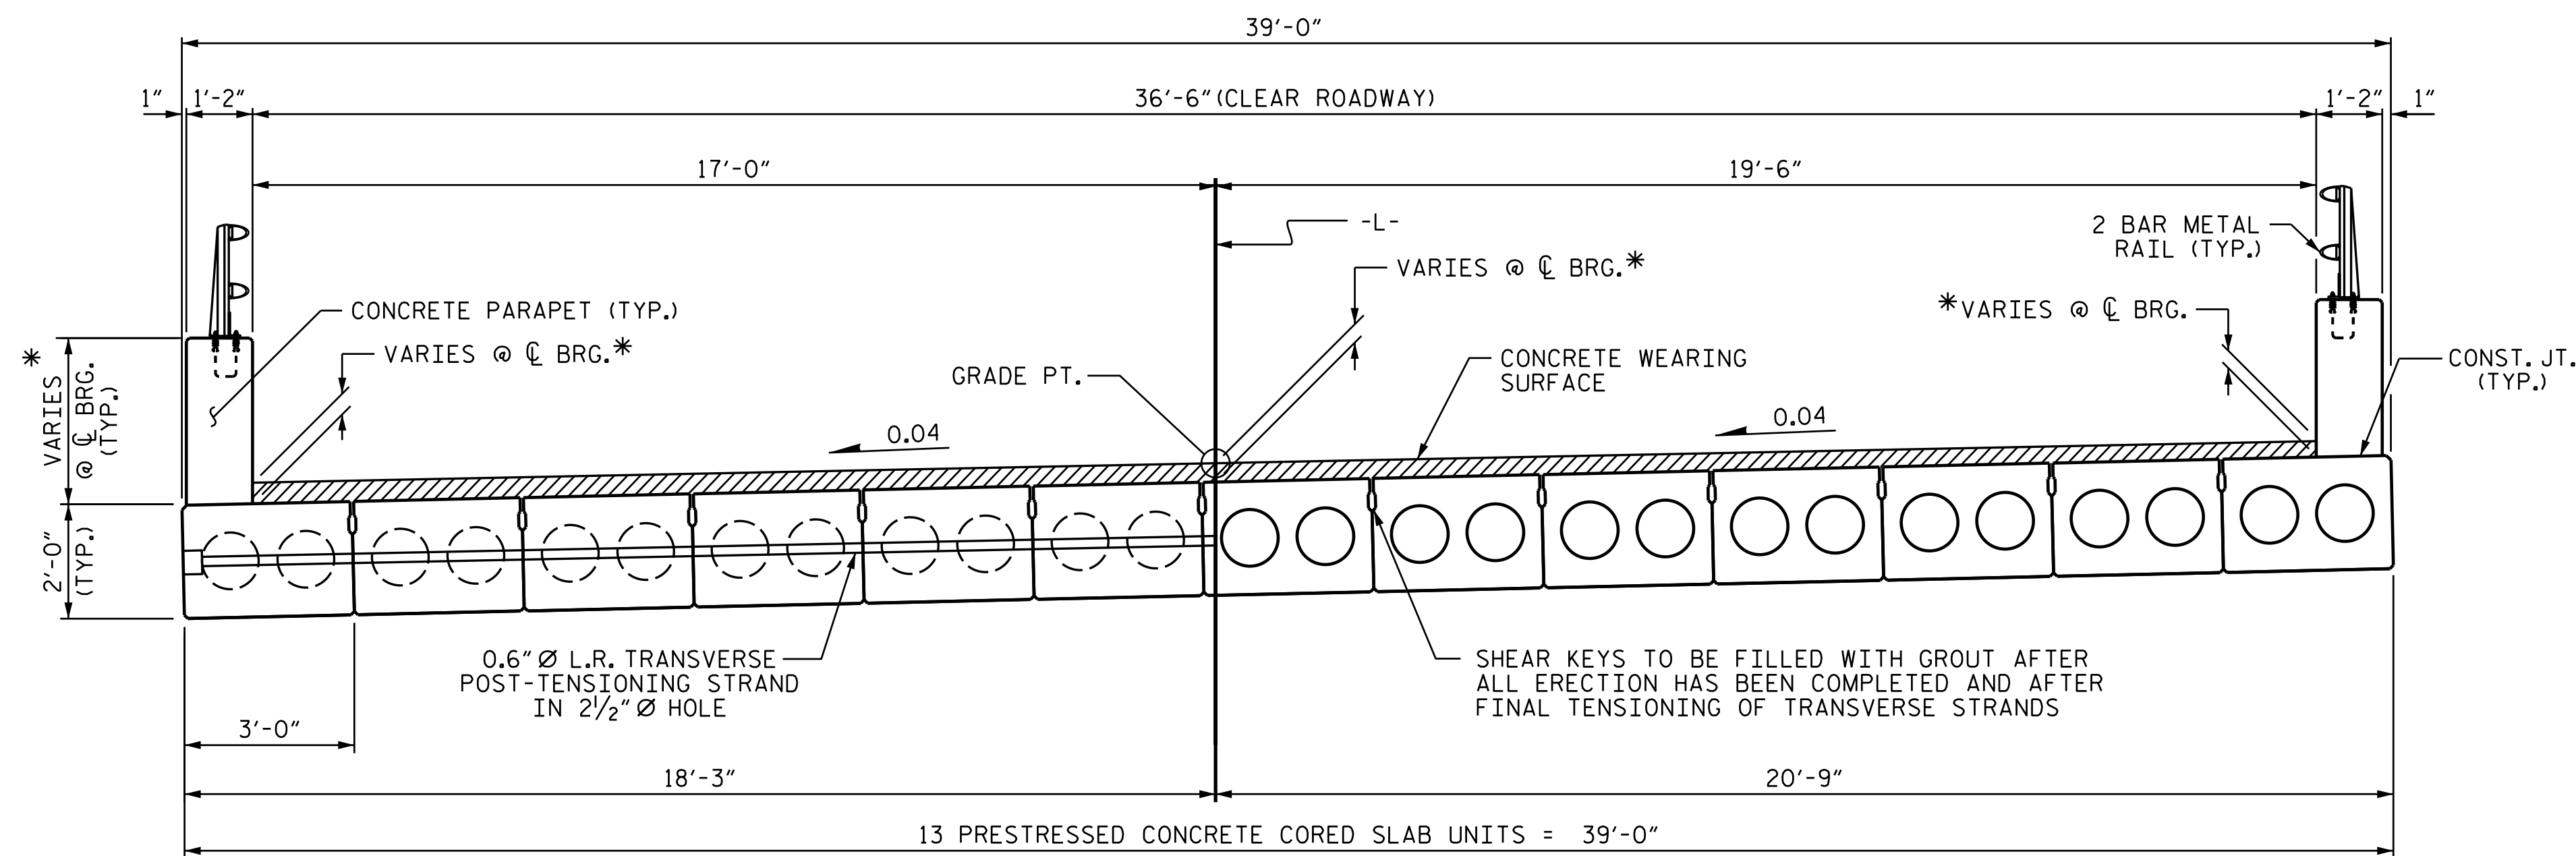


HALF SECTION AT INTERMEDIATE DIAPHRAGMS HALF SECTION THROUGH VOIDS
TYPICAL SECTION - SPAN B


* - THE HEIGHT OF THE PARAPET AND CONCRETE WEARING SURFACE THICKNESS VARIES WHILE THE TOP OF THE PARAPET FOLLOWS THE PROFILE OF THE GUTTERLINE. FOR PARAPET HEIGHT DETAILS AND CONCRETE WEARING SURFACE THICKNESS, SEE THE "CONCRETE PARAPET AND END POST DETAILS" AND "CONCRETE WEARING SURFACE DETAILS" SHEETS.

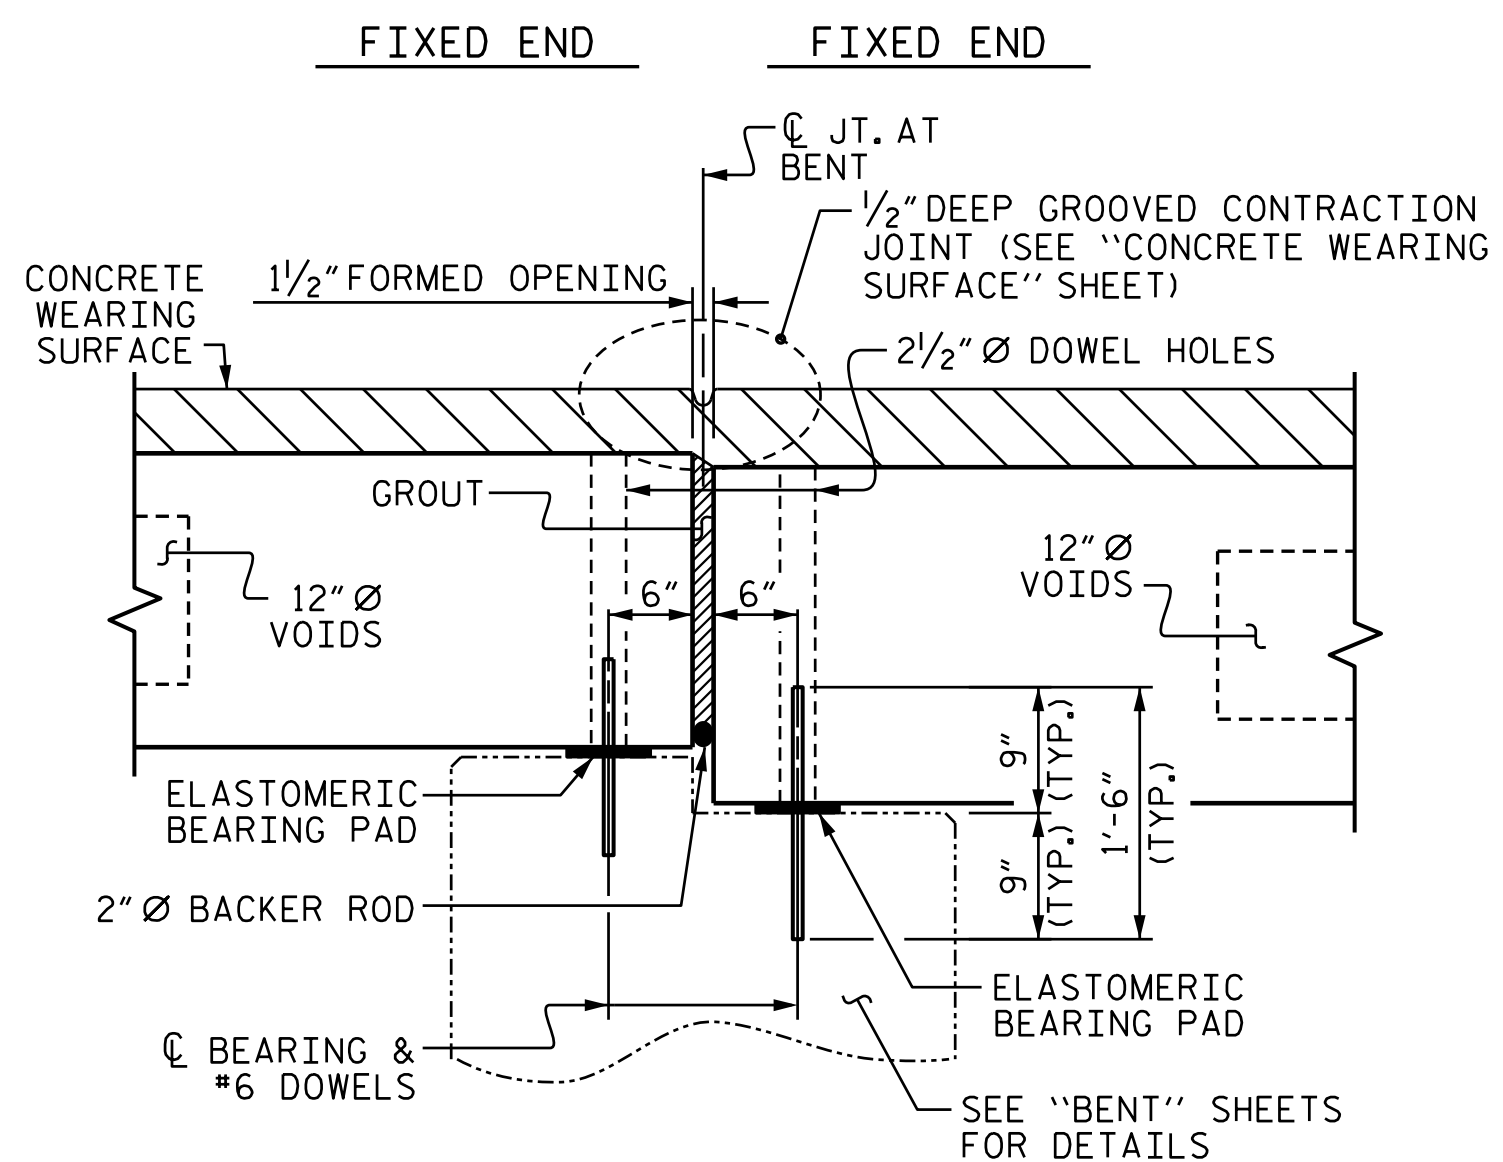


SECTION AT BENT NO. 1
 (BENT NO. 2 SIM.)

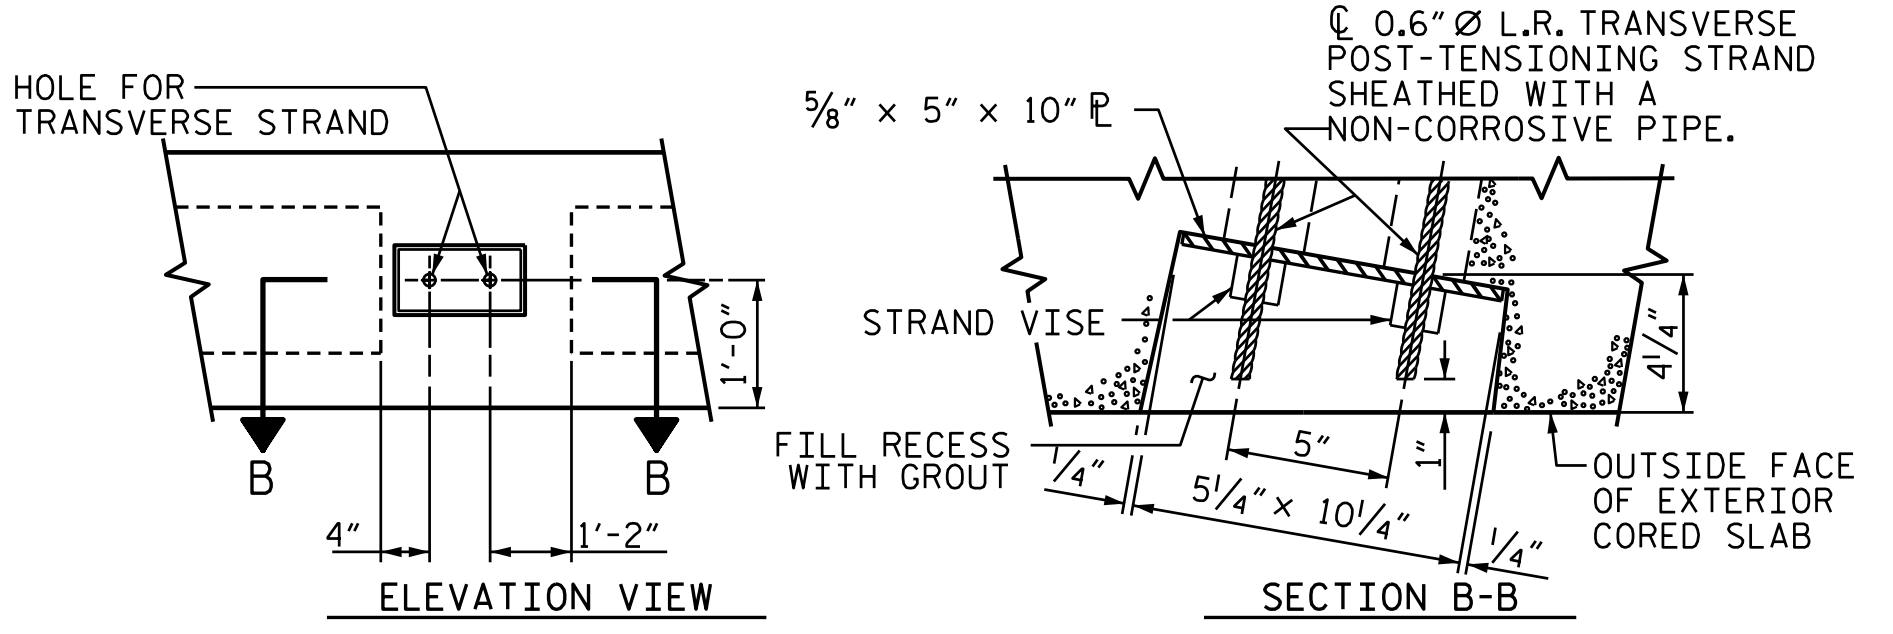


GRAUTED RECESS AT END OF POST-TENSIONED STRAND-CORED SLABS

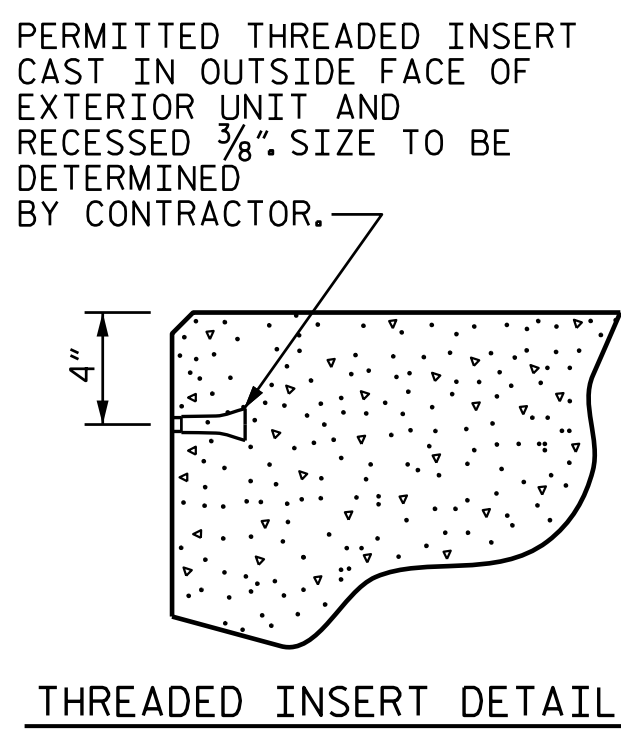

THREADED INSERT DETAIL

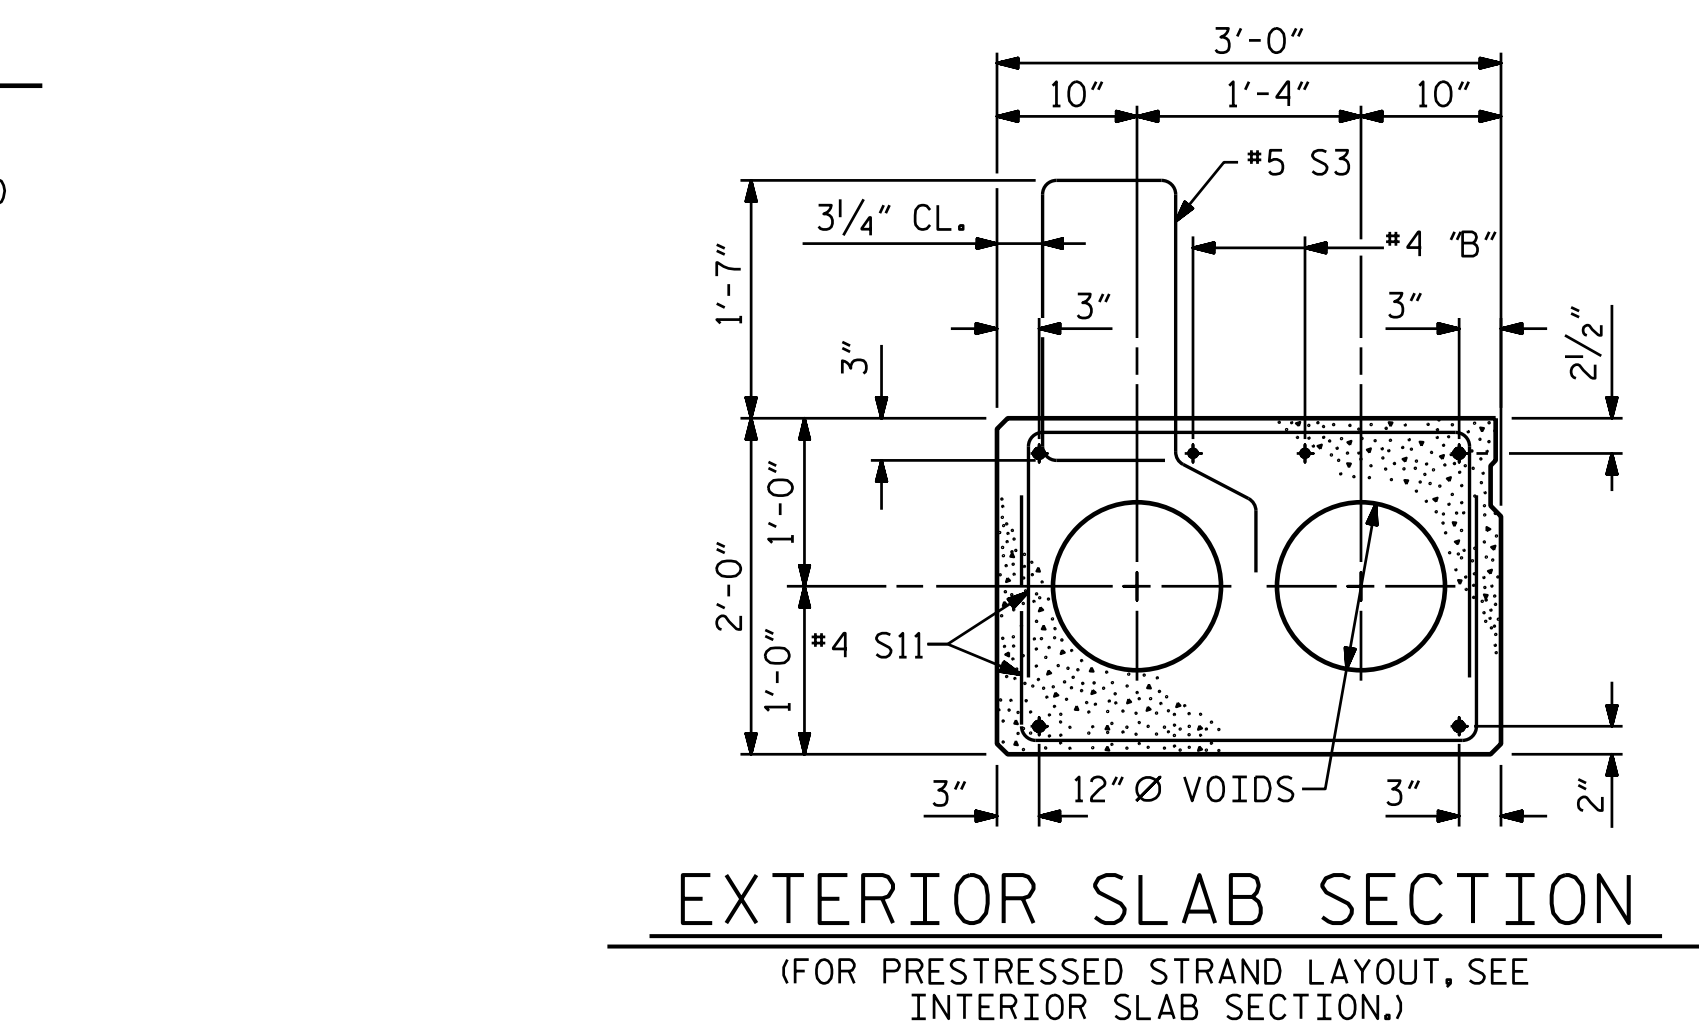


EXTERIOR SLAB SECTION
 (FOR PRESTRESSED STRAND LAYOUT, SEE INTERIOR SLAB SECTION.)

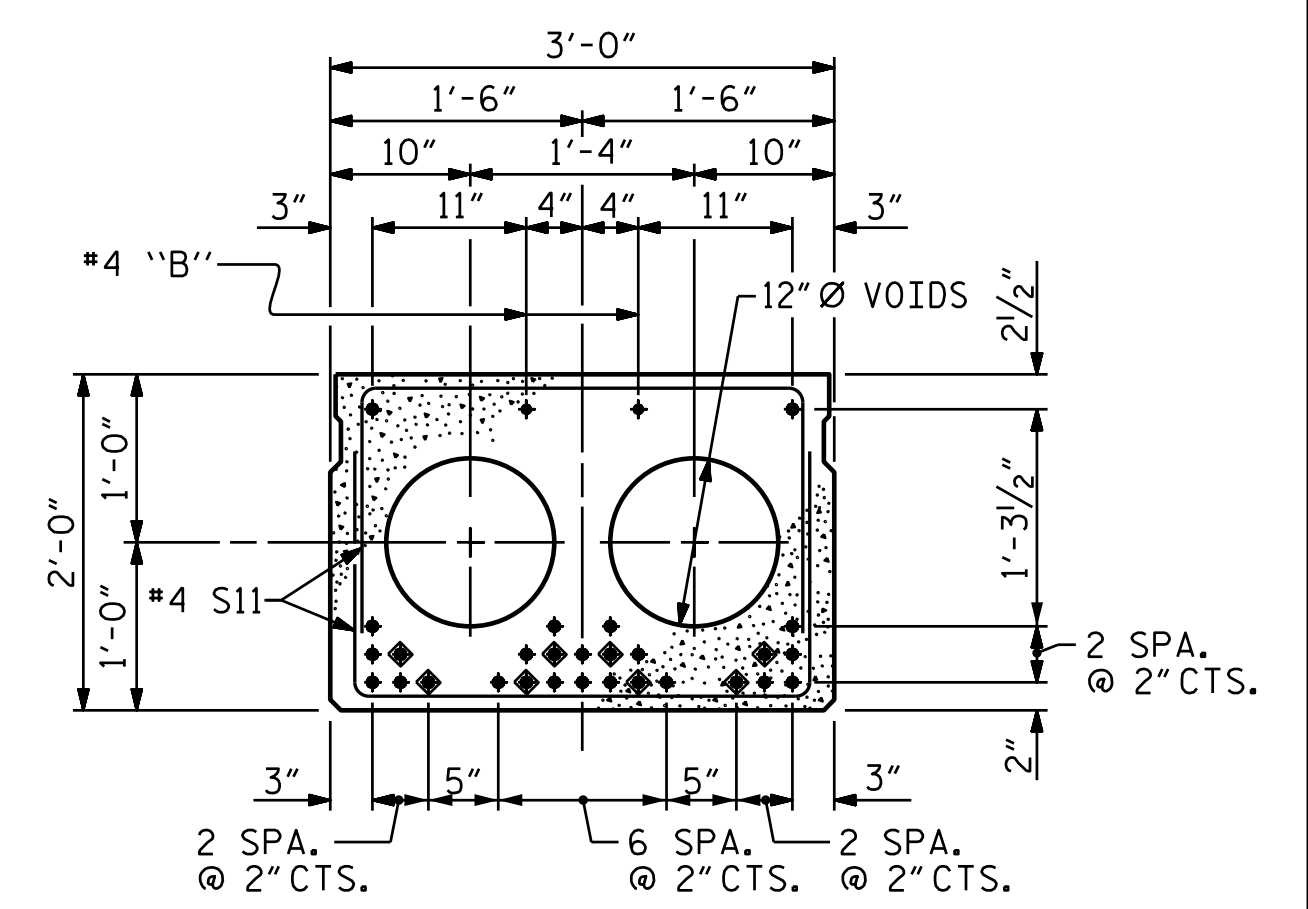


INTERIOR SLAB SECTION (70' UNIT)
 (28 STRANDS REQUIRED)
0.6" Ø LOW RELAXATION STRAND LAYOUT

◆ BOND SHALL BE BROKEN ON THESE STRANDS FOR A DISTANCE OF 12'-0" FROM END OF CORED SLAB UNIT. SEE STANDARD SPECIFICATIONS, ARTICLE 1078-7.
DEBONDING LEGEND

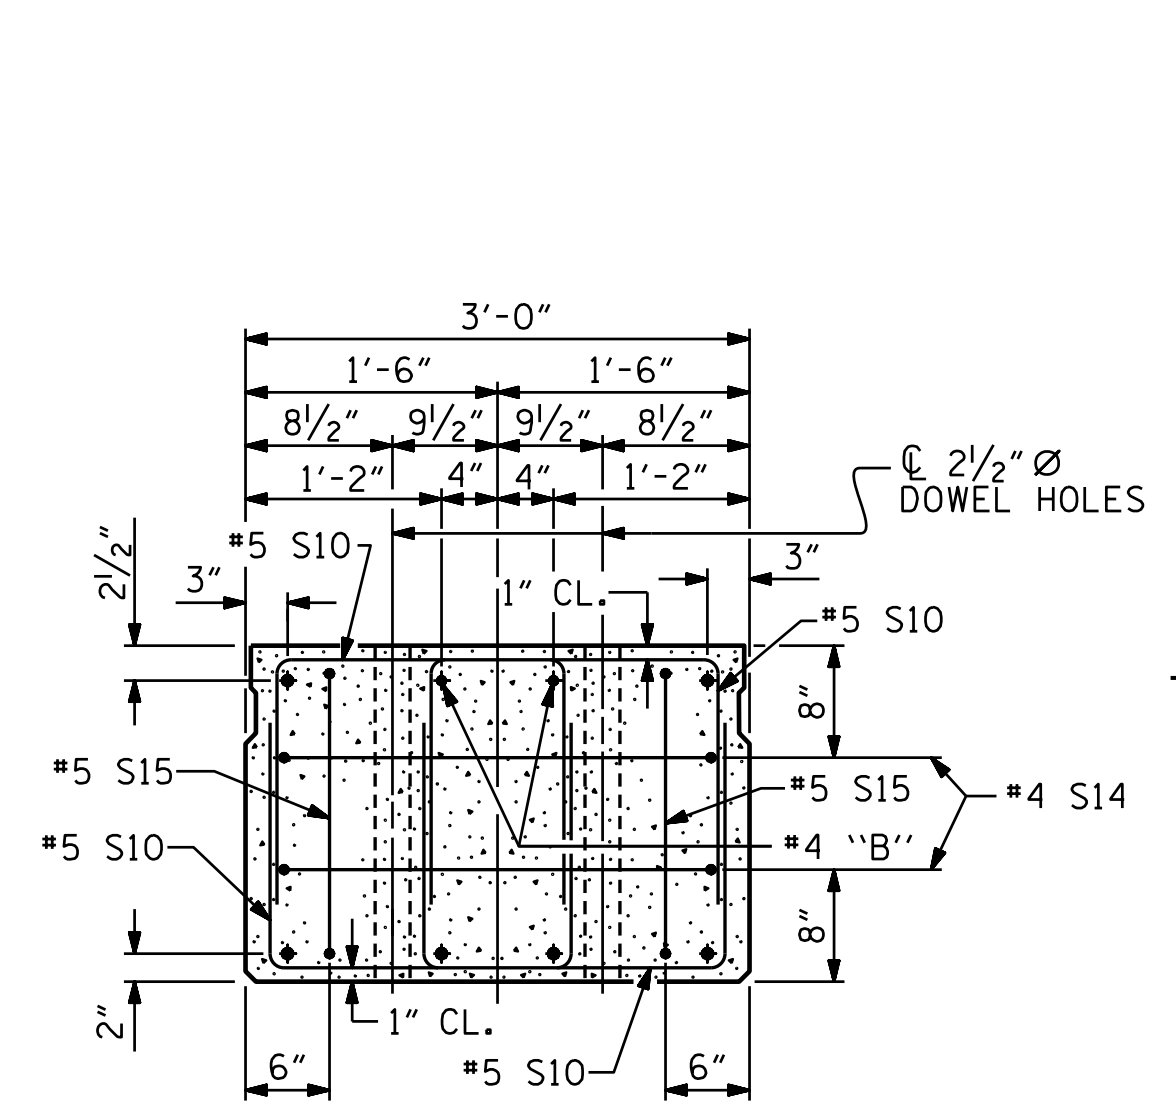

END ELEVATION
 SHOWING PLACEMENT OF DOUBLE STIRRUPS AND LOCATION OF DOWEL HOLES. (STRAND LAYOUT NOT SHOWN.)
 INTERIOR SLAB UNIT SHOWN-EXTERIOR SLAB UNIT SIMILAR EXCEPT SHEAR KEY LOCATION.

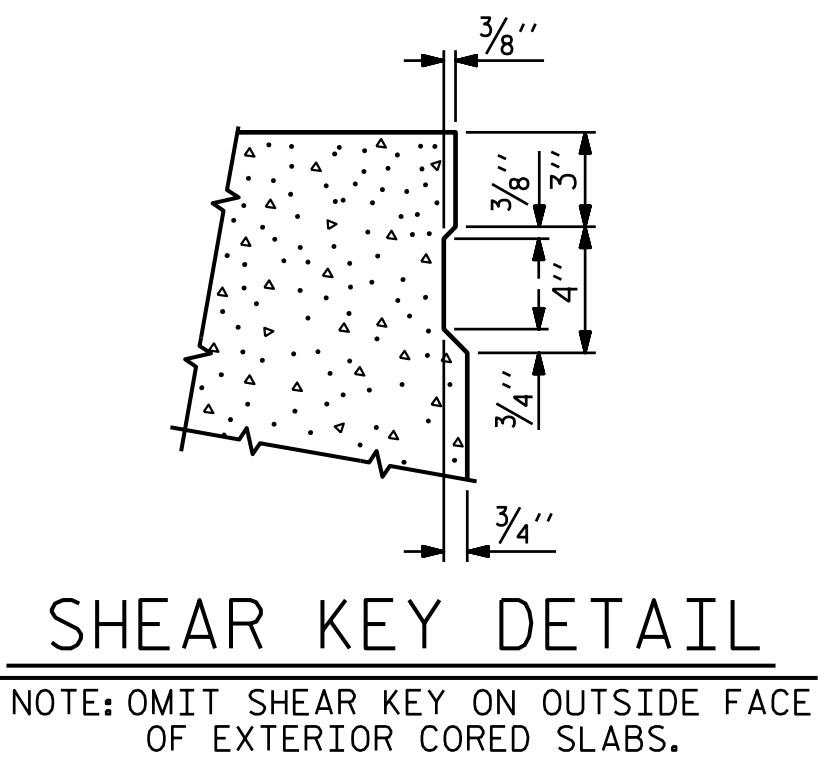


SHEAR KEY DETAIL
 NOTE: OMIT SHEAR KEY ON OUTSIDE FACE OF EXTERIOR CORED SLABS.

PROJECT NO. 17BP.7.R.127
 GUILFORD COUNTY
 STATION: 15+33.00 -L-

SHEET 2 OF 6

STATE OF NORTH CAROLINA
 DEPARTMENT OF TRANSPORTATION
 RALEIGH
 SUPERSTRUCTURE
 3'-0" X 2'-0"
 PRESTRESSED CONCRETE
 CORED SLAB UNIT


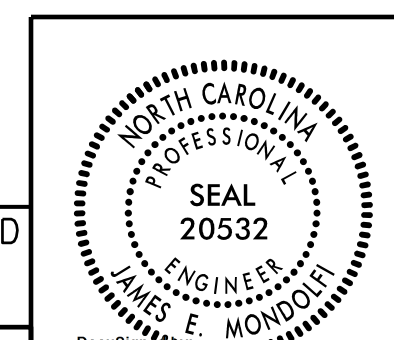


DOCUMENT NOT CONSIDERED FINAL UNLESS ALL SIGNATURES COMPLETED
 PLANS PREPARED BY:
M MOTT MACDONALD
 PO Box 700 Fuquay-Varina, NC 27526
 (919) 552-2253
 www.mottmac.com
 LICENSE NO. F-0669

REVISIONS						SHEET NO.
NO.	BY:	DATE:	NO.	BY:	DATE:	S-8
1			3			TOTAL SHEETS
2			4			30

157077
 \\s:\projects\17BP.7.R.127-SMU.LS-400067.dgn
 4/27/2021 12:10:22 PM

DRAWN BY: J. T. WILLIAMS DATE: 1-2021
 CHECKED BY: J. E. MONDOLFI DATE: 2-2021
 DESIGN ENGINEER OF RECORD: J. E. MONDOLFI DATE: 2-2021

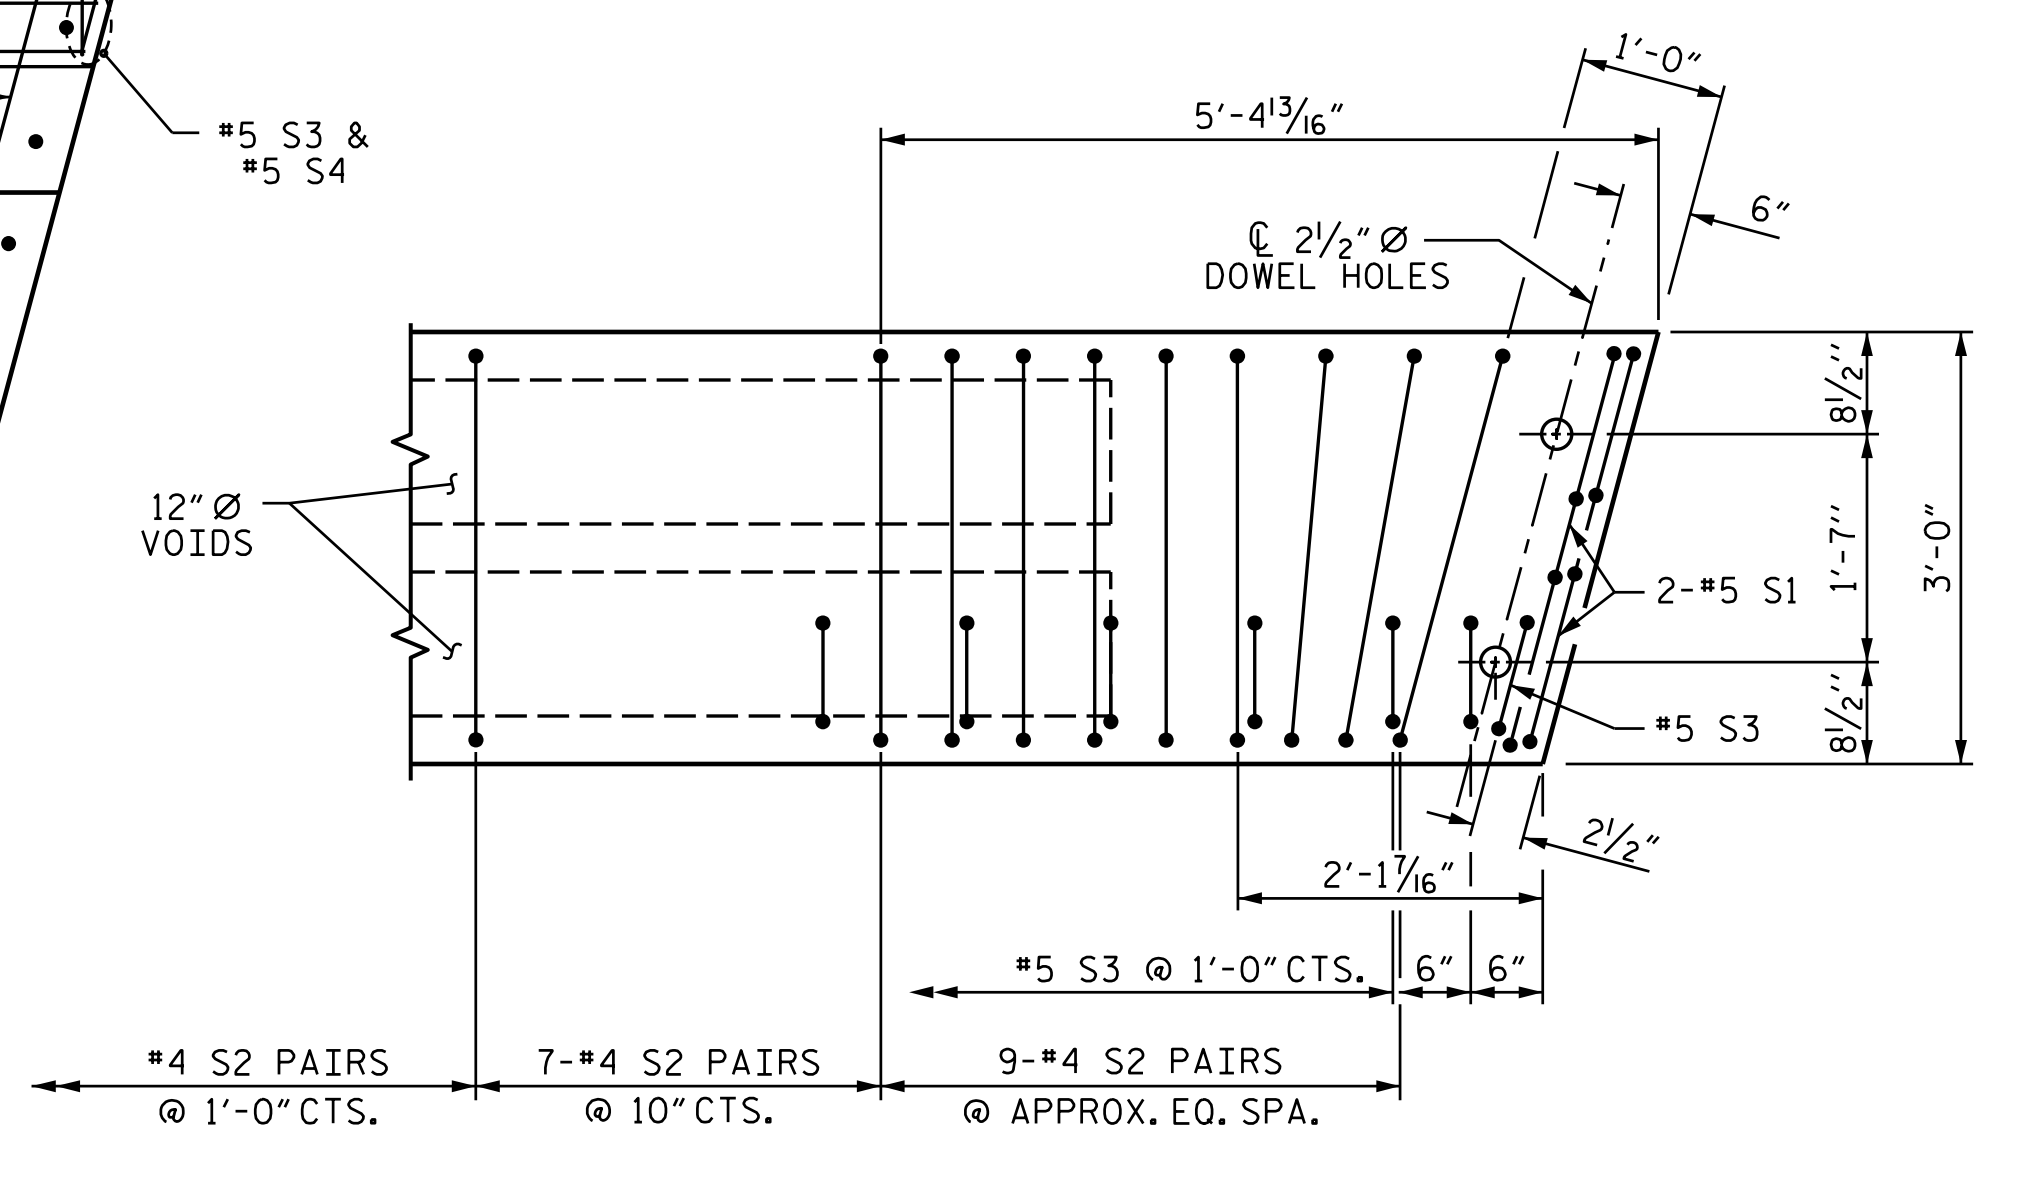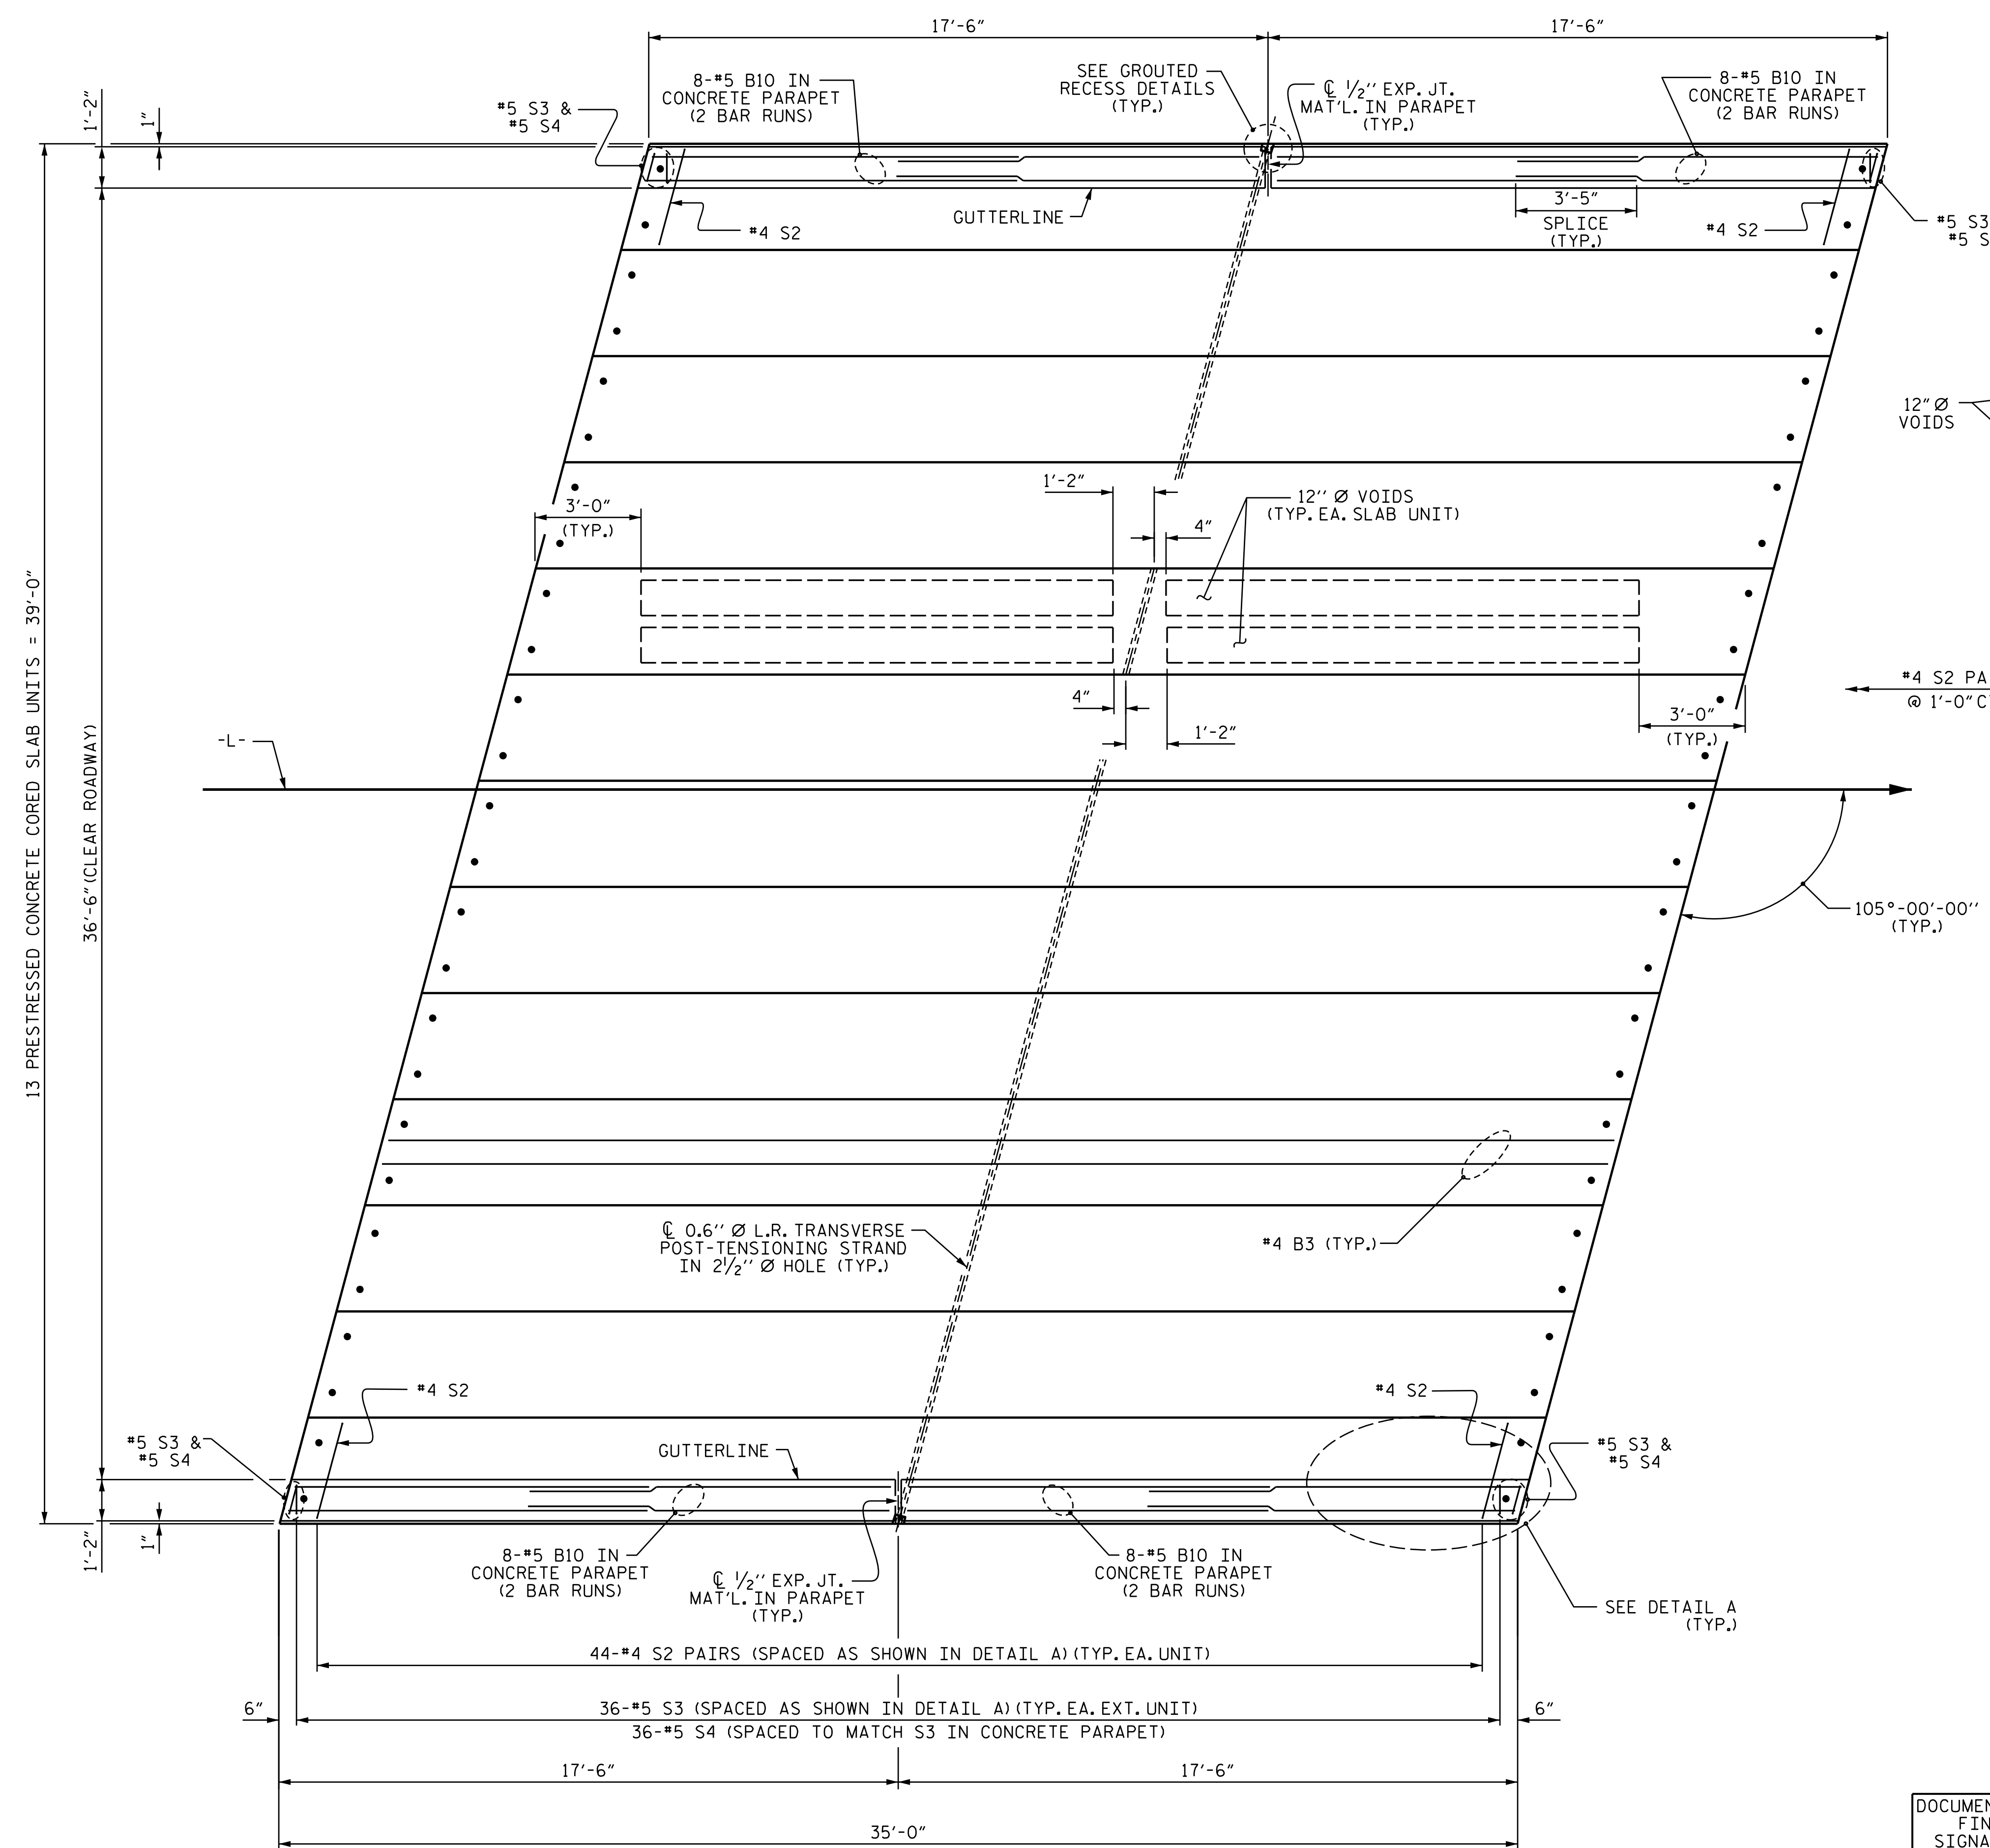


DETAIL A
 (SIMILAR EACH END OF UNIT)
 NOTE: EXTERIOR UNIT SHOWN - INTERIOR UNIT SIMILAR EXCEPT OMIT #5 S3 BARS.

PROJECT NO. 17BP.7.R.127
 GUILFORD COUNTY
 STATION: 15+33.00 -L-

SHEET 3 OF 6

STATE OF NORTH CAROLINA
 DEPARTMENT OF TRANSPORTATION
 RALEIGH

SUPERSTRUCTURE
 PLAN OF SPAN A
 35' UNIT
 36'-6" CLEAR ROADWAY
 105° SKEW

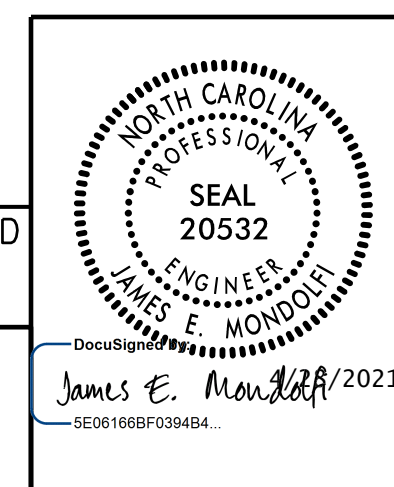

DOCUMENT NOT CONSIDERED
 FINAL UNLESS ALL
 SIGNATURES COMPLETED

PLANS PREPARED BY:
M MOTT MACDONALD
 PO Box 700
 Fuquay-Varina, NC 27526
 (919) 552-2253
 www.mottmac.com
 LICENSE NO. F-0669


REVISIONS				SHEET NO.
NO.	BY:	DATE:	NO.	DATE:
1			3	
2			4	

TOTAL SHEETS: 30


PLAN OF UNIT

DRAWN BY: J. T. WILLIAMS DATE: 1-2021
 CHECKED BY: J. E. MONDOLFI DATE: 2-2021
 DESIGN ENGINEER OF RECORD: J. E. MONDOLFI DATE: 2-2021

W:\157077\Drawings\17BP.7.R.127-SMU.LS-400067.dgn
 12/10/23 PM 4:27:2021

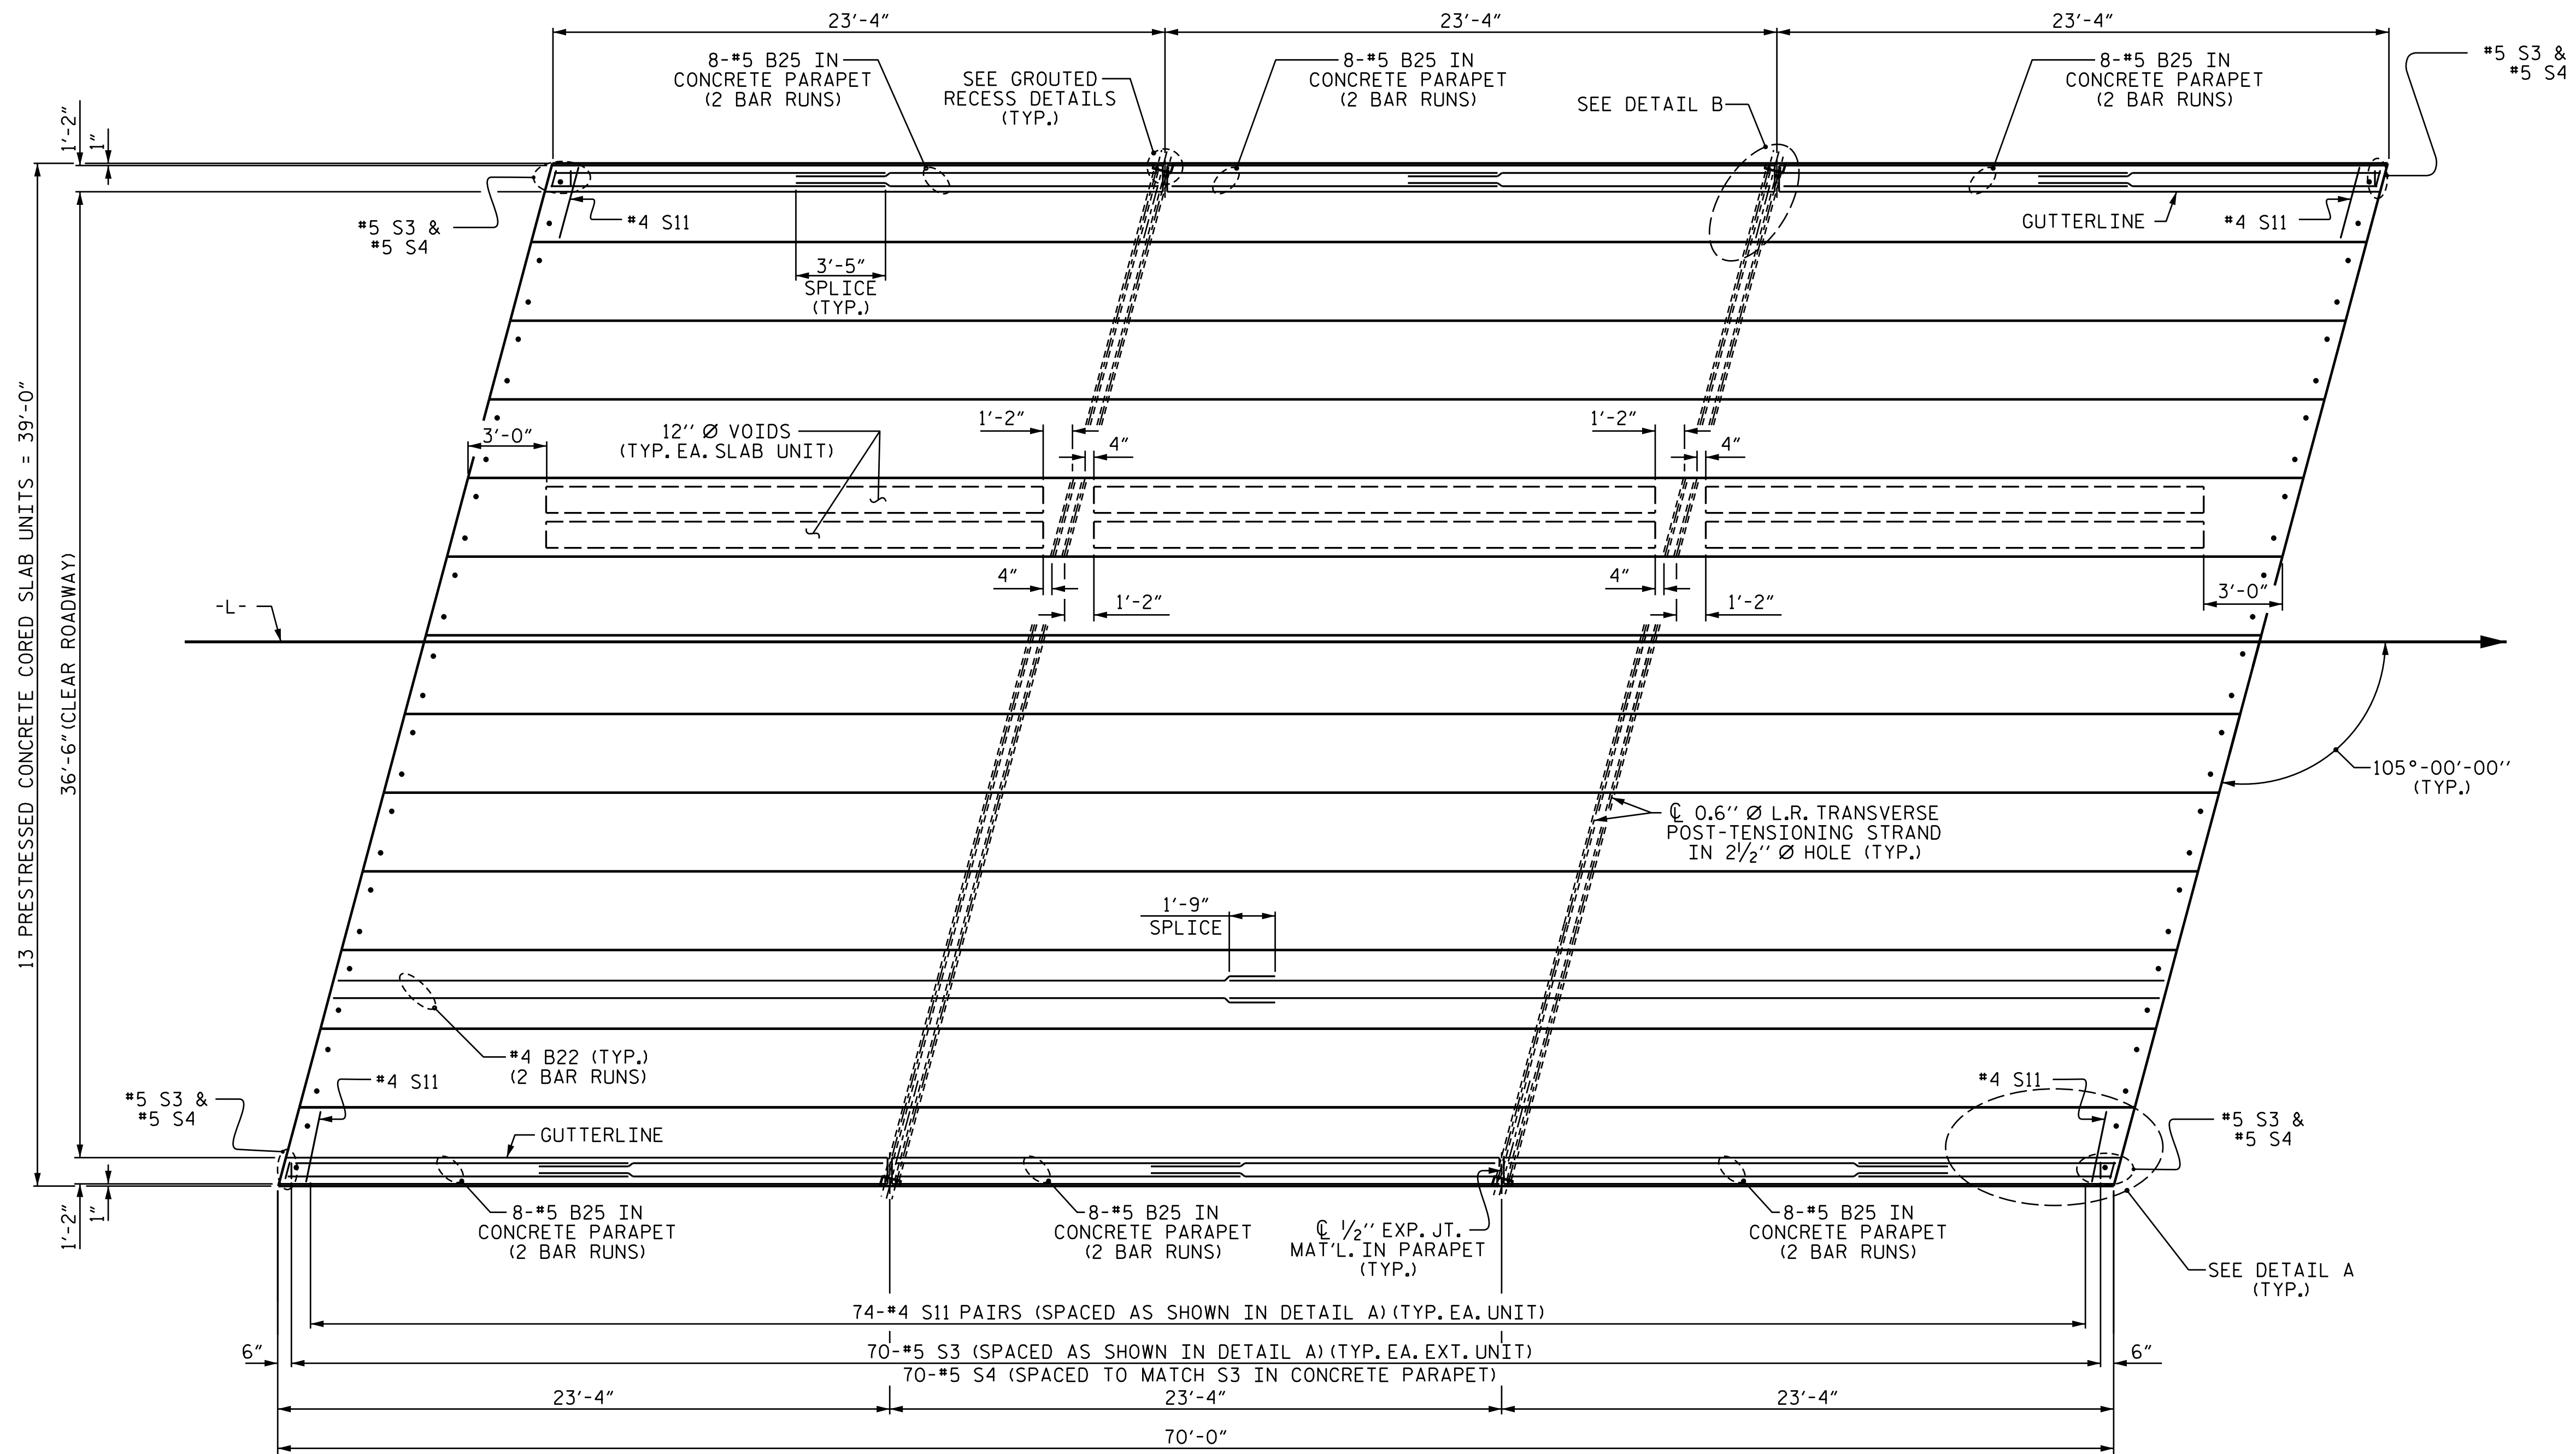


PLAN OF UNIT

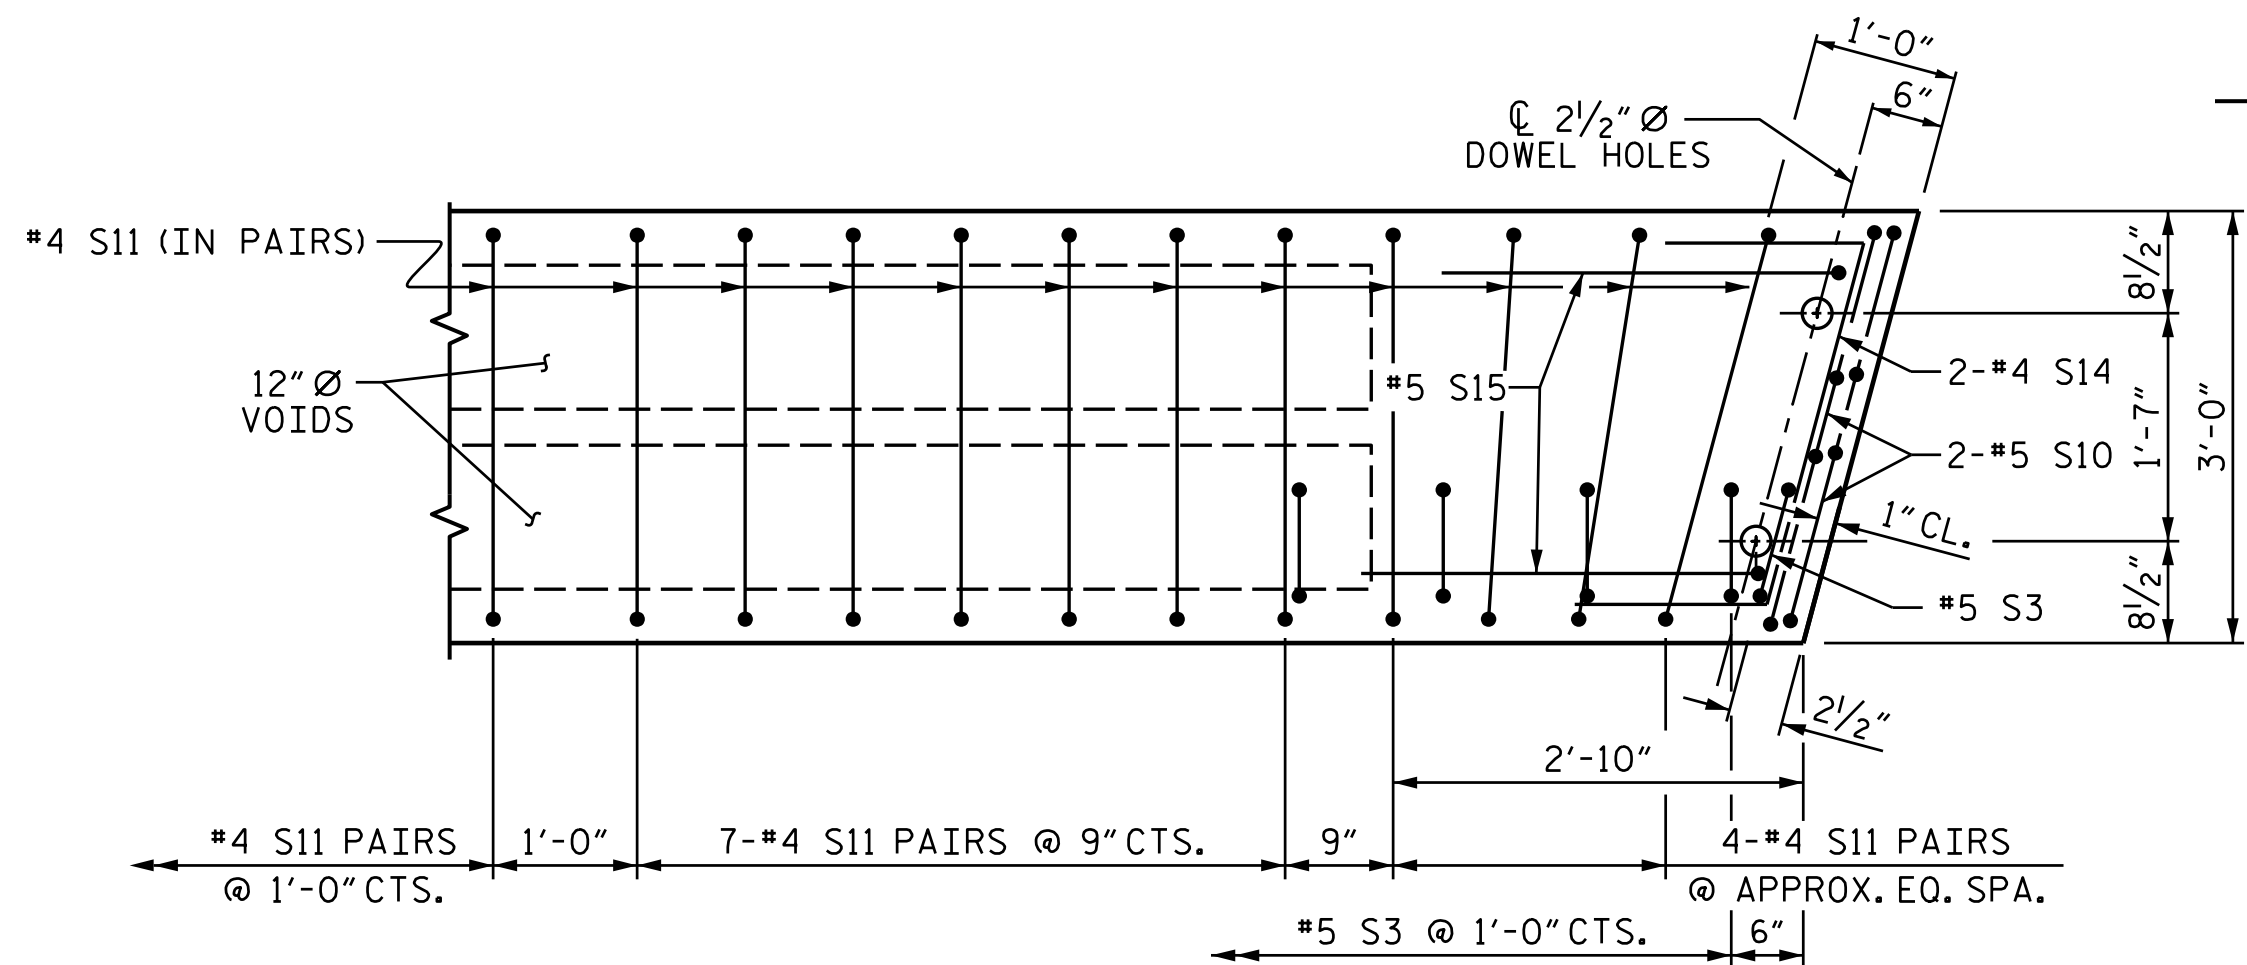

DETAIL A

(SIMILAR EACH END OF UNIT)
NOTE: EXTERIOR UNIT SHOWN - INTERIOR UNIT SIMILAR EXCEPT OMIT #5 S3 BARS.

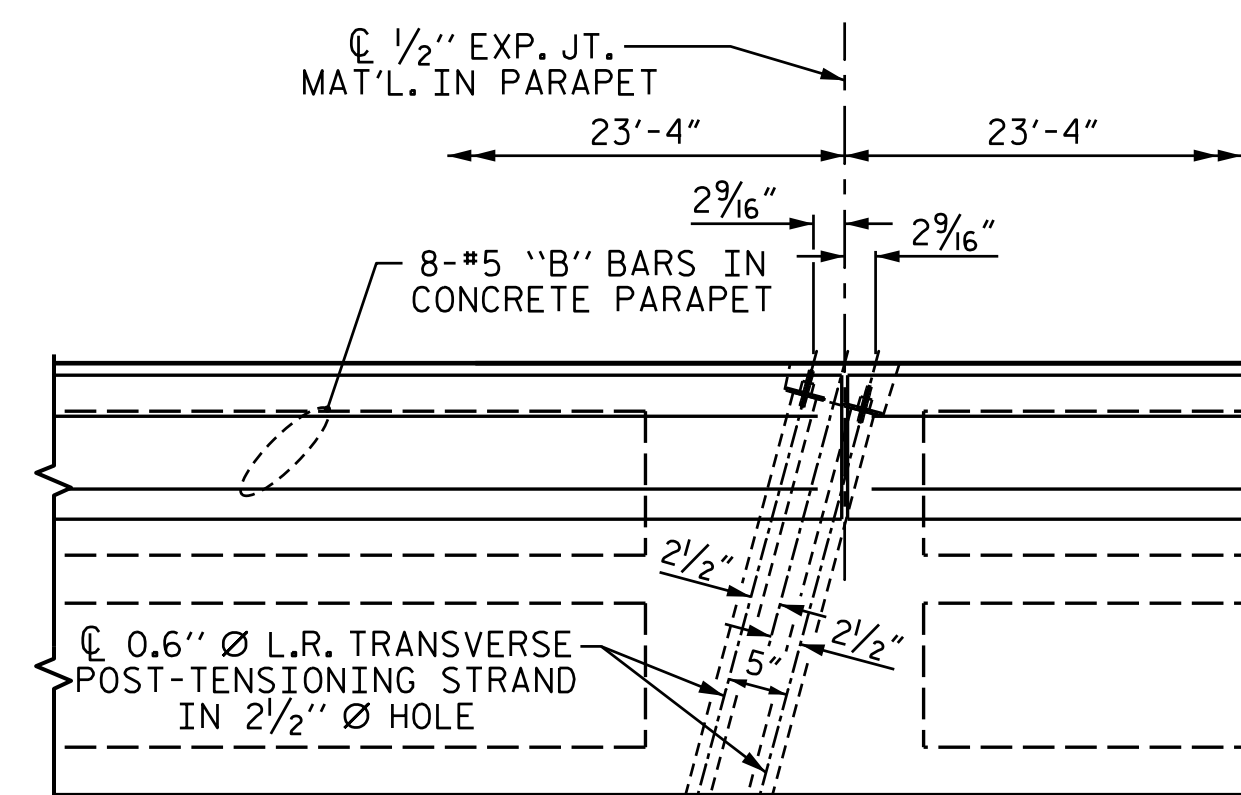


DETAIL B

#4 S11 BARS MAY BE SHIFTED AS NECESSARY TO MAINTAIN 1" CLEAR TO GROUDED RECESS AND 2 1/2" TRANSVERSE POST-TENSIONING STRAND HOLES

PROJECT NO. 17BP.7.R.127
GUILFORD COUNTY
STATION: 15+33.00 -L-

SHEET 4 OF 6

STATE OF NORTH CAROLINA
DEPARTMENT OF TRANSPORTATION
RALEIGH
SUPERSTRUCTURE
PLAN OF SPAN B
70' UNIT
36'-6" CLEAR ROADWAY
105° SKEW

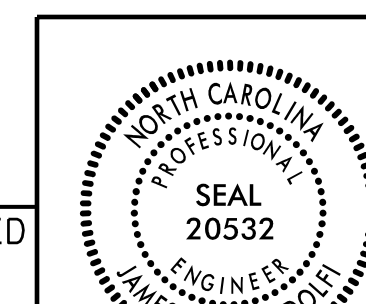

DOCUMENT NOT CONSIDERED FINAL UNLESS ALL SIGNATURES COMPLETED



PLANS PREPARED BY:
MOTT MACDONALD
PO Box 700
Fuquay-Varina, NC 27526
(919) 552-2253
www.mottmac.com
LICENSE NO. F-0669

REVISIONS				SHEET NO.	
NO.	BY:	DATE:	NO.	BY:	DATE:
1			3		
2			4		

TOTAL SHEETS: 30

157077
 C:\Users\jwilliams\17BP.7.R.127-SMU_CS_400067.dgn
 4/27/2021 12:10:24 PM

DRAWN BY: J. T. WILLIAMS DATE: 1-2021
 CHECKED BY: J. E. MONDOLFI DATE: 2-2021
 DESIGN ENGINEER OF RECORD: J. E. MONDOLFI DATE: 2-2021

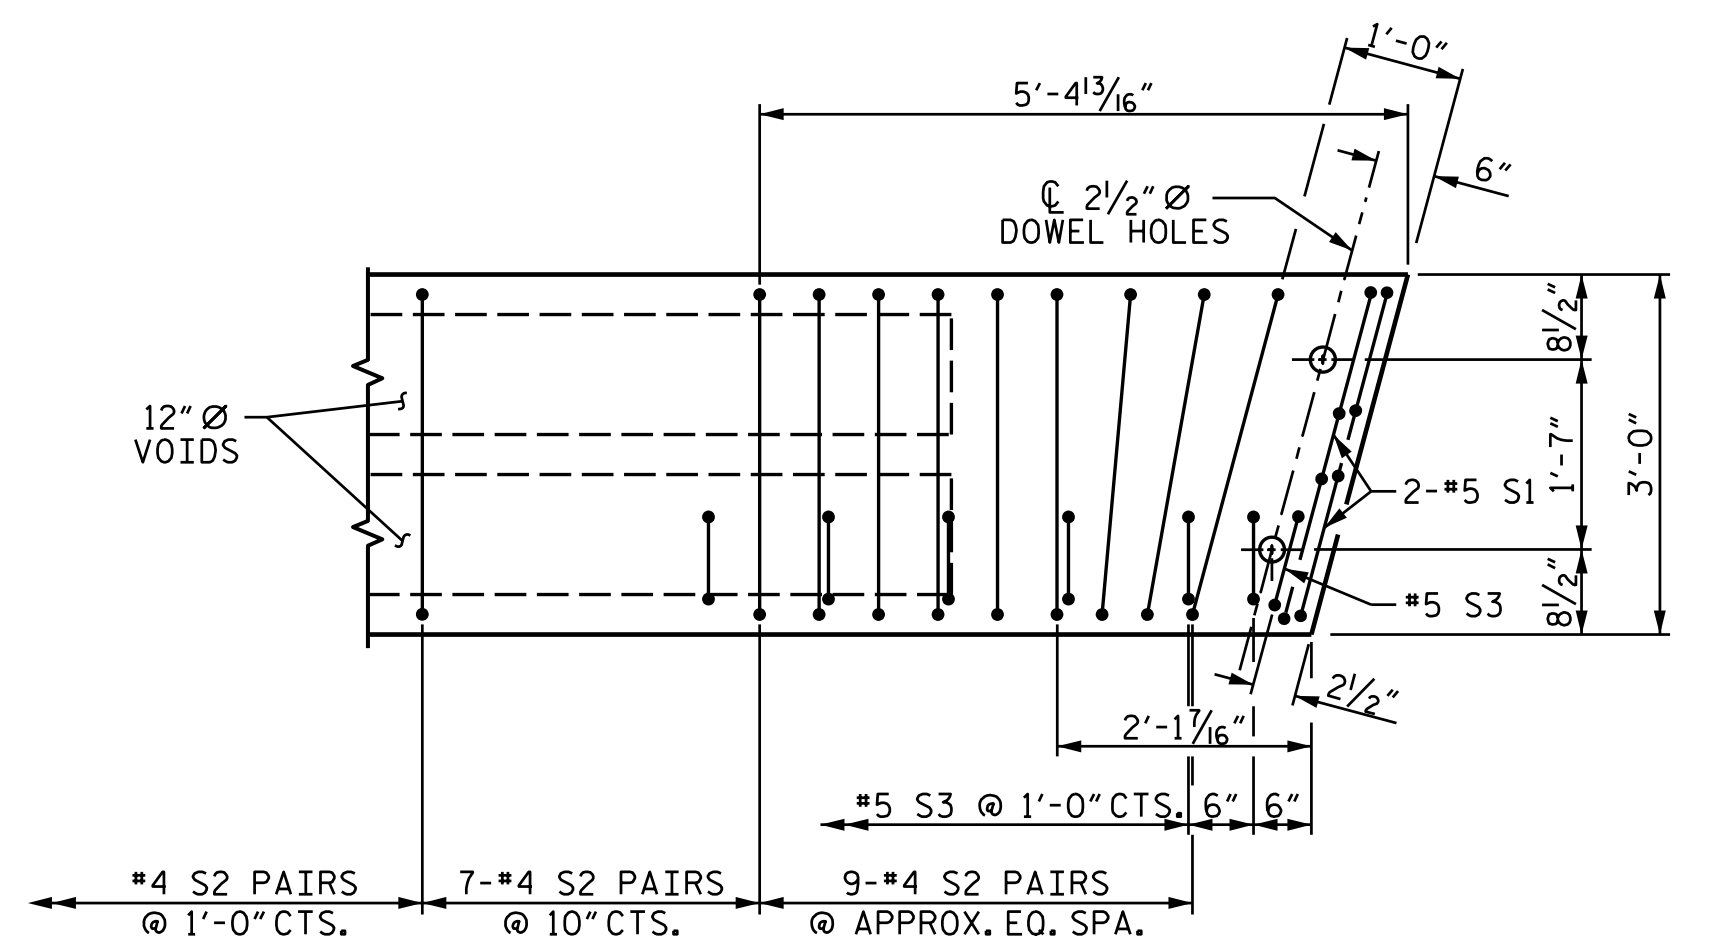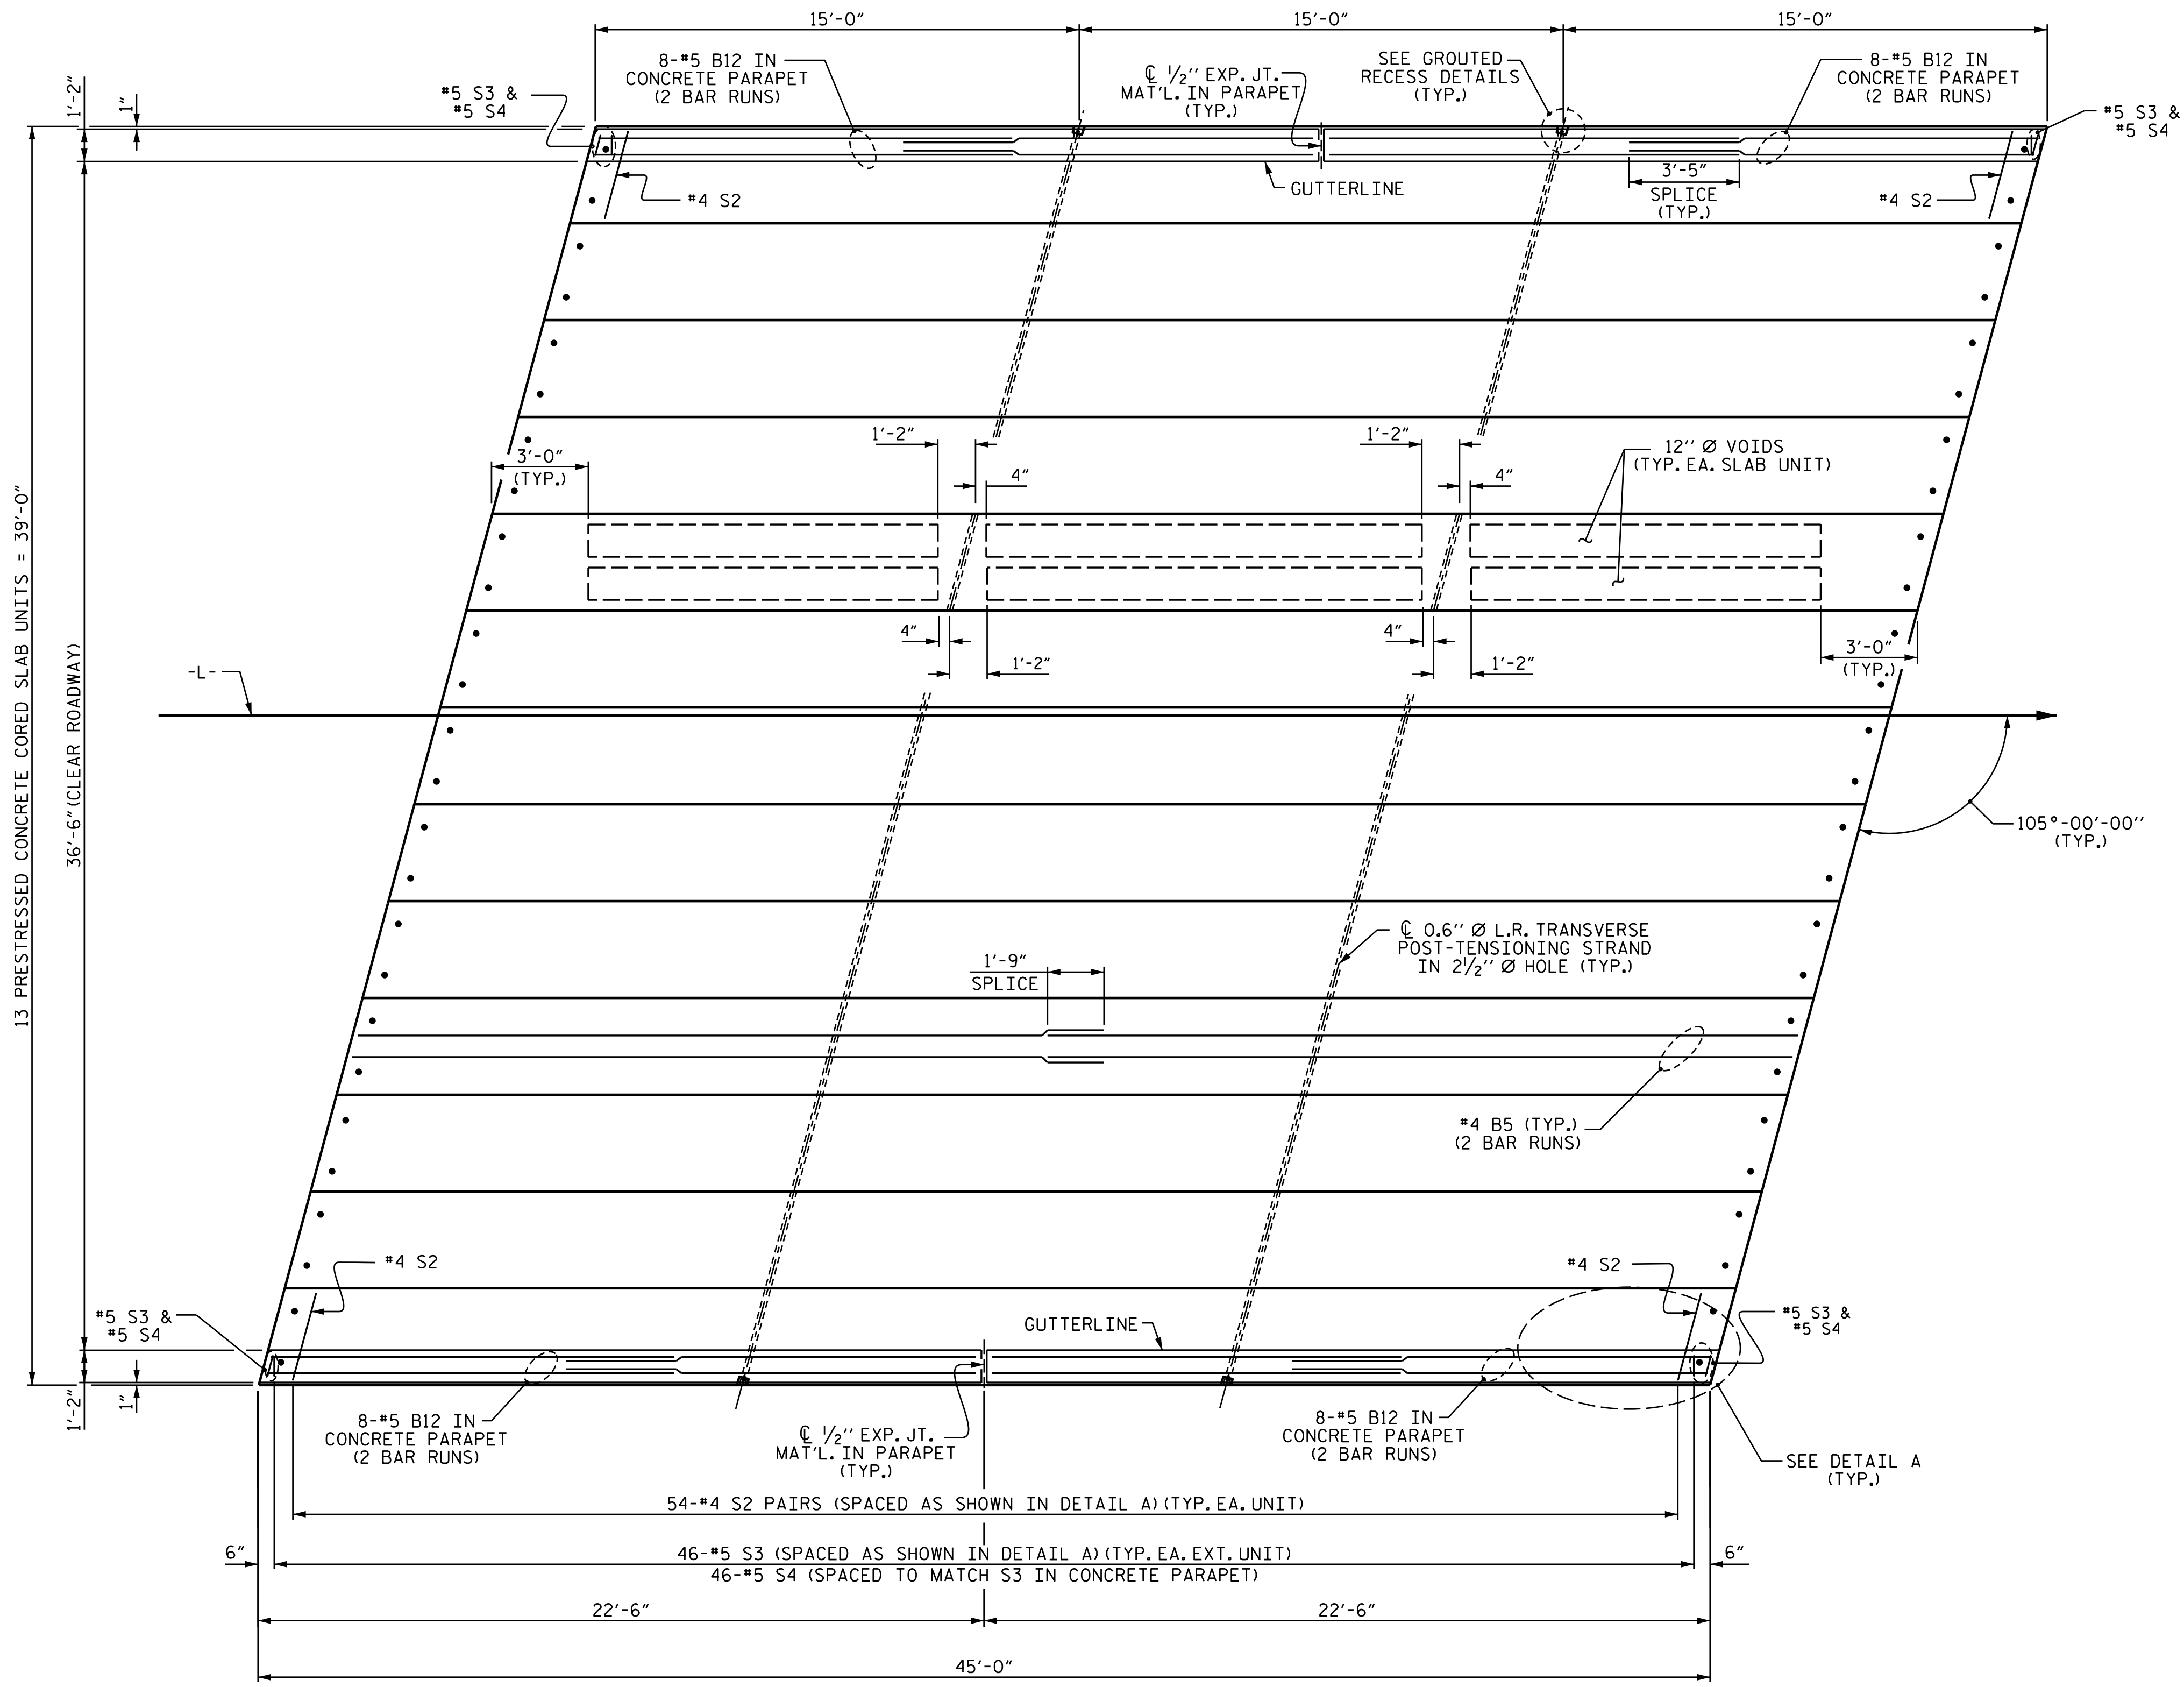


DETAIL "A"
 (SIMILAR EACH END OF UNIT)
 NOTE: EXTERIOR UNIT SHOWN - INTERIOR UNIT SIMILAR EXCEPT OMIT #5 S3 BARS.

PLAN OF UNIT

PROJECT NO. 17BP.7.R.127
 GUILFORD COUNTY
 STATION: 15+33.00 -L-
 SHEET 5 OF 6

STATE OF NORTH CAROLINA
 DEPARTMENT OF TRANSPORTATION
 RALEIGH
 SUPERSTRUCTURE
 PLAN OF SPAN C
 45' UNIT
 36'-6" CLEAR ROADWAY
 105° SKEW

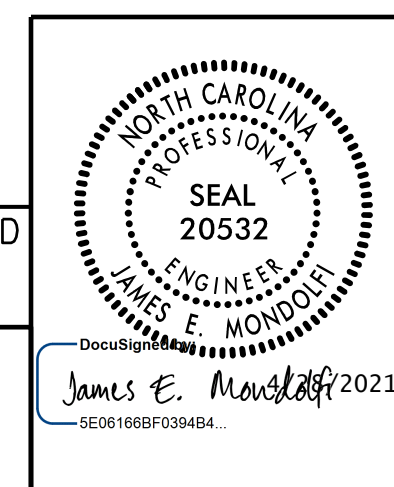


DOCUMENT NOT CONSIDERED FINAL UNLESS ALL SIGNATURES COMPLETED
 PLANS PREPARED BY:
M MOTT MACDONALD
 PO Box 700
 Fuquay-Varina, NC 27526
 (919) 552-2253
 www.mottmac.com
 LICENSE NO. F-0669

REVISIONS				SHEET NO.
NO.	BY:	DATE:	NO.	DATE:
1			3	
2			4	

TOTAL SHEETS: 30


157077
 C:\Users\jwilliams\OneDrive\17BP.7.R.127-SMU-CS-400067.dgn
 4/27/2021 12:10:24 PM

DRAWN BY: J. T. WILLIAMS DATE: 1-2021
 CHECKED BY: J. E. MONDOLFI DATE: 2-2021
 DESIGN ENGINEER OF RECORD: J. E. MONDOLFI DATE: 2-2021

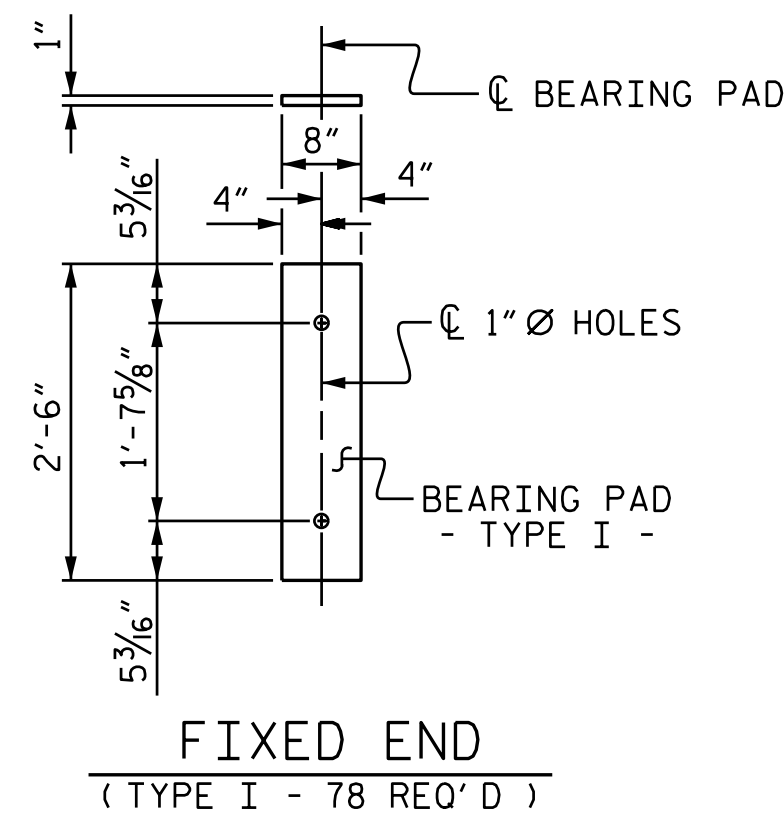

ELASTOMERIC BEARING DETAILS
ELASTOMER IN ALL BEARINGS SHALL BE 60 DUROMETER HARDNESS.

BAR TYPES

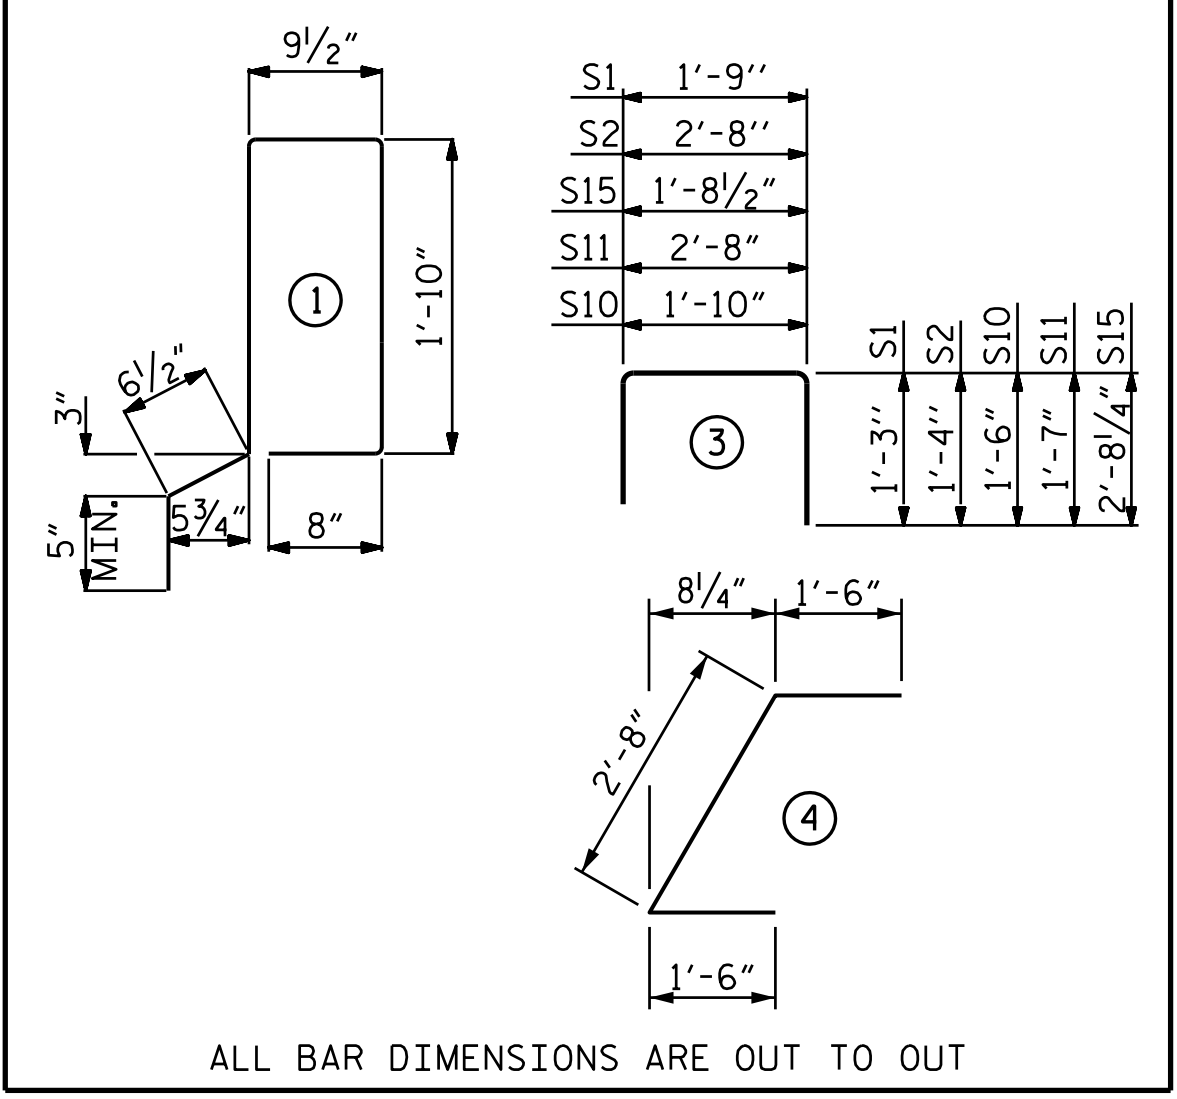

ALL BAR DIMENSIONS ARE OUT TO OUT

BILL OF MATERIAL FOR ONE 35' CORED SLAB UNIT

				EXTERIOR UNIT		INTERIOR UNIT	
BAR	NUMBER	SIZE	TYPE	LENGTH	WEIGHT	LENGTH	WEIGHT
B3	2	#4	STR	34'-6"	46	34'-6"	46
S1	8	#5	3	4'-3"	35	4'-3"	35
S2	88	#4	3	5'-4"	314	5'-4"	314
* S3	38	#5	1	6'-1"	241		
REINFORCING STEEL				LBS.	395		395
* EPOXY COATED REINFORCING STEEL				LBS.	241		
5000 P.S.I. CONCRETE				CU. YDS.	5.2		5.2
0.6" Ø L.R. STRANDS				No.	11		11

BILL OF MATERIAL FOR ONE 45' CORED SLAB UNIT

				EXTERIOR UNIT		INTERIOR UNIT	
BAR	NUMBER	SIZE	TYPE	LENGTH	WEIGHT	LENGTH	WEIGHT
B5	4	#4	STR	23'-3"	62	23'-3"	62
S1	8	#5	3	4'-3"	35	4'-3"	35
S2	108	#4	3	5'-4"	385	5'-4"	385
* S3	48	#5	1	6'-1"	305		
REINFORCING STEEL				LBS.	482		482
* EPOXY COATED REINFORCING STEEL				LBS.	305		
5000 P.S.I. CONCRETE				CU. YDS.	6.6		6.6
0.6" Ø L.R. STRANDS				No.	13		13

BILL OF MATERIAL FOR ONE 70' CORED SLAB UNIT

				EXTERIOR UNIT		INTERIOR UNIT	
BAR	NUMBER	SIZE	TYPE	LENGTH	WEIGHT	LENGTH	WEIGHT
B22	4	#4	STR	35'-9"	96	35'-9"	96
* S3	72	#5	1	6'-1"	457		
S10	8	#5	3	4'-10"	40	4'-10"	40
S11	148	#4	3	5'-10"	577	5'-10"	577
S14	4	#4	4	5'-8"	15	5'-8"	15
S15	4	#5	3	7'-1"	30	7'-1"	30
REINFORCING STEEL				LBS.	758		758
* EPOXY COATED REINFORCING STEEL				LBS.	457		
7000 P.S.I. CONCRETE				CU. YDS.	12.0		12.0
0.6" Ø L.R. STRANDS				No.	28		28

CORED SLABS REQUIRED

	NUMBER	LENGTH	TOTAL LENGTH
35' UNIT			
EXTERIOR C.S.	2	35'-0"	70'-0"
INTERIOR C.S.	11	35'-0"	385'-0"
TOTAL	13		455'-0"

CORED SLABS REQUIRED

	NUMBER	LENGTH	TOTAL LENGTH
70' UNIT			
EXTERIOR C.S.	2	70'-0"	140'-0"
INTERIOR C.S.	11	70'-0"	770'-0"
TOTAL	13		910'-0"

CORED SLABS REQUIRED

	NUMBER	LENGTH	TOTAL LENGTH
45' UNIT			
EXTERIOR C.S.	2	45'-0"	90'-0"
INTERIOR C.S.	11	45'-0"	495'-0"
TOTAL	13		585'-0"

DEAD LOAD DEFLECTION AND CAMBER

ALL UNITS 0.6" Ø L.R. STRANDS	SPAN A	SPAN B	SPAN C
	35' - 21" CORED SLAB UNIT 3'-0" x 1'-9"	70' - 24" CORED SLAB UNIT 3'-0" x 2'-0"	45' - 21" CORED SLAB UNIT 3'-0" x 1'-9"
CAMBER (SLAB ALONE IN PLACE)	1/2" ↑	2 1/4" ↑	7/8" ↑
DEFLECTION DUE TO SUPERIMPOSED DEAD LOAD *	1/16" ↓	15/16" ↓	1/4" ↓
FINAL CAMBER	7/16" ↑	1 1/16" ↑	5/8" ↑

* INCLUDES FUTURE WEARING SURFACE

GRADE 270 STRANDS

	0.6" Ø L.R.
AREA (SQUARE INCHES)	0.217
ULTIMATE STRENGTH (LBS. PER STRAND)	58,600
APPLIED PRESTRESS (LBS. PER STRAND)	43,950

CONCRETE RELEASE STRENGTH

UNIT	PSI
35' & 45' UNITS	4000
70' UNITS	5500

NOTES

ALL PRESTRESSING STRANDS SHALL BE 7-WIRE LOW RELAXATION GRADE 270 STRANDS AND SHALL CONFORM TO AASHTO M203 EXCEPT FOR SAMPLING REQUIREMENTS WHICH SHALL BE IN ACCORDANCE WITH THE STANDARD SPECIFICATIONS.

ALL REINFORCING STEEL CAST WITH THE CORED SLAB SECTIONS SHALL BE GRADE 60 AND SHALL BE INCLUDED IN THE UNIT PRICE BID FOR PRESTRESSED CONCRETE CORED SLABS.

RECESSES FOR TRANSVERSE STRANDS SHALL BE GROUTED AFTER THE TENSIONING OF THE STRANDS.

THE 2 1/2" Ø DOWEL HOLES AT FIXED ENDS OF SLAB SECTIONS SHALL BE FILLED WITH NON-SHRINK GROUT.

THE BACKER RODS SHALL CONFORM TO THE REQUIREMENTS OF TYPE M BOND BREAKER. SEE SECTION 1028 OF THE STANDARD SPECIFICATIONS.

WHEN CORED SLABS ARE CAST, AN INTERNAL HOLD-DOWN SYSTEM SHALL BE EMPLOYED TO PREVENT VOIDS FROM RISING OR MOVING SIDEWAYS. AT LEAST SIX WEEKS PRIOR TO CASTING CORED SLABS, THE CONTRACTOR SHALL SUBMIT TO THE ENGINEER FOR REVIEW AND COMMENT, DETAILED DRAWINGS OF THE PROPOSED HOLD-DOWN SYSTEM. IN ADDITION TO STRUCTURAL DETAILS, LOCATION AND SPACING OF THE HOLD-DOWNS SHALL BE INDICATED.

ALL REINFORCING STEEL IN THE CONCRETE PARAPET SHALL BE EPOXY COATED.

PRESTRESSING STRANDS SHALL BE CUT FLUSH WITH THE CORED SLAB UNIT ENDS.

APPLY EPOXY PROTECTIVE COATING TO CORED SLAB UNIT ENDS.

GROOVED CONTRACTION JOINTS, 1/2" IN DEPTH, SHALL BE TOOLED IN ALL EXPOSED FACES OF THE PARAPET AND IN ACCORDANCE WITH ARTICLE 825-10(B) OF THE STANDARD SPECIFICATIONS, A CONTRACTION JOINT SHALL BE LOCATED AT EACH THIRD POINT BETWEEN PARAPET EXPANSION JOINTS. ONLY ONE CONTRACTION JOINT IS REQUIRED AT MIDPOINT OF PARAPET SEGMENTS LESS THAN 20 FEET IN LENGTH AND NO CONTRACTION JOINTS ARE REQUIRED FOR THOSE SEGMENTS LESS THAN 10 FEET IN LENGTH.

FLAME CUTTING OF THE TRANSVERSE POST-TENSIONING STRAND IS NOT ALLOWED.

THE TRANSFER OF LOAD FROM THE ANCHORAGES TO THE CORED SLAB UNIT SHALL BE DONE WHEN THE CONCRETE HAS REACHED A COMPRESSIVE STRENGTH OF NOT LESS THAN THE REQUIRED STRENGTH SHOWN IN THE "CONCRETE RELEASE STRENGTH" TABLE.

MAINTAIN A SYMMETRIC TENSION FORCE BETWEEN EACH PAIR OF TRANSVERSE POST TENSIONING STRANDS IN THE DIAPHRAGM.

THE #4 S11 STIRRUPS MAY BE SHIFTED AS NECESSARY TO MAINTAIN 1" CLEAR TO THE GROUTED RECESS.

FOR GROUT FOR STRUCTURES, SEE SPECIAL PROVISIONS.

THE PERMITTED THREADED INSERTS ARE DETAILED AS AN OPTION FOR THE CONTRACTOR TO ATTACH FALSEWORK AND FORMWORK DURING CONSTRUCTION.

THE PERMITTED THREADED INSERTS IN THE EXTERIOR UNITS SHALL BE SIZED BY THE CONTRACTOR, SPACED AT 4'-0" CENTERS AND GALVANIZED IN ACCORDANCE WITH SECTION 1076 OF THE STANDARD SPECIFICATIONS. STAINLESS STEEL THREADED INSERTS MAY BE USED AS AN ALTERNATE.


THE PERMITTED THREADED INSERTS SHALL BE GROUTED BY THE CONTRACTOR IMMEDIATELY FOLLOWING REMOVAL OF THE FALSEWORK.

THE COST OF THE PERMITTED THREADED INSERTS SHALL BE INCLUDED IN THE PRICE BID FOR THE PRECAST UNITS.

PROJECT NO. 17BP.7.R.127
GUILFORD COUNTY
STATION: 15+33.00 -L-

SHEET 6 OF 6

STATE OF NORTH CAROLINA
DEPARTMENT OF TRANSPORTATION
RALEIGH
SUPERSTRUCTURE
PRESTRESSED CONCRETE
CORED SLAB UNIT
DETAILS

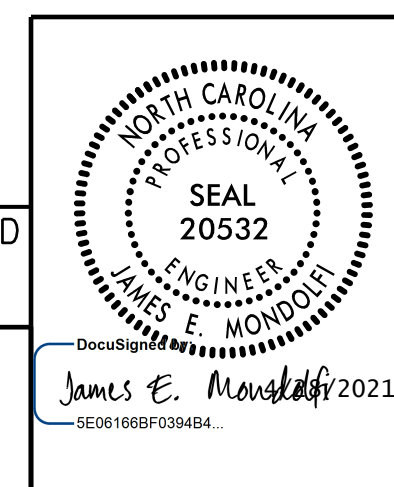

DOCUMENT NOT CONSIDERED FINAL UNLESS ALL SIGNATURES COMPLETED

PLANS PREPARED BY:
MOTT MACDONALD
PO Box 700
Fuquay-Varina, NC 27526
(919) 552-2253
www.mottmac.com
LICENSE NO. F-0669


REVISIONS

NO.	BY:	DATE:	NO.	BY:	DATE:
1			3		
2			4		

SHEET NO. S-12
TOTAL SHEETS 30

15/20/21
 W:\152021\Drawings\17BP.7.R.127-SMU-CS-400067.dgn
 12:10:25 PM

DRAWN BY: J. T. WILLIAMS DATE: 1-2021
 CHECKED BY: J. E. MONDOLFI DATE: 2-2021
 DESIGN ENGINEER OF RECORD: J. E. MONDOLFI DATE: 2-2021

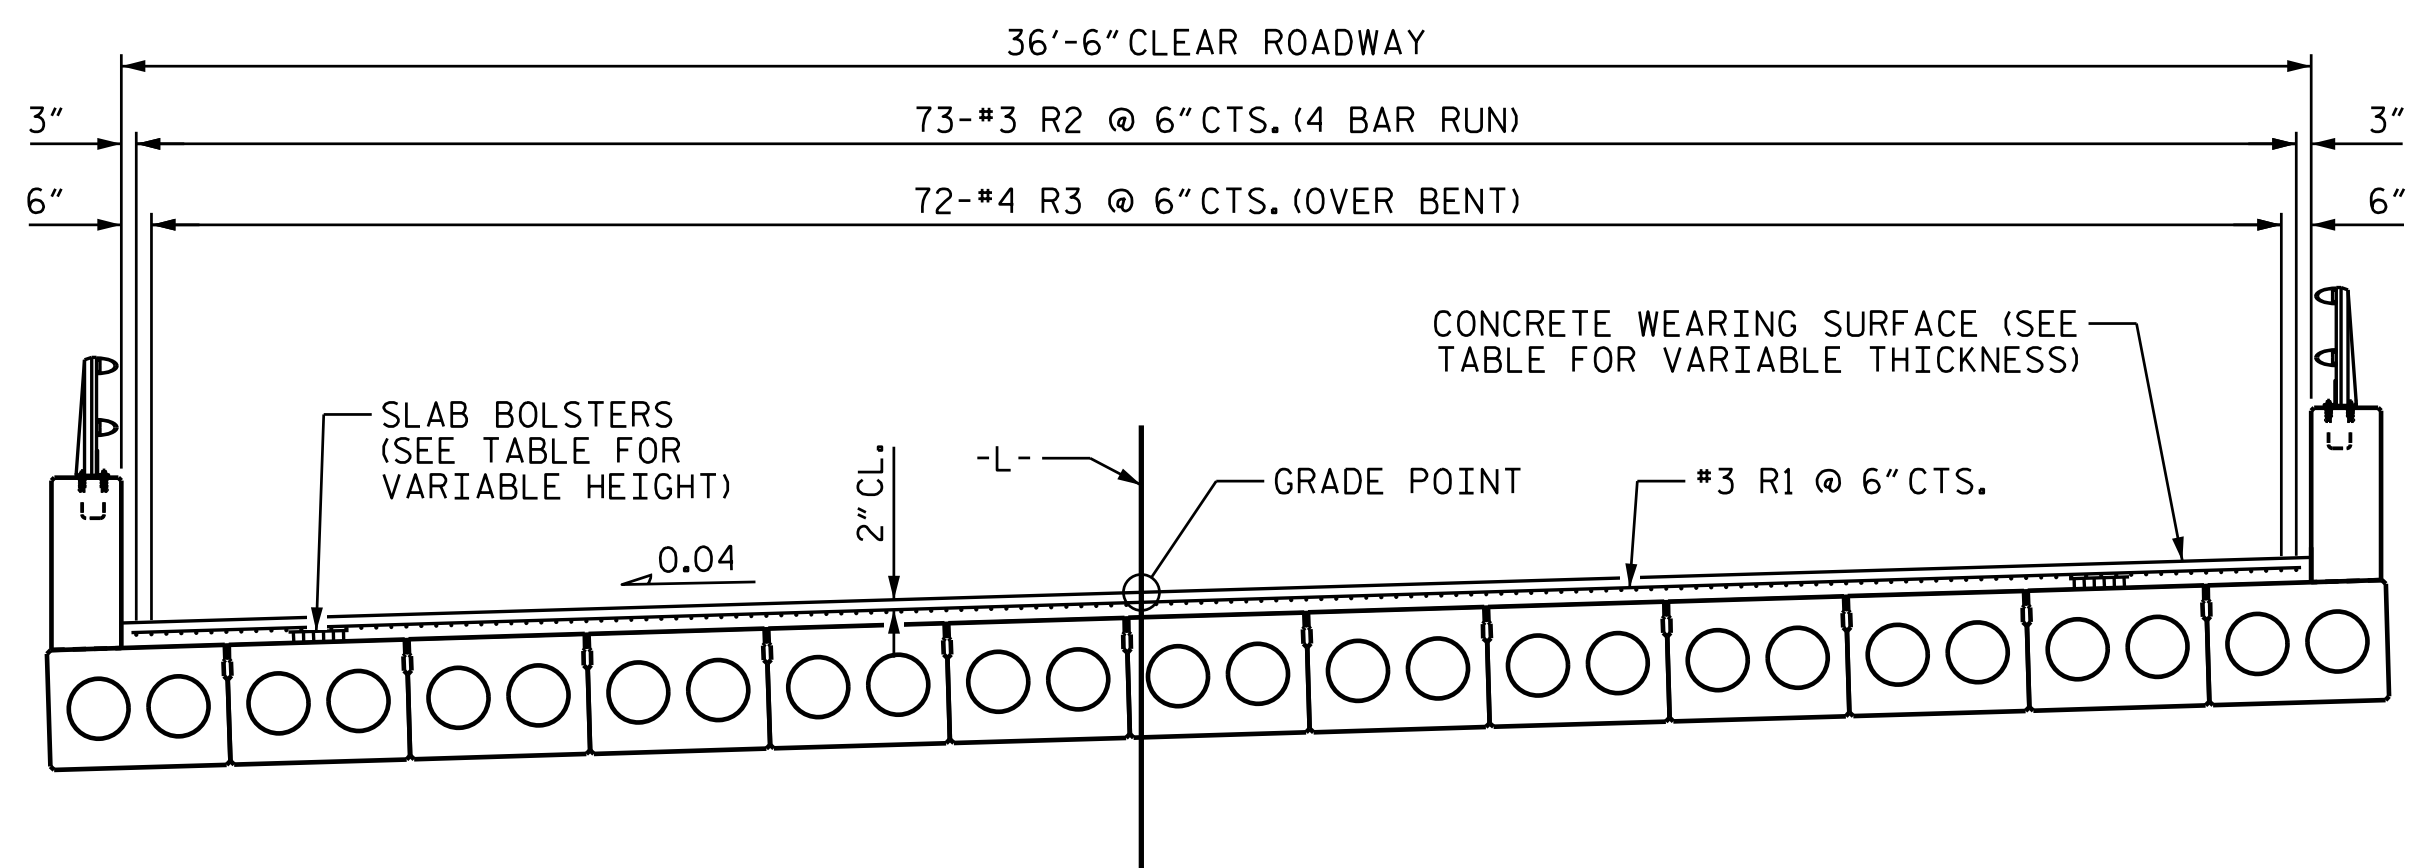

REINFORCING FOR CONCRETE WEARING SURFACE

NOTES:

PLACEMENT OF THE CONCRETE WEARING SURFACE SHALL OCCUR AFTER CASTING THE CONCRETE PARAPET. THE COST OF THE #3 & #4 BARS CAST WITH THE CONCRETE WEARING SURFACE SHALL BE INCLUDED IN THE UNIT PRICE BID FOR CONCRETE WEARING SURFACE. FOR CONCRETE WEARING SURFACE, SEE SPECIAL PROVISIONS.


ALL REINFORCING STEEL FOR THE CONCRETE WEARING SURFACE SHALL BE EPOXY COATED.

GROOVED CONTRACTION JOINTS, 1/2" IN DEPTH SHALL BE TOOLED IN THE TOP WEARING SURFACE AT INTERIOR BENTS WITH CONTINUOUS CONCRETE WEARING SURFACE IN ACCORDANCE WITH ARTICLE 825-10(B) OF THE STANDARD SPECIFICATIONS.

BILL OF MATERIAL					
CONCRETE WEARING SURFACE					
BAR	NO.	SIZE	TYPE	LENGTH	WEIGHT
* R1	300	#3	STR	37'-5"	4221
* R2	292	#3	STR	38'-9"	4254
* R3	144	#4	STR	20'-0"	1924
* EPOXY COATED REINFORCING STEEL					10,399 LBS
CONCRETE WEARING SURFACE					5,485 SQ. FT.

GROOVING BRIDGE FLOORS	
APPROACH SLABS	771 SQ. FT.
CONCRETE WEARING SURFACE	5,034 SQ. FT.
TOTAL	5,805 SQ. FT.

SPLICE LENGTH CHART	
BAR SIZE	EPOXY COATED
#3	1'-6"

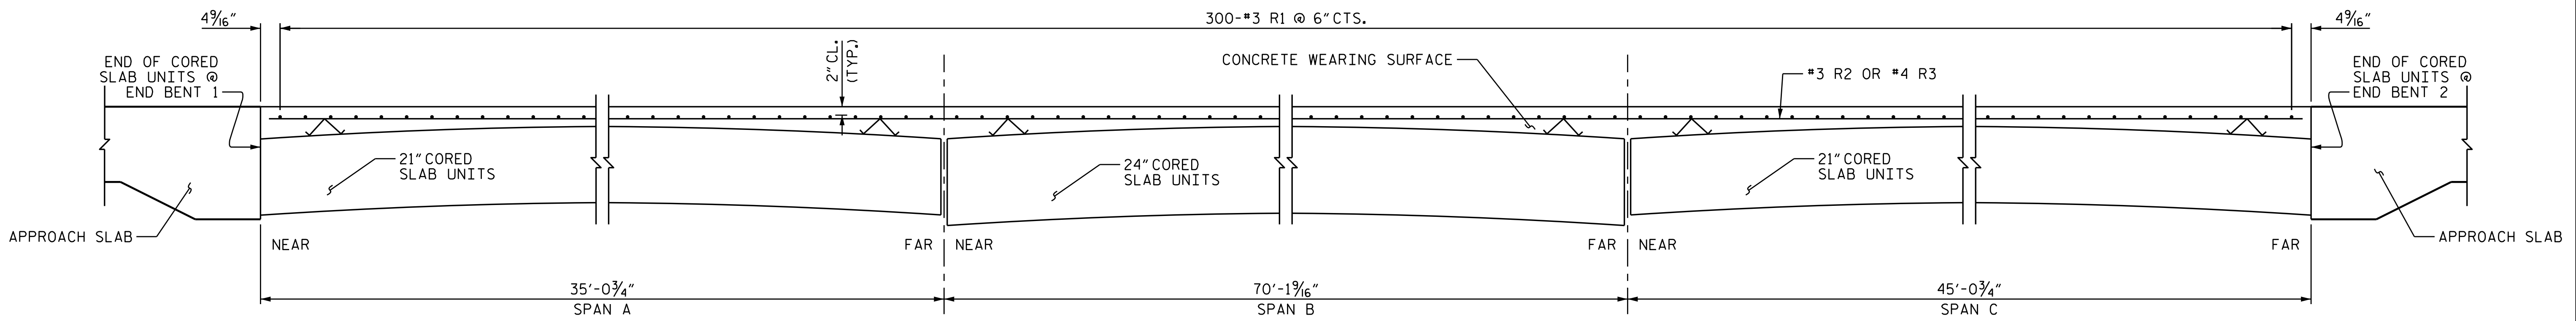

SECTION THRU CONCRETE WEARING SURFACE


CONCRETE WEARING SURFACE THICKNESS				
SPAN	LOCATION	LT. GUTTERLINE	GRADE POINT	RT. GUTTERLINE
A	BEARING (NEAR)	4"	4 1/4"	4 1/2"
	@ MID-SPAN	3 5/8"	3 5/8"	3 1/16"
	BEARING (FAR)	4 3/8"	4 3/8"	4 3/8"
B	BEARING (NEAR)	5"	5"	5"
	@ MID-SPAN	3 3/4"	3 3/4"	3 3/4"
	BEARING (FAR)	5 1/8"	5 1/8"	5 1/8"
C	BEARING (NEAR)	4 1/4"	4 1/4"	4 1/4"
	@ MID-SPAN	3 5/8"	3 5/8"	3 5/8"
	BEARING (FAR)	4 1/4"	4 1/4"	4 1/4"

NOTE: CONCRETE WEARING SURFACE THICKNESS BASED ON PREDICTED FINAL CAMBER AND THEORETICAL GRADE LINE ELEVATION AND VARIES BETWEEN Q BEARING AND MID-SPAN.

BEAM OR SLAB BOLSTER HEIGHTS				
SPAN	LOCATION	LT. GUTTERLINE	GRADE POINT	RT. GUTTERLINE
A	BEARING (NEAR)	1"	1"	1 1/2"
	MID-SPAN	3/4" **	3/4" **	3/4" **
	BEARING (FAR)	1"	1"	1"
B	BEARING (NEAR)	2"	2"	2"
	MID-SPAN	3/4" **	3/4" **	3/4" **
	BEARING (FAR)	2"	2"	2"
C	BEARING (NEAR)	1"	1"	1"
	MID-SPAN	3/4" **	3/4" **	3/4" **
	BEARING (FAR)	1"	1"	1"

**USE SLAB BOLSTERS

NOTE: BEAM AND SLAB BOLSTER HEIGHTS BASED ON PREDICTED FINAL CAMBER AND THEORETICAL GRADE LINE ELEVATION AND VARY BETWEEN Q BEARING AND MID-SPAN.

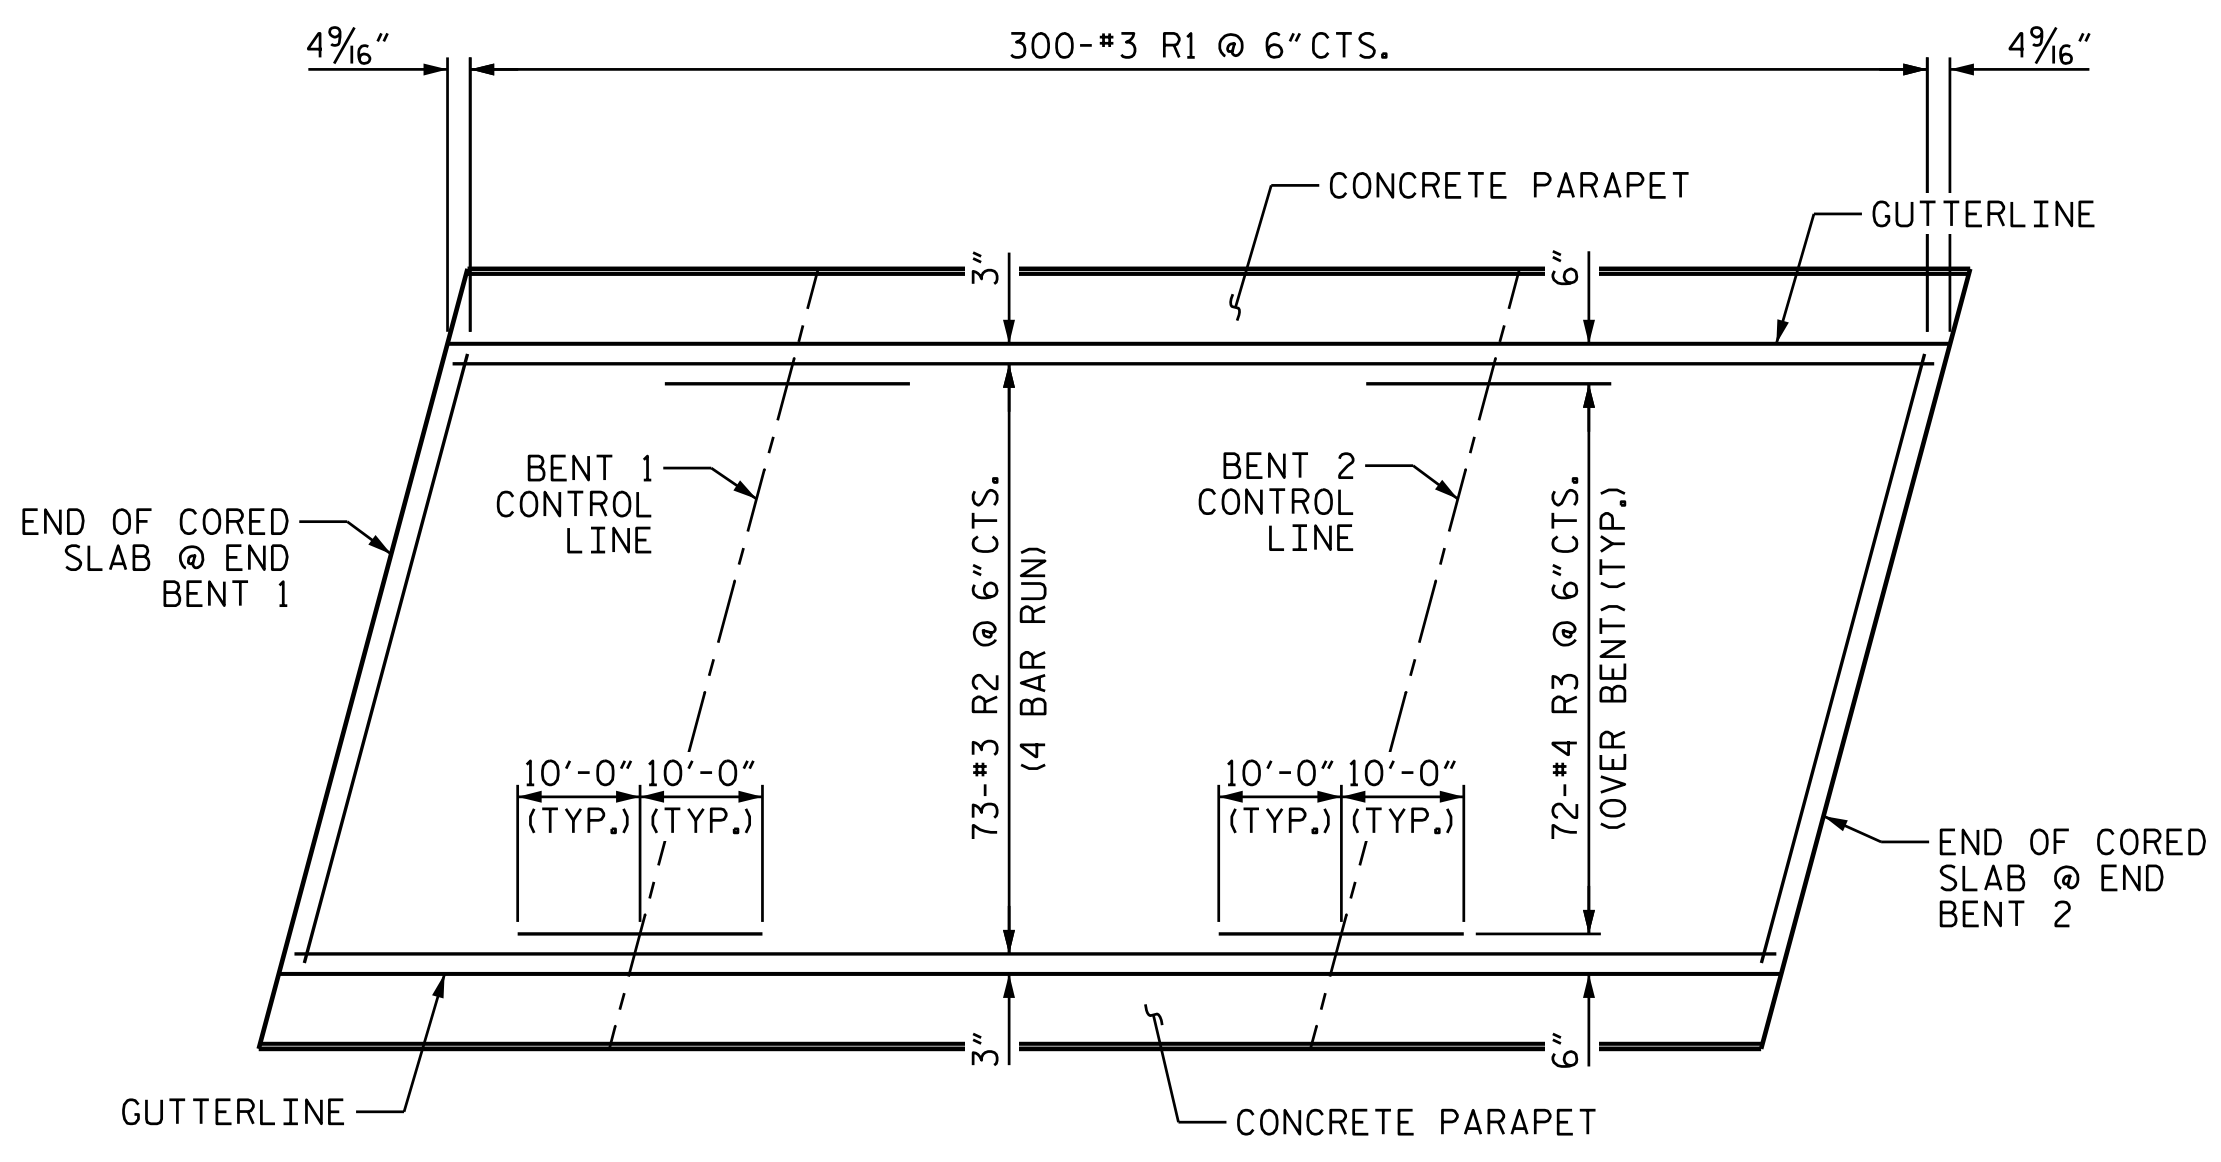


PLAN

SHOWING CONTINUOUS CONCRETE OVERLAY OVER INTERIOR BENTS

PROJECT NO. 17BP.7.R.127
 GUILFORD COUNTY
 STATION: 15+33.00 -L-

STATE OF NORTH CAROLINA
 DEPARTMENT OF TRANSPORTATION
 RALEIGH
 SUPERSTRUCTURE
 CONCRETE WEARING SURFACE DETAILS

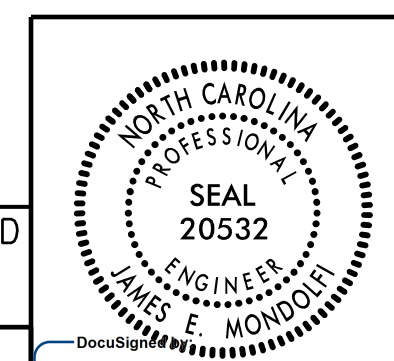


DOCUMENT NOT CONSIDERED FINAL UNLESS ALL SIGNATURES COMPLETED

PLANS PREPARED BY:
 MOTT MACDONALD
 PO Box 700
 Fuquay-Varina, NC 27526
 (919) 552-2253
 www.mottmac.com
 LICENSE NO. F-0669

REVISIONS						SHEET NO.
NO.	BY:	DATE:	NO.	BY:	DATE:	5-13
1			3			TOTAL SHEETS
2			4			30

11/15/2021 12:10:26 PM
 J:\Projects\17BP.7.R.127-SMU-CWS-400067.dgn
 4/27/2021

DRAWN BY: J. T. WILLIAMS DATE: 2-2021
 CHECKED BY: J. E. MONDOLFI DATE: 2-2021
 DESIGN ENGINEER OF RECORD: J. E. MONDOLFI DATE: 2-2021

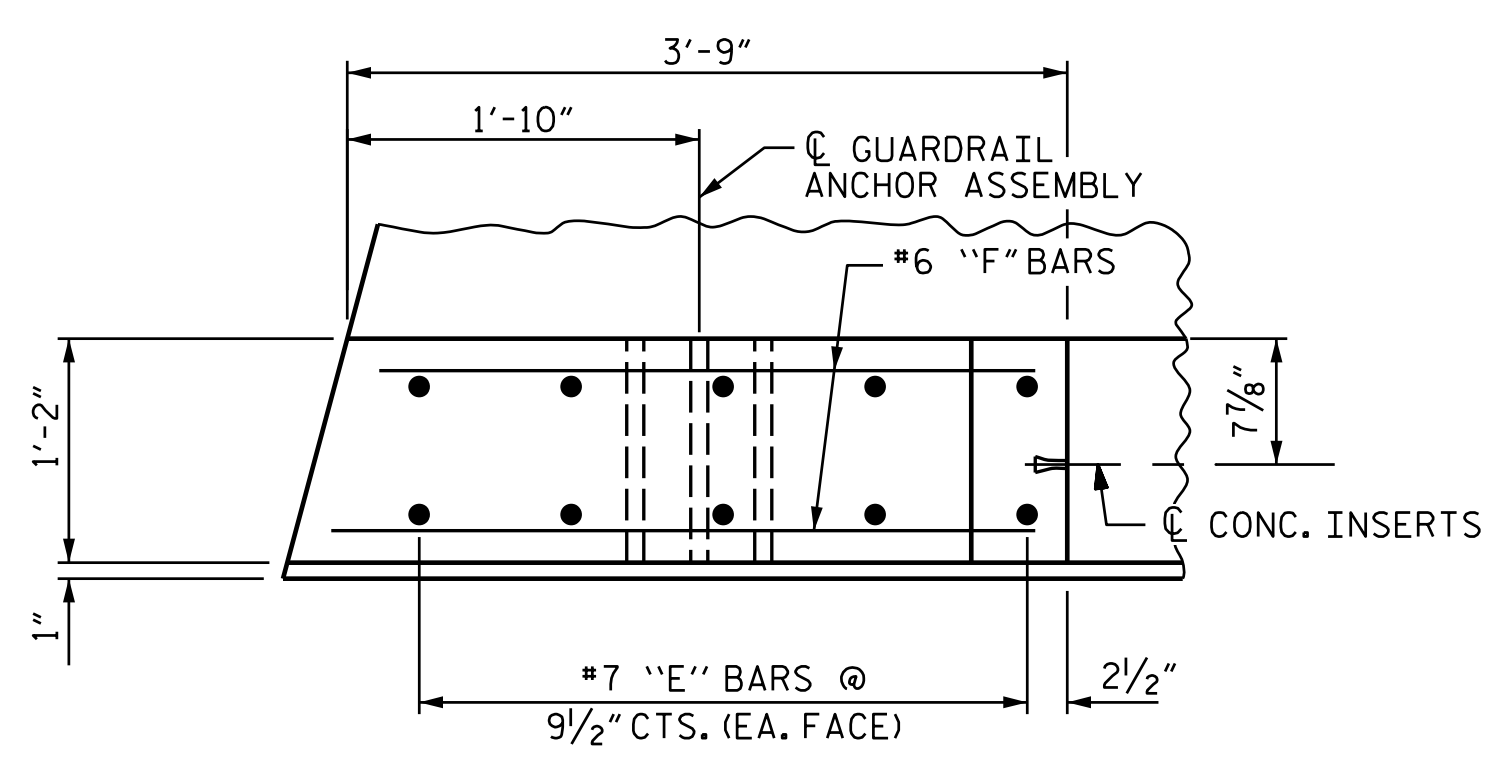

PLAN OF END POST



NOTES:

ALL REINFORCING STEEL IN PARAPETS AND END POSTS SHALL BE EPOXY COATED.


FOR DETAIL OF CONCRETE INSERT AND METAL RAIL ANCHOR ASSEMBLY, SEE "RAIL POST SPACINGS AND END OF RAIL DETAIL" SHEET.

GROOVED CONTRACTION JOINTS, 1/2" IN DEPTH, SHALL BE TOOLED IN ALL EXPOSED FACES OF THE PARAPET AND IN ACCORDANCE WITH ARTICLE 825-10(B) OF THE STANDARD SPECIFICATIONS. A CONTRACTION JOINT SHALL BE LOCATED AT EACH THIRD POINT BETWEEN PARAPET EXPANSION JOINTS. ONLY ONE CONTRACTION JOINT IS REQUIRED AT MIDPOINT OF PARAPET SEGMENTS LESS THAN 20 FEET IN LENGTH AND NO CONTRACTION JOINTS ARE REQUIRED FOR THOSE SEGMENTS LESS THAN 10 FEET IN LENGTH.


BAR TYPE		BILL OF MATERIAL				
FOR 2 PARAPETS & 4 END POSTS						
BAR	NO.	SIZE	TYPE	LENGTH	WEIGHT	
*B10	64	#5	STR	10'-5"	695	
*B12	64	#5	STR	12'-11"	862	
*B25	96	#5	STR	13'-4"	1335	
*E1	8	#7	STR	2'-11"	48	
*E2	8	#7	STR	3'-4"	55	
*E3	8	#7	STR	3'-10"	63	
*E4	8	#7	STR	4'-3"	69	
*E5	8	#7	STR	4'-7"	75	
*F1	8	#6	STR	1'-11"	23	
*F2	8	#6	STR	3'-2"	38	
*F3	4	#6	STR	3'-7"	22	
*F4	4	#6	STR	3'-10"	23	
*S4	316	#5	2	6'-0"	1978	
* EPOXY COATED REINFORCING STEEL					5,286 LBS.	
CLASS AA CONCRETE					37.8 CU. YDS.	
1'-2" X 2'-11 1/8" CONCRETE PARAPET					300.52 LIN. FT.	

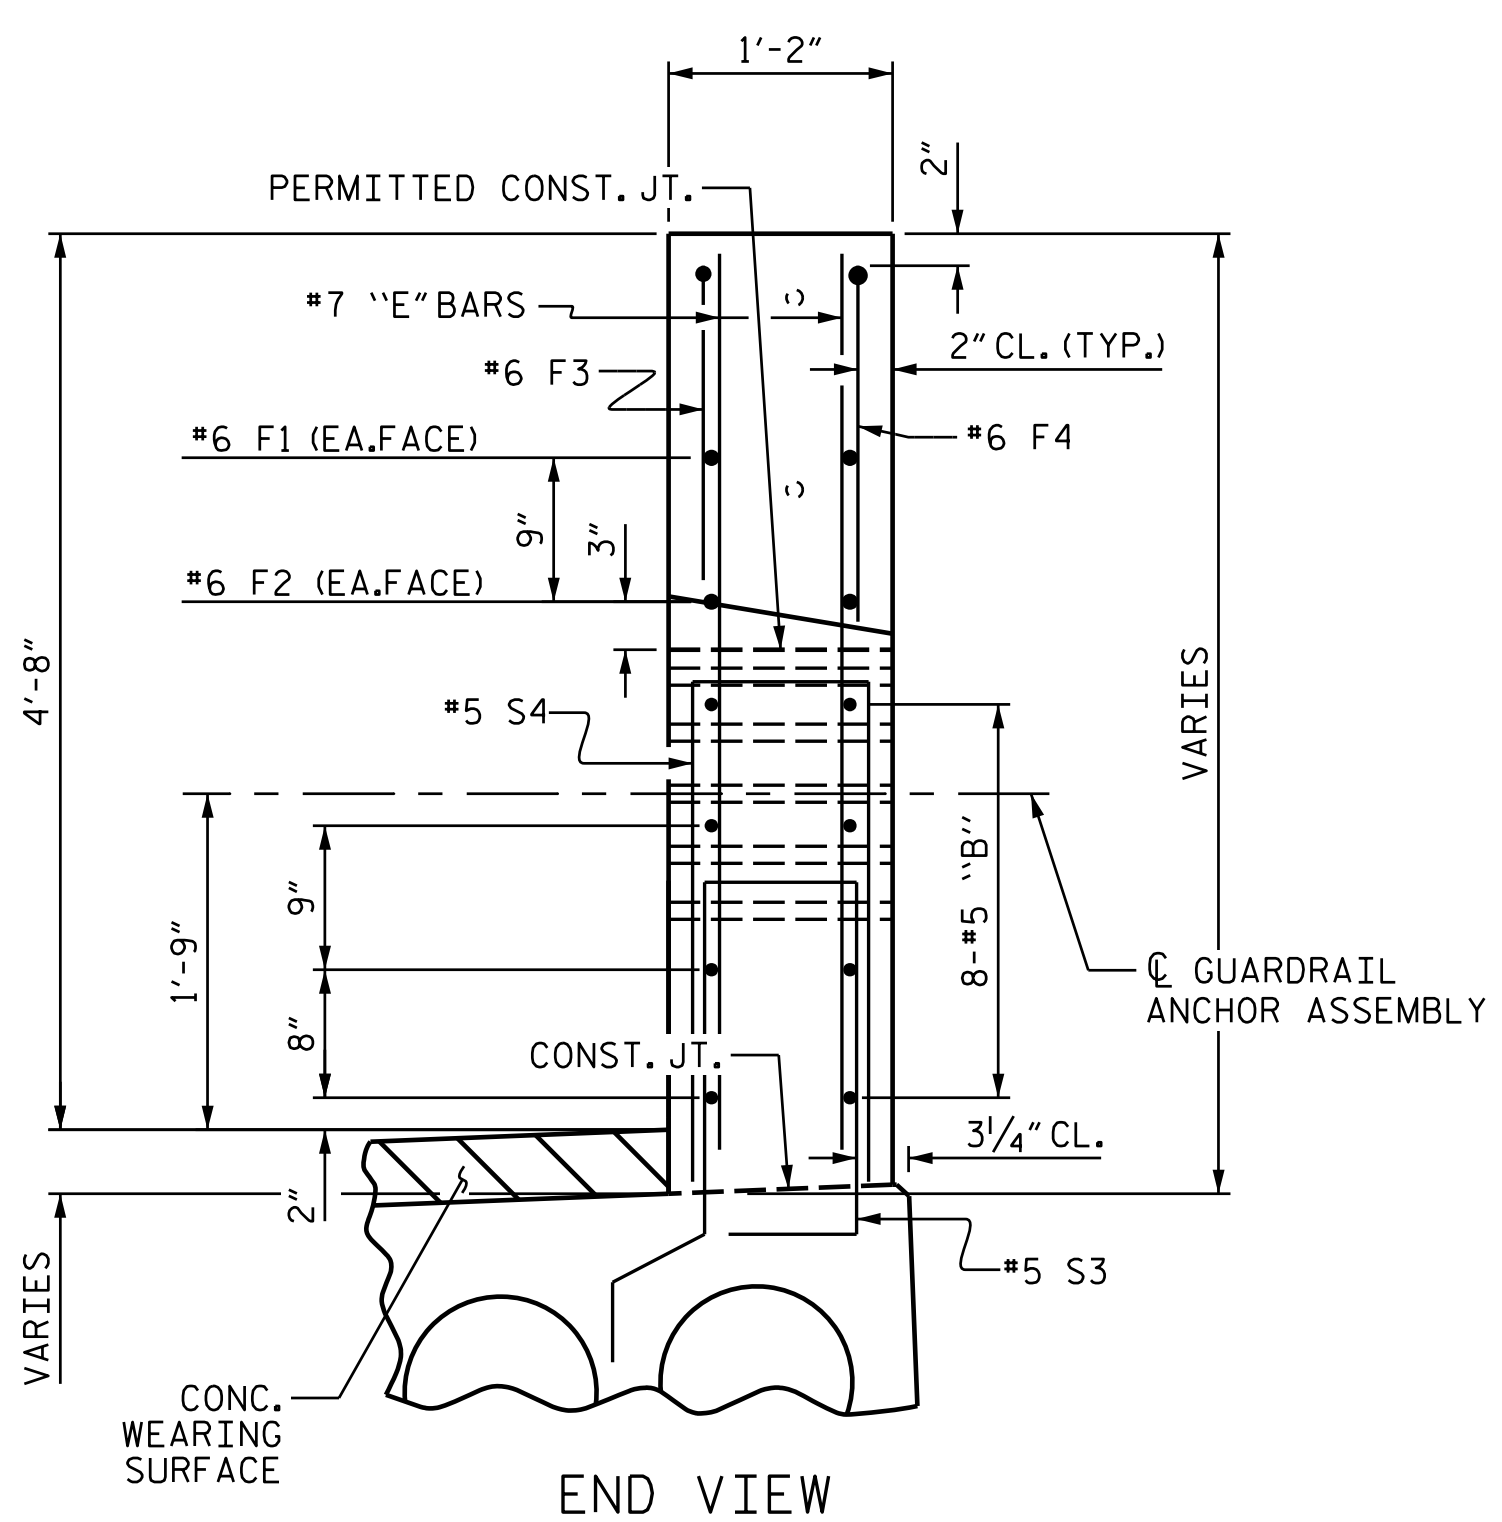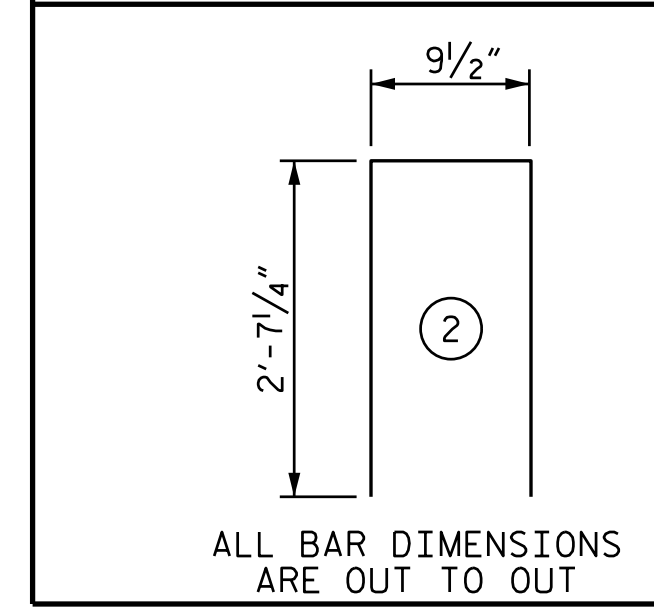

END VIEW

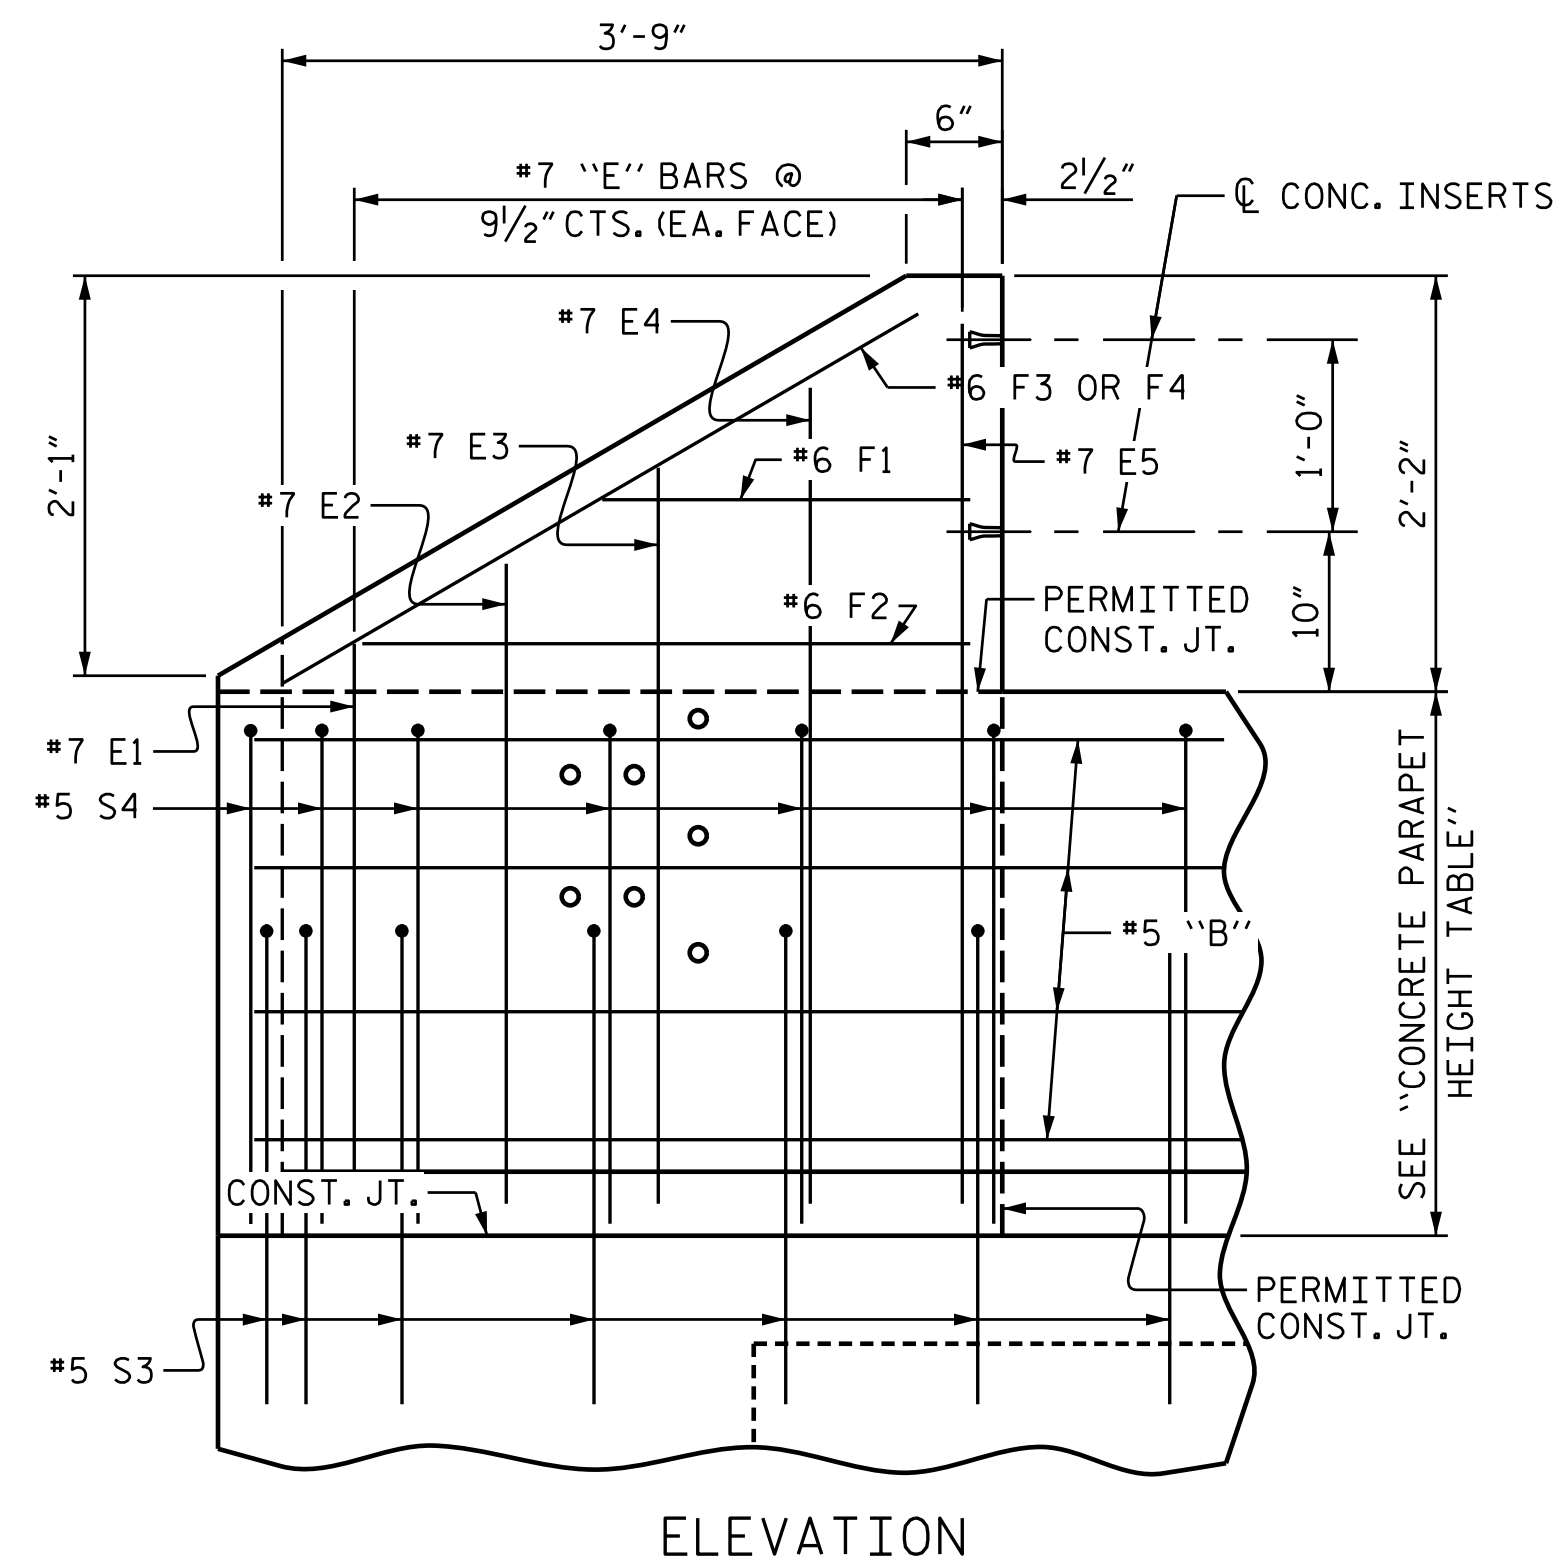

ELEVATION

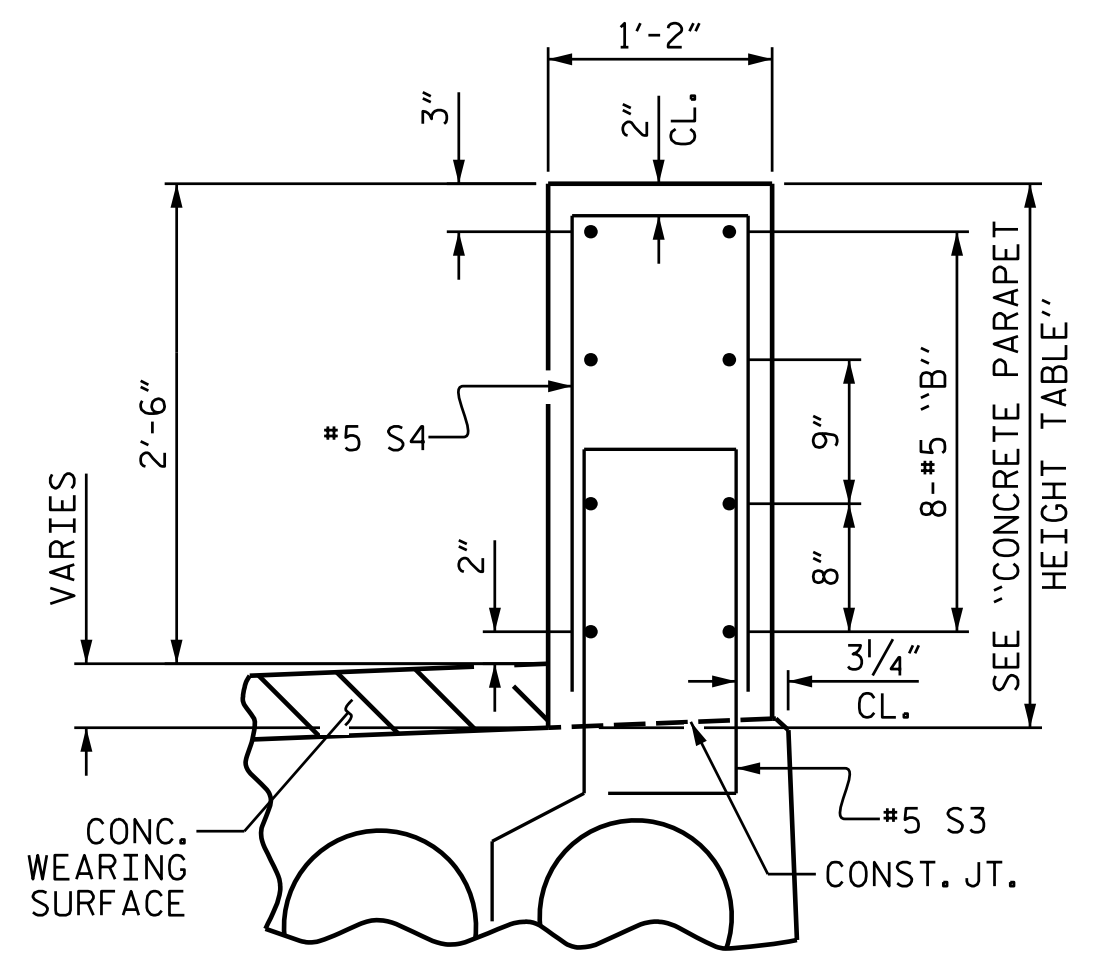


SECTION THROUGH PARAPET

CONCRETE PARAPET HEIGHT TABLE			
SPAN	LOCATION	LT. GUTTERLINE	RT. GUTTERLINE
A	BEARING (NEAR)	2'-10"	2'-10 1/2"
	@ MID-SPAN	2'-9 9/16"	2'-9 1/16"
B	BEARING (NEAR)	2'-10 3/8"	2'-10 3/8"
	@ MID-SPAN	2'-9 3/4"	2'-9 3/4"
C	BEARING (NEAR)	2'-11"	2'-11"
	@ MID-SPAN	2'-11 1/8"	2'-11 1/8"
	BEARING (NEAR)	2'-10 1/4"	2'-10 1/4"
	@ MID-SPAN	2'-9 5/8"	2'-9 5/8"
	BEARING (FAR)	2'-10 1/4"	2'-10 1/4"

NOTE: CONCRETE PARAPET HEIGHT BASED ON PREDICTED FINAL CAMBER AND THEORETICAL GRADE LINE ELEVATION AND VARIES BETWEEN CL BEARING AND MID-SPAN.

PARAPET AND END POST FOR TWO BAR RAIL

SECTION THROUGH PARAPET

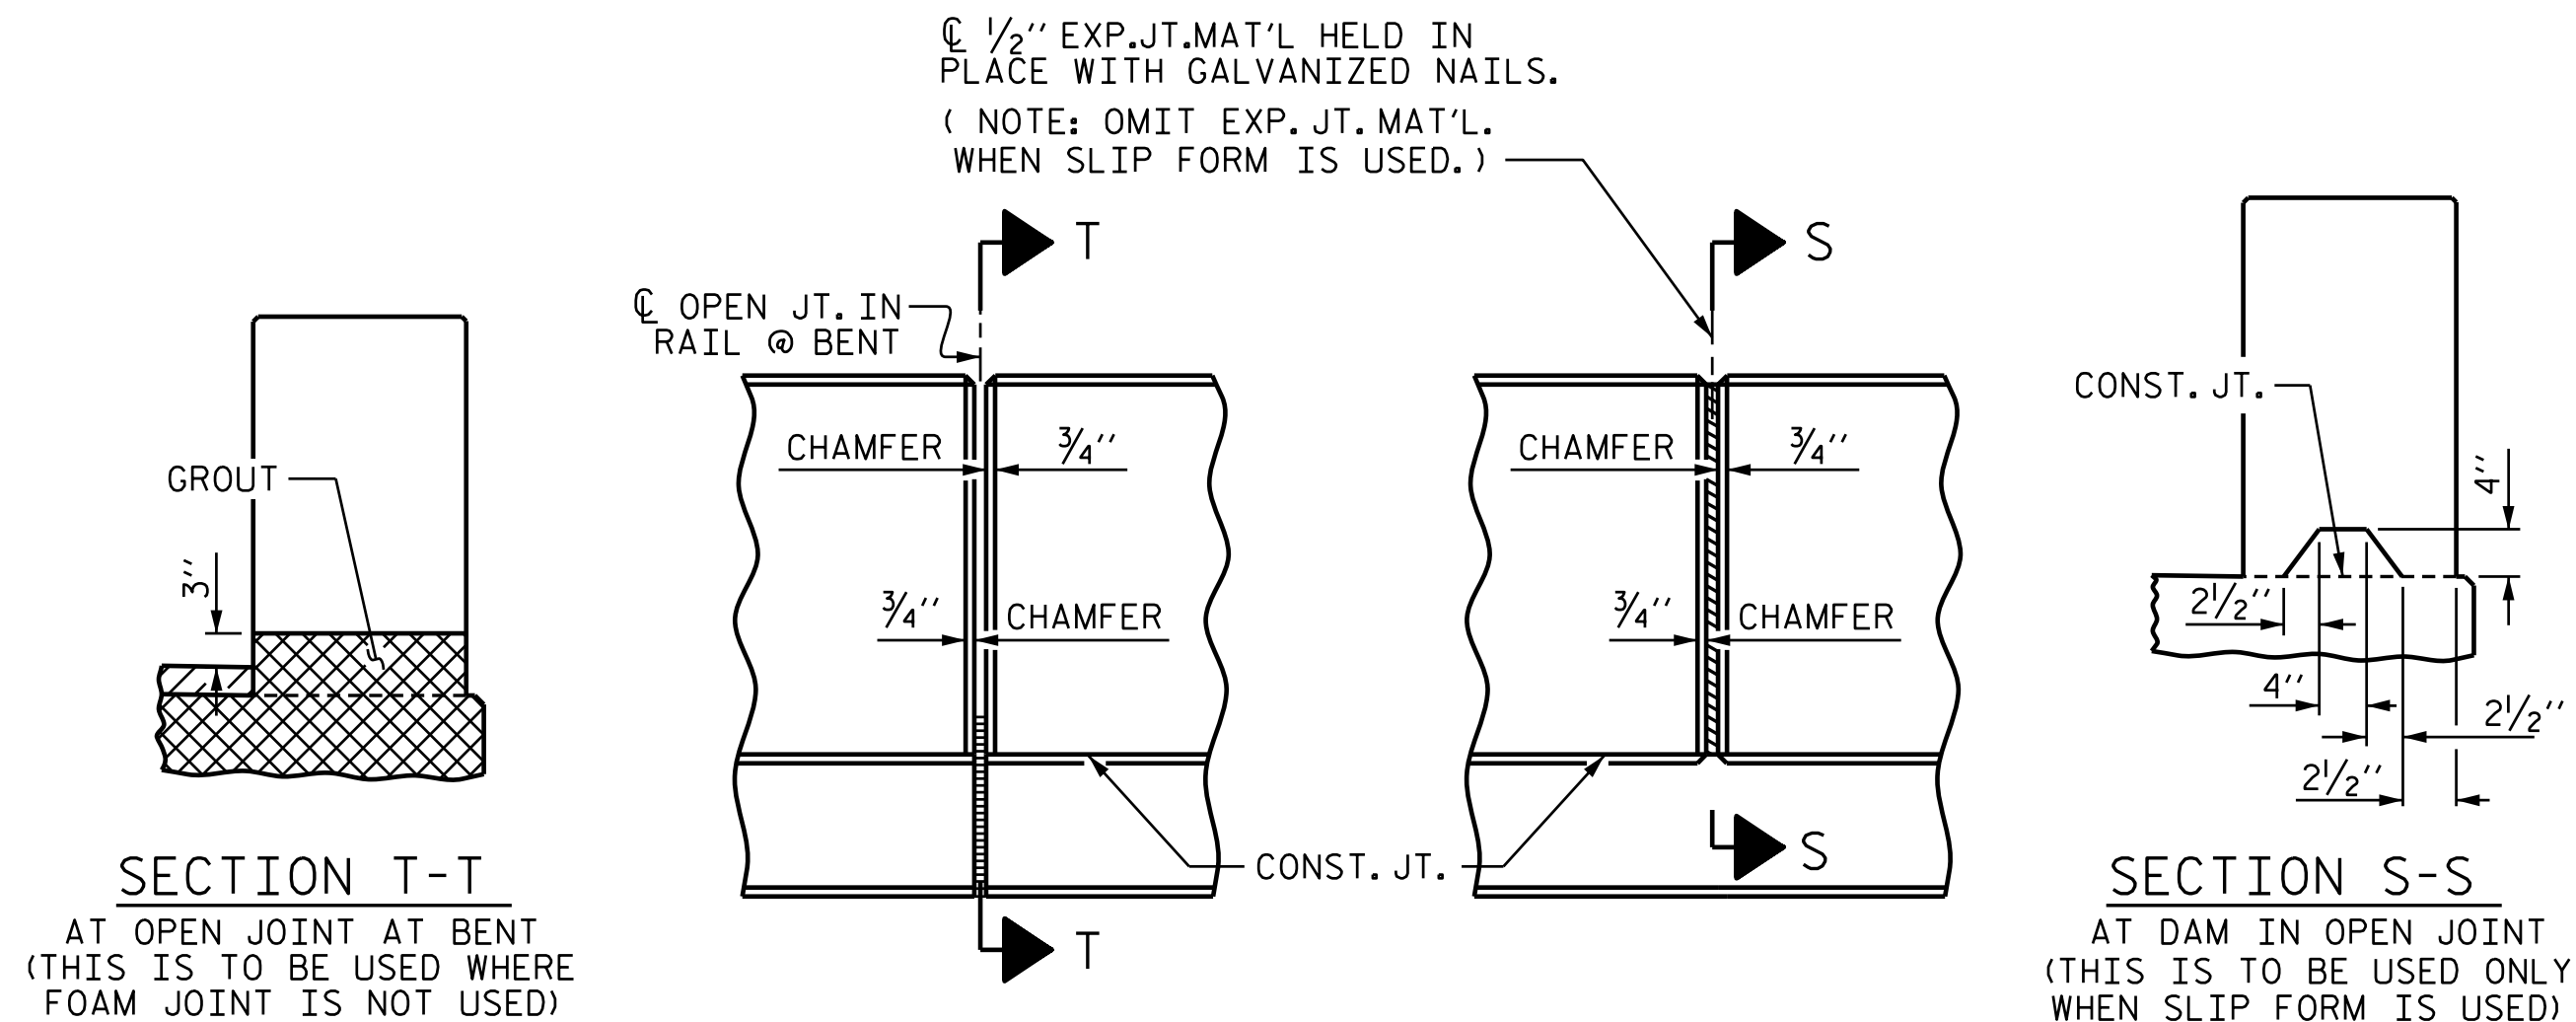


ELEVATION AT EXPANSION JOINTS

PROJECT NO. 17BP.7.R.127
 GUILFORD COUNTY
 STATION: 15+33.00 -L-

SHEET 1 OF 5

STATE OF NORTH CAROLINA
 DEPARTMENT OF TRANSPORTATION
 RALEIGH
 SUPERSTRUCTURE
 CONCRETE PARAPET
 AND END POST
 DETAILS

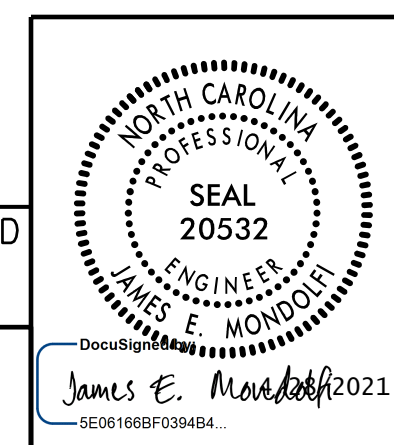

DOCUMENT NOT CONSIDERED FINAL UNLESS ALL SIGNATURES COMPLETED

PLANS PREPARED BY:
M MOTT MACDONALD
 PO Box 700
 Fuquay-Varina, NC 27526
 (919) 552-2253
 www.mottmac.com
 LICENSE NO. F-0669


REVISIONS				SHEET NO.	
NO.	BY:	DATE:	NO.	BY:	DATE:
1			3		
2			4		

S-14
 TOTAL SHEETS
 30

157077
 C:\Users\Planes\17BP.7.R.127-SMU.2MR_400067.dgn
 4/27/2021 12:10:27 PM

DRAWN BY: M. L. MARLEY DATE: 2-2021
 CHECKED BY: J. E. MONDOLFI DATE: 2-2021
 DESIGN ENGINEER OF RECORD: J. E. MONDOLFI DATE: 2-2021

FOR PLAN OF RAIL POST SPACINGS SEE SHEET 2 OF 5

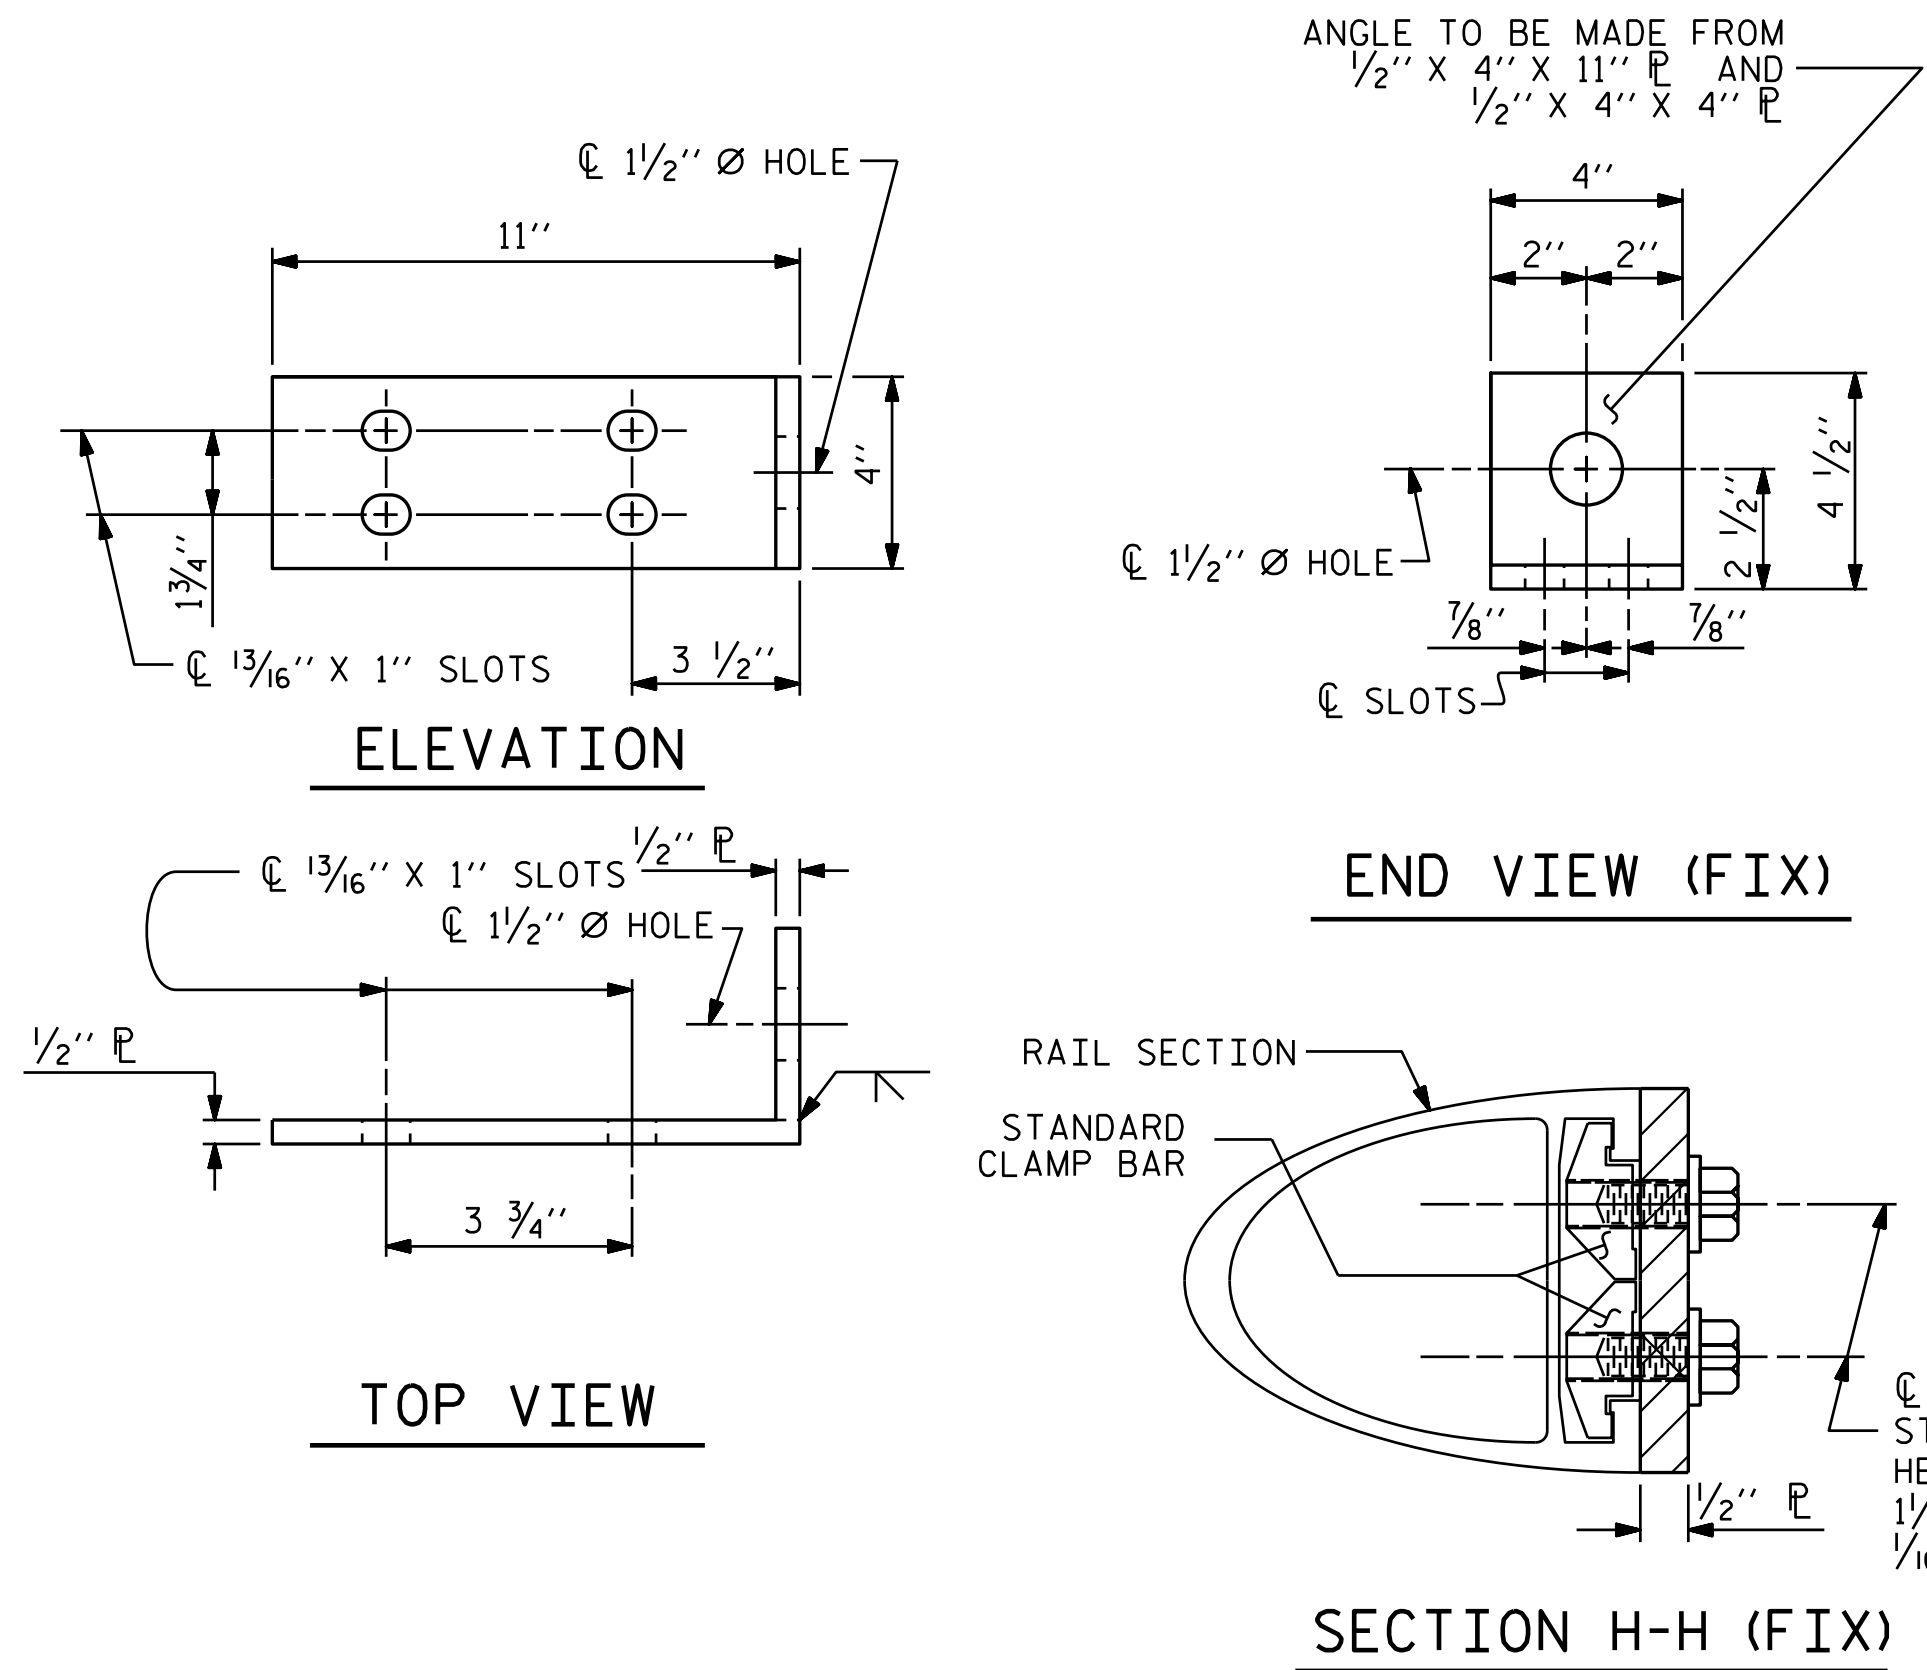

FIXED
DETAILS FOR ATTACHING METAL RAIL TO END POST

NOTES
STRUCTURAL CONCRETE INSERT

- THE STRUCTURAL CONCRETE INSERT ASSEMBLY SHALL CONSIST OF THE FOLLOWING COMPONENTS:
- A. FERRULES SHALL BE MADE FROM STEEL MEETING THE REQUIREMENTS OF AASHTO M169, GRADE 12L14 AND SHALL HAVE A MINIMUM LENGTH OF THREADS OF 1/2".
 - B. 1 - 3/4" Ø X 1 5/8" BOLT WITH WASHER. BOLT SHALL CONFORM TO THE REQUIREMENTS OF ASTM A307. BOLT AND WASHER SHALL BE GALVANIZED. (AT THE CONTRACTOR'S OPTION, STAINLESS STEEL BOLT AND WASHER MAY BE USED AS AN ALTERNATE FOR THE 3/4" Ø X 1 5/8" GALVANIZED BOLT AND WASHER. THEY SHALL CONFORM TO OR EXCEED THE MECHANICAL REQUIREMENTS OF ASTM A307. THE USE OF THIS ALTERNATE SHALL BE APPROVED BY THE ENGINEER.)
 - C. WIRE STRUT SHOWN IN THE CONCRETE INSERT ASSEMBLY DETAIL IS THE MINIMUM ALLOWABLE SIZE AND SHALL HAVE A MINIMUM TENSILE STRENGTH OF 100,000 PSI. AS AN OPTION, A 1/16" Ø WIRE STRUT WITH A MINIMUM TENSILE STRENGTH OF 90,000 PSI IS ACCEPTABLE.

NOTES
METAL RAIL TO END POST CONNECTION


- THE METAL RAIL TO END POST CONNECTION SHALL CONSIST OF THE FOLLOWING COMPONENTS:
- A. 1/2" PLATES SHALL CONFORM TO AASHTO M270 GRADE 36 AND SHALL BE GALVANIZED AFTER FABRICATION.
 - B. 3/4" STRUCTURAL CONCRETE INSERT SHALL HAVE A WORKING LOAD SHEAR CAPACITY OF 4800 LBS. THE FERRULES SHALL ENGAGE A 3/4" Ø X 1 5/8" BOLT WITH 2" O.D. WASHER IN PLACE. THE 3/4" Ø X 1 5/8" BOLT SHALL HAVE N. C. THREADS.
 - C. CAP SCREWS FOR RAIL ATTACHMENT TO ANGLE SHALL CONFORM TO THE REQUIREMENTS OF ASTM F593 ALLOY 305 STAINLESS STEEL. CAP SCREWS TO BE CENTERED IN SLOTS AT 60°F.
 - D. STANDARD CLAMP BARS (SEE METAL RAIL SHEET).
 - E. 1/2" Ø PIPE SLEEVES (IF REQUIRED) TO BE GALVANIZED.

THE COST OF THE STANDARD CLAMP BARS AND CAP SCREWS USED IN THE METAL RAIL TO END POST CONNECTION SHALL BE INCLUDED IN THE UNIT CONTRACT PRICE BID FOR LINEAR FEET OF 2 BAR METAL RAILS.


THE 3/4" STRUCTURAL CONCRETE INSERT WITH BOLT SHALL BE ASSEMBLED IN THE SHOP.

THE COST OF THE 3/4" STRUCTURAL CONCRETE INSERT ASSEMBLY, AND THE 1/2" PLATES COMPLETE IN PLACE SHALL BE INCLUDED IN THE VARIOUS PAY ITEMS.

THE CONTRACTOR, AT HIS OPTION, MAY USE AN ADHESIVE BONDING SYSTEM IN LIEU OF THE STRUCTURAL CONCRETE INSERT EMBEDDED IN THE END POST. IF THE ADHESIVE BONDING SYSTEM IS USED, THE 3/4" Ø X 1 5/8" BOLT WITH WASHER SHALL BE REPLACED WITH A 3/4" Ø X 6 1/2" BOLT AND 2" O.D. WASHER. ALL SPECIFICATIONS THAT APPLY TO THE 3/4" Ø X 1 5/8" BOLT SHALL APPLY TO THE 3/4" Ø X 6 1/2" BOLT. FIELD TESTING OF THE ADHESIVE BONDING SYSTEM IS NOT REQUIRED.

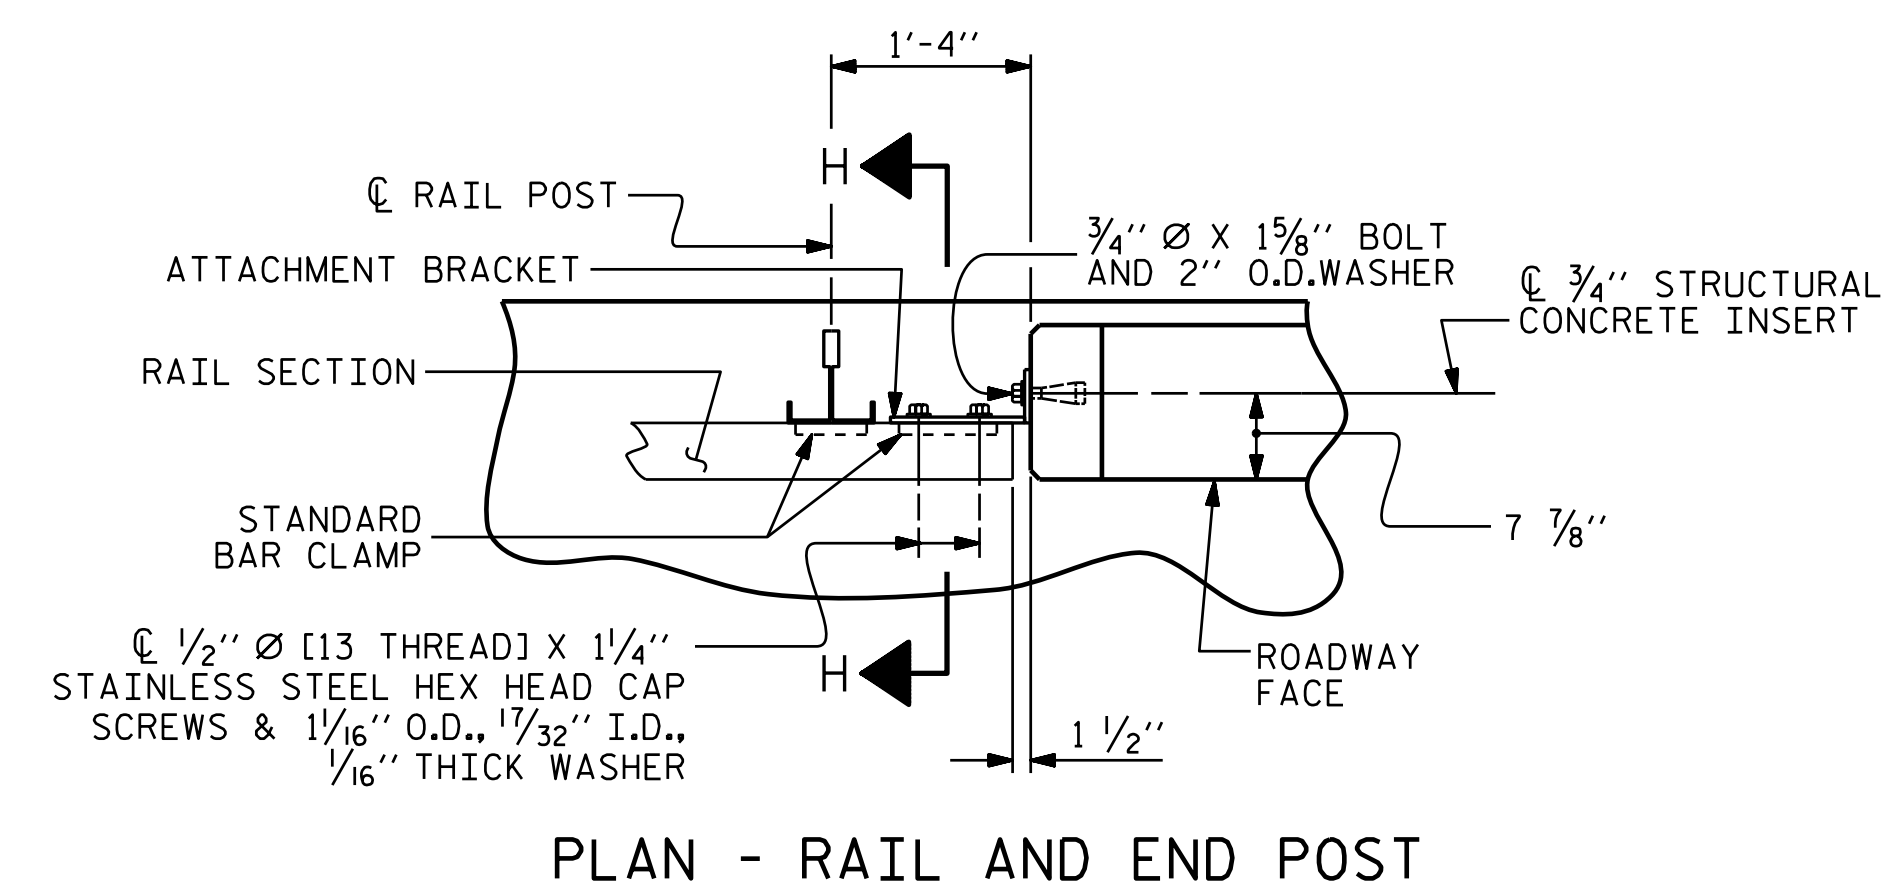

PLAN - RAIL AND END POST

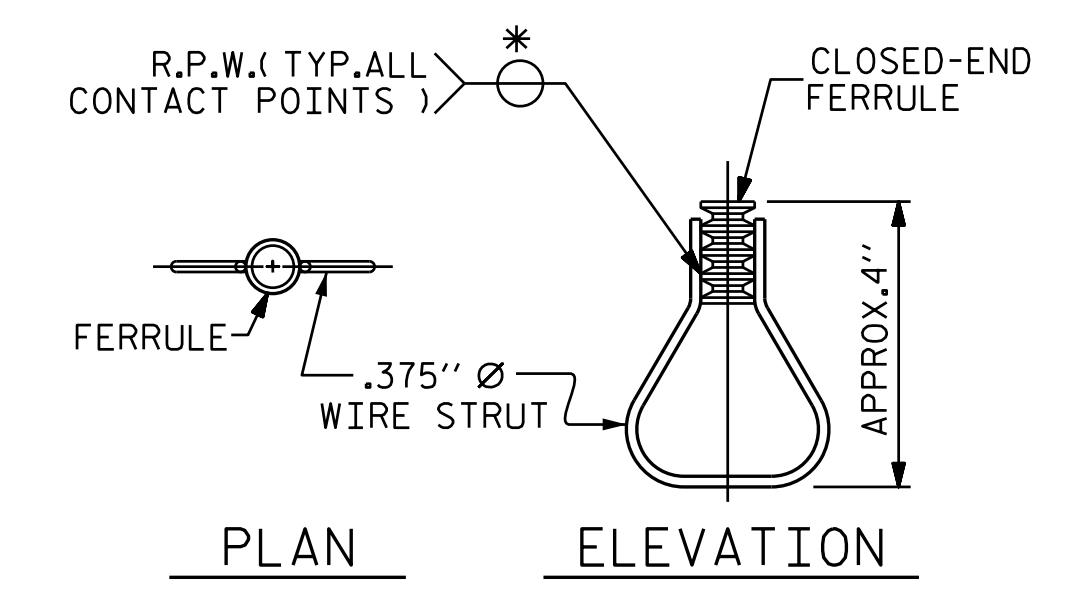

PLAN ELEVATION


STRUCTURAL CONCRETE INSERT

* EACH WELDED ATTACHMENT OF WIRE TO FERRULE SHALL DEVELOP THE TENSILE STRENGTH OF THE WIRE.

PROJECT NO. 17BP.7.R.127
GUILFORD COUNTY
STATION: 15+33.00 -L-

SHEET 3 OF 5

STATE OF NORTH CAROLINA
DEPARTMENT OF TRANSPORTATION
RALEIGH
SUPERSTRUCTURE
RAIL POST SPACINGS
AND
END OF RAIL DETAILS
FOR TWO BAR METAL RAILS

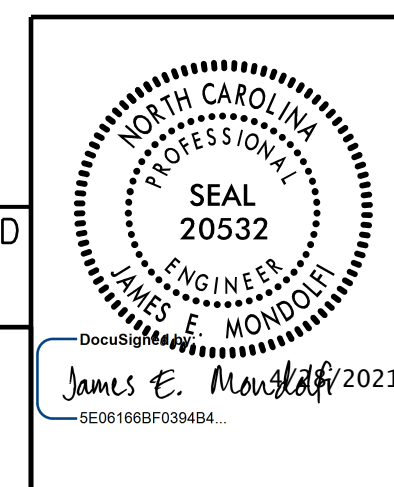


DOCUMENT NOT CONSIDERED FINAL UNLESS ALL SIGNATURES COMPLETED

PLANS PREPARED BY:
M MOTT MACDONALD
PO Box 700
Fuquay-Varina, NC 27526
(919) 552-2253
www.mottmac.com
LICENSE NO. F-0669

REVISIONS						SHEET NO.
NO.	BY:	DATE:	NO.	BY:	DATE:	5-16
1			3			TOTAL SHEETS
2			4			30

W:\157077\Drawings\17BP.7.R.127-SMU-2MR-400067.dgn
 4/27/2021 12:10:23 PM

DRAWN BY: M. L. MARLEY DATE: 2/2021
 CHECKED BY: J. E. MONDOLFI DATE: 2/2021
 DESIGN ENGINEER OF RECORD: J. E. MONDOLFI DATE: 2/2021

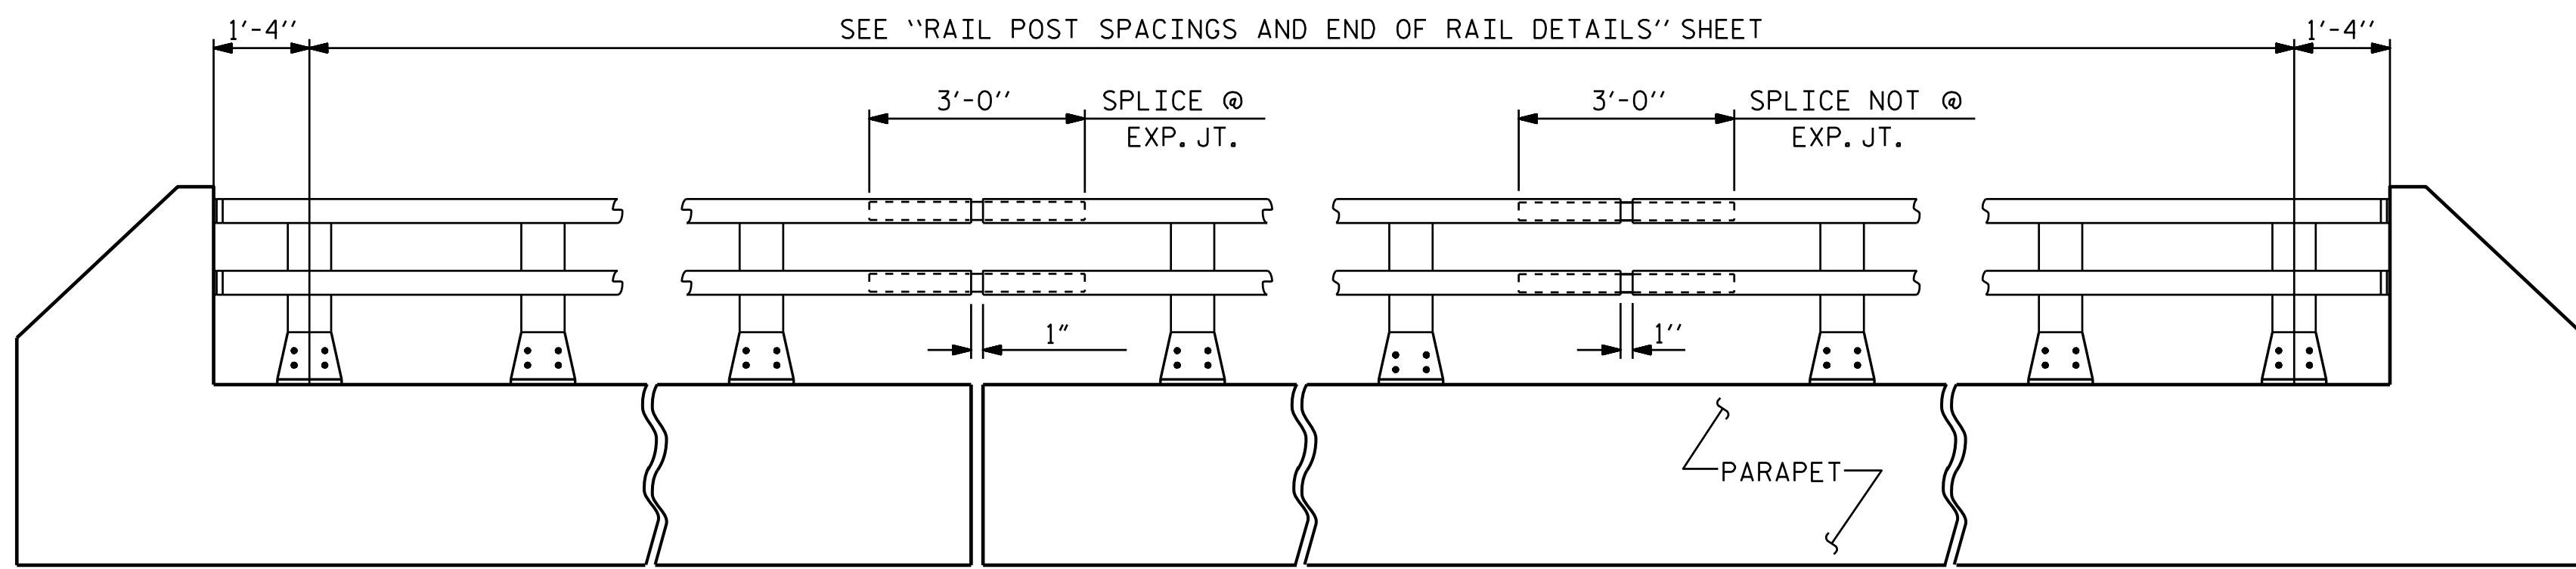

ELEVATION

NOTE : FOR ATTACHMENT OF METAL RAIL TO END POST, SEE SHEET 3 OF 5.

NOTES

AT THE CONTRACTOR'S OPTION, METAL RAIL MAY BE EITHER ALUMINUM OR GALVANIZED STEEL IN ACCORDANCE WITH THE REQUIREMENTS OF THE GENERAL NOTES AND THE FOLLOWING SPECIFICATIONS FOR THE ALTERNATE MATERIALS; HOWEVER, THE CONTRACTOR WILL BE REQUIRED TO USE THE SAME RAIL MATERIAL ON ALL STRUCTURES ON THE PROJECT FOR WHICH METAL RAIL IS DESIGNATED.

UNLESS OTHERWISE REQUIRED IN THE CONTRACT DOCUMENTS, THE CONTRACTOR HAS THE OPTION TO USE AN ALTERNATE TO THE 2 BAR METAL RAIL. THE ALTERNATE RAIL SHALL MEET THE REQUIREMENTS OF THE AASHTO LRFD BRIDGE DESIGN SPECIFICATIONS AND MUST BE LISTED ON THE DEPARTMENT'S APPROVED PRODUCTS LIST (APL) UNDER "2 BAR METAL RAIL ALTERNATE". ADJUSTMENTS TO THE CONCRETE PARAPET WILL NOT BE ALLOWED.

ALUMINUM RAILS

MATERIAL FOR POSTS, BASES AND RAILS, EXPANSION BARS AND CLAMP BARS SHALL BE ASTM B-221 ALLOY 6061-T6. MATERIAL FOR RIVETS SHALL BE ASTM B316 ALLOY 6061-T6. RIVETS SHALL BE STANDARD BUTTON HEAD AND CONE POINT COLD DRIVEN AS PER DRAWING. THE BASE OF RAIL POSTS, OR ANY OTHER ALUMINUM SURFACE IN CONTACT WITH CONCRETE SHALL BE THOROUGHLY COATED WITH AN ALUMINUM IMPREGNATED CAULKING COMPOUND OF APPROVED QUALITY. MATERIAL FOR SHIMS TO BE ASTM B209 ALLOY 6061-T6.


GALVANIZED STEEL RAILS

MATERIAL AND GALVANIZING ARE TO CONFORM TO THE FOLLOWING SPECIFICATIONS: POST, POST BASES, RAILS, EXPANSION BARS AND CLAMP BARS: AASHTO M270 GRADE 36 STRUCTURAL STEEL - GALVANIZED TO AASHTO M111. RIVETS: RIVETS SHALL MEET THE REQUIREMENTS OF ASTM A502 FOR GRADE 1 RIVETS. THE CUT ENDS OF GALVANIZED STEEL RAILING, AFTER GRINDING SMOOTH SHALL BE GIVEN TWO COATS OF ZINC RICH PAINT MEETING THE REQUIREMENTS OF FEDERAL SPECIFICATION MIL-P-26915 USAF TYPE 1, OR OF FEDERAL SPECIFICATIONS TT-P-641. SHIMS: SHIMS SHALL MEET THE REQUIREMENTS OF ASTM A570 FOR GRADE 33 OR A611 FOR GRADE C AND SHALL BE GALVANIZED IN ACCORDANCE WITH AASHTO M111. RAIL CAPS: RAIL CAPS SHALL MEET THE REQUIREMENTS OF ASTM A570 FOR GRADE 33 OR A611 FOR GRADE C AND SHALL BE GALVANIZED IN ACCORDANCE WITH AASHTO M111.


GENERAL NOTES

RAILING SHALL BE CONTINUOUS FROM END POST TO END POST OF BRIDGE. EACH JOINT IN RAIL LENGTH SHALL BE SPLICED AS DETAILED. PANEL LENGTHS OF RAIL SHALL BE ATTACHED TO A MINIMUM OF THREE POSTS. FOR END OF RAIL TO CLEAR FACE OF CONCRETE END POST DIMENSION, SEE SHEET 3 OF 5. CAP SCREWS SHALL BE ASTM F593 ALLOY 305 STAINLESS STEEL. WASHERS SHALL MEET THE REQUIREMENTS OF ASTM F844 EXCEPT THEY SHALL BE MADE FROM ALLOY 304 STAINLESS STEEL. CERTIFIED MILL REPORTS ARE REQUIRED FOR RAILS AND POSTS. SHOP INSPECTION IS NOT REQUIRED. METAL RAIL POSTS SHALL BE SET NORMAL TO CURB GRADE. METHOD OF MEASUREMENT FOR METAL RAILS: FOR LENGTH OF METAL RAILS TO BE PAID FOR, SEE THE STANDARD SPECIFICATIONS. CURVED RAIL USAGE: WHERE RAILS ARE TO BE USED ON BRIDGES ON HORIZONTAL AND/OR VERTICAL CURVATURE THE CONTRACTOR MAY, AT HIS OPTION, HAVE THE REQUIRED CURVATURE IN THE RAIL FORMED IN THE SHOP OR IN THE FIELD. IN EITHER EVENT, THE RAIL SHALL CONFORM WITHOUT BUCKLING OR KINKING TO THE REQUIRED CURVATURE IN A UNIFORM MANNER ACCEPTABLE TO THE ENGINEER. TO INSURE FUTURE IDENTIFICATION OF THE FABRICATOR, A PERMANENT IDENTIFYING MARK SHALL BE PLACED ON EACH POST. THE METHOD OF MARKING AND LOCATION SHALL BE SUCH THAT IT DOES NOT DETRACT FROM THE APPEARANCE OF THE POST, BUT REMAINS VISIBLE AFTER RAIL PLACEMENT. SHIMS SHALL BE USED AS NECESSARY FOR POST ALIGNMENT. ALLOY 6351-T5 MAY BE SUBSTITUTED FOR ALLOY 6061-T6 WHERE APPLICABLE. MINOR VARIATIONS IN DETAILS OF METAL RAIL WILL BE CONSIDERED. DETAILS OF SUCH VARIATIONS, IF DESIRED, SHALL BE SUBMITTED FOR APPROVAL. GROOVED CONTRACTION JOINTS, 1/2" IN DEPTH, SHALL BE TOOLED IN ALL EXPOSED FACES OF THE PARAPET AND IN ACCORDANCE WITH ARTICLE 825-10(B) OF THE STANDARD SPECIFICATIONS. A CONTRACTION JOINT SHALL BE LOCATED AT EACH THIRD POINT BETWEEN PARAPET EXPANSION JOINTS. ONLY ONE CONTRACTION JOINT IS REQUIRED AT MIDPOINT OF PARAPET SEGMENTS LESS THAN 20 FEET IN LENGTH AND NO CONTRACTION JOINTS ARE REQUIRED FOR THOSE SEGMENTS LESS THAN 10 FEET IN LENGTH.


PAY LENGTH = 284.89 LIN. FT.

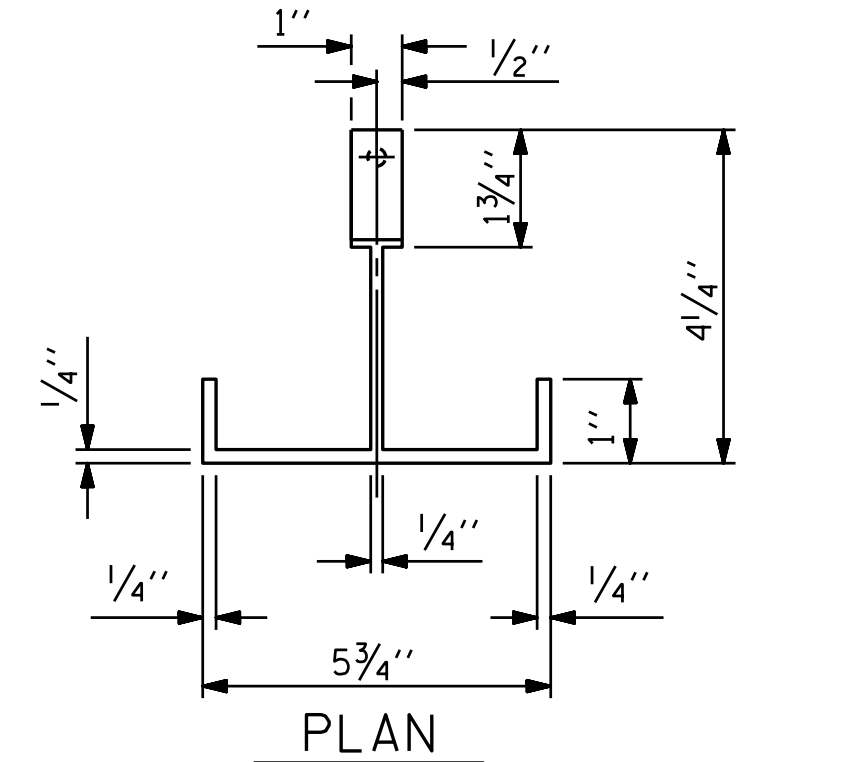


PLAN

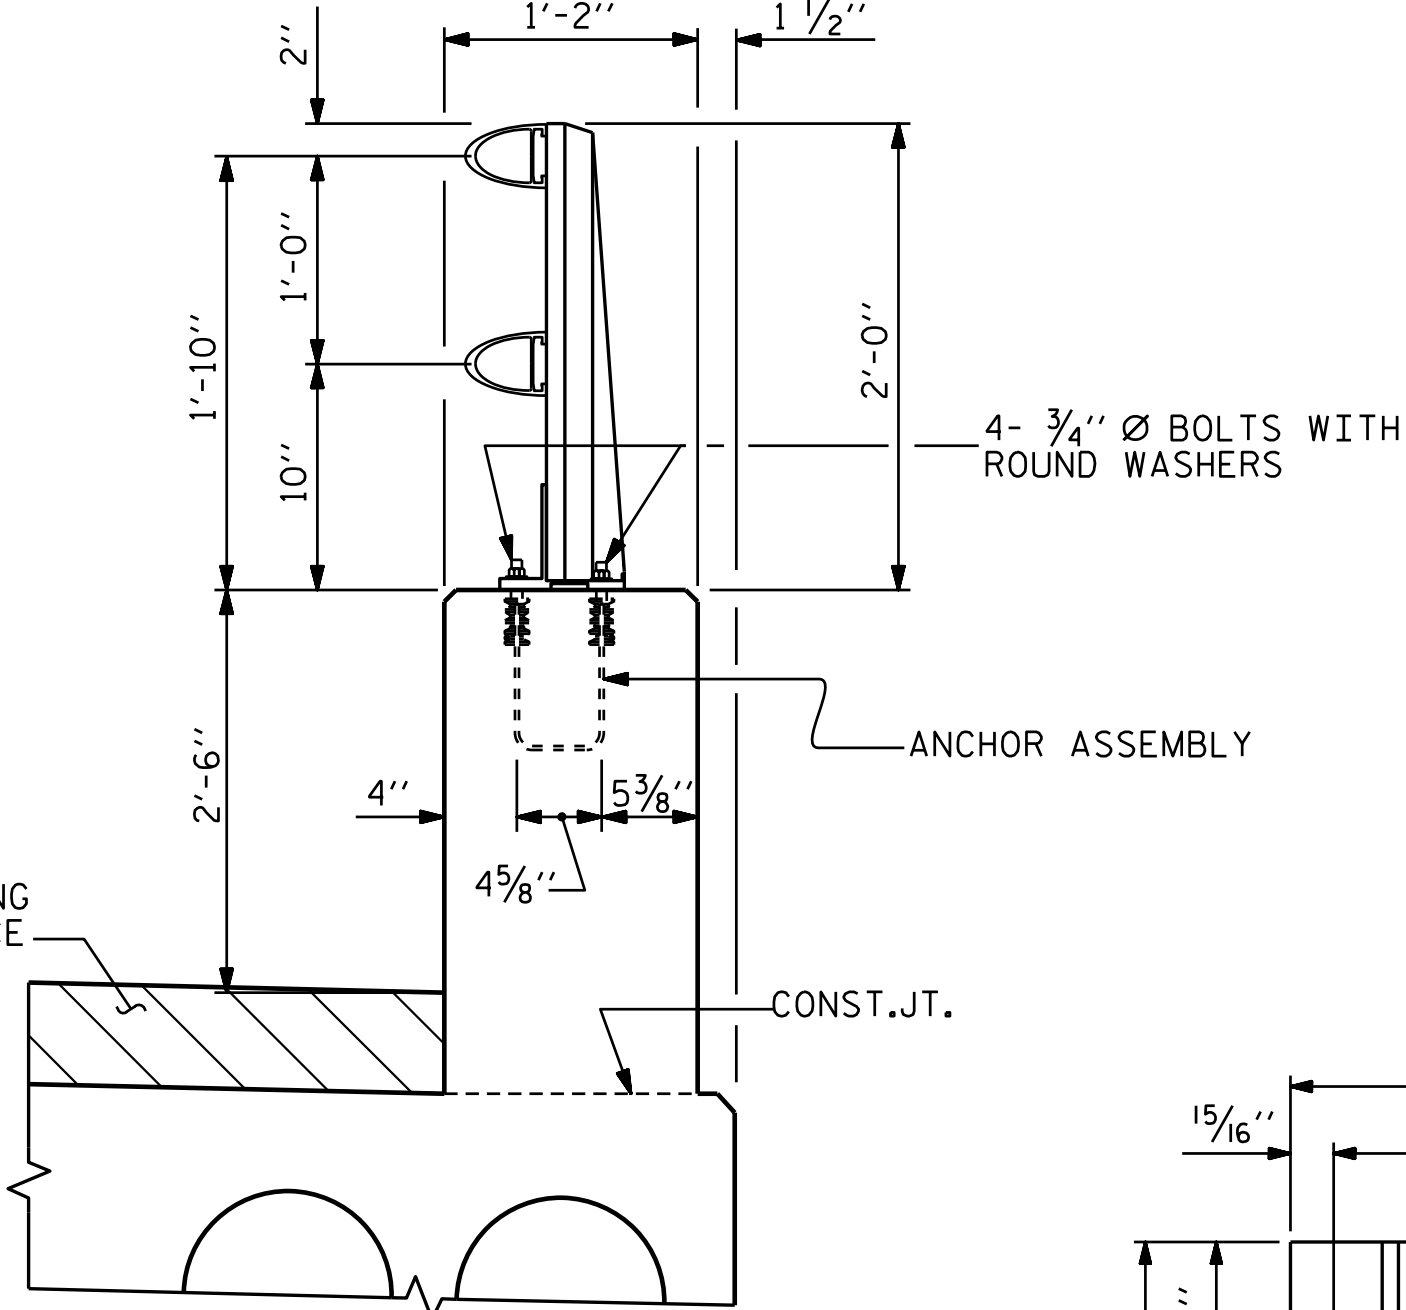


SECTION THRU PARAPET AND RAIL

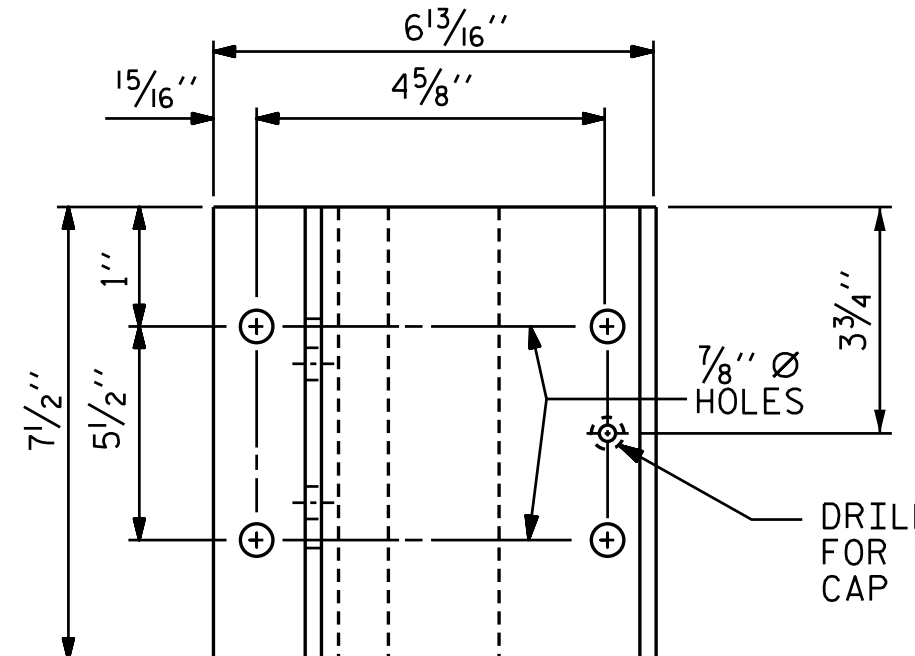

DRILL & COUNTER BORE FOR 3/8" Ø [16 THREAD] CAP SCREW

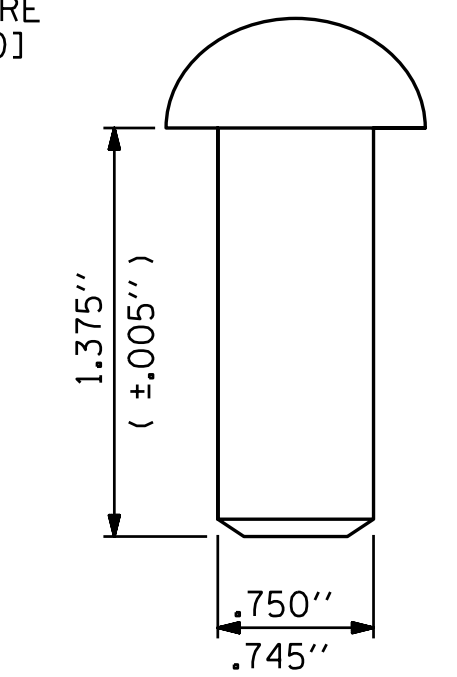


RIVET DETAIL

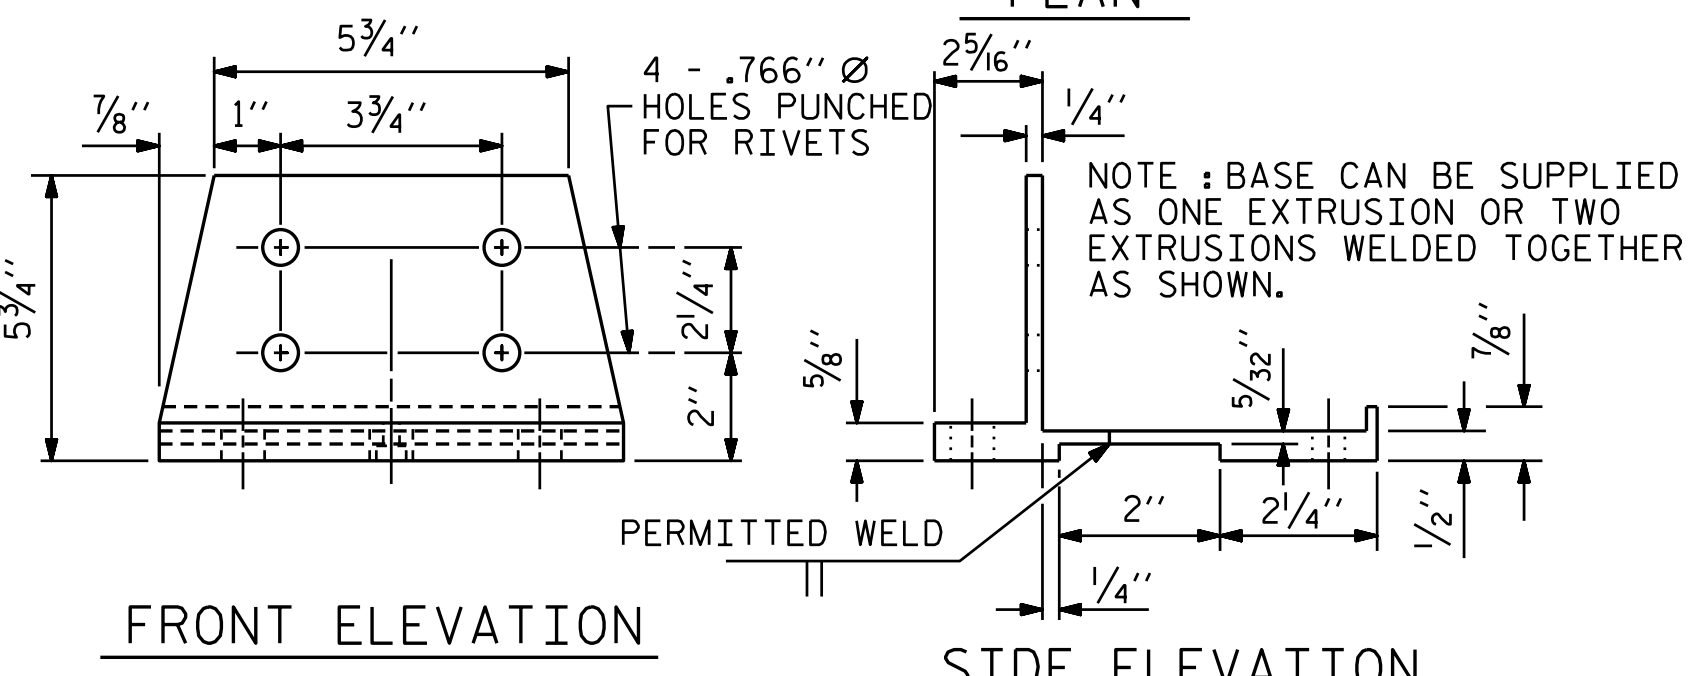

FRONT ELEVATION

SIDE ELEVATION

POST BASE DETAILS

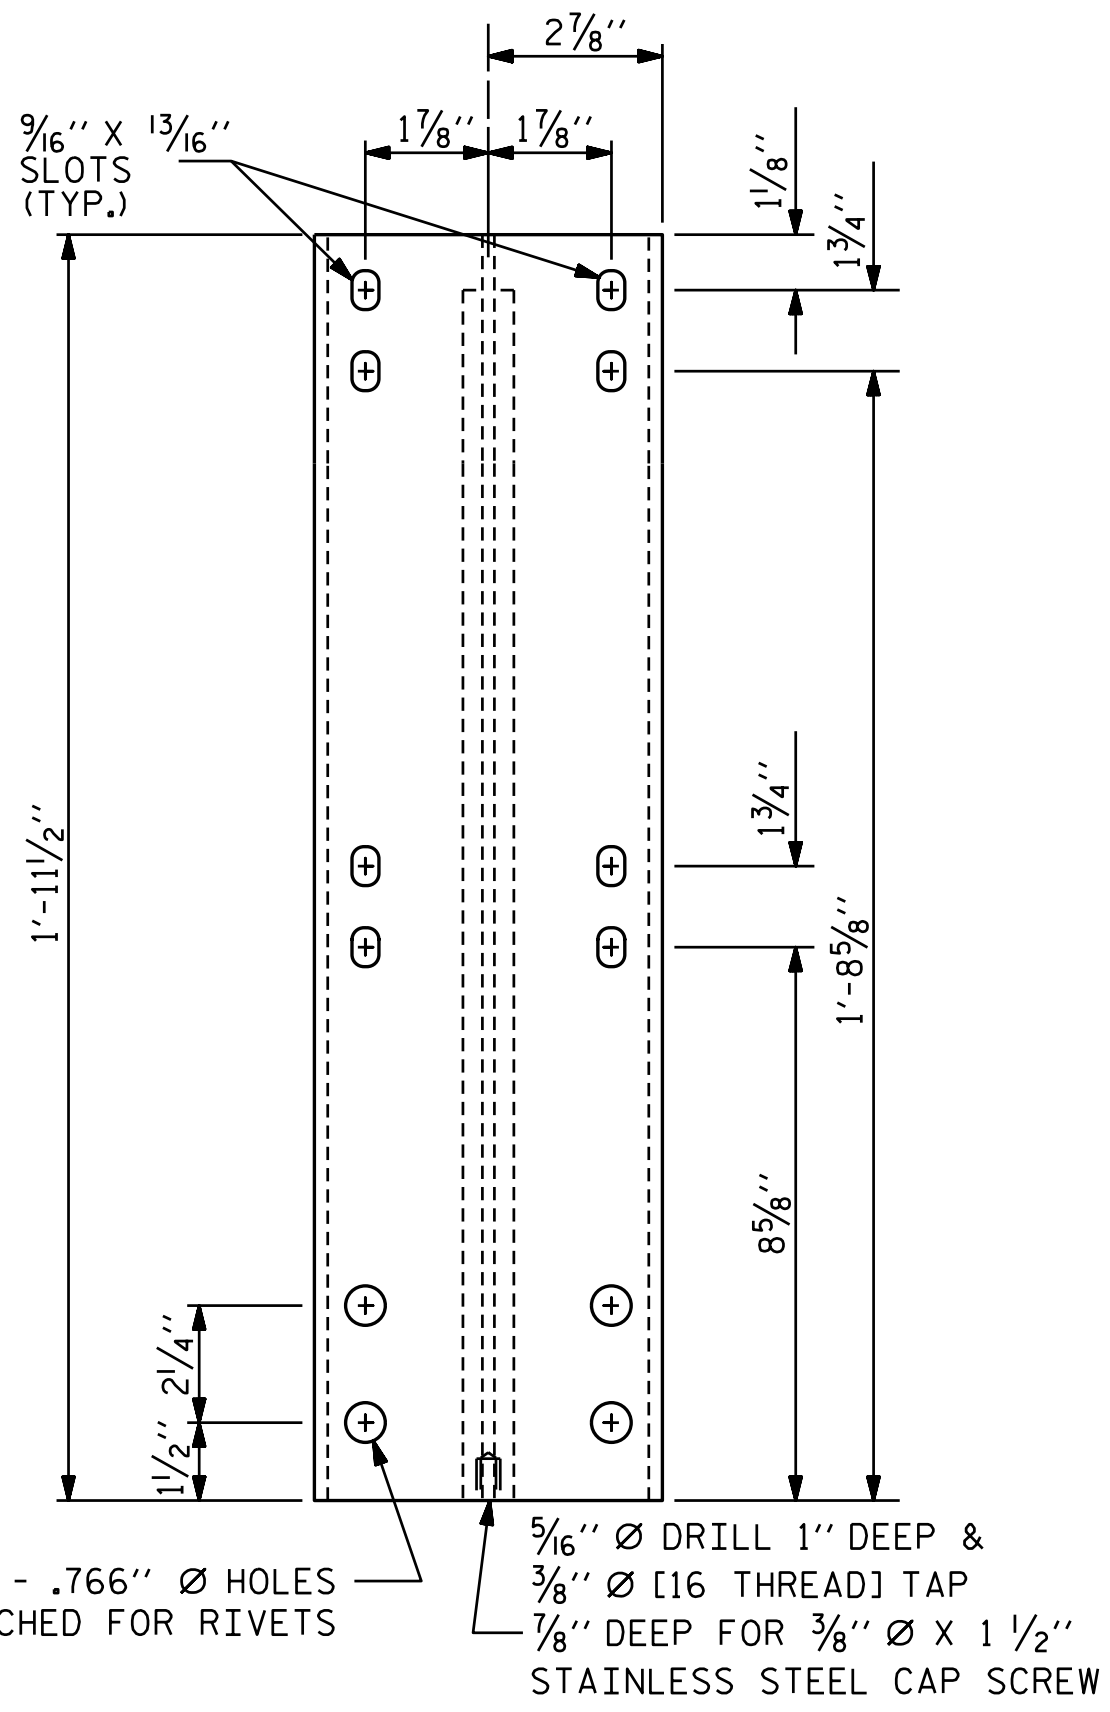

FRONT ELEVATION

SIDE ELEVATION


DETAILS OF POST

PROJECT NO. 17BP.7.R.127
GUILFORD COUNTY
STATION: 15+33.00 -L-

SHEET 4 OF 5

STATE OF NORTH CAROLINA
DEPARTMENT OF TRANSPORTATION
RALEIGH
SUPERSTRUCTURE
2 BAR METAL RAIL

REVISIONS						SHEET NO.
NO.	BY:	DATE:	NO.	BY:	DATE:	S-17
1			3			TOTAL SHEETS
2			4			30

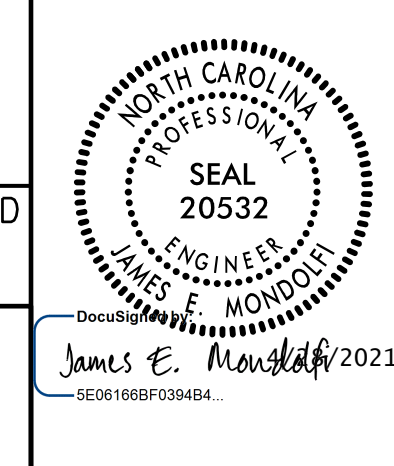

DOCUMENT NOT CONSIDERED FINAL UNLESS ALL SIGNATURES COMPLETED
PLANS PREPARED BY:
MOTT MACDONALD
PO Box 700
Fuquay-Varina, NC 27526
(919) 552-2253
www.mottmac.com
LICENSE NO. F-0669

W:\157077\Drawings\17BP.7.R.127-SMU-2MR-400067.dgn
 4/27/2021 12:10:23 PM

DRAWN BY: M. L. MARLEY DATE: 2-2021
 CHECKED BY: J. E. MONDOLFI DATE: 2-2021
 DESIGN ENGINEER OF RECORD: J. E. MONDOLFI DATE: 2-2021

NOTES


STRUCTURAL CONCRETE ANCHOR ASSEMBLY

THE STRUCTURAL CONCRETE ANCHOR ASSEMBLY SHALL CONSIST OF THE FOLLOWING COMPONENTS :


- A. FERRULES SHALL BE MADE FROM STEEL MEETING THE REQUIREMENTS OF AASHTO M169, GRADE 12L14 AND SHALL HAVE A MINIMUM LENGTH OF THREADS OF 2" FOR 3/4" FERRULES.
- B. 4 - 3/4" Ø X 2 1/2" BOLTS WITH WASHERS. BOLTS SHALL CONFORM TO THE REQUIREMENTS OF ASTM A307. BOLTS AND WASHERS SHALL BE GALVANIZED. AT THE CONTRACTOR'S OPTION, STAINLESS STEEL BOLTS AND WASHERS MAY BE USED AS AN ALTERNATE FOR THE 3/4" Ø X 2 1/2" GALVANIZED BOLTS AND WASHERS. THEY SHALL CONFORM TO OR EXCEED THE MECHANICAL REQUIREMENTS OF ASTM A307. THE USE OF THIS ALTERNATE SHALL BE APPROVED BY THE ENGINEER.
- C. WIRE STRUT SHOWN IN THE CONCRETE ANCHOR ASSEMBLY DETAIL IS THE MINIMUM ALLOWABLE SIZE AND SHALL HAVE A MINIMUM TENSILE STRENGTH OF 100,000 PSI. AS AN OPTION, A 1/16" Ø WIRE STRUT WITH A MINIMUM TENSILE STRENGTH OF 90,000 PSI IS ACCEPTABLE.
- D. THE METAL RAIL ANCHOR ASSEMBLIES TO BE HOT DIPPED GALVANIZED TO CONFORM TO REQUIREMENTS OF AASHTO M111.
- E. THE COST OF THE METAL RAIL ANCHOR ASSEMBLY WITH BOLTS AND WASHERS COMPLETE IN PLACE SHALL BE INCLUDED IN THE PRICE BID FOR LINEAR FEET OF METAL RAIL.
- F. BOLTS TO BE TIGHTENED ONE-HALF TURN WITH A WRENCH FROM A FINGER-TIGHT POSITION.

THE CONTRACTOR MAY USE ADHESIVELY ANCHORED ANCHOR BOLTS IN PLACE OF THE METAL RAIL ANCHOR ASSEMBLY. LEVEL ONE FIELD TESTING IS REQUIRED, AND THE YIELD LOAD OF THE 3/4" Ø BOLT IS 10 KIPS. FOR ADHESIVELY ANCHORED ANCHOR BOLTS OR DOWELS, SEE THE STANDARD SPECIFICATIONS.

WHEN ADHESIVELY ANCHORED ANCHOR BOLTS ARE USED, BOLTS SHALL MEET THE REQUIREMENTS OF ASTM F593 ALLOY 304 STAINLESS STEEL WITH MINIMUM 75,000 PSI ULTIMATE STRENGTH. NUTS SHALL MEET THE REQUIREMENTS OF ASTM F594 ALLOY 304 STAINLESS STEEL AND WASHERS SHALL MEET THE REQUIREMENTS OF ASTM F844 EXCEPT THEY SHALL BE MADE FROM ALLOY 304 STAINLESS STEEL.

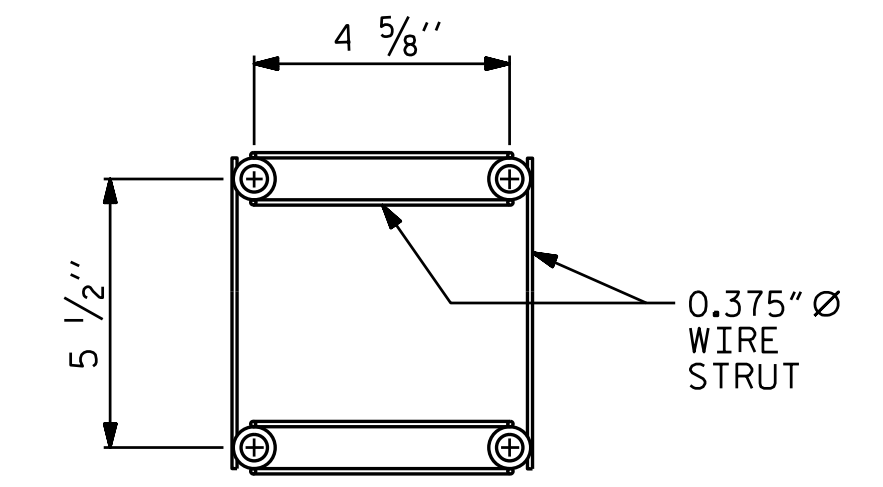

PLAN

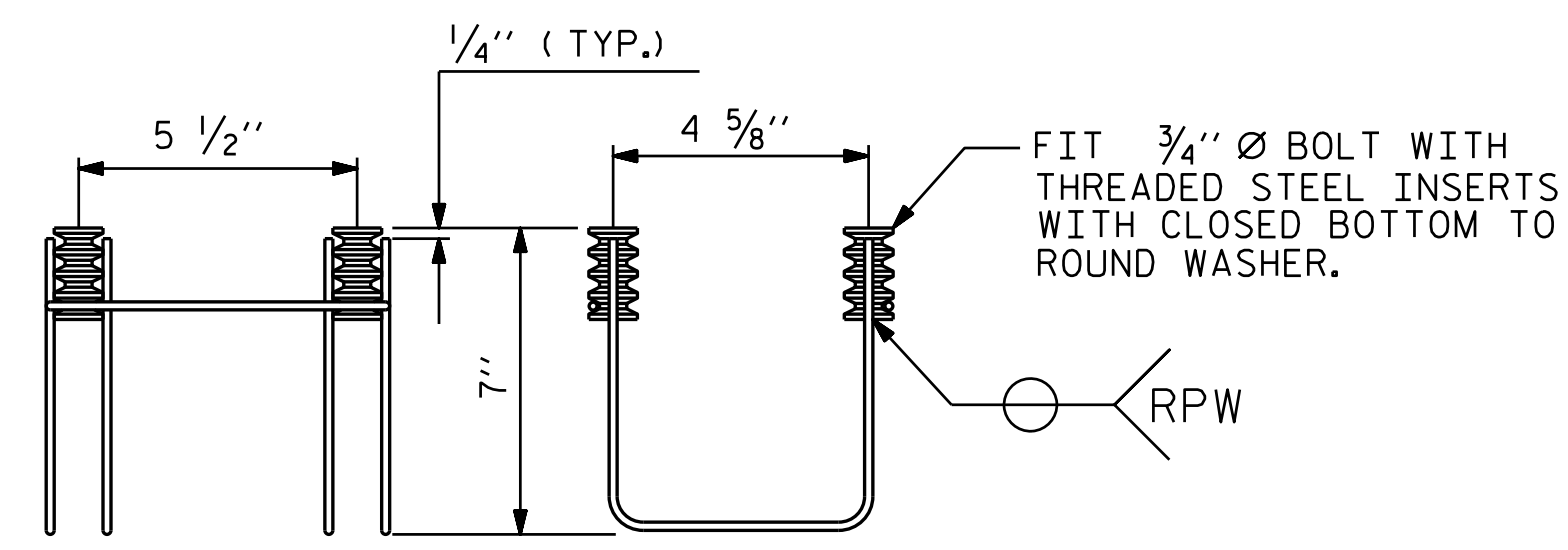


SIDE VIEW

ELEVATION

4-BOLT METAL RAIL ANCHOR ASSEMBLY


(50 ASSEMBLIES REQUIRED)

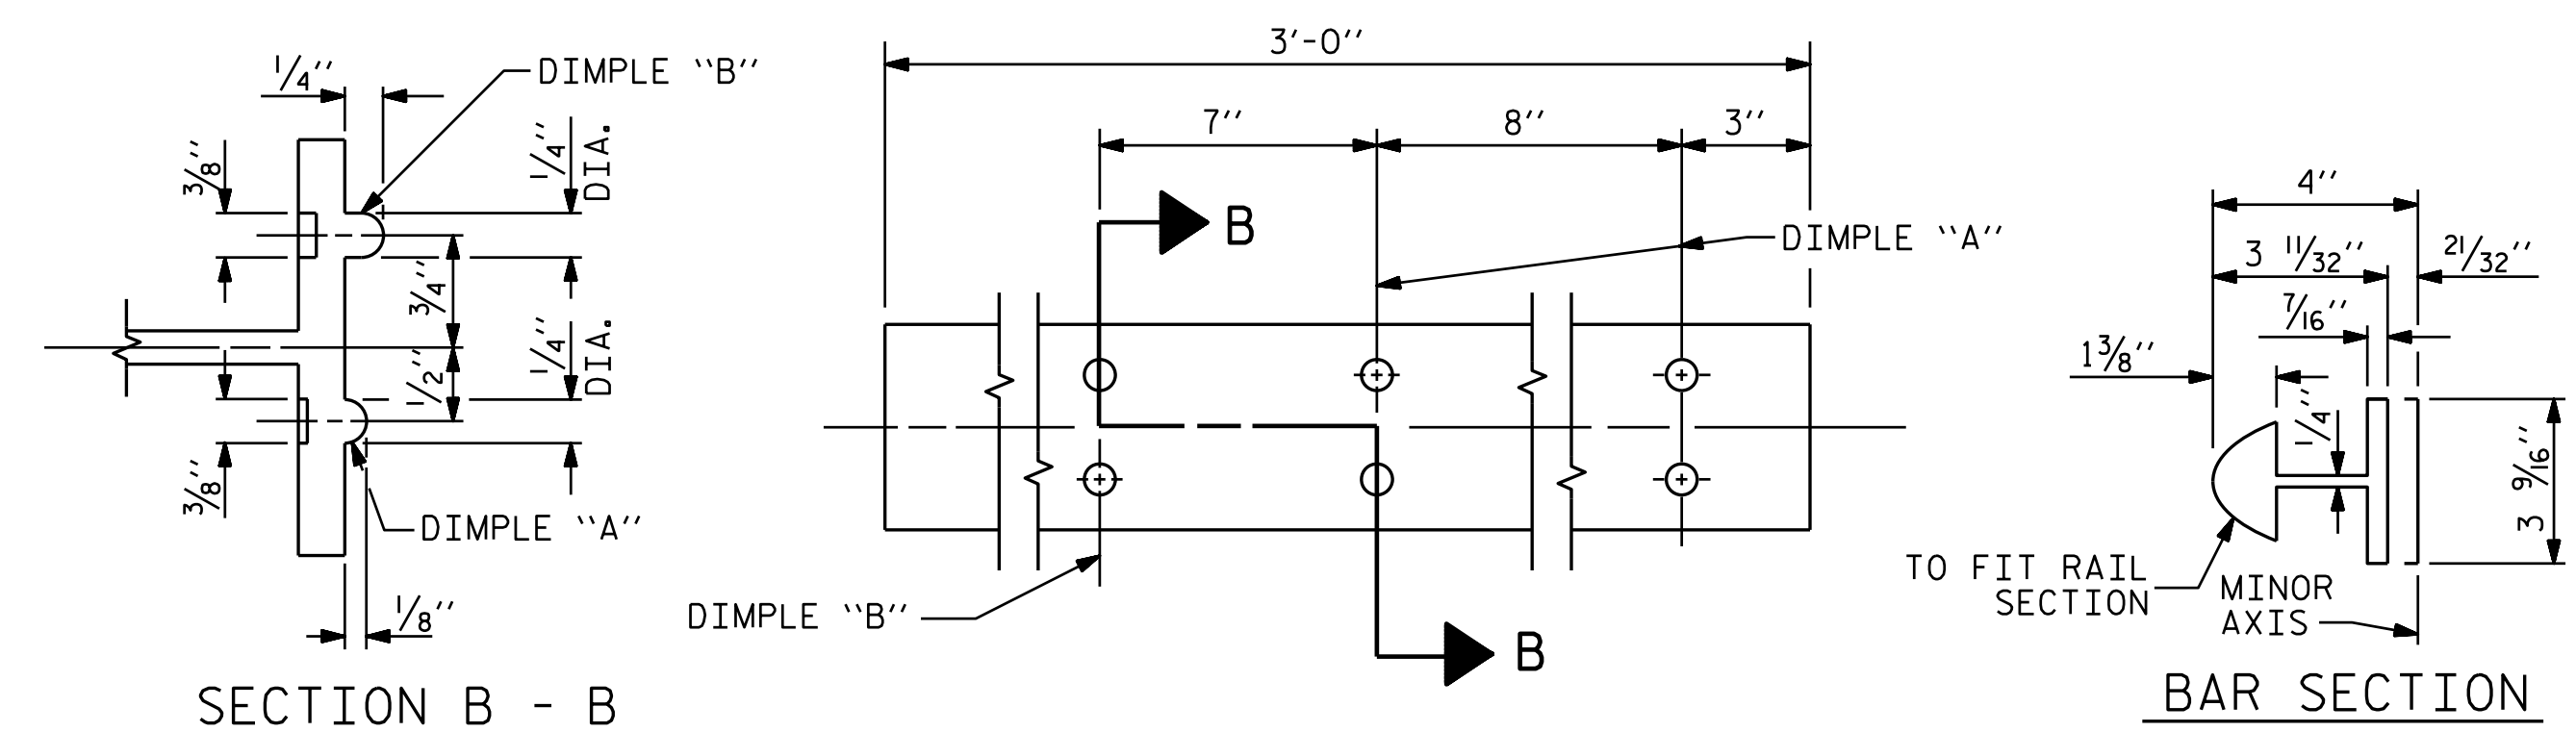

SECTION B - B

EXPANSION BAR DETAILS

BAR SECTION

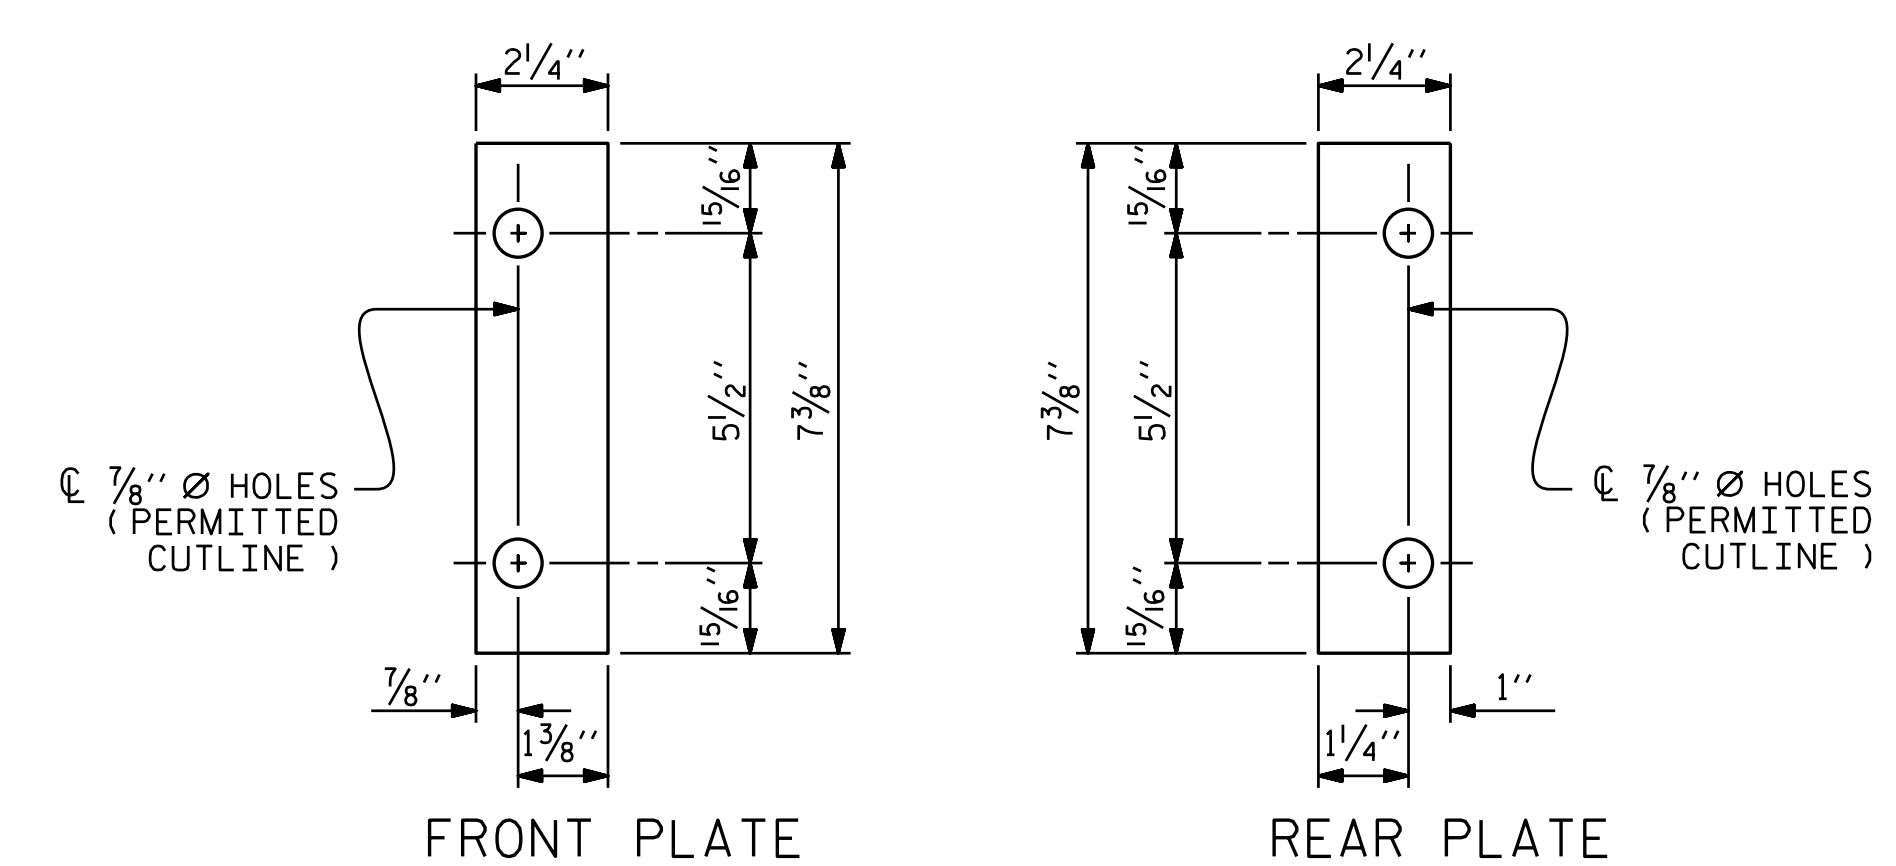


FRONT PLATE


REAR PLATE

SHIM DETAILS

NOTE : SHIMS MAY BE CUT ALONG PERMITTED CUTLINE OR SLOTTED TO EDGE OF PLATE TO FACILITATE PLACEMENT.

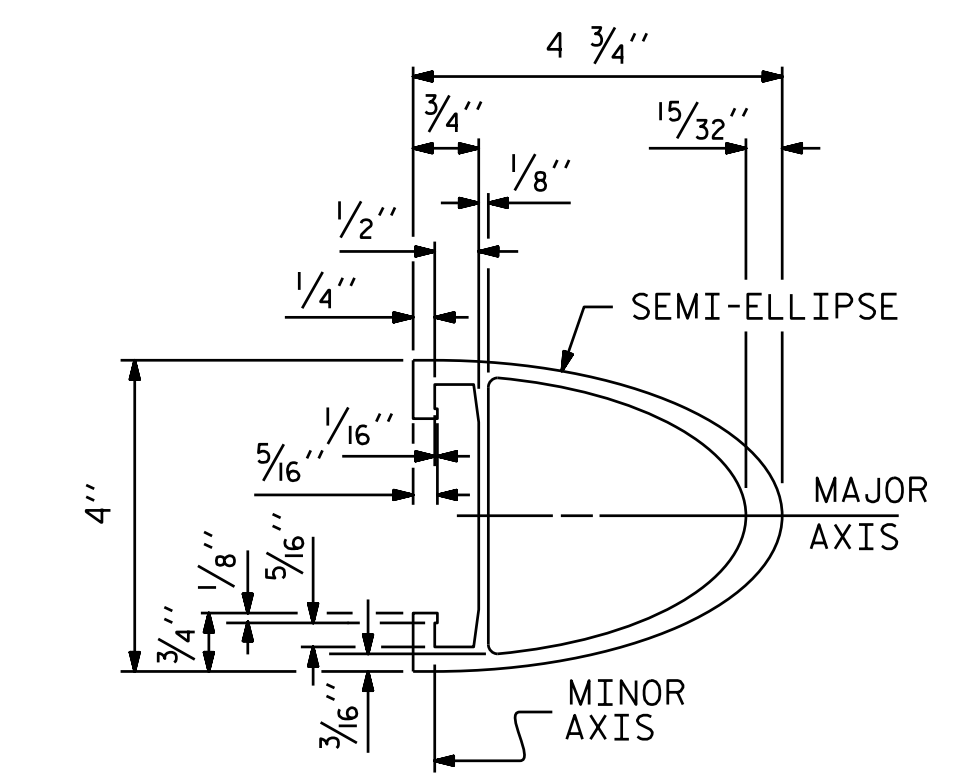


RAIL SECTION

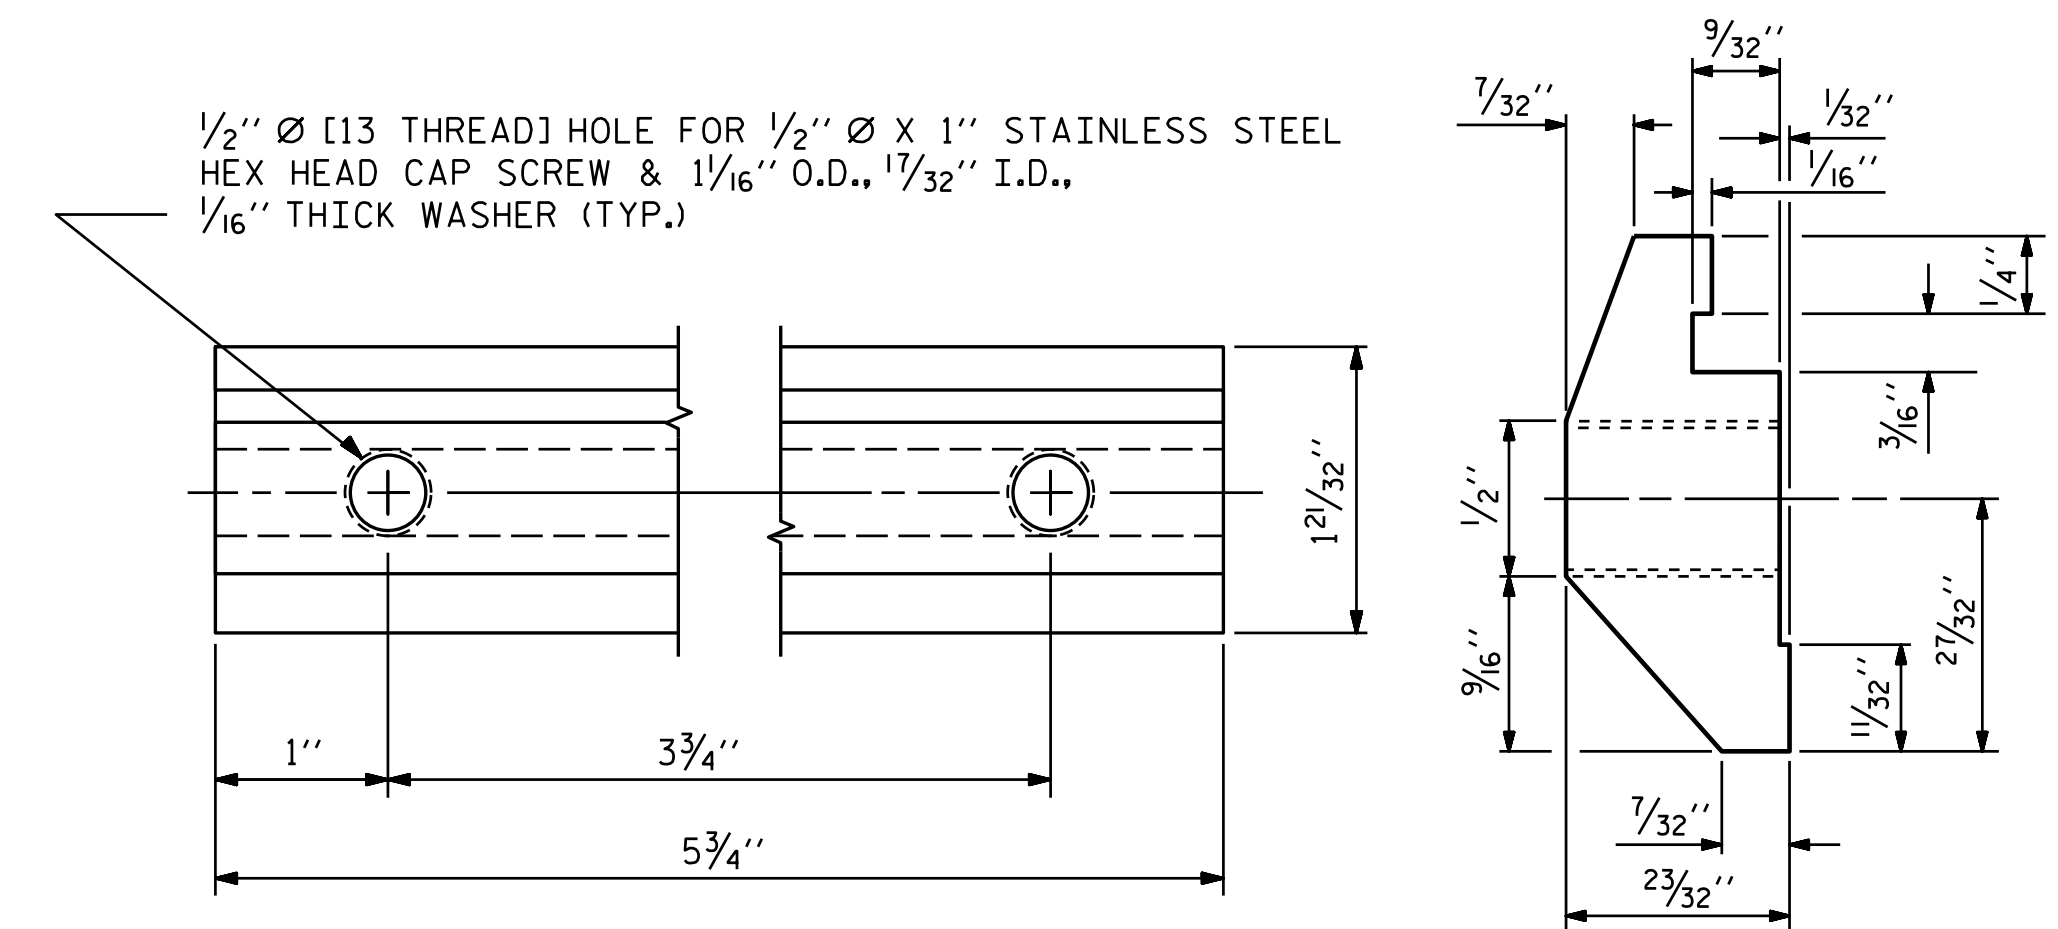

CLAMP BAR DETAIL

(4 REQUIRED PER POST)

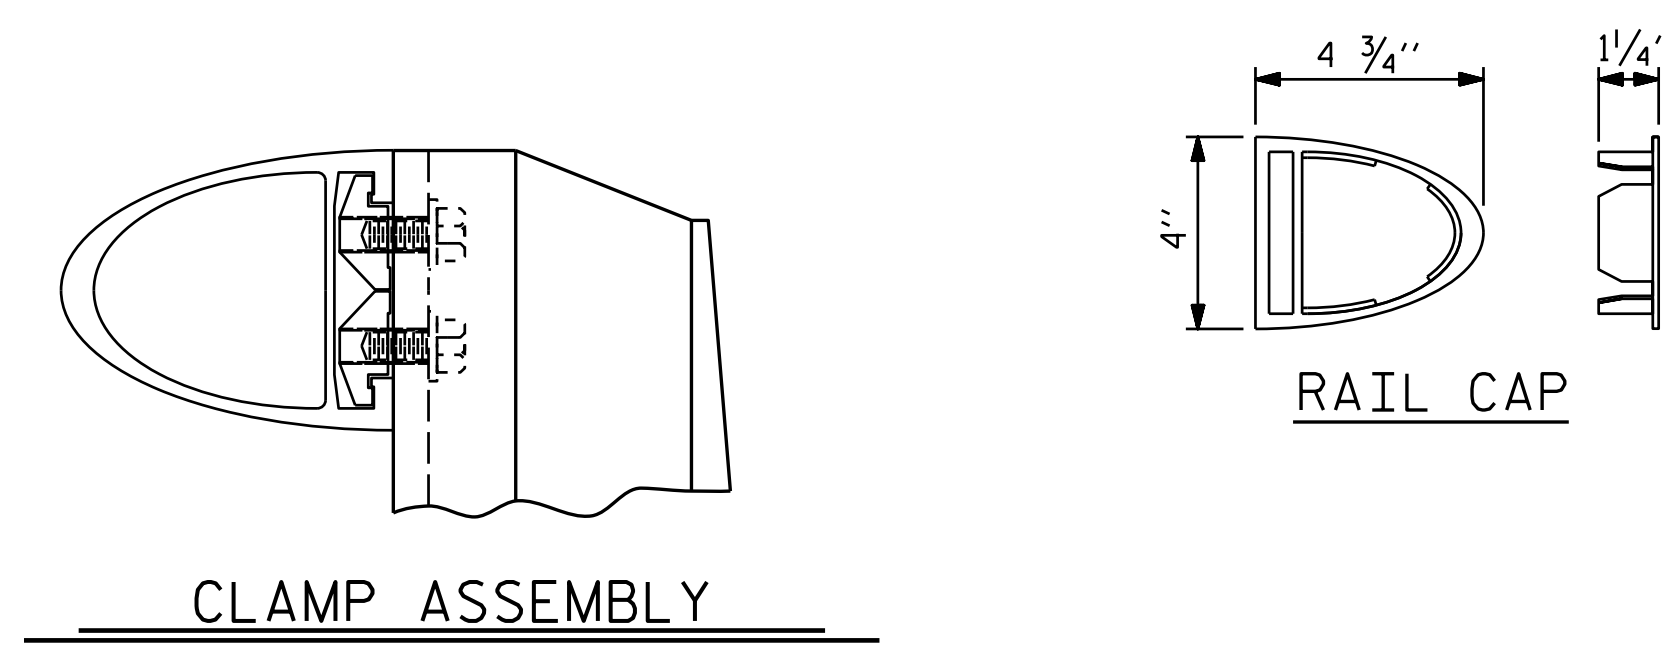

CLAMP ASSEMBLY


RAIL CAP

PROJECT NO. 17BP.7.R.127
 GUILFORD COUNTY
 STATION: 15+33.00 -L-

SHEET 5 OF 5

STATE OF NORTH CAROLINA
 DEPARTMENT OF TRANSPORTATION
 RALEIGH
 SUPERSTRUCTURE
 2 BAR METAL RAIL


DOCUMENT NOT CONSIDERED FINAL UNLESS ALL SIGNATURES COMPLETED
 PLANS PREPARED BY:
 MOTT MACDONALD
 PO Box 700
 Fuquay-Varina, NC 27526
 (919) 552-2253
 www.mottmac.com
 LICENSE NO. F-0669

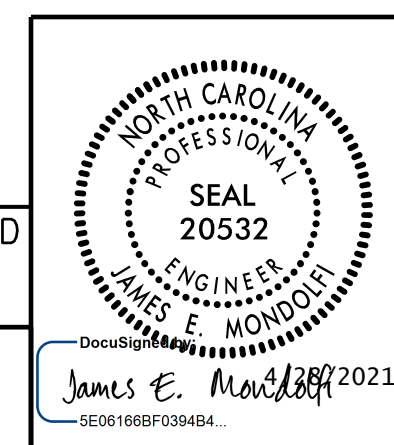

REVISIONS						SHEET NO.
NO.	BY:	DATE:	NO.	BY:	DATE:	5-18
1			3			TOTAL SHEETS
2			4			30

W:\157077\Drawings\17BP.7.R.127-SMU.2MR-400067.dgn
 4/27/2021 12:10:30 PM

DRAWN BY: M. L. MARLEY DATE: 2-2021
 CHECKED BY: J. E. MONDOLFI DATE: 2-2021
 DESIGN ENGINEER OF RECORD: J. E. MONDOLFI DATE: 2-2021

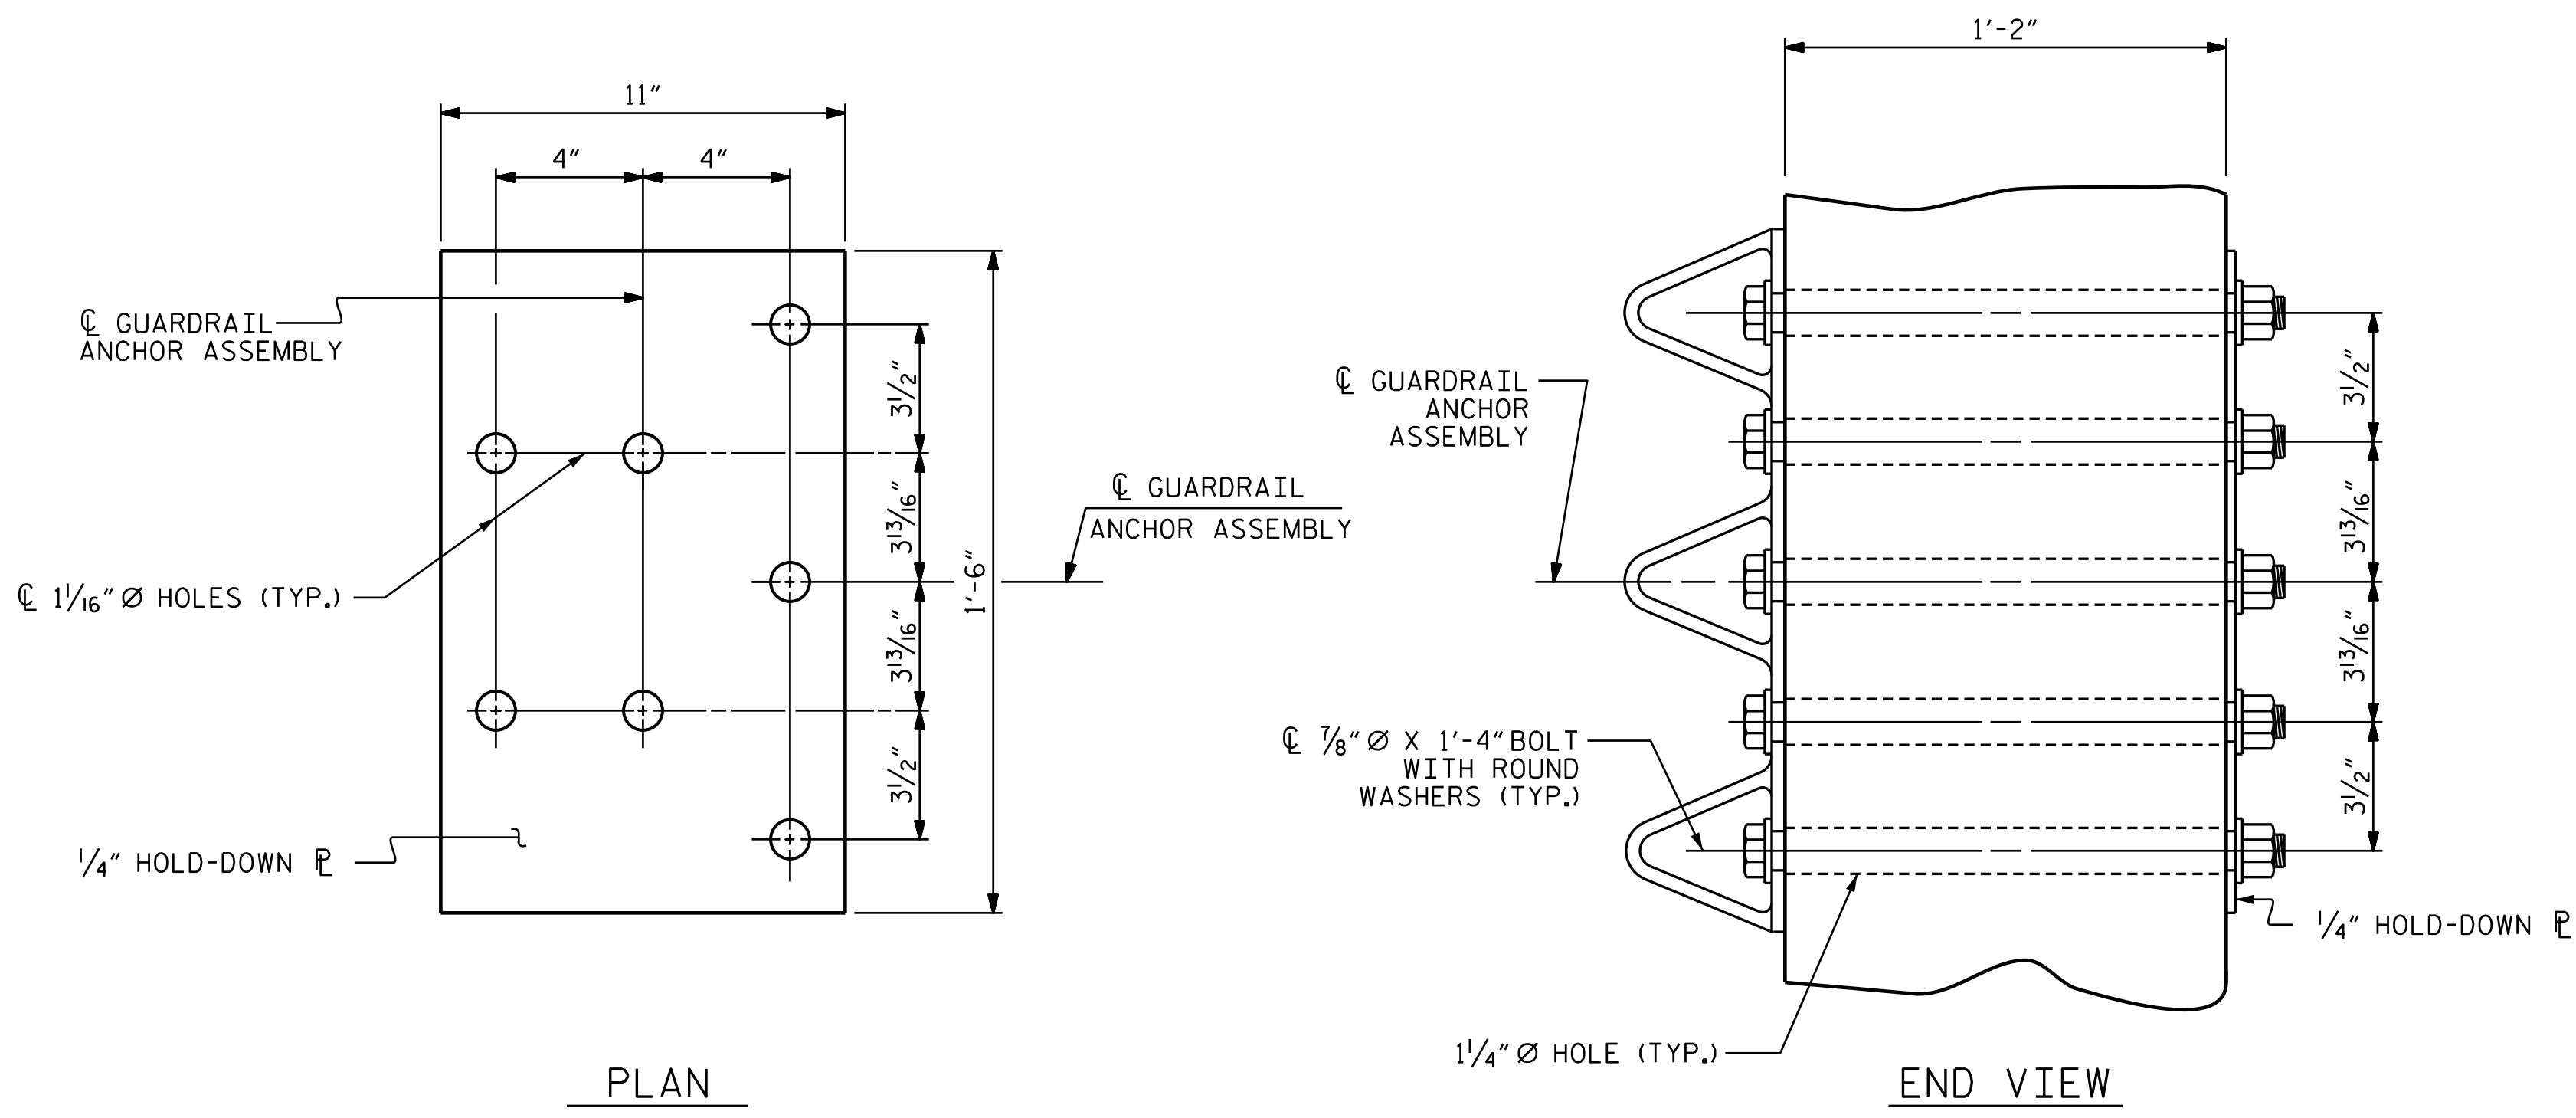

GUARDRAIL ANCHOR ASSEMBLY DETAILS

NOTES

THE GUARDRAIL ANCHOR ASSEMBLY SHALL CONSIST OF A 1/4" HOLD DOWN PLATE AND 7 - 7/8" Ø BOLTS WITH NUTS AND WASHERS.

THE HOLD-DOWN PLATE SHALL CONFORM TO AASHTO M270 GRADE 36. AFTER FABRICATION, THE HOLD-DOWN PLATE SHALL BE HOT-DIP GALVANIZED IN ACCORDANCE WITH AASHTO M111.

BOLTS SHALL CONFORM TO THE REQUIREMENTS OF ASTM A307 AND NUTS SHALL CONFORM TO THE REQUIREMENTS OF AASHTO M291. BOLTS, NUTS AND WASHERS SHALL BE GALVANIZED. AT THE CONTRACTOR'S OPTION, STAINLESS STEEL BOLTS, NUTS AND WASHERS MAY BE USED AS AN ALTERNATE FOR THE 7/8" Ø GALVANIZED BOLTS, NUTS AND WASHERS. THEY SHALL CONFORM TO OR EXCEED THE MECHANICAL REQUIREMENTS OF ASTM A307. THE USE OF THIS ALTERNATE SHALL BE APPROVED BY THE ENGINEER.


THE GUARDRAIL ANCHOR ASSEMBLY IS REQUIRED AT ALL POINTS WHERE APPROACH GUARDRAIL IS TO BE ATTACHED TO THE END OF THE PARAPET. FOR POINTS OF ATTACHMENT, SEE SKETCH.

AFTER INSTALLATION, THE EXPOSED THREAD OF THE BOLT SHALL BE BURRED WITH A SHARP POINTED TOOL.


THE COST OF THE GUARDRAIL ANCHOR ASSEMBLIES WITH BOLTS, NUTS AND WASHERS COMPLETE IN PLACE, SHALL BE INCLUDED IN THE VARIOUS PAY ITEMS.

THE VERTICAL REINFORCING BARS MAY BE SHIFTED SLIGHTLY IN THE END POST TO CLEAR ASSEMBLY BOLTS.

THE 1 1/4" Ø HOLES SHALL BE FORMED OR DRILLED WITH A CORE BIT. IMPACT TOOLS WILL NOT BE PERMITTED. ANY CONCRETE DAMAGED BY THIS WORK SHALL BE REPAIRED TO THE SATISFACTION OF THE ENGINEER.

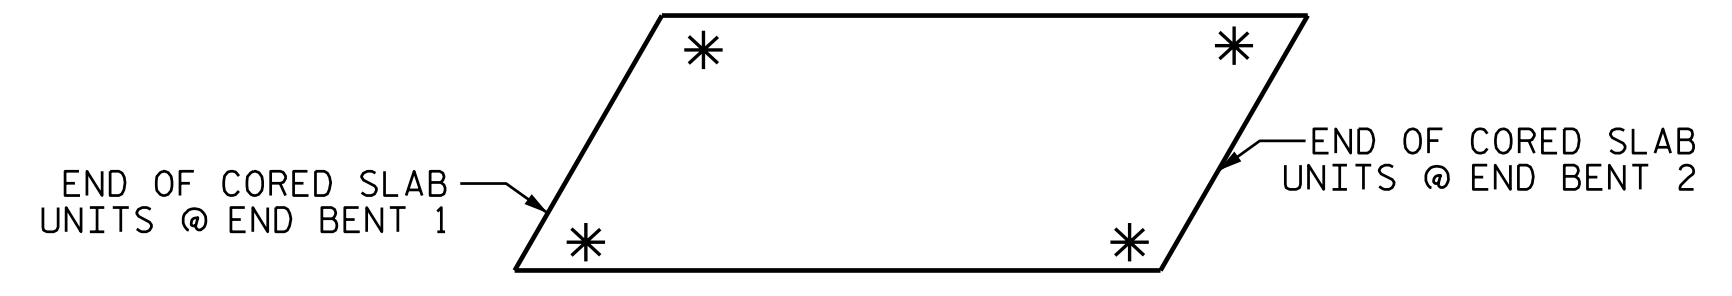

SKETCH SHOWING POINTS OF ATTACHMENT
* LOCATION OF GUARDRAIL ATTACHMENT

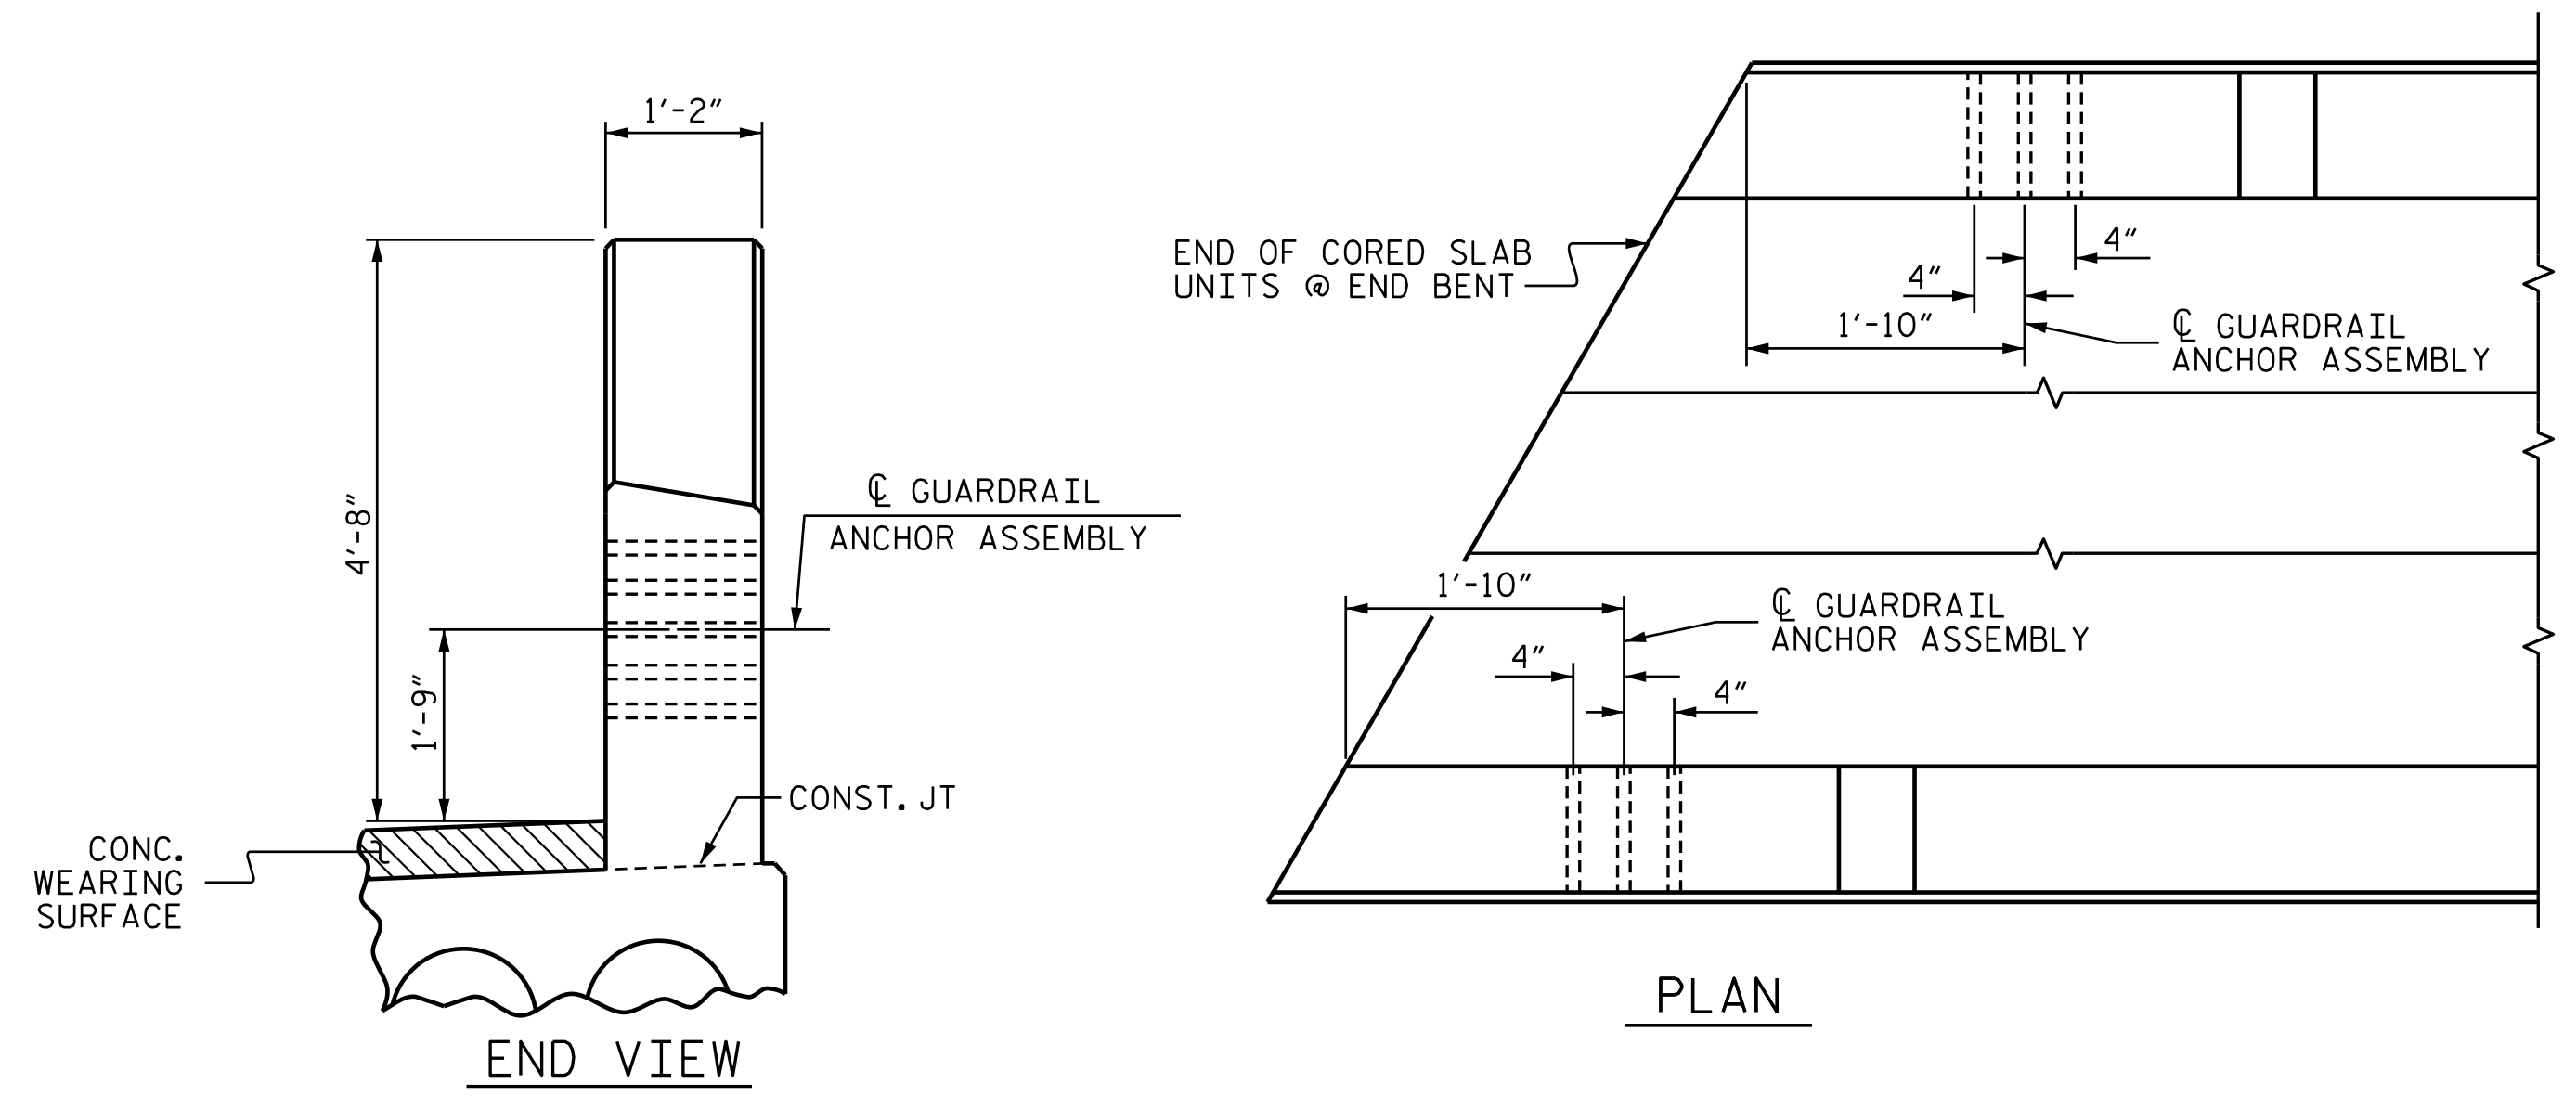


LOCATION OF GUARDRAIL ANCHOR AT END POST

PROJECT NO. 17BP.7.R.127
GUILFORD COUNTY
STATION: 15+33.00 -L-

STATE OF NORTH CAROLINA
DEPARTMENT OF TRANSPORTATION
RALEIGH

**GUARDRAIL ANCHORAGE
DETAILS
FOR METAL RAILS**

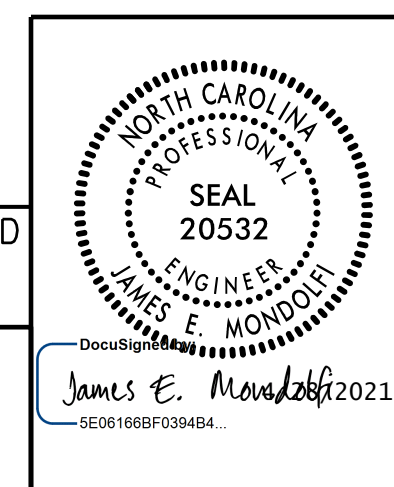

DOCUMENT NOT CONSIDERED FINAL UNLESS ALL SIGNATURES COMPLETED

PLANS PREPARED BY:
M MOTT MACDONALD
PO Box 700
Fuquay-Varina, NC 27526
(919) 552-2253
www.mottmac.com
LICENSE NO. F-0669


REVISIONS						SHEET NO.
NO.	BY:	DATE:	NO.	BY:	DATE:	5-19
1			3			TOTAL SHEETS
2			4			30

W:\157077\Drawings\17BP.7.R.127-SMU_CR-400067.dgn
 4/27/2021 12:10:31 PM


DRAWN BY: M. L. MARLEY DATE: 2-2021
 CHECKED BY: J. E. MONDOLFI DATE: 2-2021
 DESIGN ENGINEER OF RECORD: J. E. MONDOLFI DATE: 2-2021

NOTES

STIRRUPS IN CAP MAY BE SHIFTED AS NECESSARY TO CLEAR DOWELS.
 THE CONCRETE IN THE SHADED AREA OF THE WING SHALL BE POURED AFTER THE CONCRETE PARAPET IS CAST IF SLIP FORMING IS USED.
 FOR PILE SPlice DETAILS, SEE SHEET 5 OF 5.
 FOR WING DETAILS, SEE SHEET 2 OF 5.

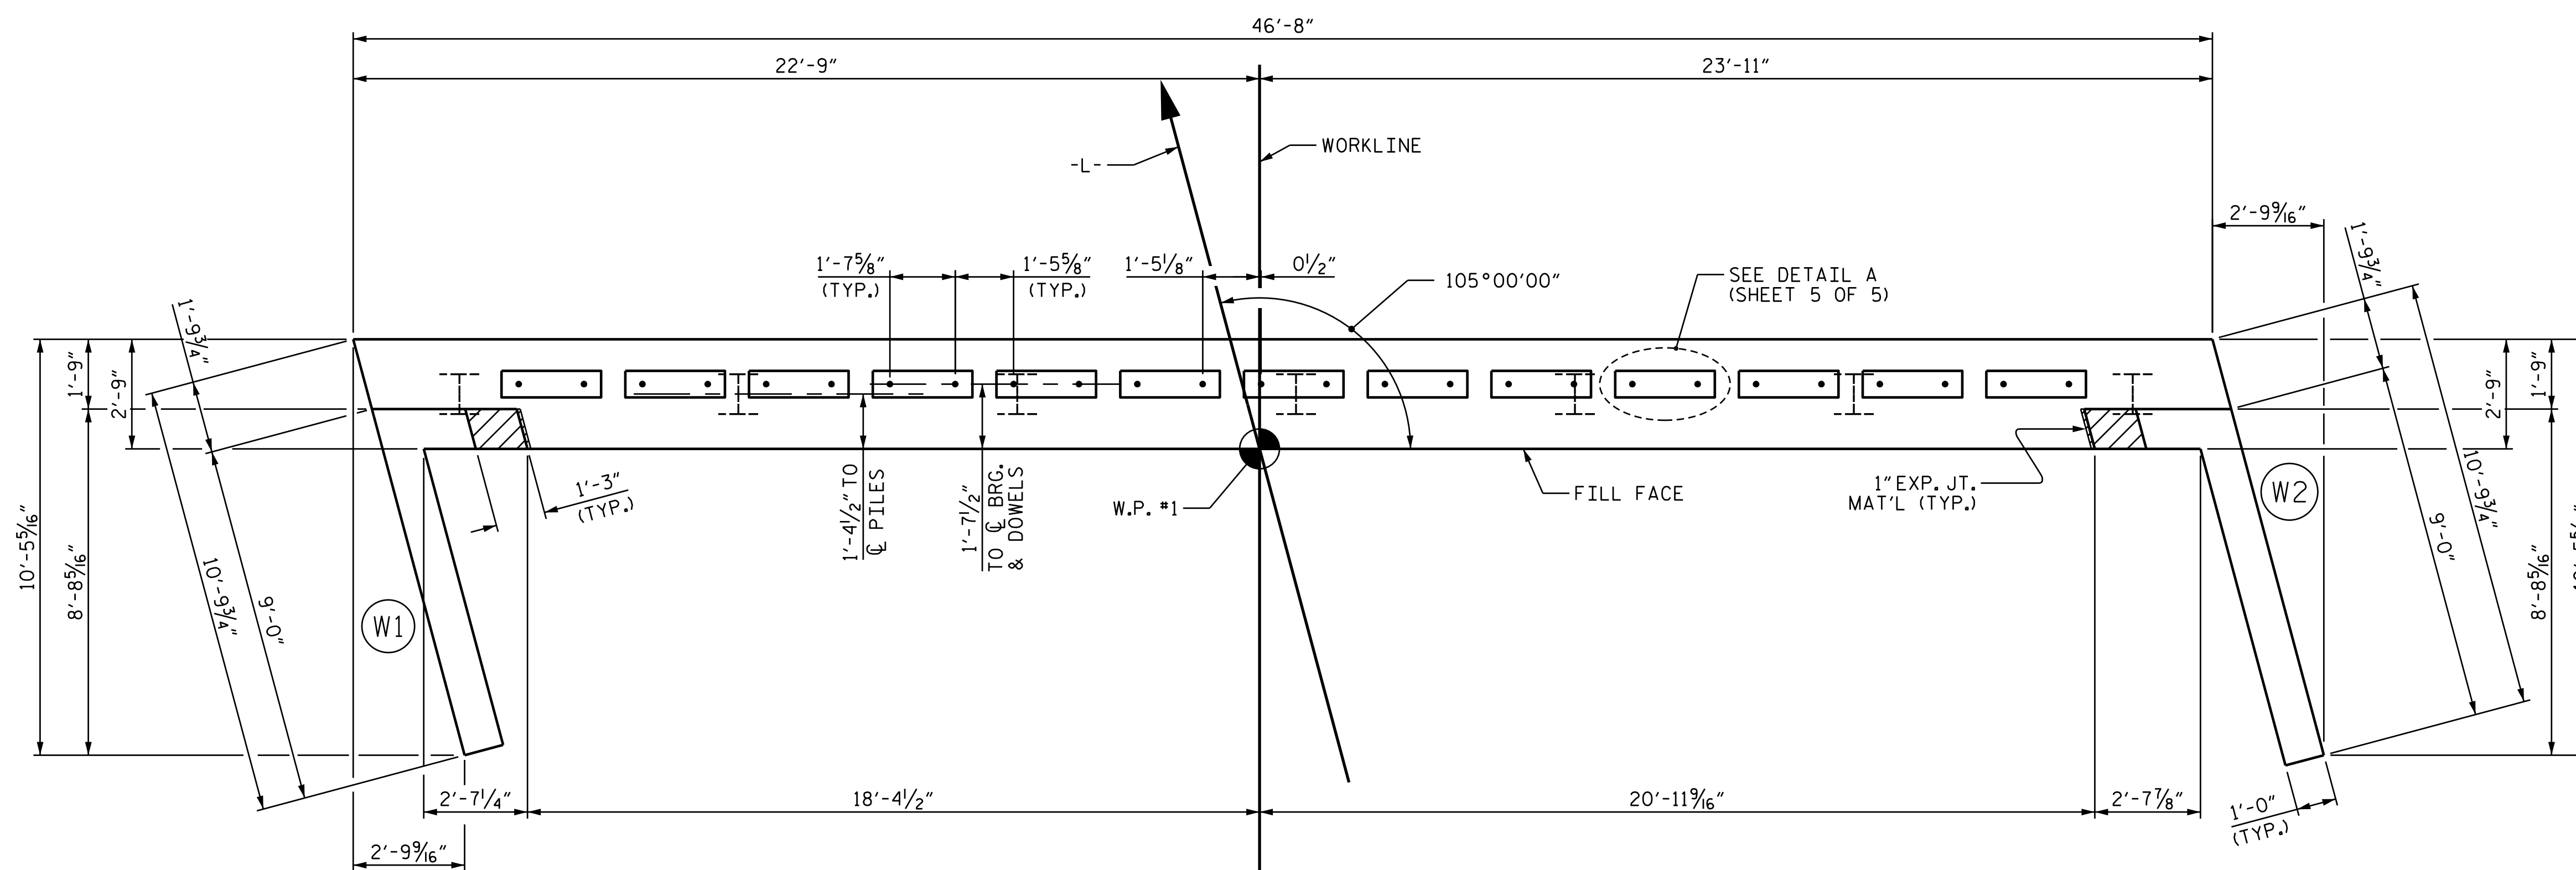

PLAN

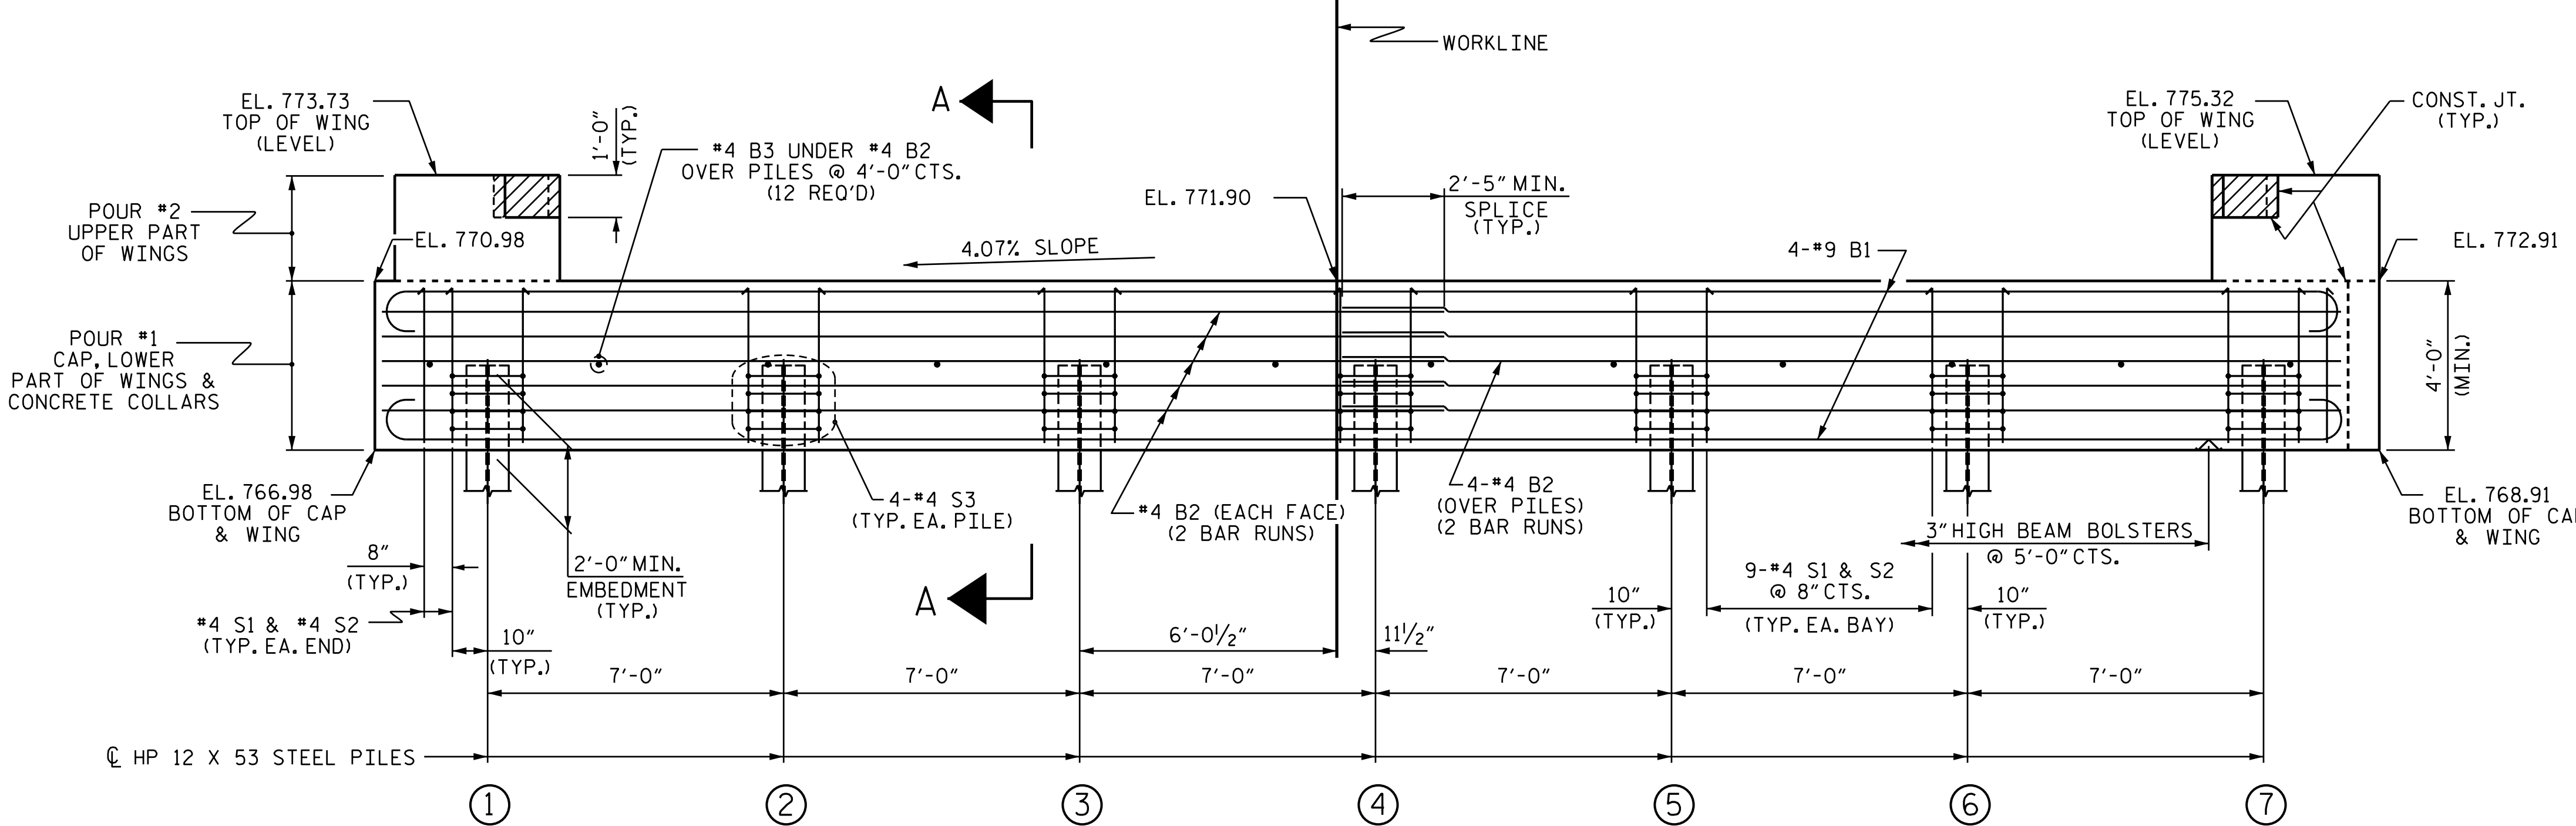

ELEVATION


WINGS NOT SHOWN FOR CLARITY.
 FOR SECTION A-A, SEE SHEET 5 OF 5.
 CONCRETE COLLARS FOR STEEL PILES NOT SHOWN IN PLAN AND ELEVATION VIEWS FOR CLARITY.
 SEE "CORROSION PROTECTION FOR STEEL PILES DETAIL", SHEET 5 OF 5.

TOP OF PILE ELEVATIONS	
①	769.09
②	769.37
③	769.66
④	769.94
⑤	770.23
⑥	770.51
⑦	770.80

PROJECT NO. 17BP.7.R.127
 GUILFORD COUNTY
 STATION: 15+33.00 -L-

SHEET 1 OF 5

STATE OF NORTH CAROLINA
 DEPARTMENT OF TRANSPORTATION
 RALEIGH
 SUBSTRUCTURE
 END BENT 1

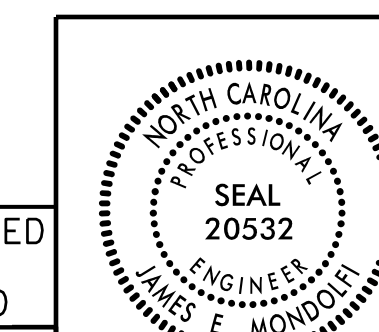

DOCUMENT NOT CONSIDERED FINAL UNLESS ALL SIGNATURES COMPLETED


PLANS PREPARED BY:
 MOTT MACDONALD
 PO Box 700
 Fuquay-Varina, NC 27526
 (919) 552-2253
 www.mottmac.com
 LICENSE NO. F-0669

James E. Mondolfi 2021
 202106030004


REVISIONS						SHEET NO.
NO.	BY:	DATE:	NO.	BY:	DATE:	S-20
1			3			TOTAL SHEETS
2			4			30

W:\157077\17BP.7.R.127-SMU.E-400067.dgn
 4/27/2021 12:10:32 PM


DRAWN BY: J. T. WILLIAMS DATE: 1-2021
 CHECKED BY: J. E. MONDOLFI DATE: 2-2021
 DESIGN ENGINEER OF RECORD: J. E. MONDOLFI DATE: 2-2021

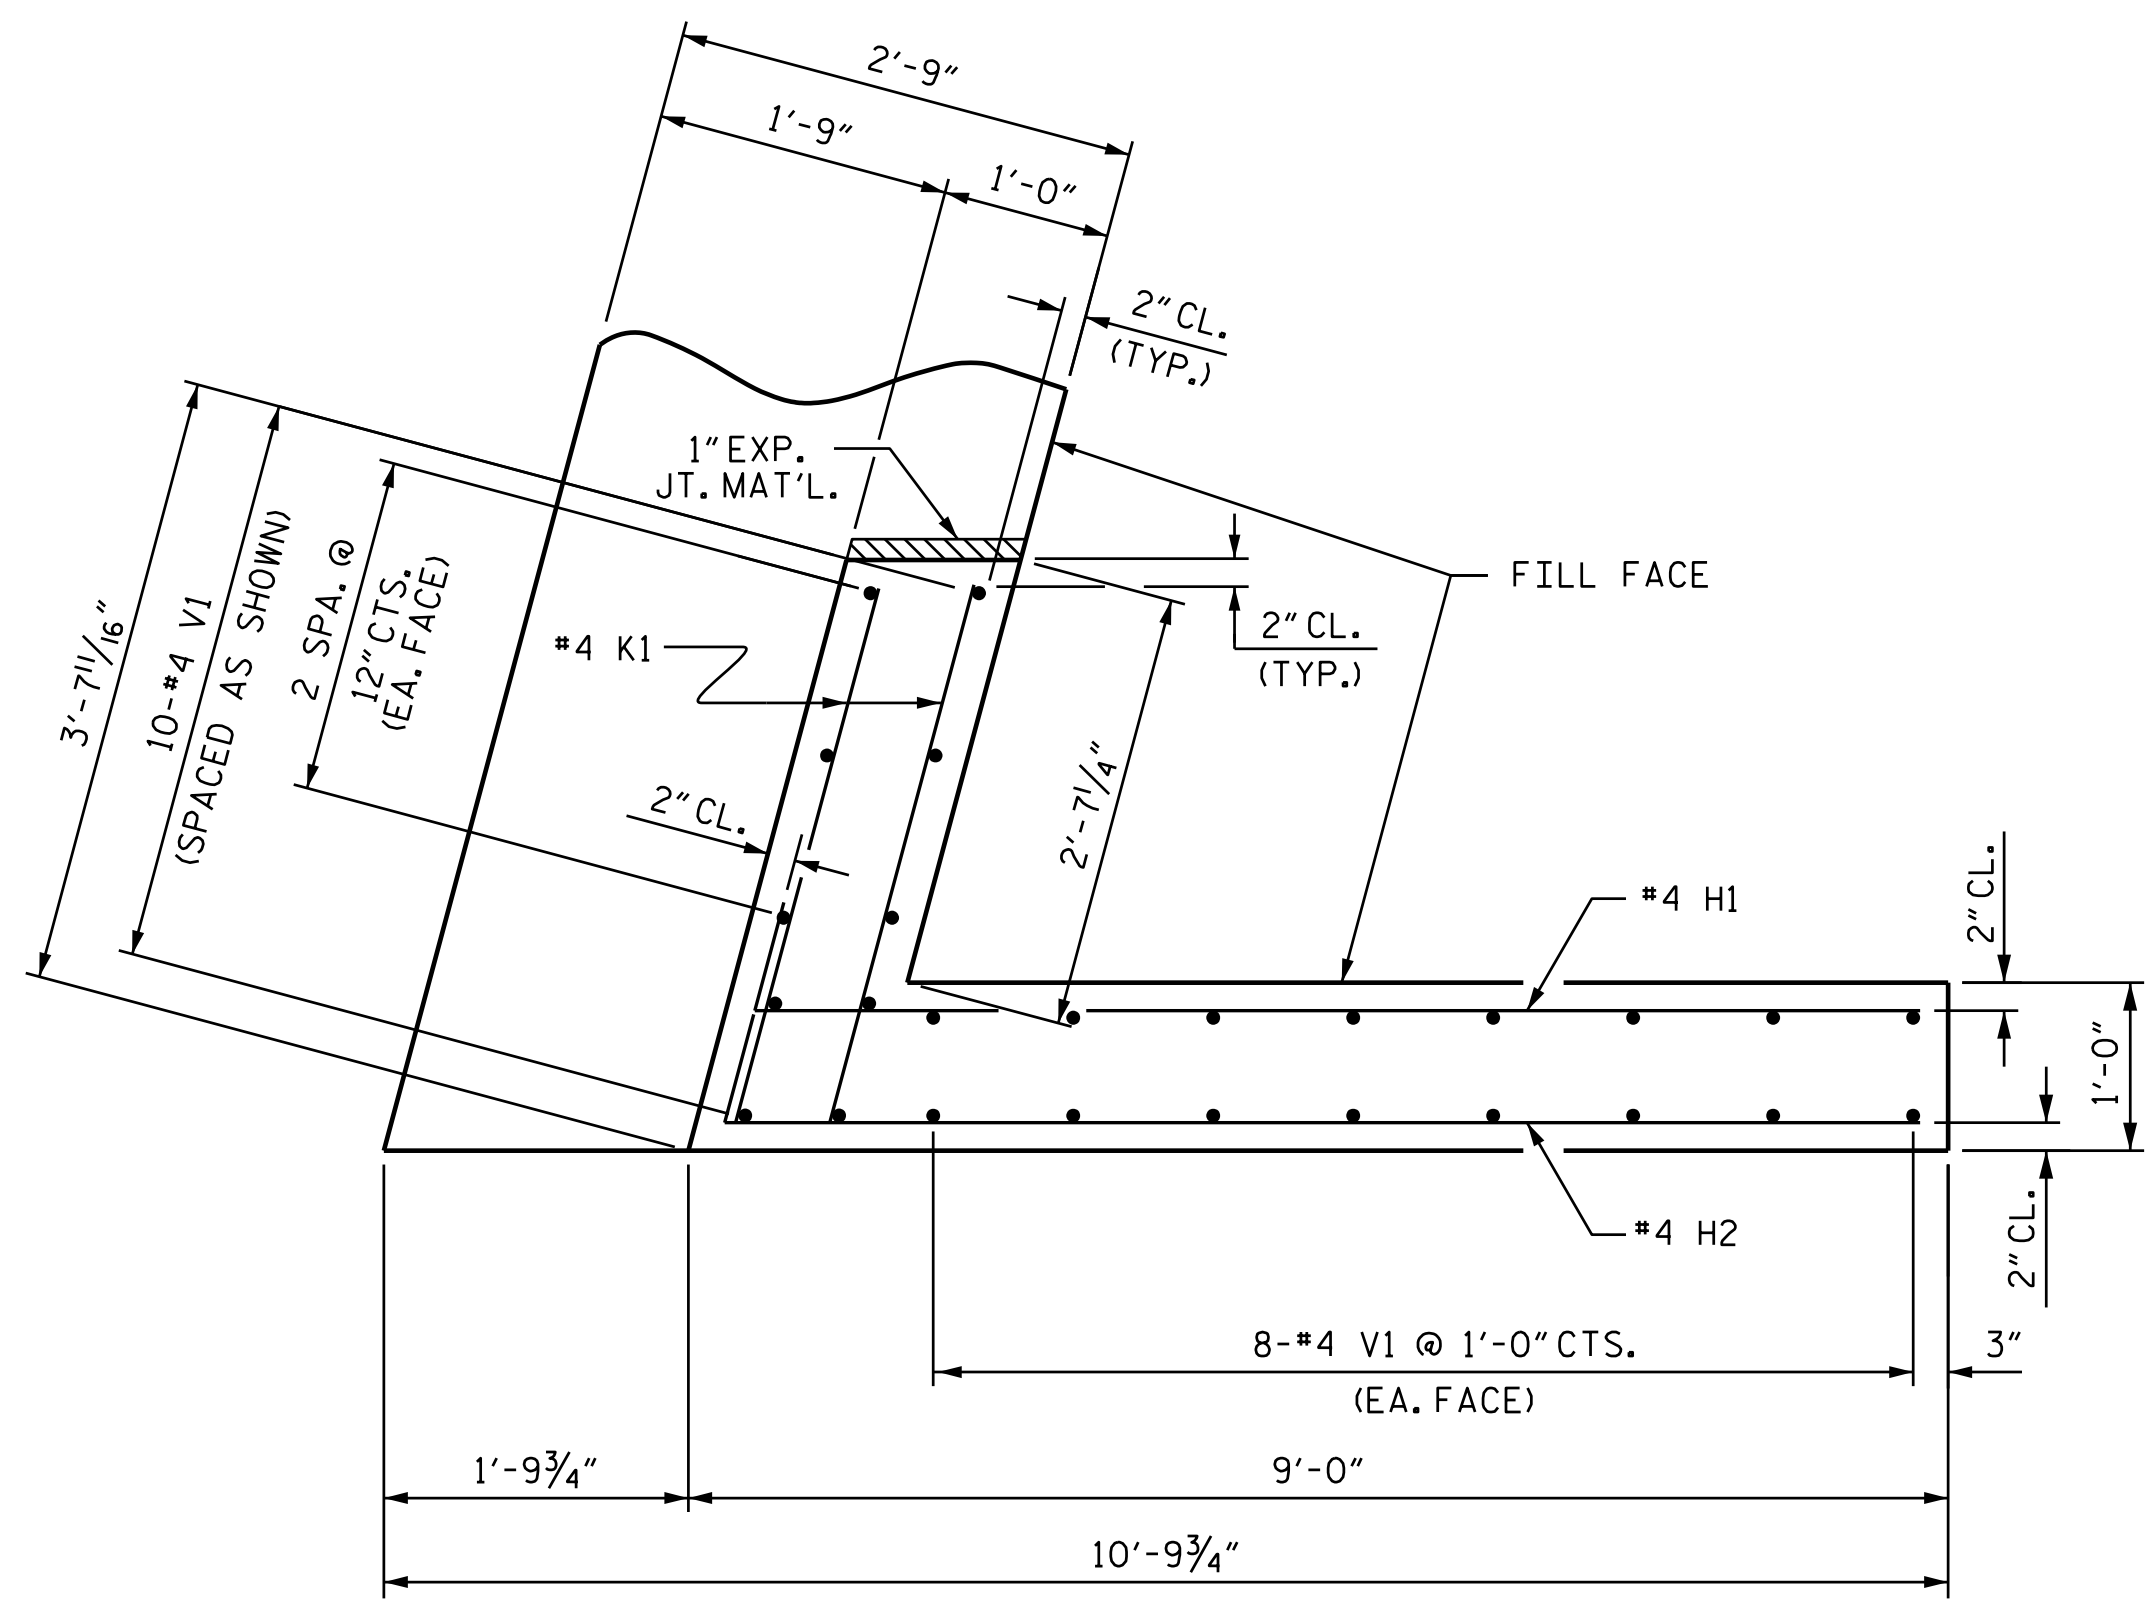


PLAN OF WING (W1)

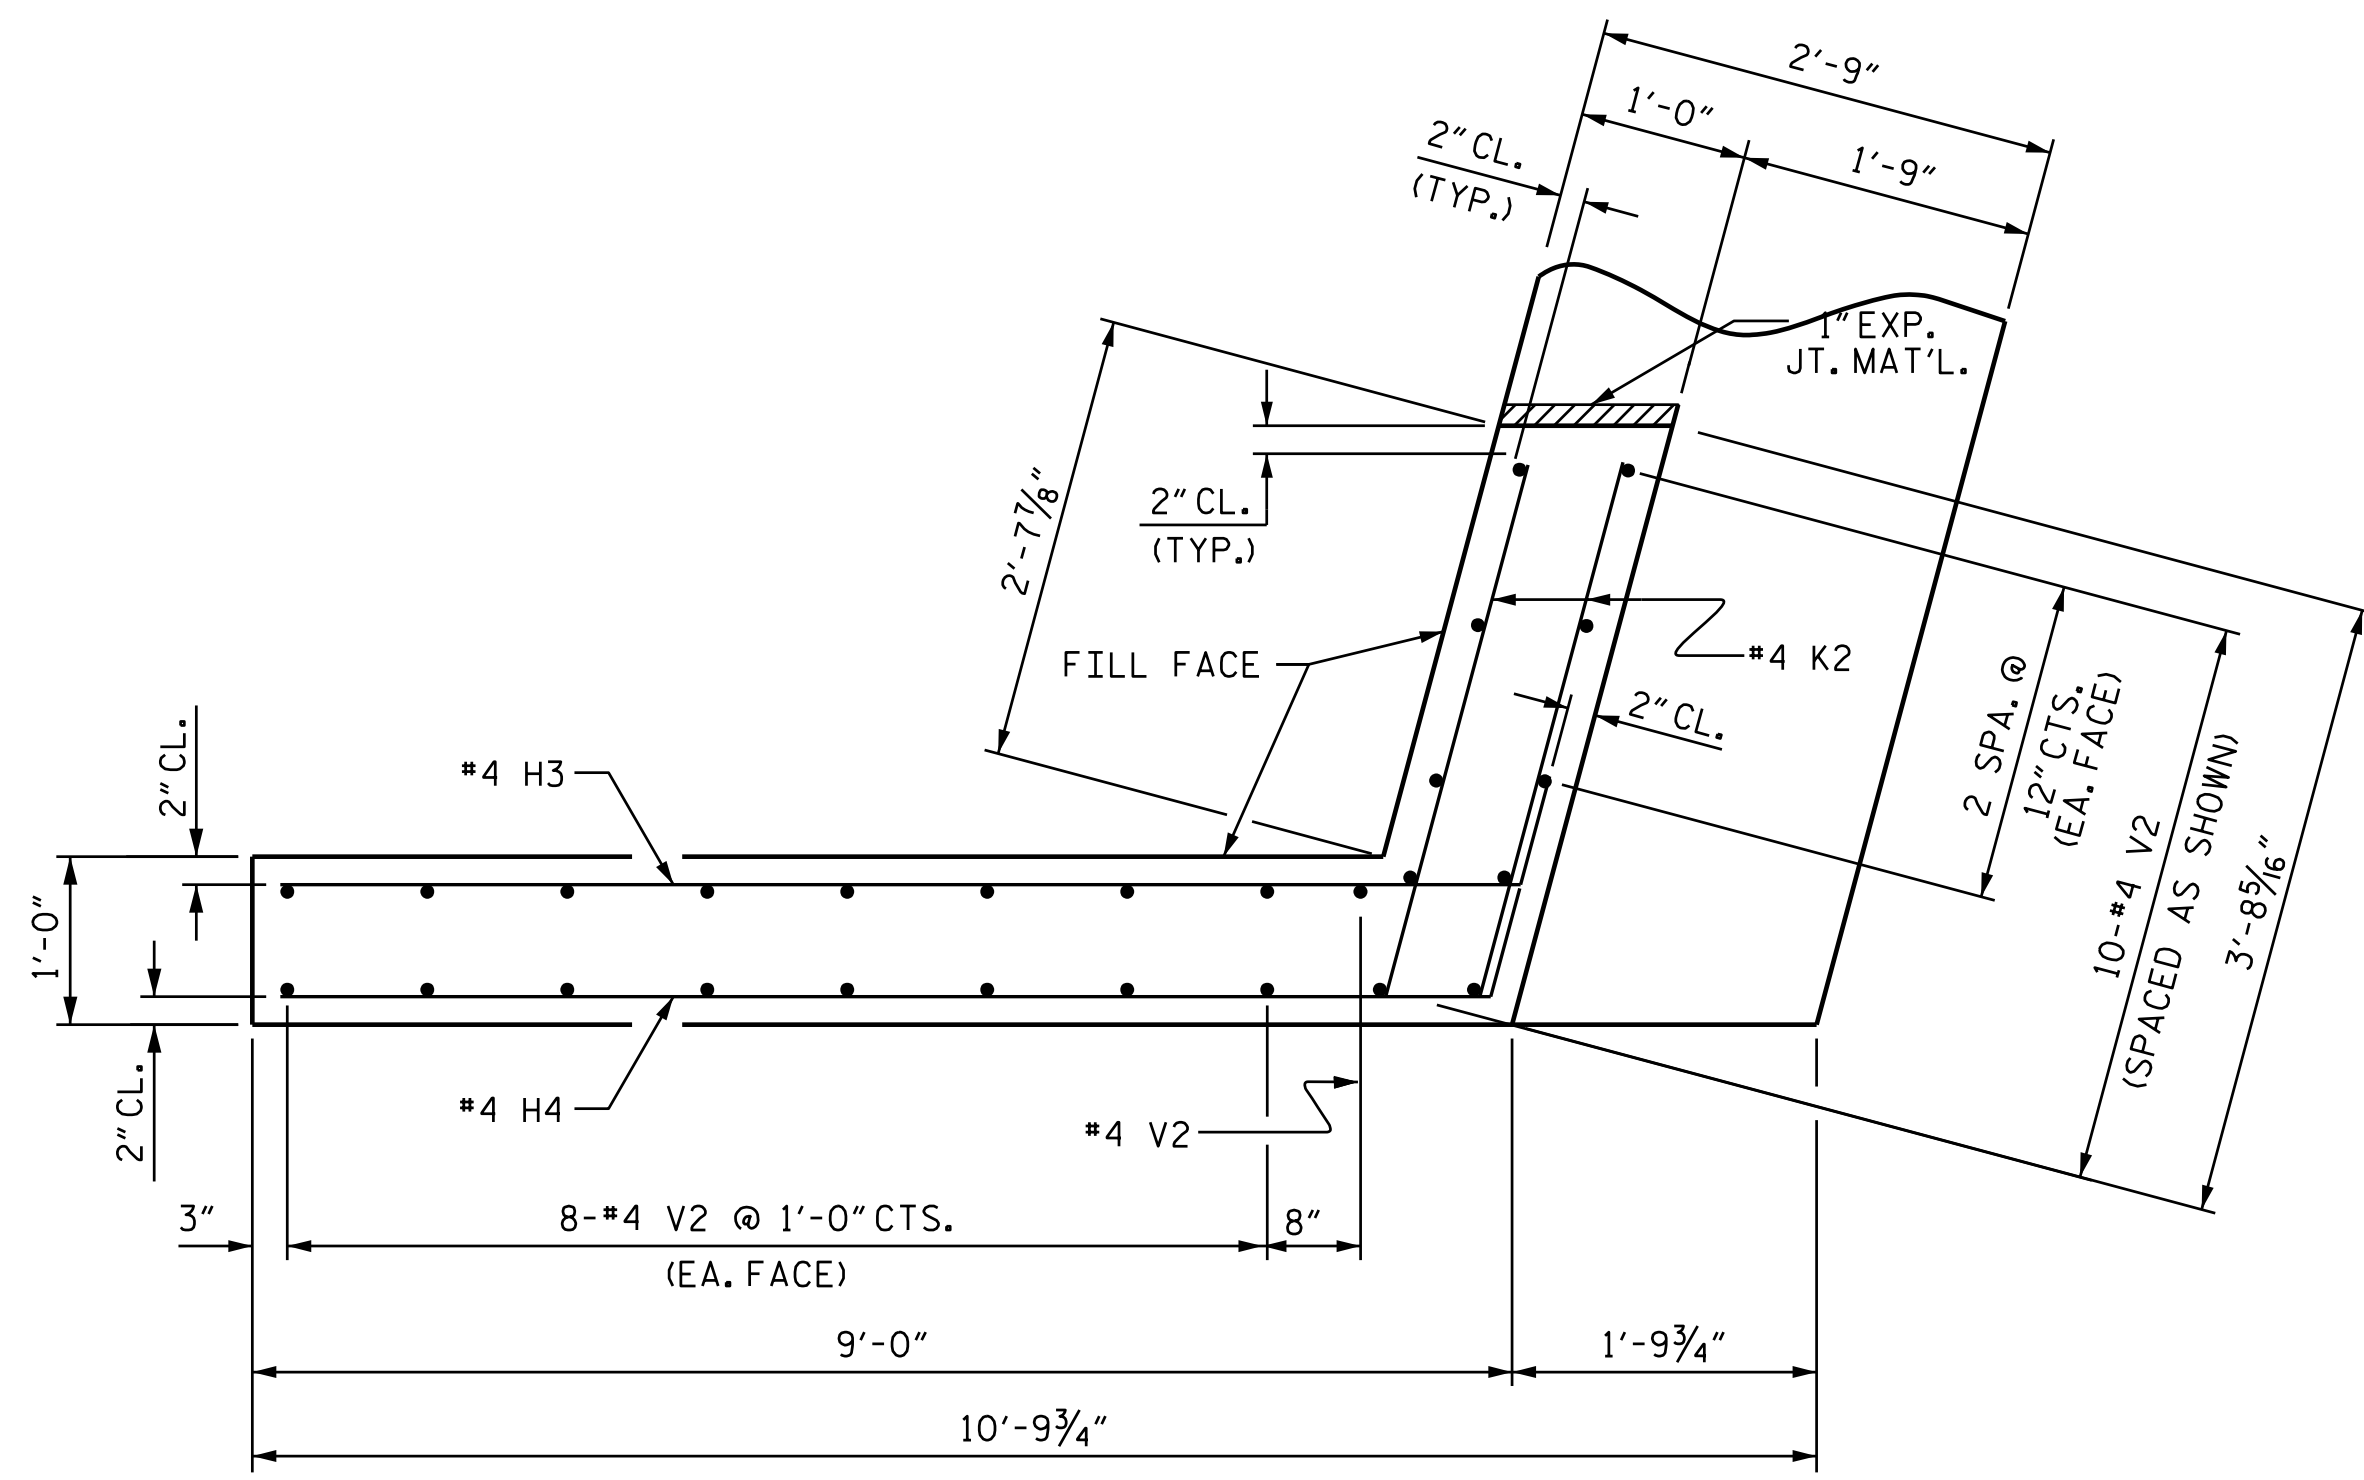


PLAN OF WING (W2)

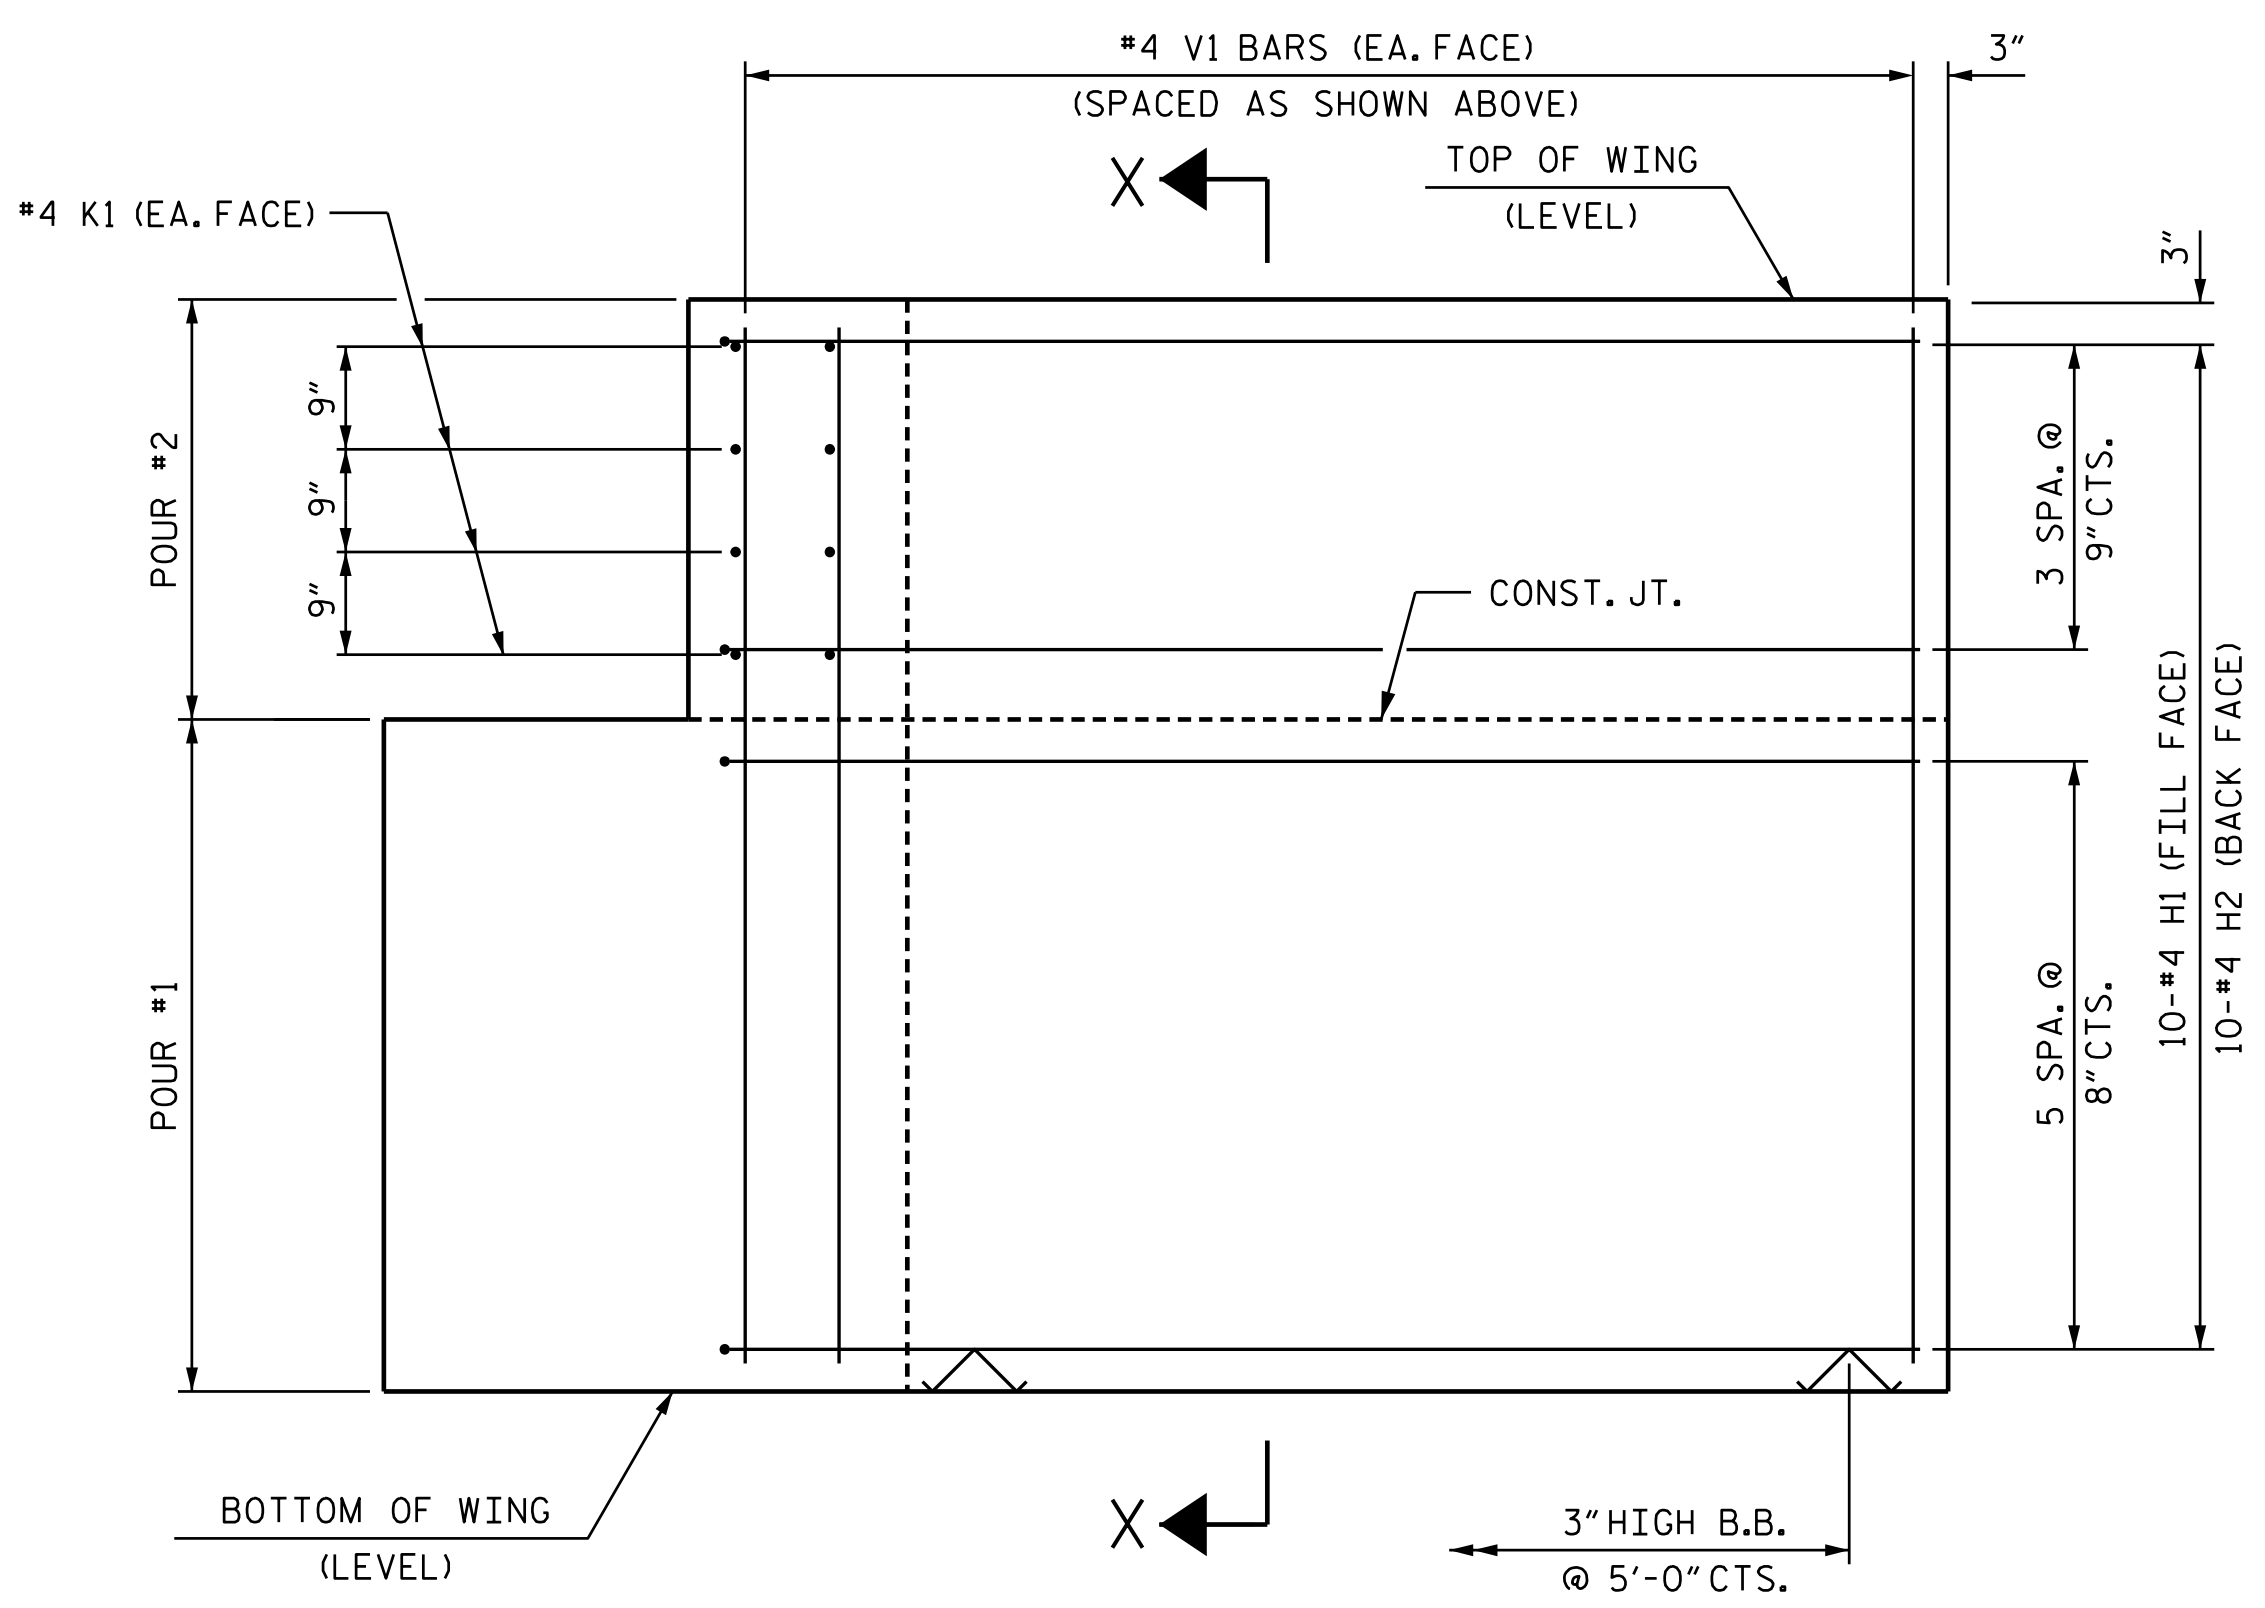


ELEVATION OF WING (W1)

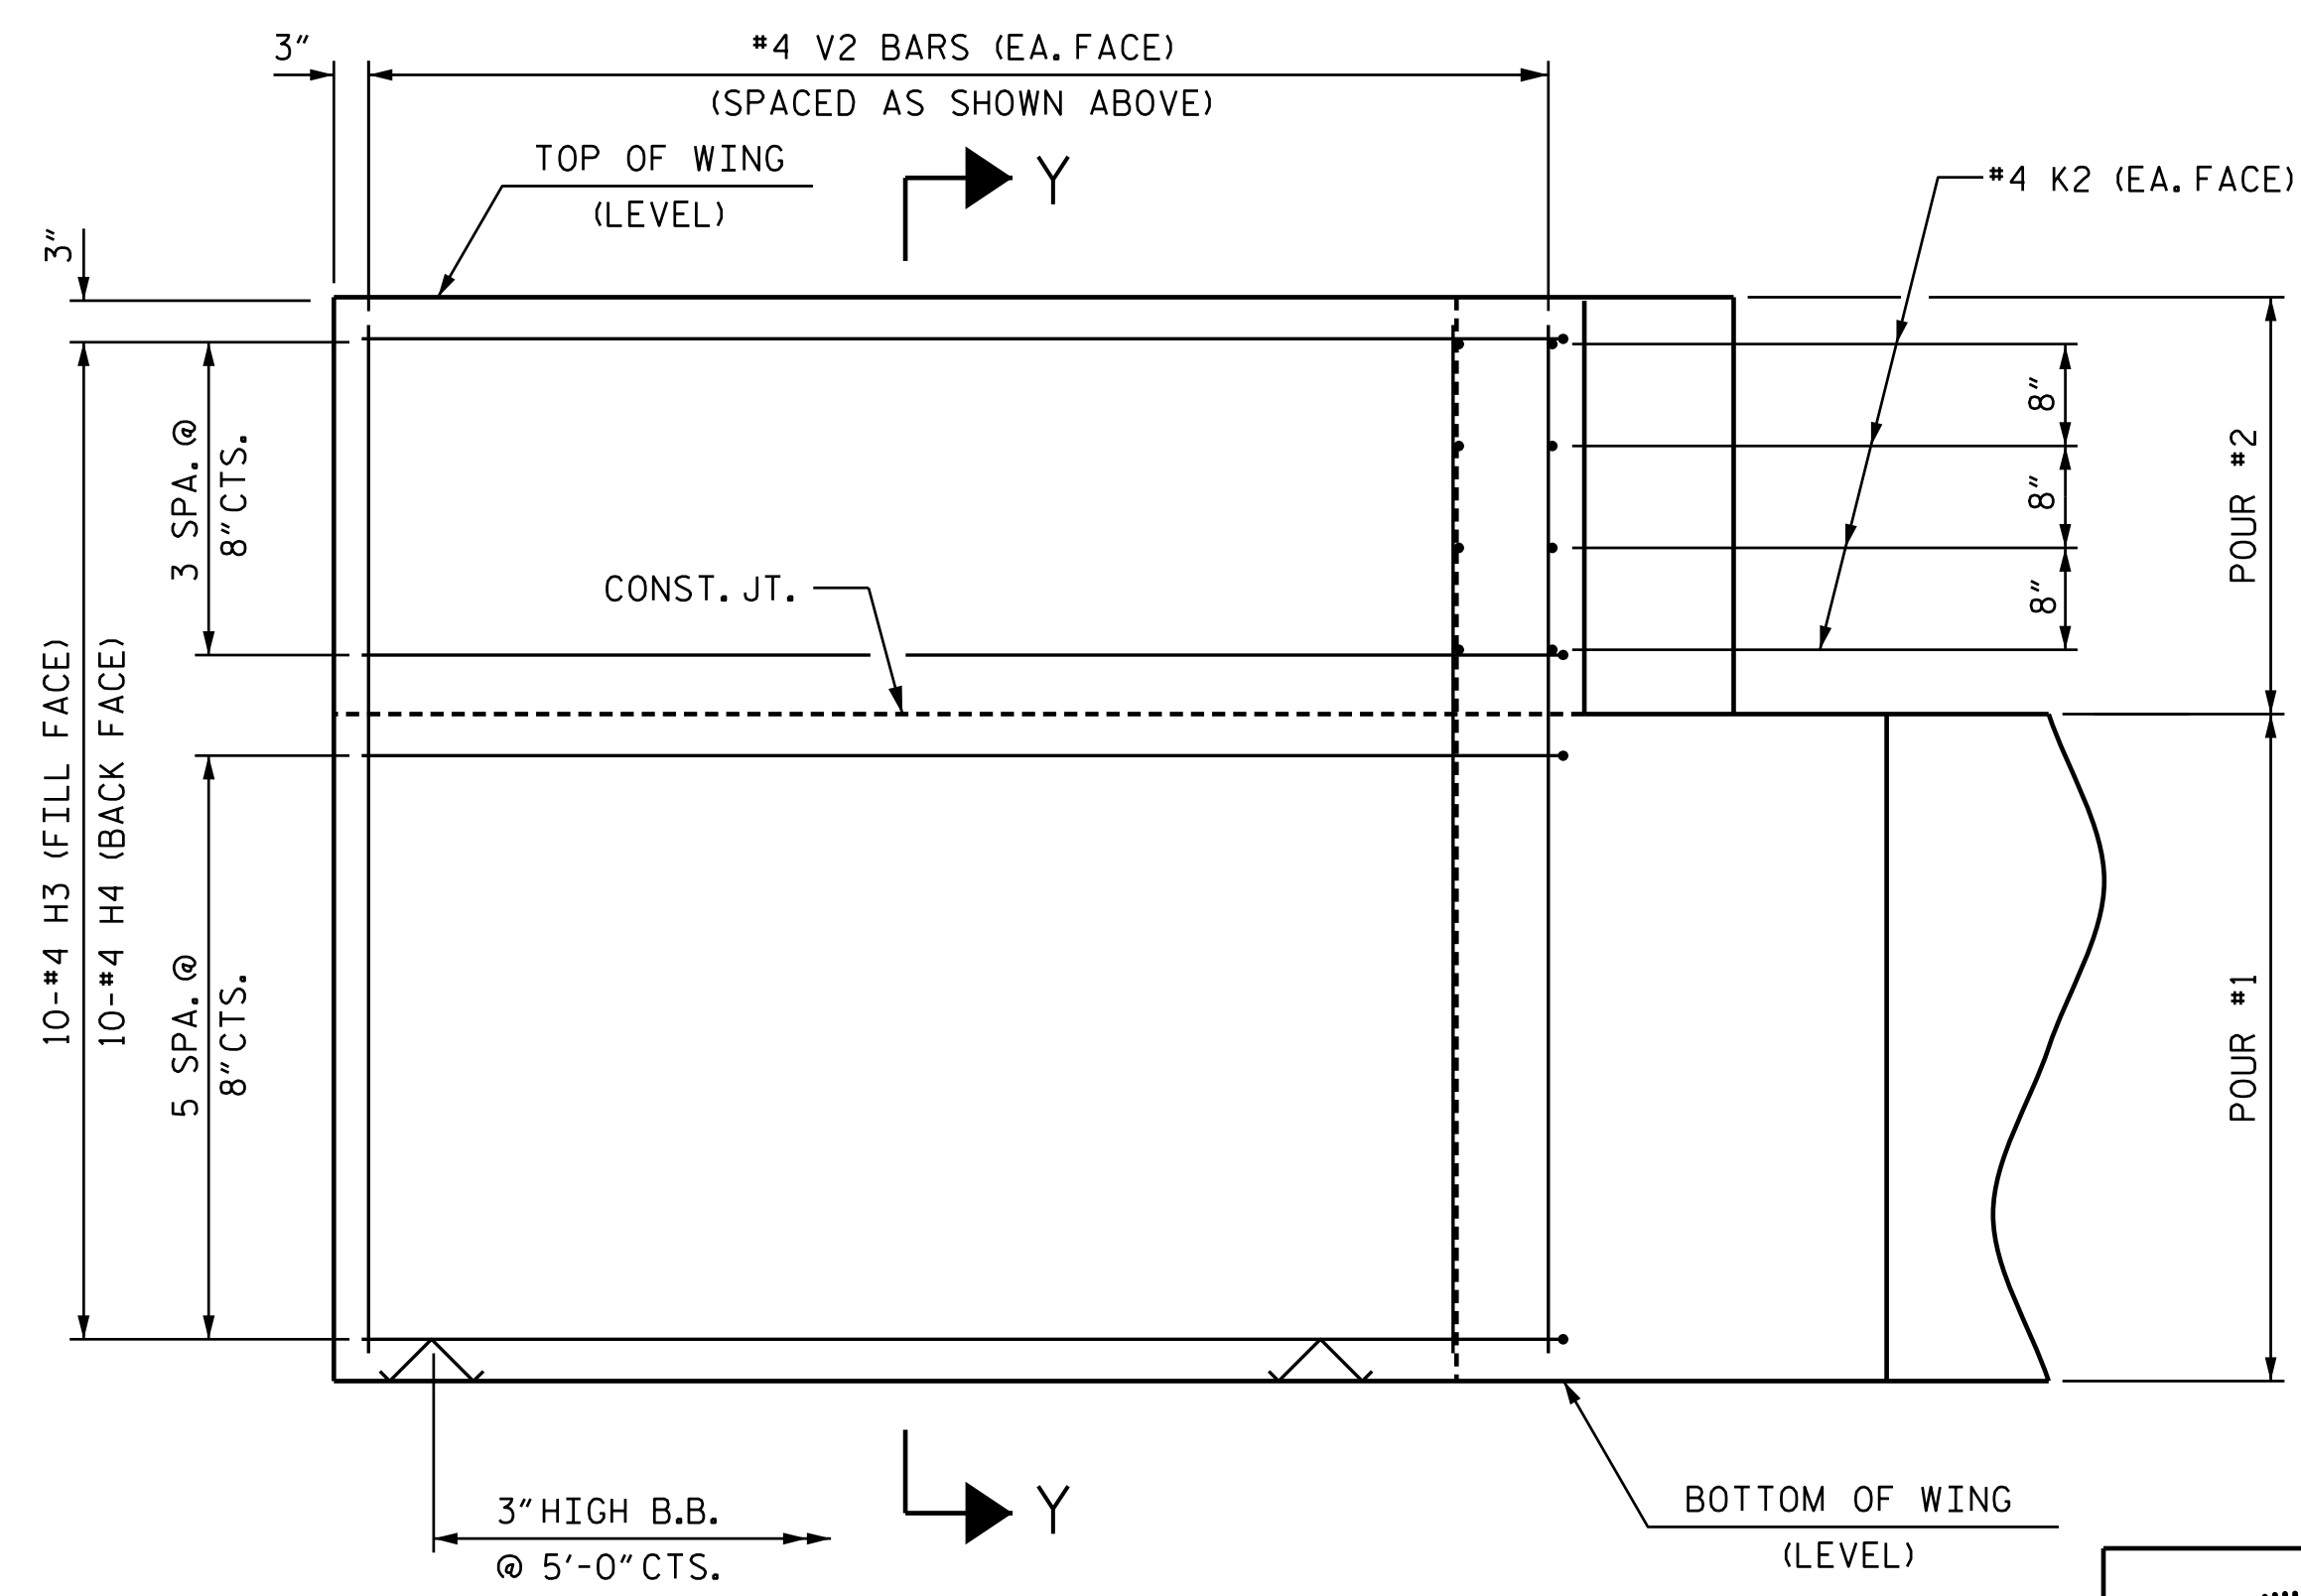

ELEVATION OF WING (W2)

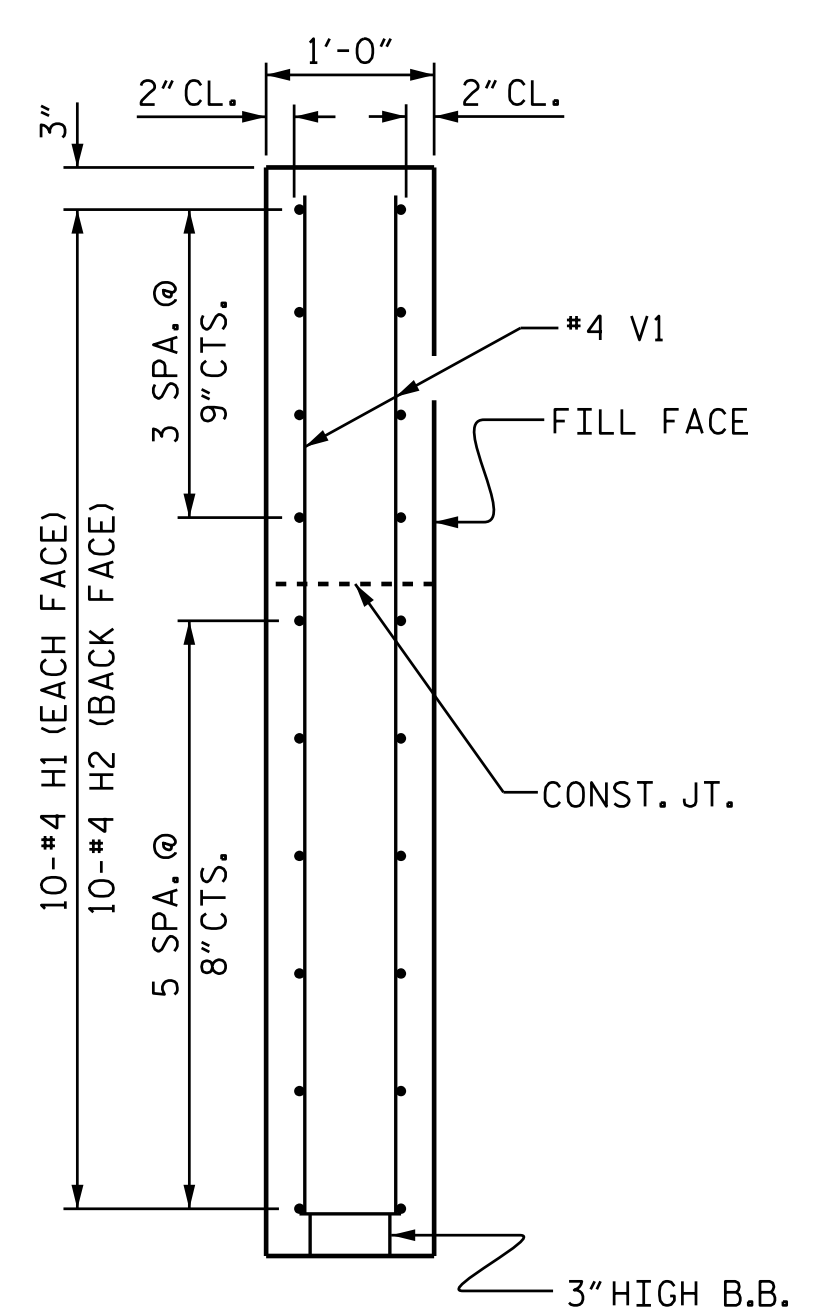

SECTION X-X

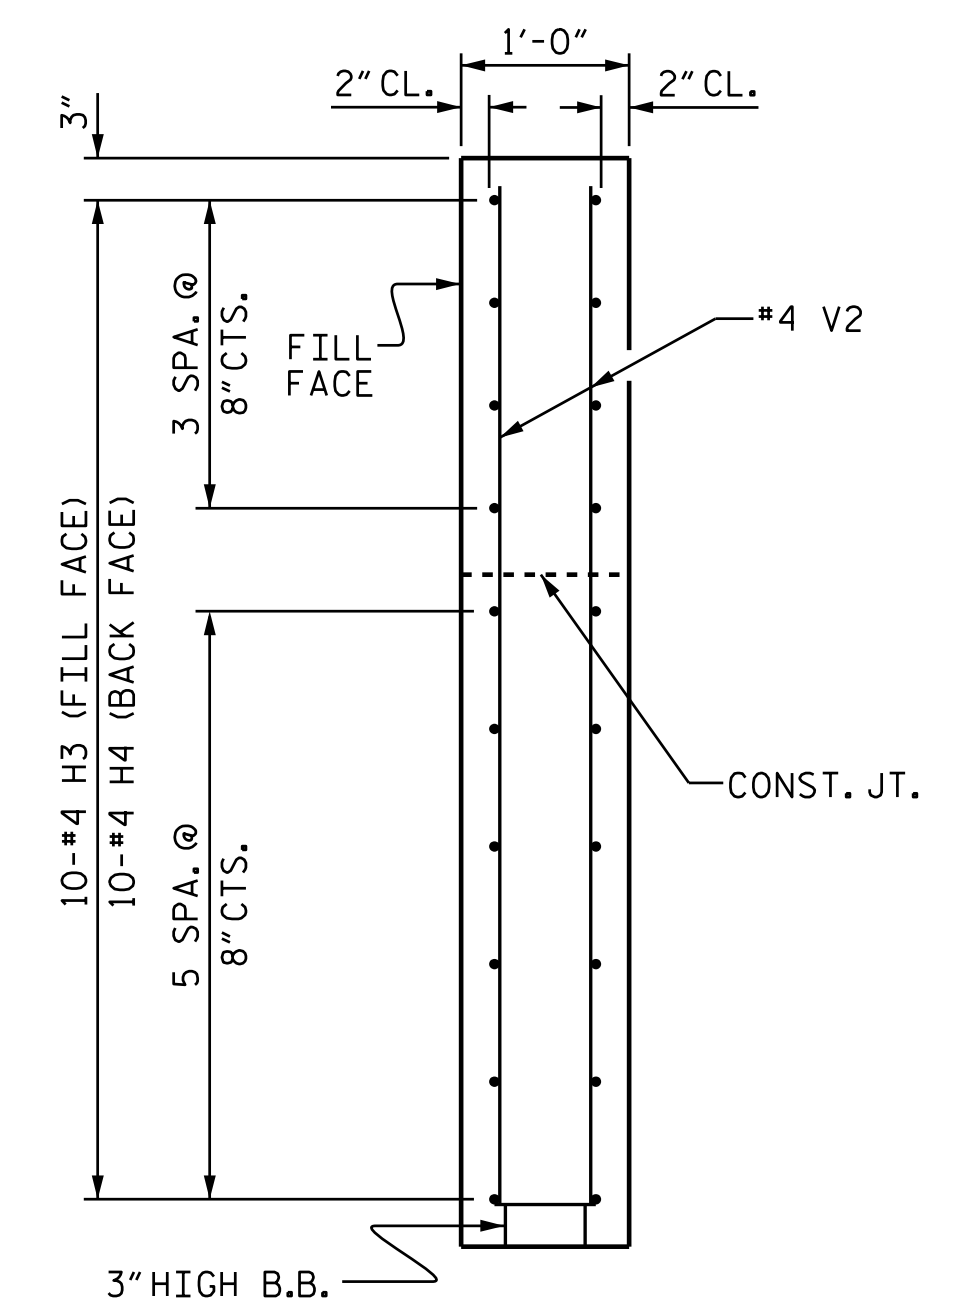

SECTION Y-Y

PROJECT NO. 17BP.7.R.127
 GUILFORD COUNTY
 STATION: 15+33.00 -L-


SHEET 2 OF 5

STATE OF NORTH CAROLINA
 DEPARTMENT OF TRANSPORTATION
 RALEIGH

SUBSTRUCTURE
 END BENT 1
 WING DETAILS

REVISIONS					
NO.	BY:	DATE:	NO.	BY:	DATE:
1			3		
2			4		

SHEET NO. S-21
 TOTAL SHEETS 30

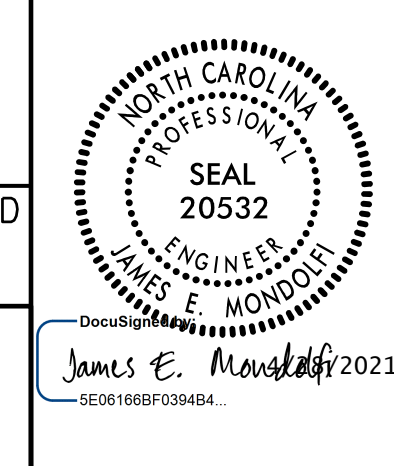

DOCUMENT NOT CONSIDERED FINAL UNLESS ALL SIGNATURES COMPLETED

PLANS PREPARED BY:
M MOTT MACDONALD
 PO Box 700
 Fuquay-Varina, NC 27526
 (919) 552-2253
 www.mottmac.com
 LICENSE NO. F-0669

WING DETAILS

157077
 I:\Projects\17BP.7.R.127-SMU.E-400067.dgn
 4/27/2021 12:10:33 PM

DRAWN BY: J. M. ABRIL DATE: 2-2021
 CHECKED BY: J. E. MONDOLFI DATE: 2-2021
 DESIGN ENGINEER OF RECORD: J. E. MONDOLFI DATE: 2-2021


NOTES

STIRRUPS IN CAP MAY BE SHIFTED AS NECESSARY TO CLEAR DOWELS.


THE CONCRETE IN THE SHADED AREA OF THE WING SHALL BE POURED AFTER THE CONCRETE PARAPET IS CAST IF SLIP FORMING IS USED.

FOR PILE SPLICE DETAILS, SEE SHEET 5 OF 5.

FOR WING DETAILS, SEE SHEET 4 OF 5.

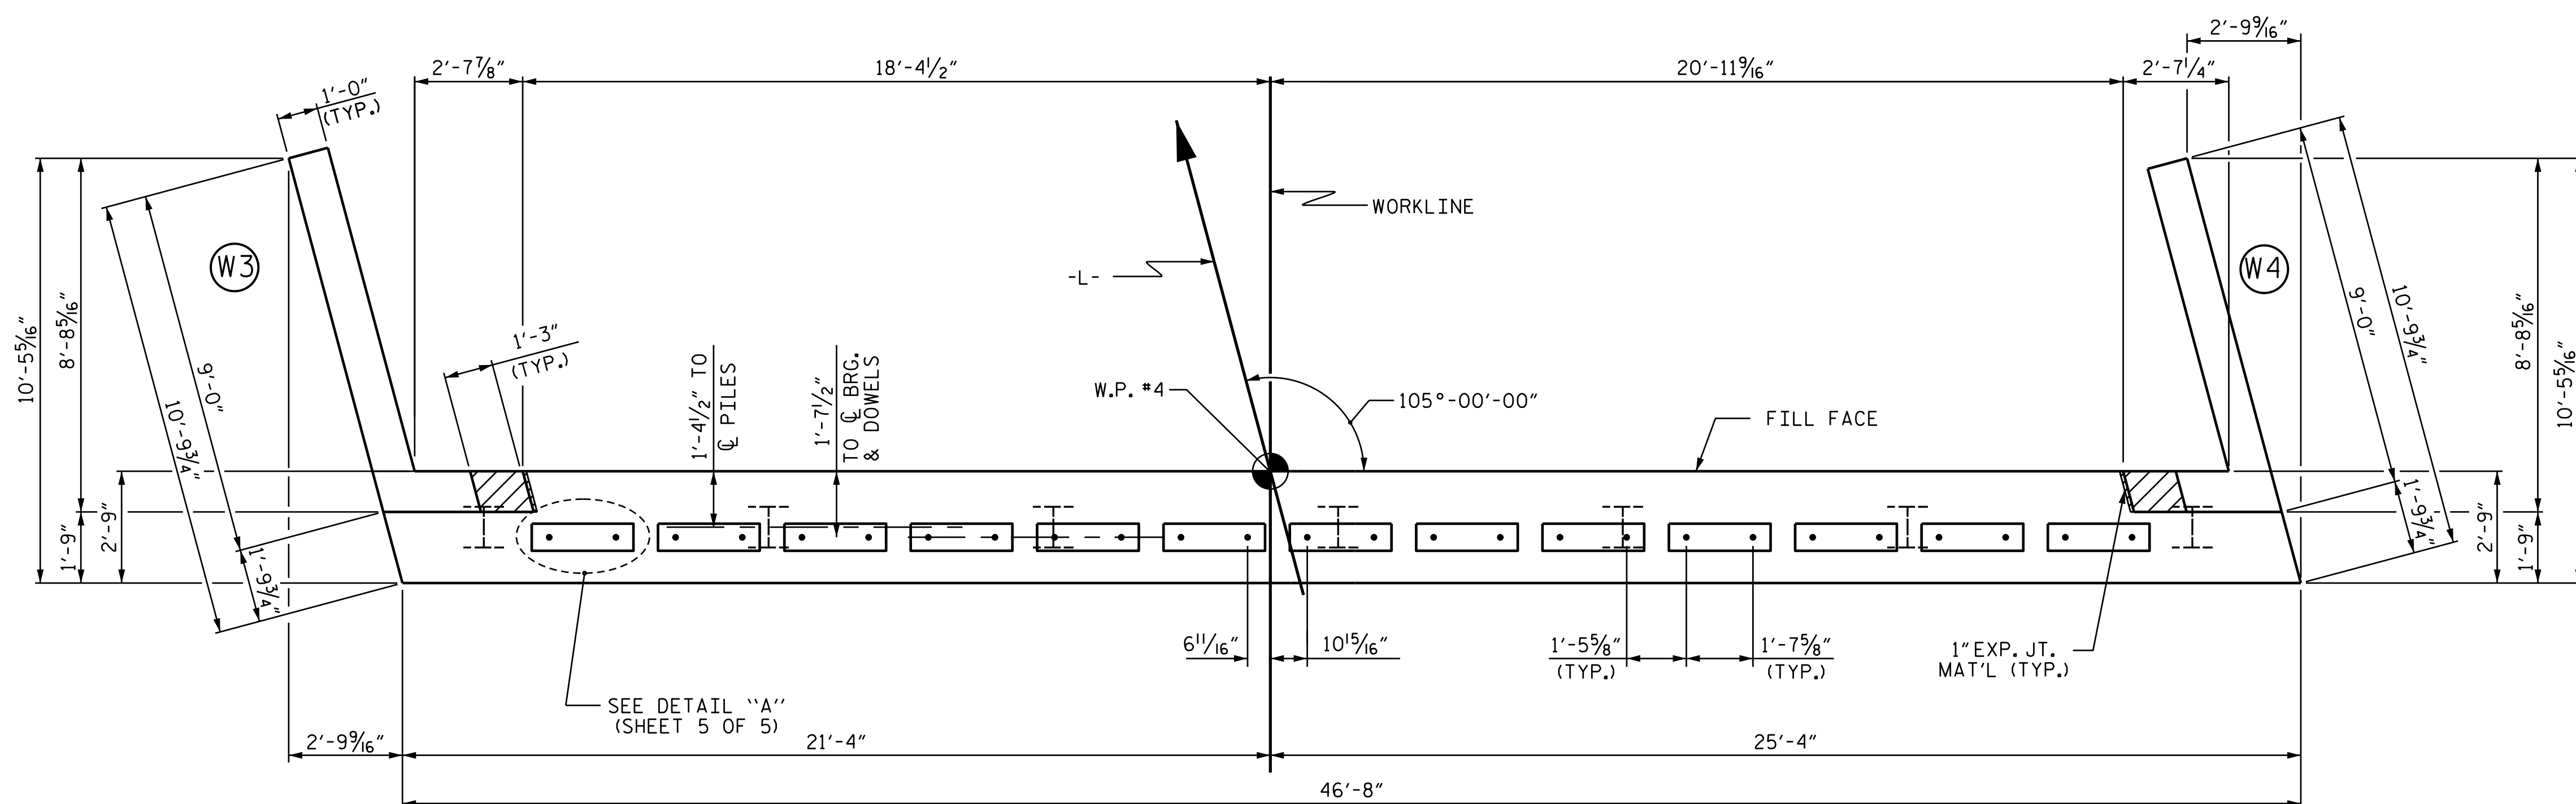

PLAN

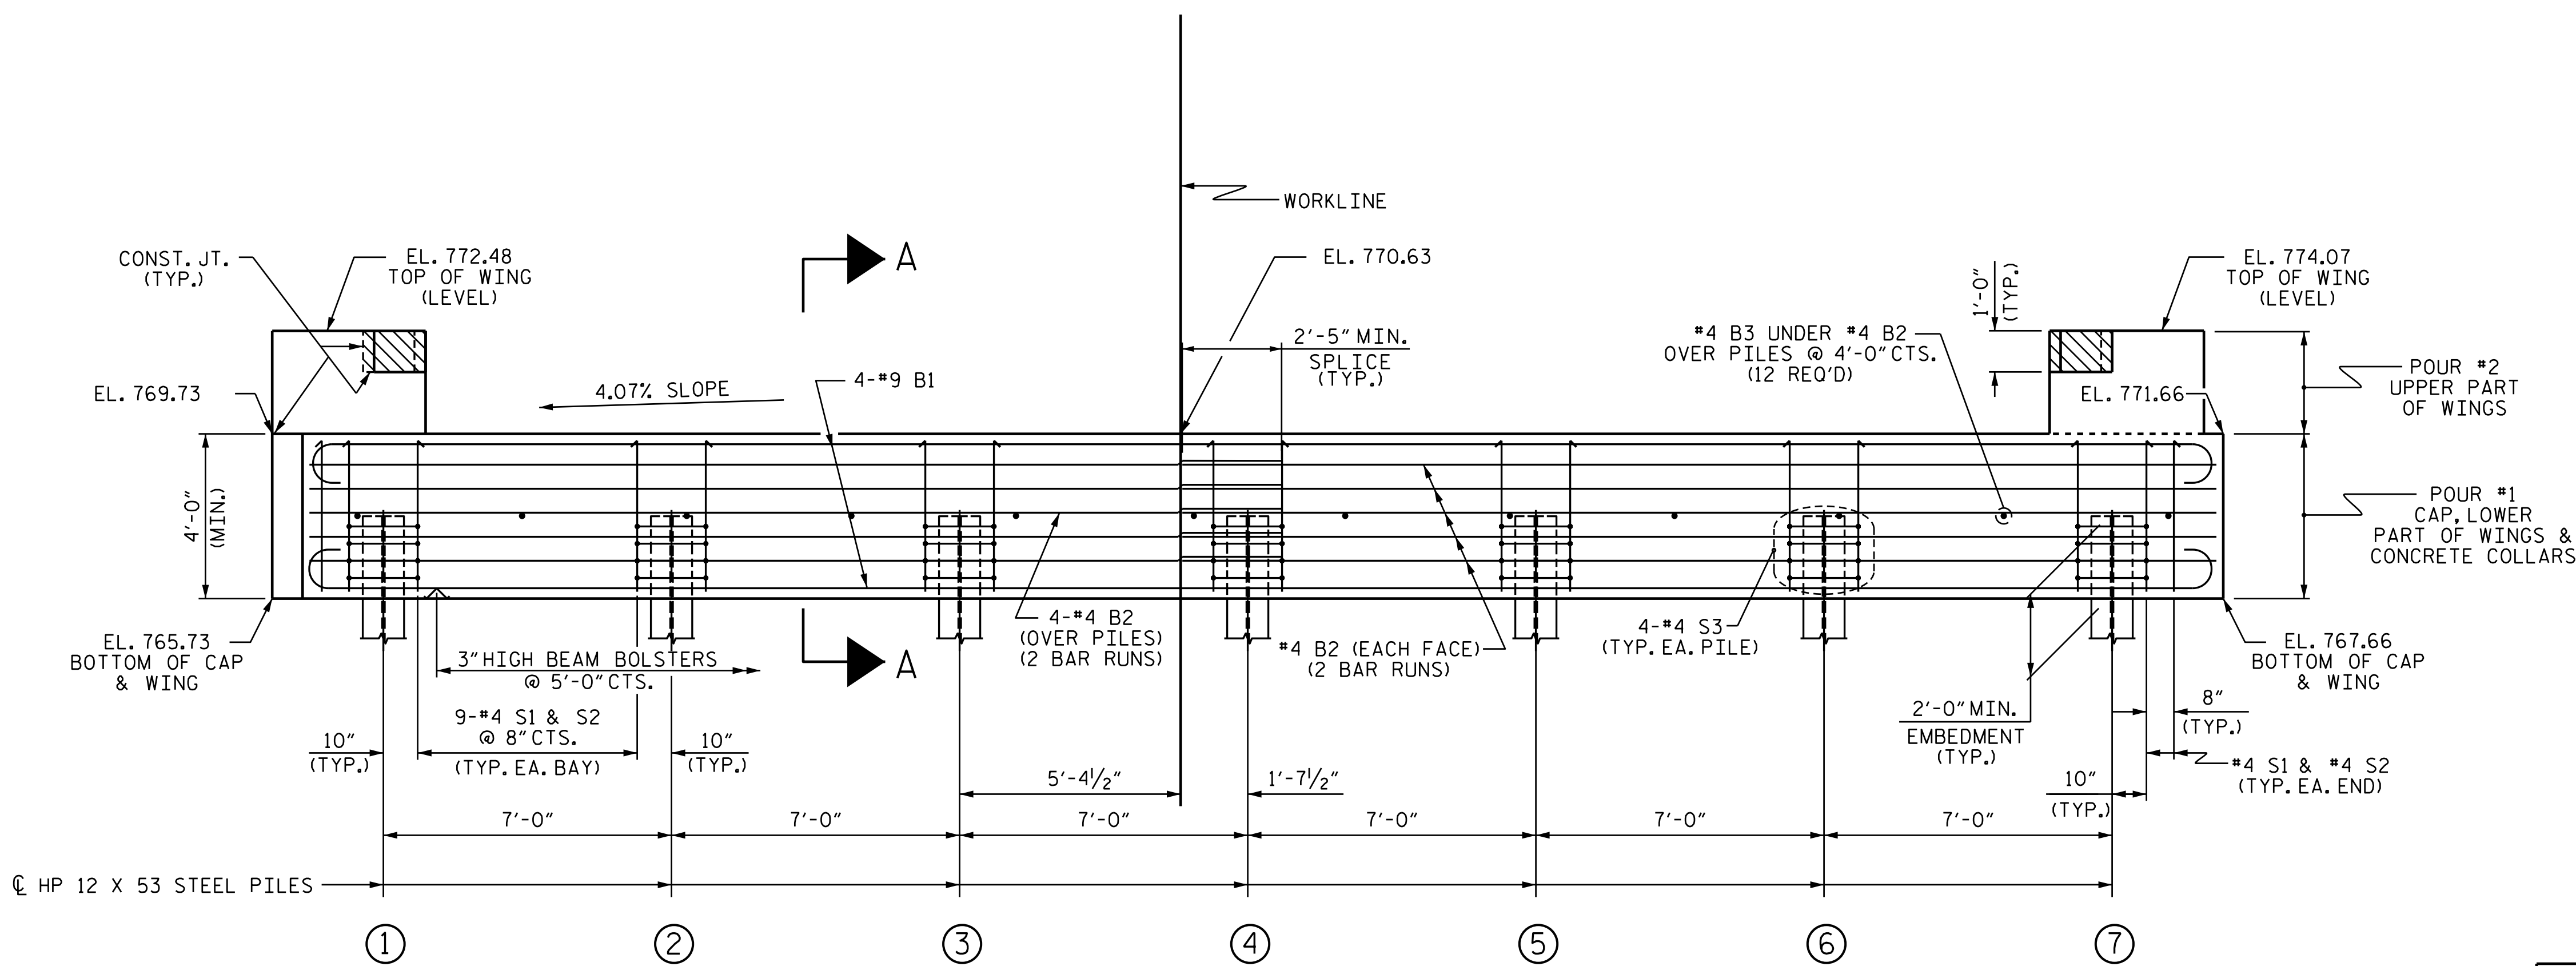

ELEVATION

WINGS NOT SHOWN FOR CLARITY.
FOR SECTION A-A, SEE SHEET 5 OF 5.
CONCRETE COLLARS FOR STEEL PILES NOT SHOWN IN PLAN AND ELEVATION VIEWS FOR CLARITY.
SEE "CORROSION PROTECTION FOR STEEL PILES DETAIL", SHEET 5 OF 5.

TOP OF PILE ELEVATIONS	
①	767.84
②	768.12
③	768.41
④	768.69
⑤	768.98
⑥	769.26
⑦	769.55


PROJECT NO. 17BP.7.R.127
GUILFORD COUNTY
STATION: 15+33.00 -L-

SHEET 3 OF 5

STATE OF NORTH CAROLINA
DEPARTMENT OF TRANSPORTATION
RALEIGH

SUBSTRUCTURE
END BENT 2

REVISIONS						SHEET NO.
NO.	BY:	DATE:	NO.	BY:	DATE:	S-22
1			3			TOTAL SHEETS
2			4			30

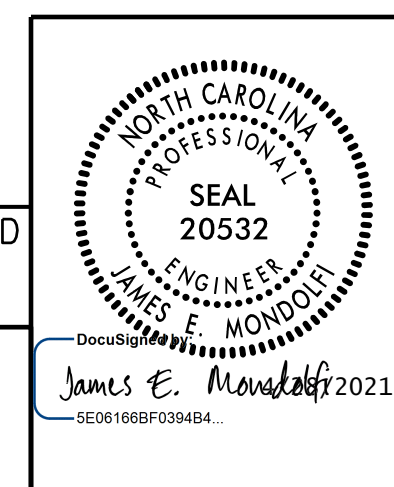


DOCUMENT NOT CONSIDERED FINAL UNLESS ALL SIGNATURES COMPLETED


PLANS PREPARED BY:
MOTT MACDONALD
PO Box 700
Fuquay-Varina, NC 27526
(919) 552-2253
www.mottmac.com
LICENSE NO. F-0669

157077
 I:\Projects\17BP.7.R.127-SMU.E-400067.dgn
 4/27/2021 12:10:34 PM


DRAWN BY: J. M. ABRIL DATE: 2-2021
 CHECKED BY: J. E. MONDOLFI DATE: 2-2021
 DESIGN ENGINEER OF RECORD: J. E. MONDOLFI DATE: 2-2021

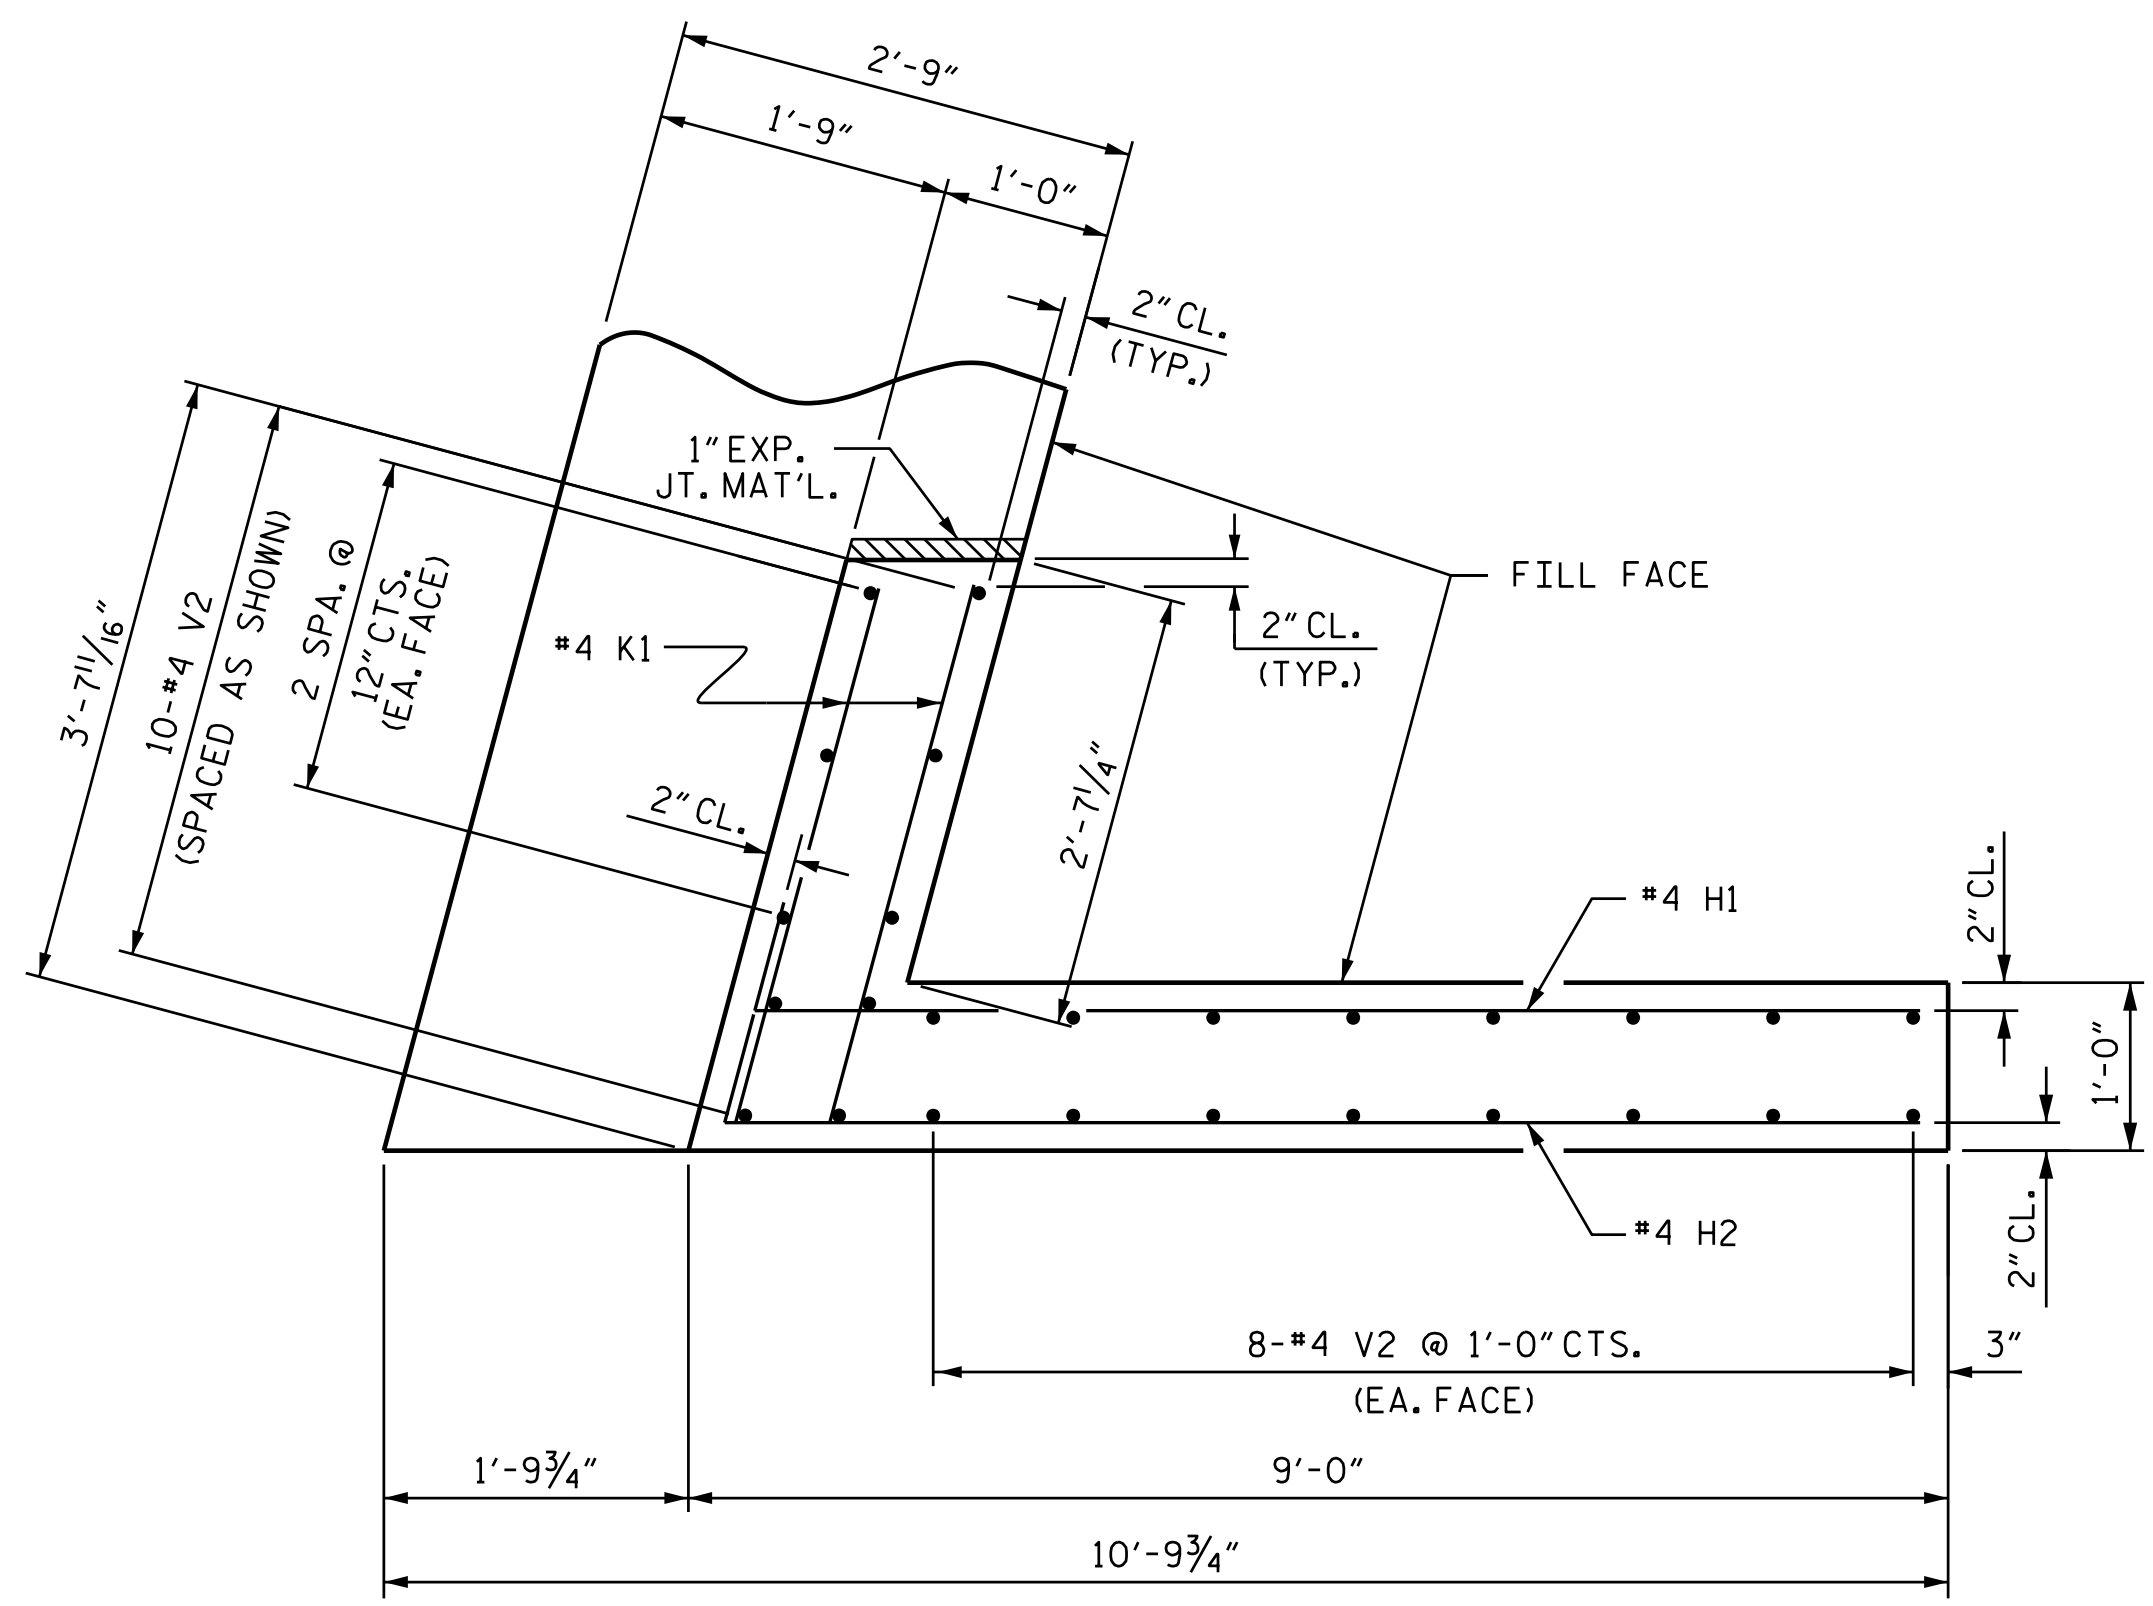


PLAN OF WING (W4)

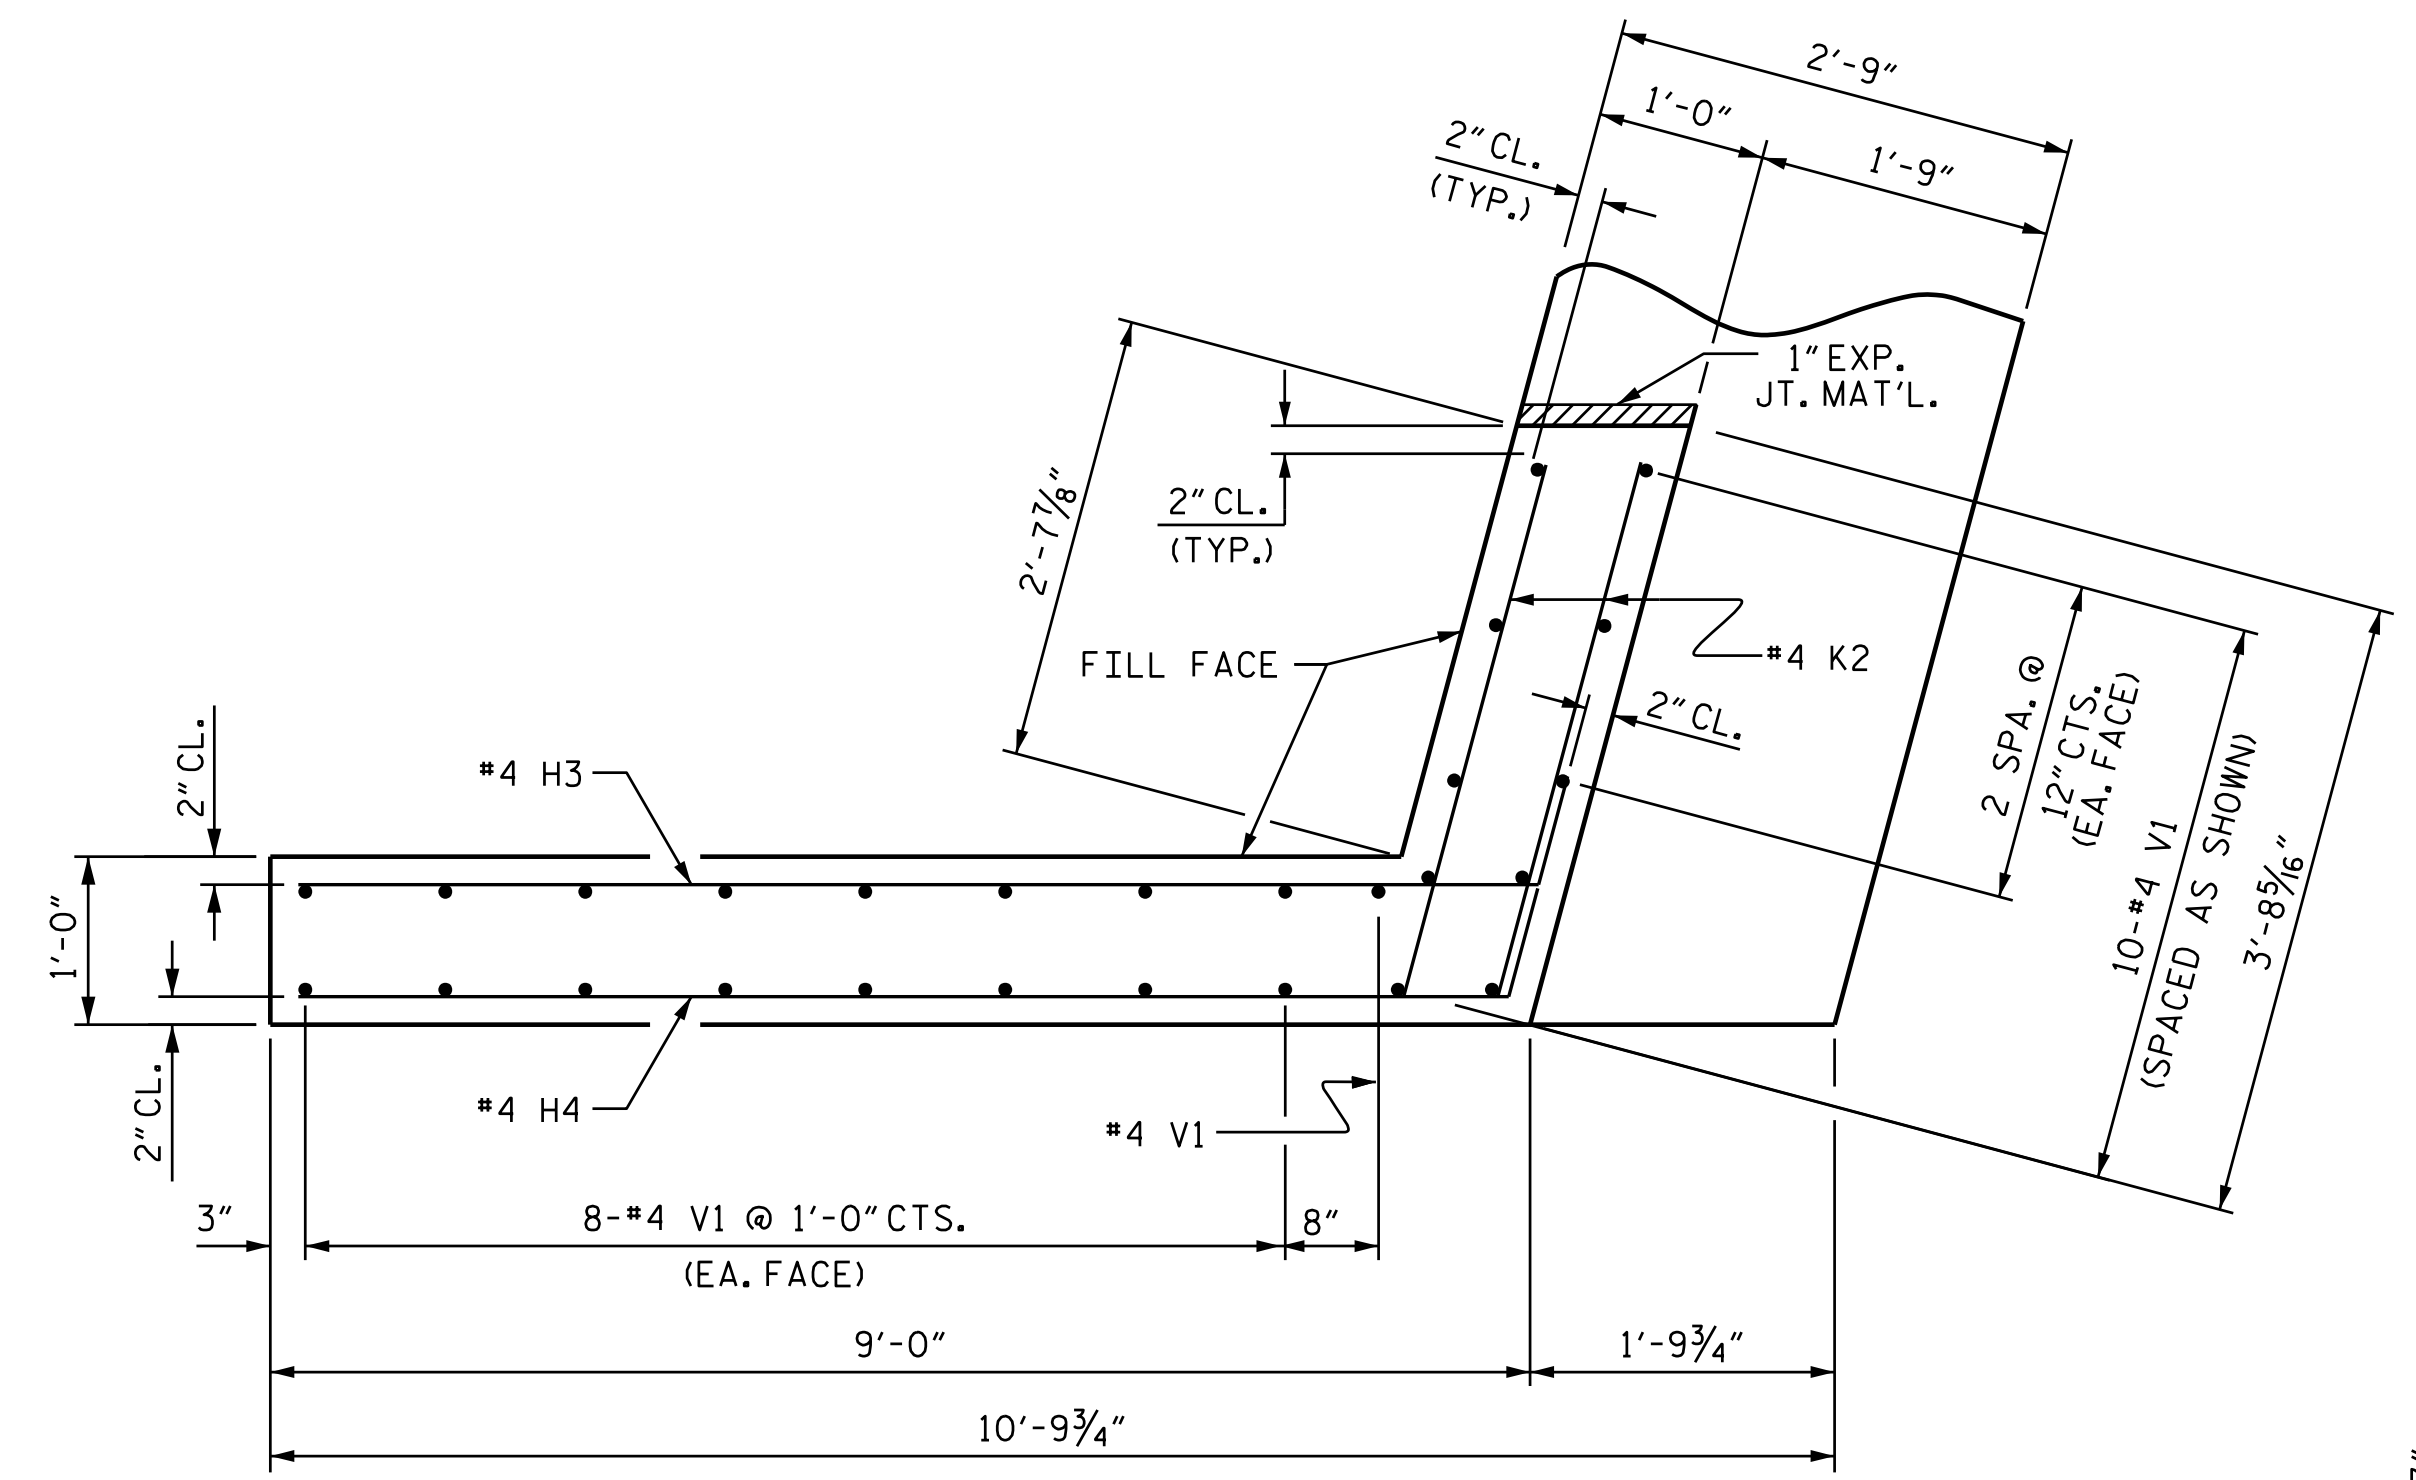


PLAN OF WING (W3)

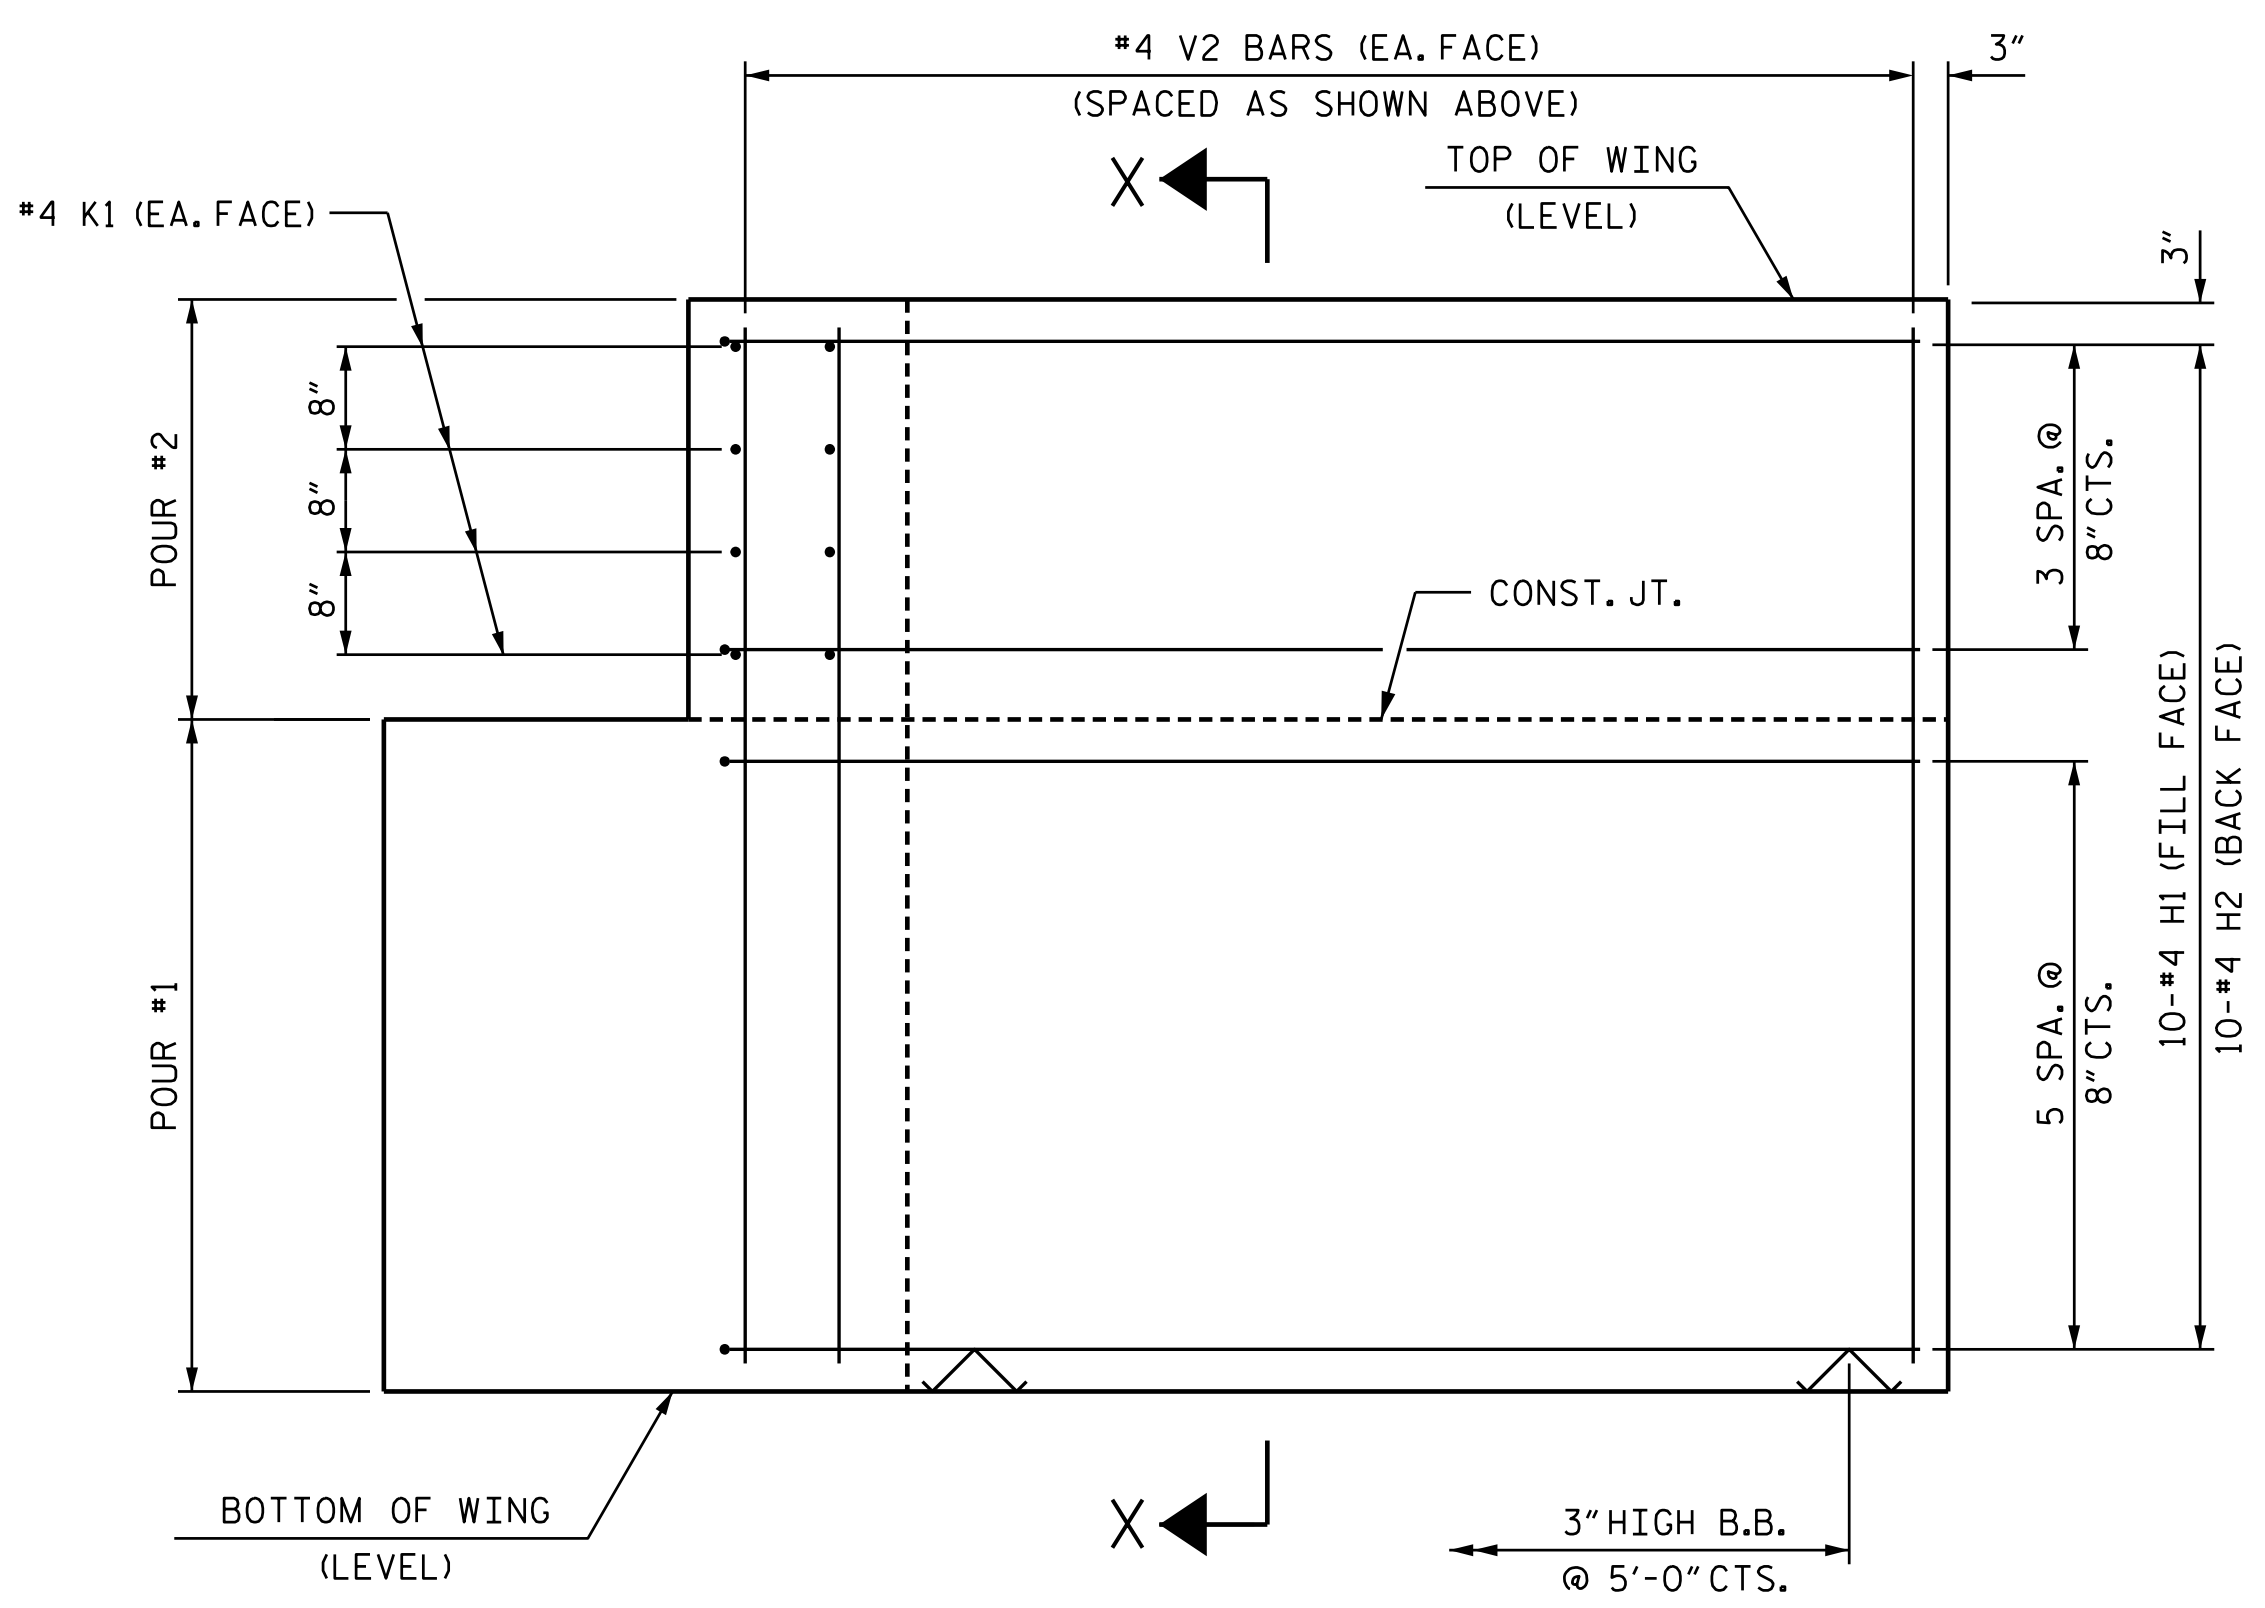


ELEVATION OF WING (W4)

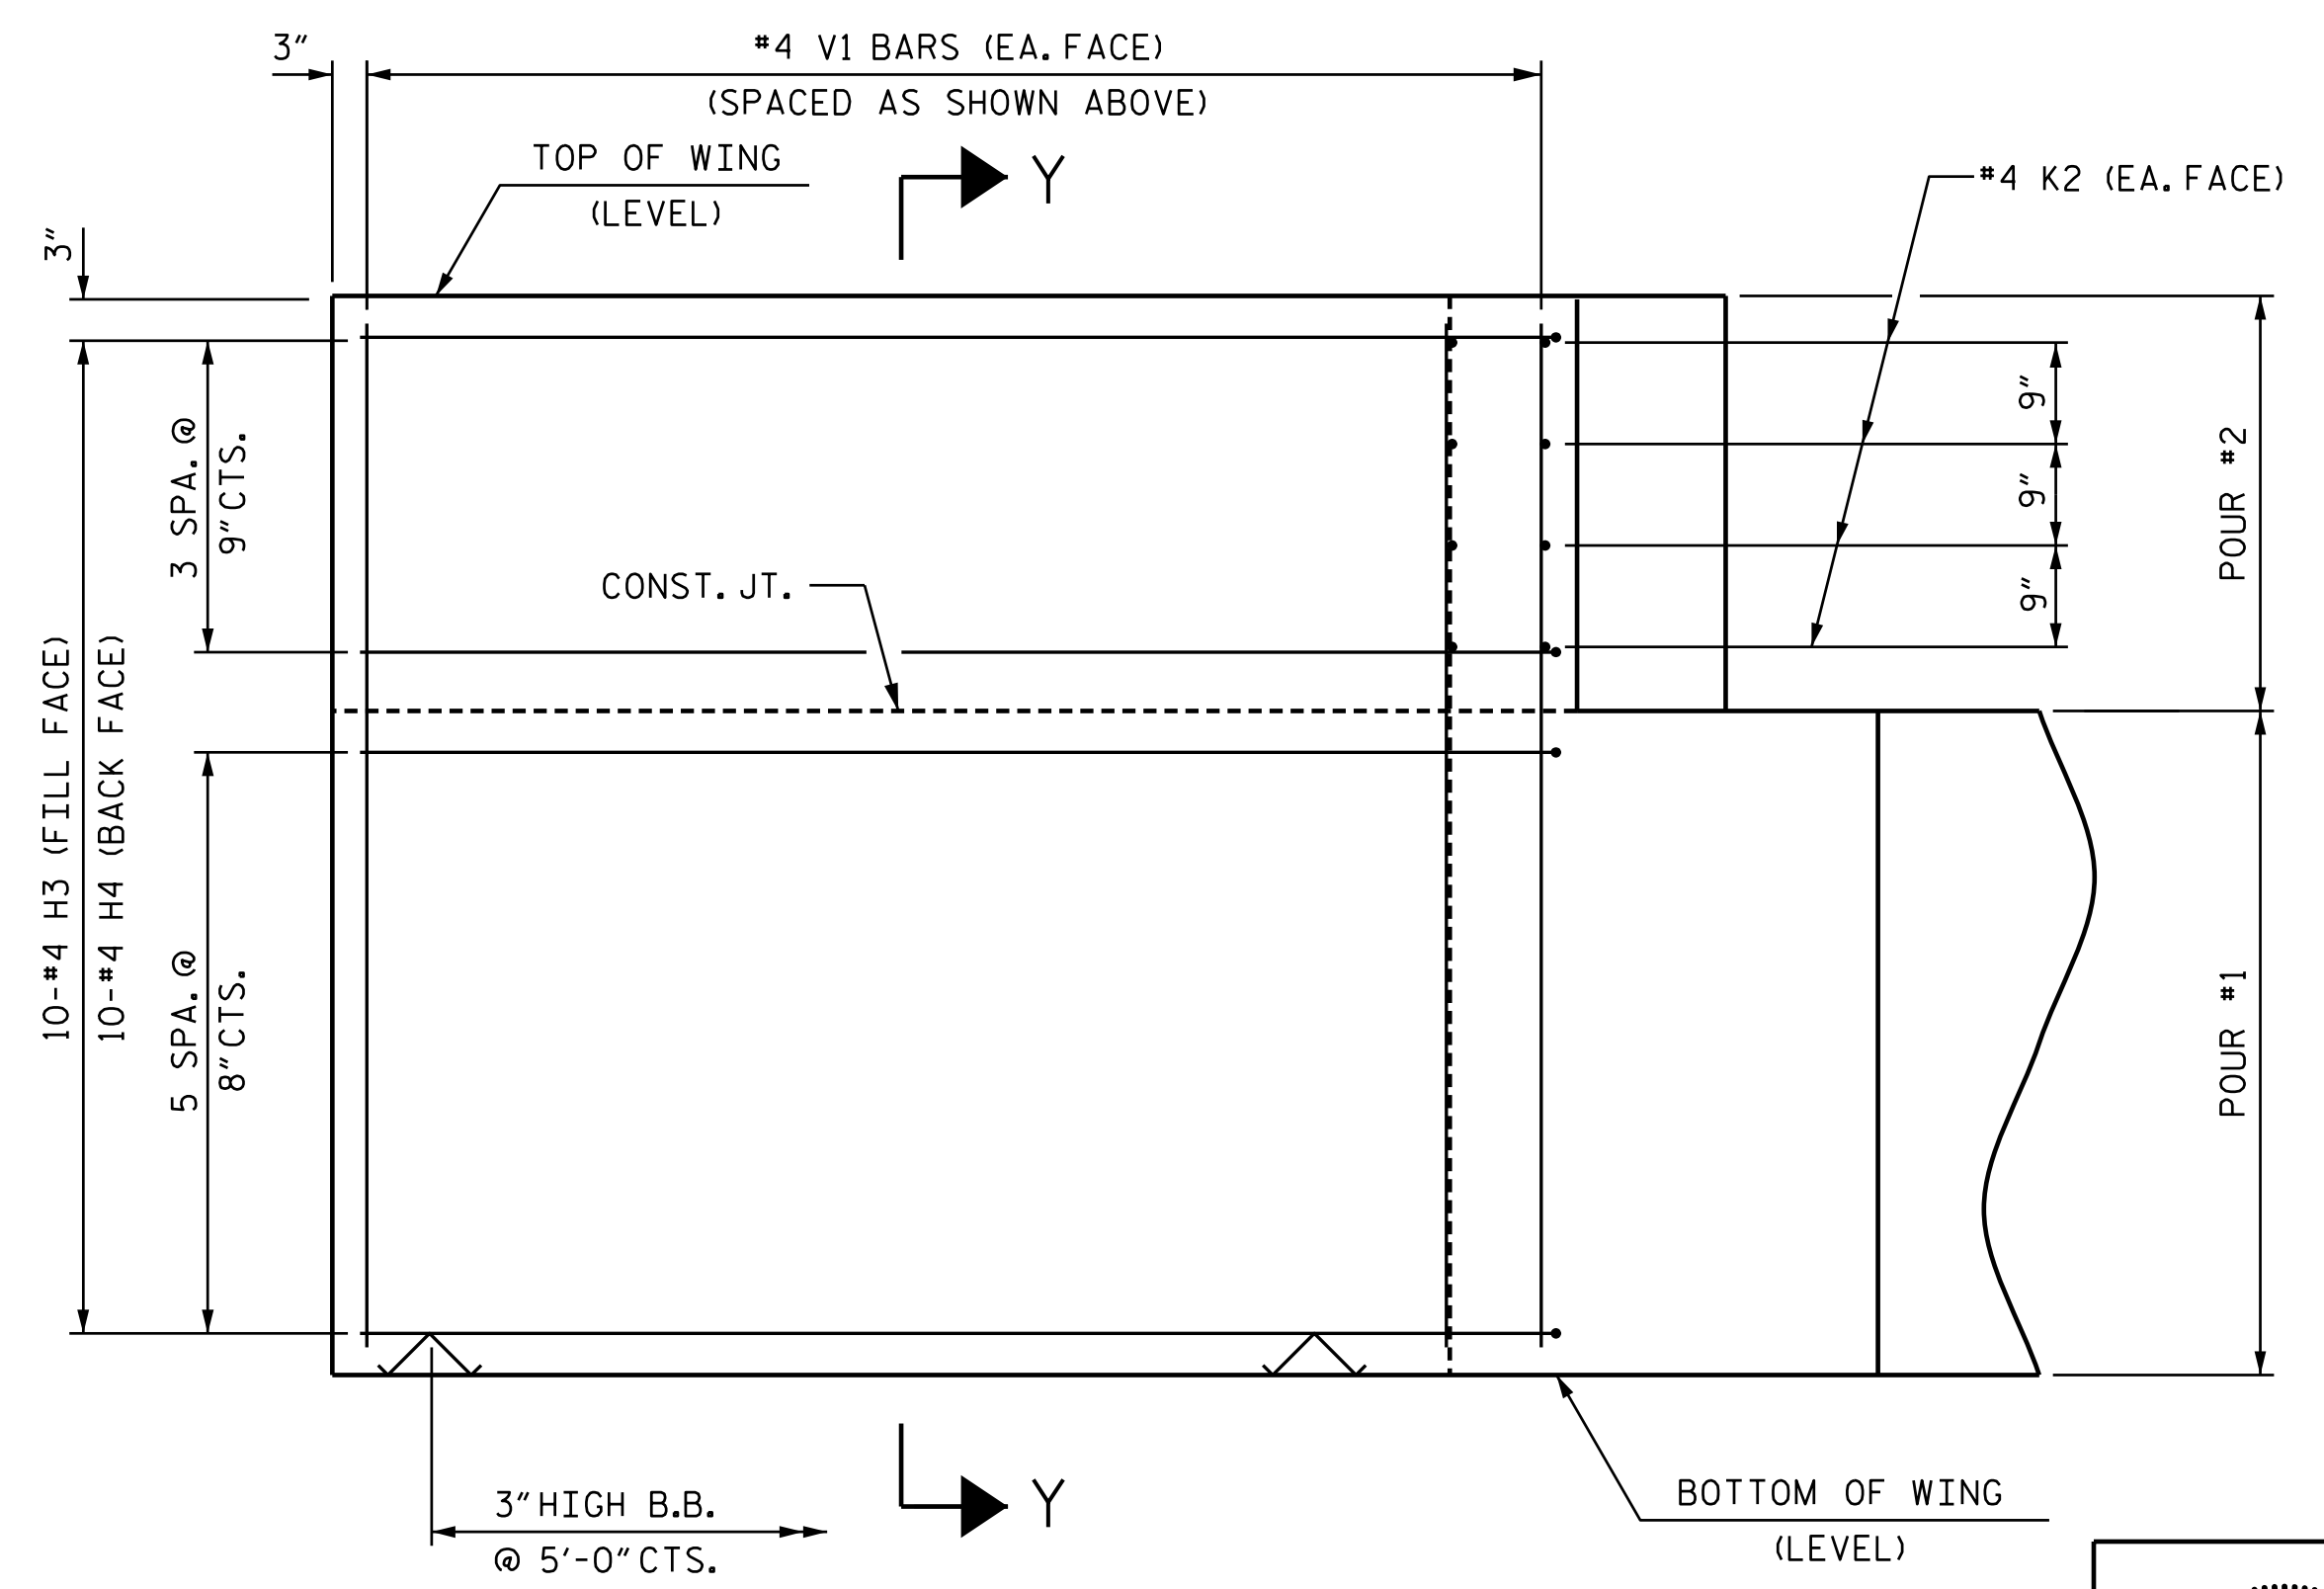

ELEVATION OF WING (W3)

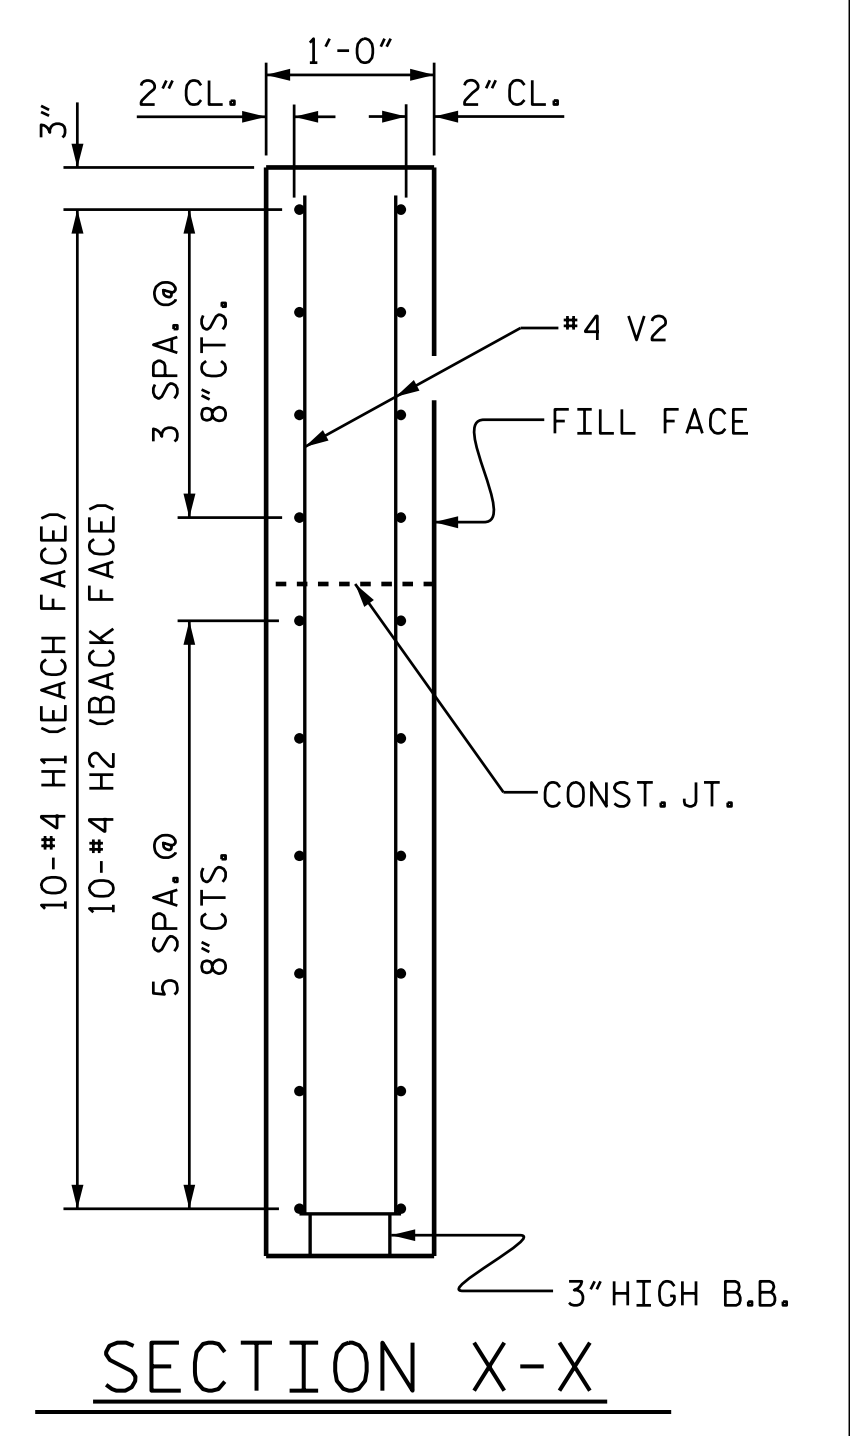

SECTION X-X

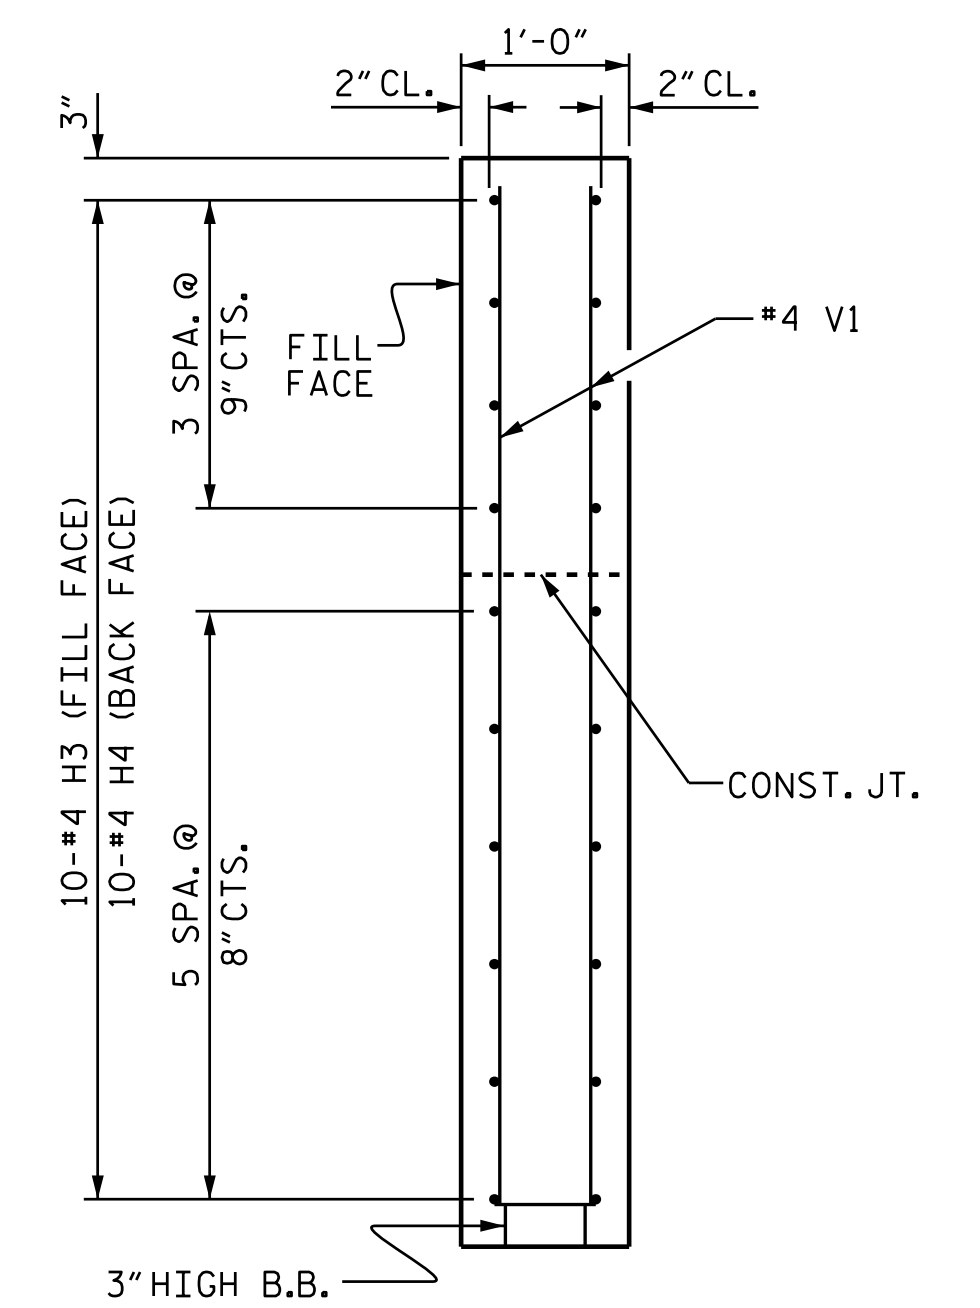

SECTION Y-Y


PROJECT NO. 17BP.7.R.127
 GUILFORD COUNTY
 STATION: 15+33.00 -L-

SHEET 4 OF 5

STATE OF NORTH CAROLINA
 DEPARTMENT OF TRANSPORTATION
 RALEIGH

SUBSTRUCTURE
 END BENT 2
 WING DETAILS

REVISIONS						SHEET NO.
NO.	BY:	DATE:	NO.	BY:	DATE:	S-23
1			3			TOTAL SHEETS
2			4			30

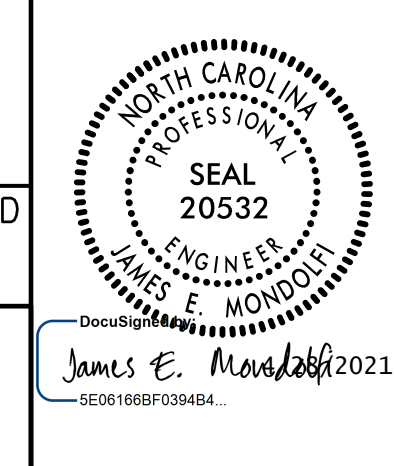

DOCUMENT NOT CONSIDERED FINAL UNLESS ALL SIGNATURES COMPLETED

PLANS PREPARED BY:
 MOTT MACDONALD
 PO Box 700
 Fuquay-Varina, NC 27526
 (919) 552-2253
 www.mottmac.com
 LICENSE NO. F-0669

#157077
 C:\Users\jplons\17BP.7.R.127-SMU.E-400067.dgn
 4/27/2021 12:10:35 PM

DRAWN BY: J. M. ABRIL DATE: 2-2021
 CHECKED BY: J. E. MONDOLFI DATE: 2-2021
 DESIGN ENGINEER OF RECORD: J. E. MONDOLFI DATE: 2-2021

WING DETAILS

NOTES

STIRRUPS IN CAP MAY BE SHIFTED AS NECESSARY TO CLEAR DOWELS.

HOOKE ON "V" BARS MAY BE TURNED AS NECESSARY FOR PLACING REINFORCING STEEL.


FOR DRILLED PIERS, SEE SECTION 411 OF THE STANDARD SPECIFICATIONS.

ALL STEEL IN THE DRILLED PIERS IS INCLUDED IN THE PAY ITEMS FOR "REINFORCING STEEL" AND "SPIRAL COLUMN REINFORCING STEEL."


★ INVERT ALTERNATE STIRRUPS.

THE LOCATION OF THE CONSTRUCTION JOINT IN THE DRILLED PIERS IS BASED ON AN APPROXIMATE GROUND LINE ELEVATION. IF THE CONSTRUCTION JOINT IS ABOVE THE ACTUAL GROUND LINE ELEVATION, THE CONTRACTOR SHALL PLACE THE CONSTRUCTION JOINT ONE FOOT BELOW THE GROUND LINE.


THE CONTRACTOR'S ATTENTION IS CALLED TO THE FACT THAT THE LONGITUDINAL REINFORCEMENT FOR DRILLED PIERS IS DETAILED WITH 3 FEET OF EXTRA LENGTH.

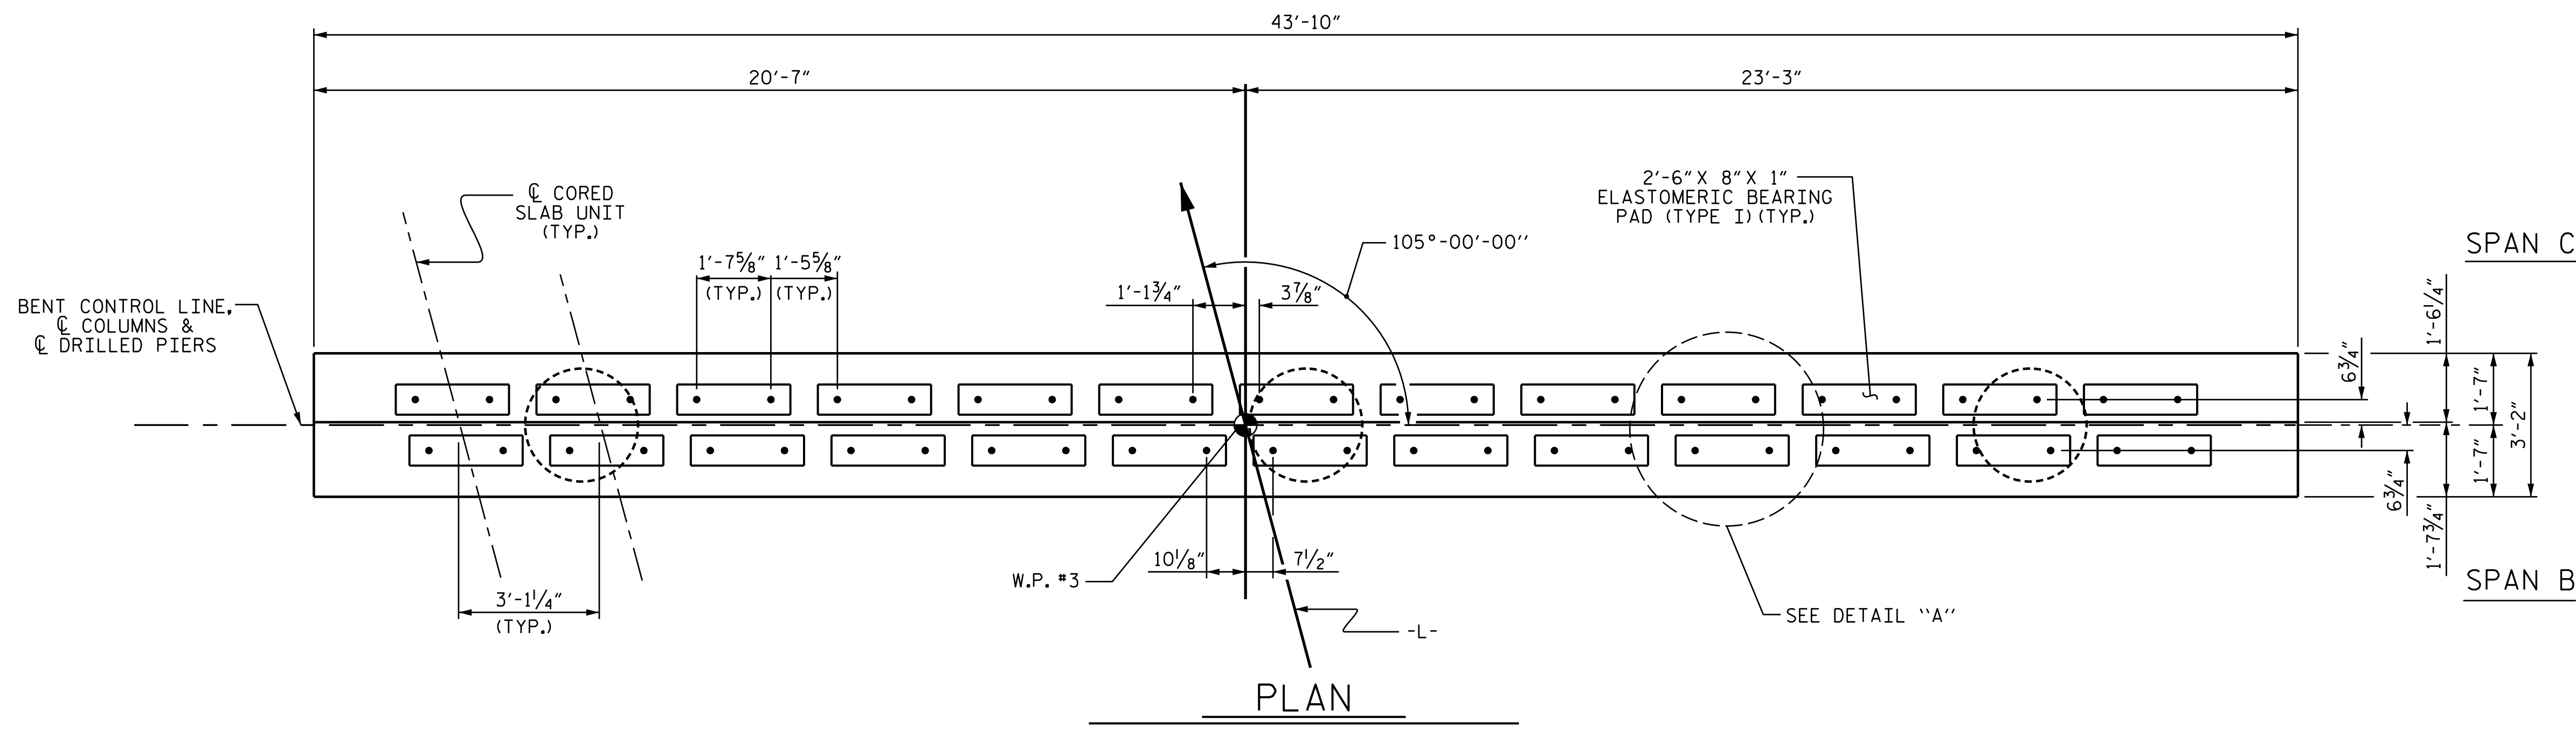

PLAN

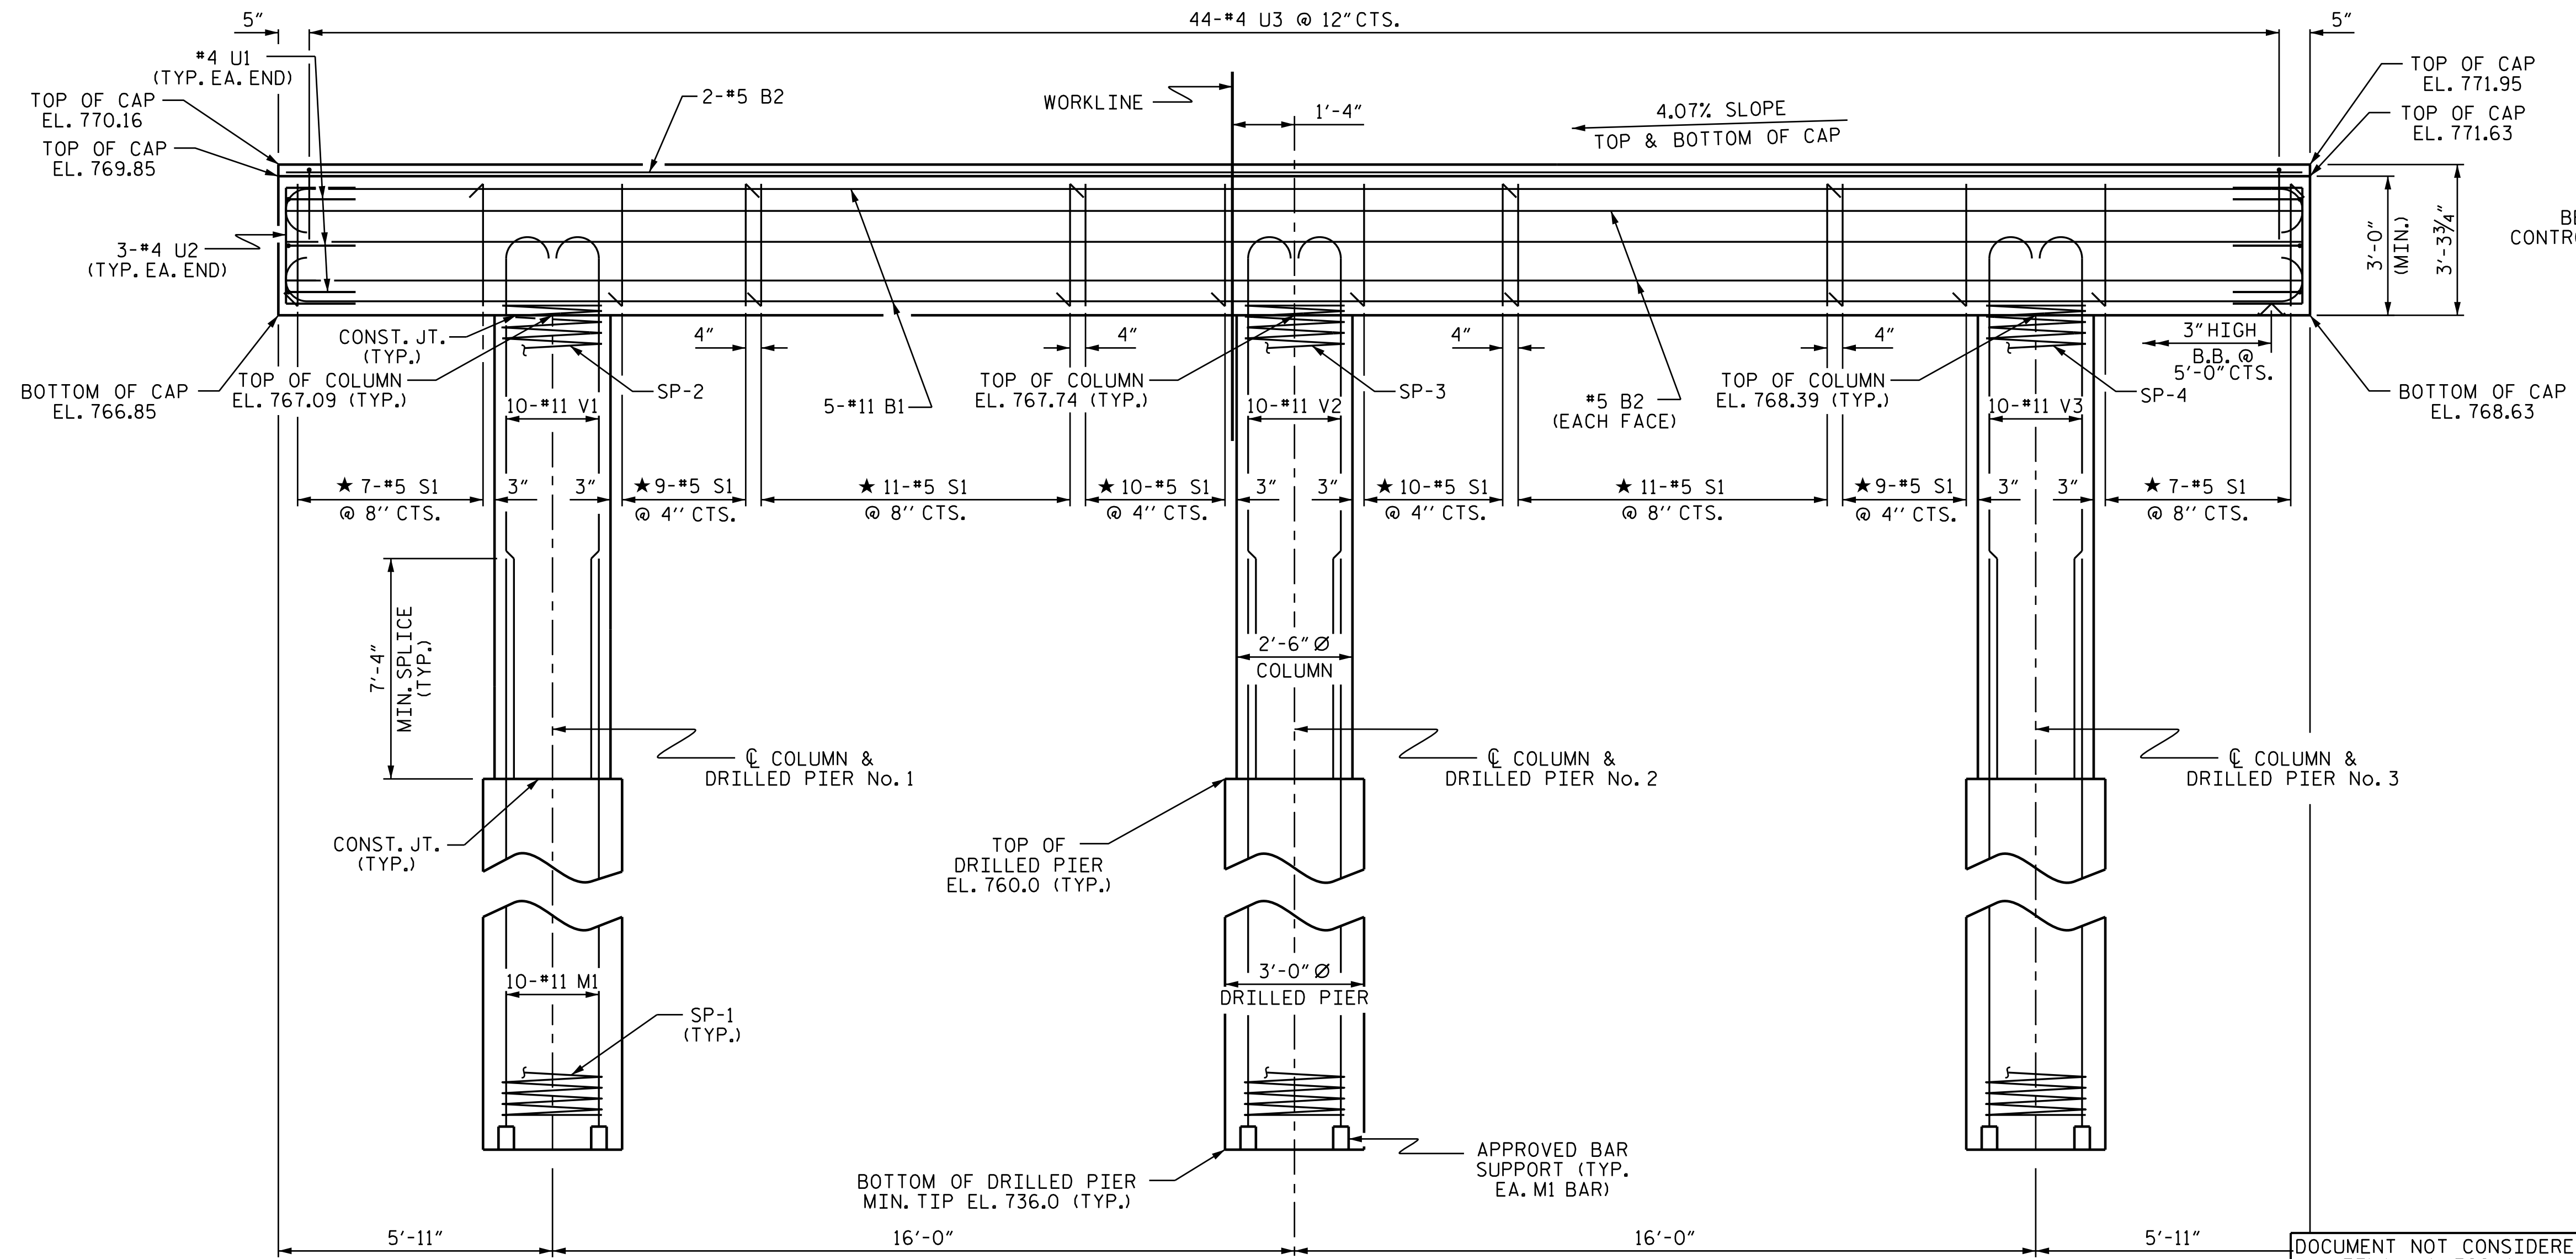

ELEVATION

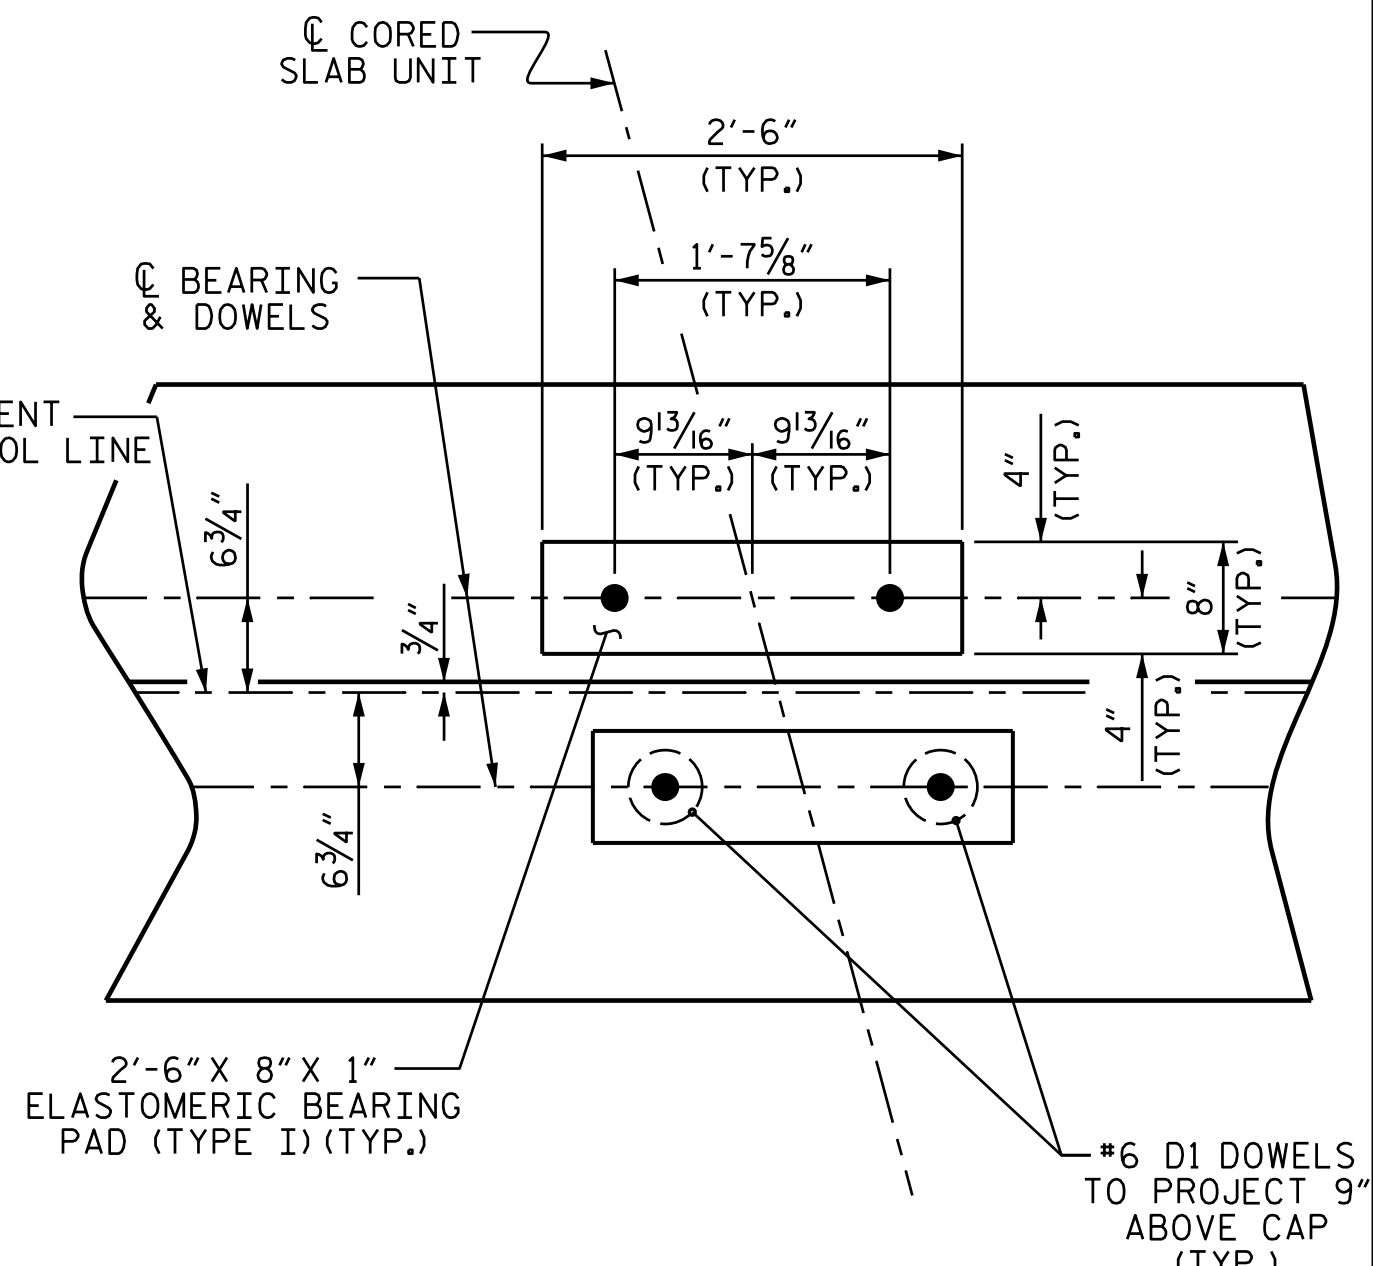


DETAIL "A"

(DIMENSIONS ARE TYPICAL EACH BEARING)

PROJECT NO. 17BP.7.R.127
 GUILFORD COUNTY
 STATION: 15+33.00 -L-

SHEET 3 OF 4

STATE OF NORTH CAROLINA
 DEPARTMENT OF TRANSPORTATION
 RALEIGH
 SUBSTRUCTURE
 BENT No. 2

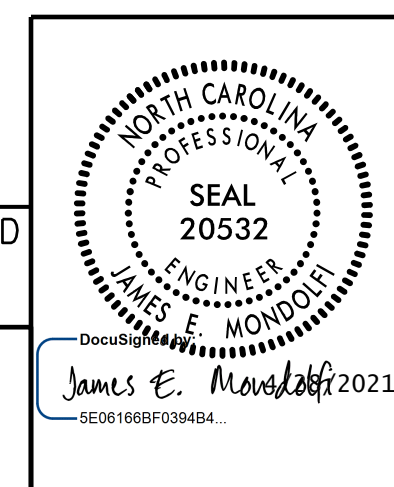

DOCUMENT NOT CONSIDERED FINAL UNLESS ALL SIGNATURES COMPLETED


PLANS PREPARED BY:
 MOTT MACDONALD
 PO Box 700
 Fuquay-Varina, NC 27526
 (919) 552-2253
 www.mottmac.com
 LICENSE NO. F-0669

REVISIONS						SHEET NO.
NO.	BY:	DATE:	NO.	BY:	DATE:	S-27
1			3			TOTAL SHEETS
2			4			30


W:\157077\Drawings\17BP.7.R.127-SMU.B.400067.dgn
 4/27/2021 12:10:38 PM

DRAWN BY: J. M. ABRIL DATE: 2-2021
 CHECKED BY: J. E. MONDOLFI DATE: 2-2021
 DESIGN ENGINEER OF RECORD: J. E. MONDOLFI DATE: 2-2021


DIMENSIONS & REINFORCING STEEL ARE TYPICAL FOR EACH COLUMN & DRILLED PIER UNLESS OTHERWISE NOTED.

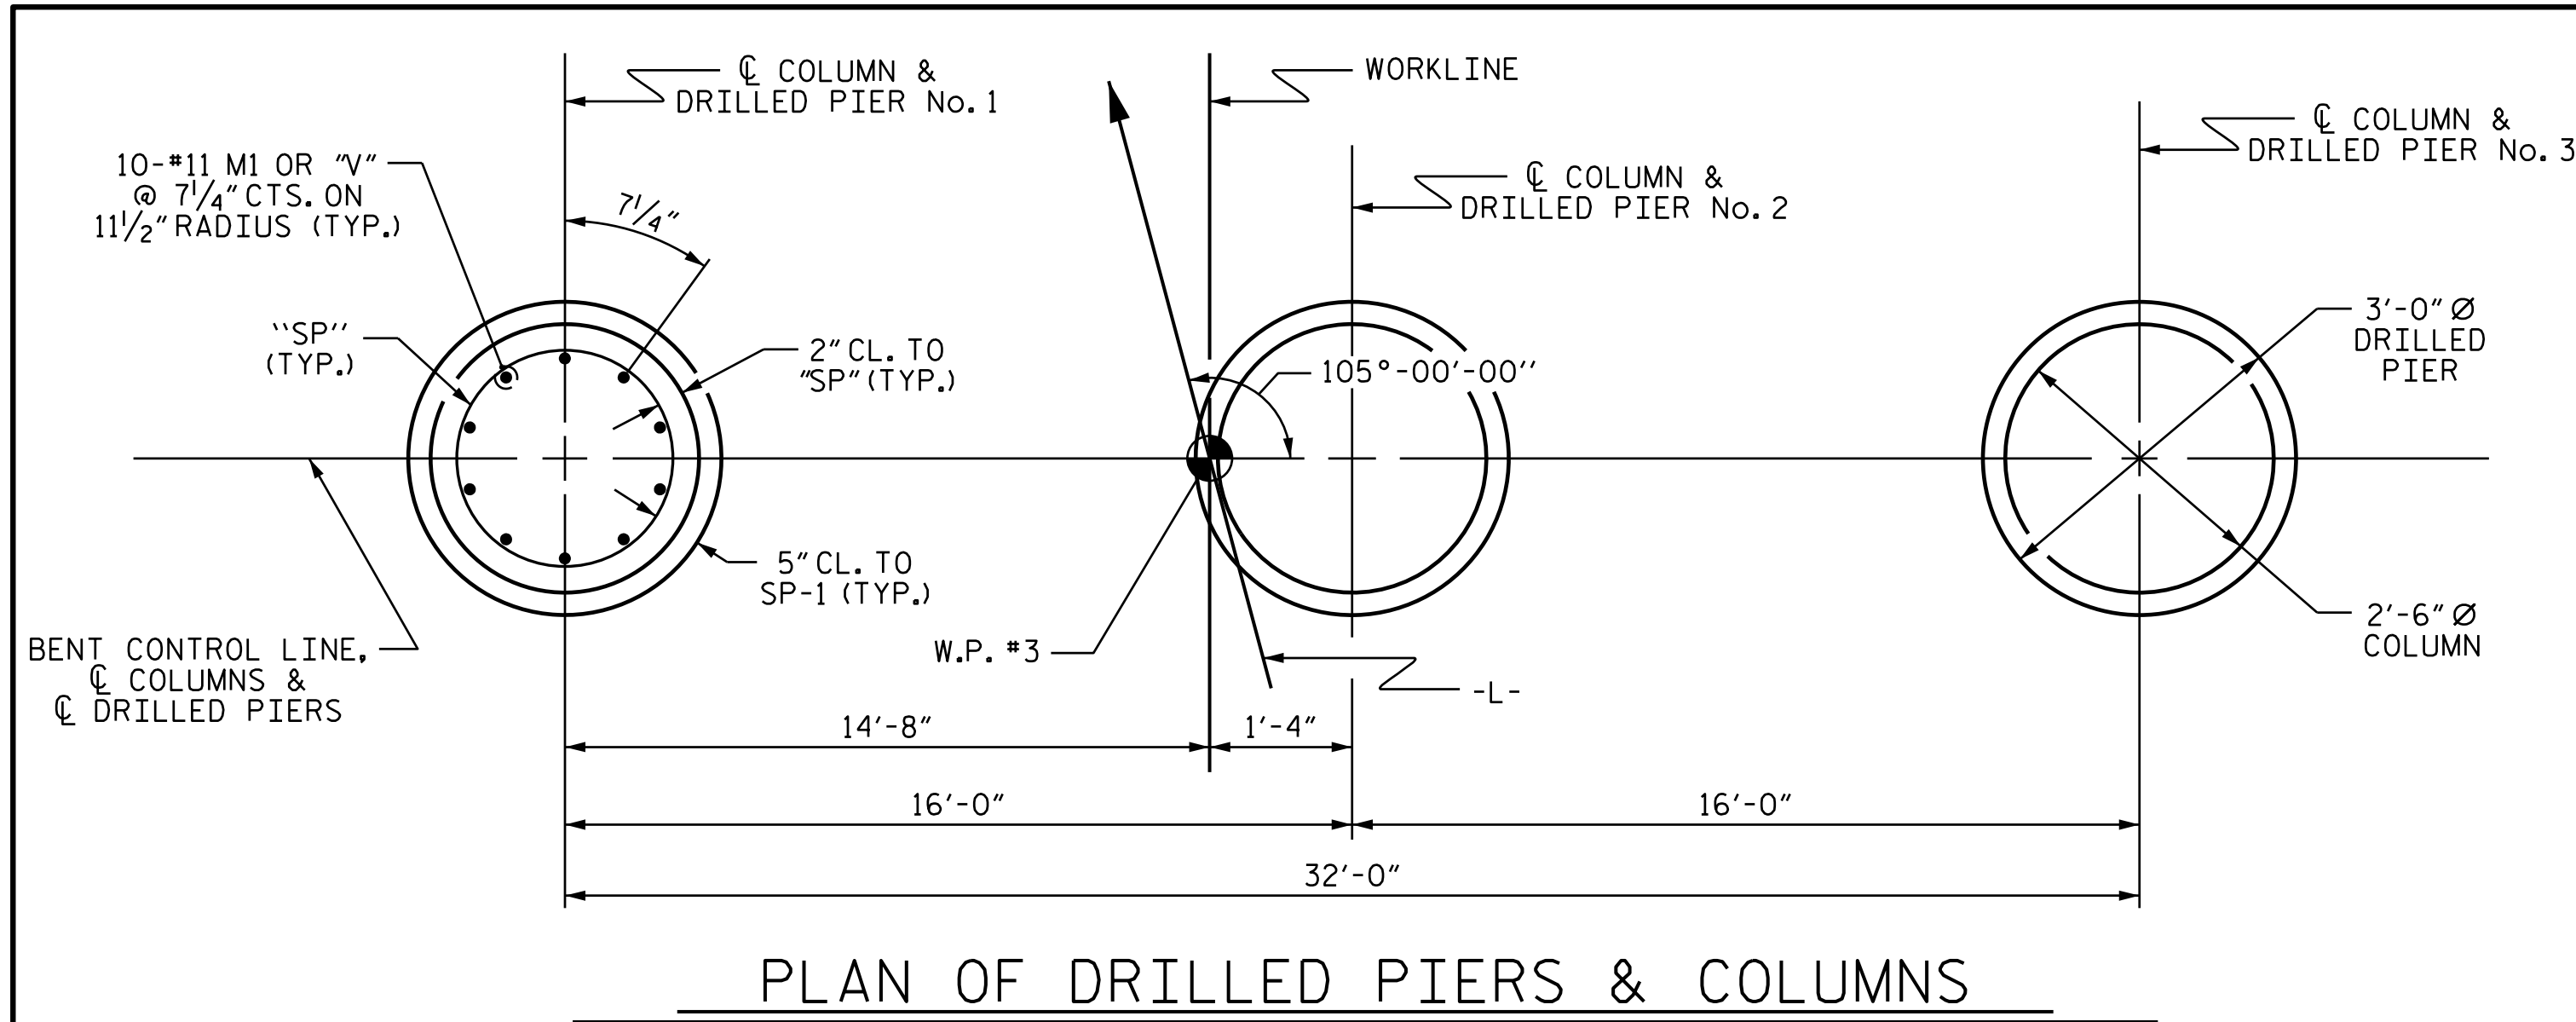


PLAN OF DRILLED PIERS & COLUMNS

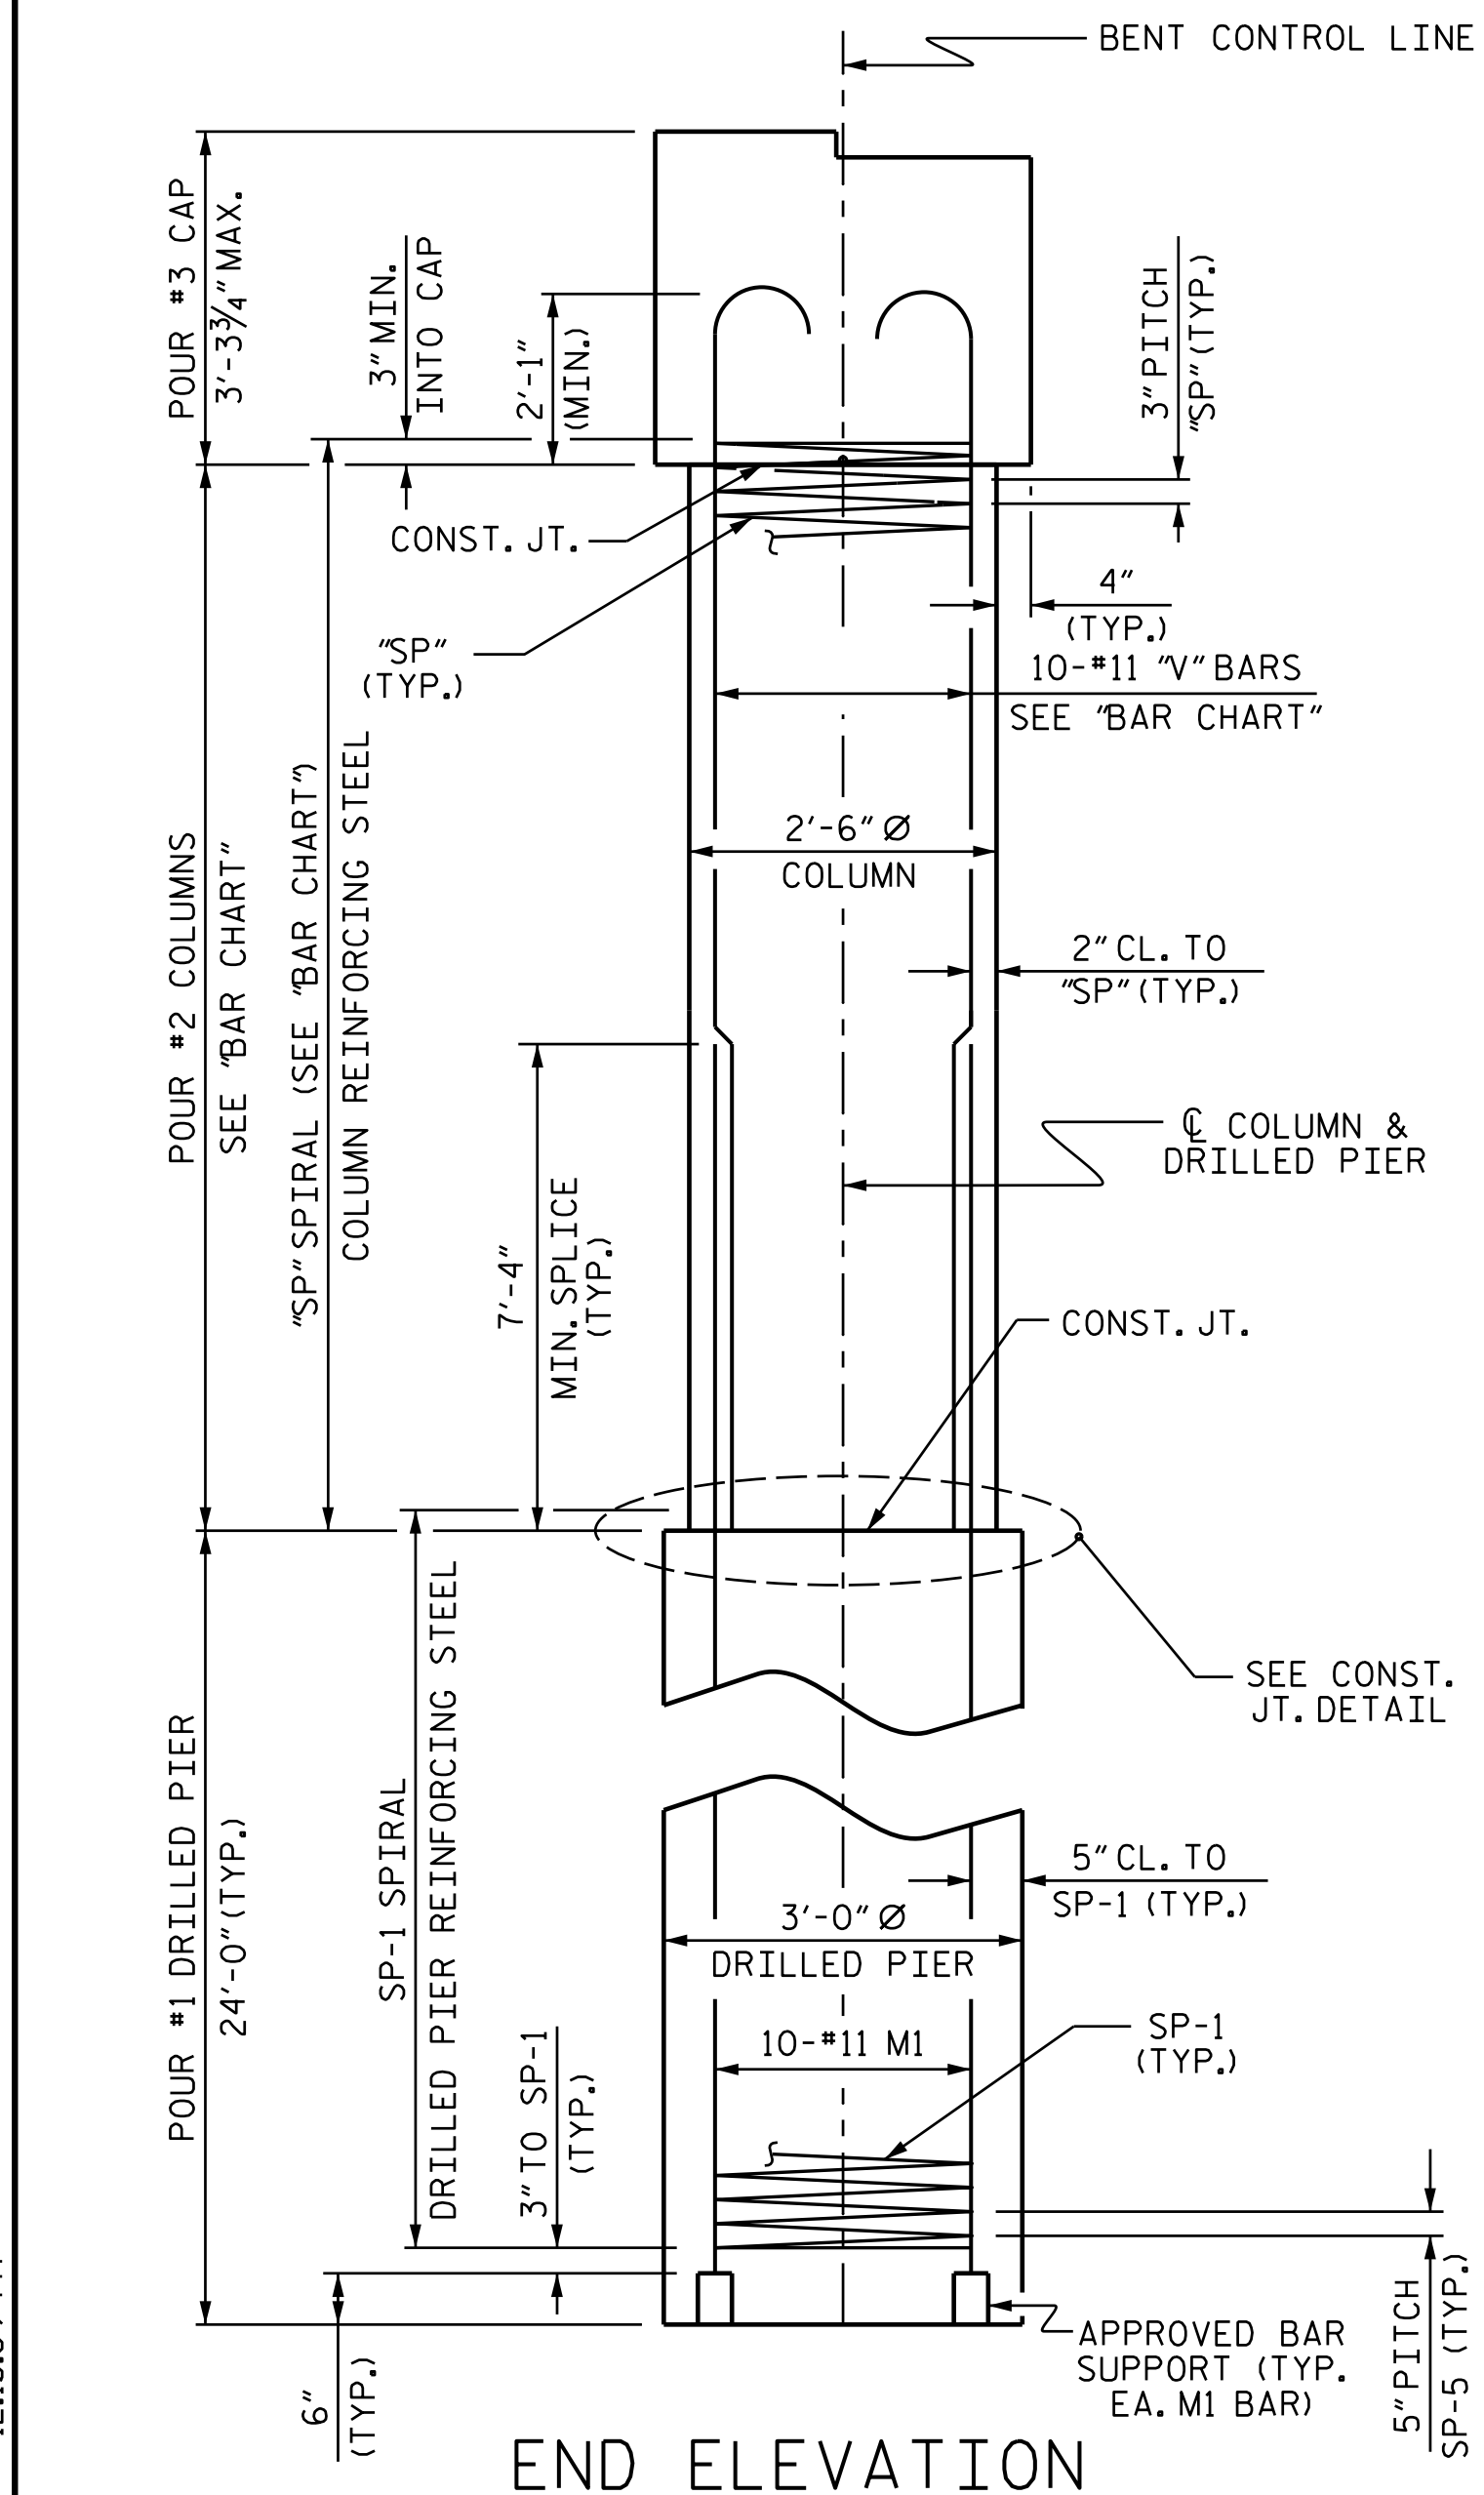

END ELEVATION

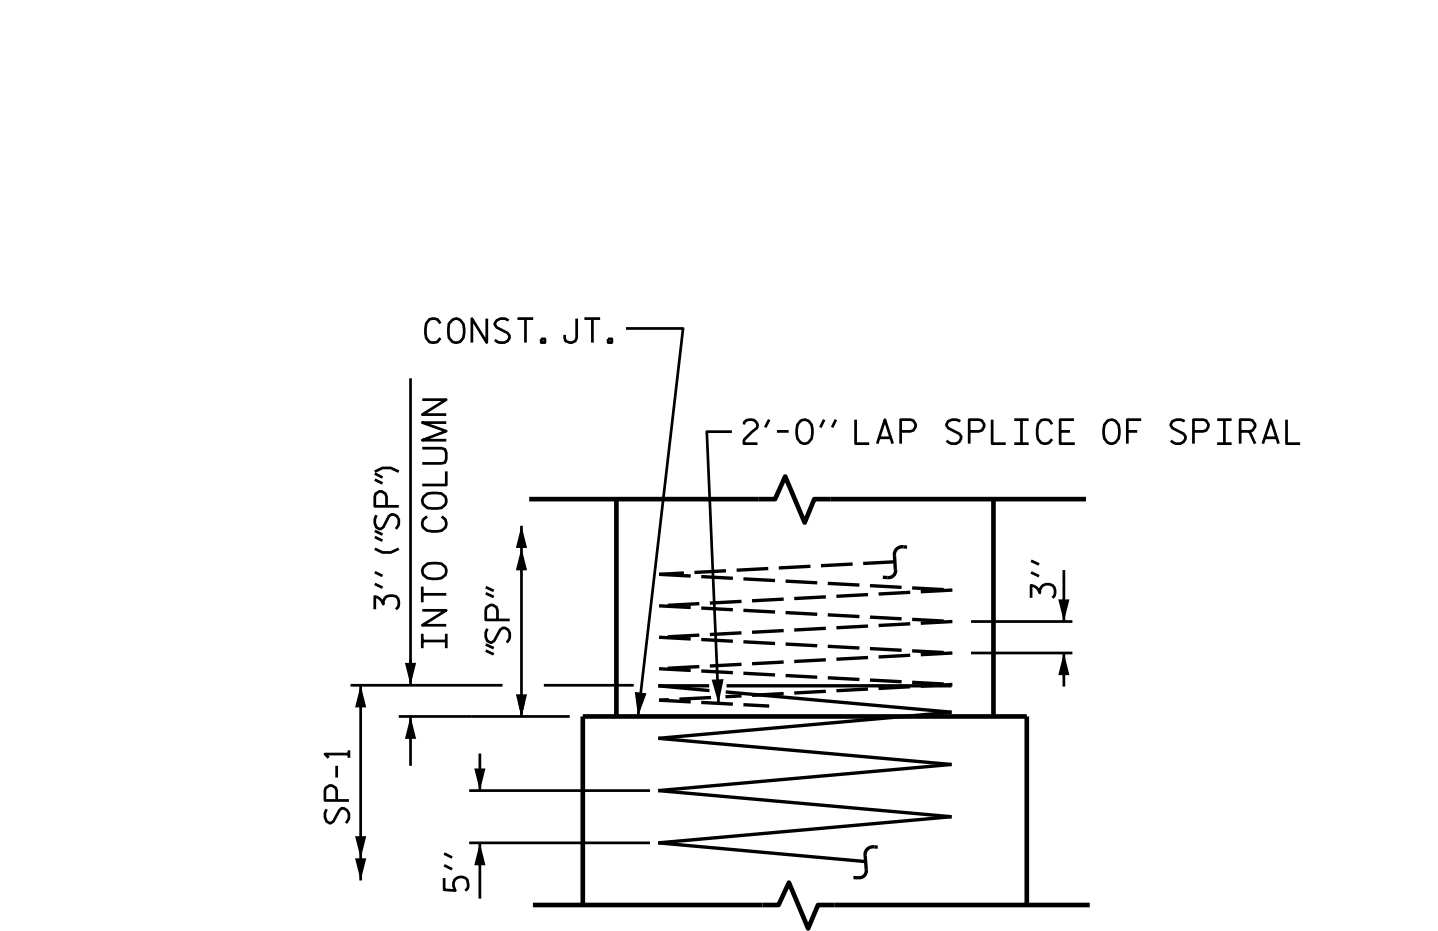


CONSTRUCTION JOINT DETAIL

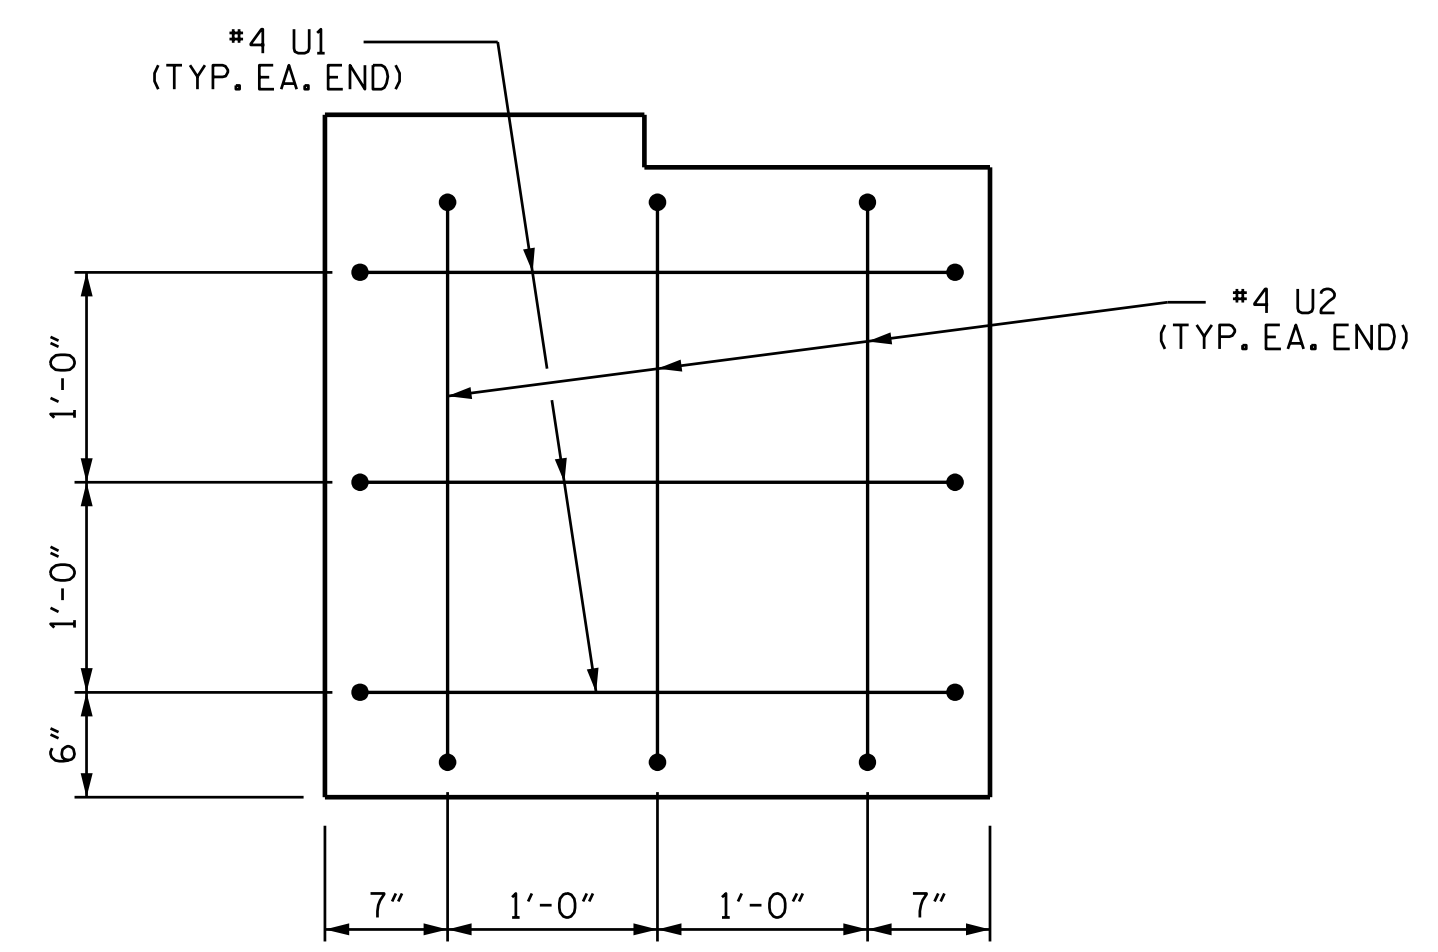


END OF CAP VIEW

(TYPICAL BOTH ENDS)

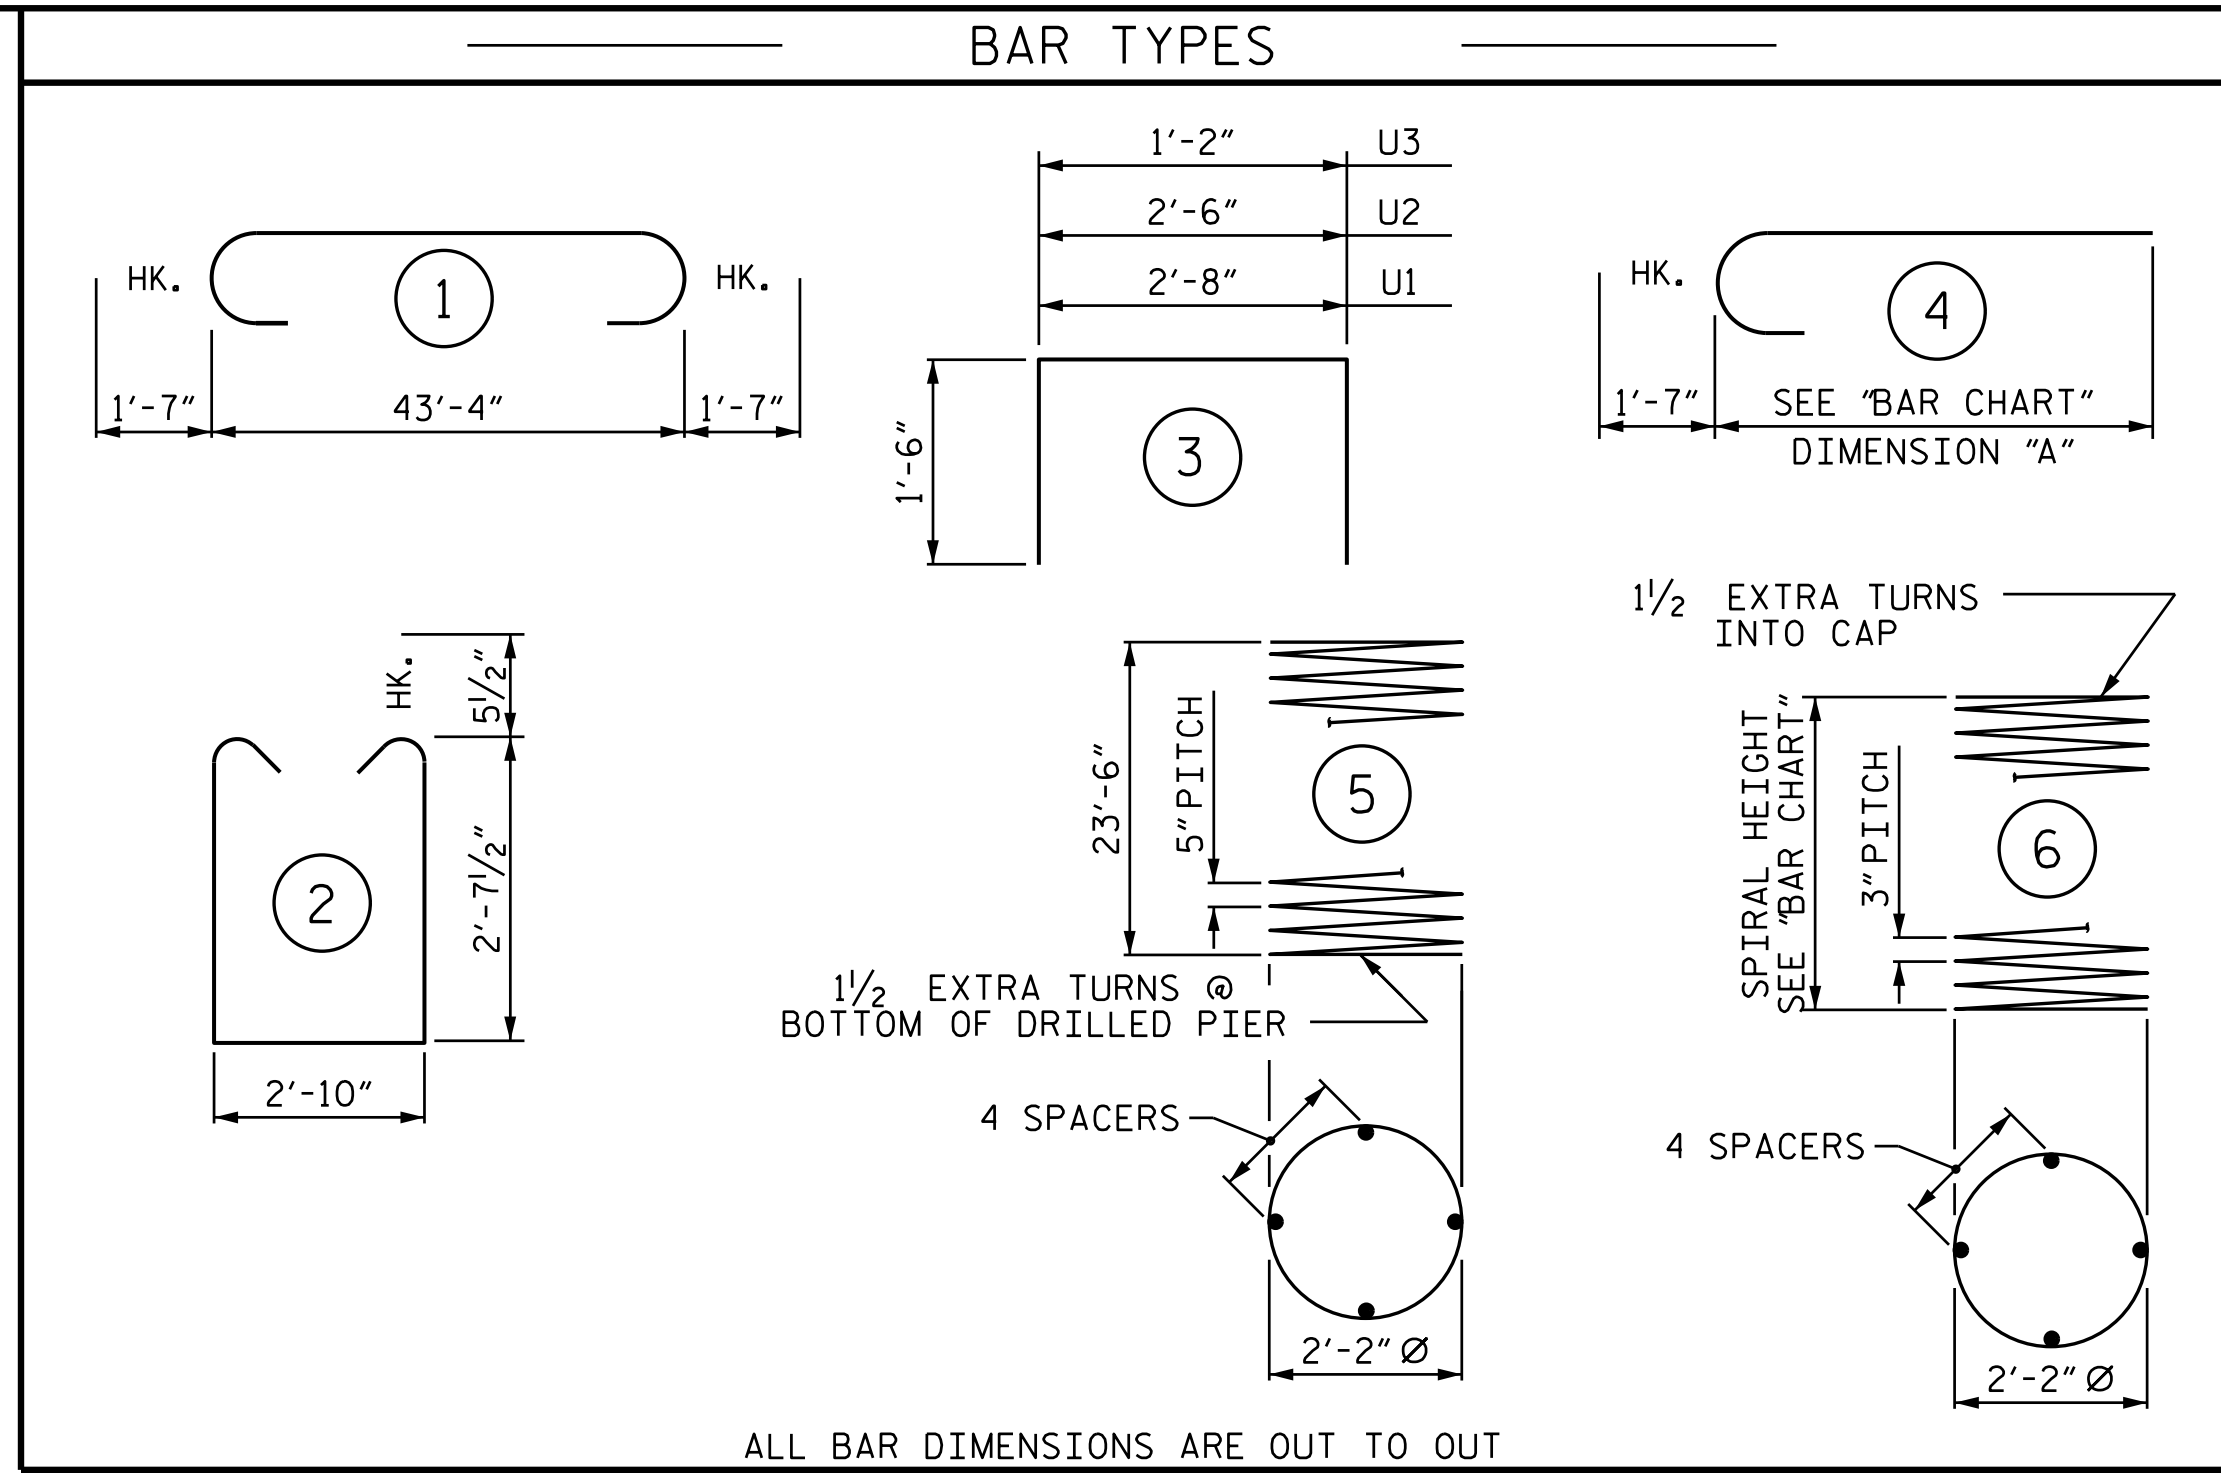

ALL BAR DIMENSIONS ARE OUT TO OUT

COLUMN No.	COLUMN HEIGHT	"SP" BAR	SPIRAL HEIGHT	"V" BAR	DIMENSION "A"
1	7'-1 1/16"	SP-2	7'-4 1/16"	V1	9'-3"
2	7'-8 7/8"	SP-3	7'-11 7/8"	V2	9'-10"
3	8'-4 11/16"	SP-4	8'-7 11/16"	V3	10'-6"

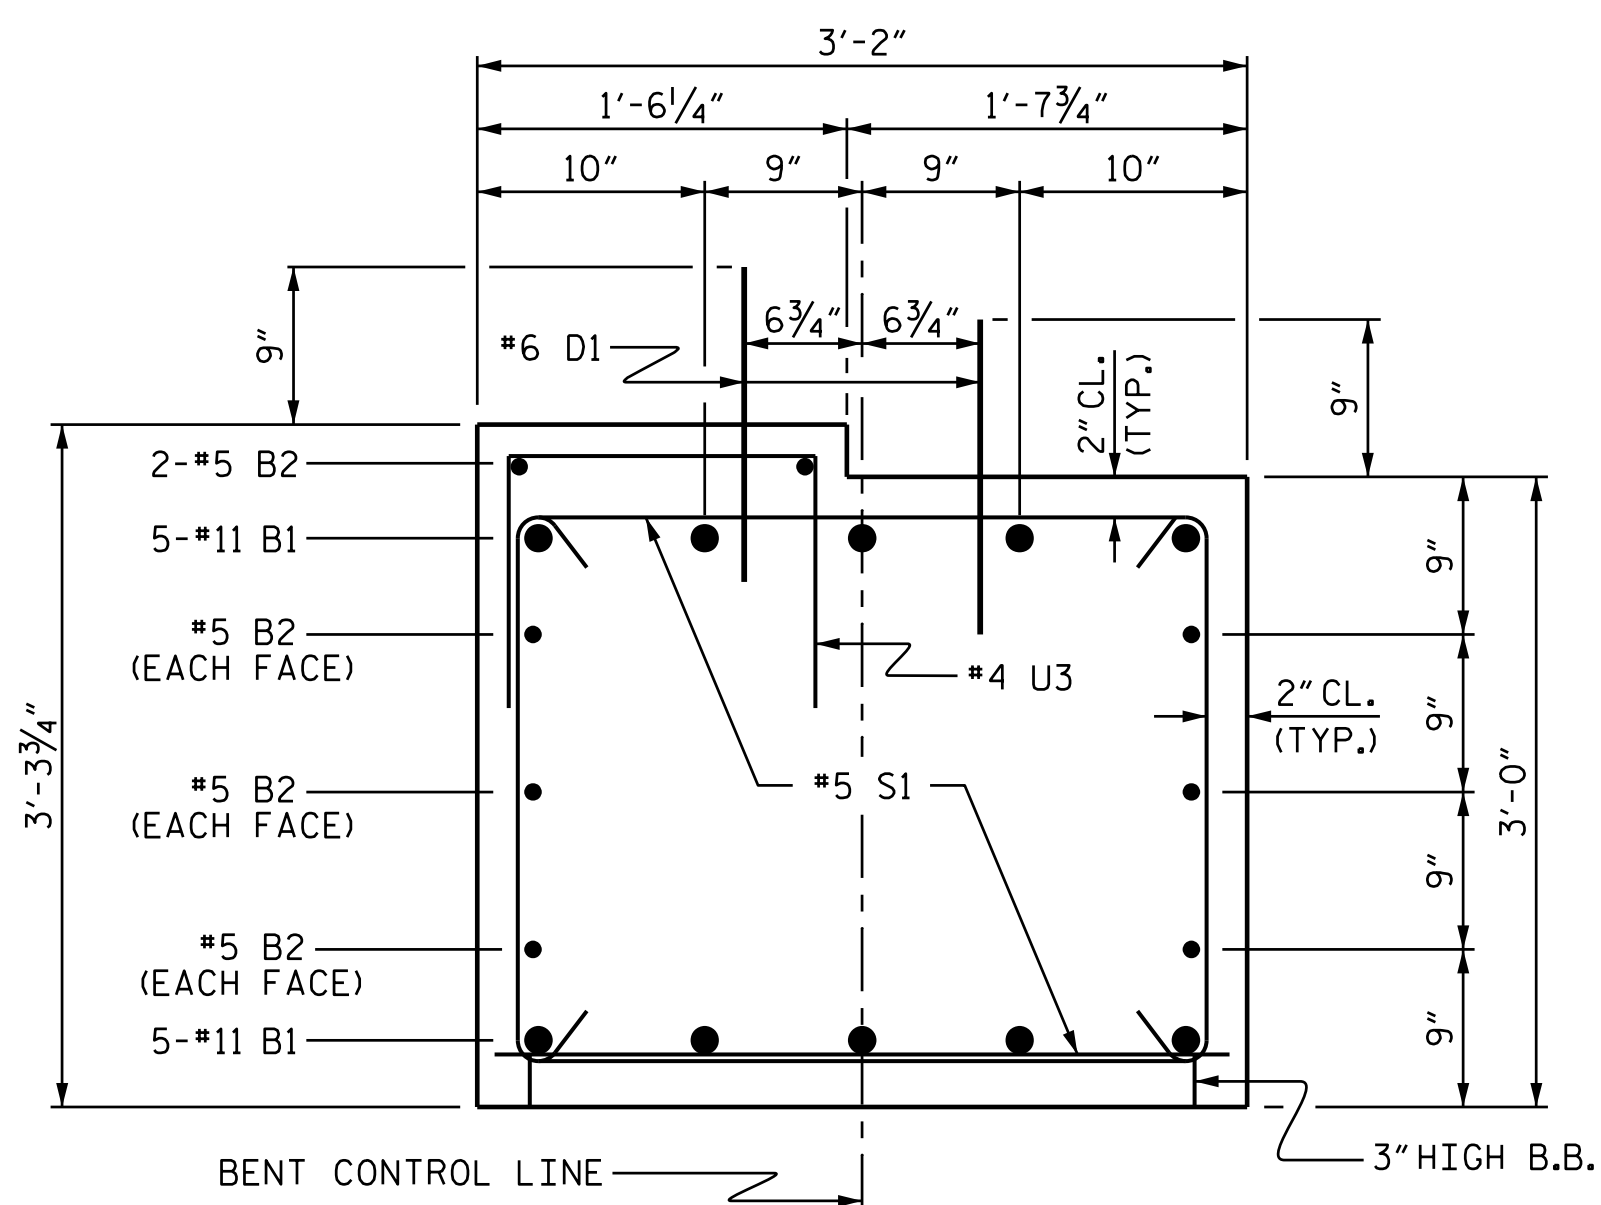

SECTION THRU CAP


BAR	NO.	SIZE	TYPE	LENGTH	WEIGHT
B1	10	#11		46'-6"	2471
B2	8	#5	STR	43'-6"	363
D1	52	#6	STR	1'-6"	117
M1	30	#11	STR	33'-11"	5406
S1	74	#5	2	9'-0"	695
U1	6	#4	3	5'-8"	23
U2	6	#4	3	5'-6"	22
U3	44	#4	3	4'-2"	122
V1	10	#11	4	10'-10"	576
V2	10	#11	4	11'-5"	607
V3	10	#11	4	12'-1"	642
REINFORCING STEEL (FOR ONE BENT)					11044 LBS.
SP-1	3	*	5	386'-1"	1208
SP-2	1	**	6	207'-2"	138
SP-3	1	**	6	223'-10"	150
SP-4	1	**	6	242'-3"	162
SPIRAL COLUMN REINFORCING STEEL (FOR ONE BENT)					1658 LBS.
* THE SP-1 SPIRAL REINFORCING STEEL SHALL BE W31 OR D-31 COLD DRAWN WIRE OR #5 PLAIN OR DEFORMED BAR					
** THE SP-2, SP-3, SP-4 SPIRAL REINFORCING STEEL SHALL BE W20 OR D-20 COLD DRAWN WIRE OR #4 PLAIN OR DEFORMED BAR					
CLASS A CONCRETE BREAKDOWN (FOR ONE BENT)					
POUR #2 (COLUMNS)				4.3 C.Y.	
POUR #3 (CAP)				16.2 C.Y.	
TOTAL CLASS A CONCRETE				20.5 C.Y.	
DRILLED PIERS: (FOR ONE BENT)					
DRILLED PIER CONCRETE					
POUR #1 (DRILLED PIERS)				18.9 C.Y.	
3'-0" Ø DRILLED PIER NOT IN SOIL				26 LIN. FT.	
3'-0" Ø DRILLED PIER IN SOIL				46 LIN. FT.	
PERMANENT STEEL CASING FOR 3'-0" Ø DRILLED PIER				30.3 LIN. FT.	
CSL TUBES				306 LIN. FT.	

PROJECT NO. 17BP.7.R.127
 GUILFORD COUNTY
 STATION: 15+33.00 -L-

SHEET 4 OF 4

STATE OF NORTH CAROLINA
 DEPARTMENT OF TRANSPORTATION
 RALEIGH

SUBSTRUCTURE
 BENT No. 2
 DETAILS

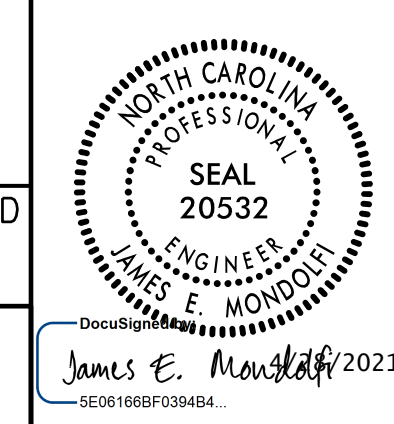

DOCUMENT NOT CONSIDERED FINAL UNLESS ALL SIGNATURES COMPLETED

PLANS PREPARED BY:
 MOTT MACDONALD
 PO Box 700
 Fuquay-Varina, NC 27526
 (919) 552-2253
 www.mottmac.com
 LICENSE NO. F-0669


NO.	BY:	DATE:	NO.	BY:	DATE:
1			3		
2			4		

SHEET NO. S-28
 TOTAL SHEETS 30


157077
 11/27/2021
 4/27/2021
 \\s1\c\p\17BP.7.R.127-SMU.B.400067.dgn
 12:10:35 PM

DRAWN BY: J. M. ABRIL DATE: 2-2021
 CHECKED BY: J. E. MONDOLFI DATE: 2-2021
 DESIGN ENGINEER OF RECORD: J. E. MONDOLFI DATE: 2-2021


NOTES :
FOR BERM WIDTH DIMENSIONS, SEE GENERAL DRAWING.

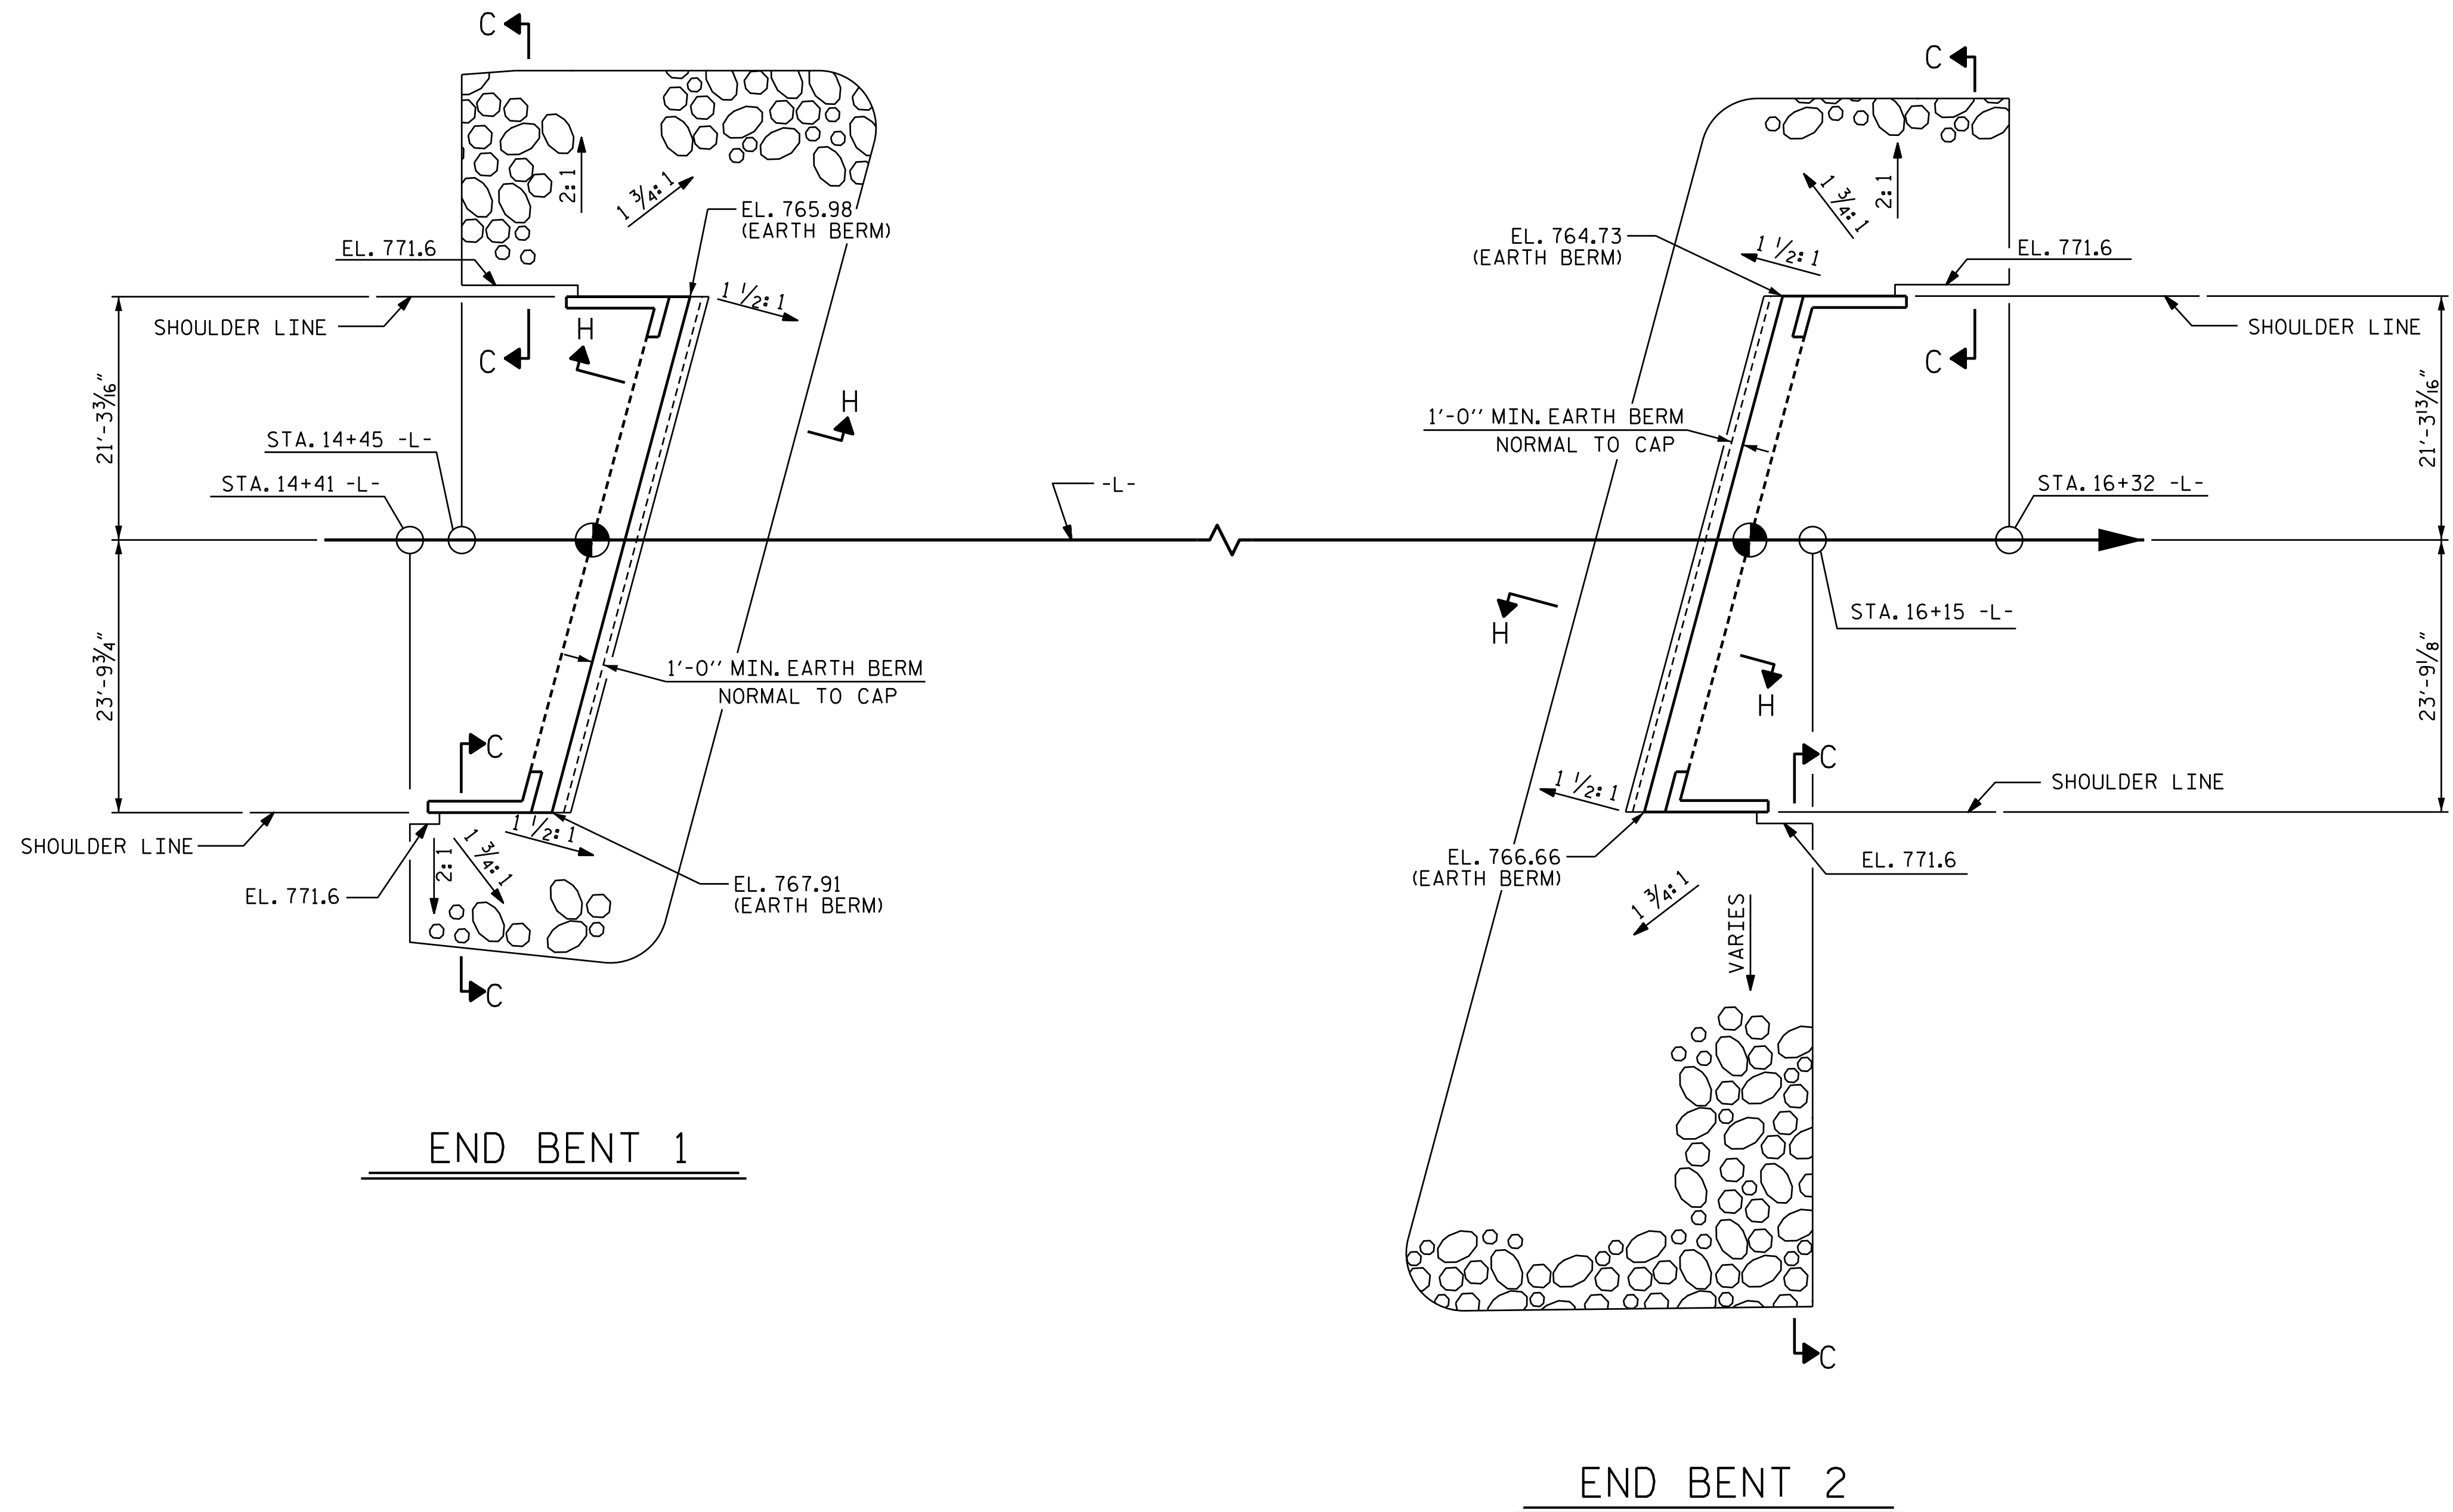


ESTIMATED QUANTITIES		
BRIDGE @ STA. 15+33.00 -L-	RIP RAP CLASS II (2'-0" THICK)	GEOTEXTILE FOR DRAINAGE
	TONS	SQUARE YARDS
END BENT 1	176	195
END BENT 2	264	293

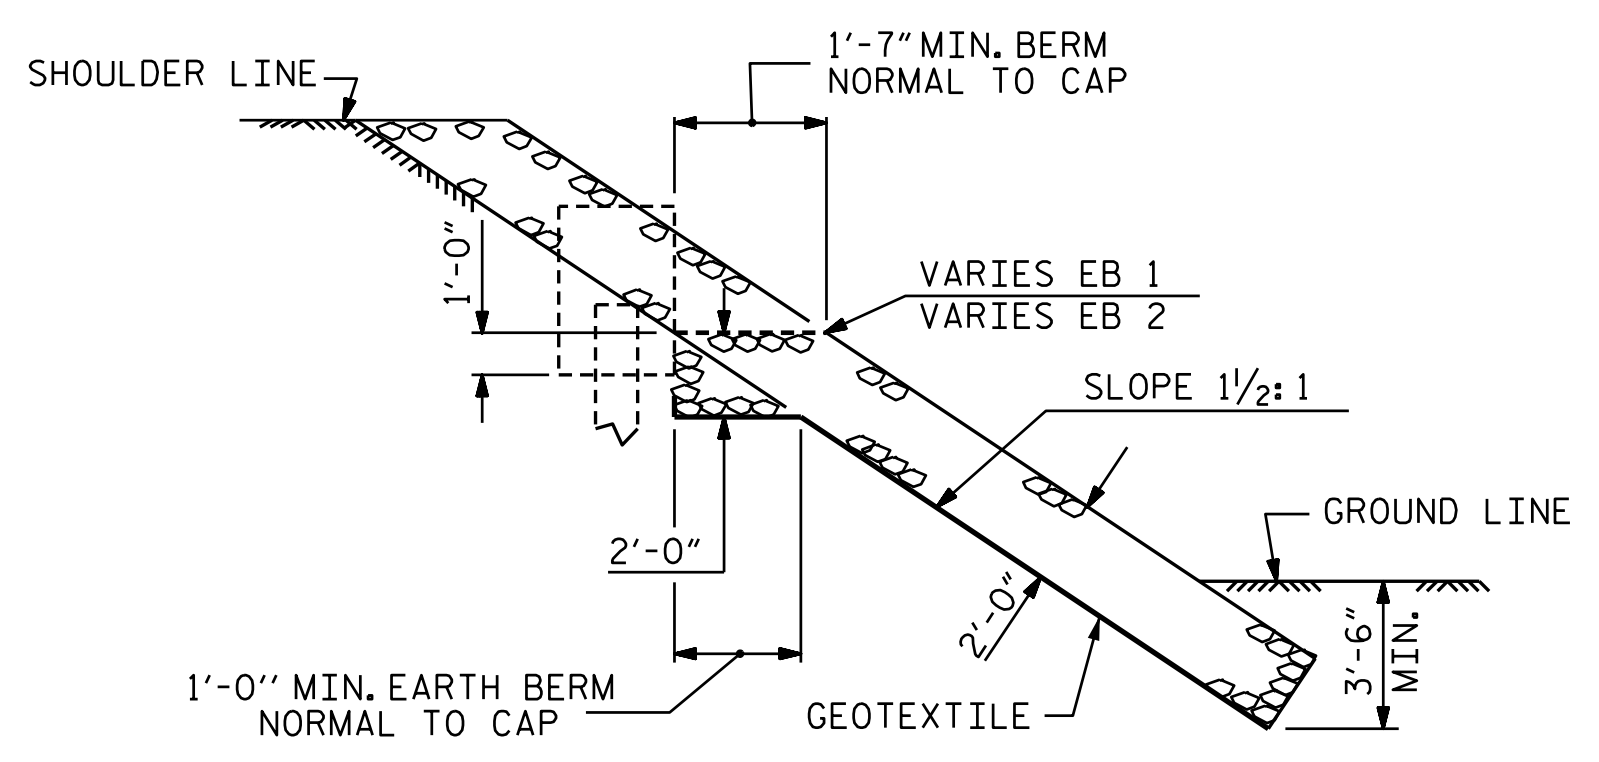

SECTION H-H

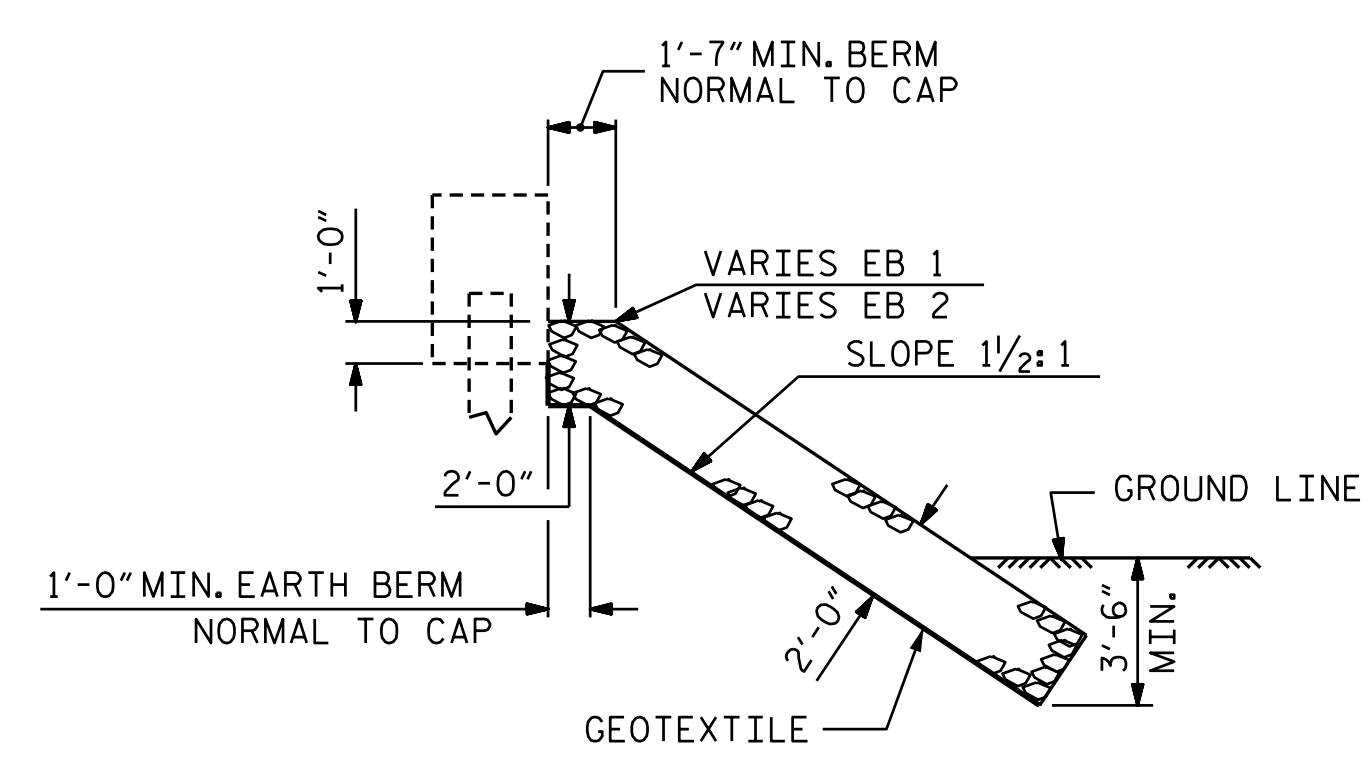

SECTION C-C
BERM RIP RAPPED

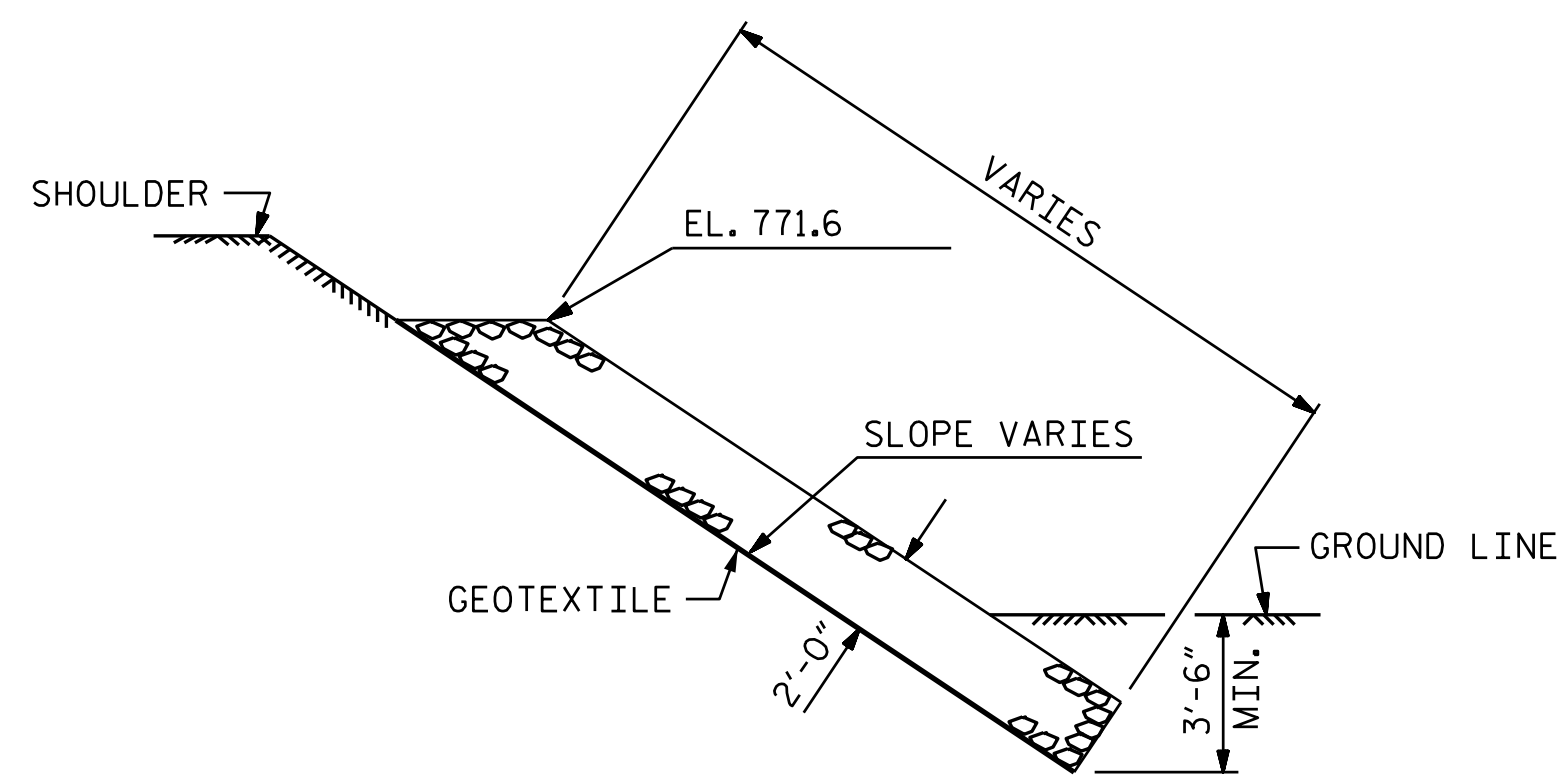


SECTION C-C

PROJECT NO. 17BP.7.R.127
GUILFORD COUNTY
STATION: 15+33.00 -L-

STATE OF NORTH CAROLINA
DEPARTMENT OF TRANSPORTATION
RALEIGH

—RIP RAP DETAILS—

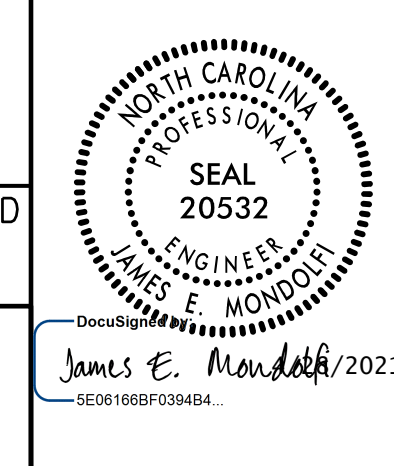

DOCUMENT NOT CONSIDERED
FINAL UNLESS ALL
SIGNATURES COMPLETED

PLANS PREPARED BY:
MOTT MACDONALD
PO Box 700
Fuquay-Varina, NC 27526
(919) 552-2253
www.mottmac.com
LICENSE NO. F-0669

REVISIONS						SHEET NO.
NO.	BY:	DATE:	NO.	BY:	DATE:	5-29
1			3			TOTAL SHEETS
2			4			30

157077
 W:\157077\Drawings\17BP.7.R.127-SMU-RR-400067.dgn
 4/27/2021 12:10:40 PM

DRAWN BY: M. L. MARLEY DATE: 2-2021
 CHECKED BY: J. M. ROBINSON DATE: 2-2021
 DESIGN ENGINEER OF RECORD: J. E. MONDOLFI DATE: 2-2021

STANDARD NOTES

DESIGN DATA:

SPECIFICATIONS	-----	A.A.S.H.T.O. (CURRENT)
LIVE LOAD	-----	SEE PLANS
IMPACT ALLOWANCE	-----	SEE A.A.S.H.T.O.
STRESS IN EXTREME FIBER OF STRUCTURAL STEEL - AASHTO M270 GRADE 36	--	20,000 LBS. PER SQ. IN.
	--	27,000 LBS. PER SQ. IN.
	--	27,000 LBS. PER SQ. IN.
REINFORCING STEEL IN TENSION - GRADE 60	----	24,000 LBS. PER SQ. IN.
CONCRETE IN COMPRESSION	-----	1,200 LBS. PER SQ. IN.
CONCRETE IN SHEAR	-----	SEE A.A.S.H.T.O.
STRUCTURAL TIMBER - TREATED OR UNTREATED EXTREME FIBER STRESS	----	1,800 LBS. PER SQ. IN.
COMPRESSION PERPENDICULAR TO GRAIN OF TIMBER	-----	375 LBS. PER SQ. IN.
EQUIVALENT FLUID PRESSURE OF EARTH	-----	30 LBS. PER CU. FT. (MINIMUM)

MATERIAL AND WORKMANSHIP:

EXCEPT AS MAY OTHERWISE BE SPECIFIED ON PLANS OR IN THE SPECIAL PROVISIONS, ALL MATERIAL AND WORKMANSHIP SHALL BE IN ACCORDANCE WITH THE 2018 "STANDARD SPECIFICATIONS FOR ROADS AND STRUCTURES" OF THE N.C. DEPARTMENT OF TRANSPORTATION.

STEEL SHEET PILING FOR PERMANENT OR TEMPORARY APPLICATIONS SHALL BE HOT ROLLED.

CONCRETE:

UNLESS OTHERWISE REQUIRED ON PLANS, CLASS A CONCRETE SHALL BE USED FOR ALL PORTIONS OF ALL STRUCTURES WITH THE EXCEPTION THAT: CLASS AA CONCRETE SHALL BE USED IN BRIDGE SUPERSTRUCTURES, ABUTMENT BACKWALLS, AND APPROACH SLABS; AND CLASS B CONCRETE SHALL BE USED FOR SLOPE PROTECTION AND RIP RAP.

CONCRETE CHAMFERS:

UNLESS OTHERWISE NOTED ON THE PLANS, ALL EXPOSED CORNERS ON STRUCTURES SHALL BE CHAMFERED $\frac{3}{4}$ " WITH THE FOLLOWING EXCEPTIONS: TOP CORNERS OF CURBS MAY BE ROUNDED TO $\frac{1}{2}$ " RADIUS WHICH IS BUILT INTO CURB FORMS; CORNERS OF TRANSVERSE FLOOR EXPANSION JOINTS SHALL BE ROUNDED WITH A $\frac{1}{4}$ " FINISHING TOOL UNLESS OTHERWISE REQUIRED ON PLANS; AND CORNERS OF EXPANSION JOINTS IN THE ROADWAY FACES AND TOPS OF CURBS AND SIDEWALKS SHALL BE ROUNDED TO A $\frac{1}{4}$ " RADIUS WITH A FINISHING STONE OR TOOL UNLESS OTHERWISE REQUIRED ON PLANS.

DOWELS:

DOWELS WHEN INDICATED ON PLANS AS FOR CULVERT EXTENSIONS, SHALL BE EMBEDDED AT LEAST 12" INTO THE OLD CONCRETE AND GROUTED INTO PLACE WITH 1:2 CEMENT MORTAR.

ALLOWANCE FOR DEAD LOAD DEFLECTION, SETTLEMENT, ETC. IN CASTING SUPERSTRUCTURES:

BRIDGES SHALL BE BUILT ON THE GRADE OR VERTICAL CURVE SHOWN ON PLANS. SLABS, CURBS AND PARAPETS SHALL CONFORM TO THE GRADE OR CURVE.

ALL DIMENSIONS WHICH ARE GIVEN IN SECTION AND ARE AFFECTED BY DEAD LOAD DEFLECTIONS ARE DIMENSIONS AT CENTER LINE OF BEARING UNLESS OTHERWISE NOTED ON PLANS. IN SETTING FORMS FOR STEEL BEAM BRIDGES AND PRESTRESSED CONCRETE GIRDER BRIDGES, ADJUSTMENTS SHALL BE MADE DUE TO THE DEAD LOAD DEFLECTIONS FOR THE ELEVATIONS SHOWN. WHERE BLOCKS ARE SHOWN OVER BEAMS FOR BUILDING UP TO THE SLAB, THE VERTICAL DIMENSIONS OF THE BLOCKS SHALL BE ADJUSTED BETWEEN BEARINGS TO COMPENSATE FOR DEAD LOAD DEFLECTIONS, VERTICAL CURVE ORDINATE, AND ACTUAL BEAM CAMBER. WHERE BOTTOM OF SLAB IS IN LINE WITH BOTTOM OF TOP FLANGES, DEPTH OF SLAB BETWEEN BEARINGS SHALL BE ADJUSTED TO COMPENSATE FOR DEAD LOAD DEFLECTION, VERTICAL CURVE ORDINATE, AND ACTUAL BEAM CAMBER.

IN SETTING FALSEWORK AND FORMS FOR REINFORCED CONCRETE SPANS, AN ALLOWANCE SHALL BE MADE FOR DEAD LOAD DEFLECTIONS, SETTLEMENT OF FALSEWORK, AND PERMANENT CAMBER WHICH SHALL BE PROVIDED FOR IN ADDITION TO THE ELEVATIONS SHOWN. AFTER REMOVAL OF THE FALSEWORK, THE FINISHED STRUCTURES SHALL CONFORM TO THE PROFILE AND ELEVATIONS SHOWN ON THE PLANS AND CONSTRUCTION ELEVATIONS FURNISHED BY THE ENGINEER.

DETAILED DRAWINGS FOR FALSEWORK OR FORMS FOR BRIDGE SUPERSTRUCTURE AND ANY STRUCTURE OR PARTS OF A STRUCTURE AS NOTED ON THE PLANS SHALL BE SUBMITTED TO THE ENGINEER FOR APPROVAL BEFORE CONSTRUCTION OF THE FALSEWORK OR FORMS IS STARTED.

REINFORCING STEEL:

ALL REINFORCING STEEL SHALL BE DEFORMED. DIMENSIONS RELATIVE TO PLACEMENT OF REINFORCING ARE TO CENTERS OF BARS UNLESS OTHERWISE INDICATED IN THE PLANS. DIMENSIONS ON BAR DETAILS ARE TO CENTERS OF BARS OR ARE OUT TO OUT AS INDICATED ON PLANS.

WIRE BAR SUPPORTS SHALL BE PROVIDED FOR REINFORCING STEEL WHERE INDICATED ON THE PLANS. WHEN BAR SUPPORT PIECES ARE PLACED IN CONTINUOUS LINES, THEY SHALL BE SO PLACED THAT THE ENDS OF THE SUPPORTING WIRES SHALL BE LAPPED TO LOCK LEGS ON ADJOINING PIECES.

STRUCTURAL STEEL:

AT THE CONTRACTOR'S OPTION, HE MAY SUBSTITUTE $\frac{7}{8}$ " \emptyset SHEAR STUDS FOR THE $\frac{3}{4}$ " \emptyset STUDS SPECIFIED ON THE PLANS. THIS SUBSTITUTION SHALL BE MADE AT THE RATE OF 3 - $\frac{7}{8}$ " \emptyset STUDS FOR 4 - $\frac{3}{4}$ " \emptyset STUDS, AND STUD SPACING CHANGES SHALL BE MADE AS NECESSARY TO PROVIDE THE SAME EQUIVALENT NUMBER OF $\frac{7}{8}$ " \emptyset STUDS ALONG THE BEAM AS SHOWN FOR $\frac{3}{4}$ " \emptyset STUDS BASED ON THE RATIO OF 3 - $\frac{7}{8}$ " \emptyset STUDS FOR 4 - $\frac{3}{4}$ " \emptyset STUDS. STUDS OF THE LENGTH SPECIFIED ON THE PLANS MUST BE PROVIDED. THE MAXIMUM SPACING SHALL BE 2'-0".

EXCEPT AT THE INTERIOR SUPPORTS OF CONTINUOUS BEAMS WHERE THE COVER PLATE IS IN CONTACT WITH BEARING PLATE, THE CONTRACTOR MAY, AT HIS OPTION, SUBSTITUTE FOR THE COVER PLATES DESIGNATED ON THE PLANS COVER PLATES OF THE EQUIVALENT AREA PROVIDED THESE PLATES ARE AT LEAST $\frac{3}{16}$ " IN THICKNESS AND DO NOT EXCEED A WIDTH EQUAL TO THE FLANGE WIDTH LESS 2" OR A THICKNESS EQUAL TO 2 TIMES THE FLANGE THICKNESS. THE SIZE OF FILLET WELDS SHALL CONFORM TO THE REQUIREMENTS OF THE CURRENT ANSI/AASHTO/AWS "BRIDGE WELDING CODE". ELECTROSLAG WELDING WILL NOT BE PERMITTED.

WITH THE SOLE EXCEPTION OF EDGES AT SURFACES WHICH BEAR ON OTHER SURFACES, ALL SHARP EDGES AND ENDS OF SHAPES AND PLATES SHALL BE SLIGHTLY ROUNDED BY SUITABLE MEANS TO A RADIUS OF APPROXIMATELY $\frac{1}{16}$ " INCH OR EQUIVALENT FLAT SURFACE AT A SUITABLE ANGLE PRIOR TO PAINTING, GALVANIZING, OR METALLIZING.

HANDRAILS AND POSTS:

METAL STANDARDS AND FACES OF THE CONCRETE END POSTS FOR THE METAL RAIL SHALL BE SET NORMAL TO THE GRADE OF THE CURB, UNLESS OTHERWISE SHOWN ON PLANS. THE METAL RAIL AND TOPS OF CONCRETE POSTS USED WITH THE ALUMINUM RAIL SHALL BE BUILT PARALLEL TO THE GRADE OF THE CURB.

METAL HANDRAILS SHALL BE IN ACCORDANCE WITH THE PLANS. RAILS SHALL BE AS MANUFACTURED FOR BRIDGE RAILING. CASTINGS SHALL BE OF A UNIFORM APPEARANCE. FINIS AND OTHER DEFORMATIONS RESULTING FROM CASTING OR OTHERWISE SHALL BE REMOVED IN A MANNER SO THAT A UNIFORM COLORING OF THE COMPLETED CASTING SHALL BE OBTAINED. CASTINGS WITH DISCOLORATIONS OR OF NON-UNIFORM COLORING WILL NOT BE ACCEPTED. CERTIFIED MILL REPORTS ARE REQUIRED FOR METAL RAILS AND POSTS.

SPECIAL NOTES:

GENERALLY, IN CASE OF DISCREPANCY, THIS STANDARD SHEET OF NOTES SHALL GOVERN OVER THE SPECIFICATIONS, BUT THE REMAINDER OF THE PLANS SHALL GOVERN OVER NOTES HEREON, AND SPECIAL PROVISIONS SHALL GOVERN OVER ALL. SEE SPECIFICATIONS ARTICLE 105-4.

ENGLISH

JANUARY, 1990

STD. NO. SN